

GOLDPARK

WORTH MORE™

CONSTRUCTION SUMMARY

Lot: 155

Model: 40.00 B BRIARWOOD

Project/Phase: Pine Valley Forevergreen / 1

ELECTRICAL

Invoice	Qty.	Description
2543 72,278 08Jan21	1	MASTER ENSUITE: ADDITIONAL INTERIOR SWITCH FOR POTLIGHTS + TUB LIGHT
2543 72,290 08Jan21	7	UPPER HALL: 4" E/S LED INTERIOR POT LIGHT (INSULATED CEILING) - SECOND FLOOR - EACH USE STANDARD SWITCH
2543 72,278 08Jan21	1	MASTER BEDROOM: ADDITIONAL INTERIOR SWITCH FOR POTLIGHTS

FRAMING

Invoice	Qty.	Description
2543 08Jan21 NoCat	1	**CUSTOM LAYOUT** MASTER ENSUITE - REDUCE DEPTH OF LINEN CLOSET IN ENSUITE TO ALLOW FOR PANTRY ACCESSIBLE FROM KITCHEN - SEE PLAN FOR LOCATION BASED ON STANDARD FINISHES
2543 72,631 08Jan21	1	MASTER ENSUITE: SHOWER NICHE [SHAMPOO SHELF] - COMPLETE WITH MATCHING MARBLE JAMBS ON 4 SIDES, STANDARD TILE, APPROX. 12 X 18 INSTALLED VERTICALLY
2543 72,631 08Jan21	1	SHARED BATH: SHOWER NICHE [SHAMPOO SHELF] - COMPLETE WITH MATCHING MARBLE JAMBS ON 4 SIDES, STANDARD TILE, APPROX. 12 X 18 INSTALLED VERTICALLY
2543 08Jan21 NoCat	1	.MASTER ENSUITE: MODEL OPTIONS 40.00 - MASTER BEDROOM - OPT. 11 FOOT TRAY CEILING
2543 08Jan21 NoCat	8	.THRU OUT 2ND FLOOR: INCREASE HEIGHT OF DOOR TO 8FT SECOND FLOOR - PER DOOR

HVAC

Invoice	Qty.	Description
2543 72,224 08Jan21	1	KITCHEN: GAS LINE ROUGH-IN - MAIN FLOOR FOR GAS COOKTOP

INTERIOR DOORS

Invoice	Qty.	Description
2543 08Jan21 NoCat	1	**CUSTOM LAYOUT** MASTER ENSUITE - REDUCE DEPTH OF LINEN CLOSET IN ENSUITE TO ALLOW FOR PANTRY ACCESSIBLE FROM KITCHEN - SEE PLAN FOR LOCATION BASED ON STANDARD FINISHES

DisciplineMS.rpt 26jun20

Page 3 of 5
Printed and Sent: 08-Jan-21

**Lot: 155****Model: 40.00 B BRIARWOOD****Project/Phase: Pine Valley Forevergreen / 1**

INTERIOR DOORS AND TRIM

Invoice	Qty.	Description
2543 72,644 08Jan21	8	THRU OUT 2ND FLOOR: INCREASE HEIGHT OF DOOR TO 8FT SECOND FLOOR - PER DOOR

INTERIOR TRIM AND DOORS

Invoice	Qty.	Description
2543	1	.GREAT ROOM: 96" GARDEN DOOR ASSEMBLY
08Jan21 NoCat		

MASONRY

Invoice	Qty.	Description
2543	1	.GREAT ROOM: 96" GARDEN DOOR ASSEMBLY
08Jan21 NoCat		

NETWORK AND WIRING

Invoice	Qty.	Description
2543 72,259 08Jan21	1	GREAT ROOM: CONDUIT PIPE - FOR WALL MOUNT TV - LOCATE ABOVE FIREPLACE, APPROX 66" A.F.F., TERMINATING AT CABLE
2543 72,258 08Jan21	1	GREAT ROOM: ADDITIONAL CAT6 ETHERNET OUTLET - EACH

PAINT


Invoice	Qty.	Description
2543 08Jan21 NoCat	1	.**CUSTOM LAYOUT** MASTER ENSUITE - REDUCE DEPTH OF LINEN CLOSET IN ENSUITE TO ALLOW FOR PANTRY ACCESSIBLE FROM KITCHEN - SEE PLAN FOR LOCATION BASED ON STANDARD FINISHES
2543 08Jan21 NoCat	1	.MASTER ENSUITE: MODEL OPTIONS 40.00 - MASTER BEDROOM - OPT. 11 FOOT TRAY CEILING
2543 08Jan21 NoCat	1	.GREAT ROOM: 96" GARDEN DOOR ASSEMBLY
2543 08Jan21 NoCat	8	.THRU OUT 2ND FLOOR: INCREASE HEIGHT OF DOOR TO 8FT SECOND FLOOR - PER DOOR



PV-155
OCT. 19 2020
DEC 28 2020

The Briarwood
40' Series
Elevation B - 2,840 sqft.

THIS PLAN
Shows OPT
Ground
Floor

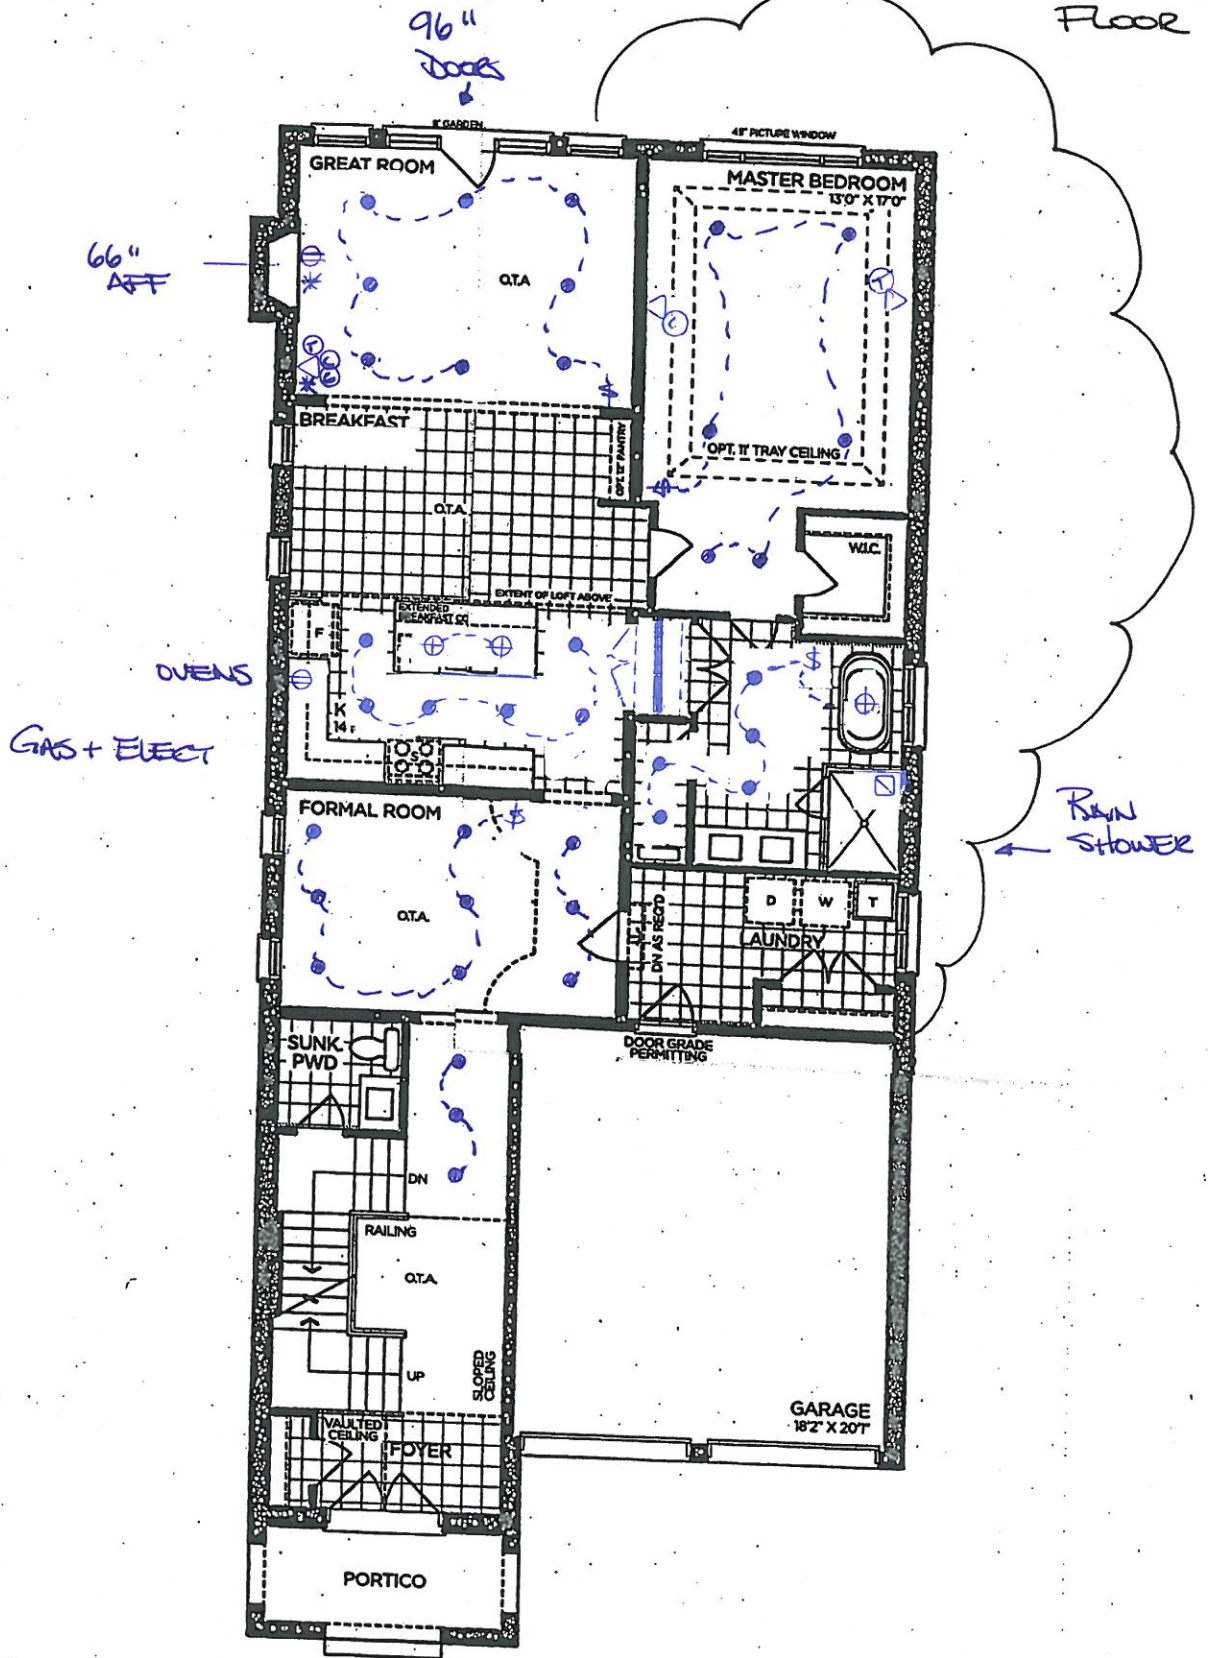

GROUND FLOOR | ELEV. A
ELEV. B

VENDOR

PURCHASER

PURCHASER

GOLDPARK
WORTH MORE™

Prices, figures, illustrations, sizes, features and finishes are subject to change without notice. Areas and dimensions are approximate and actual usable floor space may vary from the stated area. Layout may be reverse of the unit purchased. E. & O.E. 4000

2
SCHEDULE 'F'



PN-155
Oct 19 2020
DEC 28 2020


The Briarwood

40' SERIES

Elevation A • 2,870 sq.ft.

→ Elevation B • 2,860 sq.ft.

8' Doors
THRU OUT

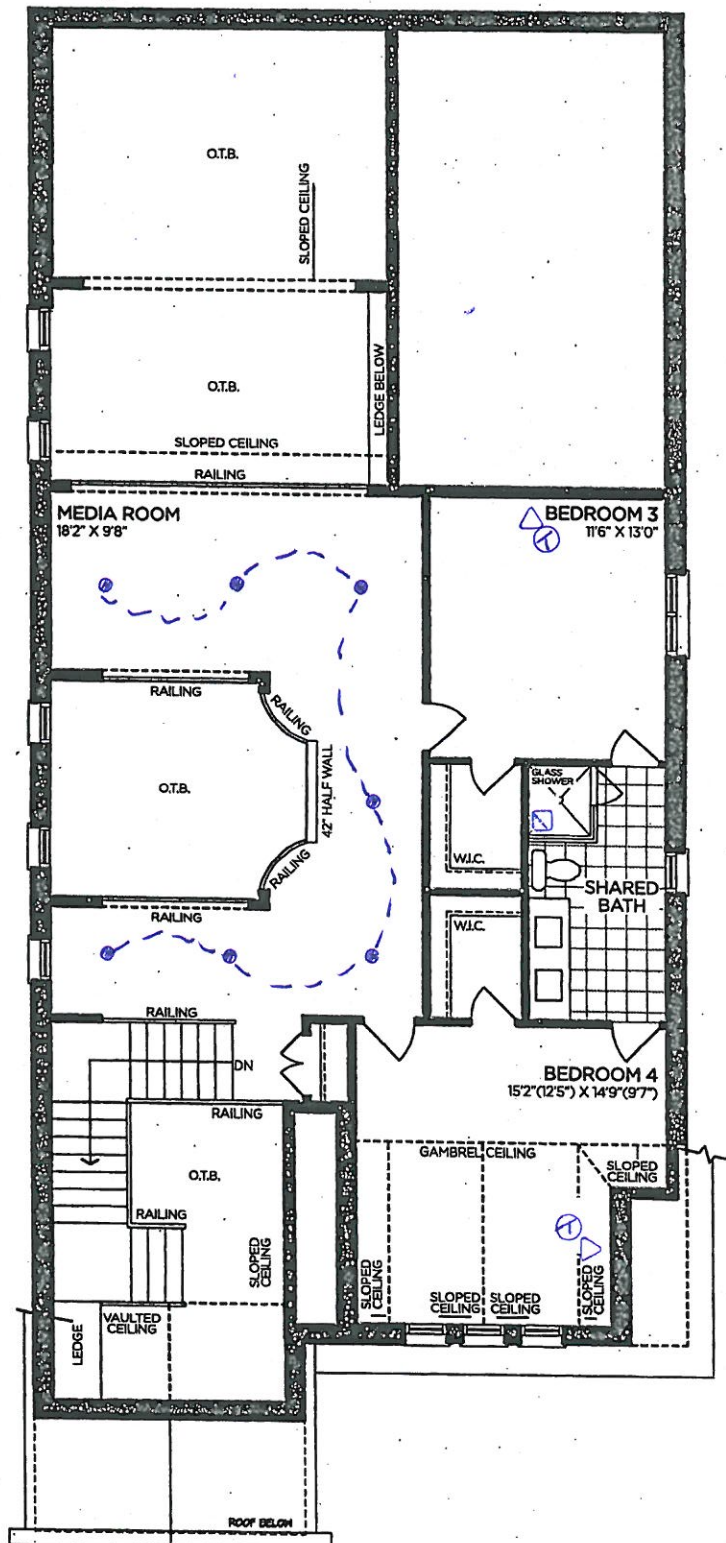

LOFT FLOOR | ELEV. A

VENDOR	
PURCHASER	
PURCHASER	

GOLDPARK

WORTH MORE™

Prices, figures, illustrations, sizes, features and finishes are subject to change without notice. Areas and dimensions are approximate and actual usable floor space may vary from the stated area. Layout may be reverse of the unit purchased. E. & O.E. 4000



SCHEDULE 'F'


PN-155
OCT 19 2020
DEC 28 2020

The Briarwood

40' SERIES

Elevation A • 2,870 sq.ft.

→ Elevation B • 2,860 sq.ft.

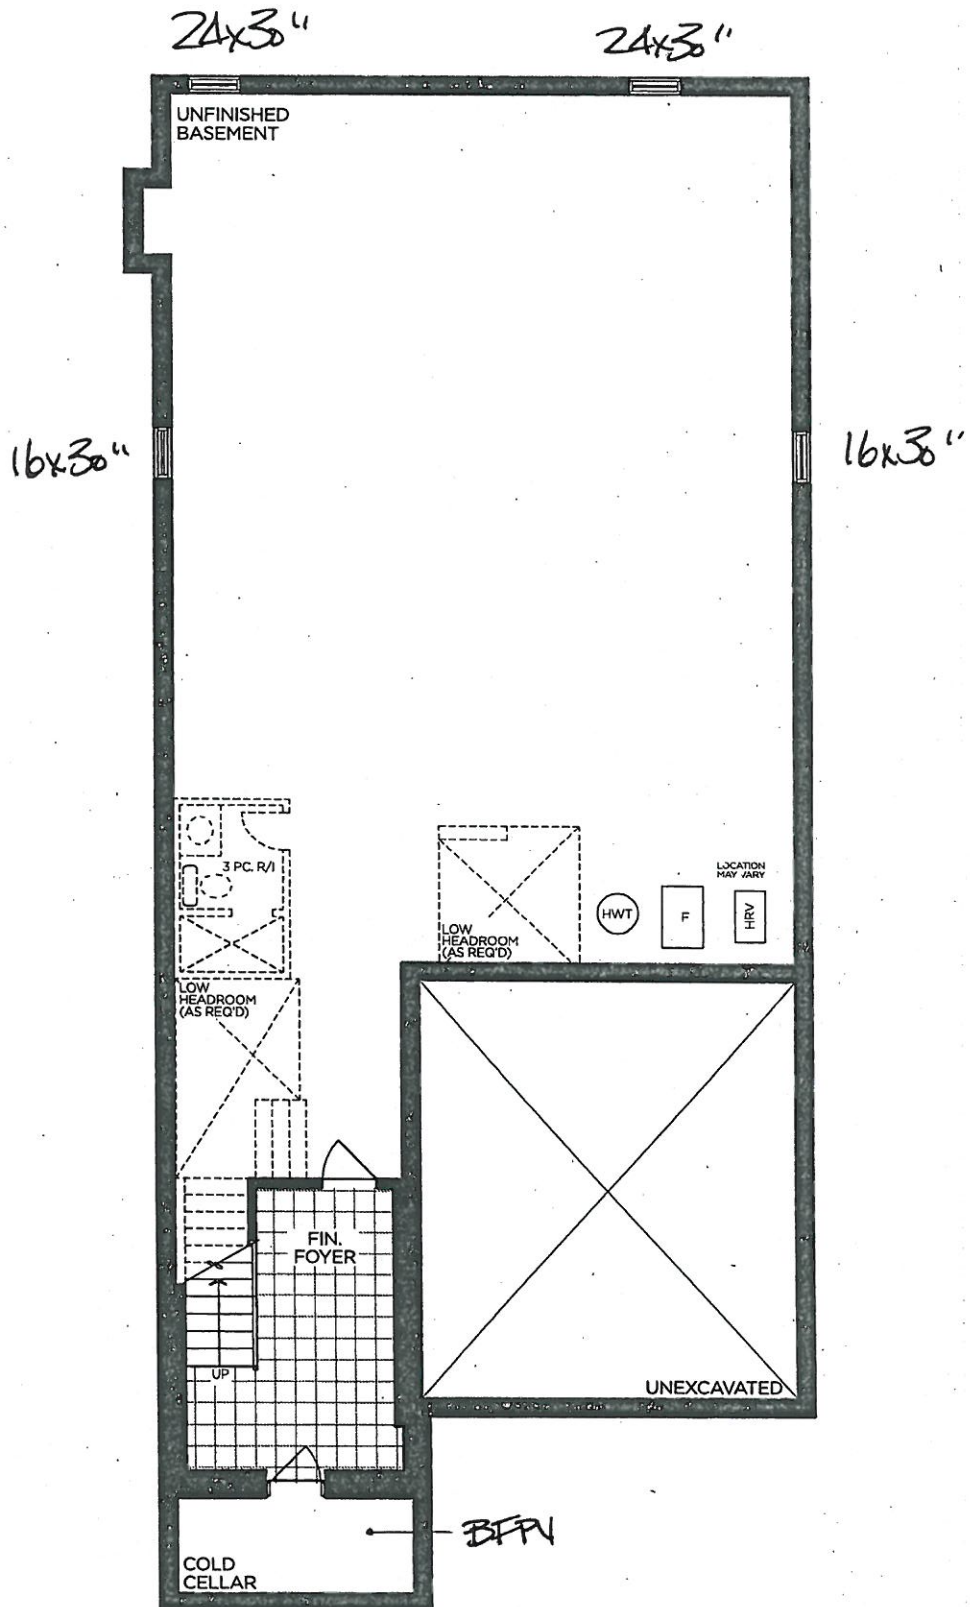

BASEMENT | ELEV. A & B
5

VENDOR

PURCHASER

PURCHASER

GOLDPARK
WORTH MORE™

Prices, figures, illustrations, sizes, features and finishes are subject to change without notice. Areas and dimensions are approximate and actual usable floor space may vary from the stated area. Layout may be reverse of the unit purchased. E. & O.E. 4000




PINE VALLEY
FOREVERGREEN

UPGRADE KITCHEN EXTRA

MOEN - MODERN

Pot Filler

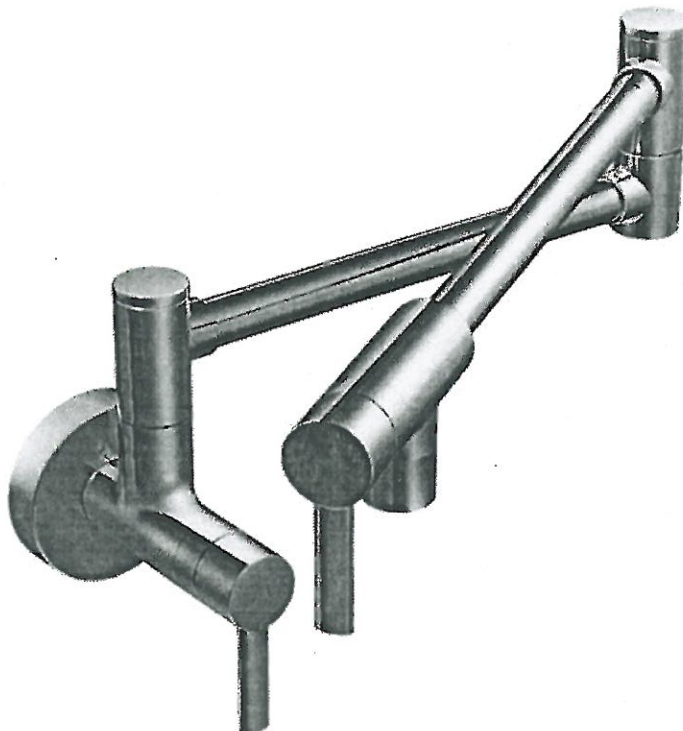

- ☐ CHROME
- ☒ STAINLESS (SRS)
- ☐ POLISHED NICKEL (NL)
- ☐ MATTE BLACK (BL)
- ☐ BRUSHED GOLD (BG)

MODEL: S665 Pot Filler

Lot# *PV-155*
Inventory

Date: *Dec. 28, 2020*

Room: *Kitchen*

Signature:

Signature:

GOLDPARK
WORTH MORE



PLUMBING UPGRADES

MOEN - FLARA

Posi-Temp SHOWER ONLY* Slide Bar with Hand Shower



- ☐ CHROME
☒ BRUSHED NICKEL (BN)

- ☒ From WALL
☐ From CEILING

MODEL: TS2912EP Shower Trim + 62320 Rough-in / UTS4911 Transfer Trim + U361CI Transfer Valve / 3669EP Handshower + A725 Drop El / *if selected: 116651 Shower Arm (Ceiling)

Lot# PV-155
Inventory

Date: Dec. 28, 2020

Room: Master Ensuite

Signature:

Signature:

PLUMBING UPGRADES

MOEN - FLARA

Two-Handle High Arc Cross Roman Tub Faucet with Hand Shower



- ☐ CHROME
☒ BRUSHED NICKEL (BN)
☐ POLISHED NICKEL (NL)
☐ BRUSHED GOLD (BG)

MODEL: TS929 Tub Faucet / 9796 Rough-In / T90331 + 140680 Tub Drain Half Kit

Lot# PV-155
Inventory

Date: Dec. 28, 2020

Room: Master Ensuite

Signature:

Signature:

MOEN - FLARA

Two-Handle High Arc Cross Lav Faucet



- ☐ CHROME
- ☒ BRUSHED NICKEL (BN)
- ☐ POLISHED NICKEL (NL)
- ☐ BRUSHED GOLD (BG)

MODEL: TS6985 Lav Faucet / 69000 Valve

Lot# <i>PV-155</i> <i>Inventory</i>	Date: <i>Dec. 28, 2020</i>	Room: <i>Master Ensuite x2</i>
Signature:		
Signature:		