



CONSTRUCTION SUMMARY

Lot: 120
Model: 40.02 B VALLEYVIEW
Project/Phase: Pine Valley Forevergreen / 1

APPLIANCES

Invoice	Qty.	Description
2432 17Sep20 NoCat	1	Appliance specifications as attached - signed

CERAMIC

Invoice	Qty.	Description
2432 17Sep20 NoCat	1	.MASTER ENSUITE: REPOSITION TUB - SEE PLAN
2432 17Sep20 NoCat	1	.MASTER ENSUITE: RELOCATE TOILET - SEE PLAN
2456 48 14Jan21	1	ENSUITE 2: TILE, WALL, LEVEL 2 - 2x8"
2456 27 14Jan21	1	ENSUITE 2: TILE INSTALLATION UPGRADE, WALL - *VERTICAL* BRICK PATTERN SEE ATTACHED SKETCH
2456 36 14Jan21	1	ENSUITE 2: TILE, FLOOR , LEVEL 9 - 30X60" LAID IN STRAIGHT, STACKED PATTERN. SEE PLAN FOR TILE DIRECTION
2456 19 14Jan21	1	ENSUITE 2: TILE GROUT UPGRADE, FLOOR + TUB WALLS

CONCRETE AND DRAIN

Invoice	Qty.	Description
2225 23Jul20 NoCat	1	.BACK-FLOW PREVENTER VALVE

CROWN MOULDING

Invoice	Qty.	Description
2376 23Jul20 NoCat	1	.MASTER BEDROOM - OPT. 10 FOOT TRAY CEILING AS PER PLAN



CONSTRUCTION SUMMARY

Lot: 120
Model: 40.02 B VALLEYVIEW
Project/Phase: Pine Valley Forevergreen / 1

DRYWALL

Invoice	Qty.	Description
2376 23Jul20 NoCat	1	.MASTER BEDROOM - OPT. 10 FOOT TRAY CEILING AS PER PLAN
2432 17Sep20 NoCat	1	.KITCHEN: DELETE NIBB WALL AT FRIDGE, RELOCATE ARCH. SEE PLAN FOR LOCATION [FRIDGE GABLE TO BE PURCHASED AT COLOUR APPOINTMENT]

ELECTRICAL

Invoice	Qty.	Description
2295 72,307 23Jul20	1	.KITCHEN: FIXTURE: RELOCATE STANDARD CEILING MOUNT FIXTURE TO ABOVE ISLAND - SEE PLAN FOR LOCATION
2295 72,289 23Jul20	6	.KITCHEN: MAIN FLOOR: 4" E/S LED INTERIOR POT LIGHT - GROUND FLOOR - EACH (INCLUDES 1 SWITCH) INCLUDED IN APS
2432 17Sep20 NoCat	1	.MASTER ENSUITE: RELOCATE VANITY TO OUTSIDE WALL - SEE PLAN FOR LOCATION

EXTERIOR COLOURS

Invoice	Qty.	Description
2376 23Jul20 NoCat	1	EXTERIOR COLOUR PACKAGE # BR.1

FORMING

Invoice	Qty.	Description
2225 23Jul20 NoCat	1	.OPTIONAL BASEMENT SERVICE STAIR
2225 23Jul20 NoCat	1	.BASEMENT WINDOWS - EGRESS BASEMENT WINDOW 47 " X 35" - 8" FRAME



CONSTRUCTION SUMMARY

Lot: 120
Model: 40.02 B VALLEYVIEW
Project/Phase: Pine Valley Forevergreen / 1

FRAMING

Invoice	Qty.	Description
2225 23Jul20 NoCat	1	.OPTIONAL BASEMENT SERVICE STAIR
2225 23Jul20 NoCat	1	.BASEMENT WINDOWS - EGRESS BASEMENT WINDOW 47 " X 35" - 8" FRAME
2376 72,403 23Jul20	1	.MASTER BEDROOM - OPT. 10 FOOT TRAY CEILING AS PER PLAN
2432 17Sep20 NoCat	1	.KITCHEN: DELETE NIBB WALL AT FRIDGE, RELOCATE ARCH. SEE PLAN FOR LOCATION [FRIDGE GABLE TO BE PURCHASED AT COLOUR APPOINTMENT]
2432 17Sep20 NoCat	1	.MASTER ENSUITE: REPOSITION TUB - SEE PLAN
2432 17Sep20 NoCat	1	.MASTER ENSUITE: RELOCATE VANITY TO OUTSIDE WALL - SEE PLAN FOR LOCATION
2432 17Sep20 NoCat	1	.MASTER ENSUITE: RELOCATE TOILET - SEE PLAN

GRANITE MARBLE QUARTZ

Invoice	Qty.	Description
2456 14Jan21 NoCat	1	ENSUITE 2: UPGRADE 6 QUARTZ COUNTER TOP



CONSTRUCTION SUMMARY

Lot: 120
Model: 40.02 B VALLEYVIEW
Project/Phase: Pine Valley Forevergreen / 1

PAINT

Invoice	Qty.	Description
2376 23Jul20 NoCat	1	.MASTER BEDROOM - OPT. 10 FOOT TRAY CEILING AS PER PLAN
2456 14Jan21 NoCat	2	MAIN STAIRS: BASEMENT TO 2ND FLOOR, STAIN STAIRS AND LANDINGS

PLUMBING

Invoice	Qty.	Description
2225 23Jul20 NoCat	1	.BACK-FLOW PREVENTER VALVE
2432 17Sep20 NoCat	1	.MASTER ENSUITE: REPOSITION TUB - SEE PLAN
2432 17Sep20 NoCat	1	.MASTER ENSUITE: RELOCATE VANITY TO OUTSIDE WALL - SEE PLAN FOR LOCATION
2432 17Sep20 NoCat	1	.MASTER ENSUITE: RELOCATE TOILET - SEE PLAN
2456 14Jan21 NoCat	1	ENSUITE 2: MOEN 'ALIGN' TUB/SHOWER FAUCET 'BRUSHED GOLD' LAV FAUCET TO BE STANDARD CHROME
2456 14Jan21 NoCat	1	ENSUITE 2: CONTRAC 'EMERY' UNERMOUNT SINK 'MATTE BLACK'

STAIR AND RAILINGS

Invoice	Qty.	Description
2456 93,780 14Jan21	2	MAIN STAIRS: UPGRADE - EURONLINE (ALL PLAIN) PICKET, 3" HALF-ROUND W/V-GROOVE HANDRAIL, 3 1/2" ALL SQUARE POST WITH PYRAMID TOP POST CAP - PACKAGE A-2

STAIRS AND RAILINGS

Invoice	Qty.	Description
2225 23Jul20 NoCat	1	.OPTIONAL BASEMENT SERVICE STAIR



CONSTRUCTION SUMMARY

Lot: 120
Model: 40.02 B VALLEYVIEW
Project/Phase: Pine Valley Forevergreen / 1

WINDOWS - BASEMENT

Invoice	Qty.	Description
2225 72,672 23Jul20	1	.BASEMENT WINDOWS - EGRESS BASEMENT WINDOW 47 " X 35" - 8" FRAME

WINDOWS AND DOORS


Invoice	Qty.	Description
2295 23Jul20 NoCat	1	THRU OUT: UPGRADE WINDOWS TO BLACK INTERIOR


PV-120 Cabinetry Schedule

ROOM	DESCRIPTION	PRICE	QTY	TOTAL
ENSUITE 2	UPGRADE SERIES 2 TO SERIES 3		1	
DOOR: CHELSEA	CONVERT VANITY TO COMFORT HEIGHT		1	
COLOUR: HI-GLOSS 'BLACK'	CONVERT STD WHITE CABINET INTERIOR TO CLASSIC MAPLE		1	
HARDWARE: NONE				
KITCHEN	UPGRADE KITCHEN PERIMETER FROM SERIES 2 TO SERIES 3		1	
DOOR: MANHATTAN				
COLOUR: MAPLE EBONY	ADD DÉCOR PANELS FOR PANEL READY 30"W x 84"H FRIDGE AND FREEZER		1	
HARDWARE: NONE	CONVERT STANDARD UPPER AND BASE CABINET INTO TALL DEEP PANTRY		1	
	CONVERT STANDARD UPPER CABINET TO FLIP UP CABINETS ABOVE FRIDGE/FREEZER/PANTRY		1	
	CONVERT FULL HEIGHT BASE CABINET DOOR TO POTS AND PANS W/ STD DRAWER		2	
	ADD 12"W 2-TIER SPICE PULL OUT TO A FULL HEIGHT DOOR CABINET		1	
	LEAVE 42" SPACE FOR FUTURE 36" CHIMNEY FAN		1	
	RETURN TRIP FOR HARDWOOD		1	
	CONVERT STD 45"H UPPERS TO 49.5"H		1	
	CONVERT STD BANK OF 4 DRAWERS INTO BEECH DRAWERS		1	
	CONVERT WHITE DRAWERS IN POTS AND PANS TO BEECH DRAWERS		2	
	CONVERT STD WHITE INTERIOR BASE CABINETS TO CLASSIC MAPLE		1	
	ADD ROLLOUTS		4	
	VOID CORNER IN BASE CABINETS		1	
	FLAT FURRING TO CEILING		1	
ISLAND	UPGRADE FROM SERIES 2 TO SERIES 3		1	
DOOR: MANHATTAN	ADD DÉCOR PANEL FOR PANEL READY DISHWASHER		1	
COLOUR: MAPLE EBONY	ADD PULL-OUT BASE RECYCLING CENTRE TO FULL HEIGHT DOOR BASE CABINET		1	
	FURNITURE KICK AT REAR OF ISLAND		1	
	APPLIED TRIM MOULDING ON OPERABLE REAR SIDE DOORS OF THE ISLAND		1	
	TOUCH LATCH AT REAR OF ISLAND		1	
	CONVERT STD WHITE INTERIOR BASE CABINETS TO CLASSIC MAPLE		1	

LOT #: PV-120

DATE: January 11, 2021

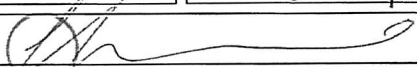SIGNATURE: 

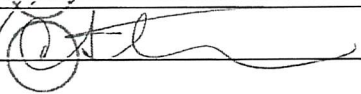SIGNATURE: 

Purchasers: Cosimo Stalteri & Fabio Sammarco

Property: 120 of Plan -

Telephone Res. / Bus: /

Project: Pine Valley Forevergreen - Phase 1

Decor Advisor: Yolande Somerville

Model and Elevation: 40.02 B VALLEYVIEW

Layout Changes: ☒ Yes ☐ No Sketch Attached: ☒ Yes ☐ No Exterior Colour Scheme:

1. Cabinetry

	Style and Colour	Counter	Hardware
Kitchen / Breakfast	*Manhattan maple 'Ebony'	Granite: Arctic White	attched
Laundry Room	Chesapeake 'Classic white'	P-Lam: White	attched
Powder Room	Chesapeake 'Classic white'	Quartz: Ice Snow	attched
Master Ensuite Bathroom	Chesapeake 'Classic white'	Quartz: Ice Snow	attched
Second Ensuite Bathroom (If Applicable)	*Chelsea hi gloss 'Black'	*Quartz: Eternal Noir	attched
Shared Ensuite	Chesapeake 'Classic white'	Quartz: Ice Snow	attched
Comment 			

2. Floor Tile

	Selection
Entrance Vestibule	13x13" Sempre 'White'
Main Hall	
Kitchen / Breakfast	*hardwood
Laundry Room	13x13" Sempre 'White'
Powder Room	13x13" Sempre 'White'
Mud Room	13x13" Sempre 'White'
Master Ensuite Bathroom	13x13" Sempre 'White'
Second Ensuite Bathroom (If Applicable)	*30x60" Marmorea polished 'Port Laurent' Grout: Charcoal
Lower Landing (If Applicable)	13x13" Sempre 'White' (basement foyer)
Shared Ensuite	13x13" Sempre 'White'
Comment Shower floors: std 2x2" white 	

3. Wall Tile

	Selection	Listello/Inserts	Describe
Master Ensuite Bathroom		☐ Yes ☒ No	
Tub Deck		☐ Yes ☒ No	
Shower Stall	8x10" Weave 'White'	☐ Yes ☒ No	
Bathroom Walls		☐ Yes ☒ No	
Second Ensuite Bathroom (If Applicable)	*2x8" CDC 'Arctic White' pol	☐ Yes ☒ No	Grout: Charcoal
Shared Ensuite	8x10" Weave 'White'	☐ Yes ☒ No	
Kitchen Backsplash	☐ Yes ☒ No	Backsplash Behind Fridge	
Comment 			

4. Plumbing Fixtures

☐	Second Ensuite	☐	Powder Room	☐
Master Ensuite Bathroom	☐	Other Room - Specify	☐	Other Washroom
☐				

Comment

Upgraded Ensuite 2 see extras

5. Hardwood Flooring

Main Hall	Type and Stain	Upper Landing	Type and Stain
Kitchen / Breakfast	*3/4x5" wht oak wirebrush 'pharoah'	Upper Hall	
Living Room		Master Bedroom	
Dining Room		Bedroom #2	
Family Room		Bedroom #3	
Den/Library		Bedroom #4	
Entrance Vestibule		Bedroom #5	
Lower Landing (If Applicable)		Other Room - Specify	
		Thru out standard areas	*3/4x5" wht oak wirebrush 'pharoah'

Comment

Thru out HERRINGBONE pattern: Vintage white oak 3/4x5x30" Wirebrushed 'Pharoah'

6. Carpeting

Ground Floor	Upgrade	Description
	☐	
Second Floor	☐	
	☐	

Upgrade Underpad	Type	Area
Carpet on Stairs	Capped	Runner - *Upgrade

Comment

7. Fireplace

	Living Room			Family Room			Other Room - Specify		
	Purchased	As Per Plan	N/A	Purchased	As Per Plan	N/A	Purchased	As Per Plan	N/A
Fireplace Type	☐	☐	☒	☐	☒	☐	☐	☐	☒
Mantle Type				Standard Gas					
Colour / Stain				Mediterranean					
Surround				Arctic White					
Hearth				n/a					
				none					

Comment

Purchasers: Cosimo Stalteri & Fabio Sammarco

Property: 120 of Plan -

Telephone Res. / Bus: /

Project: Pine Valley Forevergreen - Phase 1

Decor Advisor: Yolande Somerville

Model and Elevation: 40.02 B VALLEYVIEW

8. Trim Carpentry

Interior Doors Front Door Glass Inserts Door Handles

Interior Trim

Comment

9. Plaster Mouldings and Medallions

Standard Throughout ☐ Yes ☐ No ☒ N/A

Entrance Vestibule Kitchen/Breakfast

Main Hall Den/Library

Living Room Lower Landing

Dining Room Other Room - Specify

Family Room

Comment

10. Railings and Spindles

Railing Package

Railing Colour

Spindle Colour

Stringer / Riser

Treads

Comment

Oak Stairs ☒ Yes ☐ No ☐ N/A

11. Wall Paint / Ceilings

Throughout Finished Areas

Trim Paint

Smooth Ceilings

Ground Floor ☒

Second Floor ☒

Note

Comment

Purchasers: Cosimo Stalteri & Fabio Sammarco

Property: 120 of Plan -

Telephone Res. / Bus: /

Project: Pine Valley Forevergreen - Phase 1

Decor Advisor: Yolande Somerville

Model and Elevation: 40.02 B VALLEYVIEW

12. Electrical

Hood Fan ☐ White ☐ Stainless ☒ N/A

Above Kitchen Cabinet Light ☐ Yes ☒ No

Below Kitchen Cabinet Light ☐ Yes ☒ No

Standard Appliances ☐

Over The Range Microwave ☐

Chimney Style Fan ☐

Comment

13. Heating and Air Conditioning

Air Conditioning

Gas Provisions Stove

Gas Provisions Dryer

Gas Provisions Barbecue

Comment


14. Additional Comments

15. Disclaimers and Notes

- Colours of all materials are as close as possible to builder's selection, but not necessarily identical due to variances in manufacturing.
- Any extras listed above are null and void unless accompanied by a separate invoice/amendment. Said invoice must be paid in full.
- The Purchaser acknowledges that after Interior Colour Selection form is signed and dated, no further changes will be permitted other than re-selection due to unavailability. _____ Purchaser's Initials
- The Purchaser acknowledges reading and accepting the "Gold Park Homes Decor Centre Disclaimers" form. This document contains other miscellaneous disclaimers.

This Interior Colour Selection is final and approved by:

Signature: _____ Date: _____

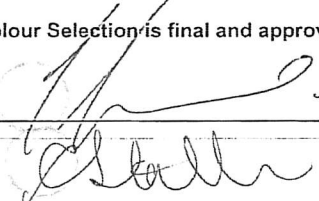

SCHEDULE 'F'



The Valleyview
40' SERIES

Elevation A • 3,145 sq.ft.

→ Elevation B • 3,170 sq.ft.

REVISED LAYOUT
AUG 21 2020

See attach.

PV-120
Jan. 11 2021

JUNE 19 2020

PV-120
XMAKED 17 2020
JUNE 4 2020
Set attached.

No!

OPT. LOGGIA

GARDEN DOOR

D.V. GAS FIREPLACE

GREAT ROOM
18'6" X 13'0"

Black
INTERIOR
Windows

*HARDWOOD IN
KITCHEN*

DELETE NBS wall
+ MOVE ARCH →

PREFERRED
HERRINGBONE
PATTERN
THRU OUT

BREAKFAST
11'6" X 13'0"

DW
KITCHEN
COUNTER
F

HARDWOOD

COFFERED CEILING

DINING ROOM
14'0" X 14'0"

LAUNDRY
(SINK)

DOOR GRADE
PERMITTING

SERVICE
STAIRS.

RAILING
O.T.A.

P.W.D.

FOYER

COVERED
PORCH

GARAGE
18'6" X 23'10" (20'2")

GROUND FLOOR | ELEV. A

VENDOR

PURCHASER

PURCHASER

GOLDPARK
WORTH MORE™

Prices, figures, illustrations, sizes, features and finishes are subject to change without notice. Areas and dimensions are approximate and actual usable floor space may vary from the stated area. Layout may be reverse of the unit purchased. E. & O.E. 4002

SCHEDULE 'F'



The Valleyview
40' SERIES


Elevation A • 3,145 sq.ft.
Elevation B • 3,170 sq.ft.

PV-120
March 17 2020 *see attached*
June 4 2020 *see attached*
June 19 2020 *see attached*
August 21 2020 *see attached*

- * REVISED LAYOUT *
- STRAIGHTEN TUB
- RELOCATE VANITY
- RELOCATE TOILET

PV-120
Jan. 11 2021

PREFERRED
HERRINGBONE
PATTERN.
THRU OUT
2nd FLOOR

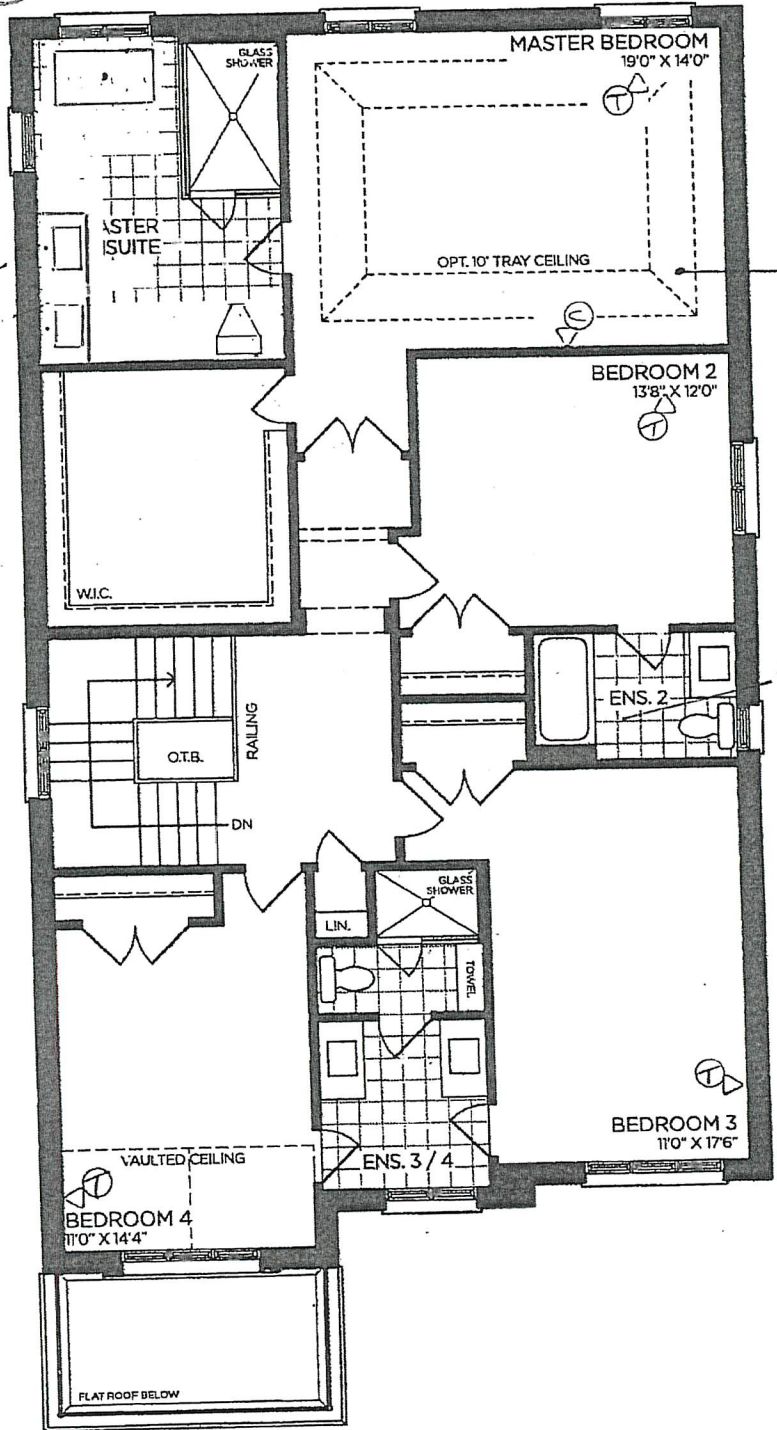

SECOND FLOOR | ELEV. A

VENDOR

PURCHASER

PURCHASER

GOLDPARK
WORTH MORE™

Prices, figures, illustrations, sizes, features and finishes are subject to change without notice. Areas and dimensions are approximate and actual usable floor space may vary from the stated area. Layout may be reverse of the unit purchased. E. & O.E. 4002

SCHEDULE 'F'



PV-120 *see attach*
 MAR 17 2020


JUNE 4 2020 *see attached*

JUNE 19 2020 *see attach*


AUG 2 2020 *see attach*

PV 120 *see attach*
 Jan. 11 2021

YES!

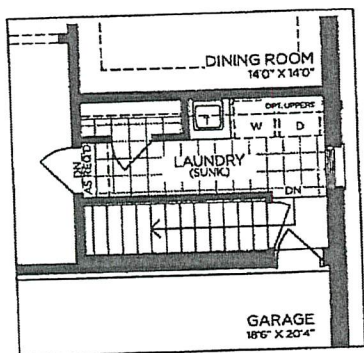

PART. GROUND FLOOR
 OPT. SERVICE STAIR

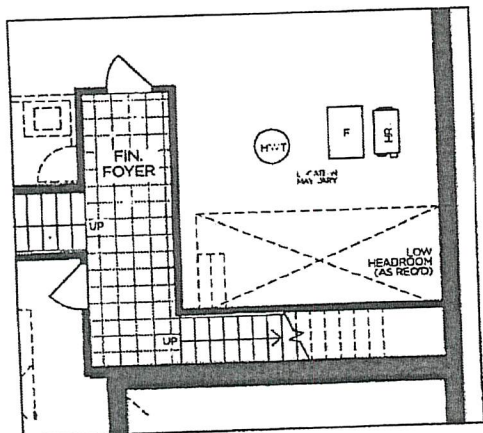


PART. BASEMENT
 OPT. SERVICE STAIR


The Valleyview 40' SERIES

Elevation A • 3,145 sq.ft.


→ Elevation B • 3,170 sq.ft.

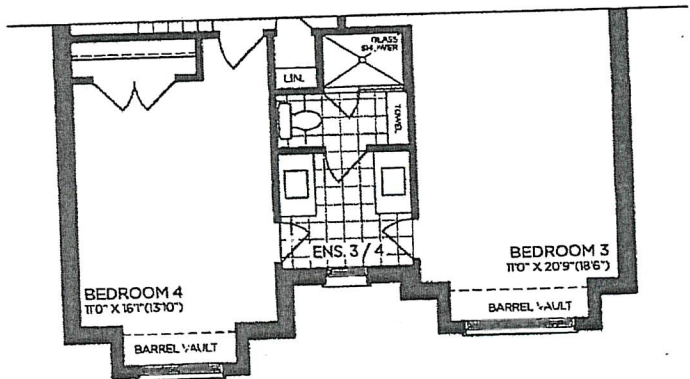

→ PART. SECOND FLOOR | ELEV. B

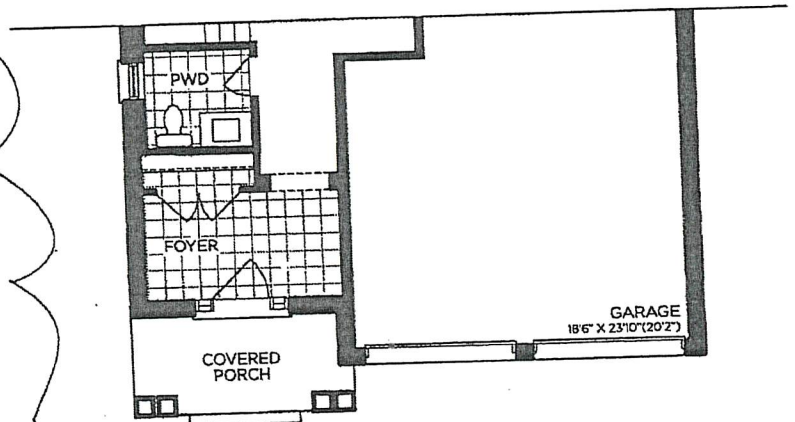

→ PART. GROUND FLOOR | ELEV. B

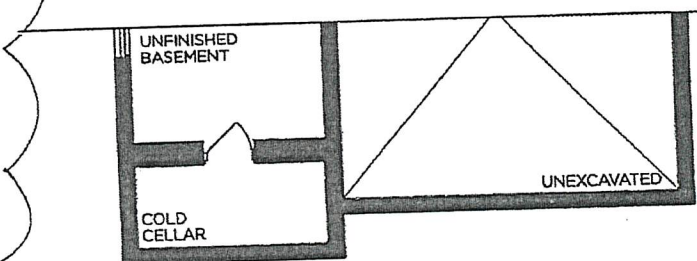

→ PART. BASEMENT | ELEV. B

VENDOR

PURCHASER

PURCHASER

GOLDPARK
 WORTH MORE™

Prices, figures, illustrations, sizes, features and finishes are subject to change without notice. Areas and dimensions are approximate and actual usable floor space may vary from the stated area. Layout may be reverse of the unit purchased. E. & O.E. 4002


SCHEDULE 'F'



The Valleyview
40' SERIES

Elevation A • 3,145 sq.ft.
Elevation B • 3,170 sq.ft.

PV-120 *see attached*
MAY 17 2020 *see attached*
JUNE 4 2020
JUNE 19 2020 *see attached* LOOK OUT 30x48"
AUG 21 2020 *see attached*
PV-120 *see attached*
Jan. 11 2021

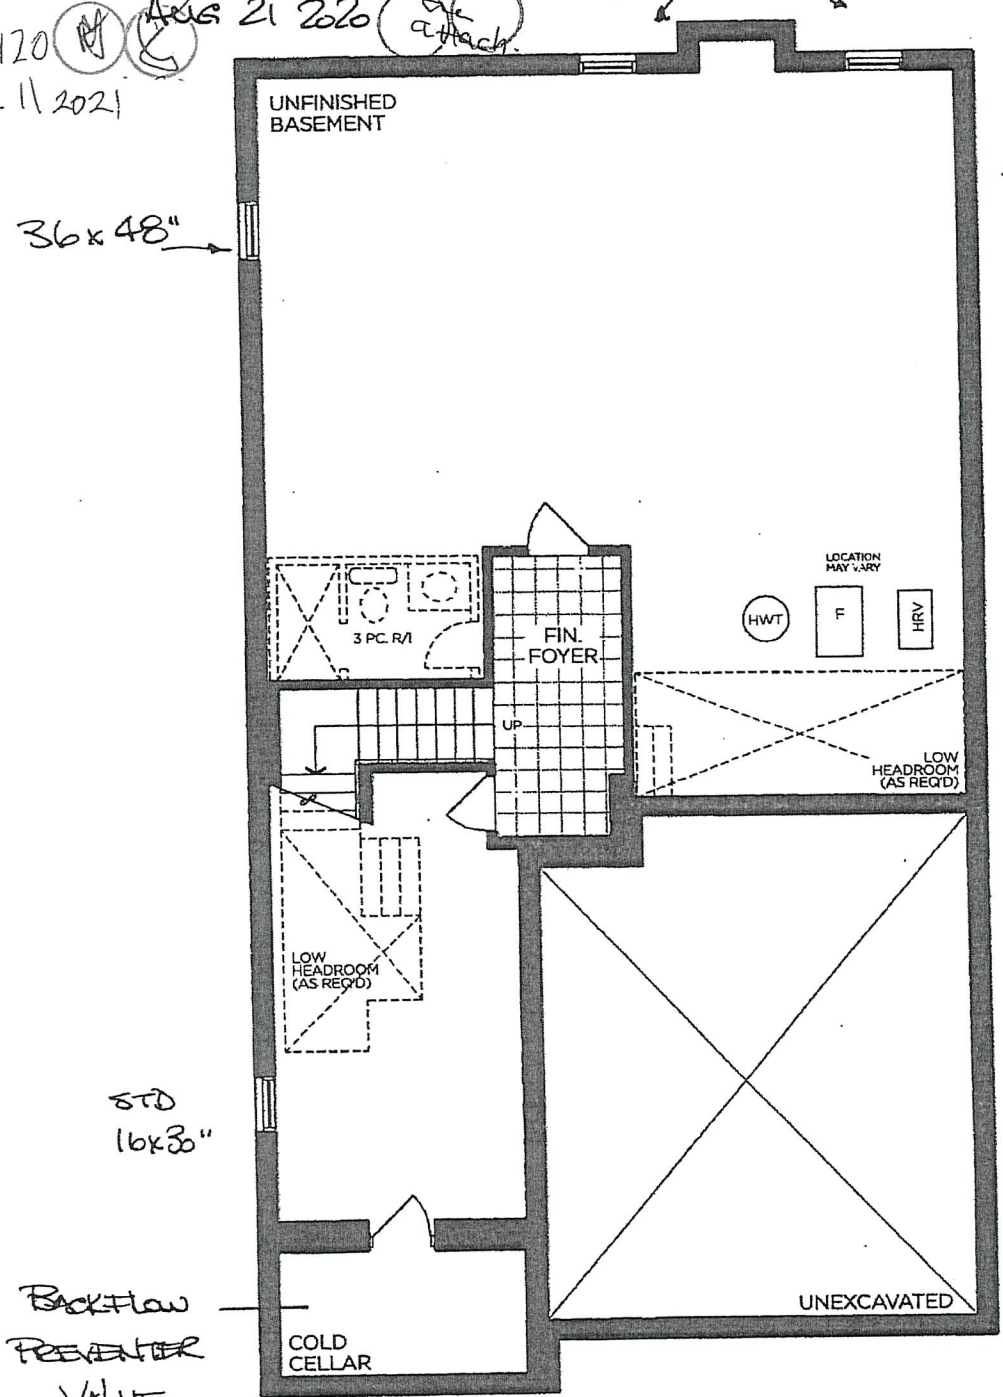

BASEMENT | ELEV. A

VENDOR

PURCHASER

PURCHASER

GOLDPARK
WORTH MORE™

Prices, figures, illustrations, sizes, features and finishes are subject to change without notice. Areas and dimensions are approximate and actual usable floor space may vary from the stated area. Layout may be reverse of the unit purchased. E. & O.E. 4002

Manhattan 'Maple Ebony'

* SLAB FURRING PANEL to CEILING.
"flush with doors"


PV-120
Jan. 11 2021

GOLDPARK HOMES
PINE VALLEY
VAUGHAN, ONTARIO
MODEL: (4002)
VALLEYVIEW

SITE STANDARD: WHITE 3/4" EXTENSION
SOFT-CLOSE DRAWERS & SOFT-CLOSE
HINGES TO KITCHEN AREA

10' CEILING - 12"H COFFERED CEILING -
M.H. = 102" + 3/4"H CONTEMPORARY
MOLDING + 5 1/4"H FURRING RAIL
+ LARGE CORNICE MOLDING TO
UNDERSIDE OF BOX

* applied - 2 panels + cut @ doors'






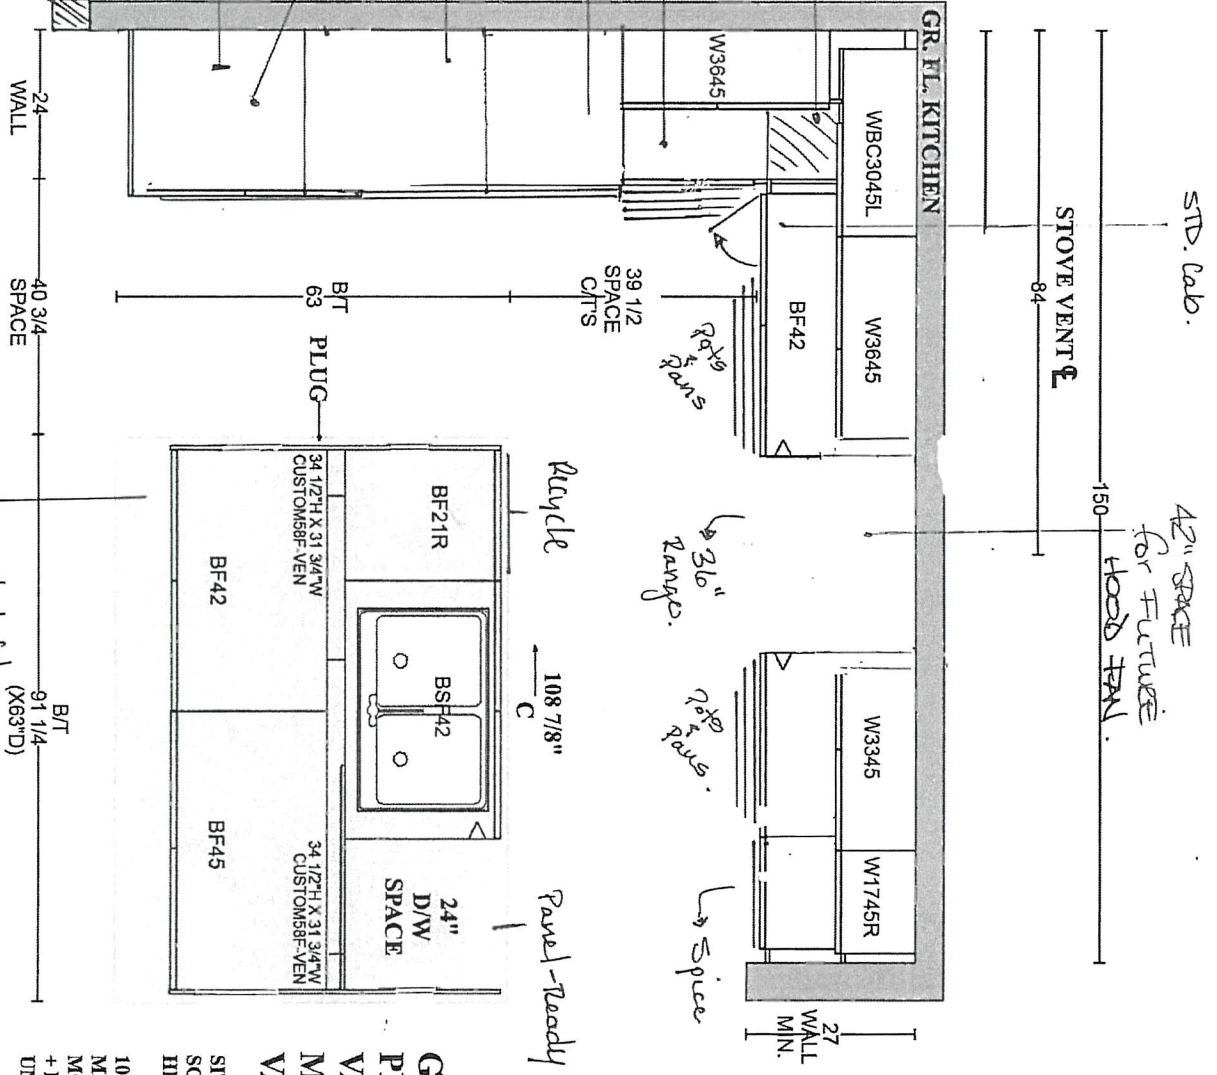


PLAN VIEW

GOLDPARK HOMES
 PINE VALLEY
 VAUGHAN, ONTARIO
 MODEL: (4002) VALLEYVIEW

SITE STANDARD: WHITE 3/4" EXTENSION
 SOFT-CLOSE DRAWERS & STANDARD SLAM DOOR HINGES
 TO VANITIES

ONE TOP DRAWER WHERE POSSIBLE THROUGHOUT EACH
 VANITY, ONE BANK OF DRAWERS WHERE POSSIBLE
 THROUGHOUT EACH MASTER ENSUITE VANITY

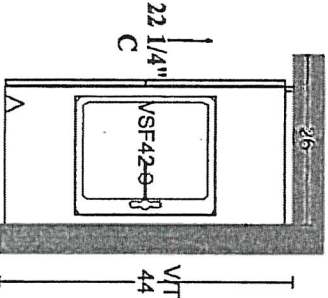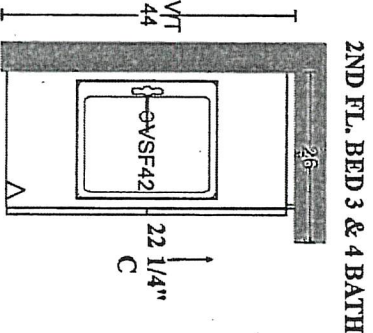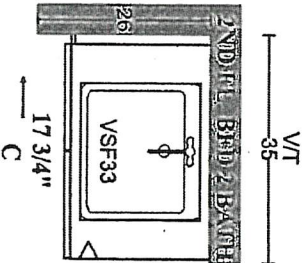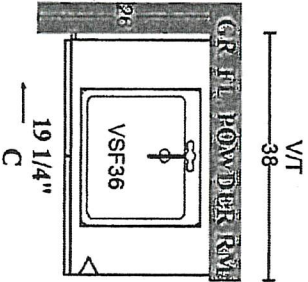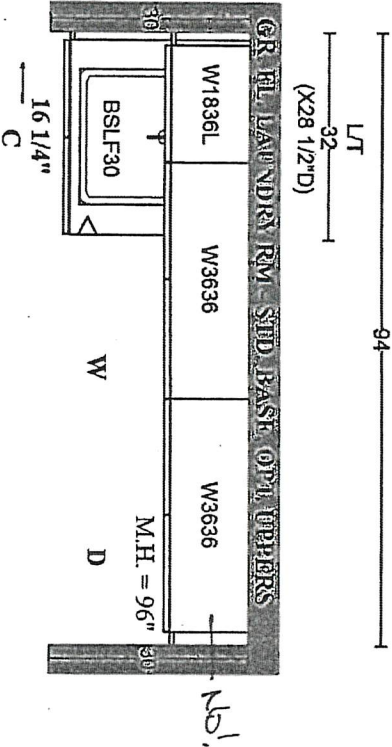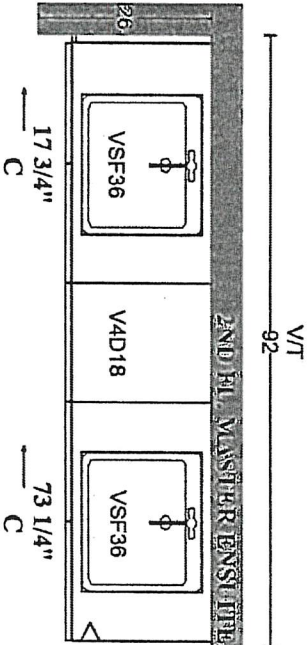

PV-120
 JAN 11 2020

STANDARD HARDWARE / KNOBS




☐ K002-02




☐ K002-03



☐ K002-04

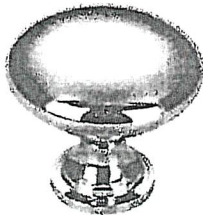

☐ K002-06

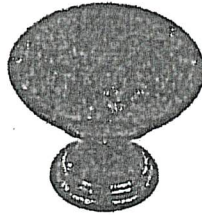

☒ K002-05

→ laundry room ✓
MASTER
POWDER
SHARED ENSUITE



☐ K002-14



☐ K024-03

☒ *NO HARDWARE

KITCHEN
+
ENSUITE 2

LOT #
120

DATE:
JAN 11 2020

SIGNATURE:

[Signature]

SIGNATURE:

[Signature]



PINE VALLEY
FOREVERGREEN


STONE COUNTERTOP EDGE PROFILES



STANDARD 2CM EASED EDGE

LOCATION:

THRU-OUT *

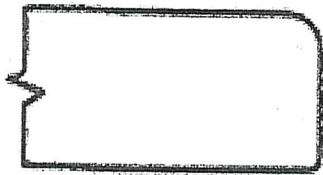


UPGRADE 3CM EASED EDGE

LOCATION:



UPGRADE 4CM MITRED EDGE

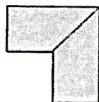

LOCATION:



UPGRADE 2CM OGEE EDGE

LOCATION:

LOT #:

120

DATE:

Jan 11 2020

SIGNATURE:

SIGNATURE:

GOLDPARK
WORTH MORE



Project: Pine Valley

Lot: 120

Purchaser(s): Loisimo Stalteri & Fabio Sammarco

Standard Hood Fan Deletion

We acknowledge that the builder's standard hood fan will not be installed.
Do not supply, install and/or credit. We will install our own hood fan after closing.

Signature: _____

Signature: _____

Date: January 11, 2021






PINE VALLEY
FOREVERGREEN

PLUMBING UPGRADES


MOEN - ALIGN

Eco-Performance Posi-Temp Tub/Shower Faucet

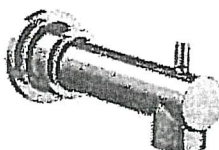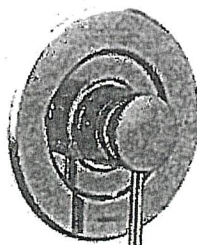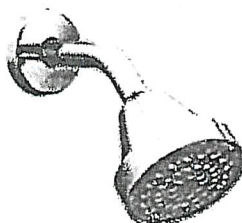

- ☐ CHROME (EP)
☒ BRUSHED GOLD (BG)
☐ MATTE BLACK (BL)

MODEL: T2193EP Shower/Tub Trim / 62320 1/2" CC Valve / 226651 (BG, BL) Shower Arm from Ceiling

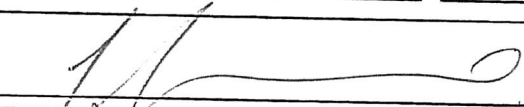Lot# 120	Date: JAN 11 2020	Room: ENSUITE 2.
Signature: 		
Signature: 		

GOLDPARK
WORTH MORE™

EMERY RECTANGULAR UNDERMOUNT SINK

- ☐ 4220CGY Undermount Sink, Soft White
- ☒ 4220CGY-077 Undermount Sink, Matte Black
- ☐ 4220CGY-088 Undermount Sink, Slate Grey

PRODUCT SPECS:

- Vitreous china
- Front overflow hole
- 8 1/4" Bowl depth
- Template and mounting hardware supplied

DIMENSIONS:

Outer:

545mm W x 355mm D x 210mm H
21 1/2" W x 14" D x 8 1/4" H

Inner:

495mm W x 305mm D x 160mm H
19 1/2" W x 12" D x 6 1/4" H


COMPLIANCE CERTIFICATIONS

Meets or exceeds the following:



- IAPMO cUPC
- ASME A112.19.2 / CSA B45.1

SHIPPING

Cube 1.85
GW 20 lbs

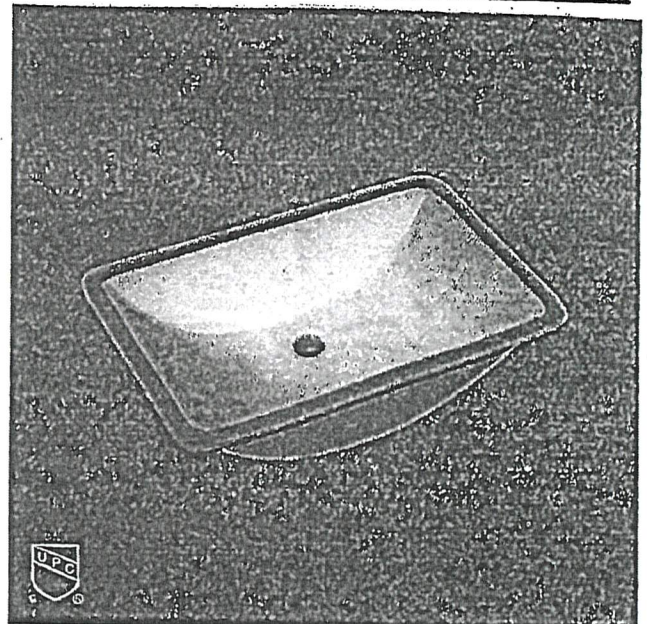


NOTES: Dimensions of fixtures are nominal and may vary within the range of tolerances established by ASME standard A112.19.2. These measurements are subject to change or cancellation. No responsibility is assumed for use of superseded or voided pages.

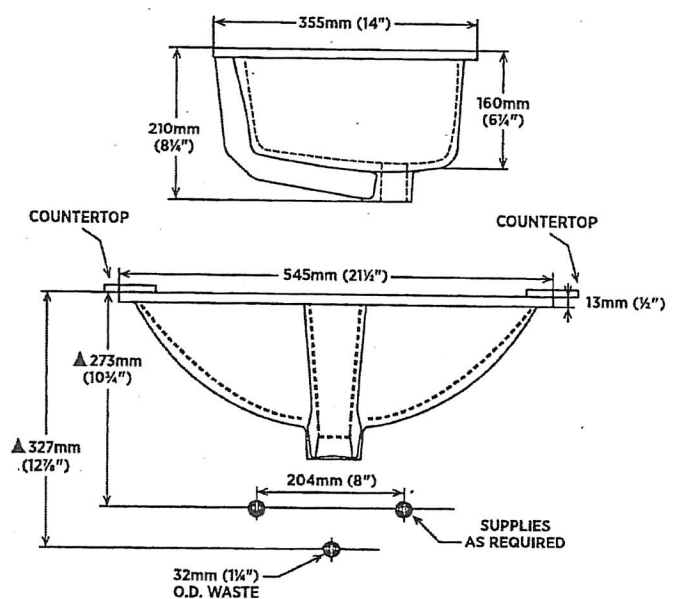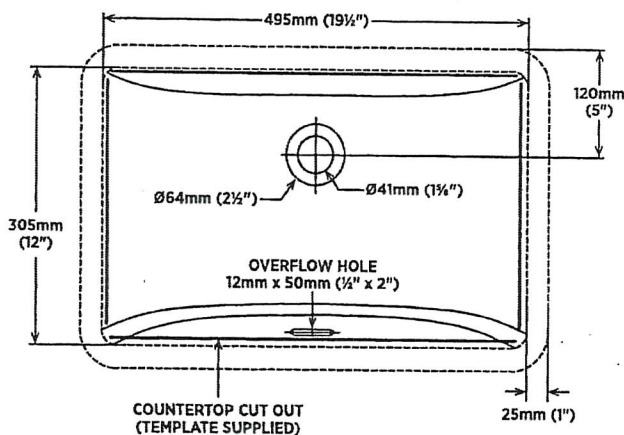

Lot#
PV-120

Room:
ENSUITE 2.

Date:
January 11, 2021

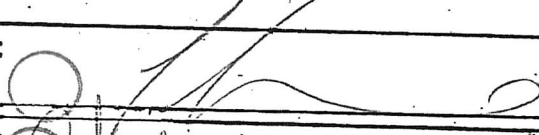
Signature: 

Signature: 

BATHROOM ACCESSORIES



Tissue Holder
Mason - Chrome


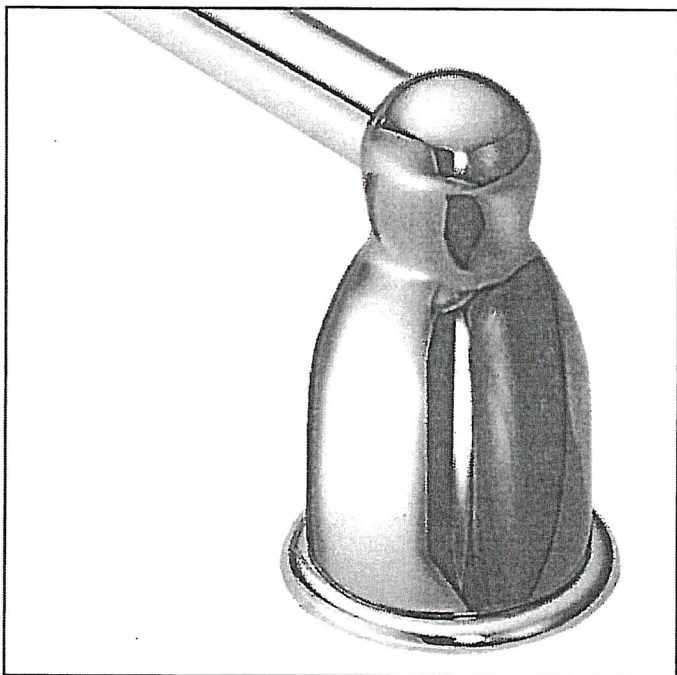



Towel Bar
Mason - Chrome

**please select one below:*

☐ INSTALL STANDARD BATHROOM ACCESSORIES THRU OUT
(tissue holder + towel bar) **location as per vendors discretion**


☒ ***DO NOT*** INSTALL STANDARD BATHROOM ACCESSORIES
THRU OUT **tissue holder + towel bar will not be provided**

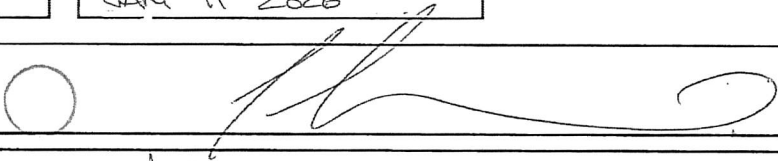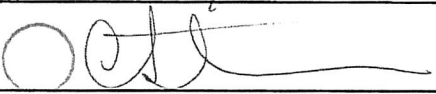LOT # PV - 120	DATE: Jan 11 2020
SIGNATURE: 	
SIGNATURE: 	

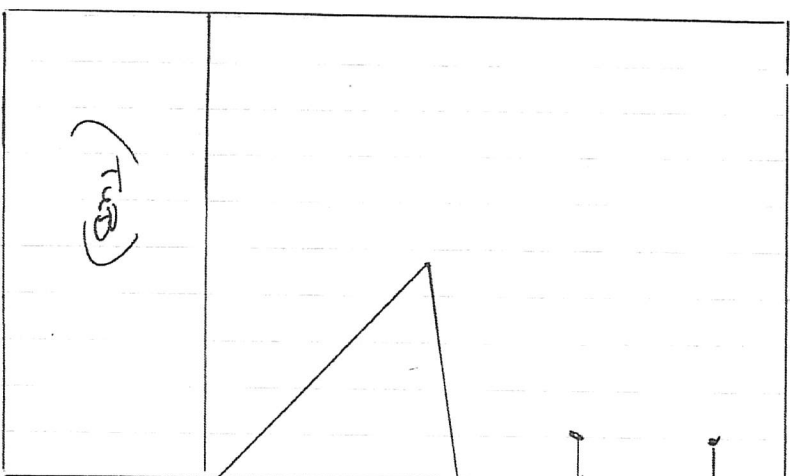

2x8" AC
Acrylic white Glossy

Grout: charcoal (→ floor + wall)

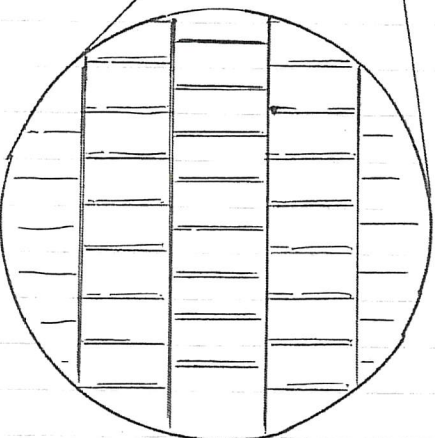

VERTICAL BRICK PATTERN

RV-120

EXHIBIT 2

TILE PATTERN - WALL

JAN. 11 2020

