


- DEVELOPMENT ENGINEERING DEPARTMENT
GRADING PERMIT APPROVAL
- DATE RECEIVED: **May 13**, 2020
- GRADING: **APPROVED**
By Nino Perez at 4:36 pm, May 27, 2020

Date: April 22/20 Reviewed By: M.R.C.

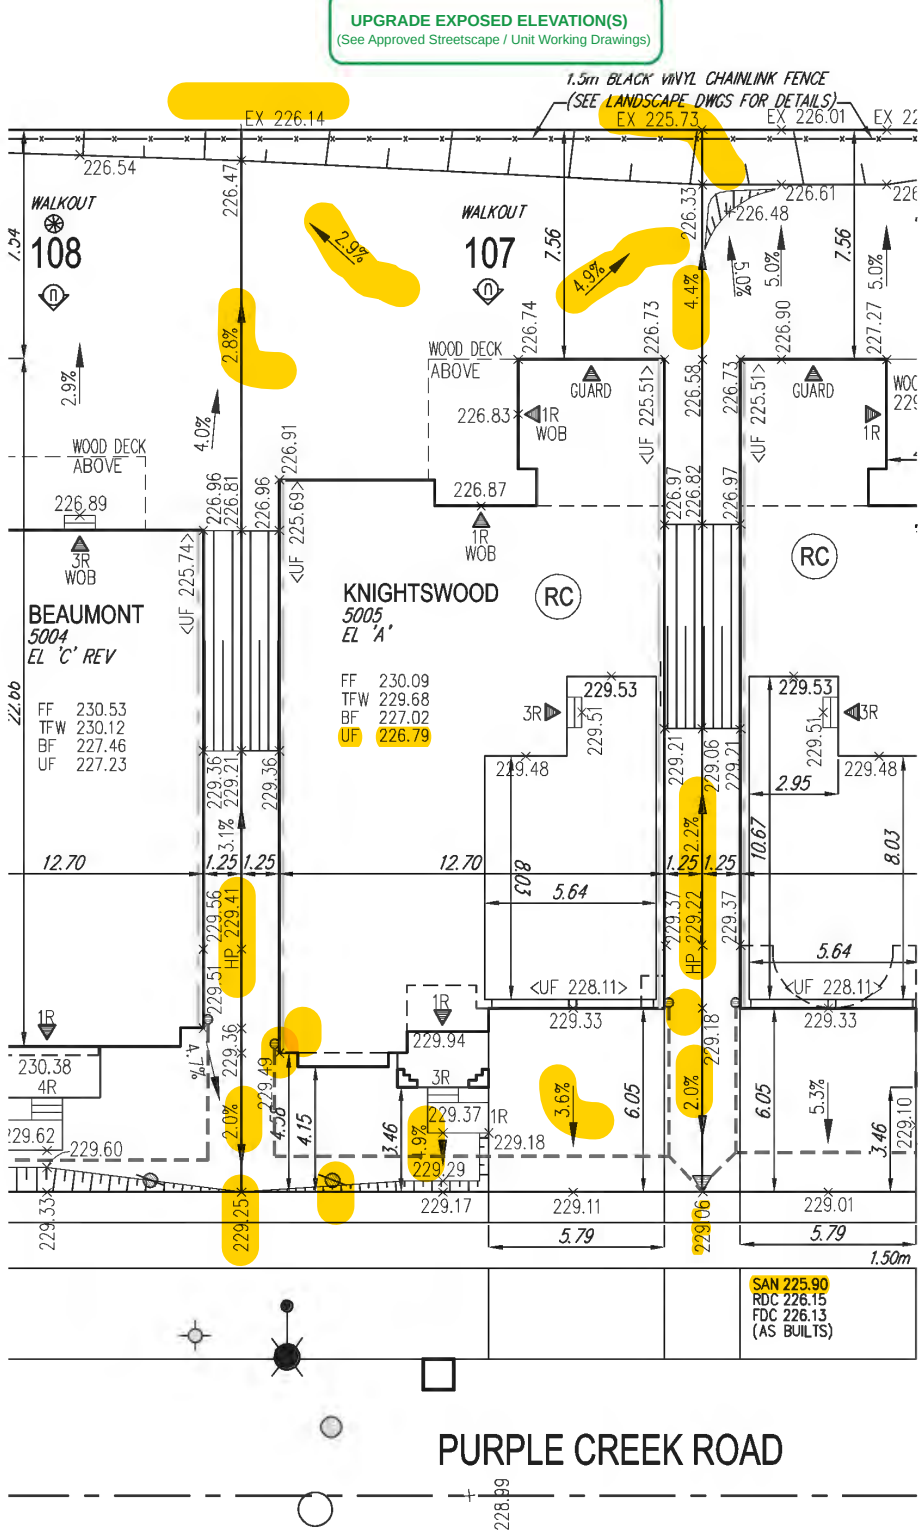

- 8966 Woodbine Ave, Markham, ON L3R 0J7 T 905.737.5133 F 905.737.7326