



















GOLDPARK

WORTH MORE™

CONSTRUCTION SUMMARY

Lot: 129

Model: 40.02 B VALLEYVIEW

Project/Phase: Pine Valley Forevergreen / 1

PLUMBING

Invoice	Qty.	Description
2203  03Nov20 NoCat	1	.BACK-FLOW PREVENTER VALVE
2524  14Jan21 NoCat	1	POWDER ROOM: MOEN ALIGN 8" CC MATTE BLACK FAUCET  SEE ATTACHED SPEC
2524  14Jan21 NoCat	1	MASTER ENSUITE: UPGRADE RAINSHOWER + HAND SHOWER TO MOEN 'ALIGN' MATTE BLACK **DIFFERENCE IN PRICE FROM '90*' IN STRUCTURAL ORDER
2524  14Jan21 NoCat	2	MASTER ENSUITE: MOEN ALIGN 8" CC LAV FAUCET - MATTE BLACK
2524  14Jan21 NoCat	1	MASTER ENSUITE: 4 PC TUB FILLER WITH H.S. MOEN ALIGN MATTE BLACK
2524  14Jan21 NoCat	1	KITCHEN: MOEN 'NIO' PULL DOWN FAUCET -BLACK WITH GOLD HANDLE
2524  14Jan21 NoCat	1	KITCHEN: BLANCO PRECIS U SUPER SINGLE

PLUMBING FIXTURES

Invoice	Qty.	Description
2326  03Nov20 NoCat	1	.MASTER ENSUITE: UPGRADE TO MOEN '90*' POSI-TEMP 3-FUNCTION RAIN SHOWER (from ceiling) + HAND SHOWER AND SLIDE BAR - CHROME #7S2712EP/3372/TS4172/62320/S3879EP/A721

STAIR AND RAILINGS

Invoice	Qty.	Description
2524 100,275 14Jan21	2	MAIN STAIRS - 2ND FLOOR TO BASEMENT: ADD FOR PAINT GRADE MATERIAL (RISERS + STRINGERS) - UPG - PAINT GRADE  SPLIT FINISH
2524 93,780 14Jan21	2	MAIN STAIRS - 2ND FLOOR TO BASEMENT: UPGRADE - EURONLINE (ALL PLAIN) PICKET, 3" HALF-ROUND W/V-GROOVE HANDRAIL, 3 1/2" ALL SQUARE POST WITH PYRAMID TOP POST CAP - PACKAGE A-2

TRIM AND DOORS

Invoice	Qty.	Description
2524  14Jan21 NoCat	1	SHARED ENSUITE: DO NOT INSTALL STANDARD WIRE "TOWEL SHELVES" - LEAVE OPEN FOR FUTURE SHELVING

DisciplineMS.rpt 26jun20

Page 9 of 9  
Printed and Sent: 01-Feb-21


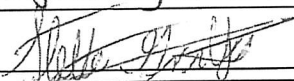
PV - 129 Cabinetry Schedule



ROOM	DESCRIPTION	PRICE	QTY	TOTAL
POWDER ROOM	UPGRADE FROM S2-S6: <i>WINSETT 'PITCH BLACK'</i>		1	
	STANDARD HARDWARE: 'K002-05'		1	
MASTER ENSUITE	UPGRADE FROM S2-S4: <i>MANHATTAN WHITE OAK 'NATURAL'</i>		1	
	UPGRADE HARDWARE: 'BH-081-03'		1	
KITCHEN	UPGRADE FROM S2-S6: <i>MEDIO 6 'OYSTER'</i>		1	
	UPGRADE HARDWARE PACKAGE: 'BH-081-03' *IN BLACK		1	
	UPGRADE HARDWARE PACKAGE: 'BAH-083-03' *IN BLACK		1	
	LIGHT VALANCE BUNDLE		1	
	CONVERT STD UPPER AND BASE CABINETS INTO A TALL DEEP PANTRY		1	
	ADD DÉCOR PANELS FOR COLUMN STYLE FRIDGE/FREEZER		1	
	CONVERT STD FULL HEIGHT DOOR CABINET TO BASE MICROWAVE DRAWER CABIN			
	WITH STD WHITE DRAWER		1	
	ADD DECORATIVE RANGE HOOD CABINET - 'ASPEN MODERN HOOD' + INCLUDES 'CIRRUS' TRIM AT BASE		1	
	CONVERT STD UPERS TO 49-1/2" UPERS + STANDARD CROWN MOULDING + FURRING RAIL		1	
ISLAND	UPGRADE FROM S2-S4: <i>MANHATTAN WHITE OAK 'NATURAL'</i>		1	
	ADD DISHWASHER DÉCOR PANEL		1	
	ADD PULL-OUT 2-BIN BASE RECYCLING CENTER TO A FULL HEIGHT DOOR BASE CABINET		1	
	ADD TOUCH LATCH AT THE REAR OF THE ISLAND CABINETS		1	
	RETURN TRIP FOR HARDWOOD		1	
	ADD CAMDEN - PROUD FURNITURE KICK AT THE REAR OF THE ISLAND + SIDES		1	
CABINETRY TOTAL:				

ok

LOT #:
PV-129

DATE:
January 8, 2021

SIGNATURE:

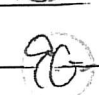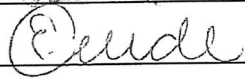

SIGNATURE:





PINE VALLEY  
FOREVERGREEN

Amended January 27th, 2021  
PV - 129 Cabinetry Schedule

ROOM	DESCRIPTION	PRICE	QTY	TOTAL
KITCHEN	ADD ITEM: CONVERT BASE CABINET INTO BASE POTS AND PANS DRAWER	990.00	2	\$ 1,980.00
				\$ 1,980.00
CABINETRY TOTAL:			\$	1,980.00

LOT #: PV-129	DATE: Jan. 27, 2021
---------------	---------------------

SIGNATURE: <u>see attached</u>
--------------------------------

SIGNATURE:
------------

GOLDPARK  
WORTH MORE™

REVISED:  
1/27/2021 10:35



Purchaser: Stephen P Guida

Property: 129 of Plan -

Telephone Res. / Bus: /

Project: Pine Valley Forevergreen - Phase 1

Decor Advisor: Yolande Somerville

Model and Elevation: 40.02 B VALLEYVIEW

Layout Changes: ☐ Yes ☒ No

Sketch Attached: ☐ Yes ☒ No

Exterior Colour Scheme:

### 1. Cabinetry

	Style and Colour	Counter	Hardware
Kitchen / Breakfast	2-tone	*Quartz: Eternal Statuario	attached
Laundry Room	Chesapeake 'Classic White'	P-Lam: Std White	attached
Powder Room	*Winset 'Pitch Black'	*Quartz: Eternal Statuario	attached
Master Ensuite Bathroom	*Manhattan 'White oak natural'	*Quartz: Pure White	attached
Second Ensuite Bathroom (If Applicable)	Chesapeake 'Classic White'	*Quartz: Pure White	attached
Shared Ensuite	Chesapeake 'Classic White'	*Quartz: Pure White	attached

#### Comment

\*Kitchen perimeter: Medio 6 'Oyster' // \*Island: Manhattan 'White oak natural'

### 2. Floor Tile

	Selection
Entrance Vestibule	*12x24" Calacatta X polished 'White'
Main Hall	
Kitchen / Breakfast	see hardwood
Laundry Room	*8x8" Marakesh Decor 'Mix 2' matte
Powder Room	*12x24" Calacatta X polished 'White'
Master Ensuite Bathroom	*Roma Hex 'Statuario'
Second Ensuite Bathroom (If Applicable)	*13x13" Sempre 'White'
Lower Landing (If Applicable)	*13x13" Sempre 'White'
Shared Ensuite	*13x13" Sempre 'White'

#### Comment



Master ensuite shower floor: 2" Hex Eterna 'Calacatta Grey' \*\*\*\*AND\*\*\* AT BACK OF SHOWER NICHE

### 3. Wall Tile

	Selection	Listello/Inserts	Describe
Master Ensuite Bathroom		<input type="radio"/> Yes <input checked="" type="radio"/> No	
Tub Deck		<input type="radio"/> Yes <input checked="" type="radio"/> No	
Shower Stall	*4X12" Picadilly 'Bianco' glossy	<input type="radio"/> Yes <input checked="" type="radio"/> No	
Bathroom Walls		<input type="radio"/> Yes <input checked="" type="radio"/> No	
Second Ensuite Bathroom (If Applicable)	*3x6" Chess 'Arctic White' polished	<input type="radio"/> Yes <input checked="" type="radio"/> No	
Shared Ensuite	*3x6" Chess 'Arctic White' polished	<input type="radio"/> Yes <input checked="" type="radio"/> No	
Kitchen Backsplash	<input checked="" type="radio"/> Yes <input type="radio"/> No	Backsplash Behind Fridge	

#### Comment

\*Quartz:slab FHBS, same as countr



Purchaser: Stephen P Guida

Property: 129 of Plan -

Telephone Res. / Bus: /

Project: Pine Valley Forevergreen - Phase 1

Decor Advisor: Yolande Somerville

Model and Elevation: 40.02 B VALLEYVIEW

#### 4. Plumbing Fixtures

Master Ensuite Bathroom  Second Ensuite  Powder Room   
Other Room - Specify  Other Washroom

##### Comment

Upgraded, see extras

#### 5. Hardwood Flooring

	Type and Stain		Type and Stain
Main Hall	<input type="text"/>	Upper Landing	<input type="text"/>
Kitchen / Breakfast	*3/4x5" wht oak wire brush 'Orion'	Upper Hall	<input type="text"/>
Living Room	<input type="text"/>	Master Bedroom	<input type="text"/>
Dining Room	<input type="text"/>	Bedroom #2	<input type="text"/>
Family Room	<input type="text"/>	Bedroom #3	<input type="text"/>
Den/Library	<input type="text"/>	Bedroom #4	<input type="text"/>
Entrance Vestibule	<input type="text"/>	Bedroom #5	<input type="text"/>
Lower Landing (If Applicable)	<input type="text"/>	Other Room - Specify	<input type="text"/>
		Thru out standard areas	*3/4x5" wht oak wire brush 'Orion'

##### Comment

#### 6. Carpeting

	Upgrade	Description
Ground Floor	<input type="checkbox"/>	<input type="text"/>
Second Floor	<input type="checkbox"/>	<input type="text"/>
<input type="text"/>	<input type="checkbox"/>	<input type="text"/>

Upgrade Underpad  Type  Area   
Capped  Runner - \*Upgrade

##### Comment

#### 7. Fireplace

	Living Room			Family Room			Other Room - Specify		
	Purchased	As Per Plan	N/A	Purchased	As Per Plan	N/A	Purchased	As Per Plan	N/A
Fireplace Type	<input type="radio"/>	<input type="radio"/>	<input checked="" type="radio"/>	<input type="radio"/>	<input checked="" type="radio"/>	<input type="radio"/>	<input type="radio"/>	<input type="radio"/>	<input checked="" type="radio"/>
Mantle Type	<input type="text"/>			Standard Gas			<input type="text"/>		
Colour / Stain	<input type="text"/>			**NONE**			<input type="text"/>		
Surround	<input type="text"/>			n/a			<input type="text"/>		
Hearth	<input type="text"/>			none			<input type="text"/>		

##### Comment

1/8 26

Purchaser: Stephen P Guida

Property: 129 of Plan -

Telephone Res. / Bus: /

Project: Pine Valley Forevergreen - Phase 1

Decor Advisor: Yolande Somerville

Model and Elevation: 40.02 B VALLEYVIEW

## 8. Trim Carpentry

Interior Doors \*Logan Front Door Glass Inserts standard Door Handles \*Halifax blk+hng

Interior Trim \*Board 4

Comment

## 9. Plaster Mouldings and Medallions

Standard Throughout ☐ Yes ☐ No ☒ N/A

Entrance Vestibule Kitchen/Breakfast

Main Hall Den/Library

Living Room Lower Landing

Dining Room Other Room - Specify

Family Room

Comment

## 10. Railings and Spindles

Railing Package \*Package A-2

Railing Colour \*Treasure Spindle Colour \*Black

Stringer / Riser \*White Treads \*Treasure

Comment

Oak Stairs ☒ Yes ☐ No ☐ N/A

## 11. Wall Paint / Ceilings

Throughout Finished Areas Cool White

Trim Paint White

Smooth Ceilings

Ground Floor ☒

Second Floor ☒

Note

Comment



Purchaser: Stephen P Guida

Property: 129 of Plan -

Telephone Res. / Bus: /

Project: Pine Valley Forevergreen - Phase 1

Decor Advisor: Yolande Somerville

Model and Elevation: 40.02 B VALLEYVIEW

## 12. Electrical

Hood Fan ☐ White ☐ Stainless ☐ N/A

Above Kitchen Cabinet Light ☐ Yes ☒ No

Below Kitchen Cabinet Light ☒ Yes ☐ No

Standard Appliances ☐

Over The Range Microwave ☐

Chimney Style Fan ☐

Comment

## 13. Heating and Air Conditioning

Air Conditioning

Gas Provisions Stove

Gas Provisions Dryer

Gas Provisions Barbecue

Comment


## 14. Additional Comments

## 15. Disclaimers and Notes

- Colours of all materials are as close as possible to builder's selection, but not necessarily identical due to variances in manufacturing.
- Any extras listed above are null and void unless accompanied by a separate invoice/amendment. Said invoice must be paid in full.
- The Purchaser acknowledges that after Interior Colour Selection form is signed and dated, no further changes will be permitted other than re-selection due to unavailability. \_\_\_\_\_ Purchaser's Initials
- The Purchaser acknowledges reading and accepting the "Gold Park Homes Decor Centre Disclaimers" form. This document contains other miscellaneous disclaimers.

This Interior Colour Selection is final and approved by:

Signature:  Date: \_\_\_\_\_

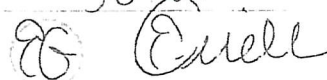



SCHEDULE 'F'

PV-129 *see email*  
 March 16 2020

PV-129  
 MAY 5 2020




# The Valleyview

## 40' SERIES

Elevation A • 3,145 sq.ft.

→ Elevation B • 3,170 sq.ft.

PV-129  
 Jan. 8 2021

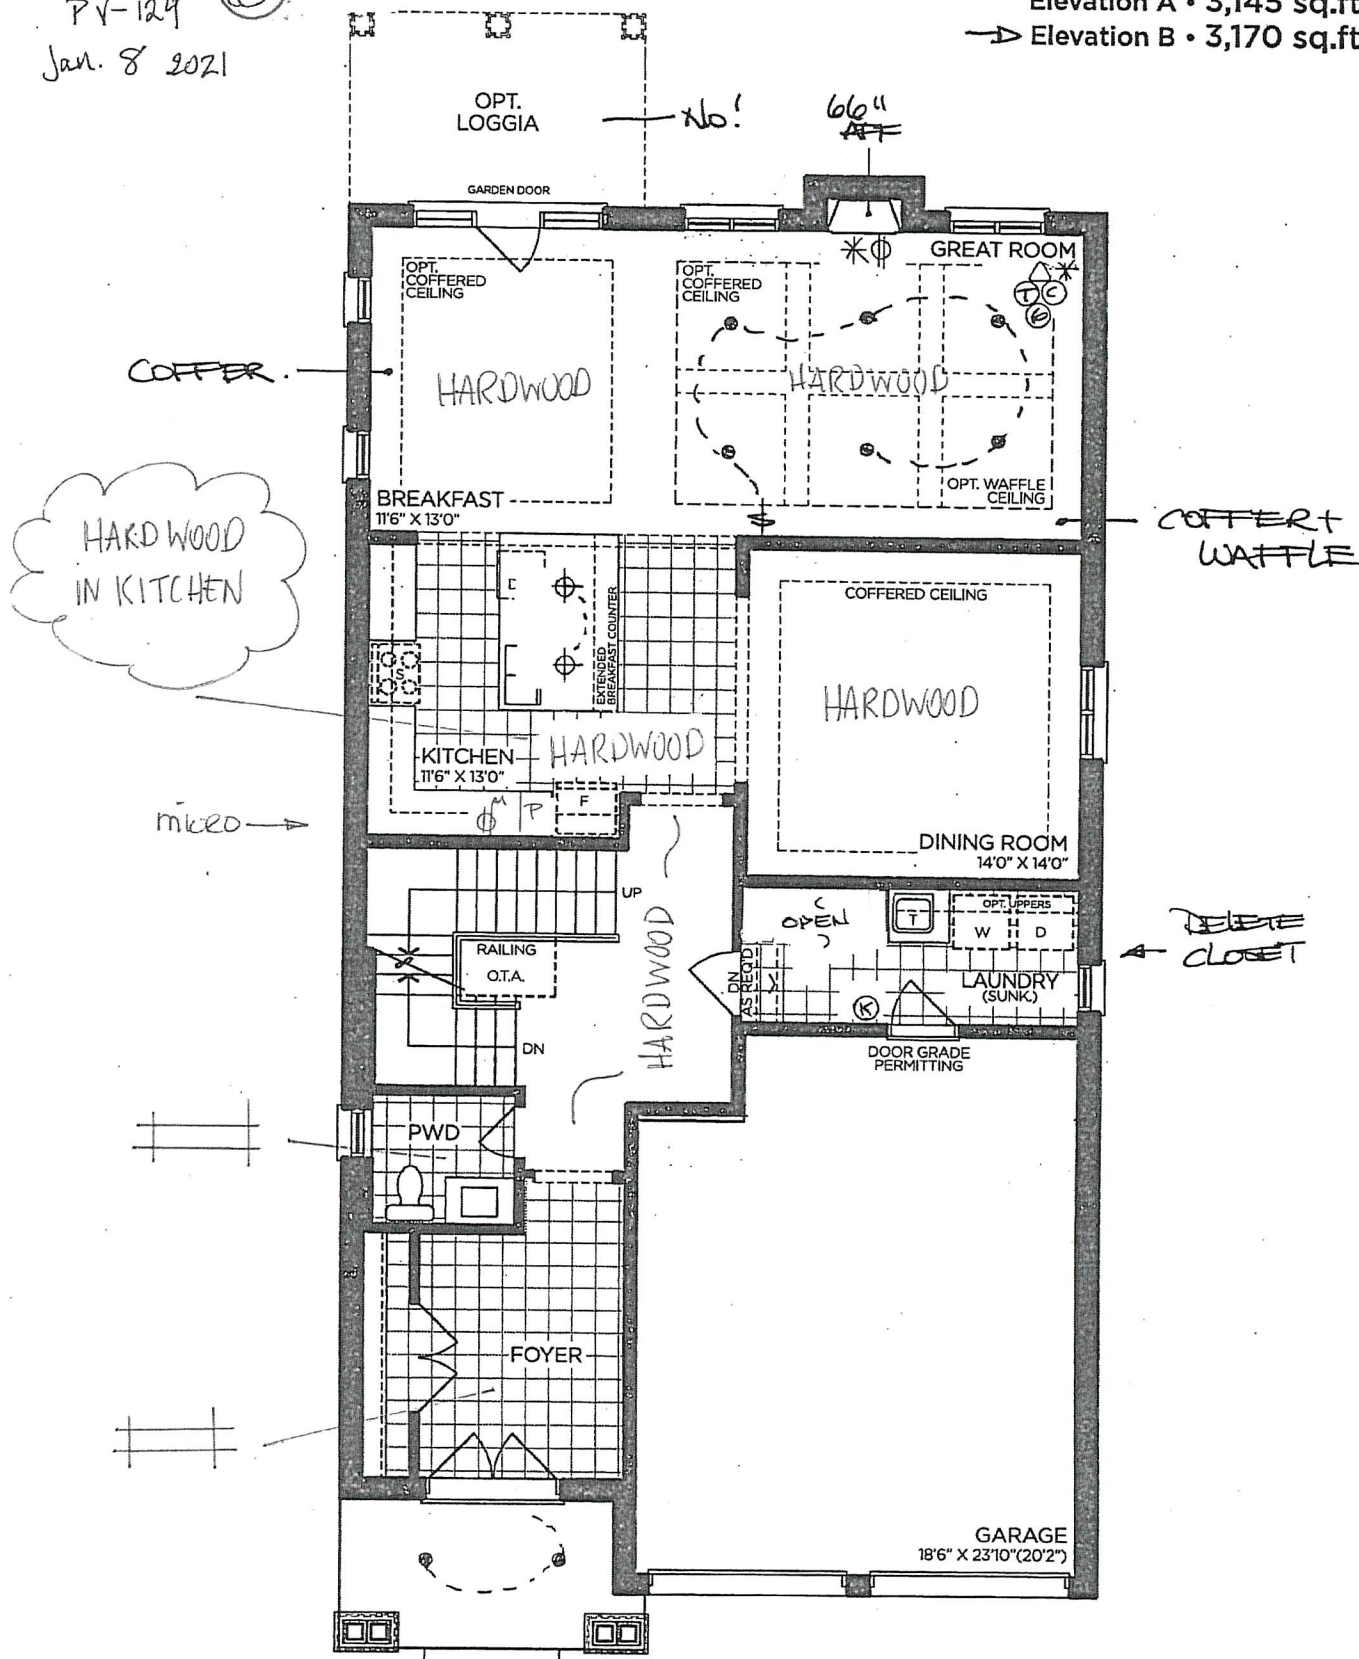

GROUND FLOOR | ELEV. A

VENDOR	
PURCHASER	
PURCHASER	

**GOLDPARK**  
 WORTH MORE™

Prices, figures, illustrations, sizes, features and finishes are subject to change without notice. Areas and dimensions are approximate and actual usable floor space may vary from the stated area. Layout may be reverse of the unit purchased. E. & O.E. 4002

SCHEDULE 'F'



PV-129  
Jan 8 2021.




PV-129 <sup>see encl</sup>  
MAR 16 2020  
PV-129 MAY 5 2020

# The Valleyview

40' SERIES  
Elevation A • 3,145 sq.ft.  
→ Elevation B • 3,170 sq.ft.

RAIN SHOWER.

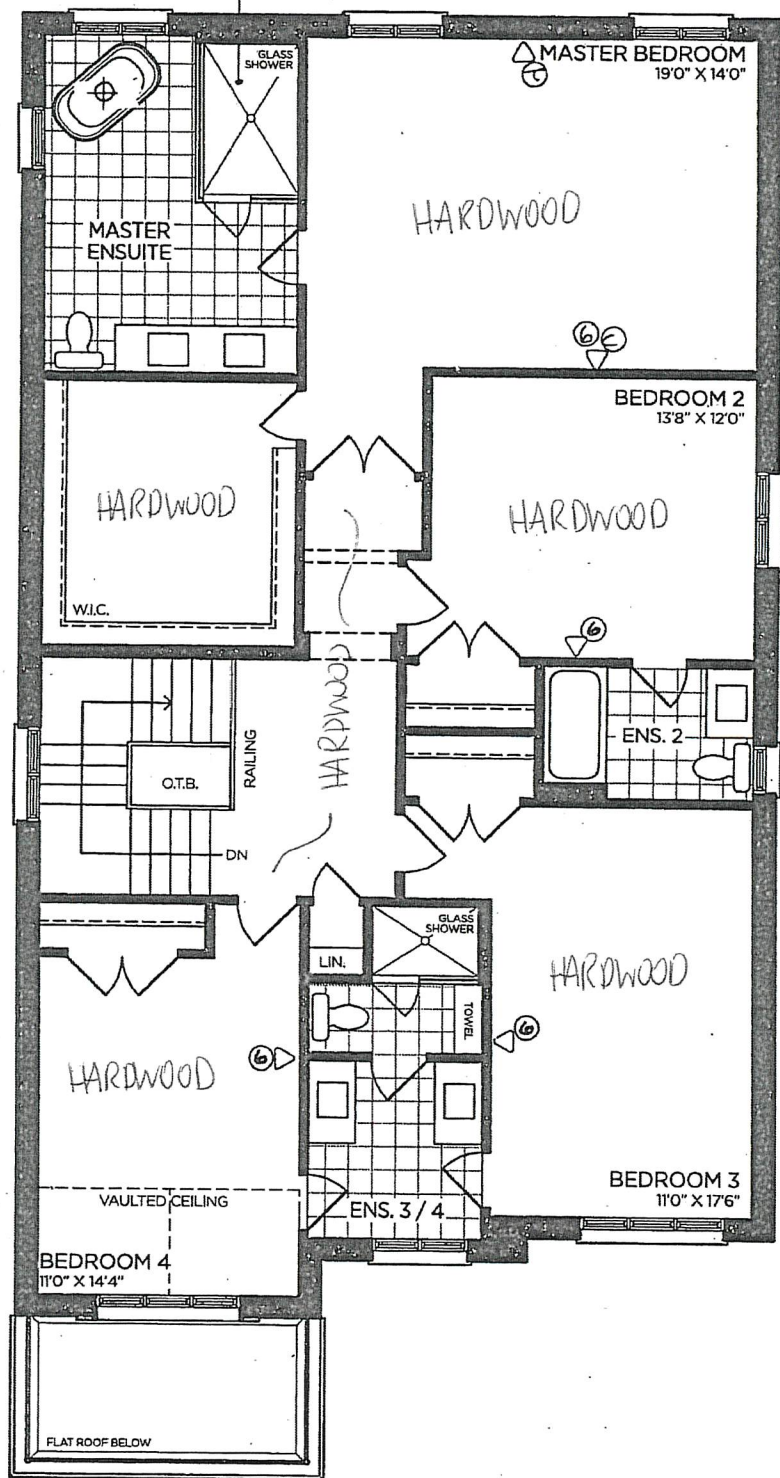

SECOND FLOOR | ELEV. A

VENDOR	<input type="text"/>
PURCHASER	<input type="text"/>
PURCHASER	<input type="text"/>

**GOLDPARK**  
WORTH MORE™

Prices, figures, illustrations, sizes, features and finishes are subject to change without notice. Areas and dimensions are approximate and actual usable floor space may vary from the stated area. Layout may be reverse of the unit purchased. E. & O.E. 4002

SCHEDULE 'F'



The Valleyview  
40' SERIES

Elevation A • 3,145 sq.ft.  
→ Elevation B • 3,170 sq.ft.

PV-129 *spe. area*  
MAR 16 2020


PV-129  
MAY 5 2020

PV-129  
Jan. 8 2021

STD 16x30"      STD 16x30"

STD 16x30"

STD 16x30"

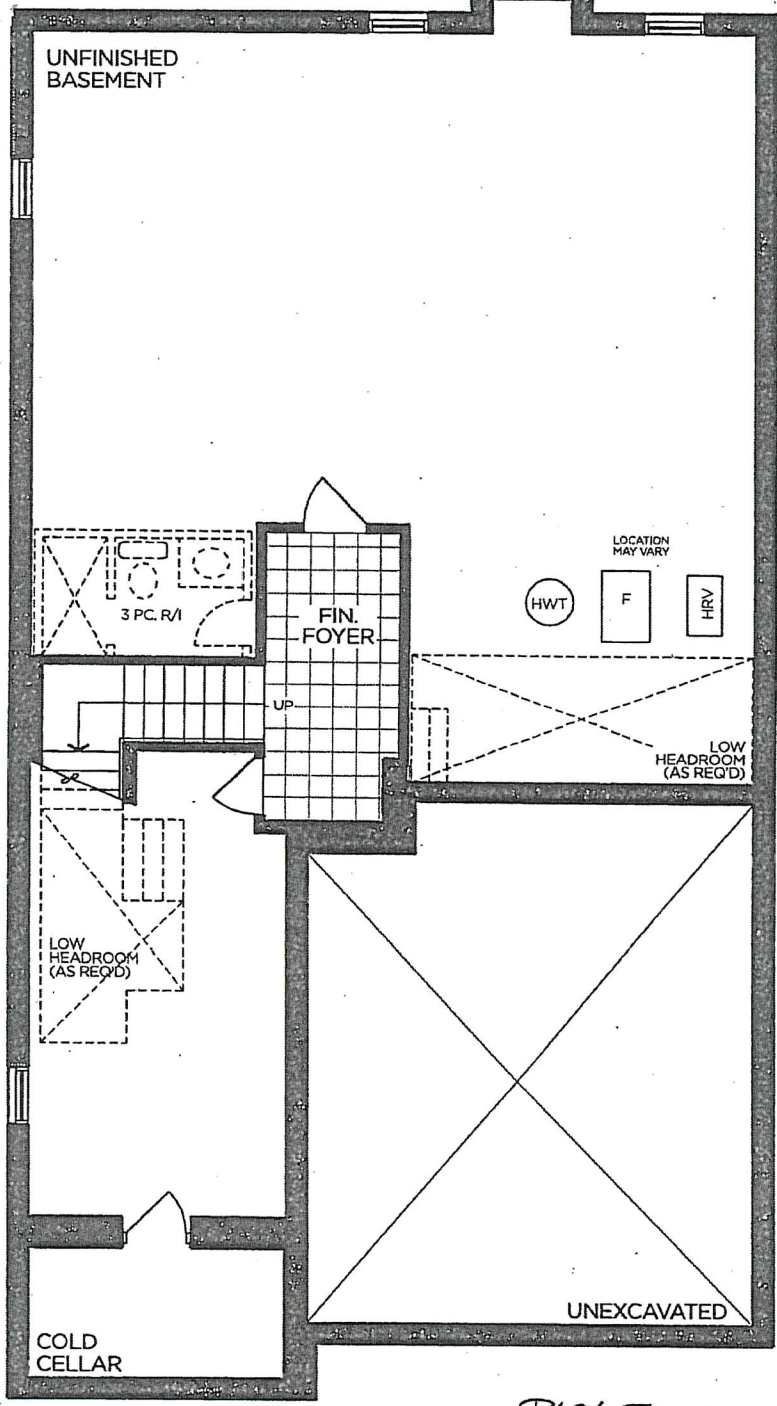

BASEMENT | ELEV. A

BACK-FLOW  
PREVENTER VALVE

VENDOR

PURCHASER

PURCHASER

GOLDPARK  
WORTH MORE™

Prices, figures, illustrations, sizes, features and finishes are subject to change without notice. Areas and dimensions are approximate and actual usable floor space may vary from the stated area. Layout may be reverse of the unit purchased. E. & O.E. 4002



PV-129  
Jan 8, 2021


\*Updated\*  
PV-129  
see attached  
Jan 27, 2021

Perimeter: Medium 6' Oyster

Island: Manhattan 'Natural White Oak'

Hardware: '64H-081-03' → \*Black.  
'64H-083-03' → \*Black.

'Aspen Modern' Decorative Hood Cabinet  
(+ CIRCUS TRIM at bottom of canopy).

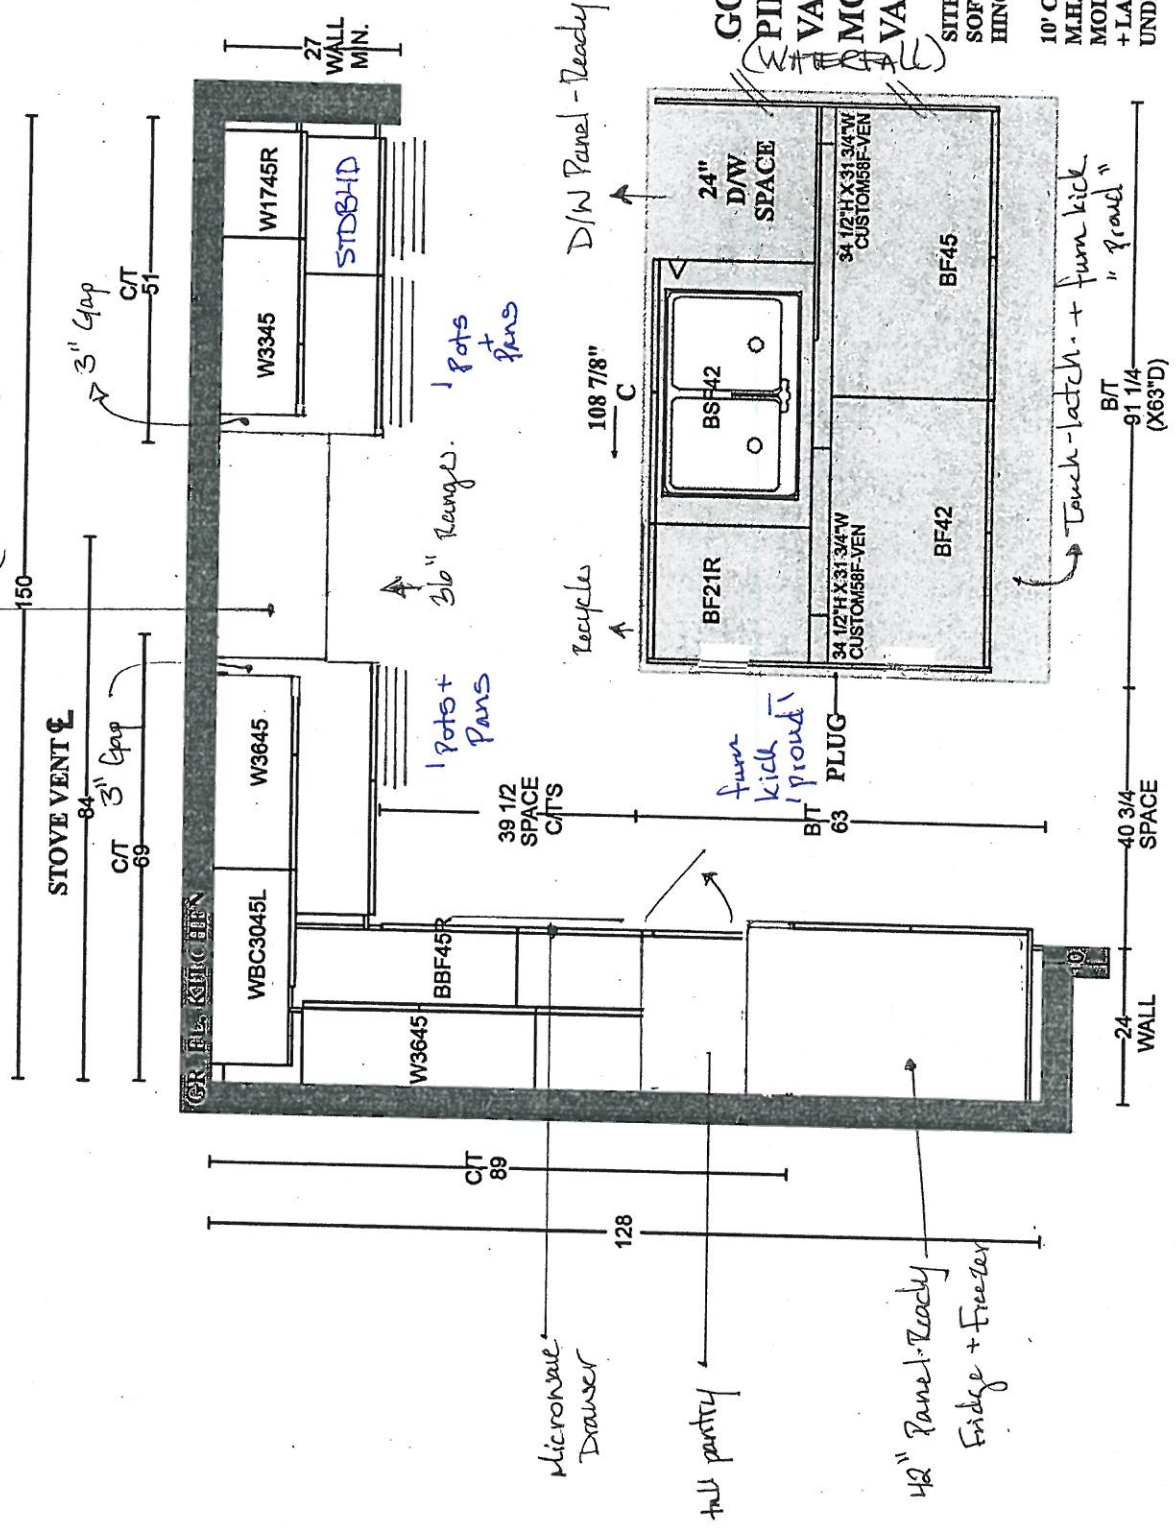

GOLDPARK HOMES  
PINE VALLEY  
VAUGHAN, ONTARIO  
MODEL: (4002)  
VALLEYVIEW

SITE STANDARD: WHITE 3/4" EXTENSION  
SOFT-CLOSE DRAWERS & SOFT-CLOSE  
HINGES TO KITCHEN AREA  
  
10' CEILING - 12"H COFFERED CEILING -  
M.H. = 102" + 3/4"H CONTEMPORARY  
MOLDING + 5 1/4"H FURRING RAIL  
+ LARGE CORNICE MOLDING TO  
UNDERSIDE OF BOX


PLAN VIEW



**GOLDPARK HOMES  
PINE VALLEY  
VAUGHAN, ONTARIO  
MODEL: (4002) VALLEYVIEW**


SITE STANDARD: WHITE 3/4" EXTENSION  
SOFT-CLOSE DRAWERS & STANDARD SLAM DOOR HINGES  
TO VANITIES

ONE TOP DRAWER WHERE POSSIBLE THROUGHOUT EACH  
VANITY, ONE BANK OF DRAWERS WHERE POSSIBLE  
THROUGHOUT EACH MASTER ENSUITE VANITY

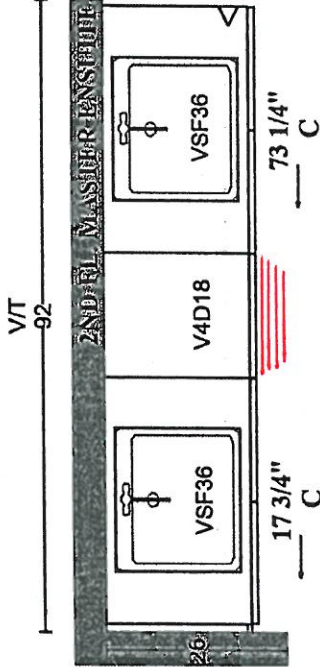


Manhattan 'White Oak Natural'


Chesapeake 'Classic White'

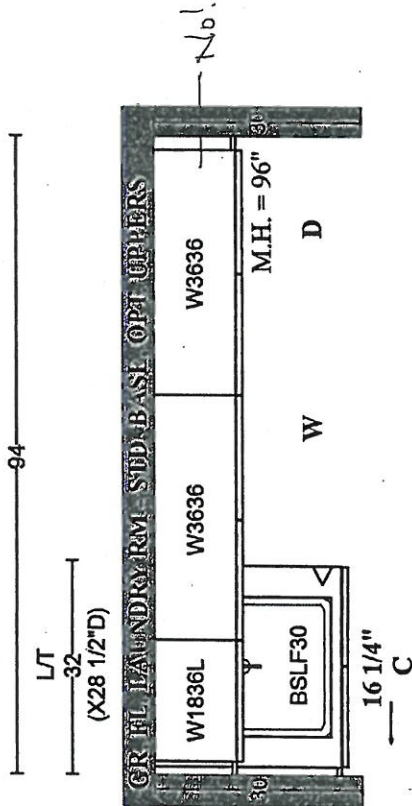


Nimbus  
'Pitch Black'

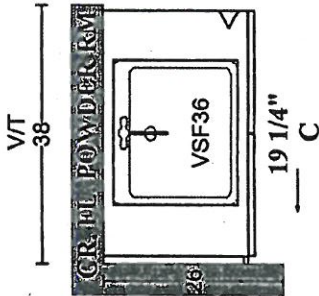

2ND FL. BED 3 & 4 BATH

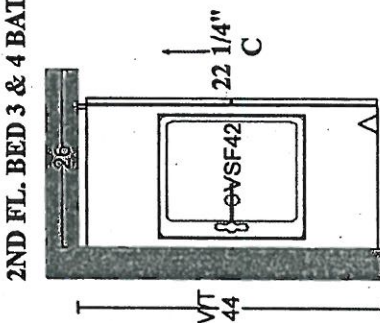

Chesapeake 'Classic White'

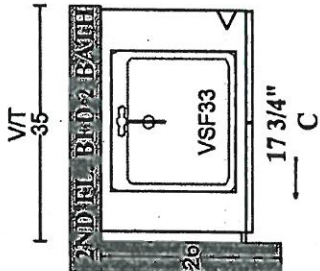

Chesapeake 'Classic White'

PV-129  
Jan 8, 2021

\*Updated \*

PV-129

Jan 27, 2020

See attached





PINE VALLEY  
FOREVERGREEN


STONE COUNTERTOP EDGE PROFILES



STANDARD 2CM EASED EDGE


LOCATION:

THRU OUT

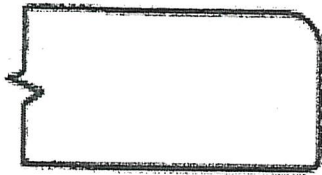


UPGRADE 3CM EASED EDGE

LOCATION:

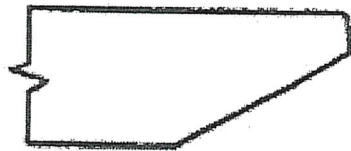

UPGRADE 4CM MITRED EDGE

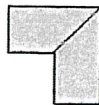

LOCATION:



UPGRADE 2CM OGEE EDGE

LOCATION:

LOT #: PV-129

DATE: Jan 8, 2021

SIGNATURE:

*[Signature]*

SIGNATURE:

*[Signature]*

GOLDPARK  
WORTH MORE

STANDARD HARDWARE / KNOBS




☐ K002-02




☐ K002-03



☐ K002-04

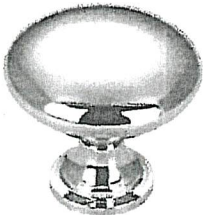

☐ K002-06

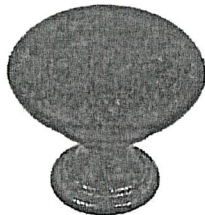

☒ K002-05

→ Laundry Room  
→ Powder Room  
→ Ensuite 2



☒ K008-14  
→ Shared Bath



☐ K024-03

☐ \*NO HARDWARE

LOT # PV-129

DATE: Jan 8, 2021

SIGNATURE: 


SIGNATURE: 

UPGRADE HARDWARE



BH-081-03

PULL HARDWARE - ~~BRUSHED NICKEL~~ BLACK  
160mm C/C

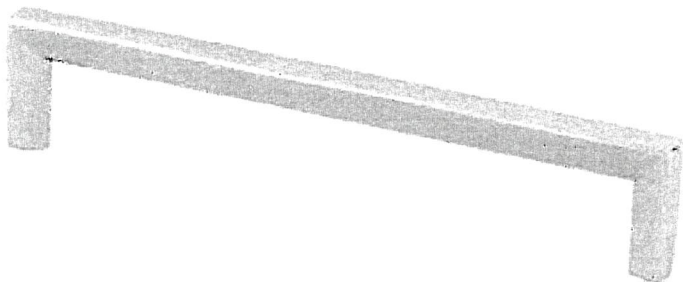

LOCATION:

→ Kitchen
→ Master Ensuite

LOT # PV-129	DATE: Jan 8, 2021
--------------	-------------------

SIGNATURE:	
------------	--


SIGNATURE:	
------------	--

UPGRADE HARDWARE



BAH-083-03

PULL HARDWARE - ~~BRUSHED NICKEL~~ BLACK  
320mm C/C

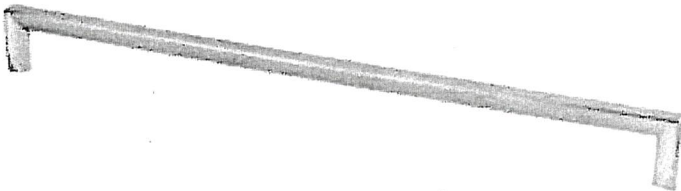

LOCATION:

Kitchen

LOT # PV-129	DATE: Jan , 2021
SIGNATURE:	
SIGNATURE:	




PINE VALLEY  
FOREVERGREEN


UPGRADE KITCHEN SINK

**BLANCO - PRECIS U SUPER SINGLE**


Silgranit - Undermount Sink  
32" x 19" x 9 1/2"

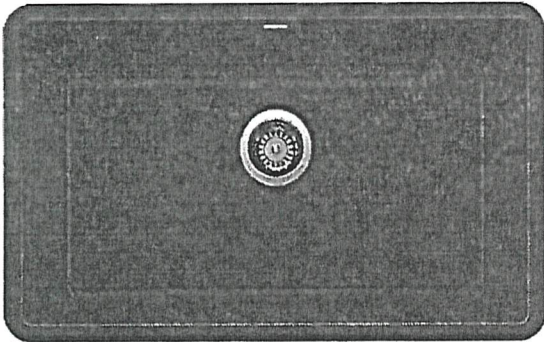


Anthracite

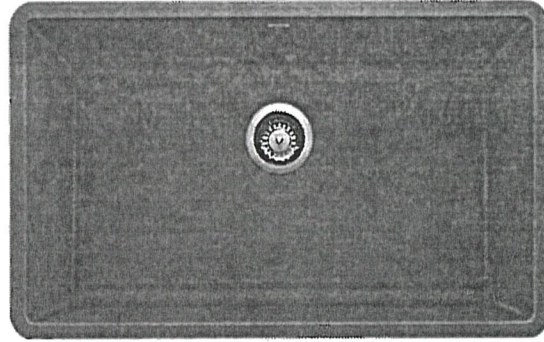

Concrete Grey

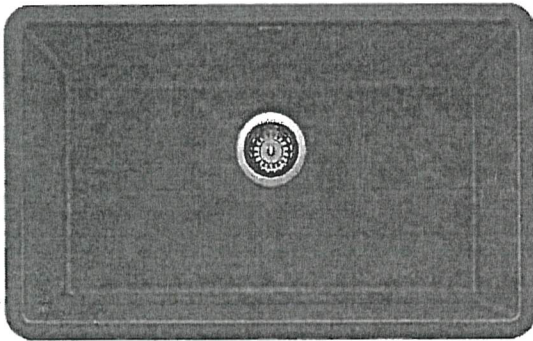

Metallic Grey

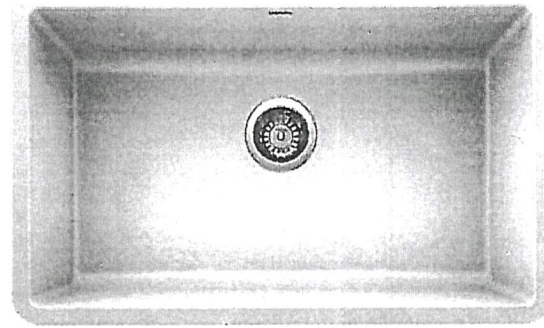

White

☒ ANTHRACITE

☐ GRID

☐ CONCRETE GREY

☐ METALLIC GREY

☐ WHITE

MODEL 400890 Anthracite / 402266 Concrete Grey / 401683 Metallic Grey /  
401820 White / 406446 Grid

Lot# PV-129

Room: kitchen

Signature:

Date: Jan 8, 2021

Signature:

GOLDPARK  
WORTH MORE™






PINE VALLEY  
FOREVERGREEN

UPGRADE KITCHEN FAUCET



MOEN - NIO

One-Handle Pulldown Kitchen Faucet

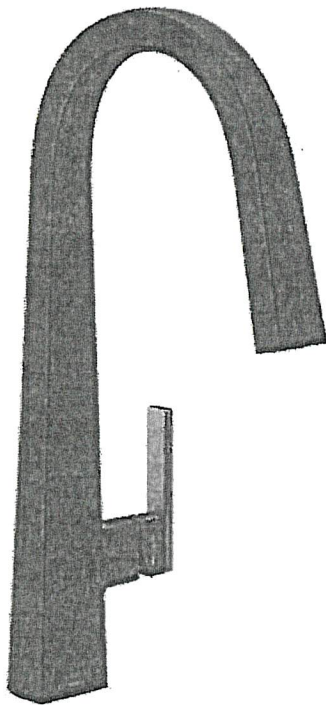

- ☐ CHROME
- ☒ MATTE BLACK / BRUSHED GOLD (BL)
- ☐ SPOT RESIST STAINLESS (SRS)

MODEL: S75005 Chrome / S75005BL Matte Black / S75005SRS Spot Resist Stainless

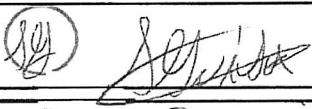Lot# PY-129	Date: Jan 8, 2021	Room: Kitchen
Signature: 		
Signature: 		




PINE VALLEY  
FOREVERGREEN

## PLUMBING UPGRADES

### MOEN - ALIGN

Two-Handle Adjustable Widespread Lav Faucet with Lift Rod Drain

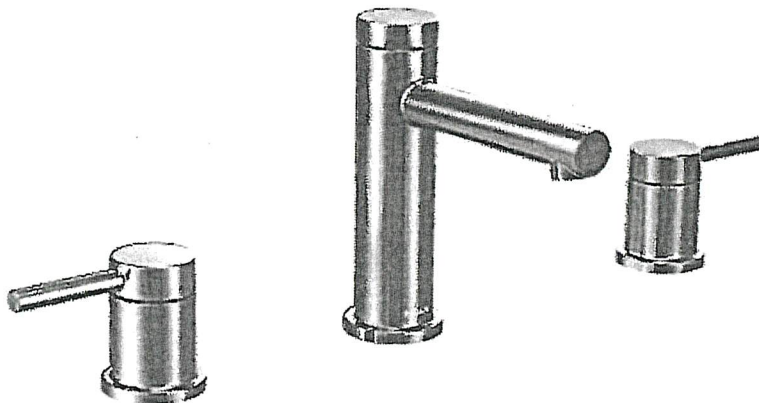

- ☐ CHROME (C)  
☐ BRUSHED NICKEL (BN)  
☒ MATTE BLACK (BL)  
☐ BRUSHED GOLD (BG)

MODEL: T6193 Lav Faucet / 69000 1/2" IPS Valve

Lot# PV-129	Date: Jan 8, 2021	Room: Powder Room
Signature:		
Signature:		

GOLDPARK  
WORTH MORE




PINE VALLEY  
FOREVERGREEN

## PLUMBING UPGRADES

### MOEN - ALIGN

Two-Handle Adjustable Widespread Lav Faucet with Lift Rod Drain

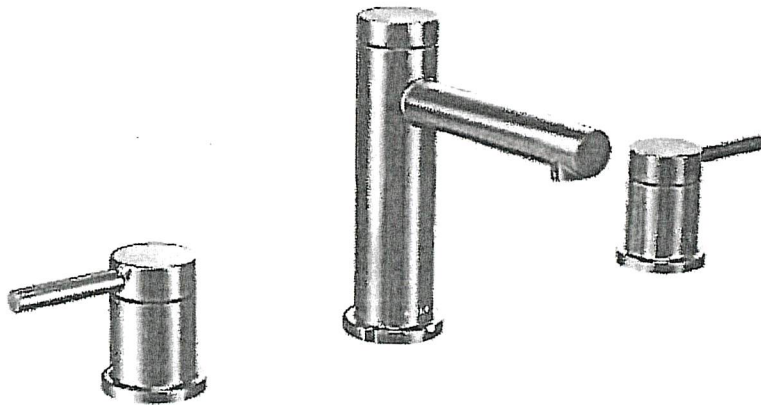

- ☐ CHROME (C)  
☐ BRUSHED NICKEL (BN)  
☒ MATTE BLACK (BL)  
☐ BRUSHED GOLD (BG)

MODEL: T6193 Lav Faucet / 69000 1/2" IPS Valve


Lot# PV-129	Date: Jan 8, 2021	Room: Master Ensuite
Signature: <i>[Signature]</i>		
Signature: <i>[Signature]</i>		

GOLDPARK  
WORTH MORE




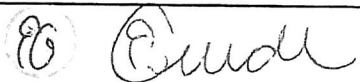
MOEN - ALIGN

Two-Handle Roman Tub Faucet with Hand Shower

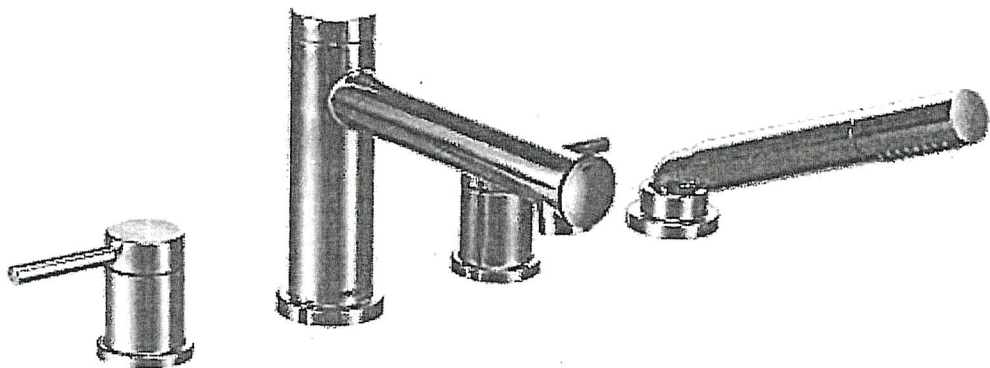

- ☐ CHROME
- ☐ BRUSHED NICKEL (BN)
- ☐ BRUSHED GOLD (BG)
- ☒ MATTE BLACK (BL)

MODEL: T394 Tub Faucet / 9796 Valve / T90331 + 140680 Tub Drain Half Kit

Lot# PV-129	Date: Jan 8, 2021	Room: Master Ensuite
Signature: 		
Signature: 		






PINE VALLEY  
FOREVERGREEN

## PLUMBING UPGRADES

### MOEN - ALIGN

Posi-Temp SHOWER ONLY\* with 3 Function Transfer Valve/Trim and Slide Bar with Handshower

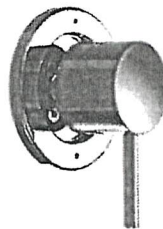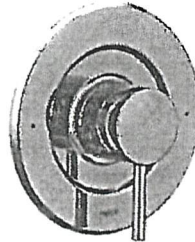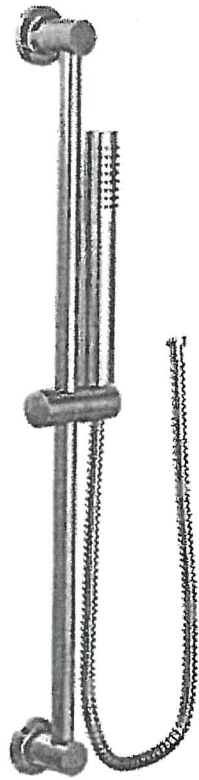

- ☐ CHROME
- ☐ BRUSHED NICKEL (BN)
- ☒ MATTE BLACK (BL)
- ☐ BRUSHED GOLD (BG)

- ☐ from WALL
- ☐ from CEILING

MODEL: T2192EP Shower ONLY\* Trim / U361CI + UT4191 Transfer Valve / 62320 1/2" CC Valve / 3887EP Handshower + A725 Drop El / \*if selected: 226651 Shower Arm (from Ceiling)

Lot# PV-129	Date: Jan 8, 2021	Room: Master Ensuite
Signature:		
Signature:		

GOLDPARK  
WORTH MORE




PINE VALLEY  
FOREVERGREEN

## UPGRADE SHOWER HARDWARE

MT6X6



Shower Door Handle

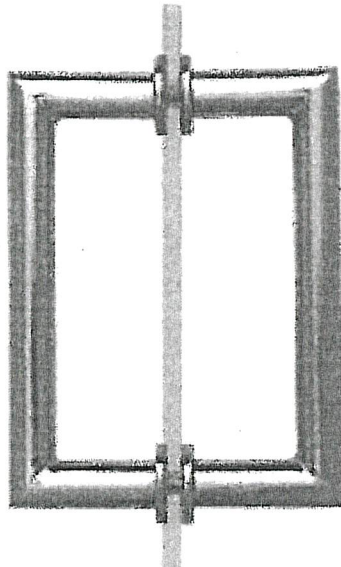

MT6X6  
Shower Door Handle


6" x 6" back-to-back  
3/4" dia. tube  
Cut and mitred corners with  
washers  
(Also available single sided)

- ☐ CHROME  
☒ MATTE BLACK  
☐ BRUSHED GOLD

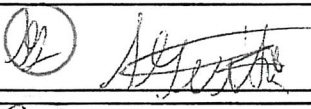
Lot# PV-129	Date: Jan 8, 2021	Room: Master Ensuite
Signature: 		
Signature: 		

GOLDPARK  
WORTH MORE

BATHROOM ACCESSORIES

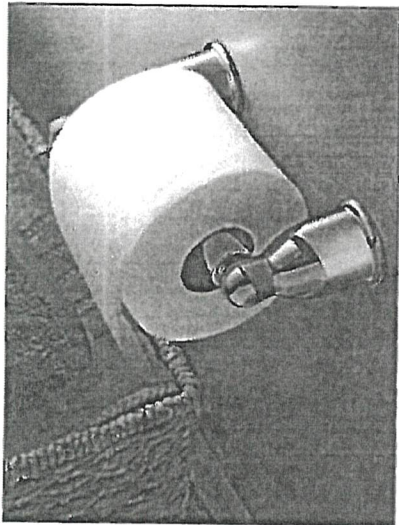

Tissue Holder  
Mason - Chrome

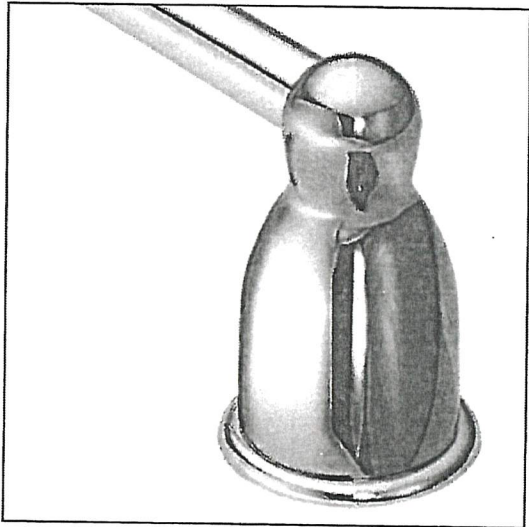


Towel Bar  
Mason - Chrome


**Please select one of the following:**

- ☐ INSTALL STANDARD BATHROOM ACCESSORIES THRU OUT  
(tissue holder + towel bar) *\*location as per vendors discretion\**
- ☒ **\*DO NOT\*** INSTALL STANDARD BATHROOM ACCESSORIES  
THRU OUT *\*tissue holder + towel bar will not be provided\**

LOT # PV-129

DATE: Jan 8, 2021

SIGNATURE: 

SIGNATURE: 



Project: Pine Valley

Lot: 129

Purchaser(s): Stephen Guida

Standard Hood Fan Deletion

We acknowledge that the builder's standard hood fan will not be installed.  
Do not supply, install and/or credit. We will install our own hood fan after closing.

Signature: 

Signature: 


Date: January 8, 2021


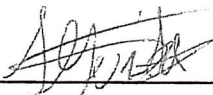

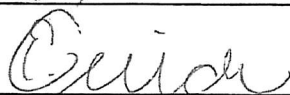




UPGRADE KITCHEN EXTRA

ASPEN MODERN HOOD

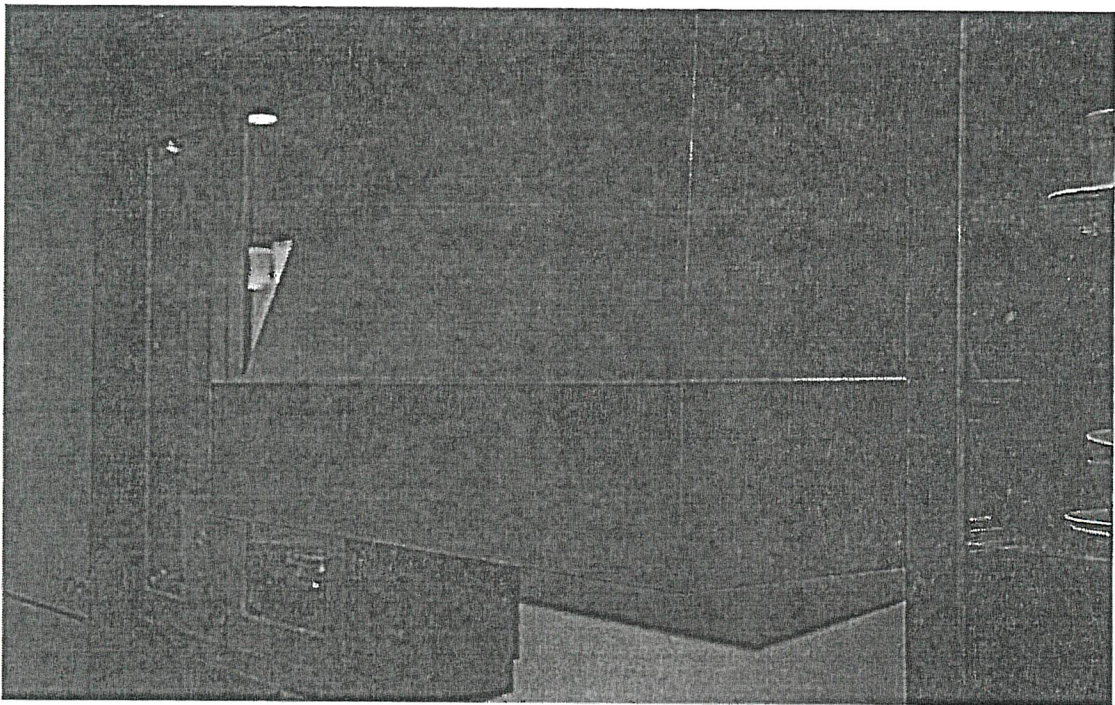
(Insert fan not included)



LOT # PV-129	ROOM: Kitchen	DATE: Jan 8 ,2021
SIGNATURE:  		
SIGNATURE:  		

PR-129    
Jan. 8 2021

Café™ 36" All Gas Professional Range  
with 6 Burners (Natural Gas)  
CGY366P4MW2 /CGY366P2MS1 / CGY366P3MD1

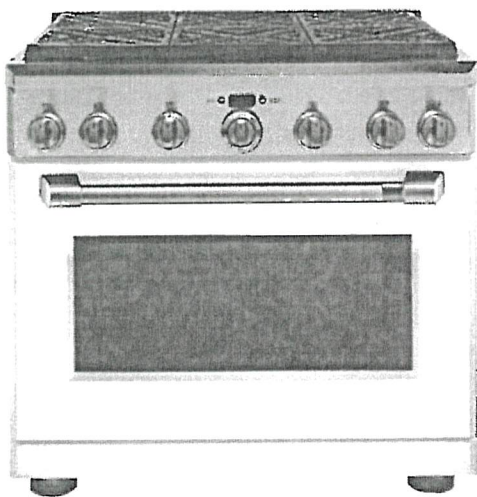

ALSO  
AVAILABLE IN

 CGY366P2MS1  
Stainless Steel  
with Brushed  
Stainless handle  
and knobs

 CGY366P3MD1  
Matte Black  
with Brushed  
Stainless handle  
and knobs



FEATURES & BENEFITS

Whip up an unforgettable meal with a **professional oven system** that combines reverse-air convection technology with an infrared broil and gas burner to provide superb baking results and fast preheating.

Enjoy a full range of heat settings from ultra-low simmers to intense boils, with six sealed **18K BTU dual stack burners**.

Experiment with every cuisine with reversible burner grates that are flat on one side and contoured on the other to accommodate round-bottom cookware like woks.

Bake more batches at once with a **6.2 cu. ft. capacity caterer's oven** that can fit up to three full-size sheet trays.

Smoothly slide heavy roasts in and out of the oven with **full-extension, heavy-duty roller racks** that can also stay in the oven during self-cleaning cycles.

Confidently cook over a steady flame with the **electronic ignition's automatic reignition** feature that instantly revives any accidentally extinguished flames.

Observe sacred days with **Star-K certification**.

APPEARANCE	
Color Appearance	Matte White
Cooktop Burner Grate Color	Matte Black
Oven Door Features	Big Clear View Oven Window
Handle Design	GE Café
Control Knobs	Dishwasher Safe; Professional-Style


FEATURES	
Configuration	6 Burners
Cooking Technology	Convection
Oven Cleaning Type	Self-Clean
Burner - Left Front	18,000 BTU
Burner - Left Rear	18,000 BTU
Burner - Right Front	18,000 BTU
Burner - Right Rear	18,000 BTU
Burner - Center	18,000 BTU Front / 18,000 BTU Rear
Cooktop Burner Type	Sealed
Cooktop Surface	Porcelain-Enamel; Gray
Dishwasher Safe Knobs	Yes
Control Location	Front controls
Control Type	Digital Temperature Display with Timer Display
Valves (Degree of Turn)	270
Audible Preheat Signal; Auto Oven Shut-Off with Override; Auto Self Clean; Certified Sabbath Mode; Electronic Timer; Front Controls; In-Oven Broiling; Temperature Probe; Proof Mode; Self-Clean Cool Down Time Display	
Oven Control Features	
Oven Cooking Modes	Convection Bake; Convection Broil; Convection Roast
Temperature Management System	True Temp System
Cooktop Burner Grate Features	Heavy-Cast Edge-to-Edge Grates
Cooktop Burner Grate Material	Heavy Cast
Cleaning Time	Variable
1 Self-Clean Roller Rack; 2 Self-Clean Flat Oven Racks; 5 Rack Positions	
Oven Rack Features	
Fuel Type	Natural Gas (factory set)
Ignition System	Electronic w/Auto Reignition
Leveling System	4 Leveling Legs
Style	Commercial
Oven Interior	6 Halogen; Blue
Cooking System	Reverse Air Convection

CAPACITY	
Total Capacity (cubic feet)	6.2 cu ft

ACCESSORIES	
LP Conversion Kit	Included

WEIGHTS & DIMENSIONS	
Depth with Door Open	43 7/8 in
Approximate Shipping Weight	462 lb
Net Weight	417 lb
Overall Height	35-1/4 in
Height to Cooking Surface (in.)	35-3/4 - 36 1/2
Overall Width	35-7/8 in
Cabinet Width	36 in
Overall Depth	30-3/4 in
Depth Without Handle	26-7/8 in
Oven Interior Dimensions (W x H x D) (in.)	28-1/4 x 16-3/8 x 19



PV-129  &  
Jan. 8 2021

Café™ 36" All Gas Professional Range  
with 6 Burners (Natural Gas)  
CGY366P4MW2 /CGY366P2MS1 / CGY366P3MD1



POWER / RATINGS

Top Burner BTU Rating - LP (000's BTU's)	(6) 15.0
Top Burner BTU Rating - Nat. Gas (000's BTU's)	(6) 18.0
Volts/Hertz/Amps	120v, 60Hz; 15A
Bake/Broiler BTU Rating - LP (000's BTU's)	23.0 Bake / 15.0 Broil
Bake/Broiler BTU Rating - Nat. Gas (000's BTU's)	24.5 Bake / 17.0 Broil

WARRANTY

Parts warranty	Limited 1-year entire appliance
Labor warranty	Limited 1-year entire appliance
Warranty notes	See written warranty for full details

DIMENSIONS AND INSTALLATION

**Electrical Requirements:** Ranges must be hooked up to a 120V, 60Hz properly grounded dedicated circuit protected by a 15-amp circuit breaker or time-delay fuse.

**GAS SUPPLY:** The natural gas models are designed to operate at 5" water column pressure. For proper operation, the pressure of the natural gas supplied to the regulator must be between 7" and 13" water column.

The LP models are designed to operate at 10" water column pressure. For proper operation, the pressure of the LP gas supplied to the regulator must be between 11" and 13" water column.

**Optional Backsplash Accessories:** The range requires a 12" minimum clearance to a vertical combustible surface at the rear. A backsplash is required for installations with less than 12" clearance. The following backsplash accessories are available, or a custom, non-combustible backsplash can be used.

Order one with a 36"-wide range backsplash  
UX12B36PSS – 12" backsplash  
UXADJB36PSS – 30"-36" adjustable-height  
backsplash with warming shelf

**NOTE:** Professional ranges offer a number of choices in size and cooktop configurations. All Professional Ranges are factory set for natural gas. Conversion kits are included with the range. High Altitude kit, WB28K10553 for operation above 6,000 feet (for Natural and LP gas models), is also available. The kits must be installed by a qualified service technician at additional cost.

**Installation Information:** Before installing, consult installation instructions packed with product or online at [geappliances.com](http://geappliances.com) for current dimensional data.


A suitable 36" or wider vent hood is required for installation over ranges with a grill and recommended for all other ranges.

**Advance Planning:** Refer to dimensional drawings for appropriate placement and necessary clearances when planning the installation.


- Working areas adjacent to the range should have 18" minimum clearance between countertop and cabinet bottom.
- Clearance between range and side wall or combustible material must be at least 12" on each side.
- Installation must conform with local codes. In the absence of local codes, the range must comply with the National Fuel Gas Code, ANSI Z223.1-1990.

**WARNING:** Installations without a hood require 48" minimum to combustibles. A custom hood installation with exposed horizontal combustible surfaces must have an Auto-On feature. Refer to hood installation instructions for specific hood clearances.

The surface of the entire back wall above the range and below the hood must be covered with a non-combustible material such as metal, ceramic tile, brick, marble or other stone.

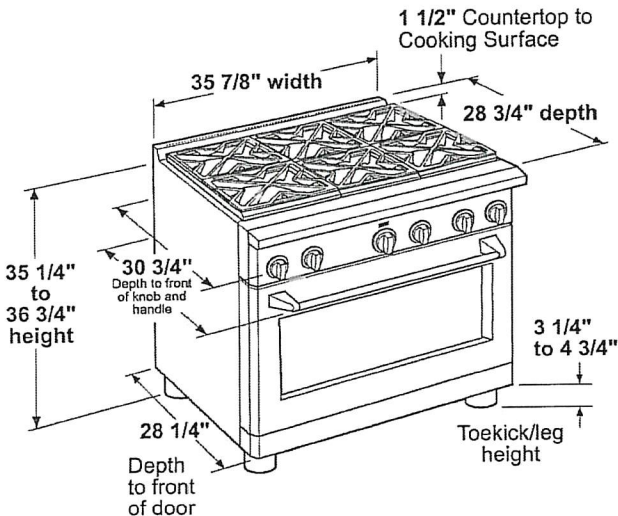



PV-129  &  
Jan. 8 2021


Café™ 36" All Gas Professional Range  
with 6 Burners (Natural Gas)

CGY366P4MW2 / CGY366P2MS1 / CGY366P3MD1



C A F É

DISTINCT BY DESIGN™

UNIVERSAL UTILITY LOCATIONS

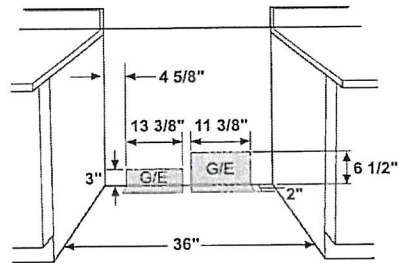

SIDE VIEW WITH BACKSLASH

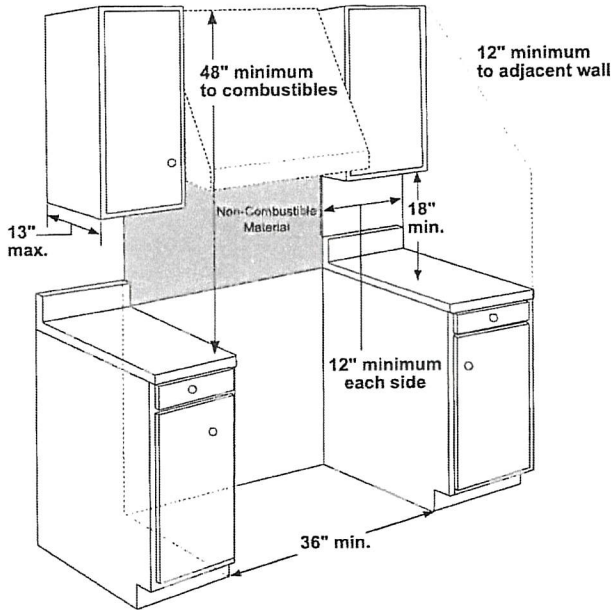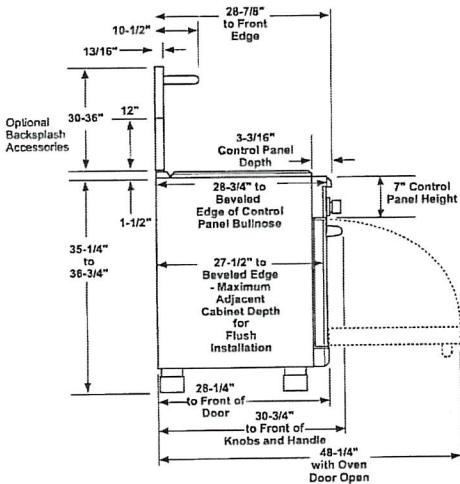

ADDITIONAL CLEARANCES

Allow 12" minimum clearance to an adjacent wall on each side.  
Working areas adjacent to the rangetop should have 18" minimum  
clearance between countertop and the bottom of the wall cabinet.


ADDITIONAL ACCESSORIES



CXPR6HKPMBZ  
Brushed Bronze  
1 handle, 8 knobs  
(standard on Matte White)




CXPR6HKPMSS  
Brushed Stainless  
1 handle, 8 knobs  
(standard on Matte Black)

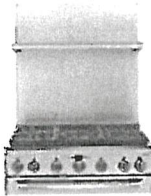

UXADJB36PSS  
30"-36"H Stainless Steel  
Adjustable Height  
Backslash with Shelf



CXPR6TKPMWS  
Matte White Toe Kick

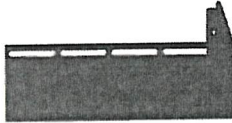


CXPR6TKPMDS  
Matte Black Toe Kick




CXPR6HKPMBT  
Brushed Black  
1 handle, 8 knobs



CXPR6HKPMCU  
Brushed Copper  
1 handle, 8 knobs

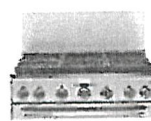

UX12B36PSS  
12"H Stainless Steel  
Backslash

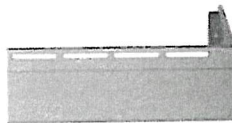


CXPR6TKPMSS  
Stainless Steel Toe Kick

PV-129 14 88  
Jan 8 2021

KitchenAid®

# 44 dBA\* Top Control Dishwasher

KDTM504E

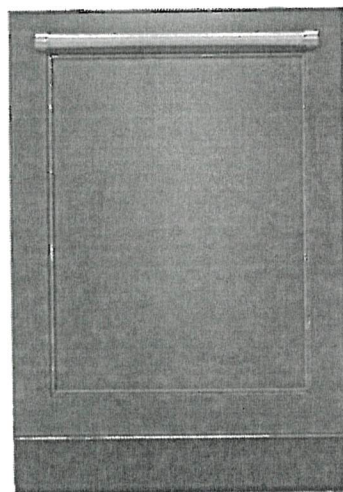

Panel Ready  
KDTM504EPA

## Key Features & Benefits

### Panel-Ready Design

Allows you to match your dishwasher to your kitchen cabinets for a high-end look, seamless look. A custom front panel and handle (not included) can be affixed to the dishwasher.

### Dynamic Wash Arm

Features nine wash arms in one for 3 times better coverage. This unique design directly sprays water everywhere in the dishwasher, including hard to reach places. This means dishes get a powerful clean no matter where they are placed in the rack.

### Clean Water Wash System

Continuously removes food particles from the wash water. The result of this advanced technology is clean wash water for excellent performance. Plus, the filter requires no routine maintenance.

## Capacity

Total Place Settings 16

## General Features & Properties

ProScrub® Option

ProScrub™ Upper (was Trio)

Third Level Rack

Advanced ProDry™ System

ProWash™ Cycle

SatinGlide® Max Rails (Upper and Lower Racks)

2 Rows Fold-Down Tines in Upper Rack

Fold-Down Tines in the Lower Rack

2 Fold-Down Cup Shelves with Integrated Stemware Holders

## Electrical Details

Amps 15 or 20

Volts 120

Hz 60

## Certifications

ADA Compliant No

ENERGY STAR® Certified Yes

Connected/Smart Appliance No

## Technical Details

Dishwasher Type Built-In

Control Location Hidden

Control Type Tap Touch

Number of Wash Cycles 6

Number of Options 7

dBA 44

Number of Racks 3

Tub Material Stainless Steel

Wash System Filter

Wash System Type Maintenance Free Microfilter

Number of Wash Arms 3

## Dimensions

Product Dimensions (H x W x D) 34-1/2" x 23-7/8" x 24-3/4"

Depth with Door Open 90° 49-1/2"

## Reference Material


[Dimension Guide](#)

[Install Guide](#)

[Use & Care Guide](#)



[Energy Guide](#)

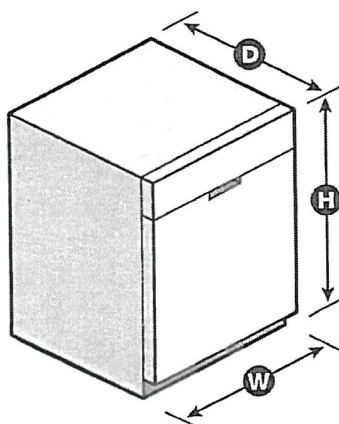[Warranty](#)




\*Per IEC standards. NOTE: Dimensions are for planning purposes only. For complete details, see Installation Instructions packed with product. Specifications subject to change without notice.  
©/™ © 2020. All rights reserved. Printed in the U.S.A. D200052XXA. KDTM504ESPECSHEETV01.



PV-129   
 Jan. 8, 2021 

Product and Cabinet Opening Dimensions

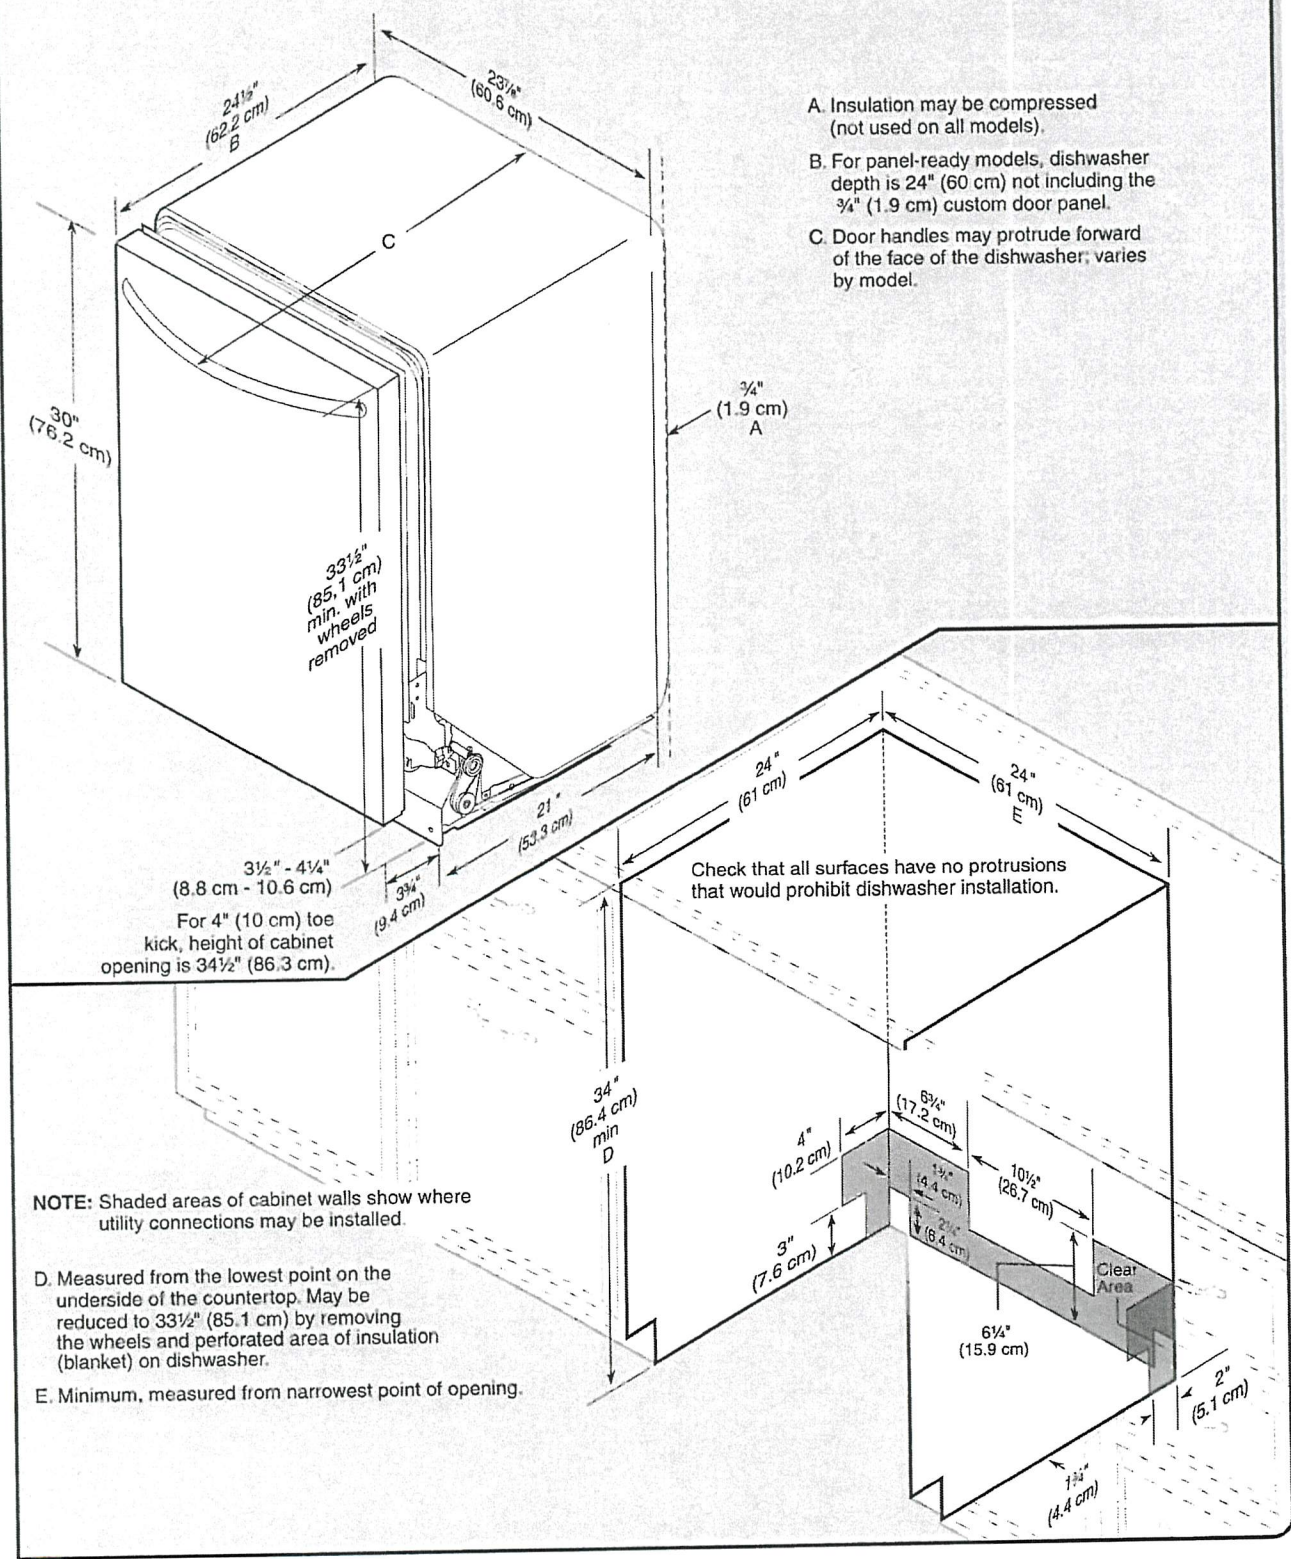

PV-129 14 E  
Jan 8 2021

# KitchenAid® Bottom Mount Built-in Refrigerator

FOR THE WAY IT'S MADE.®

## PRODUCT MODEL NUMBERS

KBBL206E	KBBR306E	KBFN502E
KBBL306E	KBFN402E	KBFN506E
KBBR206E	KBFN406E	

**IMPORTANT:** Observe all governing codes and ordinances.

**Electrical:** A 115 Volt, 60 Hz., AC only 15- or 20-amp fused, grounded electrical supply is required. It is recommended that a separate circuit serving only your refrigerator be provided. Use an outlet that cannot be turned off by a switch. Do not use an extension cord.

A grounded 3 prong electrical outlet should be placed within 4" (10.2 cm) of the right side cabinets or end panel.

**Location:** Do not install in a location where the temperature will fall below 55°F (13°C). It is recommended that you do not install the refrigerator near an oven, radiator, or other heat source.

■ Floor must support the refrigerator weight, more than 600 lbs. (272 kg), door panels, and contents of the refrigerator.

■ Ceiling height must allow for side tipping radius. See "Tipping Radius."

■ Location should permit door to open fully. See "Door Swing Dimensions."

■ Location must permit top grille removal. See "Opening Dimensions."

### Water Supply:

A cold water supply with water pressure between 30 and 120 psi (207 and 827 kPa) is required to operate the water dispenser and ice maker. If you have questions about your water pressure, call a licensed, qualified plumber.


### Reverse Osmosis Water Supply

**IMPORTANT:** The pressure of the water supply coming out of a reverse osmosis system going to the water inlet valve of the refrigerator needs to be between 30 and 120 psi (207 and 827 kPa).

■ All installations must meet local plumbing code requirements.

■ The water shutoff should be located in the base cabinet on either side of the refrigerator or some other easily accessible area. The right-hand side is recommended. The access hole through the cabinet must be within ½" (12.7 mm) of the rear wall.


**NOTE:** If the water shutoff valve is in the back wall behind the refrigerator, it must be at an angle so that the tube is not kinked when the refrigerator is pushed into its final location.

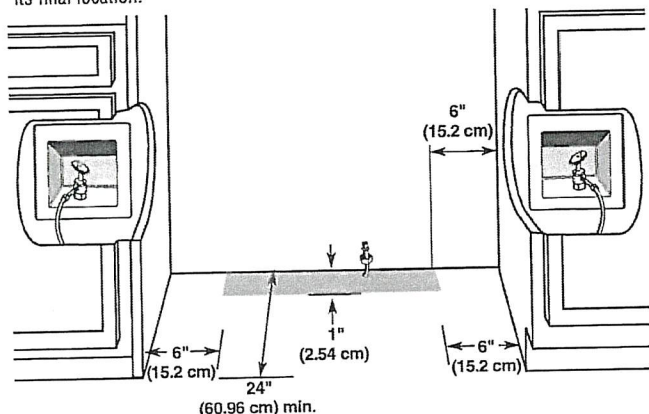

## PRODUCT DIMENSIONS


■ Height dimensions are shown with the leveling legs extended to ⅛" (3 mm) below the rollers.

■ Width dimensions were measured from trim edge to trim edge.

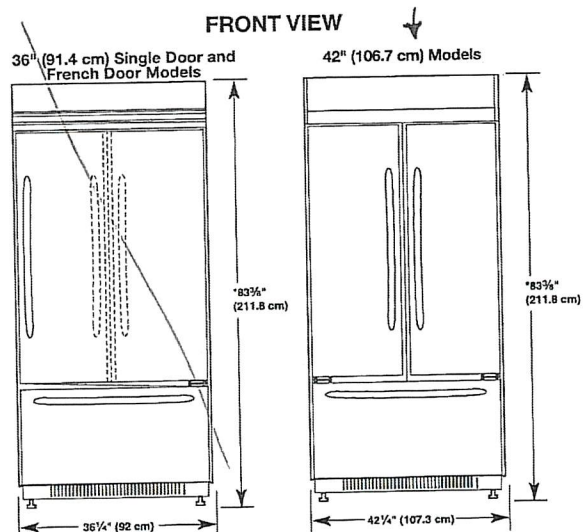


\* When leveling legs are fully extended to 1 1/4" (3.2 cm) below rollers, add 1 1/8" (2.9 cm) to the height dimensions.

### SIDE VIEW

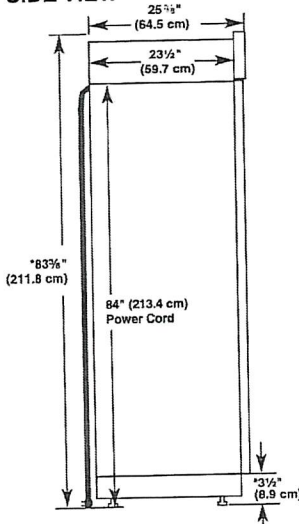

### TOP VIEW

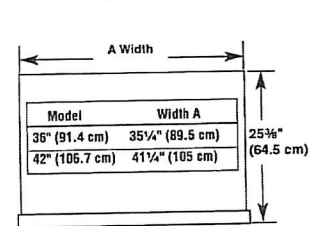


■ The water line attached to the back of the refrigerator is 5' (1.5 m) long.

## DOOR SWING DIMENSIONS


The location must permit the door to open a minimum of 90°. Allow 4 1/2" (11.4 cm) minimum space between the side of the refrigerator and a corner wall.

**NOTE:** More clearance may be required if you are using overlay panels or custom handles.


### 36" (91.4 cm) Single Door Models

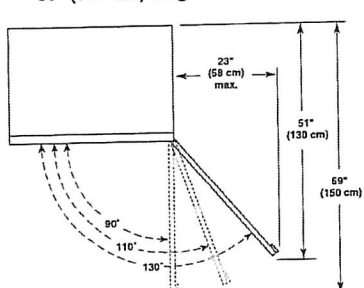

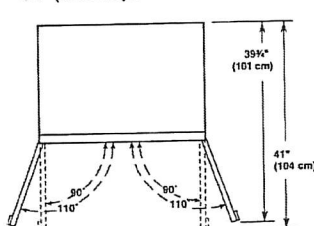

### 36" (91.4 cm) French Door Models

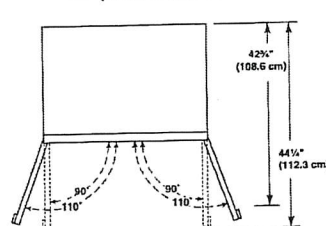

### 42" (106.7 cm) Models






PV-129    
Jan. 8 2021

OPENING DIMENSIONS


To avoid tipping during use, the solid soffit must be within 1" (2.5 cm) maximum above the refrigerator. If the solid soffit is higher than 1" (2.5 cm) or one is not available, then the refrigerator must be braced.

If anti-tip boards are needed, they must be installed to the rear wall studs so that the bottom of the anti-tip board is 84" (213.4 cm) from the floor.

**NOTE:** Do not remove the foam gasket on top of the compressor cover unless removal is necessary to fit the unit under a soffit. Removal of the gasket will cause loss in cooling efficiency.

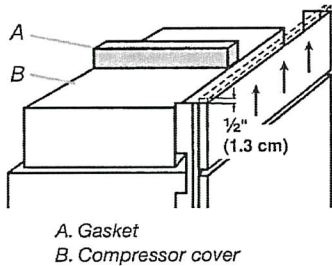

**NOTE:** If installing under a solid soffit, after installation raise the leveling legs so that the gasket is pressed snugly against the soffit.

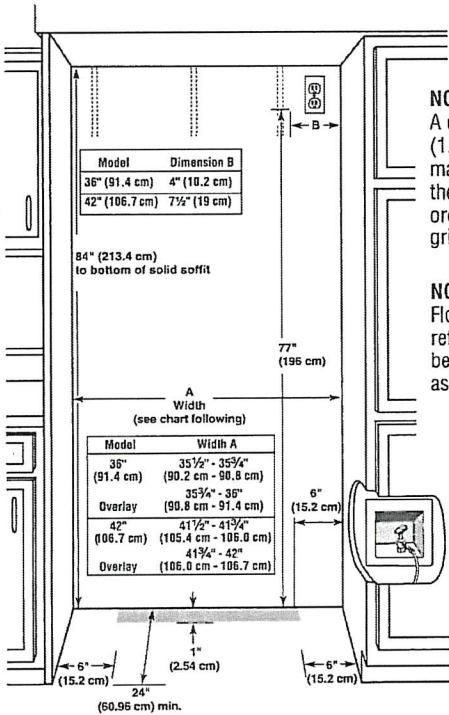

**NOTE:** A clearance of 1/2" (1.3 cm) must be maintained above the top grille in order for the top grille to be removed.


**NOTE:** Flooring under refrigerator must be at same level as the room.

TIPPING RADIUS

Be sure there is adequate ceiling height to stand the refrigerator upright when it is moved into place.


- The dolly wheel height must be added to the tipping radius when a dolly is used.
- If needed, the tipping radius can be reduced. See "Reduce Tipping Radius."

Side Tipping Radius (36" [91.4 cm] Models)

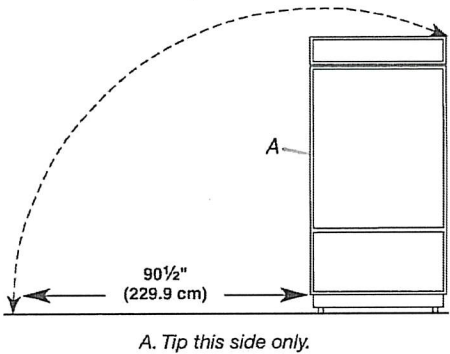


A. Tip this side only.

Side Tipping Radius (42" [106.7 cm] Models)

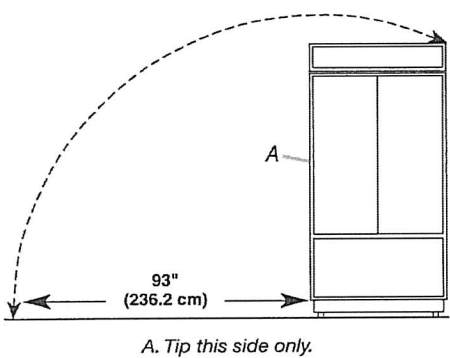


A. Tip this side only.

PV-129  E  
Jan. 8, 2021

ELICA PRO SERIES  
TRENTO




Trento provides professional grade performance, while being discreetly mounted inside the cabinetry. It is available with a 600 CFM or 1200 CFM blower for extraordinary ventilating power. Plus the All-In-One design avoids the need to purchase a stainless liner. Hidden metallic in/out knob controls operate the 4-speed blower and LED lighting. A cleaner kitchen is ensured by Elica's patented angled baffle filters, which capture a higher percentage of contaminants and hold larger volumes of grease than traditional baffle filters.

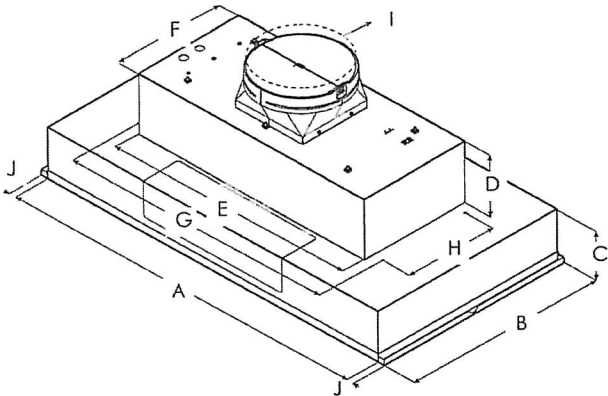


	ETR634SS ETR134SI
A	34 1/2" (87.6 cm)
B	18" (45.7 cm)
C	5 7/16" (13.8 cm)
D	6 1/2" (16.4 cm)
E	27 9/16" (70 cm)
F	12 7/16" (31.6 cm)
G	29 13/16" (75.7 cm)
H	10 1/8" (25.7 cm)
I	10" (25.4 cm)
J	3/4" (1.9 cm)

\* using reducer  
cuff for 8" duct  
size

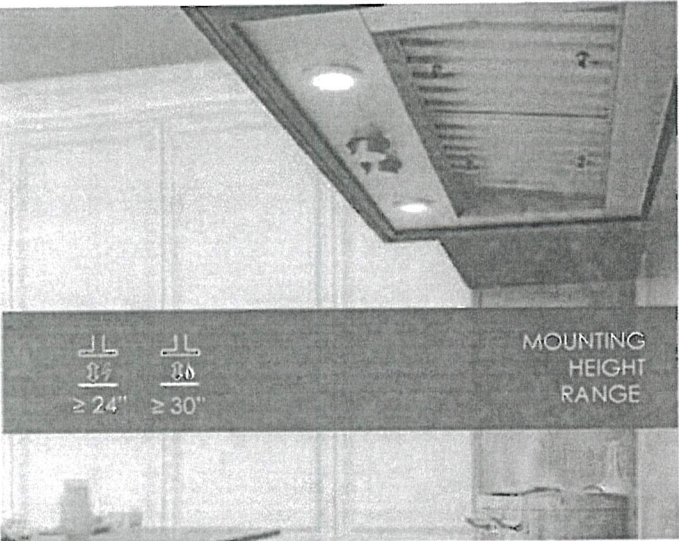



PV-129   
Jan. 8, 2021

ELICA PRO SERIES  
TRENTO



SPECIFICATIONS


	34" Unit (600 CFM)	34" Unit (1200 CFM)
Model:	ETR634SS	ETR134S1
Dimensions:	34 1/2"W x 18"D x 11 1/2"H	34 1/2"W x 18"D x 11 1/2"H
Blower Type(internal):	600 CFM (4-speed)	1200 CFM (4-speed)
Blower Performance:		
Speed 1	90 CFM	380 CFM
Speed 2	330 CFM	660 CFM
Speed 3	490 CFM	950 CFM
Speed 4	600 CFM	1200 CFM
Noise (sones):	Min:2 , Max:9.5	Min:2.05, Max:7.5
Working Speed		
Finish:	Stainless Steel	
Controls:	Fully retractable rotating knobs with blue backlighting	
Illumination:	2 LED, 7.5 W	
(replaceable lamps 1 intensity)		
Filter Type:	Dishwasher-Safe, Professional Stainless Steel	
Angled Baffle Filters:	2	
Duct Transition:	10" Round with BackDraft Damper (top only)	
Installation Type:	Ducted Installation Only	
Electrical:	120V - 60 Hz	
CONSUMABLE PARTS:		
Replacement Grease Filter (1):	GRI0140692A	
Replacement Light Bulb (1):	LMP0131098A	LMP0131098
WARRANTY:	2 YEARS PARTS AND LABOR, EARN A 3RD YEAR OF FULL FACTORY WARRANTY REGISTERING YOUR PRODUCT ON ELICA.COM	


\*Consumable parts are sold in units of one (1). Order accordingly


\*\* For valid warranty extension, register within 3 months from purchase. For USA & Canada Users only


\*The product images shown are for illustration purposes only and may not be an exact representation of the product.


PLUS FEATURES


- 

**HUSH SYSTEM** - An exclusive sound deadening technology that effectively reduces sound levels by over 35%
- 


**LED CONSUMER REPLACEABLE BULB** - High quality LED lighting usually requires a skilled technician to replace lamps. Avoid this expense with Elica's new LED lamps that enable homeowners to replace in seconds
- 

**SEAMLESS CRAFTSMANSHIP** - Heavy gauge stainless steel "Seamless" construction that delivers refined elegance.
- 

**STAINLESS STEEL BAFFLE FILTERS WITH GREASE COLLECTORS** - Designed for high airflow cooking, the "S" shape design traps high volumes of grease
- 

**PROFESSIONAL PERFORMANCE** - Special features and high performances for models with aspiration capacity between 600 and 1200 CFM's
- 


**HEAT GUARD** - Senses extreme temperatures (>158 degrees) and automatically adjusts the blower speed to HIGH

PR-129  E  
Jan. 8 2021




## Dimension Guide


Whirlpool® Top Load Washer with  
Load & Go™, Built-In Water Faucet  
and Stain Brush - 4.8 cu. ft.

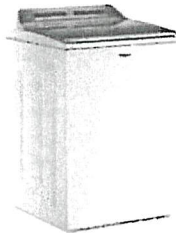

White Available WTW6120HW

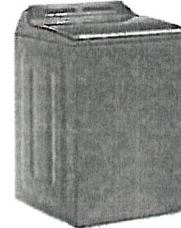


Chrome Shadow Available WTW6120HC

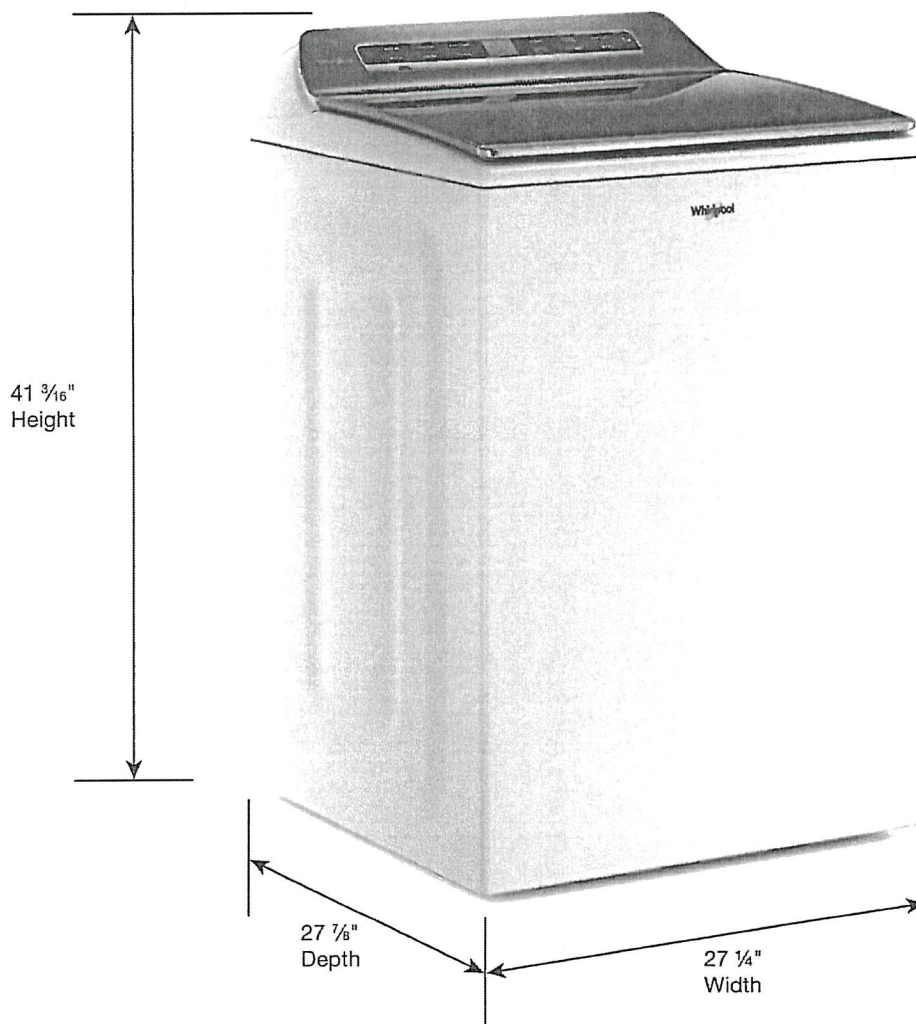

W11412605A




PV-129   
Jan. 8 2021


DETAILED PLANNING DIMENSIONS

**WARNING:** To reduce the risk of fire, electric shock, or injury to persons, read the IMPORTANT SAFETY INSTRUCTIONS and INSTALLATION INSTRUCTIONS, located in your appliance's Owner's Manual, before installing and operating this appliance.


Electrical Requirements		
WTW6120HW WTW6120HC	4.8 cu. ft. DOE (US)	5.5 cu. ft. IEC (CAN)
Minimum Circuit Amperage Rating	15 A	
Maximum AMP Draw	10.36 A	
Operating Voltage	120 V - AC only	
Operating Frequency	60 Hz	

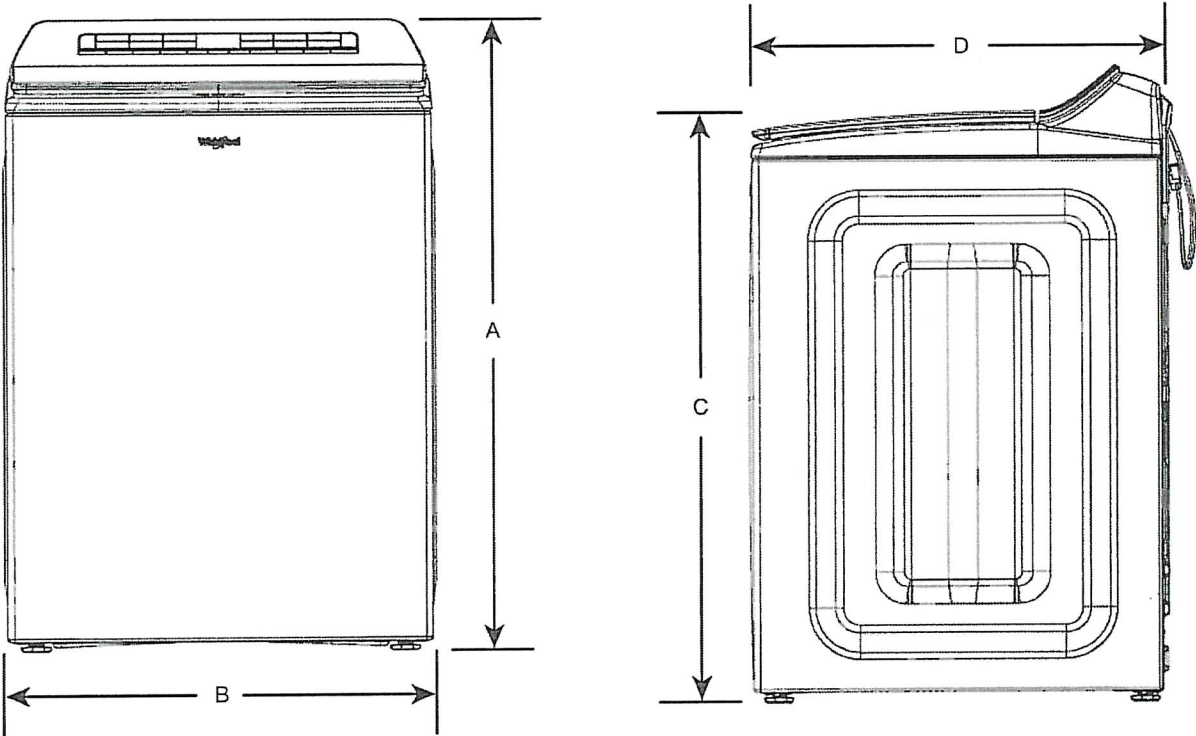

Product Dimensions					
WTW6120HW WTW6120HC		4.8 cu. ft. DOE (US)		5.5 cu. ft. IEC (CAN)	
		in (min)	mm (min)	in (max)	mm (max)
A	Height (with feet)	41 3/16	1046.42	41 3/16	1061.82
B	Width	27 1/4	692.5	-	-
C	Top of Lid Height (with feet)	38 1/8	968.12	38 3/4	983.52
D	Depth	27 7/8	708	-	-

PV-129  &C  
Jan. 8 2021


DETAILED PLANNING DIMENSIONS

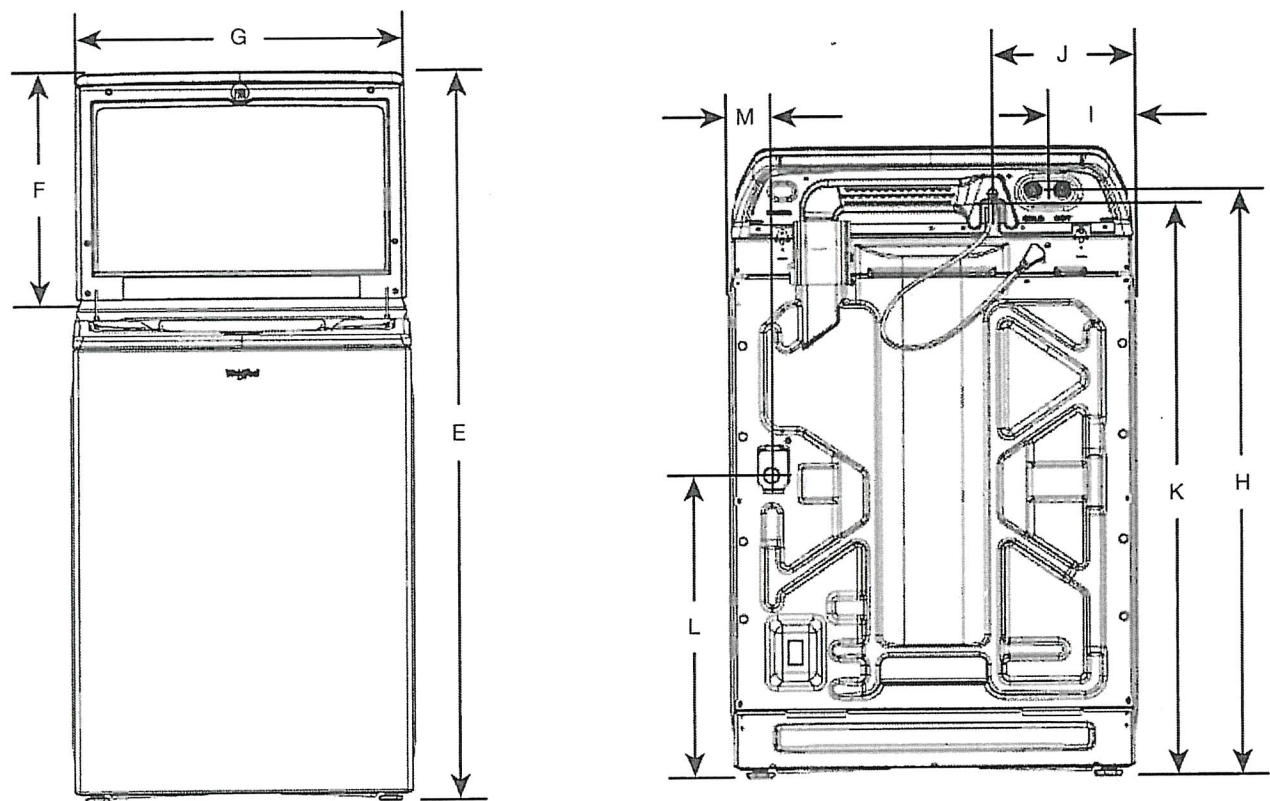

Product Dimensions					
WTW6120HW WTW6120HC		4.8 cu. ft. DOE (US)		5.5 cu. ft. IEC (CAN)	
		in (min)	mm (min)	in (max)	mm (max)
E	Height with Lid Open	57 ¼	1454.62	57 7/8	1470.02
F	Height of Lid	19 1/8	485.61	-	-
G	Width of Lid	26 3/16	664.65	-	-
H	Water Inlet Valves Height	38 3/16	970.44	38 13/16	985.84
I	Water Inlet Valves from Side	5 ¾	146.75	-	-
J	Power Cord from Side	9 ½	241.68	-	-
K	Power Cord Height	37 7/16	950.88	38 1/16	966.28
	Power Cord Length	62 7/16	1586	-	-
L	Drain Hose Outlet Height	19 3/16	487.62	19 13/16	503.02
M	Drain Hose Outlet from Side	2 13/16	71.3	-	-
	Drain Hose Length	40 15/16	1040	-	-
	Diameter of Drain Hose	1	25	-	-

DETAILED PLANNING DIMENSIONS

Recessed area or closet installation

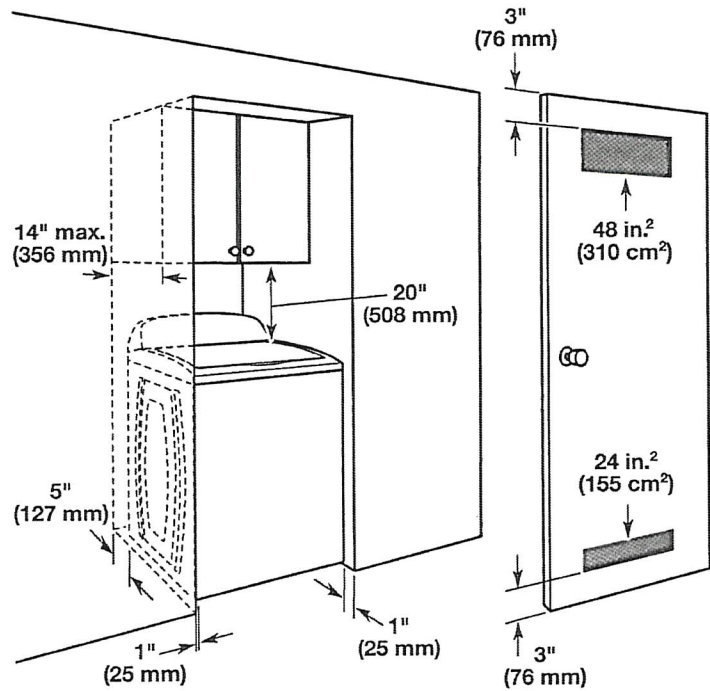

Dimensions show recommended spacing allowed, except for closet door ventilation openings which are minimum required. This washer has been tested for installation with spacing of 0" (0 mm) clearance on the sides. Consider allowing more space for ease of installation and servicing, and spacing for companion appliances and clearances for walls, doors, and floor moldings. Add spacing of 1" (25 mm) on all sides of washer to reduce noise transfer. If a closet door or louvered door is installed, top and bottom air openings in door are required.