



CONSTRUCTION SUMMARY

Lot: 102

Model: 42.01 A MAPLEWOOD

Project/Phase: Pine Valley Forevergreen / 1

DRYWALL

Invoice	Qty.	Description
2212 03Nov20 NoCat	1	.PINE VALLEY MODEL 42.01 MAPLEWOOD ELEV A OR B - 9 FOOT BASEMENT CEILING HEIGHT IN LIEU OF STANDARD 8 FOOT CEILING.
2242 03Nov20 NoCat	1	.**CUSTOM LAYOUT** DELETE 2-SIDED FIREPLACE - INSTALL APPX 96" FIN. WALL. INSTALL (breakfast side) TALL PANTRY CABINETS (approx. 5.5') + BASE CABINET TO HOUSE FUTURE WINE FRIDGE + COUNTER TOP (NO UPPER CABINET ABOVE COUNTER) BASED ON STANDARD FINISHES
2242 03Nov20 NoCat	1	.***CUSTOM***DELETE GROUND FLOOR ENSUITE 2 BATH RELOCATE LAUNDRY *from mudroom* TO FORMER ENSUITE 2, COMPLETE WITH WASHER/DRYER ROUGH-IN AND ADD STD LAUNDRY TUB. LAUNDRY BECOMES MUD ROOM (OPEN SPACE) - INCLUSIVE OF BUILDERS STANDARD FINISHES **SEE REVISED DOOR LOCATIONS FOR LAUNDRY AND BEDROOM 2-- RELOCATE PLUMBING/ELECTRICAL/HVAC **
2242 03Nov20 NoCat	1	.DELETE KITCHEN BULKHEAD, IF POSSIBLE, SITE APPROVAL REQUIRED
2242 03Nov20 NoCat	1	.**CUSTOM LAYOUT** REDUCE SIZE OF MUDROOM BY APPROX 1', INCREASE SIZE OF LAUNDRY ROOM BY 1'-- SEE PLAN FOR LOCATION

**Lot: 102****Model: 42.01 A MAPLEWOOD****Project/Phase: Pine Valley Forevergreen / 1**

STAIRS AND RAILINGS

Invoice	Qty.	Description
2552	2	MAIN STAIRS: BASEMENT TO 2ND FLOOR: STAIN STAIRS AND LANDINGS
17Feb21 NoCat		STAIRS AND LANDINGS WILL NOT MATCH HARDWOOD FLOORS IN COLOUR/TEXTURE/SPECIES

WINDOWS - BASEMENT

Invoice	Qty.	Description
2212	2	.BASEMENT WINDOWS - UPGRADE BASEMENT WINDOW SIZE TO 30 " X 24" - 8" FRAME
03Nov20 NoCat		

PV-102 Cabinetry Schedule

ROOM	DESCRIPTION	PRICE	QTY	TOTAL
KITCHEN	UPGRADE FROM SERIES 2 TO SERIES 3 - <i>MANHATTAN OYSTER</i>		1	
	ADD 36"W COOKTOP POTS AND PANS DRAWERS IN STOVE LOCATION		1	
	ADD MINI STACKED UPPER LINE TO STD KITCHEN		1	
	ADD TOUCH LATCH HARDWARE TO MINI STACKED UPPERS		1	
	ADD DECORATIVE PANEL FOR FRIDGE/FREEZER		1	
	CONVERT FULL DOOR BASE CABINET TO BASE POTS AND PANS		2	
	ADD DECORATIVE HOOD CANOPY - MITRED MODERN		1	
	ADJUST BASE CABINET'S FOR 36" COOKTOP (N/C)		1	
	CONVERT STD CABINET INTO TALL DEEP BUILT IN OVEN UNIT WITH POT DRAWER BELOW		1	
	CONVERT STD UPPER CABINET TO NOTCHED UPPER CABINET FOR FINGER PULL - NO HARDWARE ON UPPERS		1	
	RETURN TRIP FOR HARDWOOD		1	
	ADD 30"H BASE DUMMY DOOR APPLIED AGAINST END BASE		1	
	ADD APPLIANCE PULLS AT FRIDGE, PANTRY + COORDINATING HARDWARE AT BASE			
	DRAWERS AND DOORS - CONTEMPORARY 806MM METAL PULL 7191		1	
	ADD CABINETRY VALANCE		1	
ISLAND	UPGRADE FROM SERIES 2 TO SERIES 3 - <i>MANHATTAN OYSTER</i>		1	
	ADD 2-BIN RECYCLE CENTRE TO ISLAND		1	
	RELOCATE STD BANK OF DRAWERS TO ISLAND (N/C)		1	
	ADD DECORATIVE PANEL FOR DISHWASHER		1	
	ADD TOUCH LATCH HARDWARE TO BACK OF ISLAND		1	
BREAKFAST PANTRIES				
	ADD 117"H BASE LINE FULL-HEIGHT PANTRY WITH MINI STACKED UPPER RUN. ADD SEAM GABLES. ADD BASE SUPPORT GABLES FOR BEVERAGE FRIDGE. ADD 9"W SKINNY FULL-DOOR BASE CABINET BESIDE BEVERAGE FRIDGE. ADD FURRING TO 10' CEILING. (DIFFERENCE FROM STD IN STRUCTURAL ORDER)		1	
	ADD TOUCH LATCH HARDWARE TO MINI STACKED UPPERS		1	
POWDER ROOM				
	UPGRADE FROM SERIES 2 TO SERIES 3 - <i>BROADWAY II WHITE HI GLOSS PET</i>		1	
	UPGRADE HARDWARE - <i>BAH-083-03</i>		1	
	CONVERT VANITY INTO 21"H OR 24"H FLOATING VANITY		1	
	CONVERT FLOATING VANITY INTO U-SHAPED TWO DRAWER VANITY		1	
LOFT BATH	ADD SKIRT BELOW FLOATING VANITY FOR UNFORSEEN PLUMBING		1	
LAUNDRY ROOM				
	CONVERT STD VANITY CABINET INTO VANITY BANK OF DRAWERS		1	
MASTER ENSUITE				
	ADD FULL-DOOR BASE CABINET		1	
	ADD LAMINATE TOP		1	
	UPGRADE FROM SERIES 2 TO SERIES 3 - <i>MANHATTAN OYSTER</i>		1	
	UPGRADE HARDWARE - <i>BAH-083-03</i>		1	
	CONVERT VANITY INTO 21"H OR 24"H FLOATING VANITY		1	
	CONVERT FLOATING VANITY INTO U-SHAPED TWO DRAWER VANITY		1	
	ADD SKIRT BELOW FLOATING VANITY FOR UNFORSEEN PLUMBING		1	
CABINETRY TOTAL:				

LOT #: *PV-102*

DATE: *Feb 11, 2021*

SIGNATURE: *[Signature]* * see attach *

SIGNATURE:

Purchaser: ERMENZIANA SIMONE

Property: 102 of Plan -

Telephone Res. / Bus: / (647) 627-0981

Project: Pine Valley Forevergreen - Phase 1

Decor Advisor: Yolande Somerville

Model and Elevation: 42.01 A MAPLEWOOD

Layout Changes: ☒ Yes ☐ No

Sketch Attached: ☒ Yes ☐ No

Exterior Colour Scheme:

1. Cabinetry

	Style and Colour	Counter	Hardware
Kitchen / Breakfast	*Manhattan 'Oyster'	*2-tone	attached
Laundry Room	Modena 'Classic White'	P-Lam: Std White	attached
Powder Room	*Broadwayll pet hi-gloss white	*Quartz: Desert Silver	attached
Master Ensuite Bathroom	*Manhattan 'Oyster'	Quartz: Ice Snow	attached
Second Ensuite Bathroom (If Applicable)	n/a	n/a	n/a
Shared Ensuite	Modena 'Classic White'	Quartz: Ice Snow	attached

Comment

Kitchen Perimeter + Pantry Wall Countertop: *Quartz: Vivid White' // Island Countertop: *Quartz: 'Bianco Calacatta'

2. Floor Tile

	Selection
Entrance Vestibule	*24x24" Volkas 'White' polished
Main Hall	
Kitchen / Breakfast	see hardwood
Laundry Room	*12x24" Volkas 'White' polished
Powder Room	*12x24" Volkas 'White' polished
Mud Room	13x13" Sempre 'White' matte
Master Ensuite Bathroom	*12x24" Regal matte 'Shell White'
Second Ensuite Bathroom (If Applicable)	n/a
Lower Landing (If Applicable)	13x13" Sempre 'White' matte
Shared Ensuite	13x13" Sempre 'White' matte

Comment

Master Ensuite: Shower Floor: *2x2" Quebec 'Arctic White' // Shared Ensuite: std 2x2" white

3. Wall Tile

	Selection	Listello/Inserts	Describe
Master Ensuite Bathroom		☐ Yes ☒ No	
Tub Deck		☐ Yes ☒ No	
Shower Stall	*4x12" Piccadilly (Ivory) Glossy	☐ Yes ☒ No	
Bathroom Walls		☐ Yes ☒ No	
Second Ensuite Bathroom (If Applicable)		☐ Yes ☒ No	
Shared Ensuite	8x10" Splendour 'White'	☐ Yes ☒ No	
Kitchen Backsplash	☐ Yes ☒ No	Backsplash Behind Fridge	

Comment

see attach.

Purchaser: ERMENZIANA SIMONE

Property: 102 of Plan -

Telephone Res. / Bus: / (647) 627-0981

Project: Pine Valley Forevergreen - Phase 1

Decor Advisor: Yolande Somerville

Model and Elevation: 42.01 A MAPLEWOOD

4. Plumbing Fixtures

Master Ensuite Bathroom ☐ Second Ensuite ☐ Powder Room ☐
Other Room - Specify ☐ Other Washroom ☐

Comment

Standard except kitchen + Master

5. Hardwood Flooring

	Type and Stain		Type and Stain
Main Hall		Upper Landing	
Kitchen / Breakfast	*3/4x5" wht oak wirebrush 'Atlantis'	Upper Hall	
Living Room		Master Bedroom	
Dining Room		Bedroom #2	
Family Room		Bedroom #3	
Den/Library		Bedroom #4	
Entrance Vestibule		Bedroom #5	
Lower Landing (If Applicable)		Other Room - Specify	
		Thru out standard areas	*3/4x5" wht oak wirebrush 'Atlantis'

Comment

6. Carpeting

	Upgrade	Description
Ground Floor	☐	
Second Floor	☐	
	☐	

	Type	Area
Upgrade Underpad		
Carpet on Stairs	Capped	Runner - *Upgrade

Comment

7. Fireplace

	Living Room			Family Room			Other Room - Specify		
	Purchased	As Per Plan	N/A	Purchased	As Per Plan	N/A	Purchased	As Per Plan	N/A
Fireplace Type	☐	☐	☒	☐	☒	☐	☐	☐	☒
Mantle Type				Standard Gas					
Colour / Stain				**none**					
Surround				n/a					
Hearth				**none**					
				none					

Comment

* See attach. *

Scheduled Closing Date: Tuesday, May 4, 2021

Purchaser: ERMENZIANA SIMONE

Property: 102 of Plan -

Telephone Res. / Bus: / (647) 627-0981

Project: Pine Valley Forevergreen - Phase 1

Decor Advisor: Yolande Somerville

Model and Elevation: 42.01 A MAPLEWOOD

8. Trim Carpentry

Interior Doors *Lincoln Park Front Door Glass Inserts standard Door Handles *Halifax sat. chrome

Interior Trim *Board 4

Comment

9. Plaster Mouldings and Medallions

Standard Throughout ☐ Yes ☐ No ☒ N/A

Entrance Vestibule			Kitchen/Breakfast		
Main Hall			Den/Library		
Living Room			Lower Landing		
Dining Room			Other Room - Specify		
Family Room					

Comment

10. Railings and Spindles

Railing Package *Glass

Railing Colour *Stainless

Stringer / Riser *White

Spindle Colour n/a

Treads *Hopscotch

Comment

Oak Stairs ☒ Yes ☐ No ☐ N/A

11. Wall Paint / Ceilings

Throughout Finished Areas Cool White

Trim Paint White

Smooth Ceilings

Ground Floor ☒

Second Floor ☒

Note

Comment

* see attach *

Purchaser: ERMENZIANA SIMONE

Telephone Res. / Bus: / (647) 627-0981

Decor Advisor: Yolande Somerville

Scheduled Closing Date: Tuesday, May 4, 2021

Property: 102 of Plan -

Project: Pine Valley Forevergreen - Phase 1

Model and Elevation: 42.01 A MAPLEWOOD

12. Electrical

Hood Fan ☐ White ☐ Stainless ☒ N/A

Above Kitchen Cabinet Light ☐ Yes ☒ No

Below Kitchen Cabinet Light ☒ Yes ☐ No

Standard Appliances ☐

Over The Range Microwave ☐

Chimney Style Fan ☐

Comment

13. Heating and Air Conditioning

Air Conditioning

Gas Provisions Stove

Gas Provisions Dryer

Gas Provisions Barbecue

Comment

14. Additional Comments

15. Disclaimers and Notes

- 1) Colours of all materials are as close as possible to builder's selection, but not necessarily identical due to variances in manufacturing.
- 2) Any extras listed above are null and void unless accompanied by a separate invoice/amendment. Said invoice must be paid in full.
- 3) The Purchaser acknowledges that after Interior Colour Selection form is signed and dated, no further changes will be permitted other than re-selection due to unavailability. _____ Purchaser's Initials
- 4) The Purchaser acknowledges reading and accepting the "Gold Park Homes Decor Centre Disclaimers" form. This document contains other miscellaneous disclaimers.

This Interior Colour Selection is final and approved by:

Signature: *see attach

Date: Feb. 11, 2021

SCHEDULE 'F'




PV-102.
MAY 25.2020
PV-102
Feb 11, 2021

* see attach. *

The Maplewood 42' SERIES

Elevation A • 2,770 sq.ft.
Elevation B • 2,725 sq.ft.

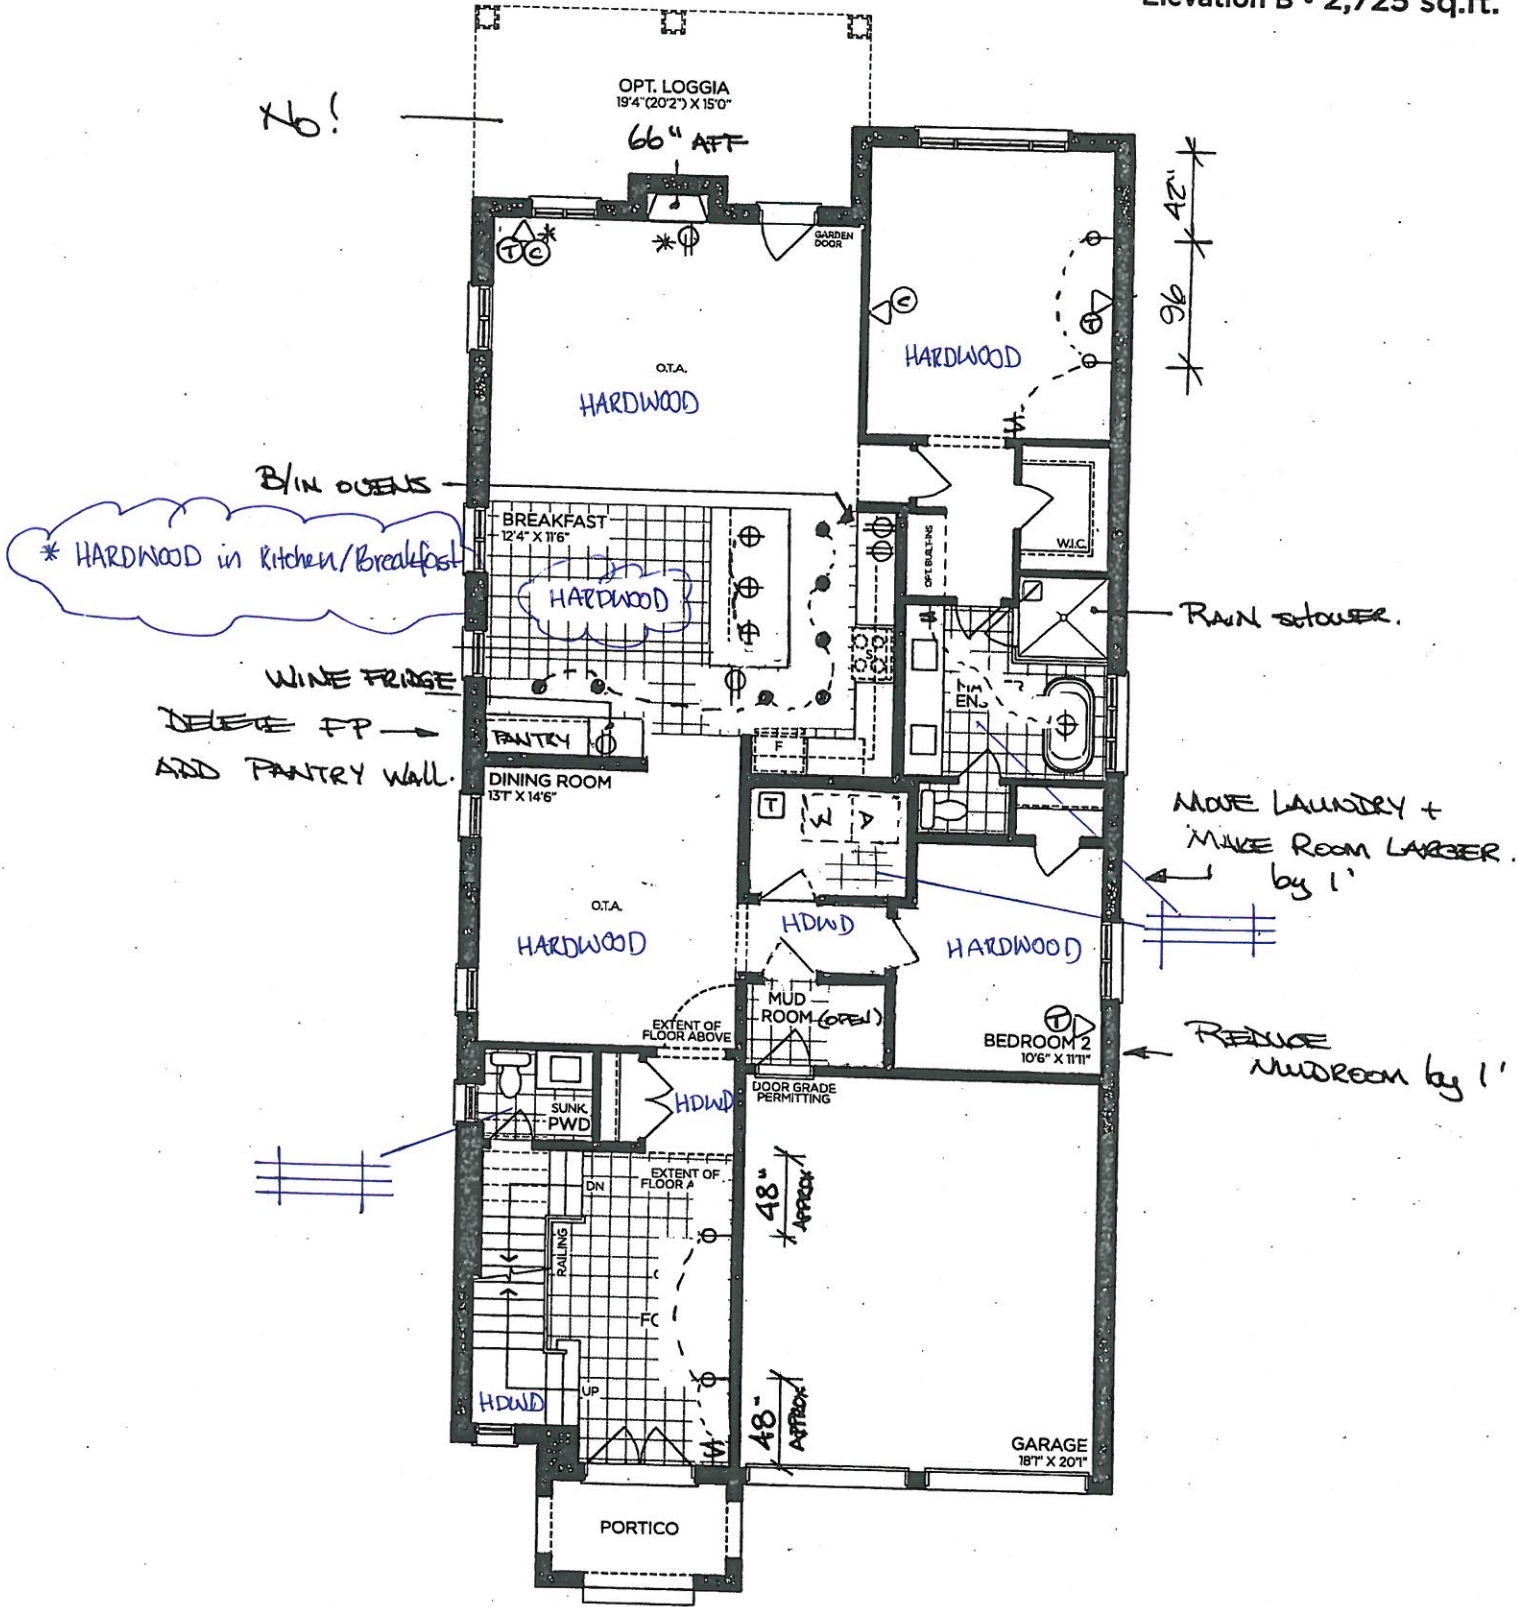

GROUND FLOOR | ELEV. A

VENDOR

PURCHASER

PURCHASER

GOLDPARK
WORTH MORE™

Prices, figures, illustrations, sizes, features and finishes are subject to change without notice. Areas and dimensions are approximate and actual usable floor space may vary from the stated area. Layout may be reverse of the unit purchased. E. & O.E. 4201

SCHEDULE 'F'



PV-102
MAY 25 2020


PV-102
Feb 11, 2021

See attached

* see attach *

The
Maplewood
42' SERIES

Elevation A • 2,770 sq.ft.
Elevation B • 2,725 sq.ft.

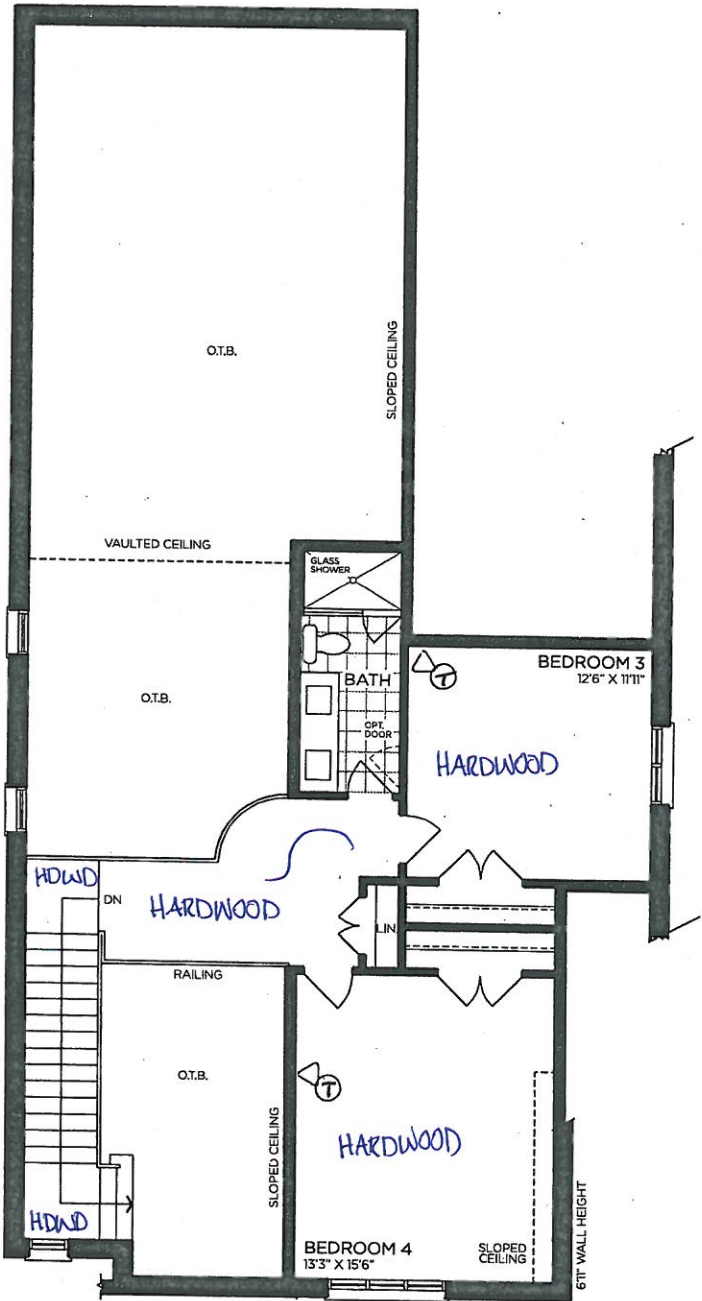

LOFT | ELEV. A

VENDOR

PURCHASER

PURCHASER

GOLDPARK
WORTH MORE™

Prices, figures, illustrations, sizes, features and finishes are subject to change without notice. Areas and dimensions are approximate and actual usable floor space may vary from the stated area. Layout may be reverse of the unit purchased. E. & O.E. 4201

SCHEDULE 'F'




PV-102. *See attached*
MAY 25 2020
PV-102
Feb 11, 2021 * see attach *

The Maplewood

42' SERIES

Elevation A • 2,770 sq.ft.
Elevation B • 2,725 sq.ft.

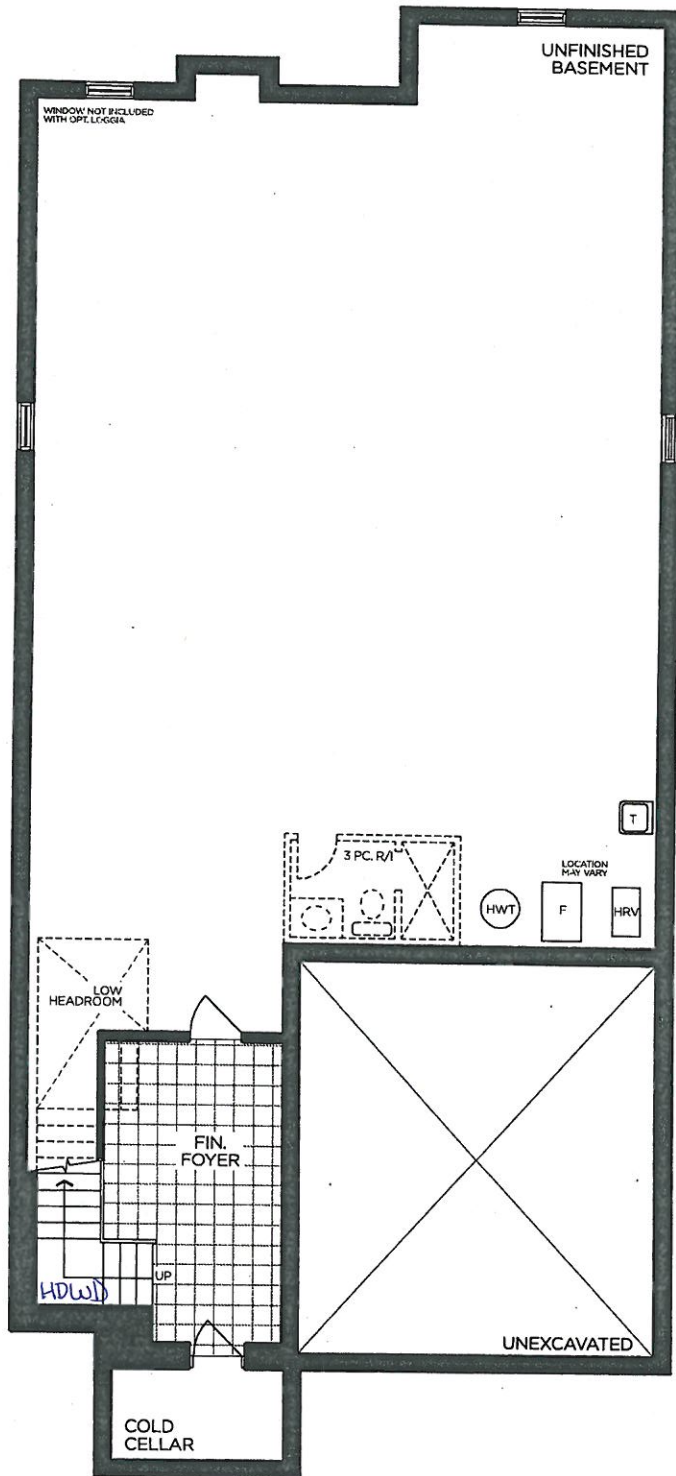


BASEMENT | ELEV. A

VENDOR	
PURCHASER	
PURCHASER	

GOLDPARK
WORTH MORE™

Prices, figures, illustrations, sizes, features and finishes are subject to change without notice. Areas and dimensions are approximate and actual usable floor space may vary from the stated area. Layout may be reverse of the unit purchased. E. & O.E. 4201

PLAN VIEW

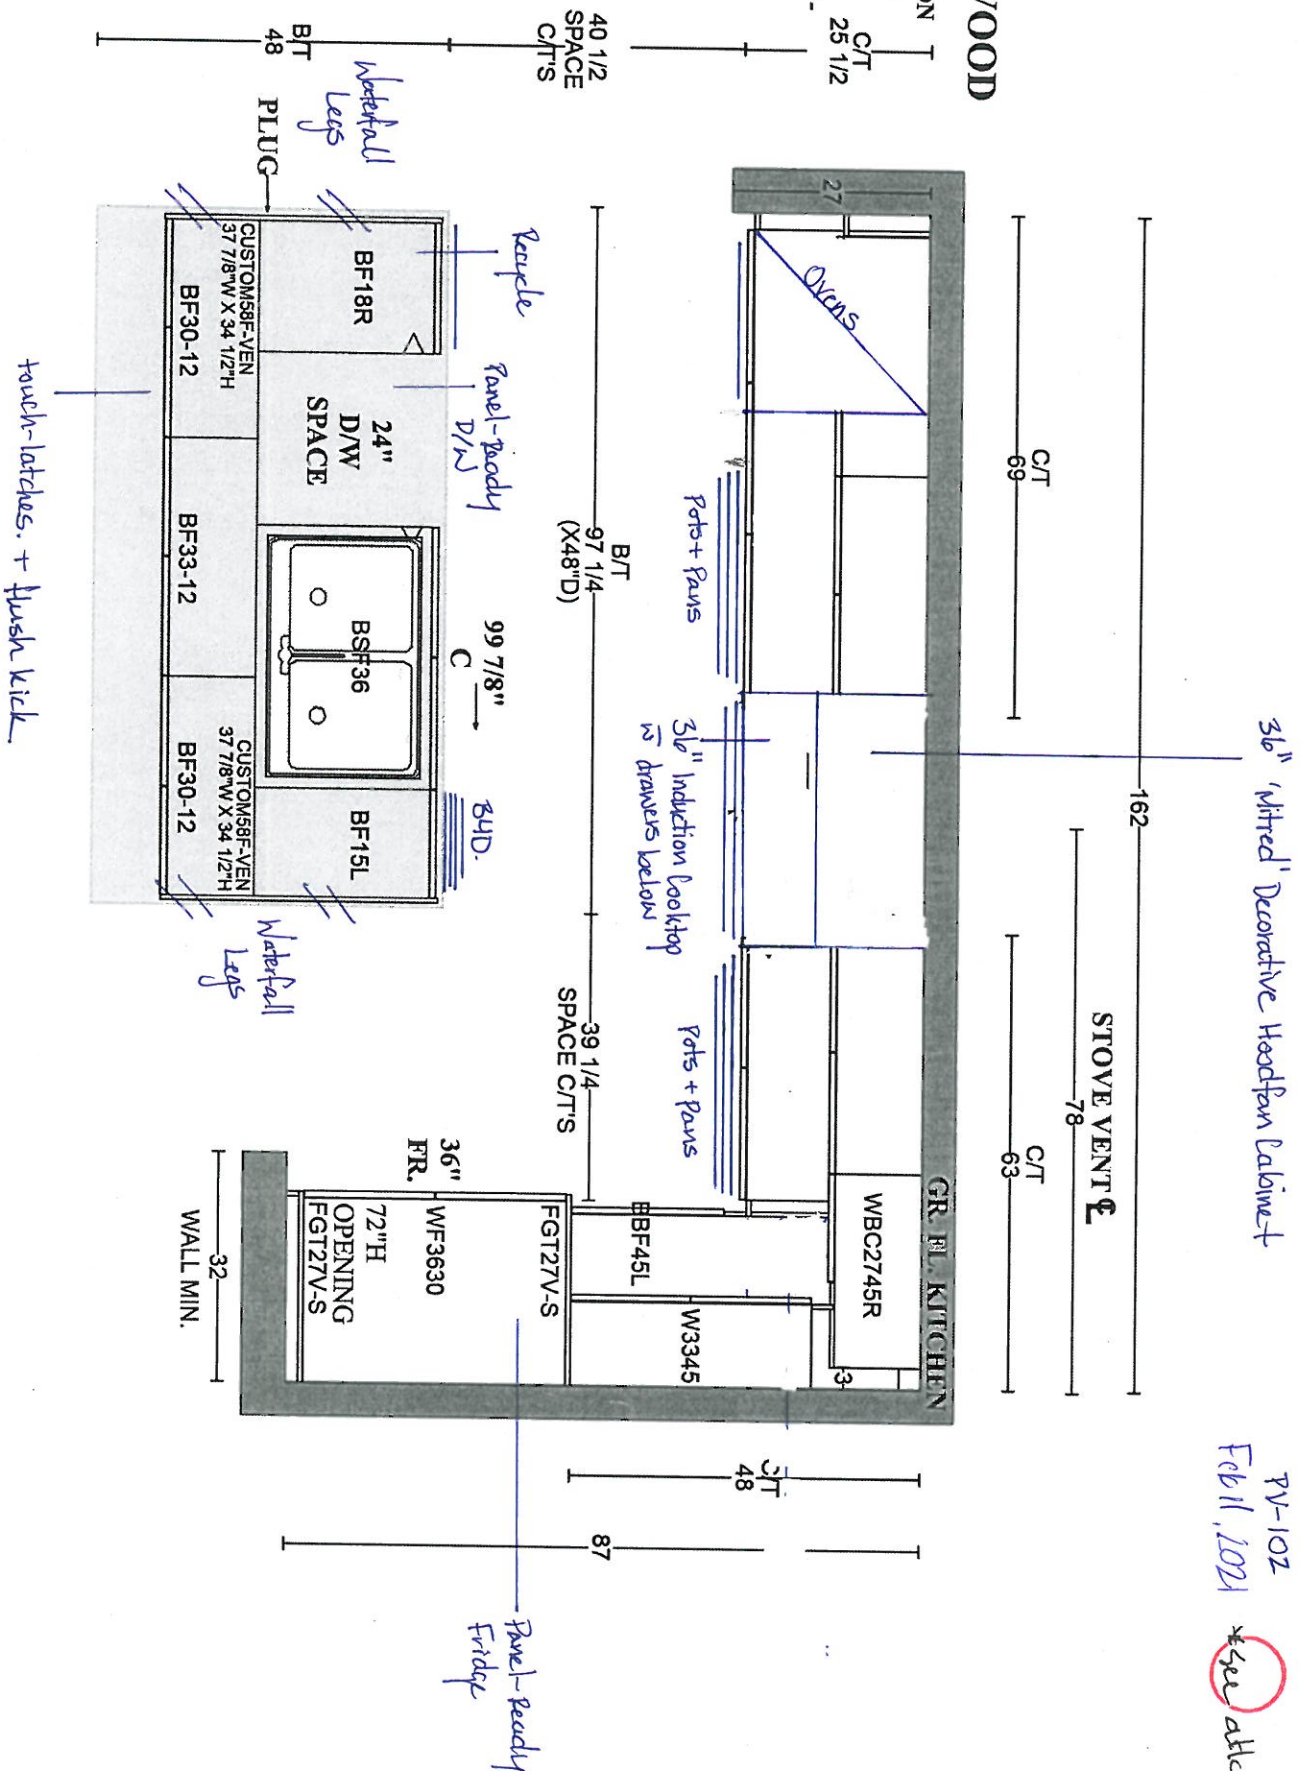


* See attach *

RV-102

Pantry at Breakfast

Feb 11, 2021

Manhattan 'Oyster'

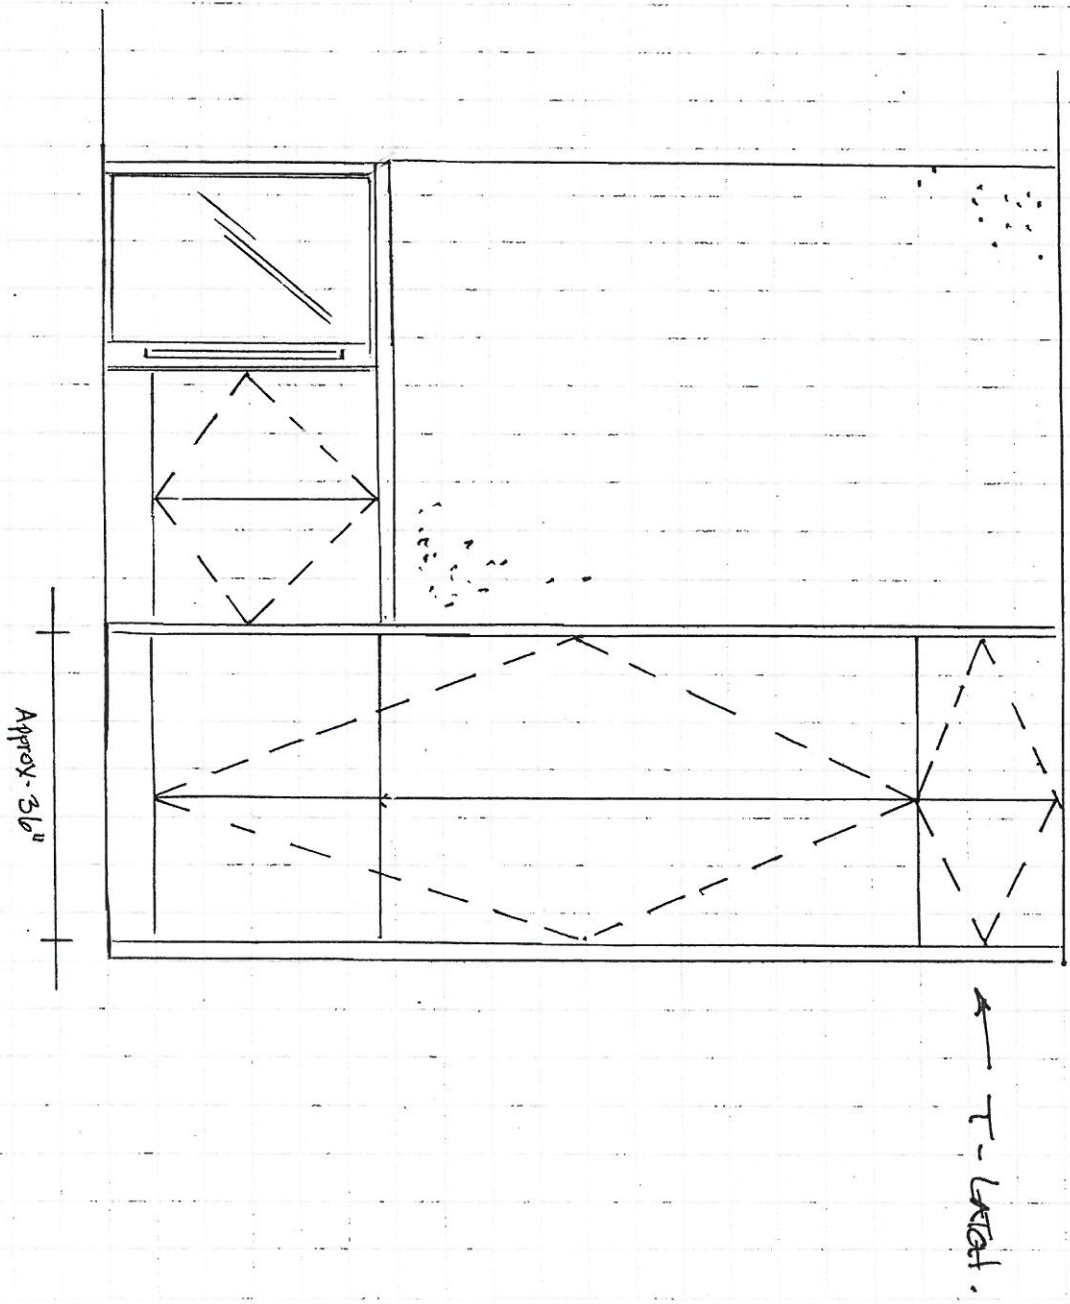



PV-102
Feb. 11, 2021

* See attach. *

**GOLDPARK HOMES
PINE VALLEY
VAUGHAN, ONTARIO
MODEL: (4201) MAPLEWOOD**



SITE STANDARD: WHITE 3/4" EXTENSION
SOFT-CLOSE DRAWERS & STANDARD SLAM DOOR HINGES
TO VANITIES

ONE TOP DRAWER WHERE POSSIBLE THROUGHOUT EACH
VANITY, ONE BANK OF DRAWERS WHERE POSSIBLE
THROUGHOUT EACH MASTER ENSUITE VANITY

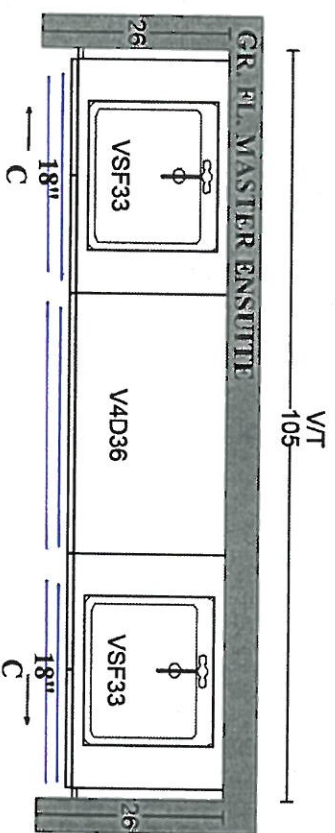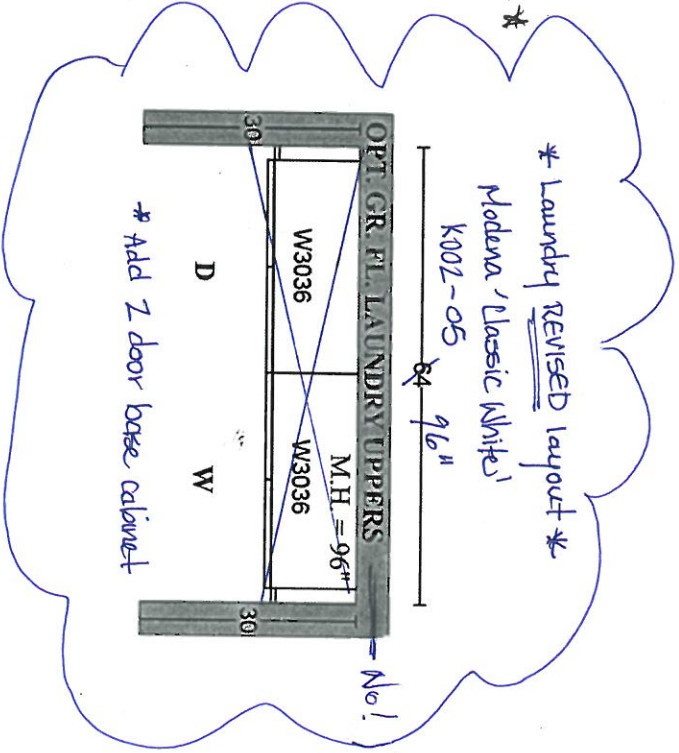


Modena 'Oyster' BATH-083-03

* Floating Vanity

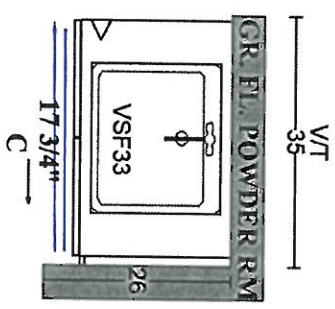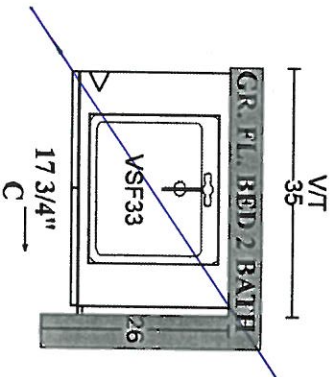

Broadway 11' PET Hi-gloss White BATH-083-03

* Floating vanity

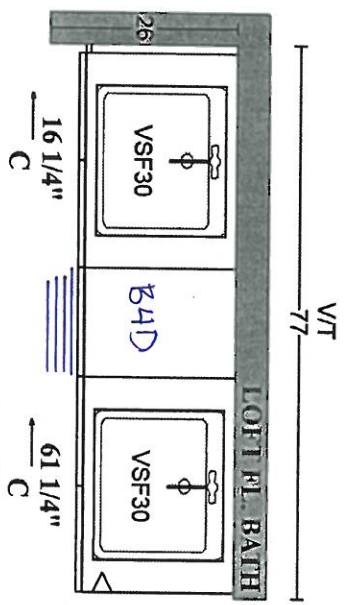

Modena 'Classic White' H039-03



PLAN VIEW



PINE VALLEY
FOREVERGREEN


STONE COUNTERTOP EDGE PROFILES



STANDARD 2CM EASED EDGE

LOCATION:

~~*THRU-OUT*~~

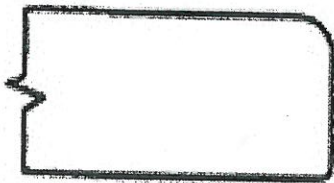


UPGRADE 3CM EASED EDGE


LOCATION:



UPGRADE 4CM MITRED EDGE

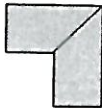

LOCATION:

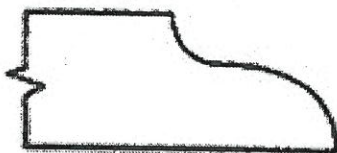

UPGRADE 2CM OGEE EDGE

LOCATION:

LOT #: PV-102

DATE: Feb 11, 2021

SIGNATURE: *see attach.*

SIGNATURE:

UPGRADE HARDWARE



CONTEMPORARY METAL PULL

806mm - 7191



LOCATION:

→ kitchen

LOT # PY-102

DATE: Feb 11, 2021

SIGNATURE:

* see attach. *


SIGNATURE:

UPGRADE HARDWARE



BAH-083-03

'Brushed Nickel'

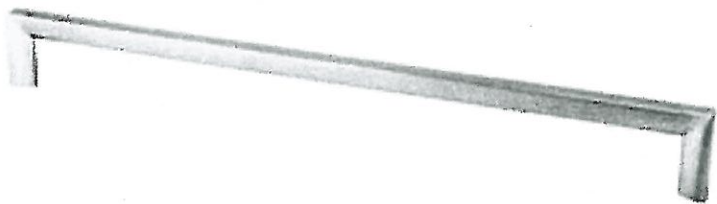

LOCATION:

→ Powder Room
→ Master ensuite

LOT # PV-102

DATE: Feb 11, 2021

SIGNATURE: * see attach. *

SIGNATURE:

STANDARD HARDWARE / HANDLES

☐

H001-02

☐

H001-03

☐

H001-04

☐

H009-03

☐

H009-09

☐


H011-03

☐

H011-05

☐

H011-06

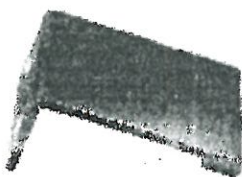☐

H033-01

☒

H039-03

→ loft bath.

☐

*NO HARDWARE

LOT # PV-102

DATE: Feb. 11 2021

SIGNATURE:  *see attach *

SIGNATURE:

STANDARD HARDWARE / KNOBS

☐

K002-02

☐

K002-03

☐

K002-04

☐

K002-06

☒

K002-05

→ Laundry

☐

K002-14

☐

K024-03

☐

*NO HARDWARE

LOT # PV-102

DATE: Feb 11 2021

SIGNATURE:



* see attach. *

SIGNATURE:





PINE VALLEY

FOREVERGREEN

UPGRADE KITCHEN SINK

BLANCO - QUATRUS R15 U SUPER SINGLE
Stainless Steel - Undermount
32" x 18" x 9"

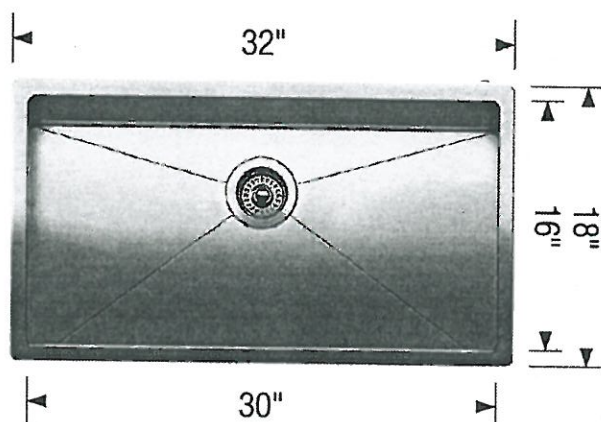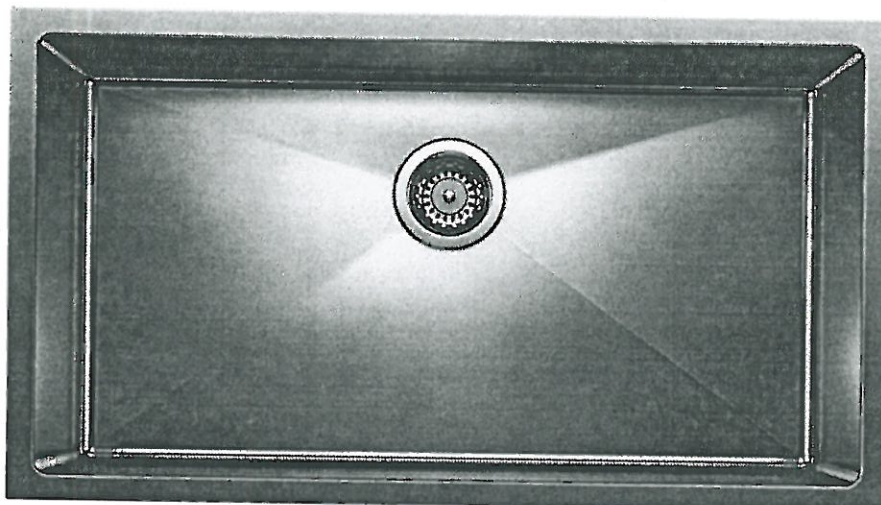

Stainless Steel

MODEL 401518 Stainless Steel

Lot#
TV-102

Room:
kitchen

Signature: *see attach*

Date:
Feb 11, 2021

Signature:

GOLDPARK
WORTH MORE




PINE VALLEY
FOREVERGREEN

UPGRADE SHOWER HARDWARE

MT6X6

Shower Door Handle

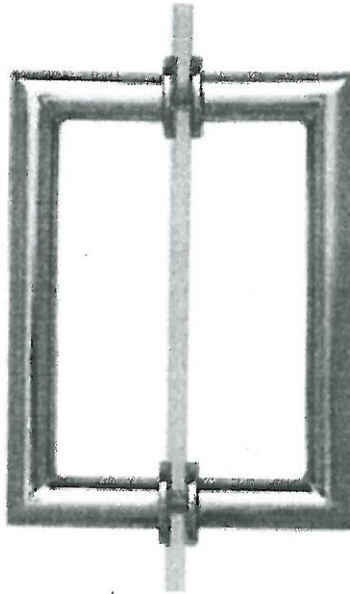

MT6X6
Shower Door Handle

6" x 6" back-to-back
3/4" dia. tube
Cut and mitred corners with
washers
(Also available single sided)



CHROME



MATTE BLACK



BRUSHED GOLD

Lot#

PV-102

Date:

Feb 11, 2021

Room:

Master Ensuite + Loft Bath

Signature:


*see attach. *

Signature:




PINE VALLEY
FOREVERGREEN

BATHROOM ACCESSORIES

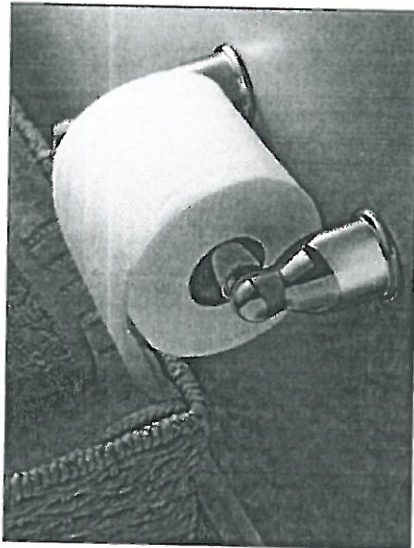

Tissue Holder
Mason - Chrome

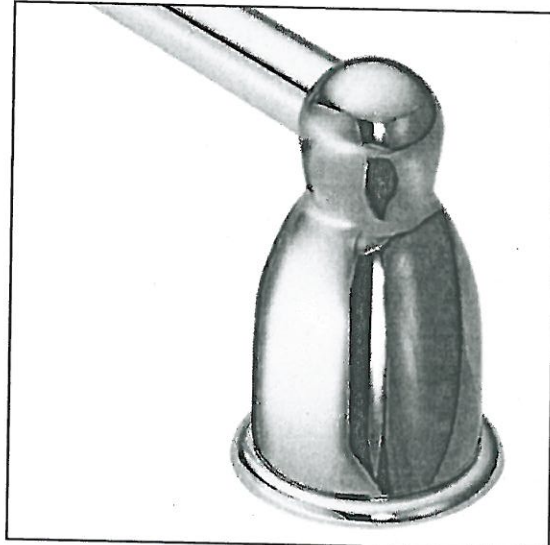

Towel Bar
Mason - Chrome

Please select one of the following:

☐ INSTALL STANDARD BATHROOM ACCESSORIES THRU OUT
(tissue holder + towel bar) **location as per vendors discretion**

☐ ***DO NOT*** INSTALL STANDARD BATHROOM ACCESSORIES
THRU OUT **tissue holder + towel bar will not be provided**

LOT #
PV-102

DATE:
Feb 11, 2021

SIGNATURE: X see attach. X

SIGNATURE:



Project: Pine Valley

Lot: 102

Purchaser(s): Ermenziana Simone

Standard Hood Fan Deletion

We acknowledge that the builder's standard hood fan will not be installed.
Do not supply, install and/or credit. We will install our own hood fan after closing.

Signature:  * see attach *

Signature: _____


Date: February 11 2021



PINE VALLEY

FOREVERGREEN

Range Hood - Mitred Square

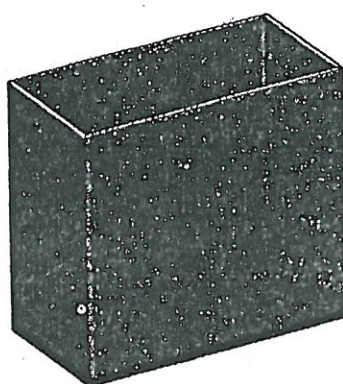

Lot#
PV-102

Room:
Kitchen



Signature:  * see attach. *

Date:
Feb 11, 2021

Signature:

POSI-TEMP SHOWER ONLY* W/ 3 FUNCTION TRANSFER
VALVE/TRIM AND SLIDE BAR WITH HAND SHOWER

MOEN - 90 DEGREE

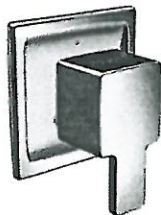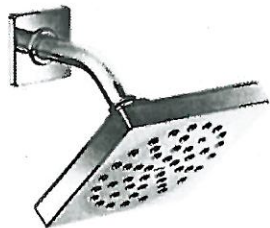

☒ CHROME

☐ BRUSHED NICKEL

☐ from WALL

☒ from CEILING

MODEL TS2712EP / 3372 / TS4172 / 62320 / S3879EP / A721

Lot#
102.

Room:
MASTER ENSUITE

Signature:
 see attached.

Date:
MAY 25 2020


Signature:


PLUMBING UPGRADES



POST-TEMP SHOWER ONLY* W/ 3 FUNCTION TRANSFER VALVE/TRIM AND SLIDE BAR WITH HAND SHOWER

MOEN - 90 DEGREE

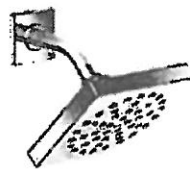

- ☒ CHROME
☐ BRUSHED NICKEL

- ☐ from WALL
☒ from CEILING

MODEL TS2712EP / 3372 / TS4172 / 62320 / S3879EP / A721

Lot# 102.

Room: MASTER ENSUITE

Signature: [Signature]

Date: MAY 25 2020

Signature: [Signature]