



CONSTRUCTION SUMMARY

Lot: 156
Model: 40.01 B SUMMERDALE
Project/Phase: Pine Valley Forevergreen / 1

BASEMENT WINDOWS

Invoice	Qty.	Description
2492 72,351 01Dec20	2	BASEMENT WINDOWS - UPGRADE BASEMENT WINDOW SIZE TO 30 " X 24" - 8" FRAME

CERAMIC

Invoice	Qty.	Description
2599 39 23Feb21	1	FRONT FOYER: TILE, FLOOR , LEVEL 7 - 30X30" LAID IN STRAIGHT, STACKED PATTERN.
2599 37 23Feb21	1	POWDER ROOM: TILE, FLOOR , LEVEL 5 - 12X24" LAID IN STRAIGHT, STACKED PATTERN. SEE PLAN FOR TILE DIRECTION
2599 39 23Feb21	1	KITCHEN: TILE, FLOOR , LEVEL 7 - 30X30" LAID IN STRAIGHT, STACKED PATTERN.
2599 23Feb21 NoCat	1	MASTER ENSUITE: ADD TILE TO SHOWER CEILING (SAME AS WALL TILE - STD LEVEL)
2599 23Feb21 NoCat	1	ENSUITE 2: ADD TILE TO SHOWER CEILING (SAME AS WALL TILE - STD LEVEL)
2599 23Feb21 NoCat	1	MASTER ENSUITE: MOEN 'ALIGN' RAIN SHOWER (from ceiling) + HAND SHOWER/SLIDE BAR - CHROME

CONCRETE AND DRAIN

Invoice	Qty.	Description
2492 01Dec20 NoCat	1	BACK-FLOW PREVENTER VALVE

DRYWALL

Invoice	Qty.	Description
2492 72,351 01Dec20 **	2	BASEMENT WINDOWS - UPGRADE BASEMENT WINDOW SIZE TO 30 " X 24" - 8" FRAME
2492 72,324 01Dec20 **	2	GARAGE DOOR OPENER (CHAMBERLAIN BELT DRIVE) - WITH 1 REMOTE - PRICE IS PER DOOR
2492 01Dec20 ** NoCat	2	GARAGE DOOR OPENER (CHAMBERLAIN BELT DRIVE) - WITH 1 REMOTE - PRICE IS PER DOOR

ELECTRICAL

Invoice	Qty.	Description
2492 72,351 01Dec20 **	2	BASEMENT WINDOWS - UPGRADE BASEMENT WINDOW SIZE TO 30 " X 24" - 8" FRAME
2492 72,281 01Dec20	1	FAMILY ROOM: INTERIOR WALL OUTLET: ADDITIONAL 110V WALL INTERIOR RECEPTACLE ON EXISTING CIRCUIT FOR WALL MOUNTED TV - LOCATE APPROX 66" A.F.F. ABOVE FIREPLACE
2492 72,289 01Dec20	6	KITCHEN: 4" E/S LED INTERIOR POT LIGHT - GROUND FLOOR - EACH - INCLUDES 1 SWITCH INCLUDED IN APS
2492 72,289 01Dec20	4	BREAKFAST ROOM: 4" E/S LED INTERIOR POT LIGHT - GROUND FLOOR - EACH
2492 72,278 01Dec20	1	BREAKFAST: ADDITIONAL INTERIOR SWITCH FOR POTLIGHTS
2492 72,280 01Dec20	2	KITCHEN: CEILING OUTLET: ADDITIONAL REINFORCED CEILING OUTLET - LOCATE APPROX CENTERED ABOVE ISLAND, USE STANDARD SWITCH
2492 72,289 01Dec20	7	MAIN HALL: 4" E/S LED INTERIOR POT LIGHT - GROUND FLOOR - EACH IN LIEU OF STANDARD LIGHT, USE STANDARD SWITCHES
2492 72,289 01Dec20	6	STUDY: 4" E/S LED INTERIOR POT LIGHT - GROUND FLOOR - EACH IN ADDITION TO STD CEILING LIGHT
2492 72,278 01Dec20	1	STUDY: ADDITIONAL INTERIOR SWITCH FOR POTLIGHTS
2492 72,289 01Dec20	8	FAMILY ROOM: 4" E/S LED INTERIOR POT LIGHT - GROUND FLOOR - EACH IN ADDITION TO STANDARD CEILING LIGHT
2492 72,278 01Dec20	1	FAMILY ROOM: ADDITIONAL INTERIOR SWITCH FOR POTLIGHTS
2492 72,273 01Dec20	1	KITCHEN: 110V WALL RECEPTACLE ON SEPARATE CIRCUIT - GAS FIRED APPLIANCE - FOR AUX. EQUIPMENT - NOT A STOVE PLUG
2492 72,290 01Dec20	7	UPPER HALL+COMPUTER NICHE: 4" E/S LED INTERIOR POT LIGHT (INSULATED CEILING) - SECOND FLOOR - EACH IN LIEU OF STANDARD CEILING LIGHTS, USE STANDARD SWITCHES



CONSTRUCTION SUMMARY

Lot: 156
Model: 40.01 B SUMMERDALE
Project/Phase: Pine Valley Forevergreen / 1

ELECTRICAL

Invoice	Qty.	Description
2492 72,280 01Dec20	1	COMPUTER NICHE: CEILING OUTLET: ADDITIONAL REINFORCED CEILING OUTLET - SEE PLAN FOR APPROX LOCATION
2492 72,278 01Dec20	1	COMPUTER NICHE: ADDITIONAL INTERIOR SWITCH FOR LIGHT IN LOFT
2492 01Dec20 NoCat	1	BREAKFAST: UPGRADE EXTERIOR GARDEN DOOR ASSEMBLY TO 96"

FORM - FORMING

Invoice	Qty.	Description
2492 72,351 01Dec20 **	2	BASEMENT WINDOWS - UPGRADE BASEMENT WINDOW SIZE TO 30 " X 24" - 8" FRAME

FRAMING

Invoice	Qty.	Description
2492 01Dec20 NoCat	1	BREAKFAST: UPGRADE EXTERIOR GARDEN DOOR ASSEMBLY TO 96"
2599 23Feb21 NoCat	1	MASTER ENSUITE: MOEN 'ALIGN' RAIN SHOWER (from ceiling) + HAND SHOWER/SLIDE BAR - CHROME

GARAGE DOORS

Invoice	Qty.	Description
2492 72,324 01Dec20	2	GARAGE DOOR OPENER (CHAMBERLAIN BELT DRIVE) - WITH 1 REMOTE - PRICE IS PER DOOR
2492 72,323 01Dec20	1	GARAGE: WIRELESS KEYPAD GARAGE DOOR ENTRY 877LM
2492 01Dec20 ** NoCat	2	GARAGE DOOR OPENER (CHAMBERLAIN BELT DRIVE) - WITH 1 REMOTE - PRICE IS PER DOOR

GLASS AND MIRROR

Invoice	Qty.	Description
2599 23Feb21 NoCat	2	MASTER ENSUITE + ENSUITE 2: UPGRADE SHOWER DOOR HARDWARE - MT6X6 CHROME



CONSTRUCTION SUMMARY

Lot: 156
Model: 40.01 B SUMMERDALE
Project/Phase: Pine Valley Forevergreen / 1

GRANITE MARBLE QUARTZ

Invoice	Qty.	Description
2599 23Feb21 NoCat	1	KITCHEN: FULL HEIGHT SLAB BACKSPLASH - STANDARD LEVEL GRANITE

HARDWOOD

Invoice	Qty.	Description
2599 7 23Feb21	1	THRU OUT STANDARD AREAS: MAIN HALL/ FAMILY/ STUDY/ DINING/ UPPER HALL/ COMPUTER NICHE/ MASTER BEDROOM/ BEDROOM 2/ BEDROOM 3/ BEDROOM 4: VINTAGE SERIES, 5" WHITE OAK, NSS ENGINEERED HARDWOOD, 3/4" THK, SCULPTED TEXTURE, UVF FINISH - LEVEL 4

HVAC

Invoice	Qty.	Description
2492 72,224 01Dec20	1	KITCHEN: GAS LINE ROUGH-IN - MAIN FLOOR FOR APPLIANCE - RANGE
2492 72,247 01Dec20	1	HUMIDIFER - LENNOX MODEL WB3-17 (2000 UP TO 3000 SQ.FT.)
2492 72,215 01Dec20	1	FURNACE - LENNOX 2 STAGE VARIABLE SPEED FURNACE (90,000 TO 110,000 BTU FOOT S) IN LIEU OF STANDARD OFFERING - (PINE VALLEY SITE ONLY - REFERENCE MODEL SPECIFIC FOR FURANCE UPGRADE EXTRA)
2492 72,238 01Dec20	1	3.5 TON AC - WITH LOW VOLTAGE WIRING & WALL BRACKETS (13ACX)
2492 01Dec20 ** NoCat	1	HUMIDIFER - LENNOX MODEL WB3-17 (2000 UP TO 3000 SQ.FT.)
2492 01Dec20 ** NoCat	1	HUMIDIFER - LENNOX MODEL WB3-17 (2000 UP TO 3000 SQ.FT.)
2492 01Dec20 ** NoCat	1	FURNACE - LENNOX 2 STAGE VARIABLE SPEED FURNACE (90,000 TO 110,000 BTU FOOT S) IN LIEU OF STANDARD OFFERING - (PINE VALLEY SITE ONLY - REFERENCE MODEL SPECIFIC FOR FURANCE UPGRADE EXTRA)
2492 01Dec20 ** NoCat	1	3.5 TON AC - WITH LOW VOLTAGE WIRING & WALL BRACKETS (13ACX)

INTERIOR TRIM /MOULDINGS

Invoice	Qty.	Description
2492 72,351 01Dec20 **	2	BASEMENT WINDOWS - UPGRADE BASEMENT WINDOW SIZE TO 30 " X 24" - 8" FRAME



CONSTRUCTION SUMMARY

Lot: 156
Model: 40.01 B SUMMERDALE
Project/Phase: Pine Valley Forevergreen / 1

MASONRY

Invoice	Qty.	Description
2492 01Dec20 NoCat	1	BREAKFAST: UPGRADE EXTERIOR GARDEN DOOR ASSEMBLY TO 96"

NETWORK AND WIRING

Invoice	Qty.	Description
2492 72,259 01Dec20	1	FAMILY ROOM: CONDUIT PIPE - FOR WALL MOUNT TV - LOCATE APPROX 66" A.F.F. ABOVE FIREPLACE, THRU BASEMENT, TERMINATING AT CABLE LOCATION. SEE PLAN FOR LOCATION
2492 72,258 01Dec20	2	FAMILY ROOM + COMPUTER STUDY: ADDITIONAL CAT6 ETHERNET OUTLET - EACH SEE PLAN FOR LOCATION
2492 72,264 01Dec20	1	LAUNDRY: ROUGH - IN FOR EXTRA SECURITY KEY PAD
2492 01Dec20 NoCat	1	GARAGE: WIRELESS KEYPAD GARAGE DOOR ENTRY 877LM

PAINT

Invoice	Qty.	Description
2599 23Feb21 NoCat	2	MAIN STAIRS: STAIN STAIRS AND LANDINGS STAIRS AND LANDINGS WILL NOT MATCH HARDWOOD IN COLOUR/TEXTURE/SPECIES

PAINTING

Invoice	Qty.	Description
2492 72,351 01Dec20 **	2	BASEMENT WINDOWS - UPGRADE BASEMENT WINDOW SIZE TO 30 " X 24" - 8" FRAME

PANL - FRAMING

Invoice	Qty.	Description
2492 72,351 01Dec20 **	2	BASEMENT WINDOWS - UPGRADE BASEMENT WINDOW SIZE TO 30 " X 24" - 8" FRAME
2492 72,324 01Dec20 **	2	GARAGE DOOR OPENER (CHAMBERLAIN BELT DRIVE) - WITH 1 REMOTE - PRICE IS PER DOOR
2492 01Dec20 ** NoCat	2	GARAGE DOOR OPENER (CHAMBERLAIN BELT DRIVE) - WITH 1 REMOTE - PRICE IS PER DOOR



CONSTRUCTION SUMMARY

Lot: 156
Model: 40.01 B SUMMERDALE
Project/Phase: Pine Valley Forevergreen / 1

PLUMBING

Invoice	Qty.	Description
2492 72,332 01Dec20	1	KITCHEN: ROUGH-IN 1/4" COLD WATER LINE TO FRIDGE
2492 01Dec20 NoCat	1	BACK-FLOW PREVENTER VALVE
2599 23Feb21 NoCat	1	MASTER ENSUITE: MOEN 'ALIGN' RAIN SHOWER (from ceiling) + HAND SHOWER/SLIDE BAR - CHROME

ROUGH CARPENTRY

Invoice	Qty.	Description
2492 72,351 01Dec20 **	2	BASEMENT WINDOWS - UPGRADE BASEMENT WINDOW SIZE TO 30 " X 24" - 8" FRAME

STAIR AND RAILINGS

Invoice	Qty.	Description
2599 93,778 23Feb21	2	MAIN STAIRS: 2ND FLOOR TO BASEMENT: UPGRADE - EURONLINE (ALL PLAIN) PICKET, 3" HALF-ROUND W/V-GROOVE HANDRAIL, 3 1/2" ALL SQUARE POST WITH PYRAMID TOP POST CAP - PACKAGE A-2

STAIRS AND RAILINGS

Invoice	Qty.	Description
2599 23Feb21 NoCat	1	MAIN STAIRS: STAIN STAIRS AND LANDINGS STAIRS AND LANDINGS WILL NOT MATCH HARDWOOD IN COLOUR/TEXTURE/SPECIES

WINDOWS - BASEMENT

Invoice	Qty.	Description
2492 72,351 01Dec20 **	2	BASEMENT WINDOWS - UPGRADE BASEMENT WINDOW SIZE TO 30 " X 24" - 8" FRAME

WINDOWS AND DOORS

Invoice	Qty.	Description
2492 01Dec20 NoCat	1	BREAKFAST: UPGRADE EXTERIOR GARDEN DOOR ASSEMBLY TO 96"

Scheduled Closing Date: Thursday, June 24, 2021

Purchasers: Vay Dau Trong & My Phung Phan

Property: 156 of Plan -

Telephone Res. / Bus: / (416) 937-6590

Project: Pine Valley Forevergreen - Phase 1

Decor Advisor: Yolande Somerville

Model and Elevation: 40.01 B SUMMERDALE

Layout Changes: ☐ Yes ☒ NoSketch Attached: ☒ Yes ☐ No

Exterior Colour Scheme:

1. Cabinetry

	Style and Colour	Counter	Hardware
Kitchen / Breakfast	Alban oak 'Storm Grey'	Granite: Arctic White	attached
Laundry Room	Alban oak 'Storm Grey'	P-Lam: Std White	attached
Powder Room	Alban oak 'Storm Grey'	Quartz: Ice Snow	attached
Master Ensuite Bathroom	Alban oak 'Storm Grey'	Quartz: Ice Snow	attached
Second Ensuite Bathroom (If Applicable)	Alban oak 'Storm Grey'	Quartz: Ice Snow	attached
Main Bath	Alban oak 'Storm Grey'	Quartz: Ice Snow	attached

Comment

2. Floor Tile

	Selection
Entrance Vestibule	*30x30" Marmorea matte 'Bianco Statuario'
Main Hall	n/a
Kitchen / Breakfast	*30x30" Marmorea matte 'Bianco Statuario'
Laundry Room	13x13" Costa 'White'
Powder Room	*12x24" Marmorea matte 'Bianco Statuario'
Master Ensuite Bathroom	13x13" New Byzantine 'Azzuro Blue'
Second Ensuite Bathroom (If Applicable)	13x13" New Byzantine 'Azzuro Blue'
Lower Landing (If Applicable)	13x13" Costa 'White' (basement)
Main Bath	13x13" New Byzantine 'Azzuro Blue'

Comment

3. Wall Tile

	Selection	Listello/Inserts	Describe
		☐ Yes ☒ No	
Master Ensuite Bathroom			
Tub Deck		☐ Yes ☒ No	
Shower Stall	8x10" Weave 'White'	☐ Yes ☒ No	
Bathroom Walls		☐ Yes ☒ No	
Second Ensuite Bathroom (If Applicable)	8x10" Weave 'White'	☐ Yes ☒ No	
Main Bath	8x10" Weave 'White'	☐ Yes ☒ No	
Kitchen Backsplash	☒ Yes ☐ No	Backsplash Behind Fridge	
	*Granite FHBS - same as counter		

Comment

Purchasers: Vay Dau Trong & My Phung Phan

Property: 156 of Plan -

Telephone Res. / Bus: / (416) 937-6590

Project: Pine Valley Forevergreen - Phase 1

Decor Advisor: Yolande Somerville

Model and Elevation: 40.01 B SUMMERDALE

4. Plumbing Fixtures

☐	Second Ensuite	☐	Powder Room	☐
Master Ensuite Bathroom	☐	Other Room - Specify	☐	Other Washroom
☐				

Comment

Standard except Master Ensuite Shower

5. Hardwood Flooring

	Type and Stain		Type and Stain
Main Hall		Upper Landing	
Kitchen / Breakfast		Upper Hall	
Living Room		Master Bedroom	
Dining Room		Bedroom #2	
Family Room		Bedroom #3	
Den/Library		Bedroom #4	
Entrance Vestibule		Bedroom #5	
Lower Landing (If Applicable)		Other Room - Specify	
		Thru out standard areas	*3/4x5" white oak sculpted 'Apollo'

Comment

6. Carpeting

	Upgrade	Description
Ground Floor	☐	
Second Floor	☐	
	☐	

	Type	Area
Upgrade Underpad		
	Capped	Runner - *Upgrade
Carpet on Stairs		

Comment

7. Fireplace

	Living Room			Family Room			Other Room - Specify		
	Purchased	As Per Plan	N/A	Purchased	As Per Plan	N/A	Purchased	As Per Plan	N/A
	☐	☐	☒	☐	☒	☐	☐	☐	☒
Fireplace Type				Standard Gas					
Mantle Type				Mediterranean					
Colour / Stain				Arctic White					
Surround				n/a					
Hearth				none					

Comment

Purchasers: Vay Dau Trong & My Phung Phan

Property: 156 of Plan -

Telephone Res. / Bus: / (416) 937-6590

Project: Pine Valley Forevergreen - Phase 1

Decor Advisor: Yolande Somerville

Model and Elevation: 40.01 B SUMMERDALE

8. Trim Carpentry

Interior Doors Front Door Glass Inserts Door Handles
 Interior Trim
 Comment

9. Plaster Mouldings and Medallions

Standard Throughout ☐ Yes ☐ No ☒ N/A

Entrance Vestibule			Kitchen/Breakfast		
Main Hall			Den/Library		
Living Room			Lower Landing		
Dining Room			Other Room - Specify		
Family Room					

Comment

10. Railings and Spindles

Railing Package
 Railing Colour Spindle Colour
 Stringer / Riser Treads
 Oak Stairs ☒ Yes ☐ No ☐ N/A

Comment

11. Wall Paint / Ceilings

Throughout Finished Areas

Trim Paint

Smooth Ceilings

Ground Floor ☒

Second Floor ☒

Note

Comment

Purchasers: Vay Dau Trong & My Phung Phan

Property: 156 of Plan -

Telephone Res. / Bus: / (416) 937-6590

Project: Pine Valley Forevergreen - Phase 1

Decor Advisor: Yolande Somerville

Model and Elevation: 40.01 B SUMMERDALE

12. Electrical

Hood Fan ☐ White ☒ Stainless ☐ N/A

Above Kitchen Cabinet Light ☐ Yes ☒ No

Below Kitchen Cabinet Light ☐ Yes ☒ No

Standard Appliances ☐

Over The Range Microwave ☐

Chimney Style Fan ☒

Comment

13. Heating and Air Conditioning

Air Conditioning

Gas Provisions Stove

Gas Provisions Dryer

Gas Provisions Barbecue

Comment

14. Additional Comments

15. Disclaimers and Notes

- Colours of all materials are as close as possible to builder's selection, but not necessarily identical due to variances in manufacturing.
- Any extras listed above are null and void unless accompanied by a separate invoice/amendment. Said invoice must be paid in full.
- The Purchaser acknowledges that after Interior Colour Selection form is signed and dated, no further changes will be permitted other than re-selection due to unavailability. _____ Purchaser's Initials
- The Purchaser acknowledges reading and accepting the "Gold Park Homes Decor Centre Disclaimers" form. This document contains other miscellaneous disclaimers.

This Interior Colour Selection is final and approved by:

Signature: _____ Date: _____

SCHEDULE 'F'



PV-156

NOV 23 2020

PV-156

Feb. 22, 2021

* 5th attach. *

[Handwritten signature]

9th GARDEN


8'3-PANEL GARDEN

The Summerdale

40' SERIES

Elevation A • 2,895 sq.ft.

→ Elevation B • 2,880 sq.ft.

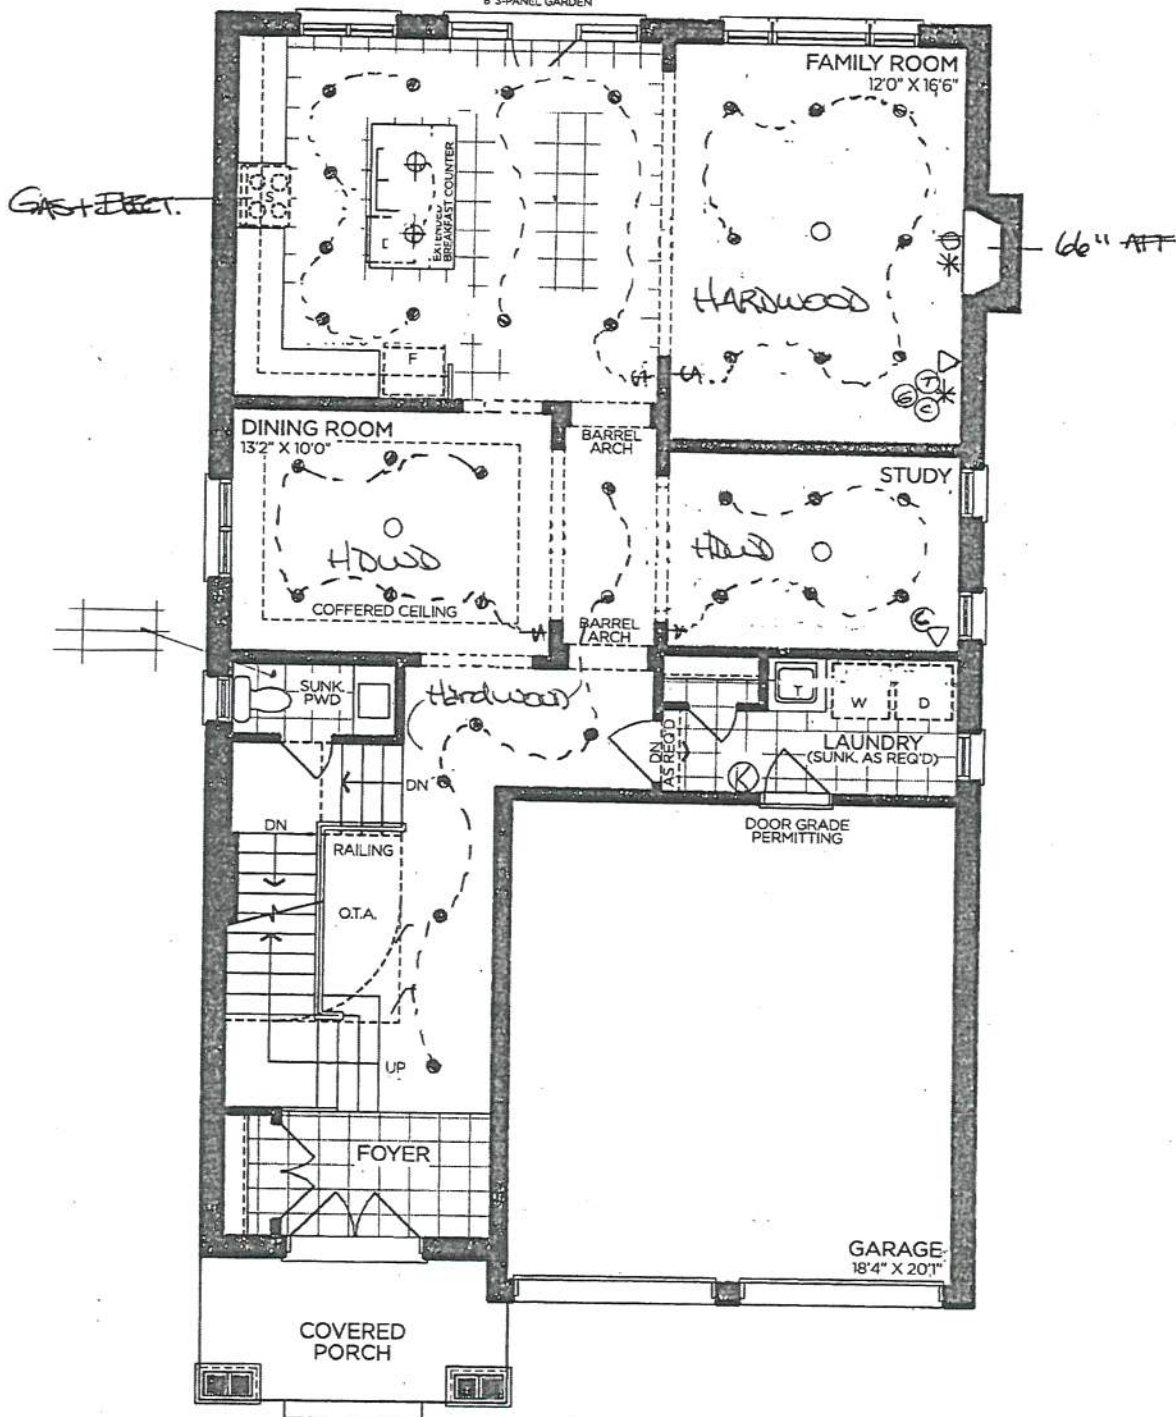

GROUND FLOOR | ELEV. A

VENDOR

PURCHASER

PURCHASER

GOLDPARK

WORTH MORE™

Prices, figures, illustrations, sizes, features and finishes are subject to change without notice. Areas and dimensions are approximate and actual usable floor space may vary from the stated area. Layout may be reverse of the unit purchased. E. & O.E. 4001

SCHEDULE 'F'



PV-156
Nov. 23, 2020


PV-156
Feb. 22, 2021

* See attach *

The Summerdale

40' SERIES

Elevation A • 2,895 sq.ft.
Elevation B • 2,880 sq.ft.

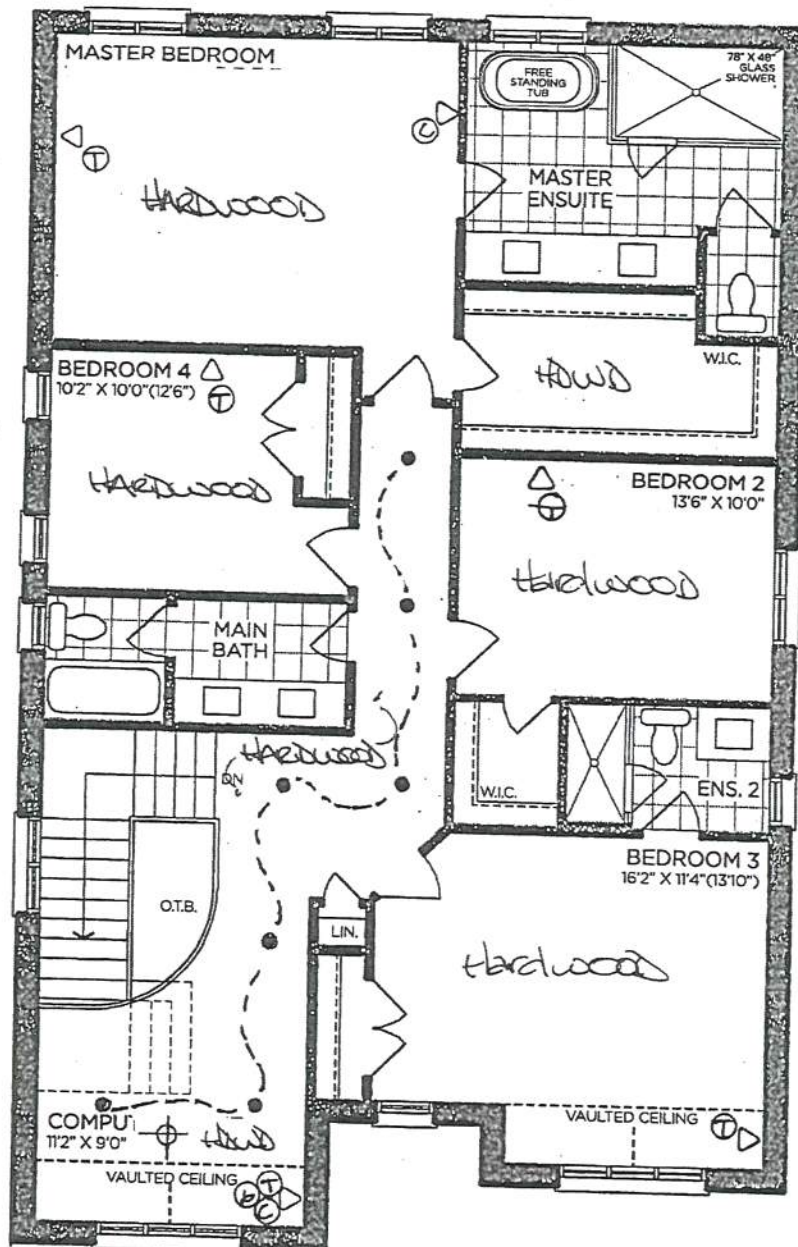

SECOND FLOOR | ELEV. A

VENDOR	
PURCHASER	
PURCHASER	

GOLDPARK
WORTH MORE™

Prices, figures, illustrations, sizes, features and finishes are subject to change without notice. Areas and dimensions are approximate and actual usable floor space may vary from the stated area. Layout may be reverse of the unit purchased. E. & O.E. 4001

SCHEDULE 'F'



PV-156

Nov 23 2020

PV-156

Feb. 22, 2021

24x30"

The Summerdale

40' SERIES


Elevation A • 2,895 sq.ft.

Elevation B • 2,880 sq.ft.

24x30"

16x30"

BFPV.

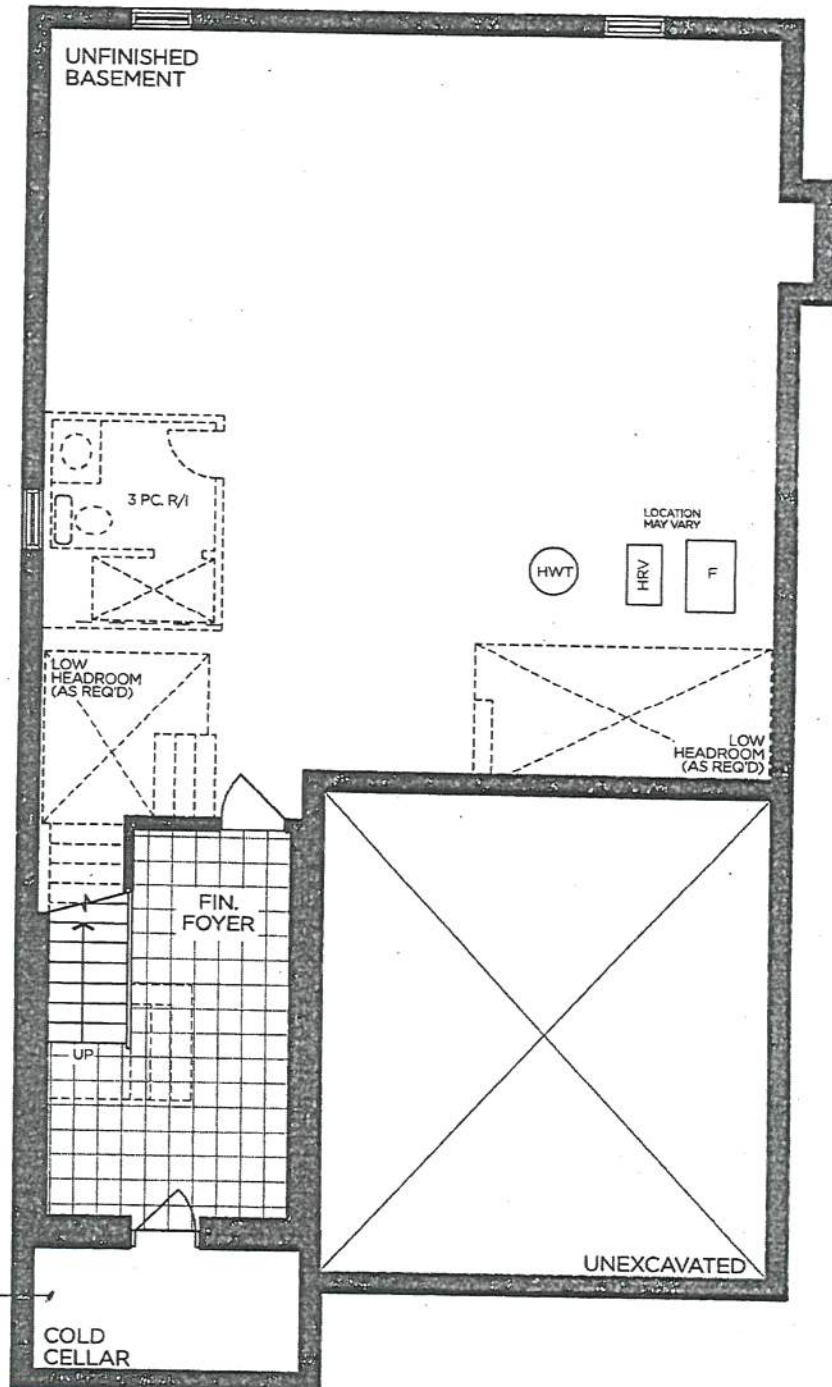

BASEMENT | ELEV. A

VENDOR

PURCHASER

PURCHASER

GOLDPARK
WORTH MORE™

Prices, figures, illustrations, sizes, features and finishes are subject to change without notice. Areas and dimensions are approximate and actual usable floor space may vary from the stated area. Layout may be reverse of the unit purchased. E. & O.E. 4001

SCHEDULE 'F'



PV-156

Nov 23 2020

PV-156


Feb. 22, 2021

*see attach. *


The Summerdale 40' SERIES

Elevation A • 2,895 sq.ft.


→ Elevation B • 2,880 sq.ft.

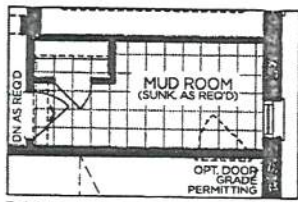


PART. GROUND FLOOR
MUDROOM FOR OPT.
SECOND FLOOR LAUNDRY

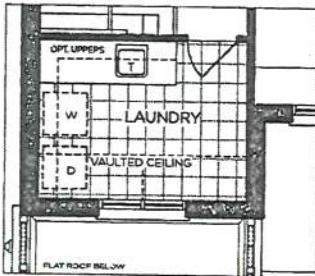


PART. SECOND FLOOR
W/ OPT. LAUNDRY
ELEV. B

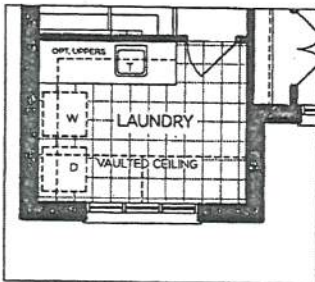


PART. SECOND FLOOR
W/ OPT. LAUNDRY
ELEV. A

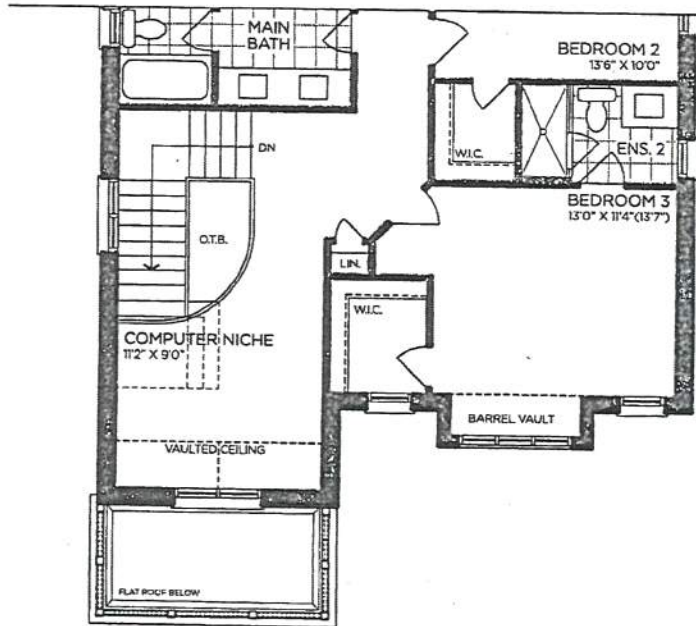

→ PART. SECOND FLOOR | ELEV. B

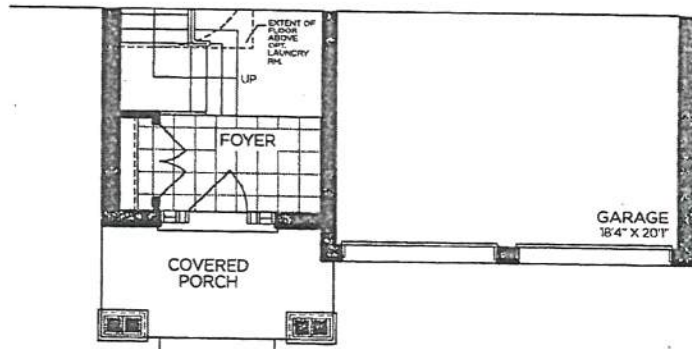

→ PART. GROUND FLOOR | ELEV. B

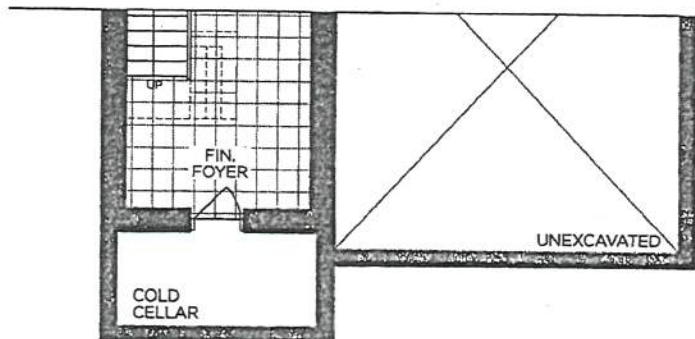

→ PART. BASEMENT | ELEV. B

VENDOR

PURCHASER

PURCHASER


GOLDPARK
WORTH MORE™

Prices, figures, illustrations, sizes, features and finishes are subject to change without notice. Areas and dimensions are approximate and actual usable floor space may vary from the stated area. Layout may be reverse of the unit purchased. E. & O.E. 4001

Alban Oak' storm grey Oak'

- * Standard appliance openings
- Kitchen layout.

standard chimney

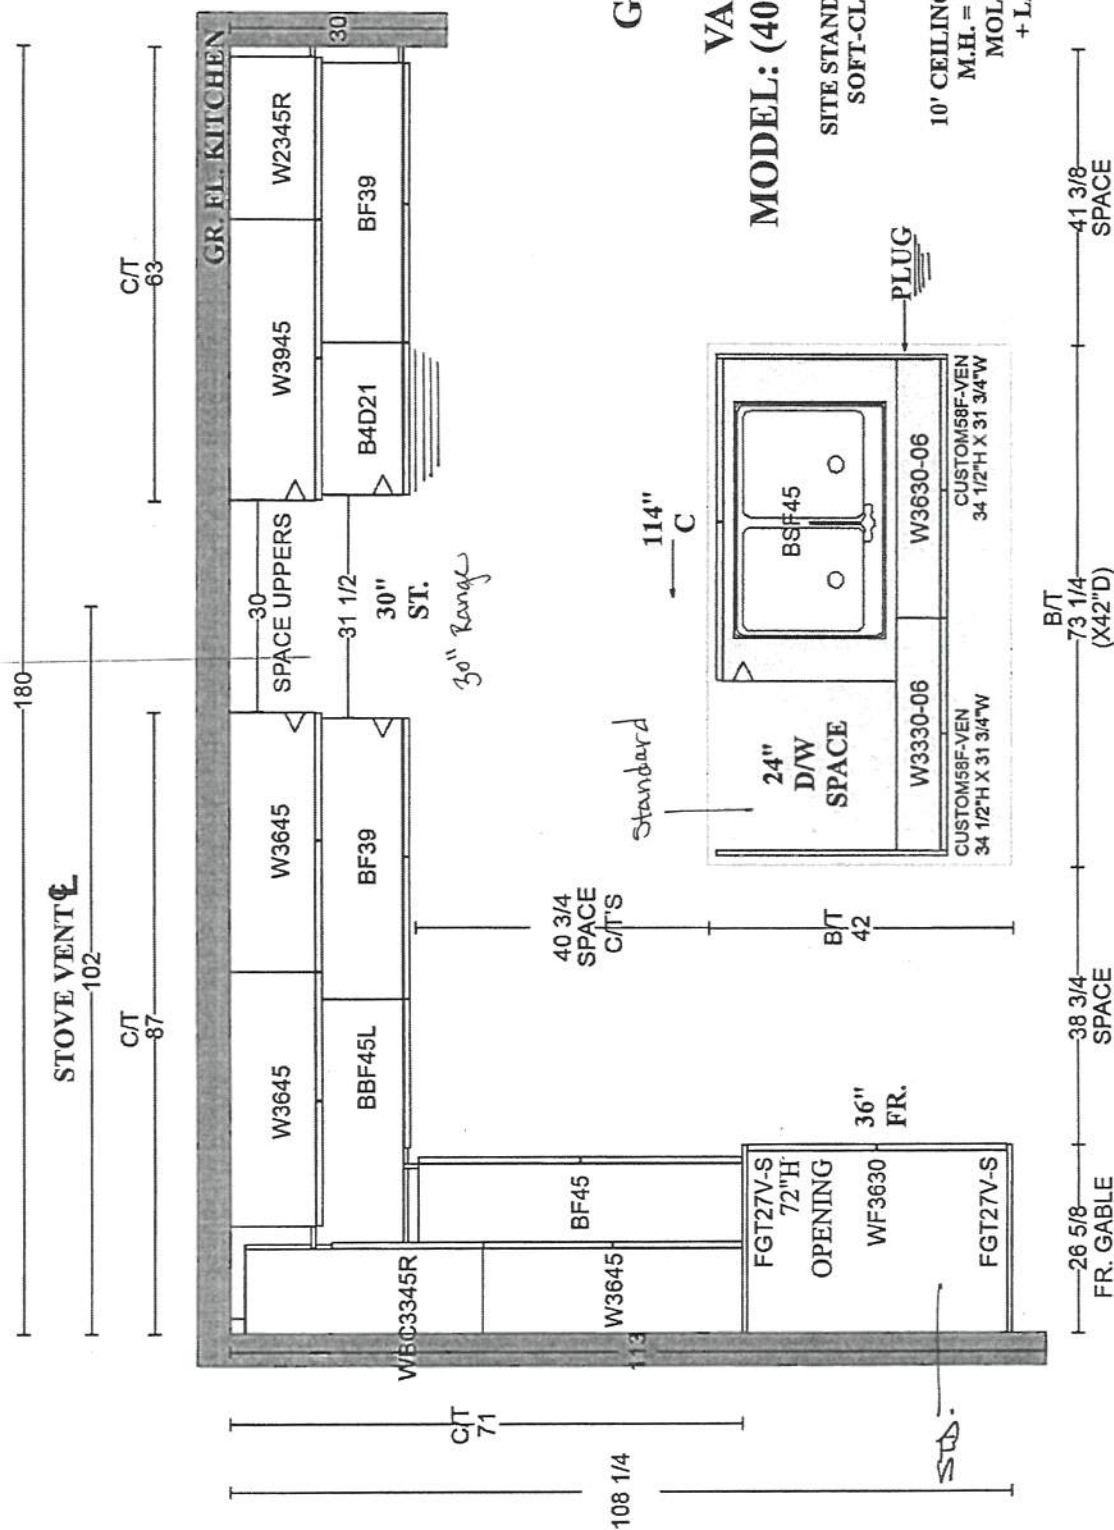

**GOLDPARK HOMES
PINE VALLEY
VAUGHAN, ONTARIO
MODEL: (4001) SUMMERDALE**

**SITE STANDARD: WHITE 3/4" EXTENSION
SOFT-CLOSE DRAWERS & SOFT-CLOSE
HINGES TO KITCHEN AREA**

10' CEILING - 12"H COFFERED CEILING -
M.H. = 102" + 3/4"H CONTEMPORARY
MOLDING + 5 1/4"H FURRING RAIL
+ LARGE CORNICE MOLDING TO
UNDERSIDE OF BOX

PLAN VIEW

Aya

PV-156
Feb. 22, 2021



Alban 'Oak Storm Grey'

* Take out: *
Alban 'Oak Storm Grey'




GOLDPARK HOMES
PINE VALLEY
VAUGHAN, ONTARIO
MODEL: (4001) SUMMERDALE

SITE STANDARD: WHITE 3/4" EXTENSION
SOFT-CLOSE DRAWERS & STANDARD SLAM DOOR HINGES
TO VANITIES

ONE TOP DRAWER WHERE POSSIBLE THROUGHOUT EACH
VANITY, ONE BANK OF DRAWERS WHERE POSSIBLE
THROUGHOUT EACH MASTER ENSUITE VANITY

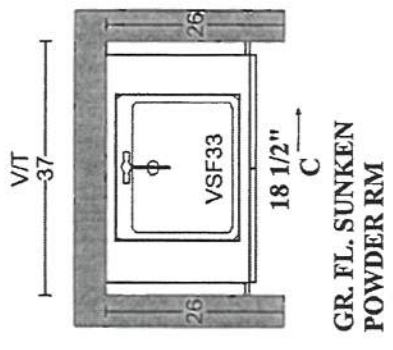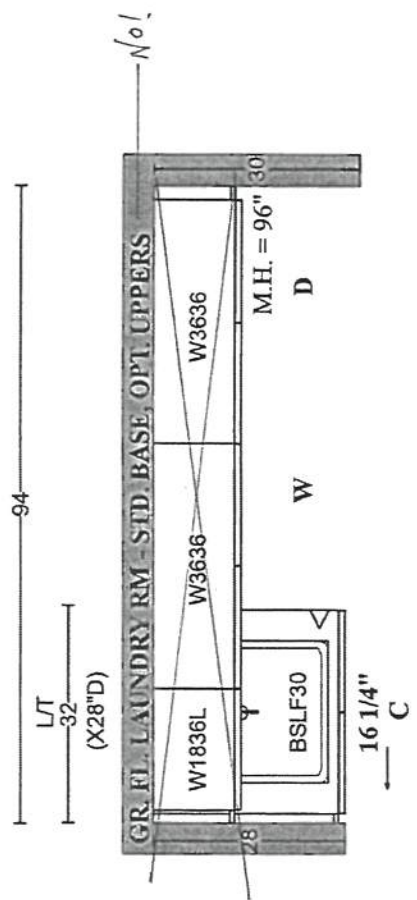

GR. FL. SUNKEN
POWDER RM

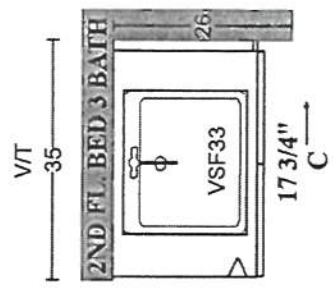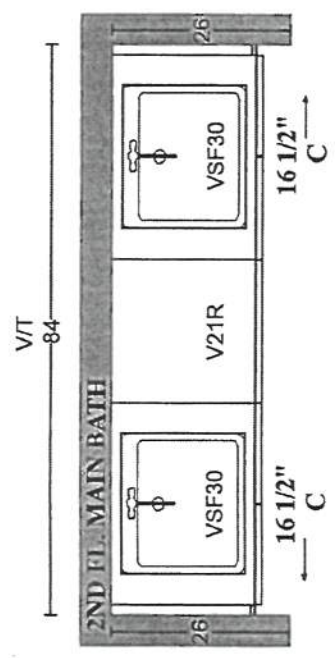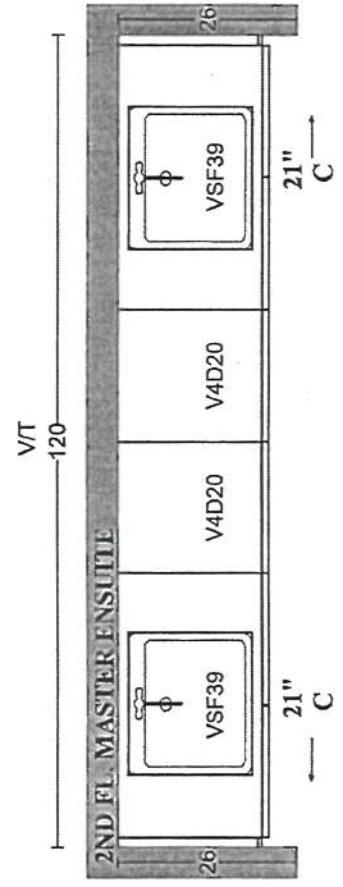


PLAN VIEW



PINE VALLEY
FOREVERGREEN

STONE COUNTERTOP EDGE PROFILES

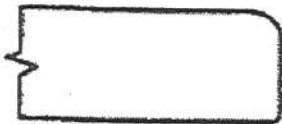

STANDARD 2CM EASED EDGE

LOCATION:

THRU OUT.




UPGRADE 3CM EASED EDGE


LOCATION:



UPGRADE 4CM MITRED EDGE

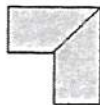

LOCATION:

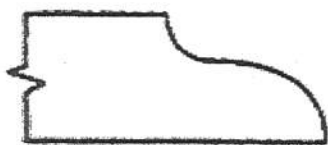

UPGRADE 2CM OGEE EDGE

LOCATION:

LOT #: PV-156

DATE: Feb. 22, 2021

SIGNATURE:

SIGNATURE:

GOLDPARK
WORTH MORE

STANDARD HARDWARE / HANDLES



☐ H001-02



☐ H001-03



☐ H001-04



☐ H009-03



☐ H009-09




☐ H011-03



☐ H011-05



☐ H011-06

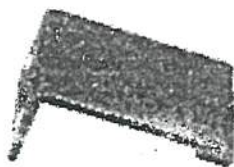

☐ H033-01



☒ H039-03
POWDER
LAUNDRY
MASTER

☐ *NO HARDWARE

LOT # PV-156

DATE: Feb. 22, 2021

SIGNATURE:

SIGNATURE:

STANDARD HARDWARE / KNOBS

☐

K002-02

☐

K002-03

☐

K002-04

☐

K002-06

☒

K002-05

KITCHEN

☐

K002-14

☐

K024-03

☐

*NO HARDWARE

LOT # PV-156

DATE: Feb. 22, 2021

SIGNATURE:



SIGNATURE:



PLUMBING UPGRADES



MOEN - ALIGN

Posi-Temp SHOWER ONLY* with 3 Function Transfer Valve/Trim and Slide Bar with Handshower



*CHROME ONLY
*from CEILING

MODEL: T2192EP / U361CI / UT4191 / 62320 / 3887EP / A725 / 226651 / S1002


Lot# 156	Date: FEB 22 2021	Room: MASTER ENSUITE
Signature: 		
Signature: 		

UPGRADE SHOWER HARDWARE



MT6X6

Shower Door Handle

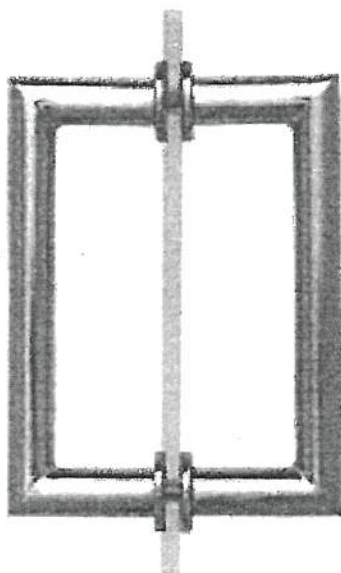


MT6X6
Shower Door Handle

6" x 6" back-to-back
3/4" dia. tube
Cut and mitred corners with
washers
(Also available single sided)


- ☒ CHROME
☐ MATTE BLACK
☐ BRUSHED GOLD

Lot# 156	Date: FEB 22 2021	Room: MASTER + ENS 2
Signature:		
Signature:		

BATHROOM ACCESSORIES

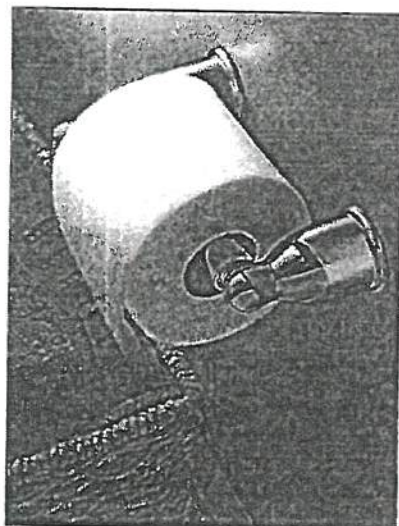

Tissue Holder
Mason - Chrome

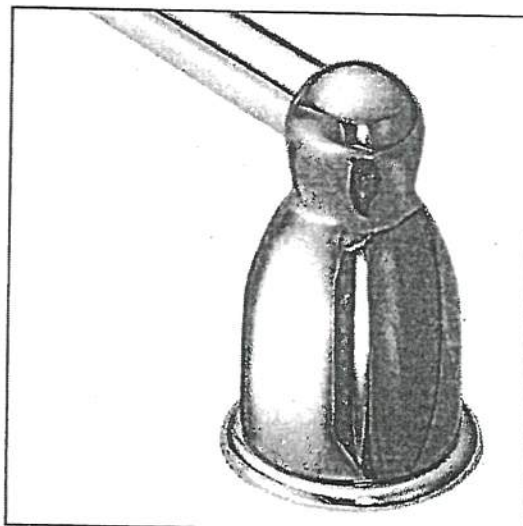

Towel Bar
Mason - Chrome

Please select one of the following:

☒ INSTALL STANDARD BATHROOM ACCESSORIES THRU OUT
(tissue holder + towel bar) **location as per vendors discretion**

☐ ***DO NOT*** INSTALL STANDARD BATHROOM ACCESSORIES
THRU OUT **tissue holder + towel bar will not be provided**

LOT # PV-156

DATE: Feb. 22, 2021

SIGNATURE:

A handwritten signature in black ink, appearing to be "C. H. H.", written over a horizontal line.

SIGNATURE:

A handwritten signature in black ink, appearing to be "Onur", written over a horizontal line.