



LOT NUMBER: 29
UNIT NAME: THE ROSEDALE
ELEVATION: C (REV)
UNIT NUMBER: 4202



LOT NUMBER: 27
UNIT NAME: FORESTCREST
ELEVATION: A
UNIT NUMBER: 4203

DEERHAVEN CRESCENT



LOT NUMBER: 26
UNIT NAME: LILAC
ELEVATION: A CORNER FRONT (REV)
UNIT NUMBER: 4006



LOT NUMBER: 26
UNIT NAME: LILAC
ELEVATION: A CORNER FLANKAGE (REV)
UNIT NUMBER: 4006



LOT NUMBER: 26
UNIT NAME: LILAC
ELEVATION: A CORNER REAR (REV)
UNIT NUMBER: 4006

It is the builder's complete responsibility to ensure that all plans submitted for approval fully comply with the Architectural Guidelines and all applicable regulations and requirements including zoning provisions and any provisions in the subdivision agreement. The Control Architect is not responsible in any way for examining or approving site (lotting) plans or working drawings with respect to any zoning or building code or permit matter or that any house can be properly built or located on its lot.

This is to certify that these plans comply with the applicable Architectural Design Guidelines approved by the City of VAUGHAN.

LOT 26

JOHN G. WILLIAMS LTD., ARCHITECT
ARCHITECTURAL CONTROL REVIEW
AND APPROVAL

APPROVED BY:
DATE: MAR 03, 2021

This stamp certifies compliance with the applicable Design Guidelines only and bears no further professional responsibility.

LEGEND:

- | | | | | |
|---|---|---|-----------------------------|--|
| 1 BRICK/STONE VENEER ON SIDES OF STAIRS (POURED OR "BRICK LEDGE" PRECAST) | 2 DROP OR RAISE BANDING BY AMOUNT INDICATED. | 3 ADD BANDING AND/OR TRIM AS INDICATED. | 4 ADDED CAMBERED HEADERS | 5 8'-0" X 8'-0" GARAGE DOORS. |
| 6 DROPPED OR RAISED SOFFIT AS INDICATED. | 7 ADJUSTED ROOF OVERHANG AS INDICATED ON ROOF PLAN. | 8 PROVIDE GUARD PER CONSTRUCTION NOTE 11. | 9 FOYER SUNKEN AS INDICATED | 10 LIGHT FIXTURE RELOCATED AS INDICATED. |

HUNT
DESIGN ASSOCIATES INC.
www.hunt-design.ca

GOLDPARK HOMES - 217020
PINE VALLEY, VAUGHAN ONT.

8966 Woodbine Ave, Markham, ON L3R 0J7 ■ T 905.737.5133 ■ F 905.737.7326 ■ 2021/02/01 ■ NEA ■

All drawings specifications, related documents and design are the copyright property of Hunt Design Associates (H.D.A.). Reproduction of this property in whole or in part is strictly prohibited without H.D.A.'s written permission.

LOTS 26-29

PAGE XX

217020WSS01



LOT NUMBER: 30
UNIT NAME: LILAC
ELEVATION: A CORNER REAR
UNIT NUMBER: 4006



LOT NUMBER: 30
UNIT NAME: LILAC
ELEVATION: A CORNER FLANKAGE
UNIT NUMBER: 4006



LOT NUMBER: 30
UNIT NAME: LILAC
ELEVATION: A CORNER FRONT
UNIT NUMBER: 4006

DEERHAVEN CRESCENT

LEGEND:

- | | | | | | | | | | |
|---|---|---|---|---|---|---|---------------------------|----|---------------------------------------|
| 1 | BRICK/STONE VENEER ON SIDES OF STAIRS (POURED OR "BRICK LEDGE" PRECAST) | 2 | DROP OR RAISE BANDING BY AMOUNT INDICATED. | 3 | ADD BANDING AND/OR TRIM AS INDICATED. | 4 | ADDED CAMBERED HEADERS | 5 | 8'-0" X 8'-0" GARAGE DOORS. |
| 6 | DROPPED OR RAISED SOFFIT AS INDICATED. | 7 | ADJUSTED ROOF OVERHANG AS INDICATED ON ROOF PLAN. | 8 | PROVIDE GUARD PER CONSTRUCTION NOTE 11. | 9 | FOYER SUNKEN AS INDICATED | 10 | LIGHT FIXTURE RELOCATED AS INDICATED. |

HUNT **DA**
DESIGN ASSOCIATES INC.
www.huntdesign.ca

GOLDPARK HOMES - 217020
PINE VALLEY, VAUGHAN ONT.

8966 Woodbine Ave, Markham, ON L3R 0J7 ■ T 905.737.5133 ■ F 905.737.7326 ■ 2021/02/24 ■ NEA ■

All drawings specifications, related documents and design are the copyright property of Hunt Design Associates (H.D.A.). Reproduction of this property in whole or in part is strictly prohibited without H.D.A.'s written permission.

It is the builder's complete responsibility to ensure that all plans submitted for approval fully comply with the Architectural Guidelines and all applicable regulations and requirements including zoning provisions and any provisions in the subdivision agreement. The Control Architect is not responsible in any way for examining or approving site (lotting) plans or working drawings with respect to any zoning or building code or permit matter or that any house can be properly built or located on its lot.

This is to certify that these plans comply with the applicable Architectural Design Guidelines approved by the City of VAUGHAN.

LOT 30

JOHN G. WILLIAMS LTD., ARCHITECT
ARCHITECTURAL CONTROL REVIEW
AND APPROVAL

APPROVED BY:

DATE: MAR 03, 2021

This stamp certifies compliance with the applicable Design Guidelines only and bears no further professional responsibility.

LOT 30

PAGE XX

217020WSS01



LOT NUMBER: 36
UNIT NAME: FORESTCREST
ELEVATION: A
UNIT NUMBER: 4203

DEERHAVEN CRESCENT



LOT NUMBER: 31
UNIT NAME: SUMMERDALE
ELEVATION: B(REV)
UNIT NUMBER: 4001

DEERHAVEN CRESCENT

LEGEND:

- | | | | | | | | | | |
|---|---|---|---|---|---|---|---------------------------|----|---------------------------------------|
| 1 | BRICK/STONE VENEER ON SIDES OF STAIRS (POURED OR "BRICK LEDGE" PRECAST) | 2 | DROP OR RAISE BANDING BY AMOUNT INDICATED. | 3 | ADD BANDING AND/OR TRIM AS INDICATED. | 4 | ADDED CAMBERED HEADERS | 5 | 8'-0" X 8'-0" GARAGE DOORS. |
| 6 | DROPPED OR RAISED SOFFIT AS INDICATED. | 7 | ADJUSTED ROOF OVERHANG AS INDICATED ON ROOF PLAN. | 8 | PROVIDE GUARD PER CONSTRUCTION NOTE 11. | 9 | FOYER SUNKEN AS INDICATED | 10 | LIGHT FIXTURE RELOCATED AS INDICATED. |

HUNT
DESIGN ASSOCIATES INC.
www.huntdesign.ca

GOLDPARK HOMES - 217020
PINE VALLEY, VAUGHAN ONT.

8966 Woodbine Ave, Markham, ON L3R 0J7 ■ T 905.737.5133 ■ F 905.737.7326 ■ 2021/02/24 ■ NEA ■

All drawings specifications, related documents and design are the copyright property of Hunt Design Associates (H.D.A.). Reproduction of this property in whole or in part is strictly prohibited without H.D.A.'s written permission.

It is the builder's complete responsibility to ensure that all plans submitted for approval fully comply with the Architectural Guidelines and all applicable regulations and requirements including zoning provisions and any provisions in the subdivision agreement. The Control Architect is not responsible in any way for examining or approving site (lotting) plans or working drawings with respect to any zoning or building code or permit matter or that any house can be properly built or located on its lot.

This is to certify that these plans comply with the applicable Architectural Design Guidelines approved by the City of VAUGHAN.

LOTS 31 & 36

JOHN G. WILLIAMS LTD., ARCHITECT
ARCHITECTURAL CONTROL REVIEW
AND APPROVAL

APPROVED BY:
DATE: MAR 03, 2021

This stamp certifies compliance with the applicable Design Guidelines only and bears no further professional responsibility.


LOTS 31-36

PAGE XX

217020WSS01



DEERHAVEN CRESCENT

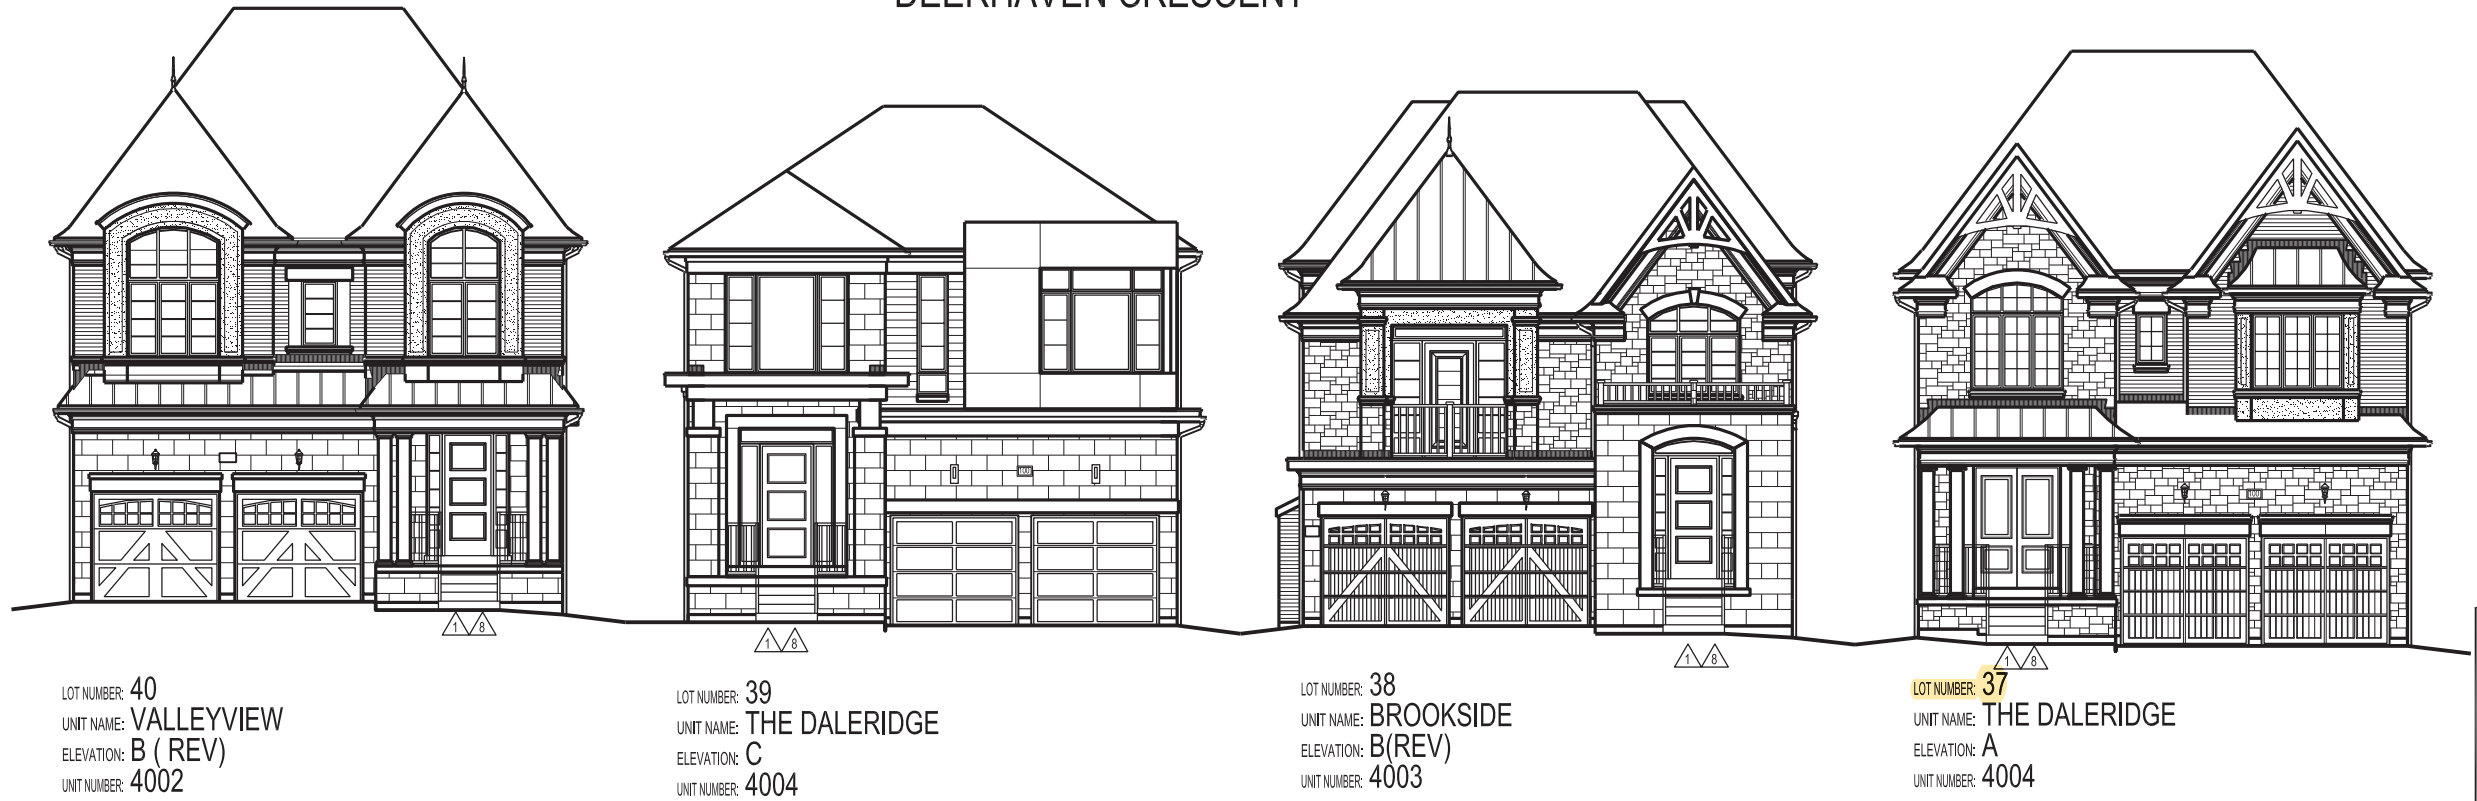

LEGEND:

- | | | | | |
|--|---|---|-----------------------------|--|
| 1 BRICK/ STONE VENEER ON SIDES OF STAIRS (POURED OR "BRICK LEDGE" PRECAST) | 2 DROP OR RAISE BANDING BY AMOUNT INDICATED. | 3 ADD BANDING AND/OR TRIM AS INDICATED. | 4 ADDED CAMBERED HEADERS | 5 8'-0" X 8'-0" GARAGE DOORS. |
| 6 DROPPED OR RAISED SOFFIT AS INDICATED. | 7 ADJUSTED ROOF OVERHANG AS INDICATED ON ROOF PLAN. | 8 PROVIDE GUARD FER CONSTRUCTION NOTE 11. | 9 FOYER SUNKEN AS INDICATED | 10 LIGHT FIXTURE RELOCATED AS INDICATED. |

HUNT
DESIGN ASSOCIATES INC.
www.huntdesign.ca

GOLDPARK HOMES - 217020
PINE VALLEY, VAUGHAN ONT.

8966 Woodbine Ave, Markham, ON L3R 0J7 ■ T 905.737.5133 ■ F 905.737.7326 ■ 2021/02/01 ■ NEA ■ 217020WSS01

All drawings specifications, related documents and design are the copyright property of Hunt Design Associates (H.D.A.). Reproduction of this property in whole or in part is strictly prohibited without H.D.A.'s written permission.

It is the builder's complete responsibility to ensure that all plans submitted for approval fully comply with the Architectural Guidelines and all applicable regulations and requirements including zoning provisions and any provisions in the subdivision agreement. The Control Architect is not responsible in any way for examining or approving site (lotting) plans or working drawings with respect to any zoning or building code or permit matter or that any house can be properly built or located on its lot.

This is to certify that these plans comply with the applicable Architectural Design Guidelines approved by the City of VAUGHAN.

LOT 37

JOHN G. WILLIAMS LTD., ARCHITECT
ARCHITECTURAL CONTROL REVIEW
AND APPROVAL

APPROVED BY:
DATE: MAR 03, 2021

This stamp certifies compliance with the applicable Design Guidelines only and bears no further professional responsibility.

STREETSCAPES - LOTS 37-45