



CONSTRUCTION SUMMARY

Lot: 37
Model: 40.04 A DALERIDGE
Project/Phase: Pine Valley Forevergreen / 1

BASEMENT WINDOWS

Invoice	Qty.	Description
2615 72,351 10Mar21	4	BASEMENT WINDOWS: UPGRADE ALL BASEMENT WINDOWS TO APPROX. 30 " X 24" IN LIEU OF STANDARD

DRYWALL

Invoice	Qty.	Description
2615 72,690 10Mar21 **	1	DELETE KITCHEN BULKHEAD, IF POSSIBLE, SITE APPROVAL REQUIRED
2615 10Mar21 NoCat	1	FYI - KITCHEN: PATIO SLIDERS - 6 FOOT VINYL PATIO DOORS WITH WHITE FRAME IN LIEU OF STANDARD GARDEN DOOR

ELECTRICAL

Invoice	Qty.	Description
2615 72,292 10Mar21	1	FRONT EXTERIOR: ADDITIONAL EXTERIOR COACH LIGHT ON EXISTING SWITCH (BUILDERS STANDARD FIXTURE) - SEE PLAN
2615 72,273 10Mar21	1	KITCHEN: 110V WALL RECEPTACLE ON SEPARATE CIRCUIT - GAS FIRED APPLIANCE - FOR AUX. EQUIPMENT - NOT A STOVE PLUG
2615 72,307 10Mar21	1	KITCHEN: RELOCATE STANDARD CEILING MOUNT FIXTURE TO CEILING CENTERED ABOVE KITCHEN ISLAND - SEE PLAN
2615 72,289 10Mar21	6	KITCHEN: 4" E/S LED INTERIOR POT LIGHT - SEE PLAN
2615 72,281 10Mar21	1	GREAT ROOM: ADDITIONAL WALL OUTLET FOR FUTURE WALL MOUNTED TV - INSTALL ABOVE STANDARD FIREPLACE - APPROX. 64" A.F.F. - SEE PLAN
2615 10Mar21 NoCat	1	FYI - KITCHEN: PATIO SLIDERS - 6 FOOT VINYL PATIO DOORS WITH WHITE FRAME IN LIEU OF STANDARD GARDEN DOOR

EXTERIOR COLOURS

Invoice	Qty.	Description
2615 10Mar21 NoCat	1	EXTERIOR COLOURS PACKAGE: BR9



CONSTRUCTION SUMMARY

Lot: 37
Model: 40.04 A DALERIDGE
Project/Phase: Pine Valley Forevergreen / 1

EXTERIOR DOORS

Invoice	Qty.	Description
2615 72,359 10Mar21	1	KITCHEN: PATIO SLIDERS - 6 FOOT VINYL PATIO DOORS WITH WHITE FRAME IN LIEU OF STANDARD GARDEN DOOR

FORMING

Invoice	Qty.	Description
2615 72,196 10Mar21	1	BASEMENT: 9 FOOT BASEMENT CEILING HEIGHT IN LIEU OF STANDARD 8 FOOT CEILING.

FRAMING

Invoice	Qty.	Description
2615 72,690 10Mar21	1	DELETE KITCHEN BULKHEAD, IF POSSIBLE, SITE APPROVAL REQUIRED
2615 10Mar21 NoCat	1	FYI - KITCHEN: PATIO SLIDERS - 6 FOOT VINYL PATIO DOORS WITH WHITE FRAME IN LIEU OF STANDARD GARDEN DOOR

HVAC

Invoice	Qty.	Description
2615 72,224 10Mar21	1	KITCHEN: INSTALL GAS LINE ROUGH-IN - FOR STOVE - SEE PLAN
2615 72,690 10Mar21 **	1	DELETE KITCHEN BULKHEAD, IF POSSIBLE, SITE APPROVAL REQUIRED

KITCHEN AND BATH CABINETRY

Invoice	Qty.	Description
2615 72,690 10Mar21 **	1	DELETE KITCHEN BULKHEAD, IF POSSIBLE, SITE APPROVAL REQUIRED

MASONRY

Invoice	Qty.	Description
2615 10Mar21 NoCat	1	FYI - FRONT EXTERIOR: ADDITIONAL EXTERIOR COACH LIGHT ON EXISTING SWITCH (BUILDERS STANDARD FIXTURE) - SEE PLAN
2615 10Mar21 NoCat	1	FYI - KITCHEN: PATIO SLIDERS - 6 FOOT VINYL PATIO DOORS WITH WHITE FRAME IN LIEU OF STANDARD GARDEN DOOR



CONSTRUCTION SUMMARY

Lot: 37
Model: 40.04 A DALERIDGE
Project/Phase: Pine Valley Forevergreen / 1

PAINTING

Invoice	Qty.	Description
2615 72,690 10Mar21 **	1	DELETE KITCHEN BULKHEAD, IF POSSIBLE, SITE APPROVAL REQUIRED




SCHEDULE 'F'

PV-37
March 8 2021
attached

The Daleridge

40' SERIES

→ Elevation A • 3,335 sq.ft.
Elevation B • 3,395 sq.ft.
Elevation C • 3,370 sq.ft.

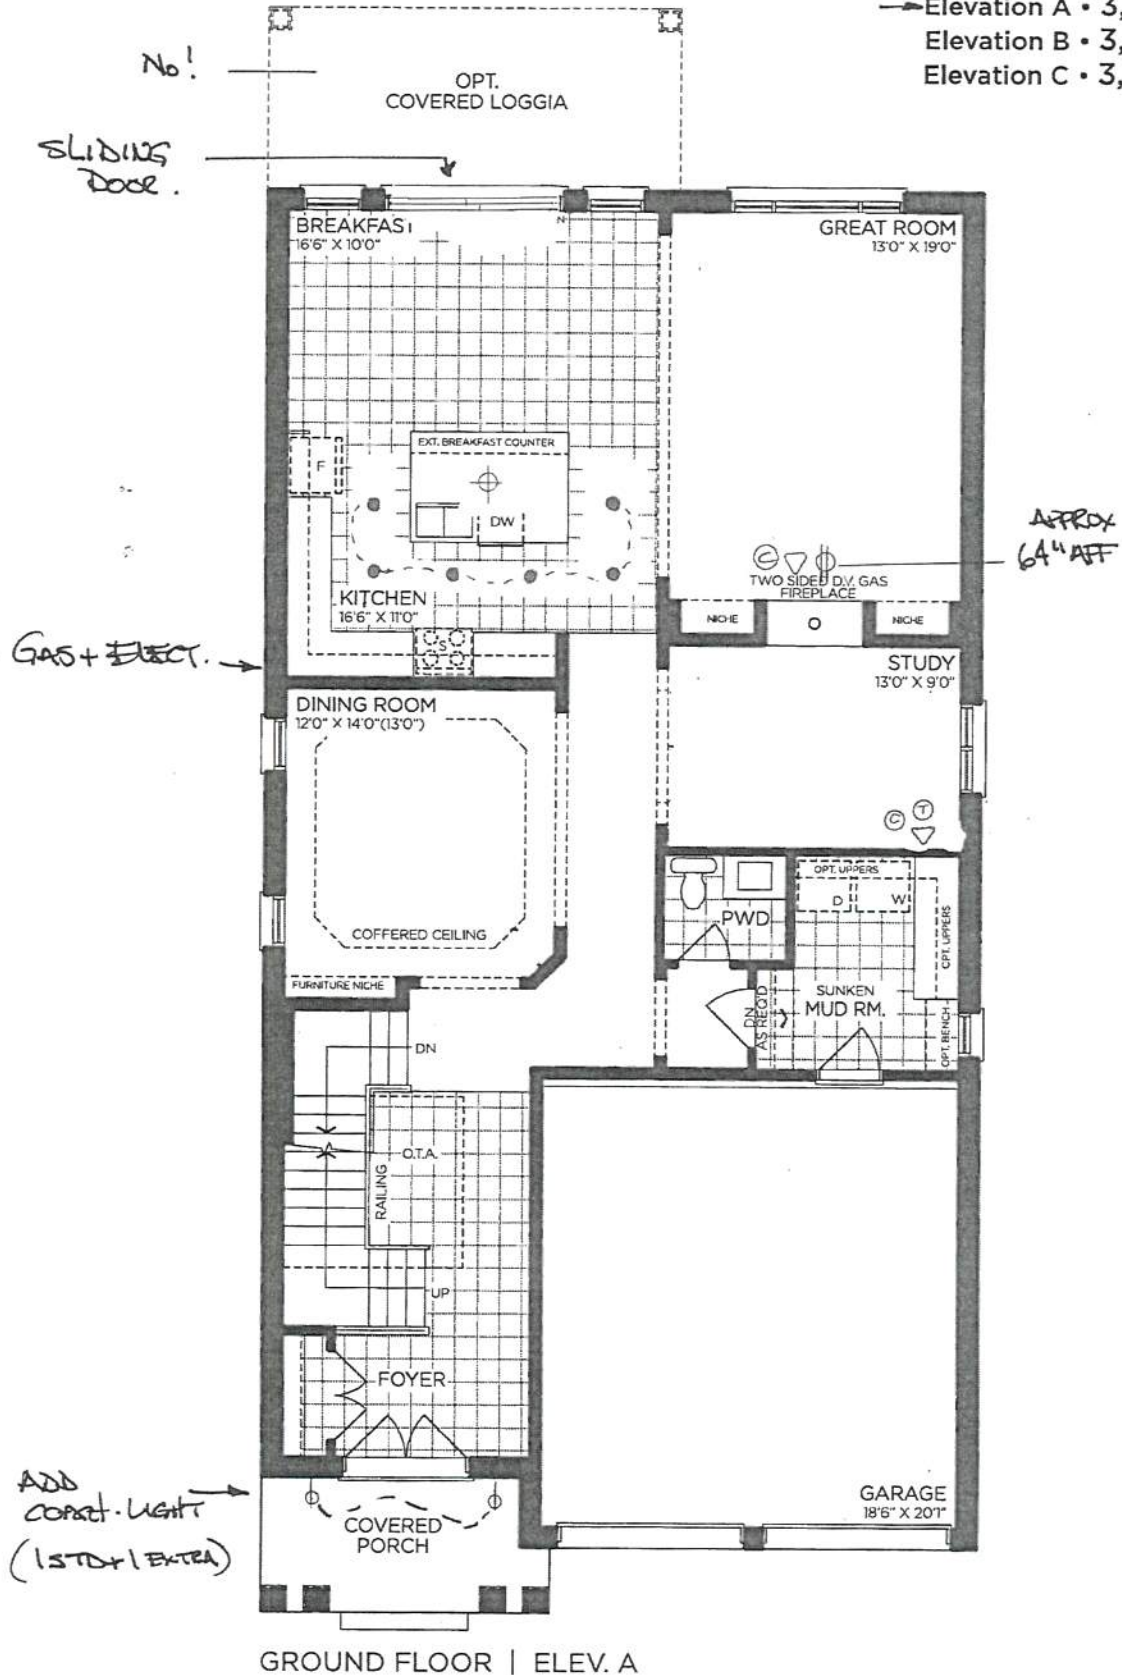

GROUND FLOOR | ELEV. A

VENDOR	
PURCHASER	
PURCHASER	

GOLDPARK
WORTH MORE™

Prices, figures, illustrations, sizes, features and finishes are subject to change without notice. Areas and dimensions are approximate and actual usable floor space may vary from the stated area. Layout may be reverse of the unit purchased. E. & O.E. 4004



SCHEDULE 'F'

PV- 37

MARCH 8 2021

attached


The Daleridge

40' SERIES

→ Elevation A • 3,335 sq.ft.

Elevation B • 3,395 sq.ft.

Elevation C • 3,370 sq.ft.

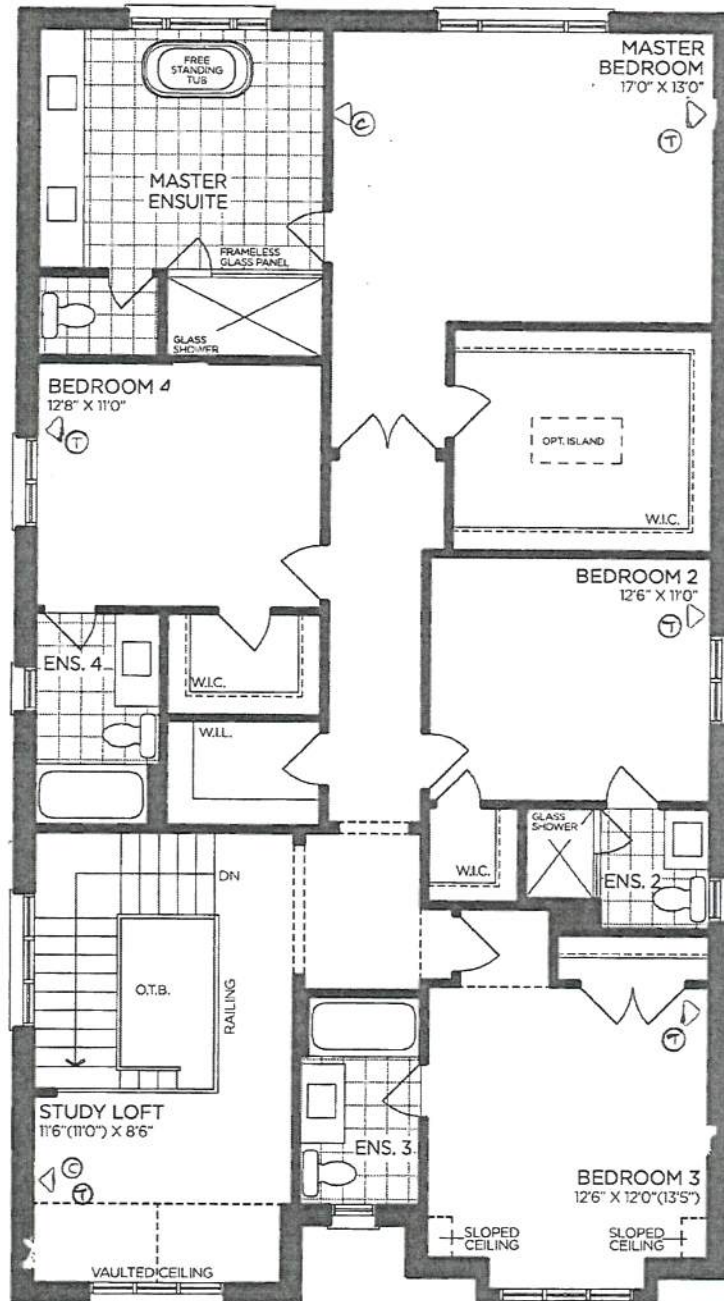

SECOND FLOOR | ELEV. A

VENDOR	
PURCHASER	
PURCHASER	

GOLDPARK
WORTH MORE™

Prices, figures, illustrations, sizes, features and finishes are subject to change without notice. Areas and dimensions are approximate and actual usable floor space may vary from the stated area. Layout may be reverse of the unit purchased. E. & O.E. 4004




SCHEDULE 'F'

PV-37
MAR 8 2021
attached

The Daleridge
40' SERIES

- Elevation A • 3,335 sq.ft.
- Elevation B • 3,395 sq.ft.
- Elevation C • 3,370 sq.ft.

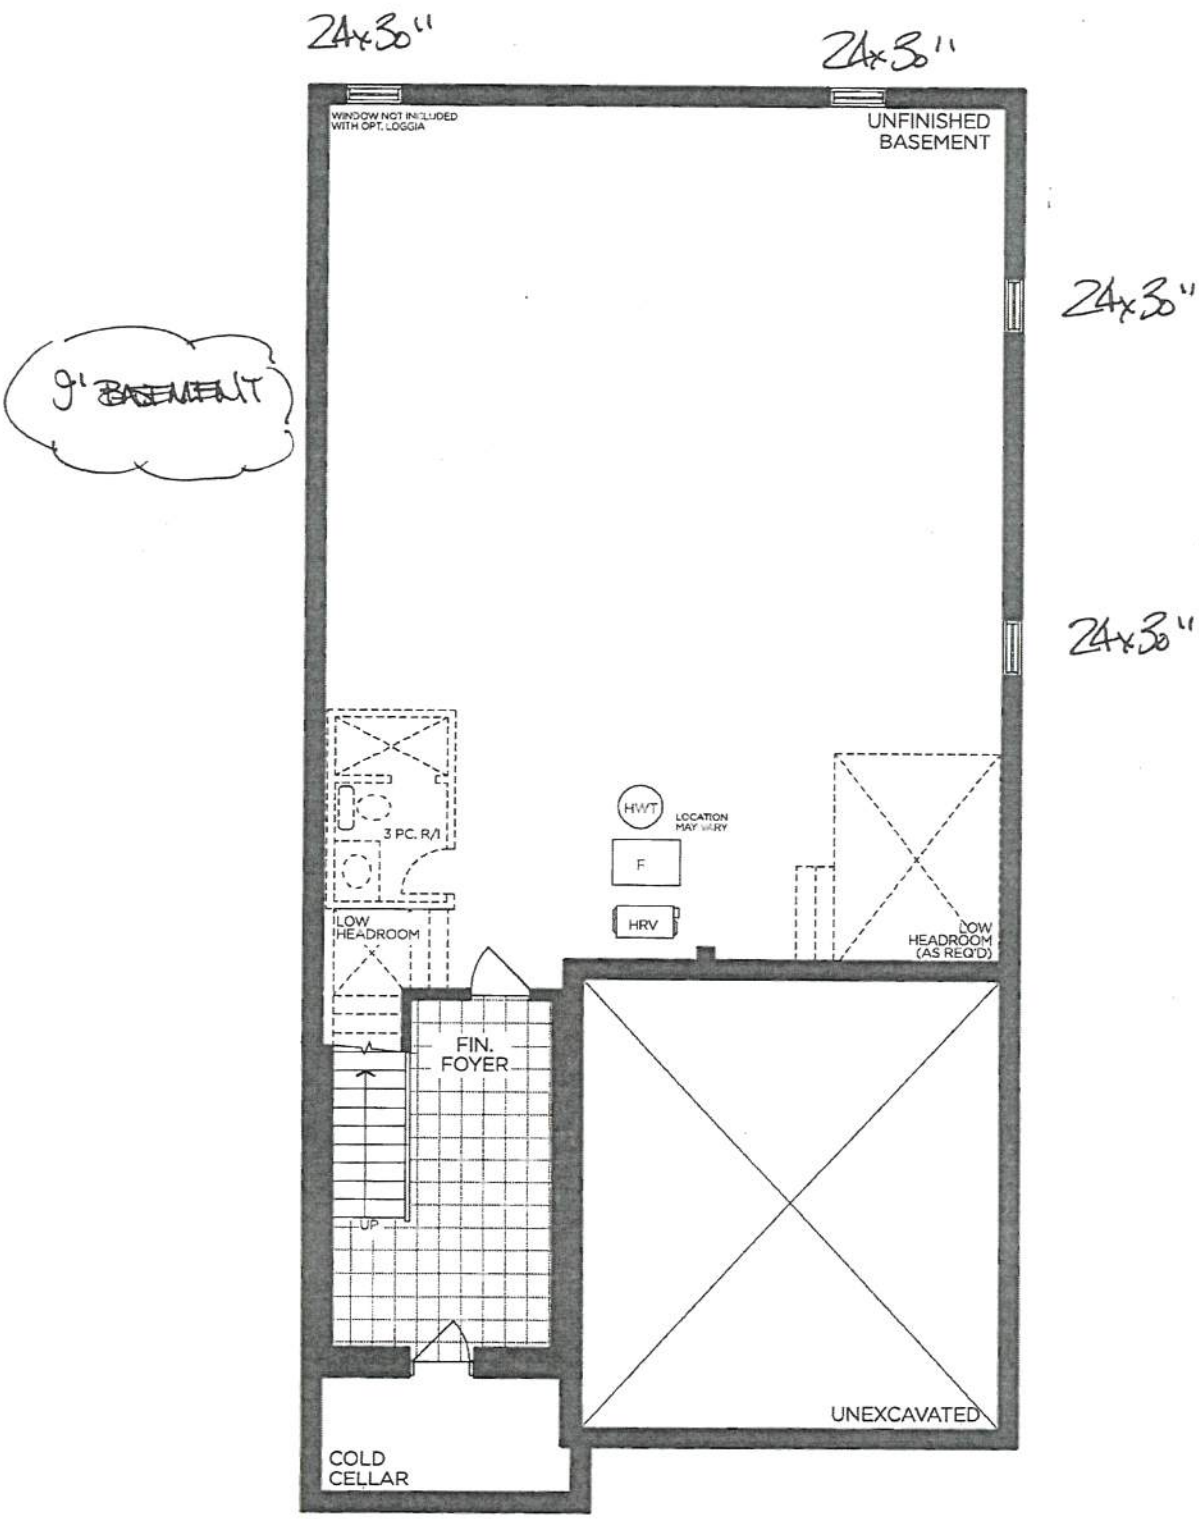

BASEMENT | ELEV. A

VENDOR

PURCHASER

PURCHASER

GOLDPARK
WORTH MORE™


Prices, figures, illustrations, sizes, features and finishes are subject to change without notice. Areas and dimensions are approximate and actual usable floor space may vary from the stated area. Layout may be reverse of the unit purchased. E. & O.E. 4004



SCHEDULE 'F'
PV-37 09
March 8 2021 BS

The Daleridge 40' SERIES

Elevation A • 3,335 sq.ft.
Elevation B • 3,395 sq.ft.
Elevation C • 3,370 sq.ft.

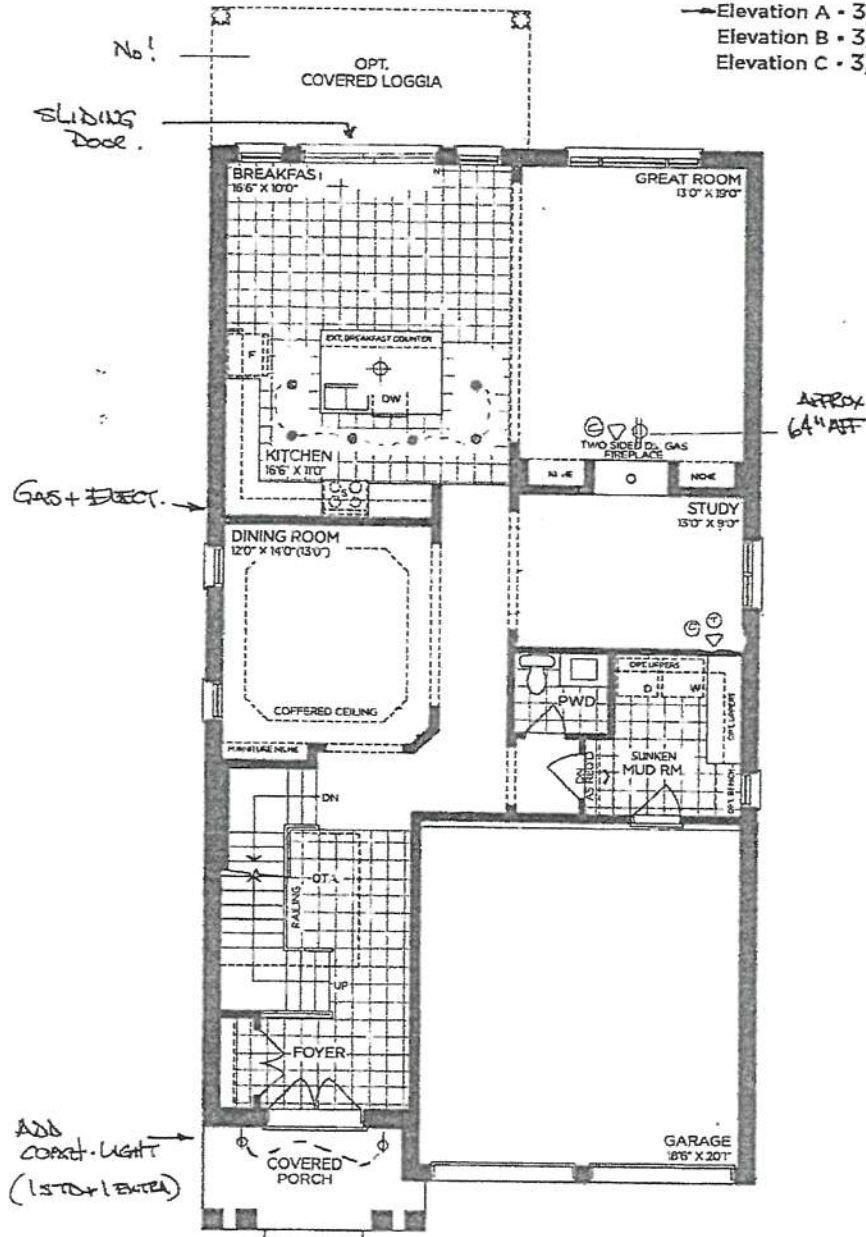

GROUND FLOOR | ELEV. A

VENDOR
PURCHASER
PURCHASER

GOLDPARK
WORTH MORE

Prices, figures, illustrations, sizes, features and finishes are subject to change without notice. Areas and dimensions are approximate and actual usable floor space may vary from the stated area. Layout may be reverse of the unit purchased. E. & O.E. 4004




SCHEDULE 'F'

1224 B.S.
PV- 37
MARCH 8 2021

The
Daleridge
40' SERIES

→ Elevation A • 3,335 sq.ft.
Elevation B • 3,395 sq.ft.
Elevation C • 3,370 sq.ft.

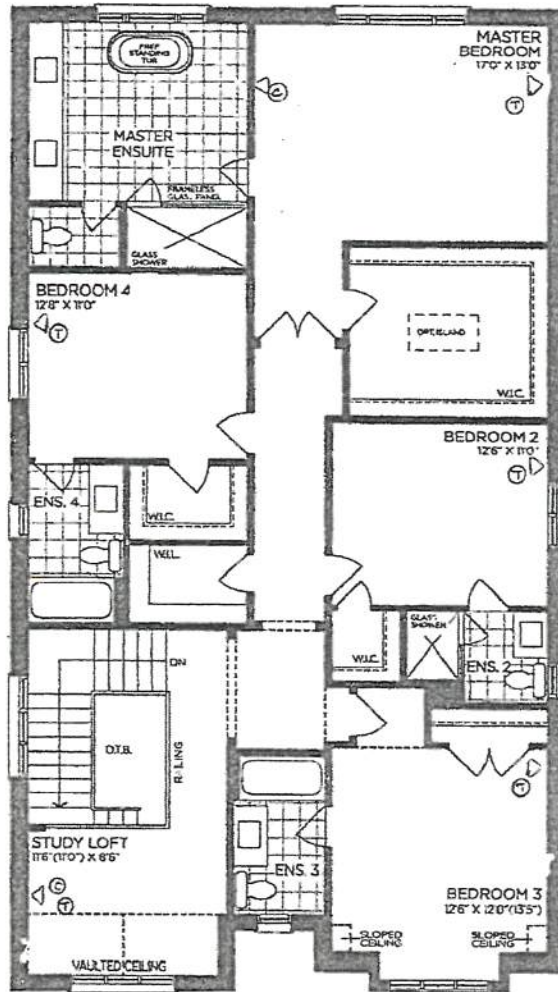

SECOND FLOOR | ELEV. A

VENDOR
PURCHASER
PURCHASER

GOLDPARK
WORTH MORE™

Prices, figures, illustrations, sizes, features and finishes are subject to change without notice. Areas and dimensions are approximate and actual usable floor space may vary from the stated area. Layout may be reverse of the unit purchased. E & O.E. 4004




SCHEDULE 'F'

PV-37
MARCH 5 2021 B.S.

The Daleridge 40' SERIES

Elevation A • 3,335 sq.ft.
Elevation B • 3,395 sq.ft.
Elevation C • 3,370 sq.ft.

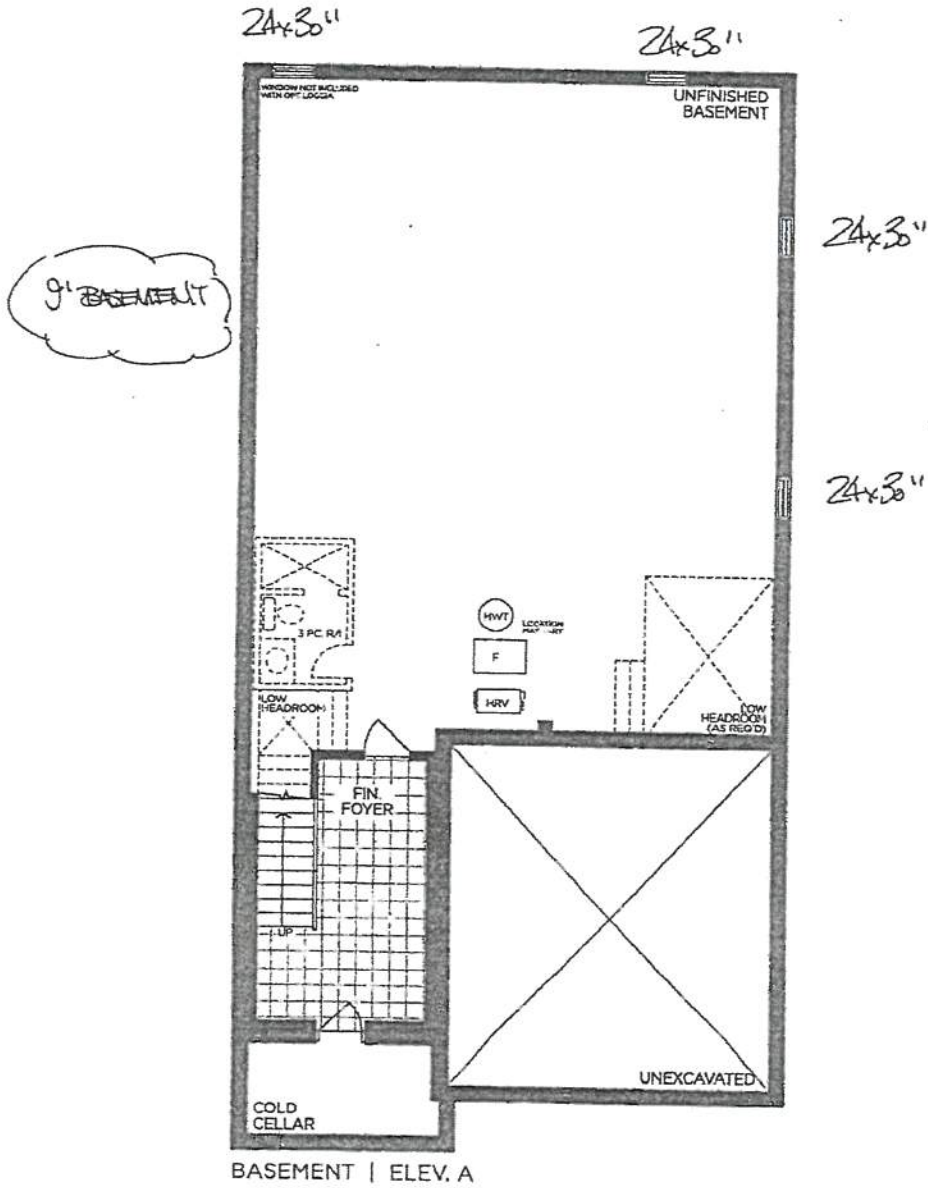

VENDOR

PURCHASER

PURCHASER

GOLDPARK
WORTH MORE

Prices, figures, illustrations, sizes, features and finishes are subject to change without notice. Areas and dimensions are approximate and actual usable floor space may vary from the stated area. Layout may be reverse of the unit purchased. E. & O.E. 4004