

see attach

MARCH 5 2021



PINE VALLEY
FOREVERGREEN

The
Valleyview
40' SERIES

→ Elevation A • 3,145 sq.ft.

Elevation B • 3,170 sq.ft.

OPT. LOGGIA

GARDEN DOOR

OPT. COFFERED CEILING

OPT. COFFERED CEILING

D.V. GAS FIREPLACE

GREAT ROOM 18'6" X 13'0"

OPT. WAFFLE CEILING

BREAKFAST 11'6" X 13'0"

DW

ISLAND

EXT. BREAKFAST COUNTER

KITCHEN 11'6" X 13'0"

COFFERED CEILING

DINING ROOM 14'0" X 14'0"

OPT. UPPERS

W D

LAUNDRY (SUNK)

DOOR GRADE PERMITTING

UP

RAILING O.T.A.

DN

PWD

FOYER

COVERED PORCH

GARAGE 18'6" X 23'10" (20'2")

GROUND FLOOR | ELEV. A

VENDOR

PURCHASER

PURCHASER

GOLDPARK
WORTH MORE

WORTH MORE

Prices, figures, illustrations, sizes, features and finishes are subject to change without notice. Areas and dimensions are approximate and actual usable floor space may vary from the stated area. Layout may be reverse of the unit purchased. E. & O.E. 4002




SCHEDULE 'F'

PV-42
March 5 2021
see attach.

The
Valleyview
40' SERIES

→ Elevation A • 3,145 sq.ft.
Elevation B • 3,170 sq.ft.

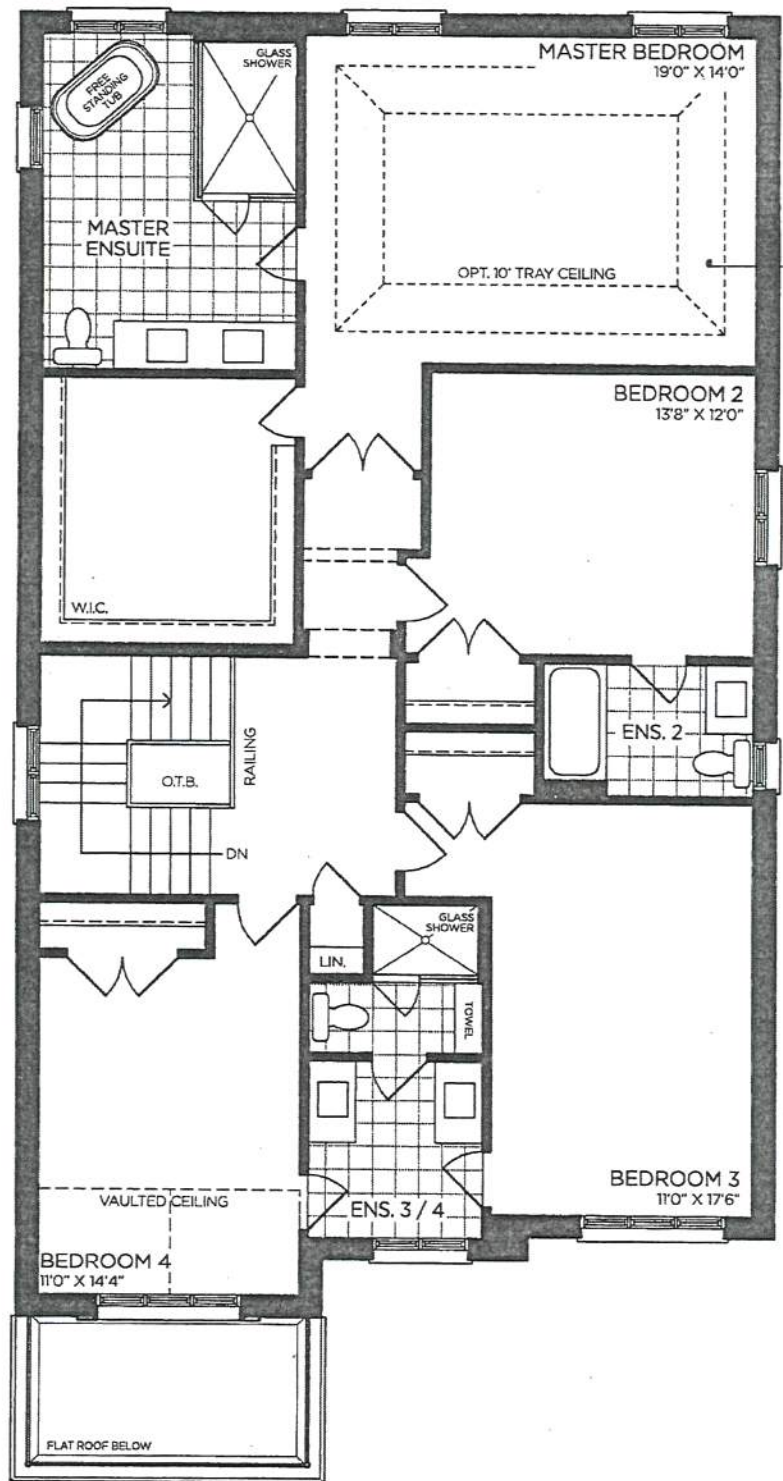

SECOND FLOOR | ELEV. A

TRAY YES!

VENDOR

PURCHASER

PURCHASER

GOLDPARK
WORTH MORE™

Prices, figures, illustrations, sizes, features and finishes are subject to change without notice. Areas and dimensions are approximate and actual usable floor space may vary from the stated area. Layout may be reverse of the unit purchased. E. & O.E. 4002




SCHEDULE 'F'

PV-42
March 5 2021
see attach.

The Valleyview

40' SERIES

→ Elevation A • 3,145 sq.ft.
Elevation B • 3,170 sq.ft.

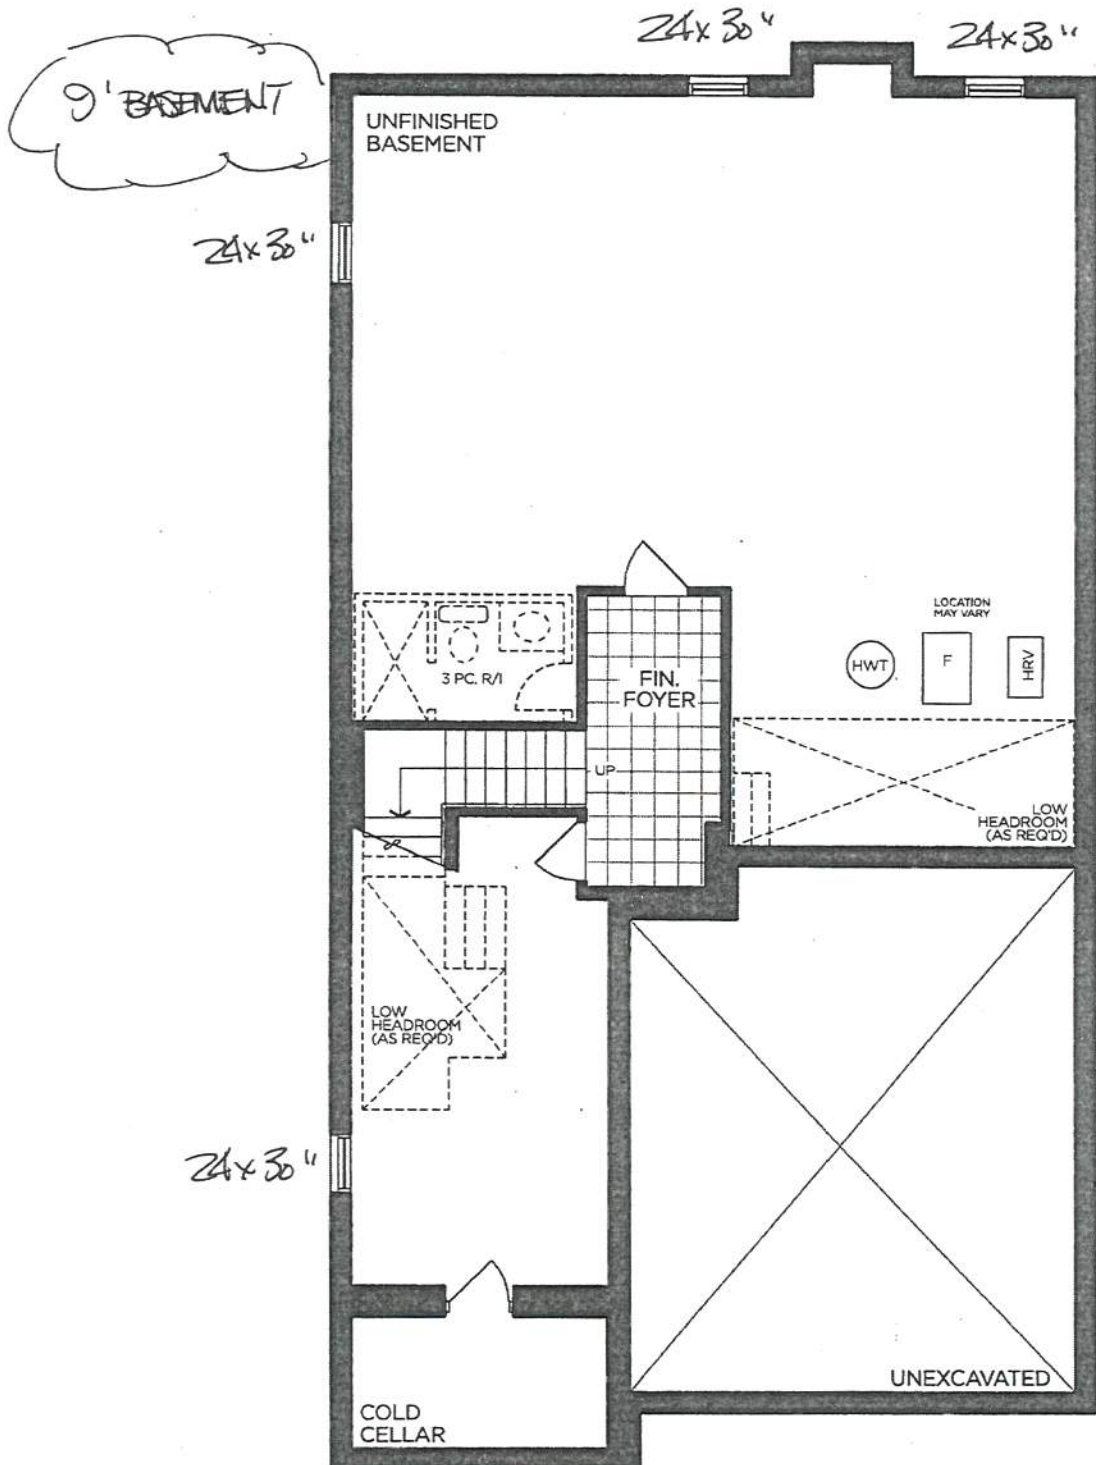

BASEMENT | ELEV. A

VENDOR

PURCHASER

PURCHASER

GOLDPARK
WORTH MORE™

Prices, figures, illustrations, sizes, features and finishes are subject to change without notice. Areas and dimensions are approximate and actual usable floor space may vary from the stated area. Layout may be reverse of the unit purchased. E. & O.E. 4002


SCHEDULE 'F'



PV-42
MARCH 5 2021

The Valleyview 40' SERIES

→ Elevation A • 3,145 sq.ft.
Elevation B • 3,170 sq.ft.

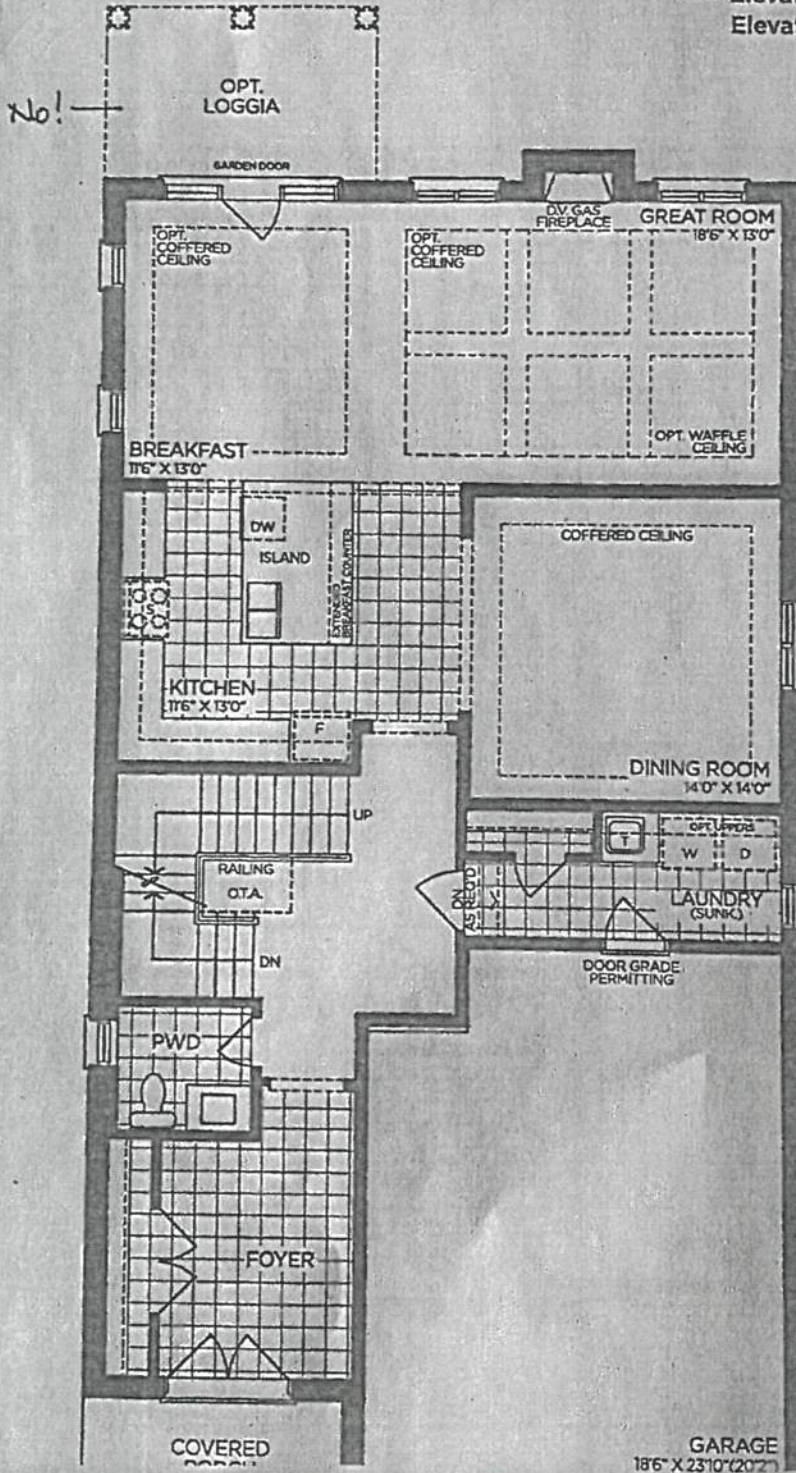

Handwritten signature

SCHEDULE 'F'


PV-42
March 5 2021



The Valleyview

40' SERIES

→ Elevation A • 3,145 sq.ft.
Elevation B • 3,170 sq.ft.

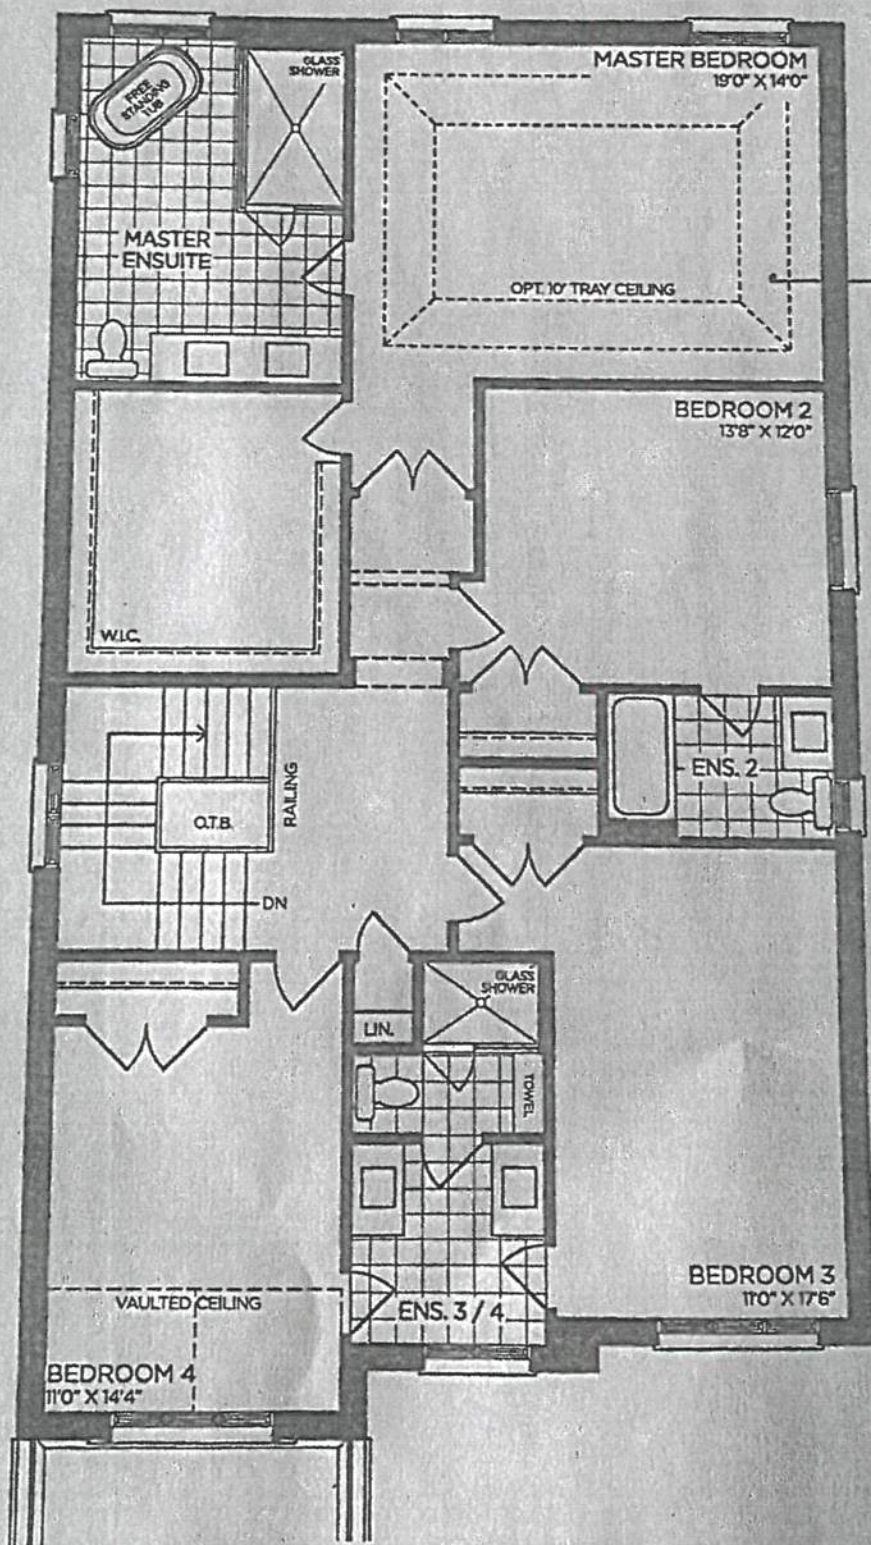




PV-42
March 5 2021

SCHEDULE 'F'

The Valleyview 40' SERIES

→ Elevation A • 3,145 sq.ft.
Elevation B • 3,170 sq.ft.

9' BASEMENT

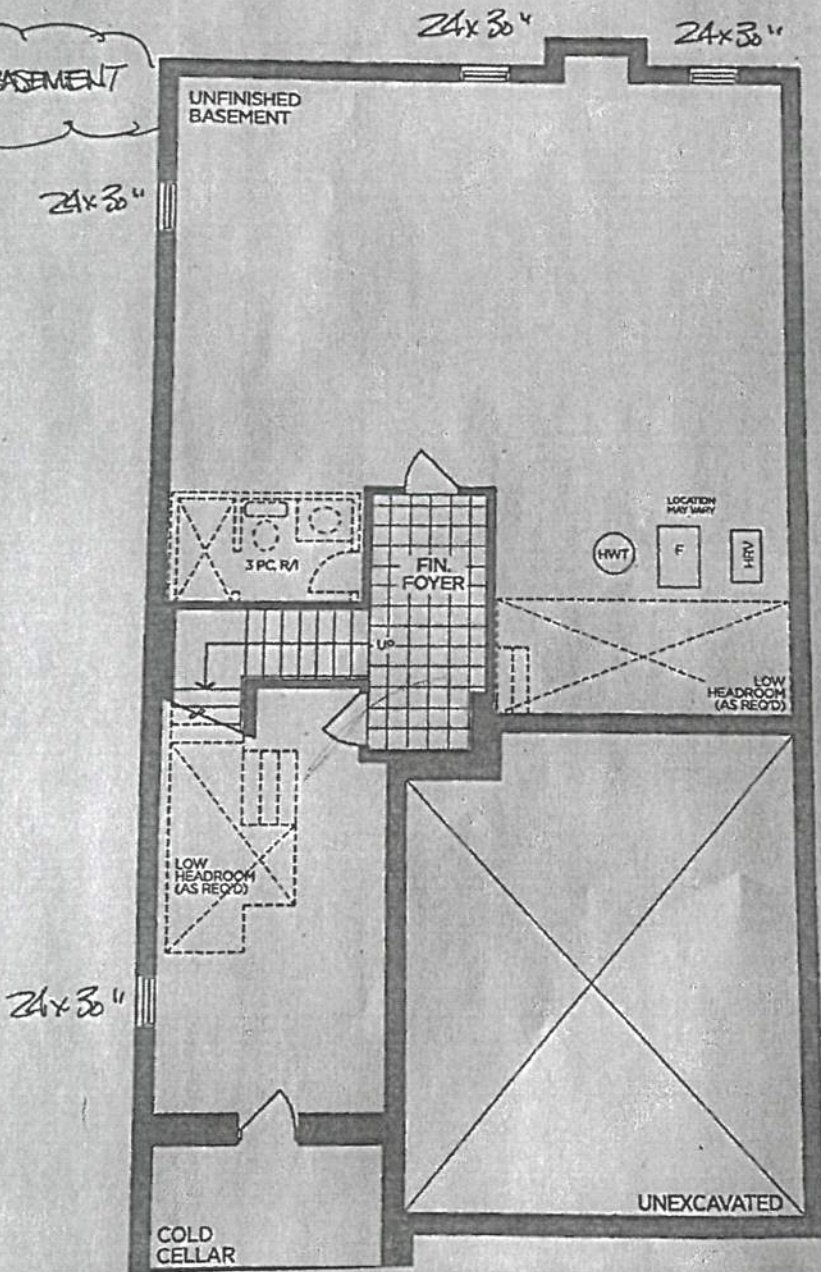

al m