

DRYWALL

Invoice	Qty.	Description
2614 72,690 11Mar21 **	1	DELETE KITCHEN BULKHEAD, IF POSSIBLE, SITE APPROVAL REQUIRED

ELECTRICAL

Invoice	Qty.	Description
2614 72,307 11Mar21	1	KITCHEN: RELOCATE STANDARD CEILING MOUNT FIXTURE - TO CENTRE ON CEILING ABOVE KITCHEN ISLAND
2614 72,288 11Mar21	1	MASTER ENSUITE: ROUGH-IN FOR ADDITIONAL WALL SCONCE (1) CAPPED OUTLET ON EXISTING SWITCH - FIXTURE NOT INCLUDED - APPROX 66" A.F.F., INSTALL APPROX. 6" IN FROM END OF VANITY - SEE PLAN
2614 72,307 11Mar21	1	MASTER ENSUITE: RELOCATE STANDARD VANITY MOUNT FIXTURE - INSTALL APPROX 66" A.F.F., 6" OUT FROM WALL - SEE PLAN
2614 72,281 11Mar21	1	MEDIA ROOM: ADDITIONAL 110V WALL INTERIOR RECEPTACLE ON EXISTING CIRCUIT FOR WALL MOUNTED TV - APPROX. 58" A.F.F. - SEE PLAN
2614 72,292 11Mar21	1	FRONT EXTERIOR: ADDITIONAL EXTERIOR COACH LIGHT ON EXISTING SWITCH (BUILDERS STANDARD FIXTURE) - SEE PLAN

EXTERIOR DOORS

Invoice	Qty.	Description
2614 72,354 11Mar21	1	KITCHEN: ADDITIONAL WINDOW OPERATOR - SEE PLAN FOR LOCATION

FRAMING

Invoice	Qty.	Description
2614 72,385 11Mar21	1	GREAT ROOM: OPT. COFFERED CEILING - AS PER PLAN
2614 72,690 11Mar21	1	DELETE KITCHEN BULKHEAD, IF POSSIBLE, SITE APPROVAL REQUIRED

GLASS AND MIRROR

Invoice	Qty.	Description
2614 72,440 11Mar21	1	*THRU OUT: DELETE ALL STANDARD ENSUITE MIRRORS*



CONSTRUCTION SUMMARY

Lot: 41
Model: 40.03 A BROOKSIDE
Project/Phase: Pine Valley Forevergreen / 1

HVAC

Invoice	Qty.	Description
2614 72,690 11Mar21 **	1	DELETE KITCHEN BULKHEAD, IF POSSIBLE, SITE APPROVAL REQUIRED

KITCHEN AND BATH CABINETRY

Invoice	Qty.	Description
2614 72,690 11Mar21 **	1	DELETE KITCHEN BULKHEAD, IF POSSIBLE, SITE APPROVAL REQUIRED

MASONRY

Invoice	Qty.	Description
2614 11Mar21 NoCat	1	FYI - FRONT EXTERIOR: ADDITIONAL EXTERIOR COACH LIGHT ON EXISTING SWITCH (BUILDERS STANDARD FIXTURE) - SEE PLAN

PAINTING

Invoice	Qty.	Description
2614 72,690 11Mar21 **	1	DELETE KITCHEN BULKHEAD, IF POSSIBLE, SITE APPROVAL REQUIRED

PANL - FRAMING

Invoice	Qty.	Description
2614 72,690 11Mar21 **	1	DELETE KITCHEN BULKHEAD, IF POSSIBLE, SITE APPROVAL REQUIRED




SCHEDULE 'F'
PV-41 See attached
March 8, 2021

The Brookside

40' SERIES

Elevation A • 3,380 sq.ft.
Elevation B • 3,350 sq.ft.

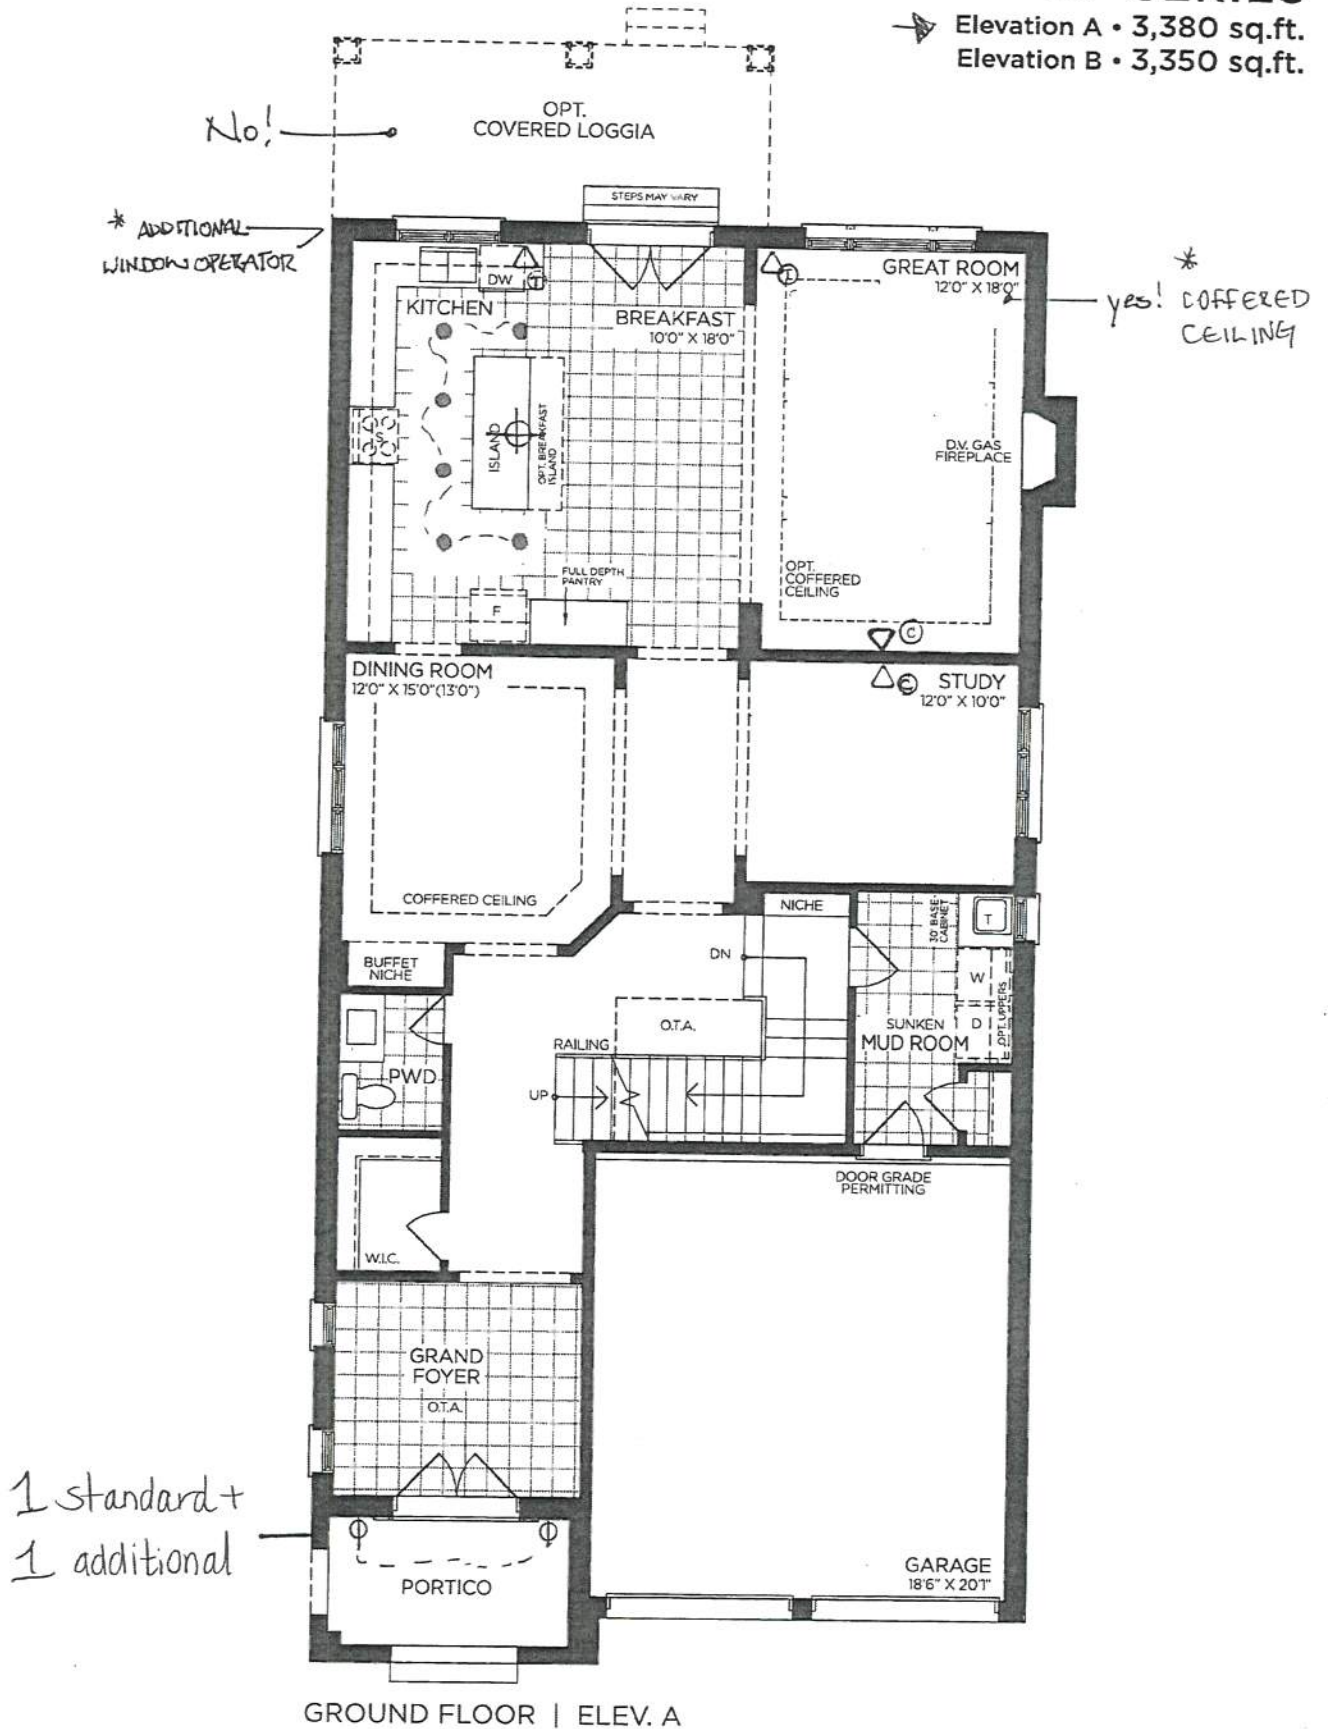

VENDOR
PURCHASER
PURCHASER

GOLDPARK
WORTH MORE™

Prices, figures, illustrations, sizes, features and finishes are subject to change without notice. Areas and dimensions are approximate and actual usable floor space may vary from the stated area. Layout may be reverse of the unit purchased. E. & O.E. 4003




SCHEDULE 'F'

PV-41 81 attached
March 8, 2021

The Brookside

40' SERIES

➔ Elevation A • 3,380 sq.ft.
Elevation B • 3,350 sq.ft.

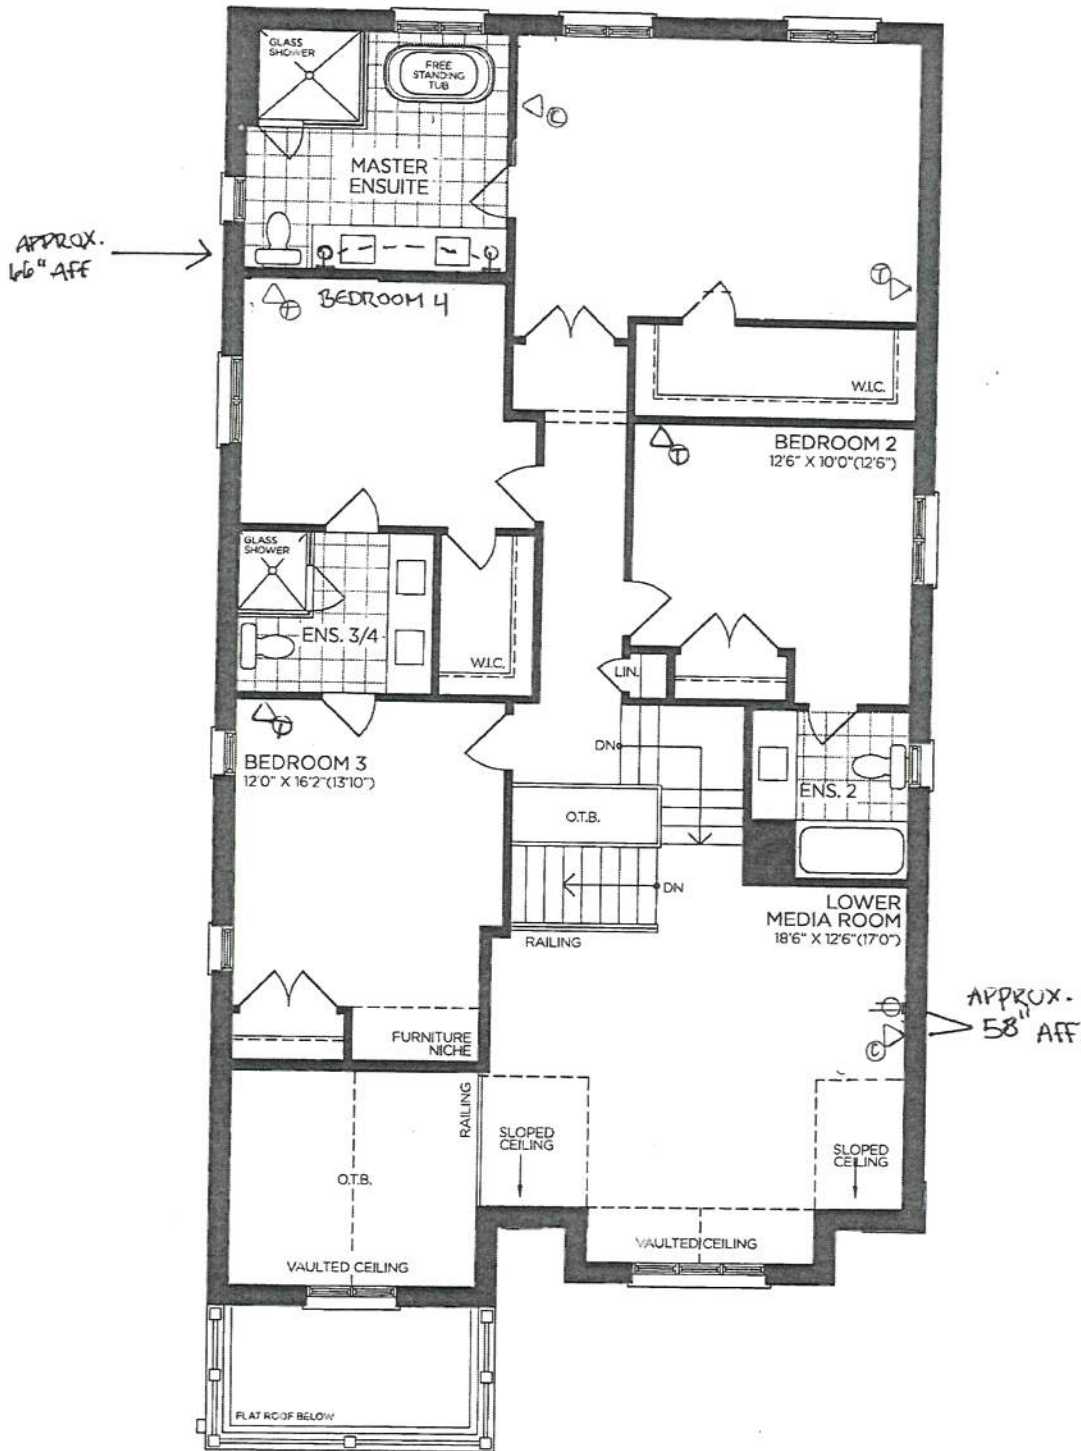

SECOND FLOOR | ELEV. A

VENDOR	
PURCHASER	
PURCHASER	

GOLDPARK
WORTH MORE™

Prices, figures, illustrations, sizes, features and finishes are subject to change without notice. Areas and dimensions are approximate and actual usable floor space may vary from the stated area. Layout may be reverse of the unit purchased. E. & O.E. 4003




SCHEDULE 'F'

PV-41 see attached
March 8, 2021

The Brookside

40' SERIES

➔ Elevation A • 3,380 sq.ft.
Elevation B • 3,350 sq.ft.

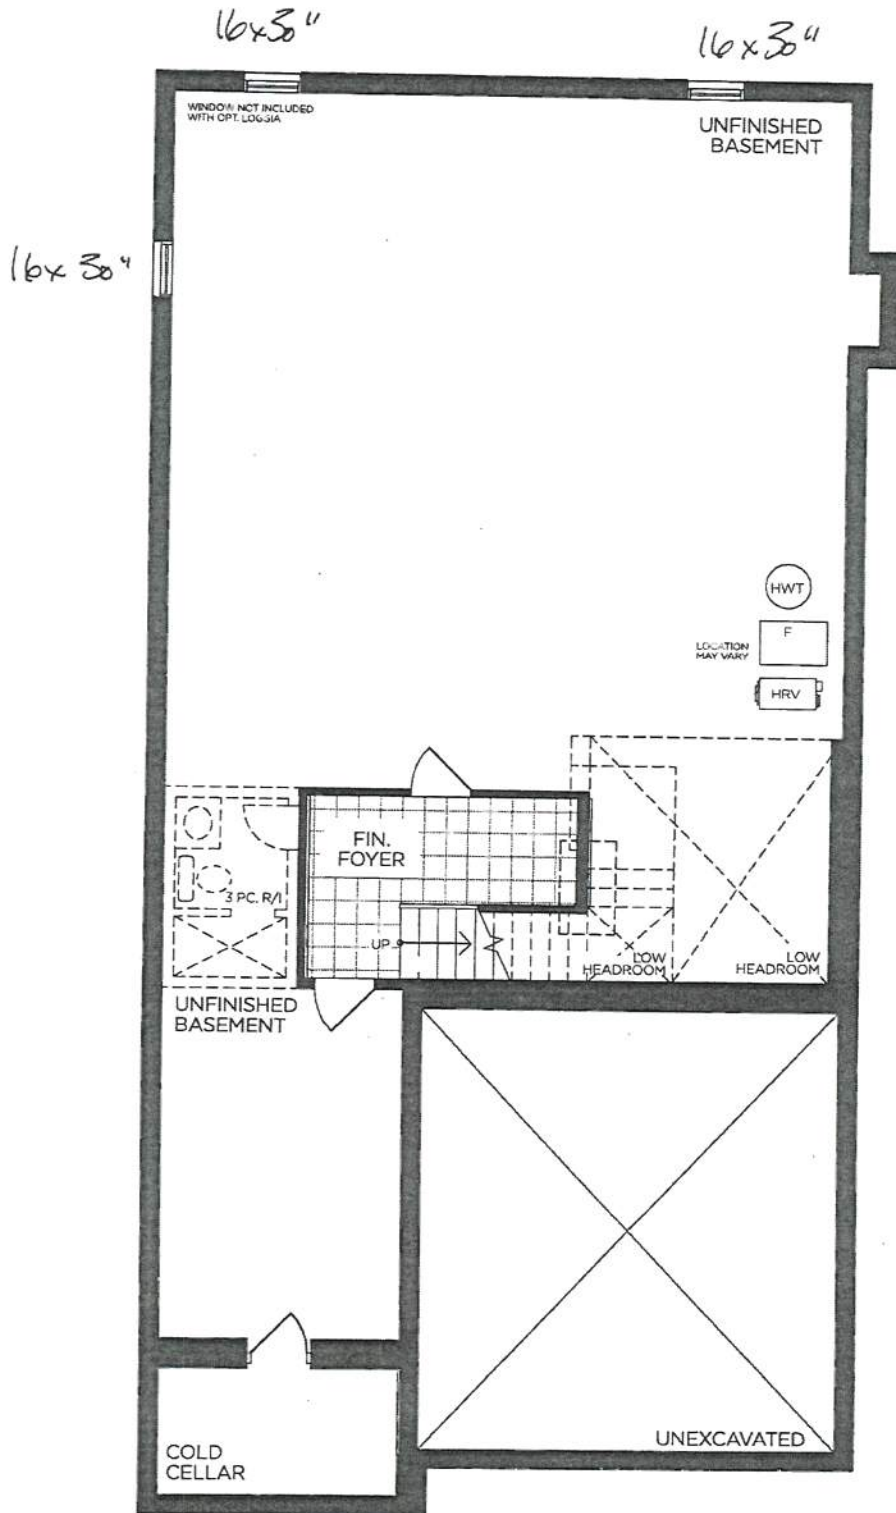

BASEMENT | ELEV. A

VENDOR	
PURCHASER	
PURCHASER	

GOLDPARK
WORTH MORE™

Prices, figures, illustrations, sizes, features and finishes are subject to change without notice. Areas and dimensions are approximate and actual usable floor space may vary from the stated area. Layout may be reverse of the unit purchased. E. & O.E. 4003




SCHEDULE 'F'
PV-41 (LS) (MC)
March 3, 2021

The Brookside

40' SERIES

Elevation A • 3,380 sq.ft.
Elevation B • 3,350 sq.ft.

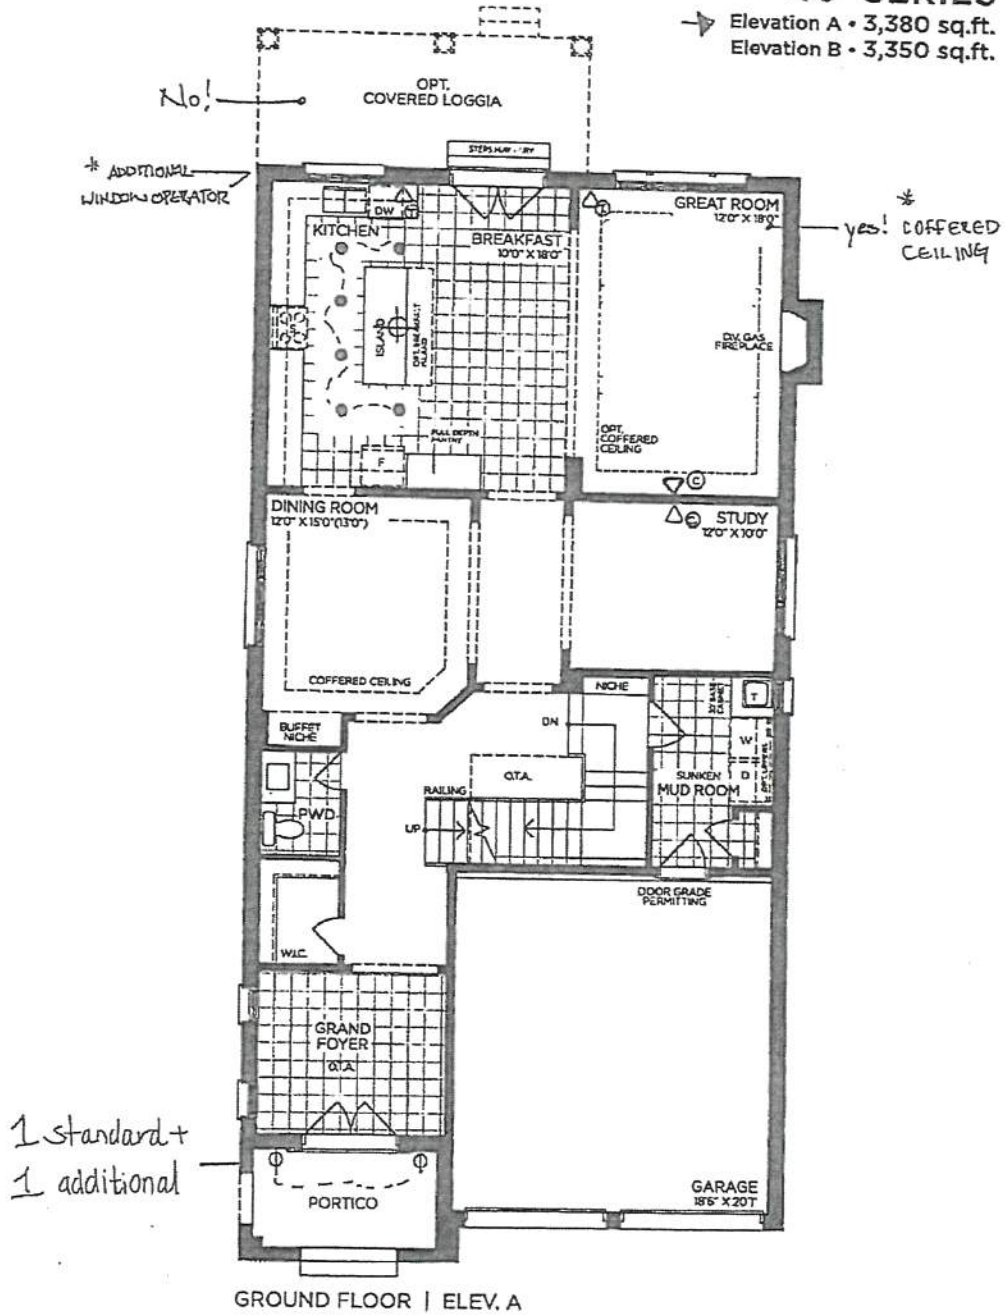

VENDOR
PURCHASER
PURCHASER

GOLDPARK
WORTH MORE™

Prices, figures, illustrations, sizes, features and finishes are subject to change without notice. Areas and dimensions are approximate and actual usable floor space may vary from the stated area. Layout may be reverse of the unit purchased. E. & O.E. 4003




SCHEDULE 'F'

PV-41 (LS) (MC)
March 8, 2021

The Brookside
40' SERIES

→ Elevation A • 3,380 sq.ft.
Elevation B • 3,350 sq.ft.

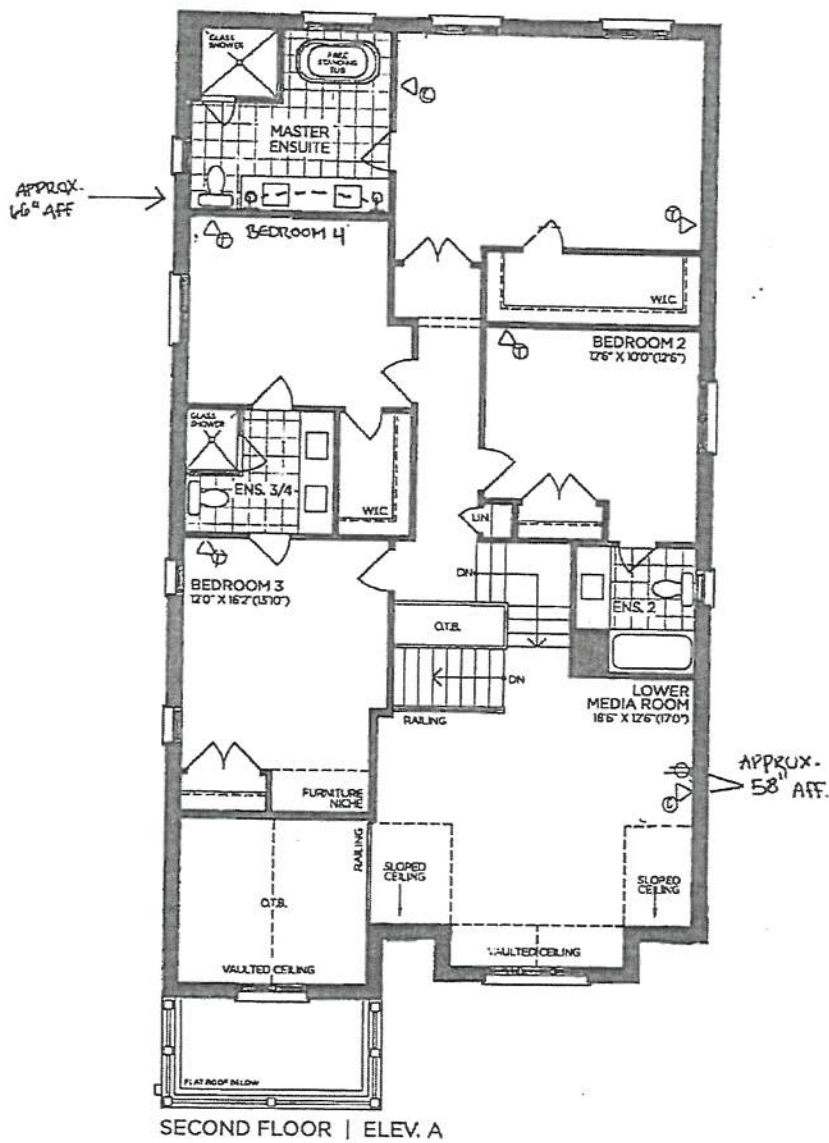

SECOND FLOOR | ELEV. A

VENDOR
PURCHASER
PURCHASER

GOLDPARK
WORTH MORE™

Prices, figures, illustrations, sizes, features and finishes are subject to change without notice. Areas and dimensions are approximate and actual usable floor space may vary from the stated area. Layout may be reverse of the unit purchased. E. & O.E. 4003




SCHEDULE 'F'
PV-41 (L) (MC)
March 8, 2021

The Brookside

40' SERIES

→ Elevation A • 3,380 sq.ft.
Elevation B • 3,350 sq.ft.

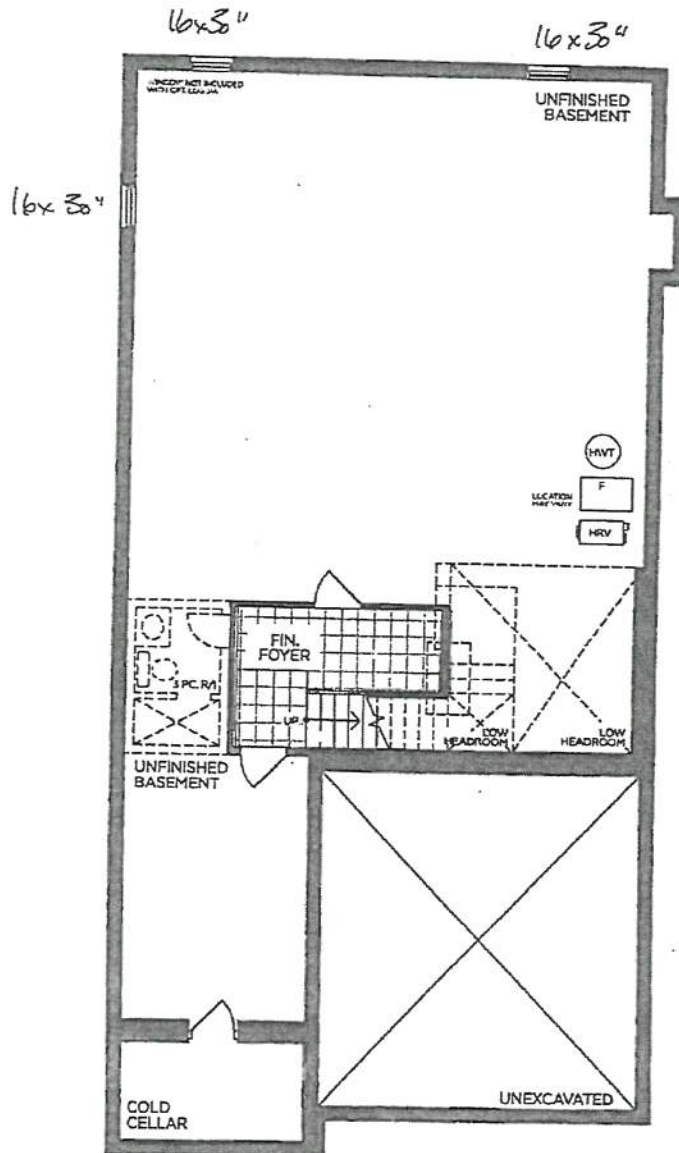

BASEMENT | ELEV. A

VENDOR _____
PURCHASER *[Signature]* _____
PURCHASER *[Signature]* _____

GOLDPARK
WORTH MORE™

Prices, figures, illustrations, sizes, features and finishes are subject to change without notice. Areas and dimensions are approximate and actual usable floor space may vary from the stated area. Layout may be reverse of the unit purchased. E. & O.E. 4003