

CERAMIC

Invoice	Qty.	Description
2323 10Nov20 NoCat	1	ENSUITE 2: **REPLACE STANDARD TUB TO STANDING SHOWER - INCLUDES TILE ON SHOWER BASE AND POT LIGHT IN CEILING - **NO GLASS ENCLOSURE** LEAVE OPEN FOR PURCHASER TO INSTALL OWN AFTER CLOSING..
2317 38 11Mar21	1	KITCHEN: TILE, FLOOR , LEVEL 6 - 24 x 24" LAID IN STRAIGHT, STACKED PATTERN
2317 38 11Mar21	1	FRONT FOYER: TILE, FLOOR , LEVEL 6 - 24 x 24" LAID IN STRAIGHT, STACKED PATTERN.
2317 36 11Mar21	1	POWDER ROOM: TILE, FLOOR , LEVEL 4 - 12 x 24" LAID IN STRAIGHT, STACKED PATTERN. SEE PLAN FOR TILE DIRECTION
2317 35 11Mar21	1	MASTER ENSUITE: TILE, FLOOR , LEVEL 3 - 12X24" LAID IN STRAIGHT, STACKED PATTERN. SEE PLAN FOR TILE DIRECTION
2317 43 11Mar21	1	MASTER ENSUITE: TILE, SHOWER FLOOR, LEVEL 2 - 2X2" SQUARE
2317 49 11Mar21	1	MASTER ENSUITE: TILE, WALL, LEVEL 3 - 12X36" LAID IN HORIZONTAL STACKED PATTERN
2317 11Mar21 NoCat	1	BASEMENT FOYER: DO NOT INSTALL TILE - LEAVE CONCRETE FLOOR

ELECTRICAL

Invoice	Qty.	Description
2323 72,289 10Nov20	6	MAIN HALL: 4" E/S LED INTERIOR POT LIGHT - GROUND FLOOR - EACH. INSTALL IN LIEU OF STANDARD CEILING LIGHTS - USE STANDARD SWITCH INCLUDED IN APS
2317 11Mar21 NoCat	1	**note** electrical for microwave to be installed by purchaser after closing

FRAMING

Invoice	Qty.	Description
2323 10Nov20 NoCat	1	ENSUITE 2: **REPLACE STANDARD TUB TO STANDING SHOWER - INCLUDES TILE ON SHOWER BASE AND POT LIGHT IN CEILING - **NO GLASS ENCLOSURE** LEAVE OPEN FOR PURCHASER TO INSTALL OWN AFTER CLOSING.



CONSTRUCTION SUMMARY

Lot: 127
Model: 40.03 A BROOKSIDE
Project/Phase: Pine Valley Forevergreen / 1

GLASS AND MIRROR

Invoice	Qty.	Description
2323 10Nov20 NoCat	1	ENSUITE 2: **REPLACE STANDARD TUB TO STANDING SHOWER - INCLUDES TILE ON SHOWER BASE AND POT LIGHT IN CEILING - **NO GLASS ENCLOSURE** LEAVE OPEN FOR PURCHASER TO INSTALL OWN AFTER CLOSING.
2317 11Mar21 NoCat	2	MASTER ENSUITE + SHARED ENSUITE: MT6X6 - CHROME

HARDWOOD

Invoice	Qty.	Description
2317 101,930 11Mar21	1	THRU-OUT STANDARD AREAS: MAIN HALL/ DINING ROOM/ STUDY/ GREAT ROOM/ LOWER MEDIA ROOM/ MASTER BEDROOM/ BEDROOM 2/ BEDROOM 3/ BEDROOM 4: VINTAGE, 5 X 3/4" WHITE OAK, WIREBRUSH, UV OIL FINISH - LEVEL 3

INTERIOR TRIM AND DOORS

Invoice	Qty.	Description
2317 153,300 11Mar21	1	UPGRADE 3 1/4" STEP BEVEL BB CASING, 7 1/4" BASE BOARD UPGRADE

KITCHEN AND BATH CABINETRY

Invoice	Qty.	Description
2317 101,930 11Mar21	1	THRU OUT: SEE ATTACHED CABINETRY SCHEDULE

NETWORK AND WIRING

Invoice	Qty.	Description
2323 10Nov20 NoCat	1	GREAT ROOM: INSTALL STANDARD CABLE APPROX. 66" A.F.F. ABOVE FIREPLACE . (NO ELECTRICAL FOR TV WAS PURCHASED)
2323 10Nov20 NoCat	1	LOWER MEDIA ROOM: INSTALL STANDARD CABLE APPROX. 66" A.F.F. SEE PLAN FOR LOCATION. NO ELECTRICAL WAS PURCHASED

PAINT

Invoice	Qty.	Description
2317 101,930 11Mar21	2	MAIN STAIRS: 2ND FLOOR TO BASEMENT - STAIN STAIRS AND LANDINGS

PLUMBING

Invoice	Qty.	Description
2323 72,350 10Nov20	1	ENSUITE 2: **REPLACE STANDARD TUB TO STANDING SHOWER - INCLUDES TILE ON SHOWER BASE AND POT LIGHT IN CEILING - **NO GLASS ENCLOSURE** LEAVE OPEN FOR PURCHASER TO INSTALL OWN AFTER CLOSING.



CONSTRUCTION SUMMARY

Lot: 127
Model: 40.03 A BROOKSIDE
Project/Phase: Pine Valley Forevergreen / 1

STAIR AND RAILINGS

Invoice	Qty.	Description
2317 93,952 11Mar21	2	MAIN STAIRS: 2ND FLOOR TO BASEMENT - UPGRADE - EURONLINE # 1, 3" HALF-ROUND W/V-GROOVE HANDRAIL, 3 1/2" ALL SQUARE POST WITH PYRAMID TOP POST CAP - PACKAGE D

PV - 127 Cabinetry Schedule

ROOM	DESCRIPTION	QTY	TOTAL
KITCHEN	UPGRADE FROM SERIES 2 TO SERIES 5 - MEDIO 6 OYSTER	1	
	STANDARD 30" HOOD FAN - LEAVE APPROX 3" GAP ON EITHER SIDE (N/C)	1	
	RELOCATE BANK OF 4 DRAWERS TO CORNER OF KITCHEN CLOSEST TO FRIDGE WALL - SEE DRAWING (N/C)	1	
	THRU OUT: NO PANELS / NO HARDWARE (N/C)	1	
ISLAND	UPGRADE FROM SERIES 2 TO SERIES 5 - MEDIO 6 OYSTER	1	
	CONVERT BASE CABINET TO BASE POTS AND PANS	1	
	CONVERT BASE CABINET TO 24-27"W MICROWAVE SHELF WITH DRAWER BELOW	1	
CAE			✓

HANDLE INSTALLATION: HORIZONTAL ON DRAWERS, VERTICAL ON DOORS UNLESS OTHERWISE NOTED

LOT #: 127

DATE: March 11 2021

SIGNATURE: 


SIGNATURE: 

PINE VALLEY
COALEXICAN

March 10, 2021

See attached

→ Elevation A • 3,380 sq.ft.
Elevation B • 3,350 sq.ft.

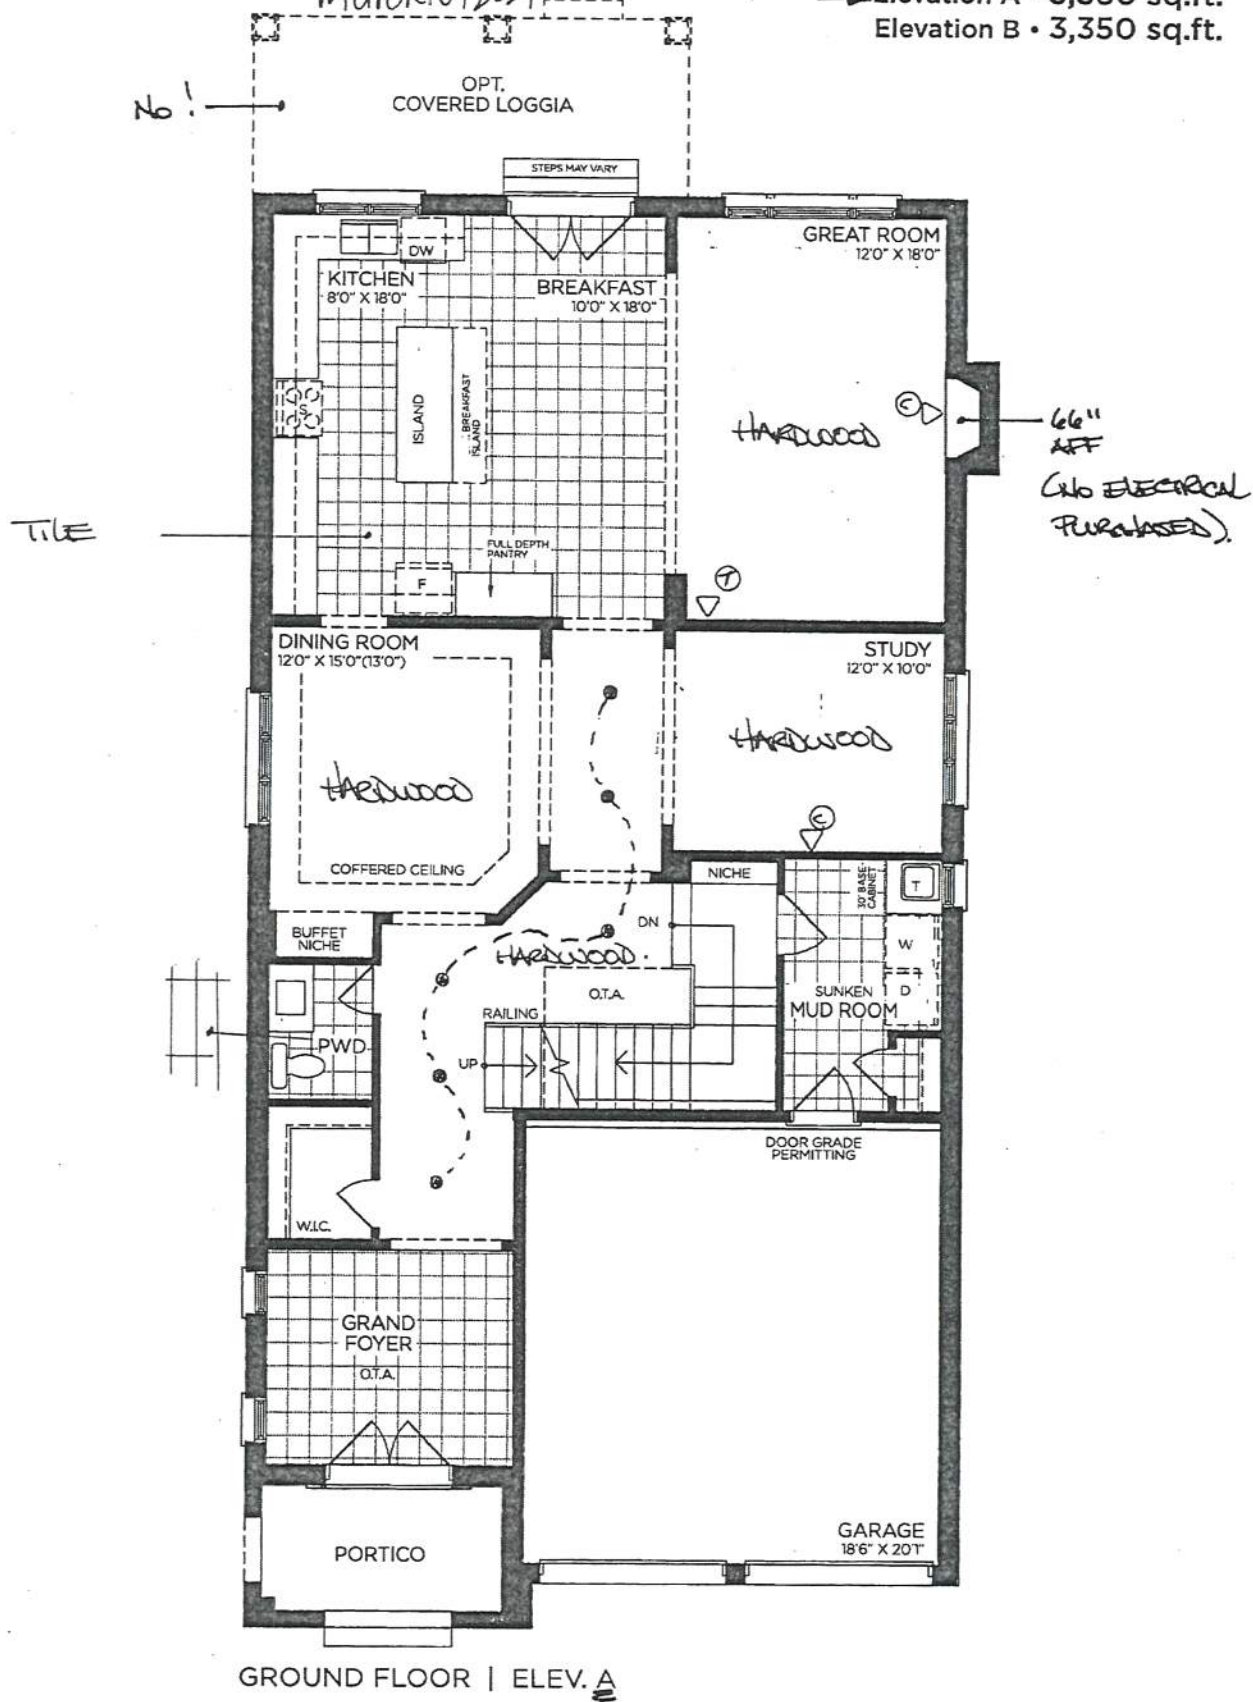

VENDOR _____
PURCHASER _____
PURCHASER _____

GOLDPARK
WORTH MORE™


Prices, figures, illustrations, sizes, features and finishes are subject to change without notice. Areas and dimensions are approximate and actual usable floor space may vary from the stated area. Layout may be reverse of the unit purchased. E. & O. 4003

SCHEDULE 'F'



See attached
TN-127
MAY 13 2020
PV-127
March 10, 2021

The
Brookside
40' SERIES
→ Elevation A • 3,380 sq.ft.
Elevation B • 3,350 sq.ft.

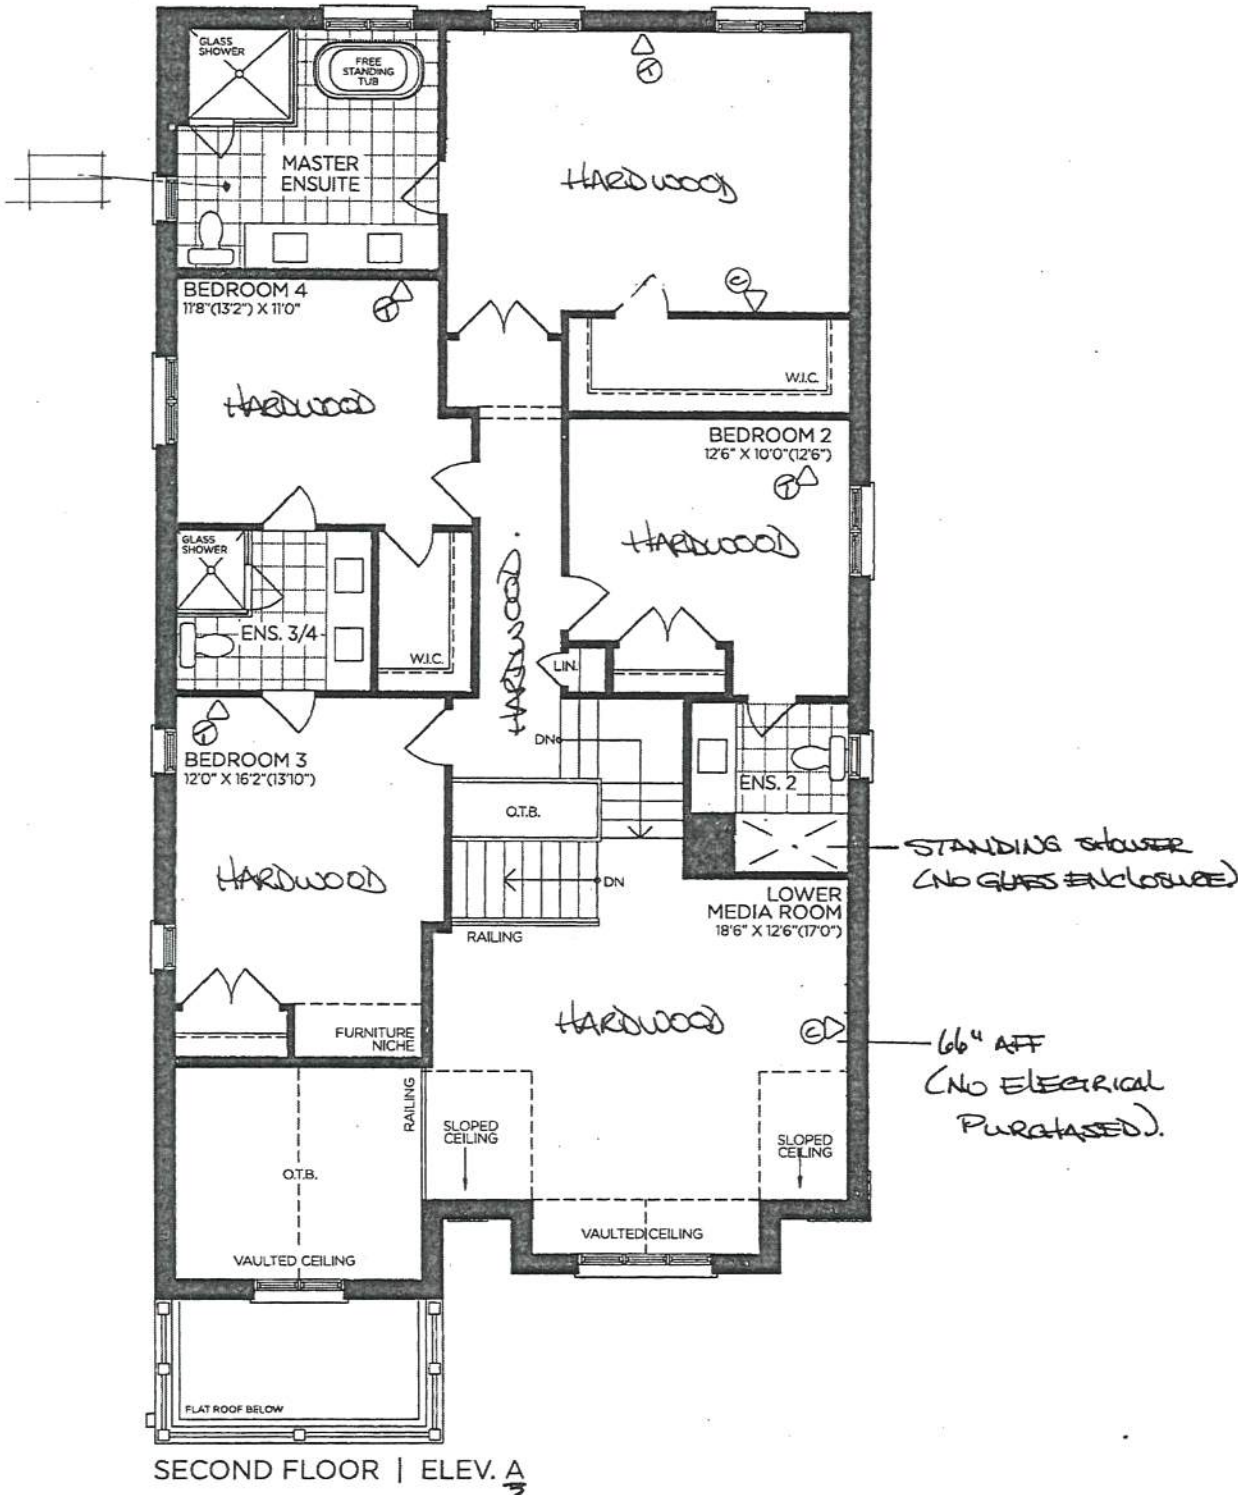

VENDOR

PURCHASER

PURCHASER

GOLDPARK
WORTH MORE™

Prices, figures, illustrations, sizes, features and finishes are subject to change without notice. Areas and dimensions are approximate and actual usable floor space may vary from the stated area. Layout may be reverse of the unit purchased. E. & O.E. 4003


SCHEDULE 'F'



PV-127
MAY 13 2022
PV-127
March 10, 2021

See attached.

The
Brookside
40' SERIES
→ Elevation A • 3,380 sq.ft.
Elevation B • 3,350 sq.ft.

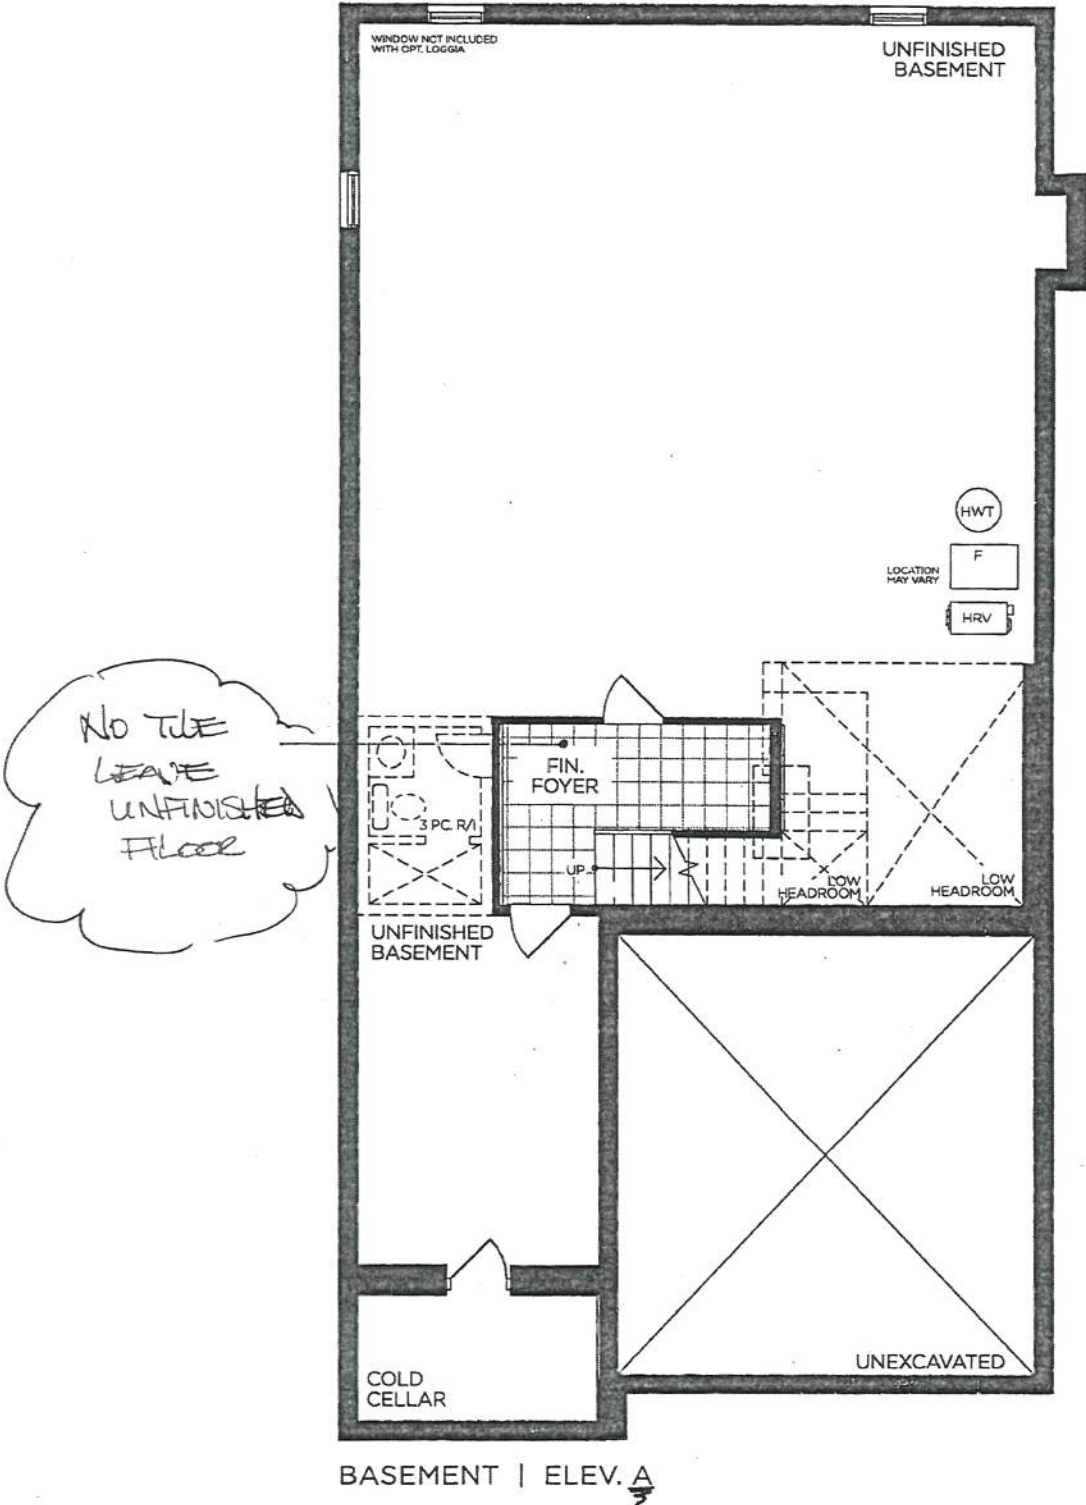

VENDOR

PURCHASER

PURCHASER

GOLDPARK
WORTH MORE™

Prices, figures, illustrations, sizes, features and finishes are subject to change without notice. Areas and dimensions are approximate and actual usable floor space may vary from the stated area. Layout may be reverse of the unit purchased. E. & O.E. 4003

Medio b Oyster

* NO PANELS / NO HARDWARE *



**SITE STANDARD: WHITE 3/4" EXTENSION
SOFT-CLOSE DRAWERS & SOFT-CLOSE
HINGES TO KITCHEN AREA**

10' CEILING - 12"H COFFERED CEILING -
M.H. = 102" + 3/4"H CONTEMPORARY
MOLDING + 5 1/4"H FURRING RAIL
+ LARGE CORNICE MOLDING TO
UNDERSIDE OF BOX

PV-127





March 11, 2021




**GOLDPARK HOMES
PINE VALLEY
VAUGHAN, ONTARIO
MODEL: (4003) BROOKSIDE**

SITE STANDARD: WHITE 3/4" EXTENSION
SOFT-CLOSE DRAWERS & STANDARD SLAM DOOR HINGES
TO VANITIES


ONE TOP DRAWER WHERE POSSIBLE THROUGHOUT EACH
VANITY, ONE BANK OF DRAWERS WHERE POSSIBLE
THROUGHOUT EACH MASTER ENSUITE VANITY

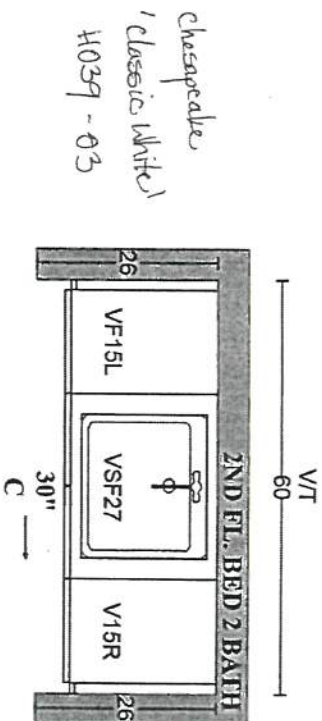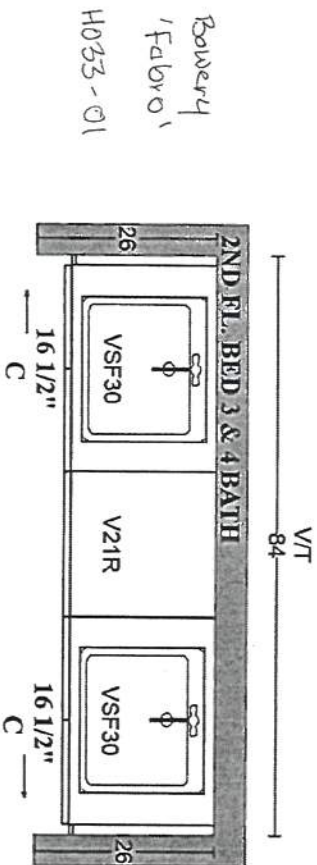

PLAN VIEW

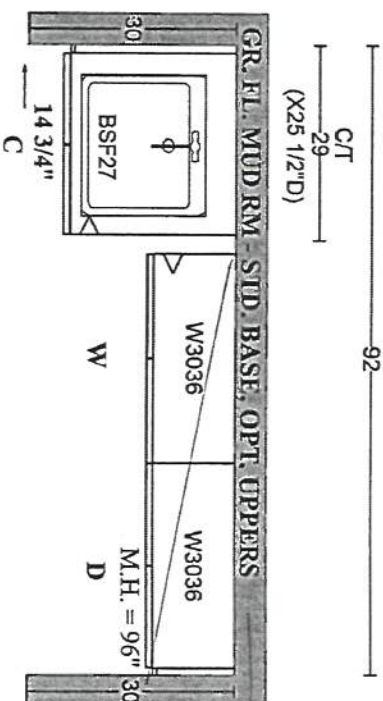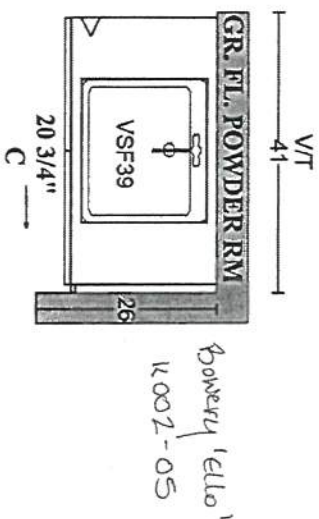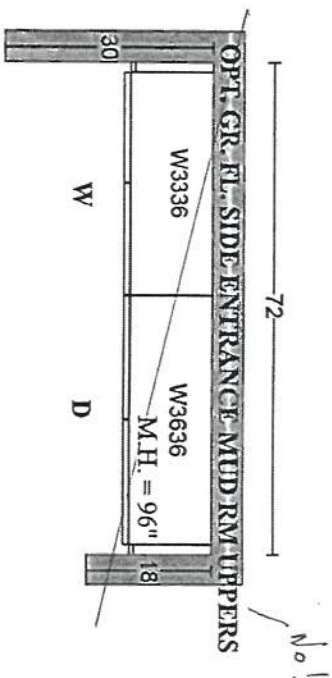

Bovery 'White' K002-03

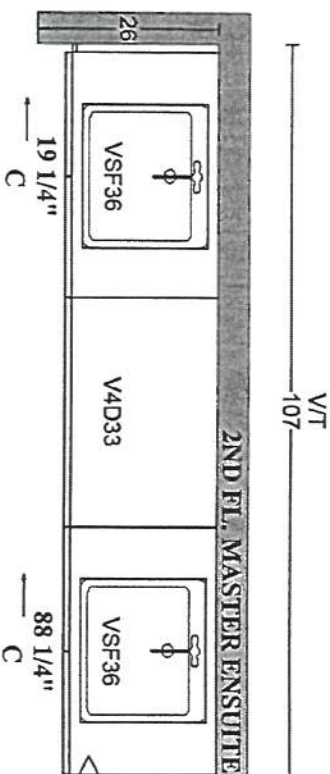


Alban 'Storm Grey Oak' K002-05



PINE VALLEY
FOREVERGREEN

STONE COUNTERTOP EDGE PROFILES

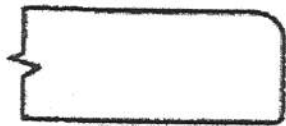


STANDARD 2CM EASED EDGE

LOCATION: THRU OUT




UPGRADE 3CM EASED EDGE

LOCATION: _____

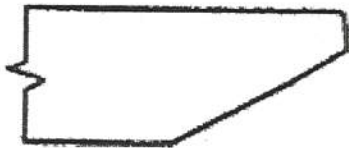

UPGRADE 4CM MITRED EDGE

LOCATION: _____

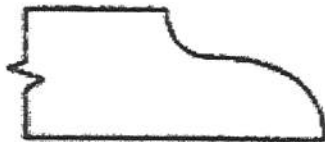

UPGRADE 2CM OGEE EDGE

LOCATION: _____

LOT #: PV-127

DATE: March 11, 2021

SIGNATURE:

SIGNATURE:

STANDARD HARDWARE / KNOBS



☐ K002-02



☒ K002-03
→ Mud Room



☐ K002-04



☐ K002-06



☒ K002-05
→ Powder Room
→ Master Ensuite



☐ K002-14



☐ K024-03

☒ *NO HARDWARE
→ Kitchen

LOT # PV-127

DATE: March 11, 2021

SIGNATURE:

SIGNATURE:

STANDARD HARDWARE / HANDLES

☐

H001-02

☐

H001-03

☐

H001-04

☐

H009-03

☐

H009-09

☐


H011-03

☐

H011-05

☐

H011-06

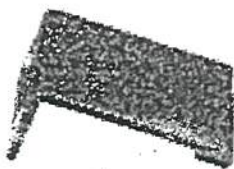☒

H033-01

→ Ensuite 2

☒

H039-03

→ Ensuite 3/4

☐

*NO HARDWARE

LOT # PV-127

DATE: March 11, 2021

SIGNATURE:



SIGNATURE:






PINE VALLEY
FOREVERGREEN

UPGRADE SHOWER HARDWARE

MT6X6

Shower Door Handle

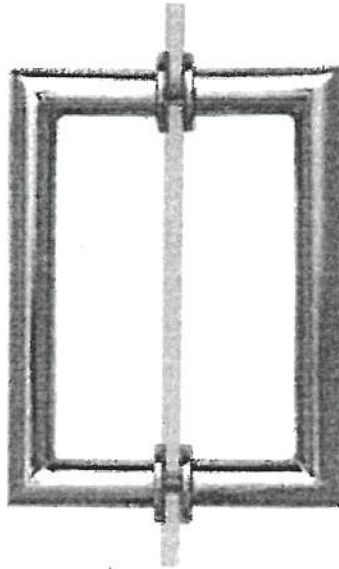

MT6X6
Shower Door Handle

6" x 6" back-to-back
3/4" dia. tube
Cut and mitred corners with
washers
(Also available single sided)

- ☒ CHROME
☐ MATTE BLACK
☐ BRUSHED GOLD

Lot# PV-127

Date: March 11, 2021


Room: Master Ensuite, Ensuite 3/4

Signature:


Signature:

GOLDPARK
WORTH MORE™

BATHROOM ACCESSORIES

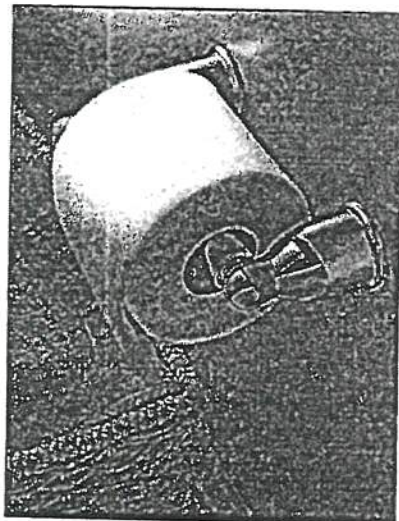

Tissue Holder
Mason - Chrome

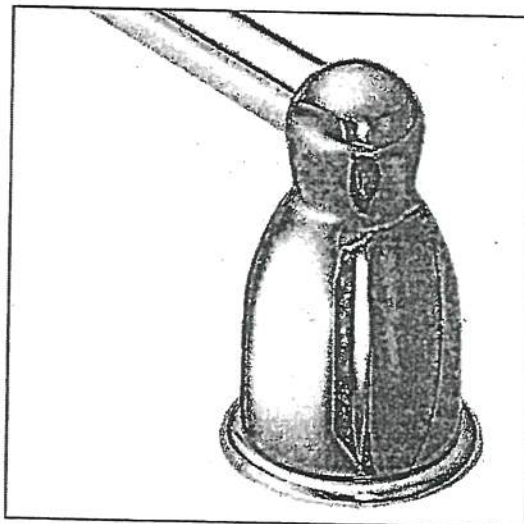

Towel Bar
Mason - Chrome

Please select one of the following:

- ☐ INSTALL STANDARD BATHROOM ACCESSORIES THRU OUT
(tissue holder + towel bar) **location as per vendors discretion**
- ☐ ***DO NOT*** INSTALL STANDARD BATHROOM ACCESSORIES
THRU OUT **tissue holder + towel bar will not be provided**

LOT # PV-127

DATE: March 11, 2021

SIGNATURE:

SIGNATURE:

3/4" (19 mm) or Raised Panel

A raised panel design screwed or glued to a 1/4" (6 mm) thick backing, or a 3/4" (19 mm) routed board can be used. The raised portion of the panel must be fabricated to permit clearances of at least 2" (5.1 cm) from the handle side for fingertip clearance.

Panels thicker than 1/4" (6 mm), up to 3/4" (19 mm) max., will require that the outer 5/16" (8 mm) of panel perimeter be no thicker than 1/4" (6 mm).



Weight limitations for custom panels:

Fresh Food 10 lbs. (4.5 kg) max. for each door

Freezer Door 18 lbs. (8 kg) max.


PV-127
March 11
2021

Panels thicker than 1/4" (6 mm)

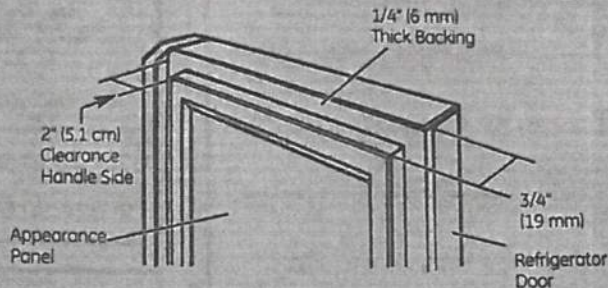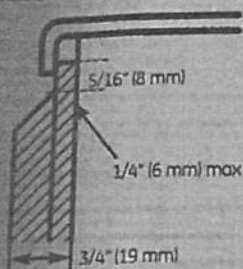


Dimensions for Custom Wood Panels


Left Fresh Food Door


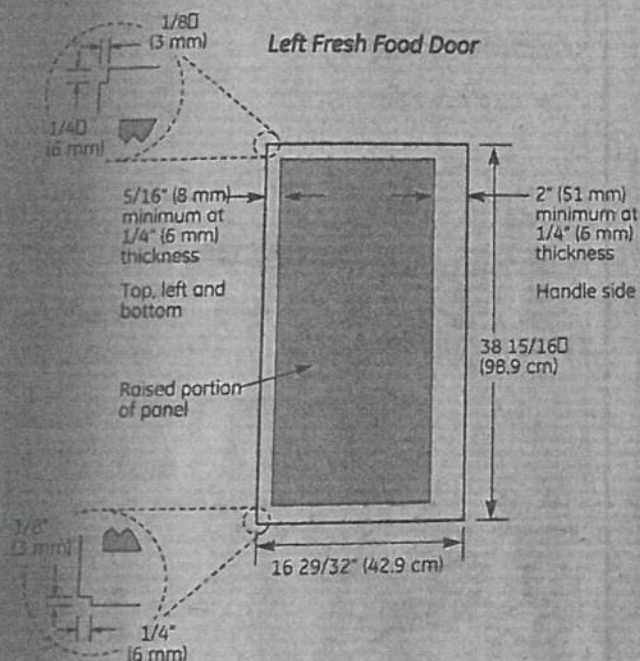


Right Fresh Food Door

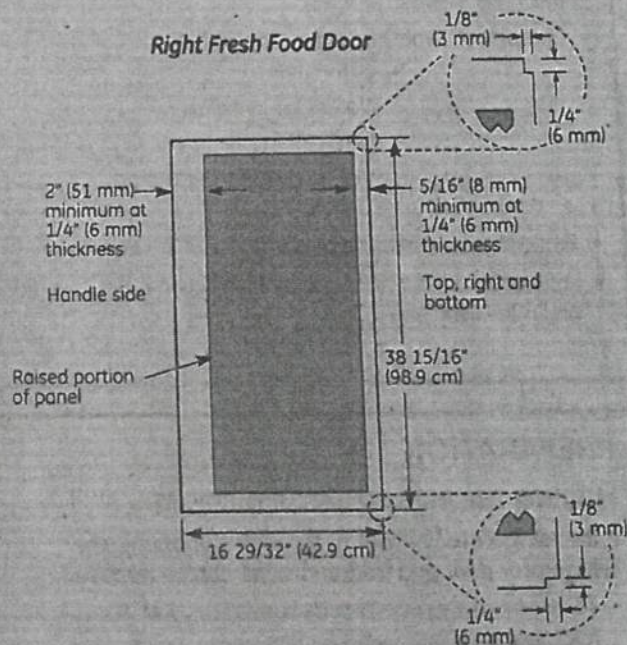

Freezer Door

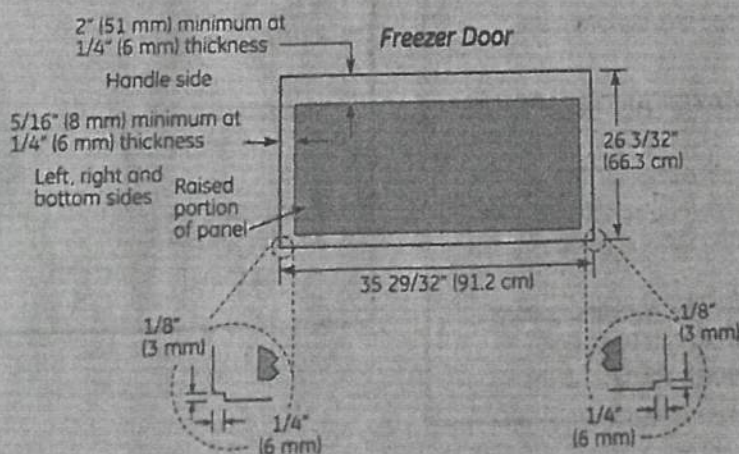

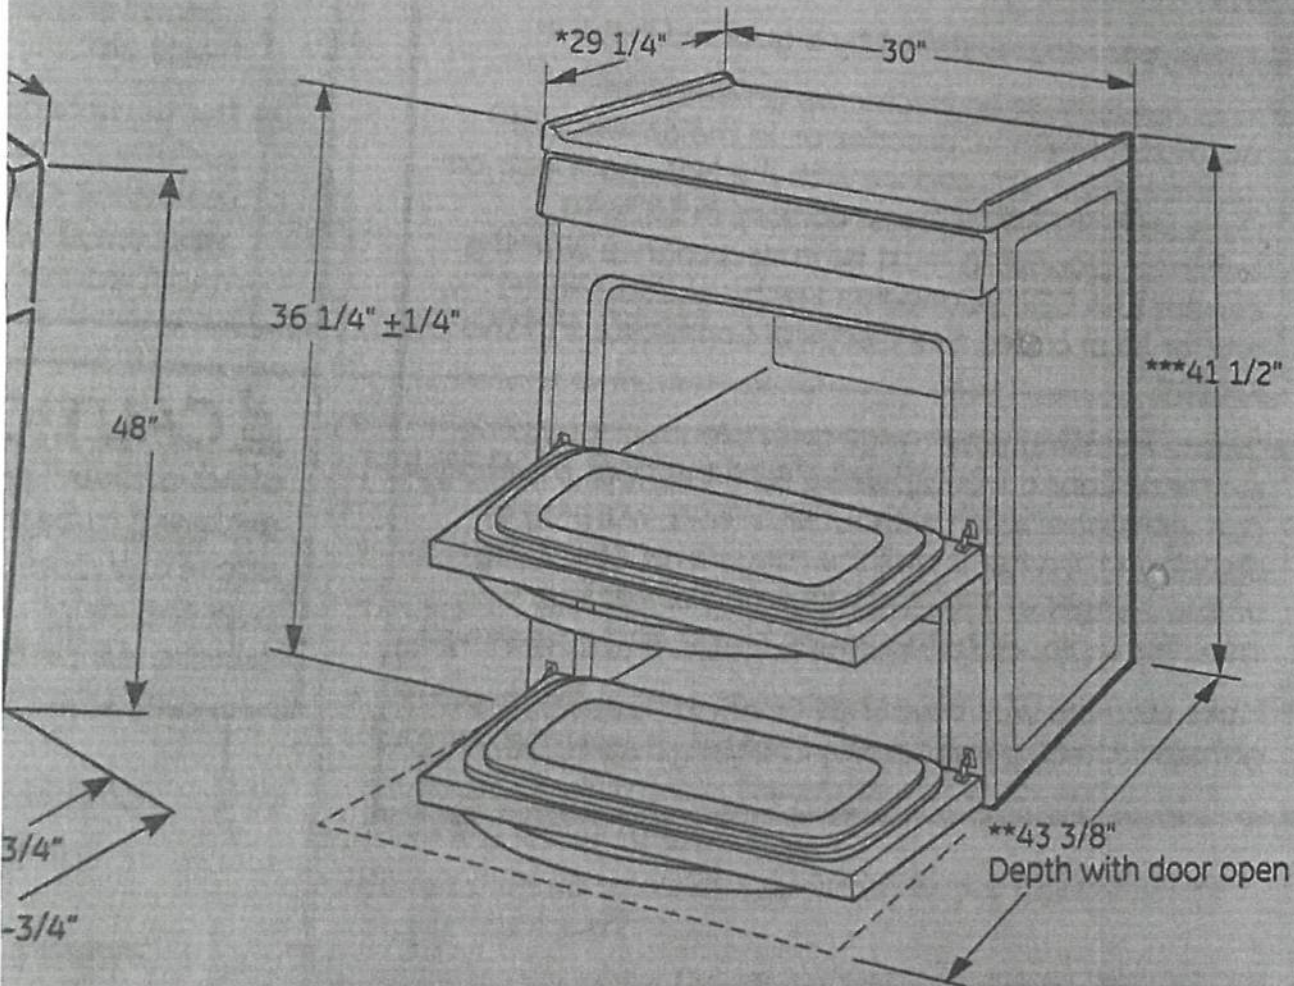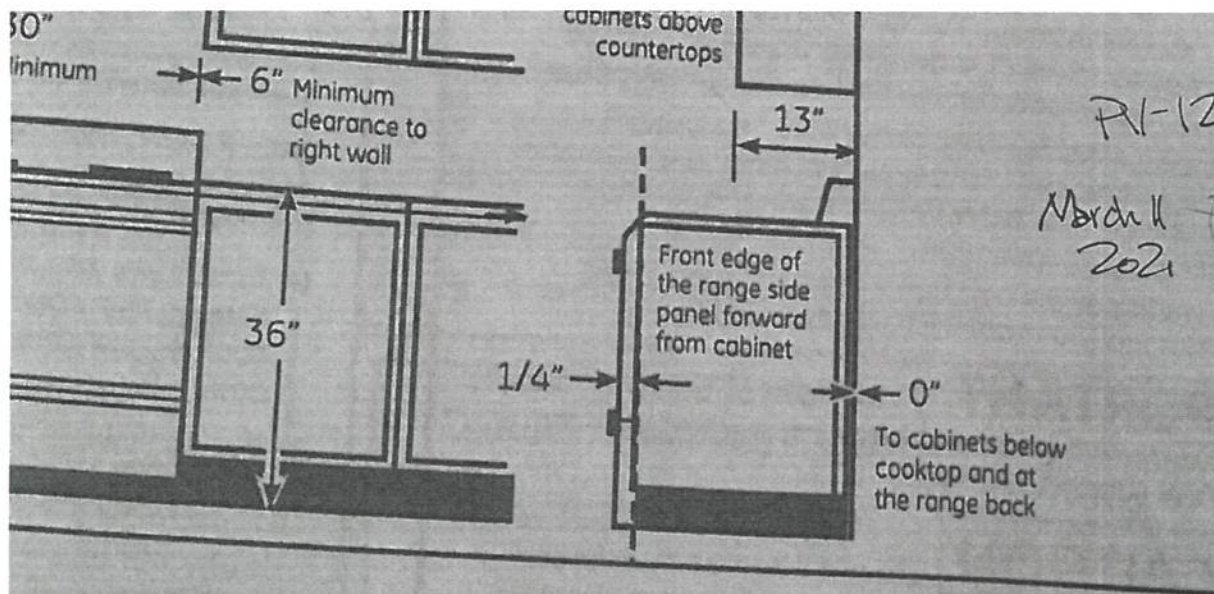

*** Height to backguard based on Café style backguard kit installed.

wall first.
the upper

the range should be similar to the front of the range should be more than the range will allow servicing. A stand 180° (See the range.)