



CONSTRUCTION SUMMARY

Lot: 87
Model: 50.04 A BEAUMONT
Project/Phase: Pine Valley Forevergreen / 1

BASEMENT WINDOWS

Invoice	Qty.	Description
2639 72,675 16Mar21	5	BASEMENT WINDOWS - UPGRADE BASEMENT WINDOW SIZE TO 30 " X 24" - 10" FRAME (PINEVALLEY 50 FOOT LOTS ONLY)

SCHEDULE 'F'




PV-87
March 15

SK
202 TS

The
Beaumont
50' SERIES

→ Elevation A • 4,170 sq.ft.
4,315 sq.ft. Opt. Elevator
Elevation B • 4,165 sq.ft.
4,315 sq.ft. Opt. Elevator
Elevation C • 4,250 sq.ft.
4,400 sq.ft. Opt. Elevator

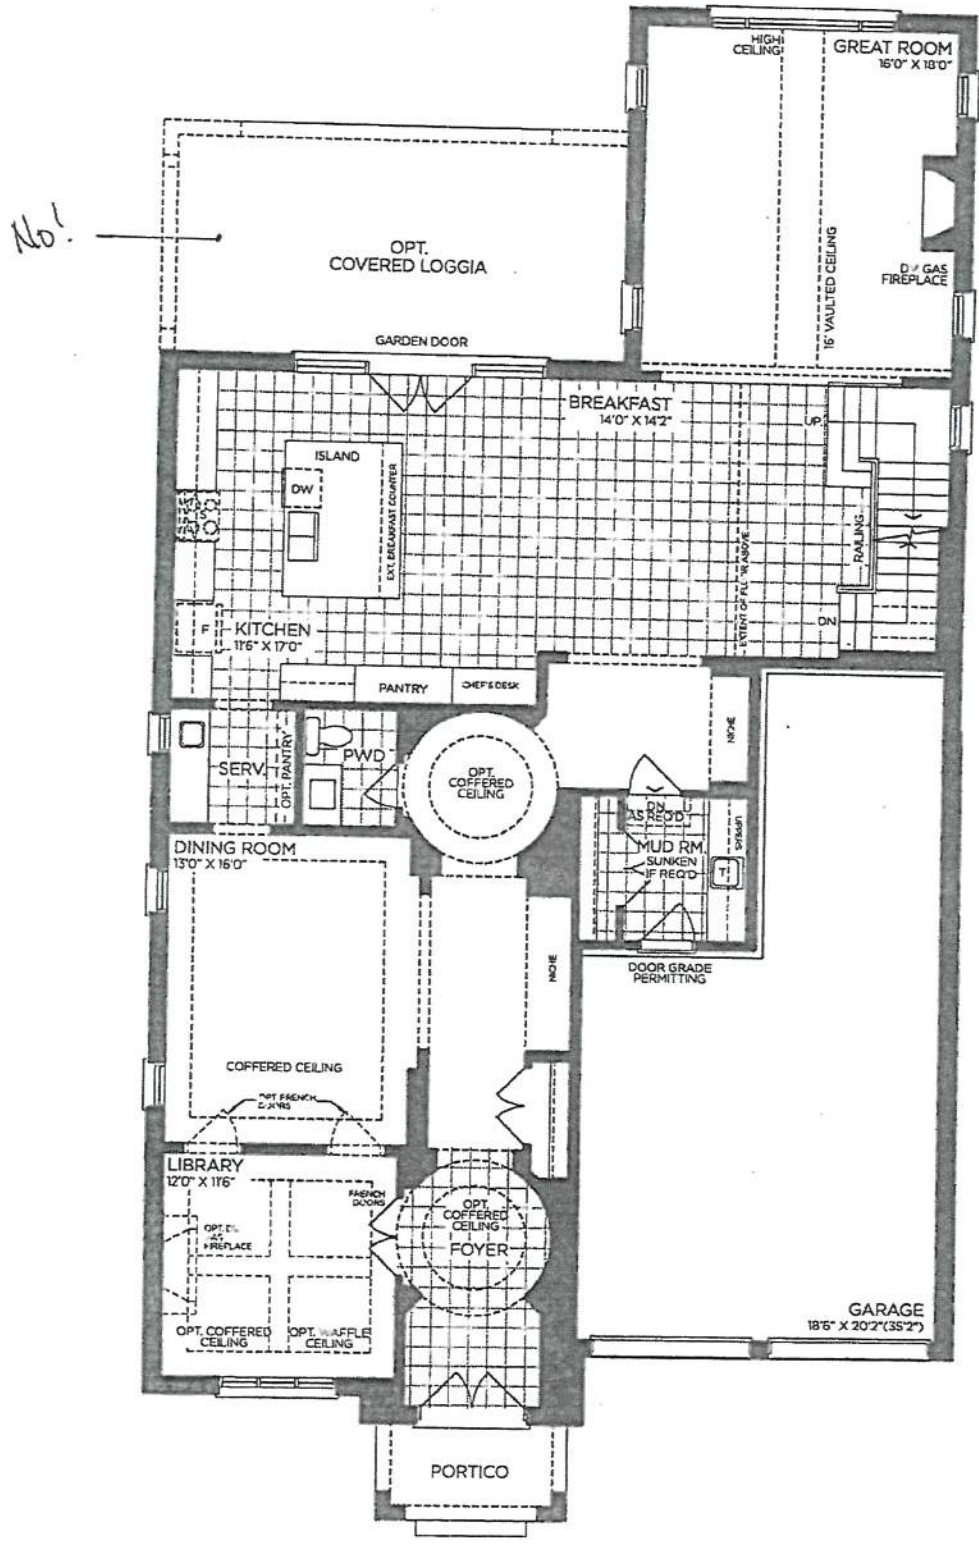

GROUND FLOOR | ELEV. A

VENDOR

PURCHASER

PURCHASER

GOLDPARK
WORTH MORE™

Prices, figures, illustrations, sizes, features and finishes are subject to change without notice. Areas and dimensions are approximate and actual usable floor space may vary from the stated area. Layout may be reverse of the unit purchased. E. & O.E. 5004


SCHEDULE 'F'



PV- 87
 Mar 15 2021

The Beaumont 50' SERIES

→ Elevation A • 4,170 sq.ft.
 4,315 sq.ft. Opt. Elevator
 Elevation B • 4,165 sq.ft.
 4,315 sq.ft. Opt. Elevator
 Elevation C • 4,250 sq.ft.
 4,400 sq.ft. Opt. Elevator

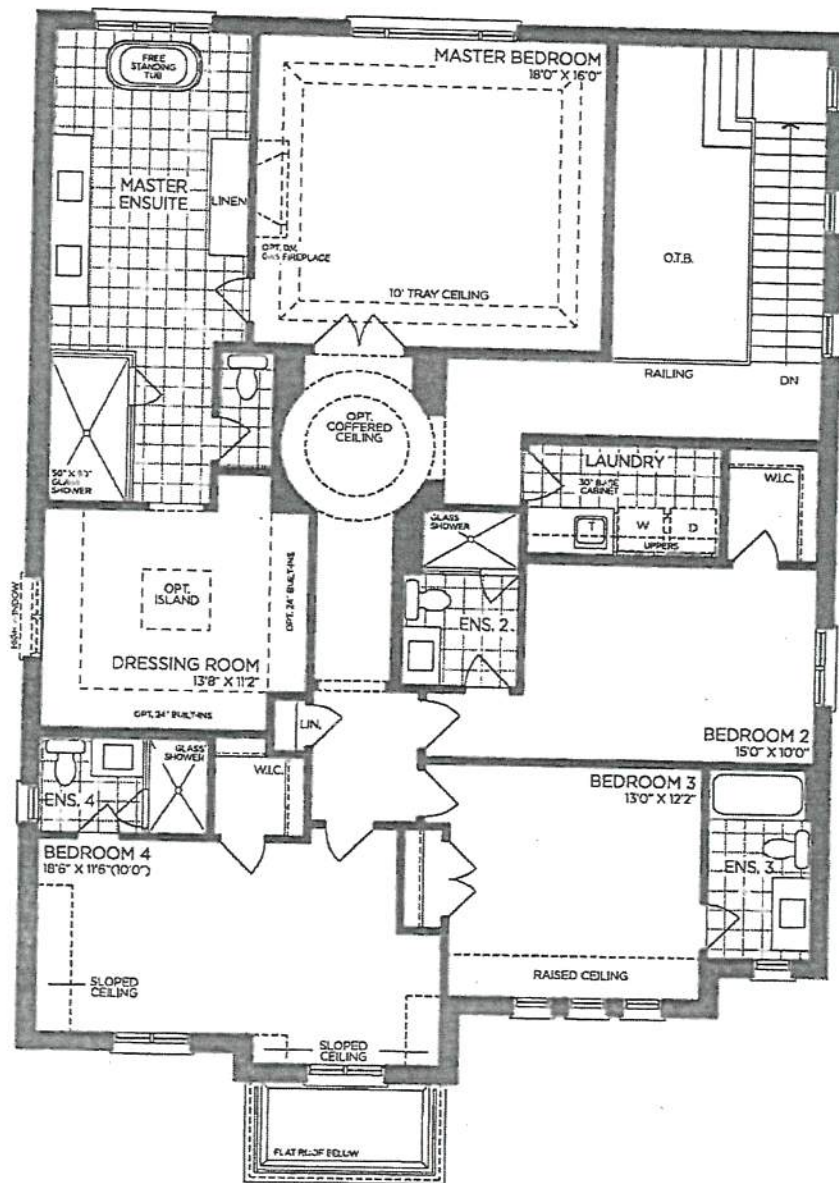

SECOND FLOOR | ELEV. A

VENDOR

PURCHASER

PURCHASER

GOLDPARK
 WORTH MORE™

Prices, figures, illustrations, sizes, features and finishes are subject to change without notice. Areas and dimensions are approximate and actual usable floor space may vary from the stated area. Layout may be reverse of the unit purchased. E. & O.E. 5004




PV-87
MARCH 15 2021 TS

SCHEDULE 'F'

The Beaumont

50' SERIES

- Elevation A • 4,170 sq.ft.
4,315 sq.ft. Opt. Elevator
- Elevation B • 4,165 sq.ft.
4,315 sq.ft. Opt. Elevator
- Elevation C • 4,250 sq.ft.
4,400 sq.ft. Opt. Elevator

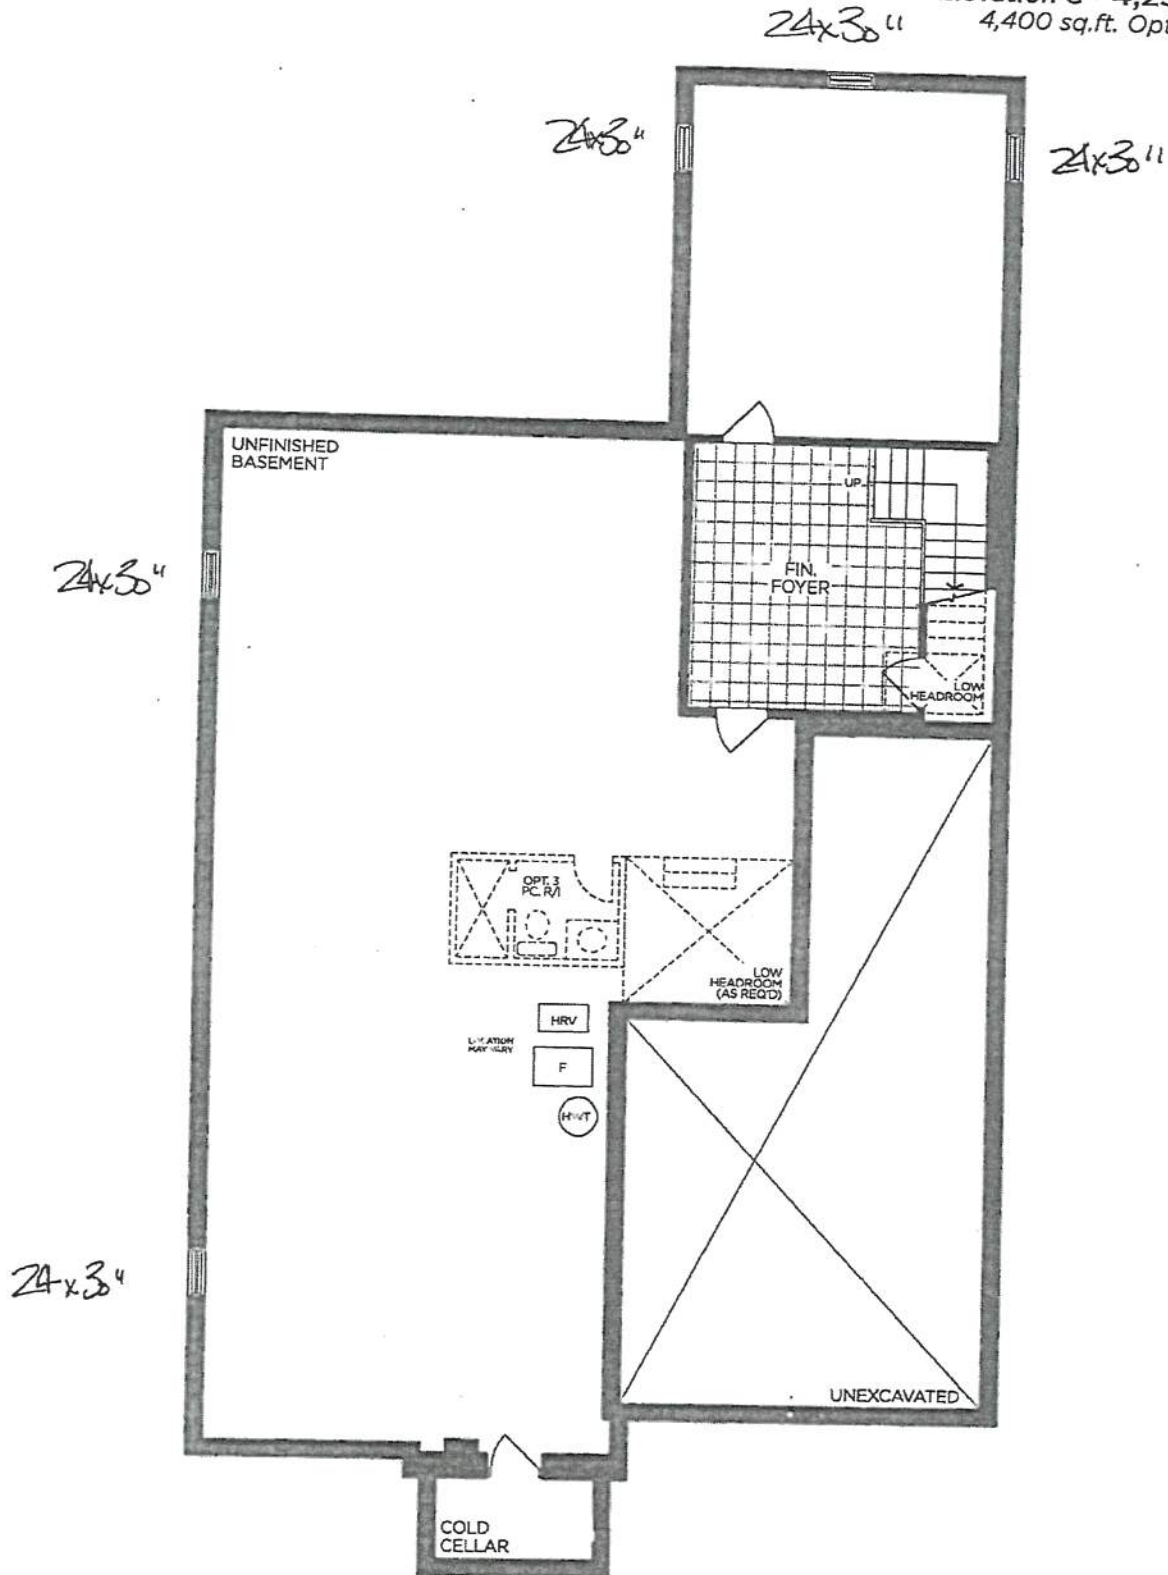

BASEMENT | ELEV. A

VENDOR

PURCHASER

PURCHASER

GOLDPARK
WORTH MORE™

Prices, figures, illustrations, sizes, features and finishes are subject to change without notice. Areas and dimensions are approximate and actual usable floor space may vary from the stated area. Layout may be reverse of the unit purchased. E. & O.E. 5004