

CERAMIC

Invoice	Qty.	Description
2425 25Aug20 NoCat	1	.BASEMENT: ADDITIONAL 3-PC BATHROOM (TOILET, SINK, FAUCET, TILED SHOWER) COMPLETE WITH BUILDERS STANDARD OFFERINGS - SHOWER OPEN FOR FUTURE SHOWER CURTAIN (NO GLASS DOOR)
2425 25Aug20 NoCat	1	.MASTER ENSUITE: SHOWER BENCH COMPLETE WITH STANDARD TILE AND MATCHING MARBLE JAMB COLOUR SEAT TOP
2425 25Aug20 NoCat	1	.MASTER ENSUITE: SHOWER NICHE [SHAMPOO SHELF] - COMPLETE WITH MATCHING MARBLE JAMBS ON 4 SIDES, STANDARD TILE, APPROX. 12 X 18 INSTALLED VERTICALLY - SEE PLAN FOR PREFERRED LOCATION
2425 25Aug20 NoCat	1	.MAIN BATH: SHOWER NICHE [SHAMPOO SHELF] - COMPLETE WITH MATCHING MARBLE JAMBS ON 4 SIDES, STANDARD TILE, APPROX. 12 X 18 INSTALLED VERTICALLY - SEE PLAN FOR PREFERRED LOCATION
2425 25Aug20 NoCat	1	.MASTER ENSUITE: MOEN 'VOSS' POLISHED NICKEL 3-FUNCTION SHOWER SYSTEM WITH RAIN SHOWER (from wall) 62380/T2692NL/3372/T4611NL/3669NL/A725NL
2584 34 09Feb21	1	FOYER: TILE, FLOOR, LEVEL 2 - 12x24" LAID IN STRAIGHT STACKED PATTERN. SEE PLAN FOR DIRECTION
2584 34 09Feb21	1	POWDER ROOM: TILE, FLOOR, LEVEL 2 - 12x24" LAID IN STRAIGHT STACKED PATTERN. SEE PLAN FOR DIRECTION
2584 48 09Feb21	1	MASTER ENSUITE: TILE, FLOOR, LEVEL 2 - 12x24" LAID IN STRAIGHT STACKED PATTERN. SEE PLAN FOR DIRECTION

CONCRETE AND DRAIN

Invoice	Qty.	Description
2425 25Aug20 NoCat	1	.BACK-FLOW PREVENTER VALVE

DRYWALL

Invoice	Qty.	Description
2425 25Aug20 NoCat	1	.GREAT ROOM: UPGRADE TO 96" GARDEN DOOR ASSEMBLY



CONSTRUCTION SUMMARY

Lot: 151
Model: 40.00 B BRIARWOOD
Project/Phase: Pine Valley Forevergreen / 1

ELECTRICAL

Invoice	Qty.	Description
2425 72,281 25Aug20	1	.GREAT ROOM: INTERIOR WALL OUTLET: ADDITIONAL 110V WALL INTERIOR RECEPTACLE ON EXISTING CIRCUIT FOR WALL MOUNTED TV - LOCATE APPROX. 66" A.F.F. ABOVE FIREPLACE
2425 72,289 25Aug20	6	.KITCHEN: 4" E/S LED INTERIOR POT LIGHT - GROUND FLOOR - EACH - INCLUDES SWITCH INCLUDED IN APS
2425 72,307 25Aug20	1	.KITCHEN: FIXTURE: RELOCATE STANDARD CEILING MOUNT FIXTURE -LOCATE ABOVE ISLAND SEE PLAN
2425 72,280 25Aug20	1	.KITCHEN: CEILING OUTLET: ADDITIONAL REINFORCED CEILING OUTLET - LOCATE ABOVE ISLAND - SEE PLAN USE SAME SWITCH AS STANDARD CEILING LIGHT
2425 72,303 25Aug20	1	.KITCHEN: FIXTURE: UNDER CABINET FLUORESCENT LIGHT FIXTURES - DOES NOT INCLUDE (AND REQUIRES) LIGHT VALANCE
2425 72,273 25Aug20	1	.KITCHEN: 110V WALL RECEPTACLE ON SEPARATE CIRCUIT - GAS FIRED APPLIANCE - FOR AUX. EQUIPMENT - NOT A STOVE PLUG
2425 72,288 25Aug20	2	.MAIN HALL: ROUGH-IN FOR ADDITIONAL WALL SCONCE (1) CAPPED OUTLET -FIXTURE NOT INCLUDED LOCATE APPROX. 80" A.F.F. - SEE PLAN FOR LOCATION
2425 72,276 25Aug20	1	.MAIN HALL: ADDITIONAL 3 - WAY SWITCH (LIGHT OPERATED BY 2 DIFFERENT SWITCHES) FOR SCONCES
2425 72,288 25Aug20	2	.FORMAL ROOM: ROUGH-IN FOR ADDITIONAL WALL SCONCE (1) CAPPED OUTLET - FIXTURE NOT INCLUDED LOCATE APPROX 80" A.F.F. SEE PLAN FOR LCOAITON
2425 72,278 25Aug20	1	.FORMAL ROOM: ADDITIONAL INTERIOR SWITCH FOR WALL SCONCES
2425 25Aug20 NoCat	1	.BASEMENT: ADDITIONAL 3-PC BATHROOM (TOILET, SINK, FAUCET, TILED SHOWER) COMPLETE WITH BUILDERS STANDARD OFFERINGS - SHOWER OPEN FOR FUTURE SHOWER CURTAIN (NO GLASS DOOR)

EXTERIOR COLOURS

Invoice	Qty.	Description
2425 25Aug20 NoCat	1	EXTERIOR COLOR PKG # BR.11

FORMING

Invoice	Qty.	Description
2425 25Aug20 NoCat	1	.BASEMENT: ADDITIONAL 3-PC BATHROOM (TOILET, SINK, FAUCET, TILED SHOWER) COMPLETE WITH BUILDERS STANDARD OFFERINGS - SHOWER OPEN FOR FUTURE SHOWER CURTAIN (NO GLASS DOOR)
2425 25Aug20 NoCat	1	.GREAT ROOM: UPGRADE TO 96" GARDEN DOOR ASSEMBLY

FRAMING

Invoice	Qty.	Description
2425 72,671 25Aug20	1	.MASTER ENSUITE: SHOWER BENCH COMPLETE WITH STANDARD TILE AND MATCHING MARBLE JAMB COLOUR SEAT TOP
2425 72,631 25Aug20	1	.MASTER ENSUITE: SHOWER NICHE [SHAMPOO SHELF] - COMPLETE WITH MATCHING MARBLE JAMBS ON 4 SIDES, STANDARD TILE, APPROX. 12 X 18 INSTALLED VERTICALLY - SEE PLAN FOR PREFERRED LOCATION
2425 72,631 25Aug20	1	.MAIN BATH: SHOWER NICHE [SHAMPOO SHELF] - COMPLETE WITH MATCHING MARBLE JAMBS ON 4 SIDES, STANDARD TILE, APPROX. 12 X 18 INSTALLED VERTICALLY - SEE PLAN FOR PREFERRED LOCATION
2425 25Aug20 NoCat	1	.GREAT ROOM: UPGRADE TO 96" GARDEN DOOR ASSEMBLY
2425 25Aug20 NoCat	1	.BASEMENT: ADDITIONAL 3-PC BATHROOM (TOILET, SINK, FAUCET, TILED SHOWER) COMPLETE WITH BUILDERS STANDARD OFFERINGS - SHOWER OPEN FOR FUTURE SHOWER CURTAIN (NO GLASS DOOR)

GARAGE DOORS

Invoice	Qty.	Description
2425 72,324 25Aug20	2	.GARAGE DOOR OPENER (CHAMBERLAIN BELT DRIVE) - WITH 1 REMOTE - PRICE IS PER DOOR
2425 72,323 25Aug20	1	.WIRELESS KEYPAD GARAGE DOOR ENTRY 877LM

GLASS AND MIRROR

Invoice	Qty.	Description
2584 09Feb21 NoCat	1	MASTER ENSUITE: UPGRADE SHOWER DOOR HANDLE TO MT6X6 - CHROME



CONSTRUCTION SUMMARY

Lot: 151
Model: 40.00 B BRIARWOOD
Project/Phase: Pine Valley Forevergreen / 1

GRANITE MARBLE QUARTZ

Invoice	Qty.	Description
2584 101,930 09Feb21	1	KITCHEN: UPGRADE 4 GRANITE COUNTER TOP
2584 101,930 09Feb21	1	KITCHEN: ADD FULL HEIGHT BACKSPLASH - LEVEL 4
2584 101,930 09Feb21	1	MASTER ENSUITE: UPGRADE 4 GRANITE COUNTER TOP

HARDWOOD

Invoice	Qty.	Description
2584 1 09Feb21	1	KITCHEN/BREAKFAST: MIRAGE, 3 5/16" RED OAK, TRUE BALANCE ENGINEERED HARDWOOD, 3/4", ADMIRATION TEXTURE CASHMERE FINISH - KITCHEN/ BREAKFAST - LEVEL 1

HVAC

Invoice	Qty.	Description
2425 72,224 25Aug20	1	KITCHEN: GAS LINE ROUGH-IN - MAIN FLOOR FOR APPLIANCE - SEE PLAN FOR LOCATION
2425 72,247 25Aug20	1	HUMIDIFIER - LENNOX MODEL WB3-17 (2000 UP TO 3000 SQ.FT.)
2425 72,235 25Aug20	1	3.0 TON AC - WITH LOW VOLTAGE WIRING & WALL BRACKETS (13ACX)

INTERIOR TRIM AND DOORS

Invoice	Qty.	Description
2425 25Aug20 NoCat	1	GREAT ROOM: UPGRADE TO 96" GARDEN DOOR ASSEMBLY

KITCHEN AND BATH CABINETRY

Invoice	Qty.	Description
2584 101,930 09Feb21	1	THRU OUT: SEE ATTACHED CABINETRY SCHEDULE

NETWORK AND WIRING

Invoice	Qty.	Description
2425 72,259 25Aug20	1	.GREAT ROOM: CONDUIT PIPE - FOR WALL MOUNT TV - LOCATE ABOVE FIREPLACE, APPROX 66" A.F.F. THRU BASEMENT, TERMINATING AT CABLE LOCATION - SEE PLAN
2425 72,258 25Aug20	1	.BEDROOM 2:ADDITIONAL CAT6 ETHERNET OUTLET - EACH SEE PLAN FOR LCOAITON

PAINT

Invoice	Qty.	Description
2425 25Aug20 NoCat	1	.GREAT ROOM: UPGRADE TO 96" GARDEN DOOR ASSEMBLY

PLUMBING

Invoice	Qty.	Description
2425 72,345 25Aug20	1	.BASEMENT: ADDITIONAL 3-PC BATHROOM (TOILET, SINK, FAUCET, TILED SHOWER) COMPLETE WITH BUILDERS STANDARD OFFERINGS - SHOWER OPEN FOR FUTURE SHOWER CURTAIN (NO GLASS DOOR)
2425 72,336 25Aug20	1	.BASEMENT: ROUGH-IN FOR LAUNDRY IN BASEMENT (INCLUDES LAUNDRY TUB AND FIXTURE)
2425 72,332 25Aug20	1	.KITCHEN: ROUGH-IN 1/4" COLD WATER LINE TO FRIDGE
2425 25Aug20 NoCat	1	.MASTER ENSUITE: UPGRADE TUB TO MIROLIN 'SABLE' SOAKING TUB #CF2012
2425 25Aug20 NoCat	1	.MASTER ENSUITE: MOEN 'VOSS' POLISHED NICKEL 3-FUNCTION SHOWER SYSTEM WITH RAIN SHOWER (from wall) 62380/T2692NL/3372/T4611NL/3669NL/A725NL
2425 25Aug20 NoCat	1	.MASTER ENSUITE: MOEN 'VOSS' ROMAN TUB FILLER WITH HAND SHOWER - POLISHED NICKEL #T694NL/9796
2425 25Aug20 NoCat	2	.MASTER ENSUITE: MOEN 'VOSS' 8" LAV FAUCET POLISHED NICKEL #T6905NL/9000

STAIR AND RAILINGS

Invoice	Qty.	Description
2584 93,947 09Feb21	2	MAIN STAIRS: BASEMENT TO 2ND FLOOR; UPGRADE - EURONLINE # 1, 3" HALF-ROUND W/V-GROOVE HANDRAIL, 3 1/2" ALL SQUARE POST WITH PYRAMID TOP POST CAP - PACKAGE D



CONSTRUCTION SUMMARY

Lot: 151

Model: 40.00 B BRIARWOOD

Project/Phase: Pine Valley Forevergreen / 1

STAIRS AND RAILINGS

Invoice	Qty.	Description
2584 101,930 09Feb21	2	MAIN STAIRS: STAIN STAIRS AND LANDINGS- 2ND FLOOR TO BASEMENT:

PV - 151 Cabinetry Schedule

ROOM	DESCRIPTION	PRICE	QTY	TOTAL
KITCHEN	UPGRADE PERIMETER FROM SERIES 2 TO SERIES 5 - WINDSOR 6 "OYSTER"		1	
	UPGRADE ISLAND FROM SERIES 2 TO SERIES 5 - WINDSOR 6 "OYSTER"		1	
	UPGRADE PANTRIES FROM SERIES 2 TO SERIES 5 - WINDSOR 6 "OYSTER"		1	
	RETURN TRIP FOR KICKPLATE ADJUSTMENTS		1	
	ADD PROUD CAMDEN FURNITURE KICK AT BACK OF ISLAND		1	
	CONVERT STD BASE CABINETS INTO BASE POTS AND PANS		2	
	ADJUST CABINETRY FOR 36" RANGE (N/C)		1	
	ADD CABINET ABOVE RANGE		1	
	ADD CLEAR GLASS DOOR INSERTS TO UPPER CABINETS ON EITHER SIDE OF RANGE		1	
	CONVERT STD WHITE INTERIOR TO MATCHING INTERIOR FOR GLASS CABINETS ON EITHER SIDE OF RANGE		1	
	ADD VALANCE		1	
	ADD RECESSED END GABLES TO SIDES OF ISLAND		2	
LAUNDRY ROOM	ADD OPTIONAL UPPEKS		1	
CABINETRY TOTAL:				

LOT #: 151	DATE: FEB 8 2021
------------	------------------

SIGNATURE: *L. L. L. L. L.*

SIGNATURE:

Purchaser: Lia A. Grigoras

Property: 151 of Plan -

Telephone Res. / Bus: (905) 760-9595

Project: Pine Valley Forevergreen - Phase 1

Decor Advisor: Yolande Somerville

Model and Elevation: 40.00 B BRIARWOOD

Layout Changes: ☒ Yes ☐ No

Sketch Attached: ☒ Yes ☐ No

Exterior Colour Scheme:

1. Cabinetry

	Style and Colour	Counter	Hardware
Kitchen / Breakfast	Windsor 6 'Oyster'	*Granite: Smokey Mountain HP	attachd
Laundry Room	Chesapeake 'Classic White'	P-Lam White	attachd
Powder Room	Chesapeake 'Classic White'	Quartz: Nordic Loft	attachd
Main Bath	Chesapeake 'Classic White'	Quartz: Nordic Loft	
Master Ensuite Bathroom	Chesapeake 'Classic White'	*Granite: Smokey Mountain HP	attachd
Second Ensuite Bathroom (If Applicable)			
Shared Bath	Tribeca 'Arris'	Quartz: Blanco City	attachd

Comment

Basement Bath: Tribeca 'Arris' Quartz: Blanco City

2. Floor Tile

	Selection
Entrance Vestibule	*12x24" Geology 'Grey'
Main Hall	
Kitchen / Breakfast	hardwood
Laundry Room	13x13" Venus 'Ivory'
Powder Room	*12x24" Geology 'Grey'
Main Bath	13x13" Venus 'Ivory'
Master Ensuite Bathroom	*12x24" Geology 'Grey'
Second Ensuite Bathroom (If Applicable)	
Lower Landing (If Applicable)	13x13" New Byzantine 'Pentellic Grey'
Shared Bath	13x13" New Byzantine 'Pentellic Grey'

Comment

Basement Bath: 13x13" New Byzantine 'Pentellic Grey' // Shower floor tile thru out: std 2x2" white

3. Wall Tile

	Selection	Listello/Inserts	Describe
Main Bath	8x10" Weave 'White'	☐ Yes ☒ No	
Master Ensuite Bathroom			
Tub Deck		☐ Yes ☒ No	
Shower Stall	8x10" Weave 'White'	☐ Yes ☒ No	
Bathroom Walls		☐ Yes ☒ No	
Second Ensuite Bathroom (If Applicable)		☐ Yes ☒ No	
Shared Bath	8x10" Weave 'White'	☐ Yes ☒ No	
Kitchen Backsplash	☒ Yes ☐ No	Backsplash Behind Fridge	

Comment

Basement Bath: 8x10" Weave 'White'

Purchaser: Lia A. Grigoras

Property: 151 of Plan -

Telephone Res. / Bus: (905) 760-9595

Project: Pine Valley Forevergreen - Phase 1

Decor Advisor: Yolande Somerville

Model and Elevation: 40.00 B BRIARWOOD

4. Plumbing Fixtures

Master Ensuite Bathroom ☐ Second Ensuite ☐ Powder Room ☐
Other Room - Specify ☐ Other Washroom ☐

Comment

Standard thru out except master ensuite

5. Hardwood Flooring

	Type and Stain		Type and Stain
Main Hall		Upper Landing	
Kitchen / Breakfast	3/4x3-5/16" red oak smooth Rio	Upper Hall	
Living Room		Master Bedroom	
Dining Room		Bedroom #2	
Family Room		Bedroom #3	
Den/Library		Bedroom #4	
Entrance Vestibule		Bedroom #5	
Lower Landing (If Applicable)		Other Room - Specify	
		Thru out standard areas	3/4x3-5/16" red oak smooth Rio

Comment

Stairs and landings will not match in colour/texture

6. Carpeting

	Upgrade	Description
Ground Floor	☐	
Second Floor	☐	
	☐	

	Type	Area
Upgrade Underpad		
Carpet on Stairs	Capped	Runner - *Upgrade

Comment

7. Fireplace

	Living Room			Family Room			Other Room - Specify		
	Purchased	As Per Plan	N/A	Purchased	As Per Plan	N/A	Purchased	As Per Plan	N/A
Fireplace Type	☐	☐	☒	☐	☒	☐	☐	☐	☒
Mantle Type				Standard Gas					
Colour / Stain				Mediterranean					
Surround				Arctic White					
Hearth				n/a					
				none					

Comment

Purchaser: Lia A. Grigoras

Property: 151 of Plan -

Telephone Res. / Bus: (905) 760-9595

Project: Pine Valley Forevergreen - Phase 1

Decor Advisor: Yolande Somerville

Model and Elevation: 40.00 B BRIARWOOD

8. Trim Carpentry

Interior Doors Carrara Front Door Glass Inserts Standard Door Handles Standard
Interior Trim Standard

Comment

9. Plaster Mouldings and Medallions

Standard Throughout ☐ Yes ☐ No ☒ N/A

Entrance Vestibule			Kitchen/Breakfast		
Main Hall			Den/Library		
Living Room			Lower Landing		
Dining Room			Other Room - Specify		
Family Room					

Comment

10. Railings and Spindles

Railing Package Package D
Railing Colour Rio Spindle Colour Black
Stringer / Riser Rio Treads Rio
Oak Stairs ☒ Yes ☐ No ☐ N/A

Comment

11. Wall Paint / Ceilings

Throughout Finished Areas Oyster

Trim Paint White

Smooth Ceilings

Ground Floor ☒

Second Floor ☒

Note

Comment

Scheduled Closing Date:

Purchaser: Lia A. Grigoras

Property: 151 of Plan -

Telephone Res. / Bus: (905) 760-9595

Project: Pine Valley Forevergreen - Phase 1

Decor Advisor: Yolande Somerville

Model and Elevation: 40.00 B BRIARWOOD

12. Electrical

Hood Fan ☐ White ☐ Stainless ☐ N/A

Above Kitchen Cabinet Light ☐ Yes ☒ No

Below Kitchen Cabinet Light ☒ Yes ☐ No

Standard Appliances ☐

Over The Range Microwave ☐

Chimney Style Fan ☐

Comment

13. Heating and Air Conditioning

Air Conditioning

Gas Provisions Stove

Gas Provisions Dryer

Gas Provisions Barbecue

Comment

14. Additional Comments

15. Disclaimers and Notes

- 1) Colours of all materials are as close as possible to builder's selection, but not necessarily identical due to variances in manufacturing.
- 2) Any extras listed above are null and void unless accompanied by a separate invoice/amendment. Said invoice must be paid in full.
- 3) The Purchaser acknowledges that after Interior Colour Selection form is signed and dated, no further changes will be permitted other than re-selection due to unavailability. _____ Purchaser's Initials
- 4) The Purchaser acknowledges reading and accepting the "Gold Park Homes Decor Centre Disclaimers" form. This document contains other miscellaneous disclaimers.

This Interior Colour Selection is final and approved by:


Signature: L. Grigoras Date: Feb. 8, 2021

PINE VALLEY
THE GREEN

RV-151
Feb 8, 2021

40' SERIES

Elevation A - 2,870 sq.ft.
Elevation B - 2,860 sq.ft.

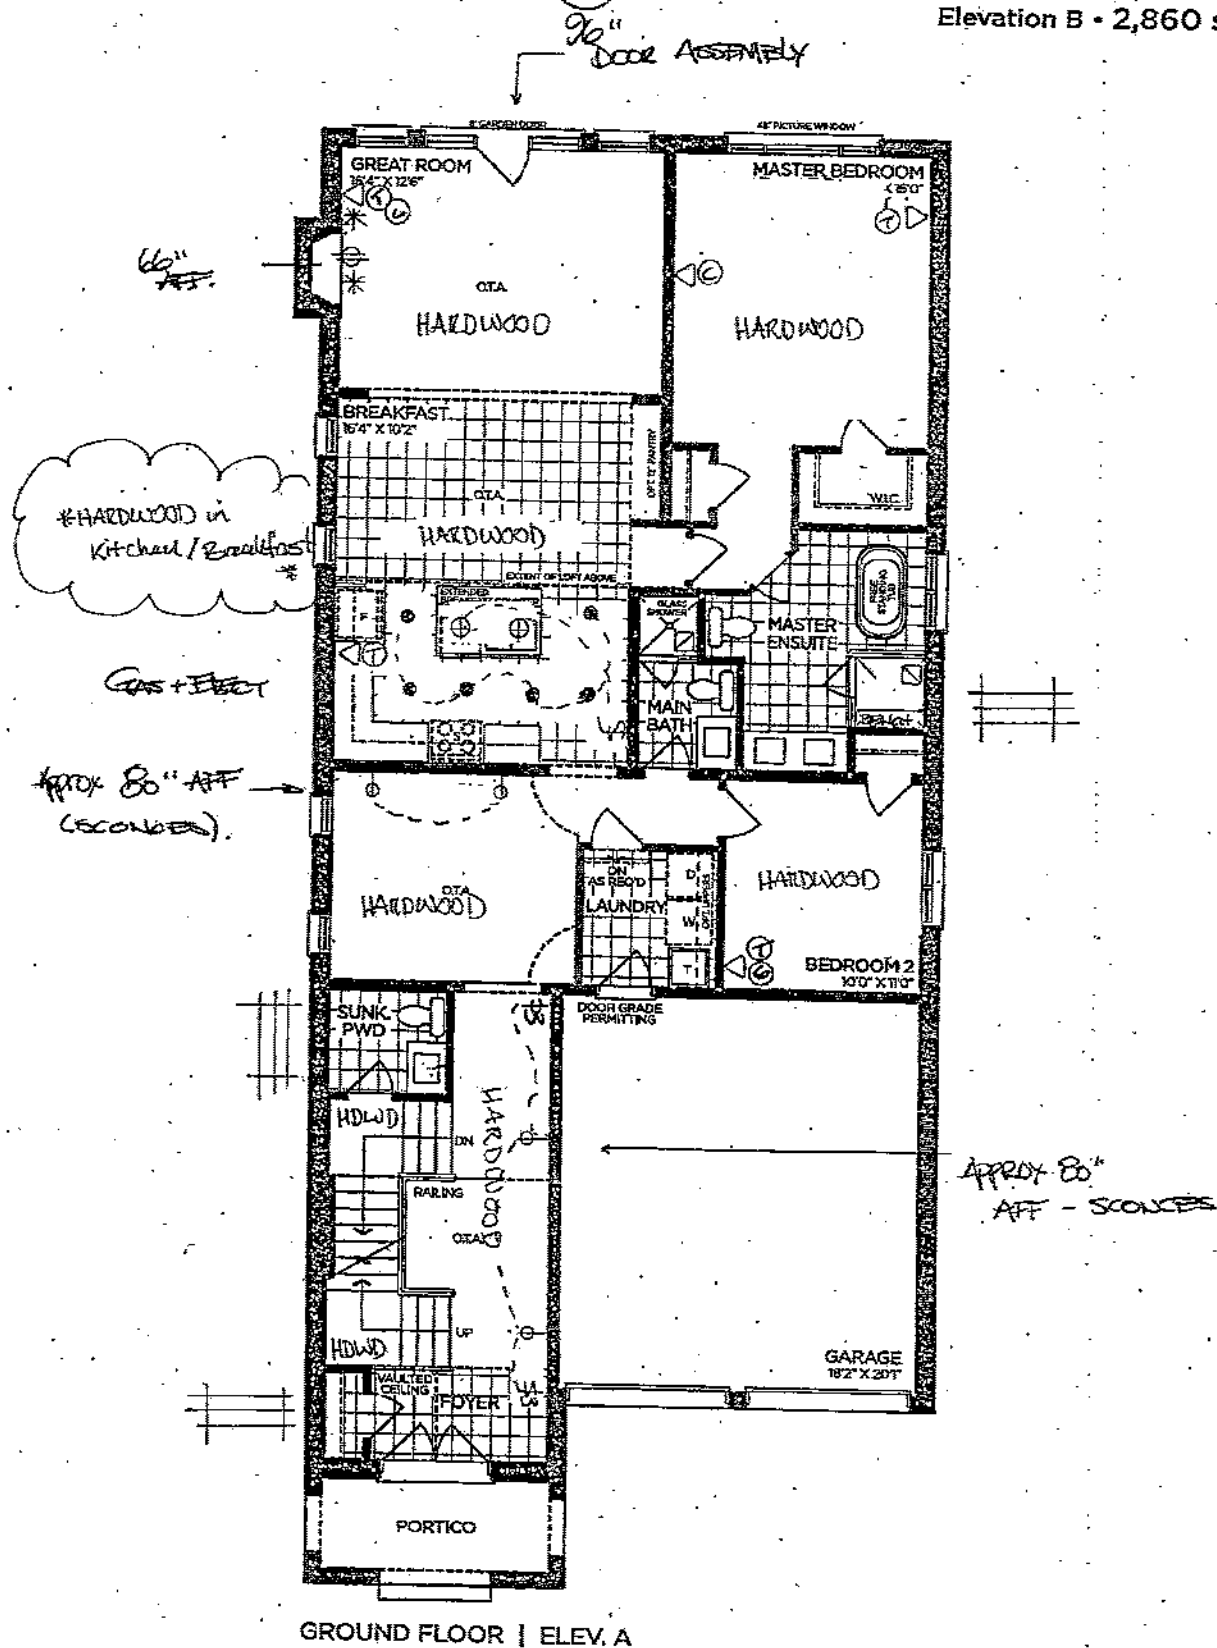

PURCHASER

GOLD PARK
WORTH MORE


Prices, figures, illustrations, sizes, features and finishes are subject to change without notice. Areas and dimensions are approximate and actual useable floor space may vary from the stated area. Layout may be reverse of the unit purchased. E & O 4000

SCHEDULE 'F'




PV-151
August 13, 2020.
PV-151
Feb 8, 2021


The
Briarwood
40' SERIES
Elevation A • 2,870 sq.ft.
Elevation B • 2,860 sq.ft.

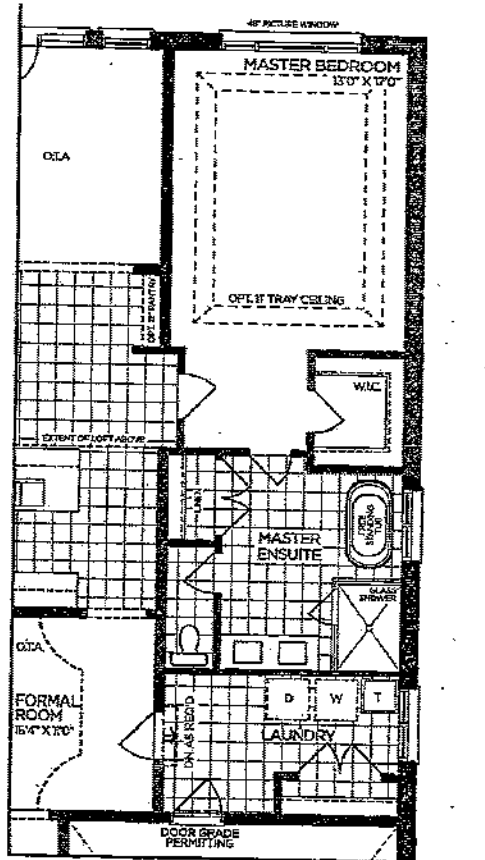


PART. OPT. GROUND FLOOR | ELEV. A
(ELEV. B SIMILAR)

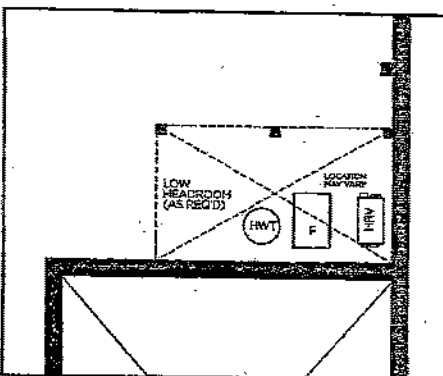

PART. BASEMENT | ELEV. A

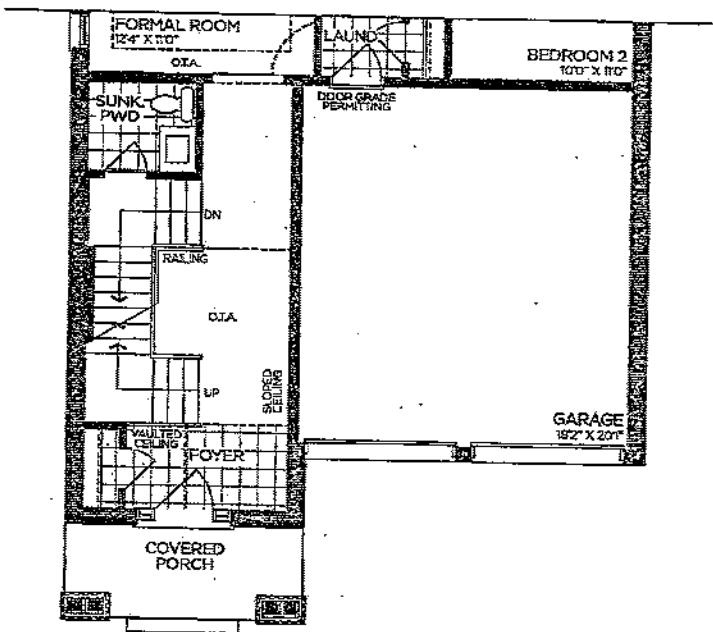

PART. GROUND FLOOR | ELEV. B

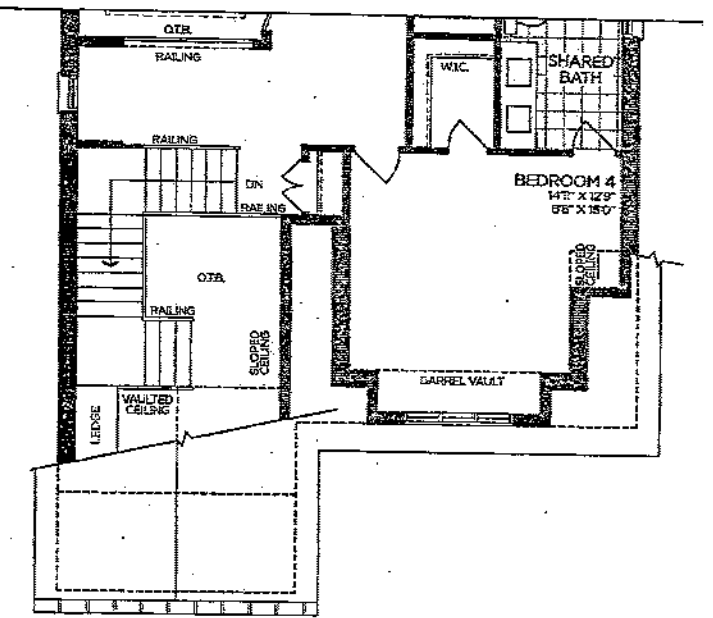

PART. LOFT FLOOR | ELEV. B

VENDOR	
PURCHASER	
PURCHASER	

GOLDPARK
WORTH MORE™


Prices, figures, illustrations, sizes, features and finishes are subject to change without notice. Areas and dimensions are approximate and actual usable floor space may vary from the stated area. Layout may be reverse of the unit purchased. E. & O.E. 4000

2
SCHEDULE 'F'



PV-151
August 13, 2020 *LG*
PV-151
Feb. 8, 2021 *RG*

The
Briarwood
40' SERIES
Elevation A • 2,870 sq.ft.
Elevation B • 2,860 sq.ft.

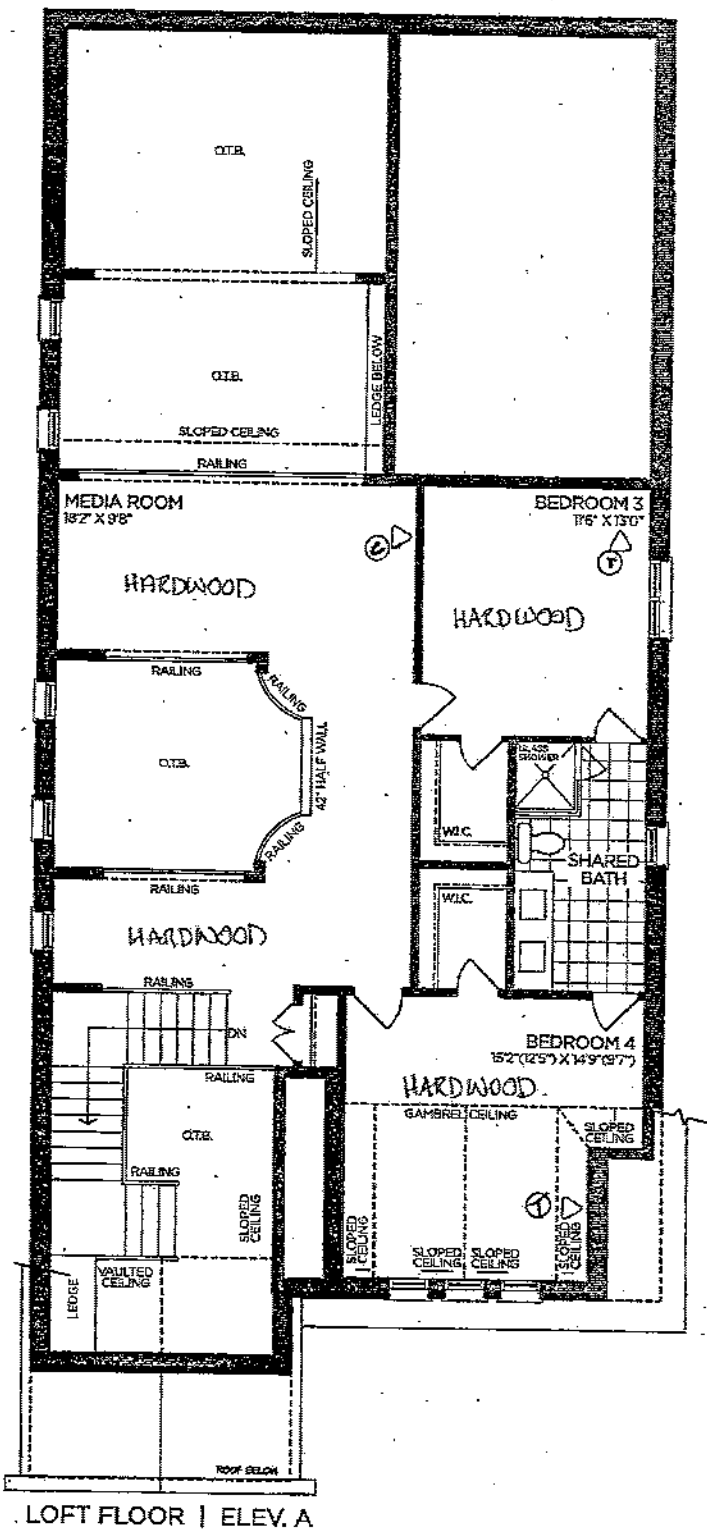

VENDOR

PURCHASER

PURCHASER

GOLDPARK
WORTH MORE™


Prices, figures, illustrations, sizes, features and finishes are subject to change without notice. Areas and dimensions are approximate and actual usable floor space may vary from the stated area. Layout may be reverse of the unit purchased. E. & O.E. 4000

SCHEDULE 'F'



PV-151
August 13, 2020
PV-151
Feb 8, 2021

The
Briarwood
40' SERIES
Elevation A • 2,870 sq.ft.
Elevation B • 2,860 sq.ft.

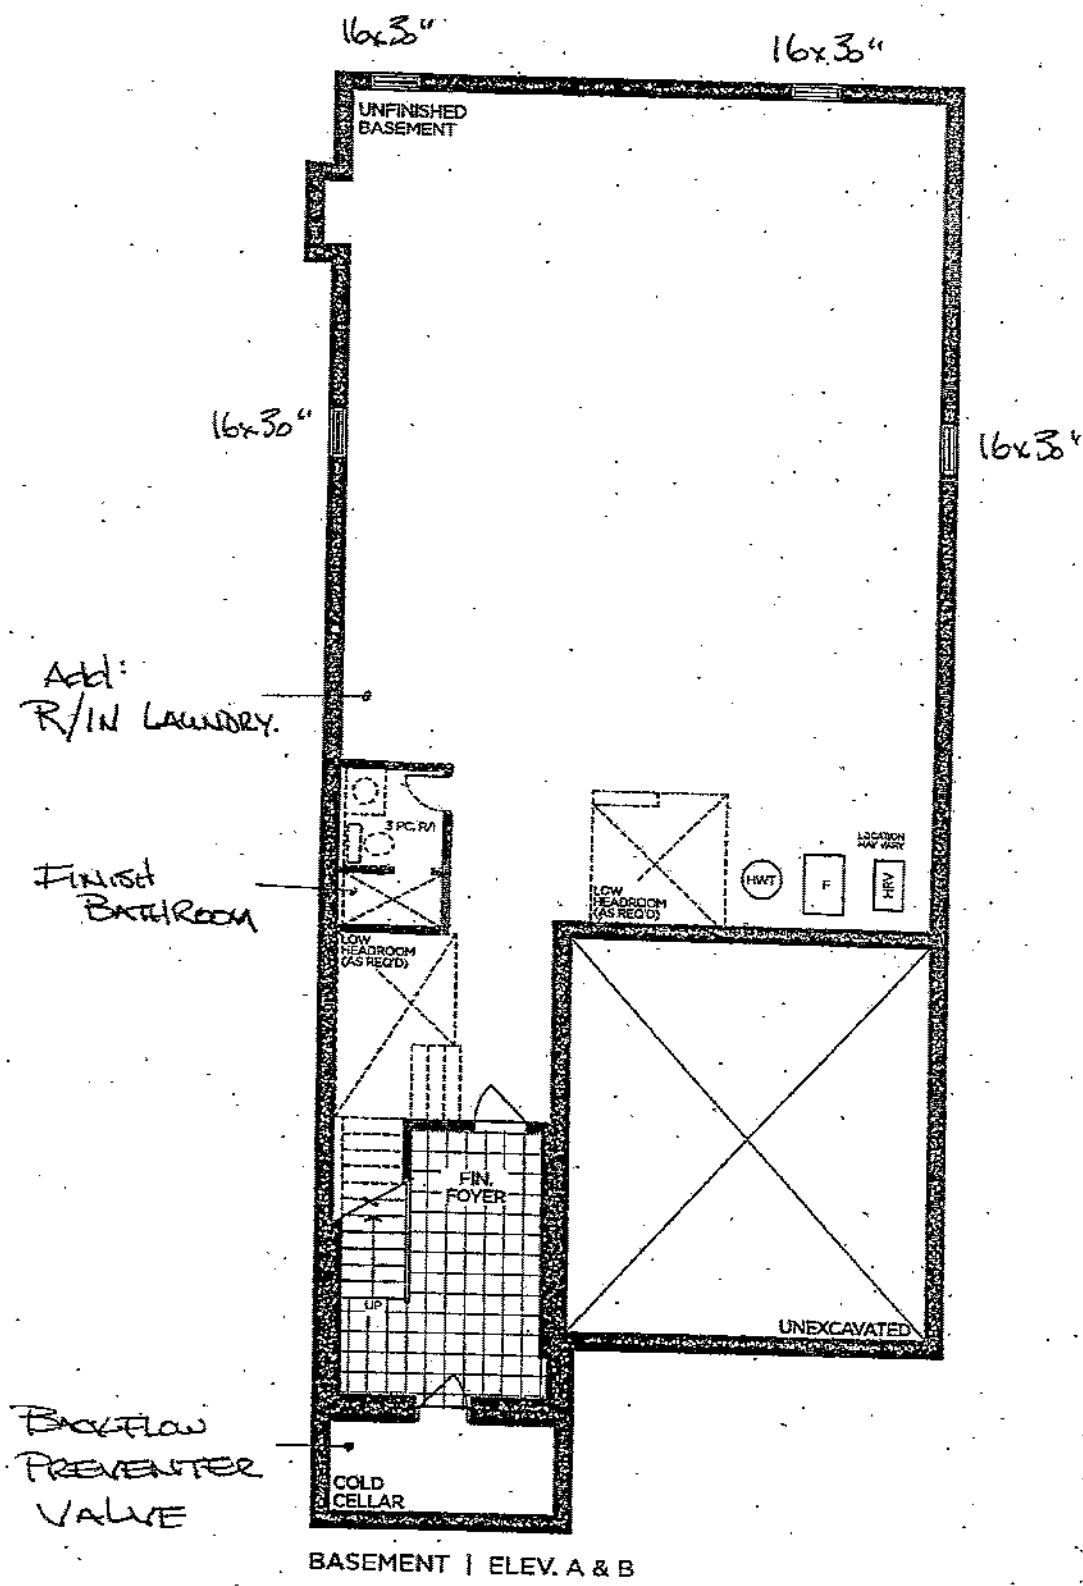

VENDOR

PURCHASER

PURCHASER

GOLDPARK
WORTH MORE™

Prices, figures, illustrations, sizes, features and finishes are subject to change without notice. Areas and dimensions are approximate and actual usable floor space may vary from the stated area. Layout may be reverse of the unit purchased. E. & O.E. 4000

74

TV-151


Feb 8, 2021

**GOLDPARK HOMES
PINE VALLEY
VAUGHAN, ONTARIO
MODEL: (4000) BRIARWOOD**



SITE STANDARD: WHITE 3/4" EXTENSION
SOFT-CLOSE DRAWERS & STANDARD SLAM DOOR HINGES
TO VANITIES

ONE TOP DRAWER WHERE POSSIBLE THROUGHOUT EACH
VANITY, ONE BANK OF DRAWERS WHERE POSSIBLE
THROUGHOUT EACH MASTER ENSUITE VANITY


Vermont Oak 'Cashew'
K002-02

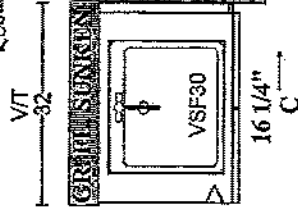


Vermont Oak 'Cashew'
K002-03

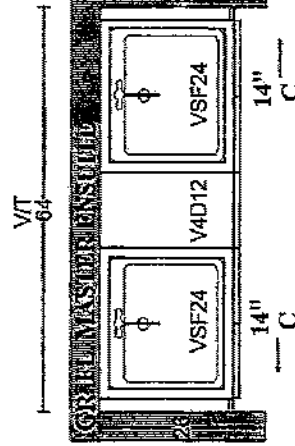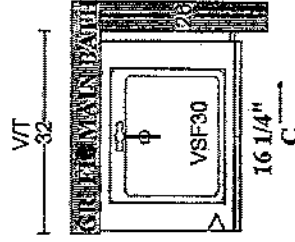

Chesapeake 'Classic White'
K002-07

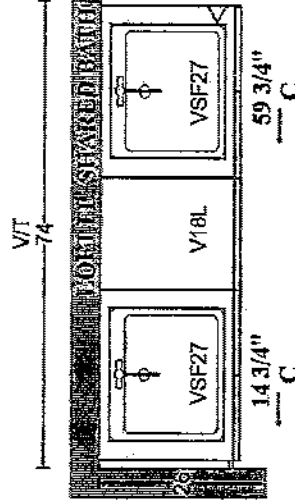

Tribeca 'Amis'
K002-03

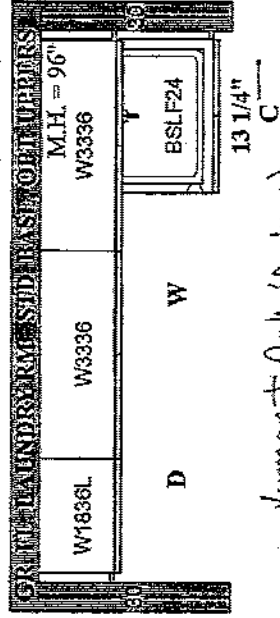

Vermont Oak 'Cashew'
K002-03



PLAN VIEW

STONE COUNTERTOP EDGE PROFILES



STANDARD 2CM EASED EDGE

LOCATION:

THRU-OUT



UPGRADE 3CM EASED EDGE


LOCATION:



UPGRADE 4CM MITRED EDGE



LOCATION:

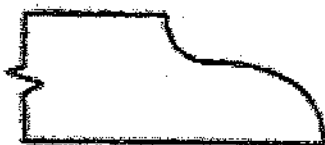

UPGRADE 2CM OGEE EDGE

LOCATION:


LOT #: PV-151

DATE: Feb 8, 2021

SIGNATURE: 

SIGNATURE:

STANDARD HARDWARE / KNOBS

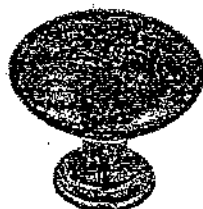

☒ K002-02
 → kitchen
 → Powder Room
 → Master Ensuite



☐ K002-06



☒ K002-03
 → Main Bath
 → Laundry → Shared Ensuite



☐ K002-05



☐ K002-04



☐ K002-14



☐ K024-03

☐ *NO HARDWARE

LOT # PV-151

DATE: Feb 8, 2021

SIGNATURE:

[Signature]


SIGNATURE:

STANDARD SHOWER HARDWARE



SDK106

Shower Door Knob

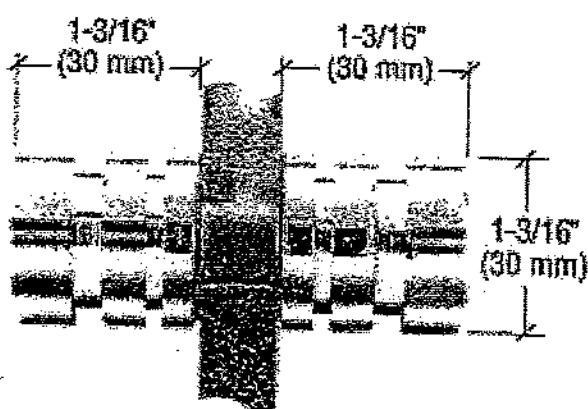

SDK106
Shower Door Knob

1-3/16" dia.
Contemporary Style
(Also available single sided)

CHROME

Lot# PV-151	Date: Feb 8 2021	Room: THER OUT EXCEPT MASTER EN'S.
Signature: L. Briggs		
Signature:		




PINE VALLEY
FOREVERGREEN

UPGRADE SHOWER HARDWARE

MT6X6

Shower Door Handle

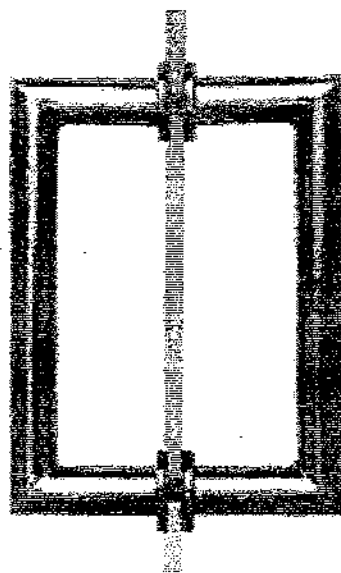

MT6X6
Shower Door Handle


6" x 6" back-to-back
3/4" dia. tube
Cut and mitred corners with
washers
(Also available single sided)

- ☒ CHROME
☐ MATTE BLACK
☐ BRUSHED GOLD


Lot# PV-151	Date: Feb 8, 2021	Room: MASTER EN SUITE
Signature: 		
Signature:		

GOLDPARK
WORTH MORE

BATHROOM ACCESSORIES

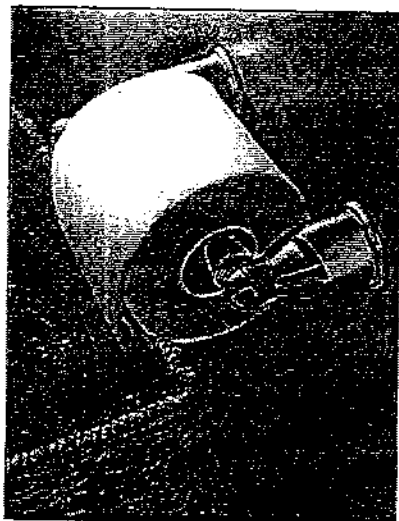

Tissue Holder
Mason - Chrome

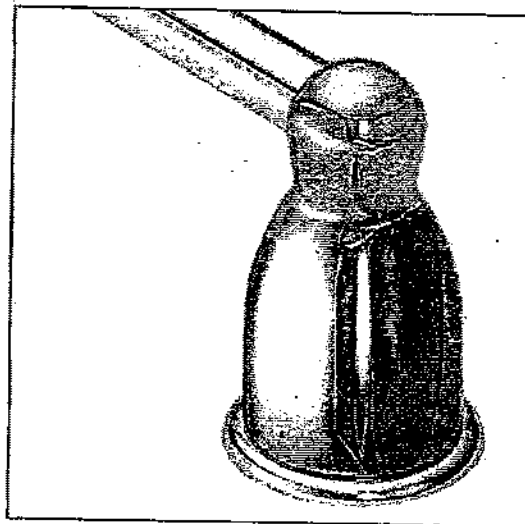

Towel Bar
Mason - Chrome

Please select one of the following:

☒ **INSTALL STANDARD BATHROOM ACCESSORIES THRU OUT**
(tissue holder + towel bar) **location as per vendors discretion**

☐ ***DO NOT* INSTALL STANDARD BATHROOM ACCESSORIES**
THRU OUT **tissue holder + towel bar will not be provided**

LOT # PV-151

DATE: Feb 8 2021

SIGNATURE:

Lg

SIGNATURE:



Project: Pine Valley

Lot: 151

Purchaser(s): Lia A. Grigoras

Standard Hood Fan Deletion

We acknowledge that the builder's standard hood fan will not be installed.
Do not supply, install and/or credit. We will install our own hood fan after closing.

Signature: 

Signature: _____

Date: Feb 8, 2021

Lia G. lot # 151 Pine Heights

GOEMANS APPLIANCES

Expect More. Get More.

APPLIANCE SPECIFICATIONS



PROJECT PARTNER:
Bill To: 4163567860

SHIP TO:
Ship To: 4163567860

GRIGORAS, LIA
LOT 151 PINEHEIGHTS
WOODBIDGE, ON L4L 2A2

REMINDER:

To ensure a smooth project it is the responsibility of the homeowner / purchaser of appliances to share all the attached specifications with their cabinet provider, contractor, or any other tradesperson so they have the information required to complete their work accurately. Product specifications are for planning purposes only and are subject to change without notice. Refer to installation instructions shipped with the product before cutting cabinets, counters, panels, etc.

Goemans Appliances assumes no liability for product specifications.

Full Spec Package

Ship To: 4163567860

Bill To: 4163567860

GRIGORAS, LIA
LOT 151 PINEHEIGHTS
WOODBIDGE, ON L4L 2A2



Goemans Appliances
goemans.com

Nick Georgakopoulos
9052641771

Document V000020151
Version 1.1

Sat, Aug 15, 2020
1:52 PM EDT



steelcod.com/sp/goem/YK39UGU7

PNE25NSLKSS	3-4
GE Refrigeration	
JCGS760SELSS	5-6
GE Range	
WM3500CW	7-8
LG Washer	
DLE3500W	9-11
LG Dryer	
AK1200BS	12-13
Zephyr Ventilation	
GBT632SSMSS	14-15
GE Dishwasher	

Note about page numbers:
Because the original manufacturer's documents are not altered in any way, the page numbers displayed on the page may not correspond to the page number within this package.

All specifications are intended for initial planning purposes only. Manufacturers reserve the right to change specifications at any time without notice. Always consult the installation instructions found on the manufacturer's website or included with the appliances before installation.


PNE25NSLKSS



GE APPLIANCES

24.5 CU.FT. FRENCH DOOR BOTTOM-MOUNT,
W/FACTORY INSTALLED ICEMAKER

www.geappliances.ca

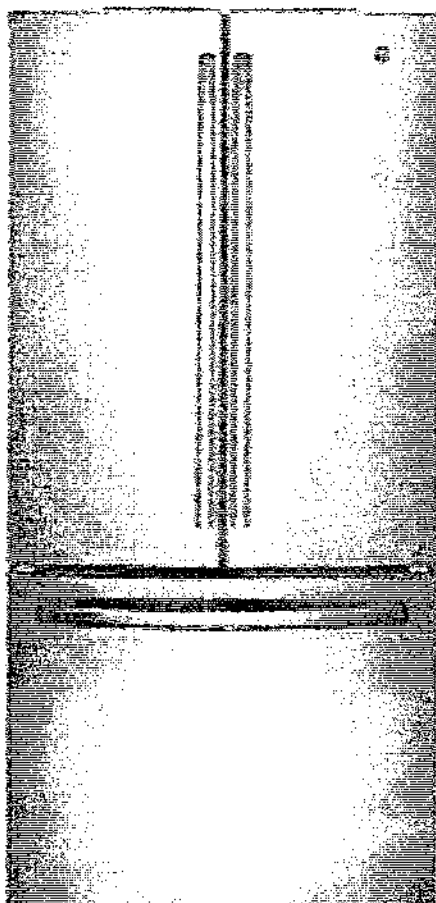

Color Stainless Steel

Cabinet Integrated Controls	Yes
Crisper Cover	Glass
Defrost Type	Frost Free
Digital Temperature Readout	Yes
Door Alarm	Yes
Electronic Sensors	Yes
Freezer Configuration	Slide Out Drawer
Fresh Food Door Bins	6 Adjustable Gallon
Fresh Food Shelves	4 Split
FrostGuard	Yes
Full Case LED Lighting	Yes
Humidity Sensor	Yes
Ice Storage Bin	Ice Bucket
Interior Light	LED
Internal Water Dispenser	Yes
Multiflow Air System	Yes
Ramp Up LED Lighting	Full Case
Storage Basket	2 Plastic
Temperature Sensor	4
Total Number of Shelves	4 Split, Spillproof
TurboCool Setting	Yes
Vegetable / Fruit Crisper(s)	2 Adj. Humidity
Freezer (cubic feet)	7.3
Fresh Food (cubic feet)	17.5
Total (cubic feet)	24.8

Dimensions

Height to Top of Case	68-5/8"
Overall Height	69-7/8"
Overall Depth (without door)	37 1/4" (30")
Overall Width	32-3/4"


Product dimension, cutout and installation specifications are provided for planning purposes only. Before installing any product, be sure to verify cutout dimensions and electrical/gas connections with the installation

* Registered trademark/™ Trademark of GE Appliances a HAIER company. © MC Commercial Inc. All Rights Reserved.

All other trademarks are owned by their respective companies.

Because GE Appliances policy includes a continuous commitment to improve our products, we reserve the right to change materials and specifications without notice. We also reserve the right to discontinue or transition products without notice.

APPLIANCE DIMENSIONS

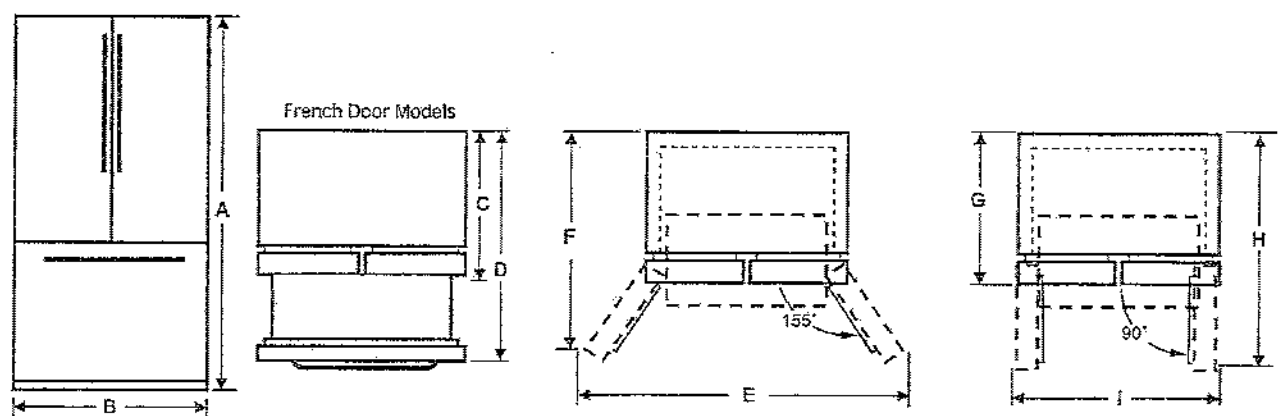

ITEM	24/25 cuft models with french doors
A*	69-7/8"
B	33"
C**	37-1/8"
D**	54-3/4"
E	60-1/2"
F	38-3/4"
G	35-3/8"
H	48-3/8"
I**	40-1/2"

NOTE:
* The height of the refrigerator to the top of the door.
** Includes the handle.

**MEASURE THE CABINET OPENING
ACCORDING TO THE WIDTH OF THE
REFRIGERATOR**

Measure width of cabinet opening where refrigerator will be placed, *B*.

Be sure to account for any countertop overhang, baseboard thickness and any clearance desired. Width, *B*, should not be less than 30"-33" (depending on model). The refrigerator will be placed approximately in the middle of this opening.

The diagram shows a top-down view of the cabinet opening. A dashed rectangle represents the opening. The width of the opening is labeled *B*. To the left of the opening is the 'Back Wall'. To the right is the 'Right Side'. Below the opening is the 'REFRIGERATOR' with its 'Front' edge. A note on the right indicates: 'Baseboard Thickness or Countertop Overhang (Whichever Is Larger) Plus Any Desired Clearance'.

REFRIGERATOR LOCATION

- Do not install the refrigerator where the temperature will go below 60°F (16°C) because it will not run often enough to maintain proper temperatures.
- Do not install the refrigerator where the temperature will go above 100°F (37°C) because it will not perform properly.
- Do not install the refrigerator in a location exposed to water (rain, etc.) or direct sunlight.
- Install it on a floor strong enough to support it fully loaded.

CLEARANCES

Allow the following clearances for ease of installation, proper air circulation and plumbing and electrical connections.

Sides	" (3 mm)
Top	" (25 mm) Cabinet/Hinge Cover
Back	" (50 mm)


JCGS760SELSS



GE APPLIANCES

SLIDE-IN FRONT CONTROL, 5.6 CU. FT.
SELF-CLEANING CONVECTION GAS RANGE

www.geappliances.ca

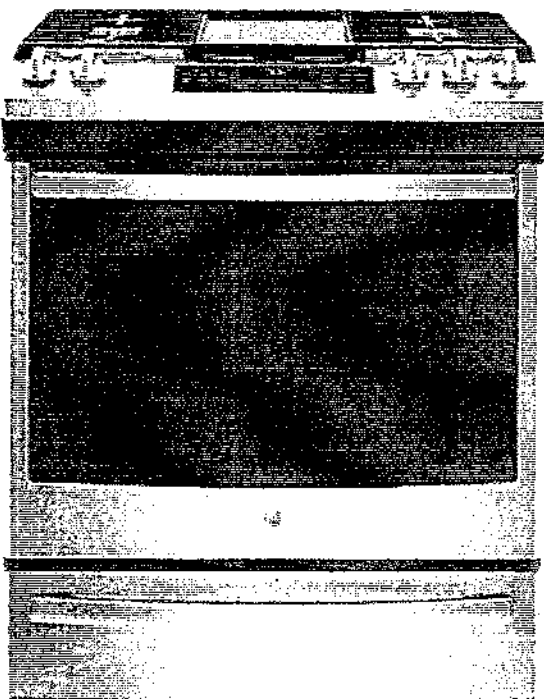

Color Stainless Steel

Dimensions

Overall Depth (in.)	29.3
Overall Height (in.)	37.2
Overall Width (in.)	29.9

Bake	16,000 BTU
Broil	16,500 BTU
Burner - Centre Oval	10,000 BTU
Burner - Left Front	18,000 BTU
Burner - Left Rear	5,000 BTU Precise Simmer
Burner - Right Front	15,000 BTU
Burner - Right Rear	9,500 BTU
Burner Type	Sealed
Control Location	Front Center
Control Type	Electronic Touch
Convection Cooking	Yes
Conversion Kit	Yes, Included - Nat. Gas to LP
Cooktop Grate/Burner Cap Colour	Matte (Dull) Black
Cooktop Grates	Cast-Iron, Porcelainized
Drawer System, Bake/Warm/Storage	Storage
Fan Convection	Yes
Fuel Type	Gas
Griddle	Integrated Non-Stick
Ignition System	Electronic
Oven Cavity Colour	Black
Oven Interior Light	Automatic
Oven Rack Positions	6
Oven Racks	3 Chrome
Oven Type / Cleaning	Self-Clean / Steam Clean
Valves (Degree of Turn)	270

Product dimension, cutout and installation specifications are provided for planning purposes only. Before installing any product, be sure to verify cutout dimensions and electrical/gas connections with the installation

* Registered trademark/TM Trademark of GE Appliances a HAIER company. © MC Commercial Inc. All Rights Reserved.
All other trademarks are owned by their respective companies.
Because GE Appliances policy includes a continuous commitment to improve our products, we reserve the right to change materials and specifications without notice. We also reserve the right to discontinue or transition products without notice.

DIMENSIONS AND CLEARANCES


Provide adequate clearances between the range and adjacent combustible surfaces. These dimensions must be met for safe use of your range.

Allow 30" (76.2 cm) minimum clearance between burners and bottom of unprotected wood or metal cabinet, or allow a 24" (61 cm) minimum when bottom of wood or metal cabinet is protected by no less than 1/4" (6.4 mm) thick


flame-retardant millboard covered with no less than No. 28 MSG sheet metal (.015" [.38 mm] thick), .015" (.38 mm) thick stainless steel, .025" (.64 mm) aluminum or .020" (.5 mm) copper.

Installation of a listed microwave oven or cooking appliance over the cooktop shall conform to the installation instructions packed with that appliance.

For island installation, maintain 2-1/2" minimum from cutout to back edge of countertop and 3" minimum from cutout to side edges of countertop.

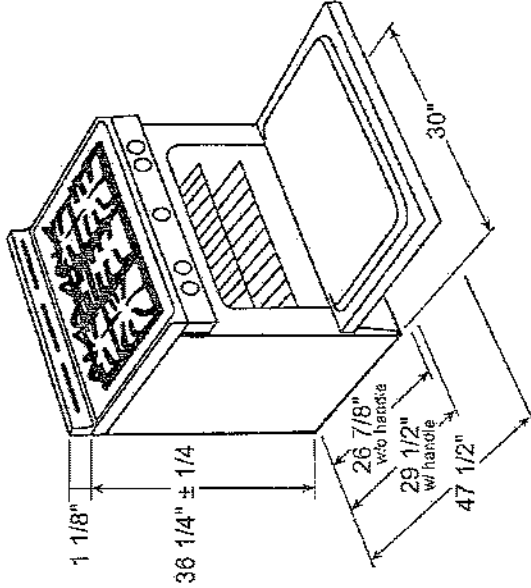


For all installations, install the required rear trim to back of range with 4 screws provided.

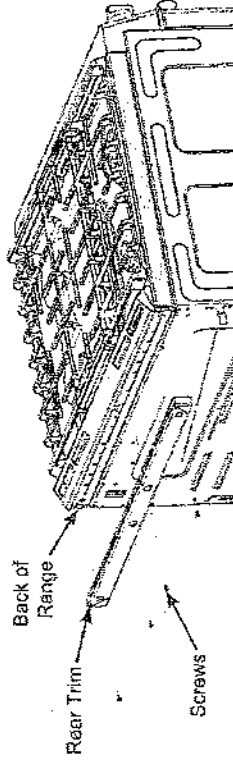

DIMENSIONS AND CLEARANCES (CONT.)

GAS PIPE AND ELECTRICAL OUTLET LOCATIONS

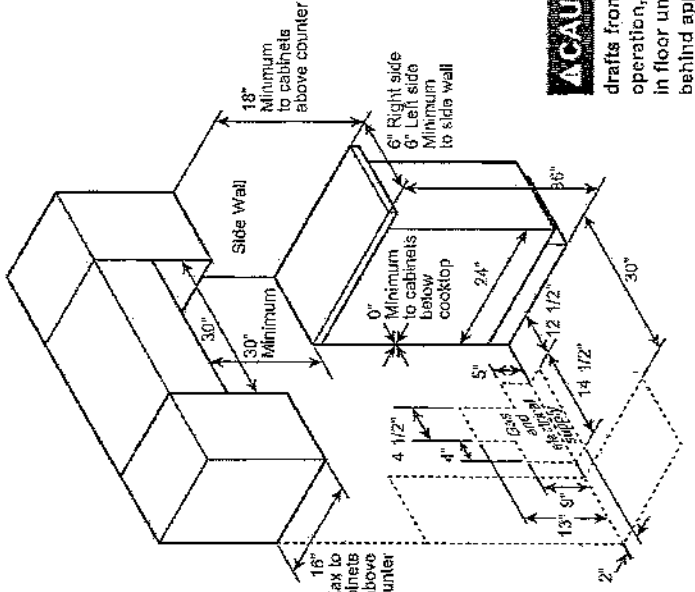

CAUTION


To prevent drafts from affecting burner operation, seal all openings in floor under appliance and behind appliance wall.

CONVERTING TO PROPANE GAS (OR CONVERTING BACK TO NATURAL GAS FROM PROPANE)

This range leaves the factory set for use with natural gas. If you want to convert to propane gas, the conversion must be performed by a qualified propane gas installer.

The conversion orifices and instructions can be found on back of the range. Keep these instructions and all orifices in case you want to convert back to natural gas.

Rear of Range

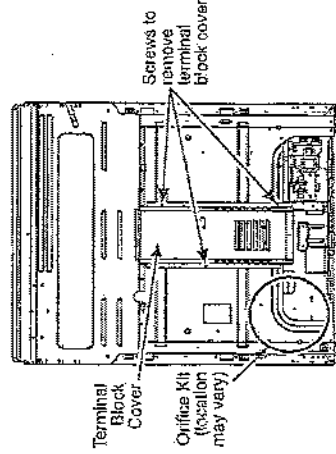

INSTALLATION AT HIGH ALTITUDE

Over 6000ft, product configured for natural gas or propane requires installation of kit (WB2BX28254 for natural gas and WB2BX29255 for propane gas). Follow the instructions included with the kit.


HOME APPLIANCES

LG LAUNDRY

WM3500CW

4.5 cu. ft. Front Load Washer

- 4.5 Cu.Ft. Capacity
- 10 Wash Programs
- 6Motion™ Technology
- Inverter Direct Drive Motor with 10-Year Warranty
- TWINWash™ Compatibility
- SmartThinQ® (Wi-Fi Enabled)
- SmartDiagnosis™
- ColdWash™ Option
- ENERGY STAR® Most Efficient 2019
- NeverRust™ Stainless Steel Drum
- Available in White (W)

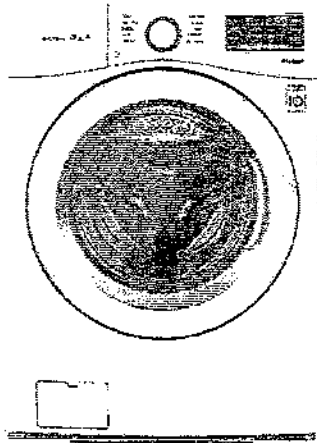

Enjoy new ways to control your home with LG smart appliances

- Start the laundry while you're out shopping
- Get alerts when the cycle is finished
- Works with the LG SmartThinQ® app

SmartThinQ®

WORKS WITH Google Assistant

WORKS WITH Alexa

SUMMARY

Capacity (cu.ft.)	4.5 cu. Ft.
Matching Electric Dryer	DLE3500W
Matching Gas Dryer	DLG3501W
Color	White (W)
APPEARANCE	
Hard Buttons	Yes
Touch Buttons	Yes
DiA-Cycle™	Yes
ENERGY	
ENERGY STAR®	Yes
Most Efficient 2019	Yes
ENERGY STAR® Qualified	Yes
CEE Tier	2
MEF	2.92
IWF	2.3
WASH PROGRAMS	
No. of Programs	10
	Normal, Perm. Press, Heavy Duty, Delicates, Towels, Speed Wash, Bedding, Tub Clean, Whites, Downloaded
WASH OPTIONS	
No. of Options	10
	Fresh Care, Prewash, Remote Start, Delay Wash, Wi-Fi, Add Garments, ColdWash, Extra Rinse, Rinse+Spin, Child Lock
WASH DETAILS	
No. of Wash/Rinse Temps	3
Wash/Rinse Temps	Hot, Warm, Cold
No. of Spin Speeds	3
Spin Speeds	High, Medium, Low
Max RPMs	1300
Water Levels	Load Sensing
No. of Soil Levels	3

FABRIC CARE FEATURES

ColdWash™ Option	Yes
SensaClean™ System	Yes
CONVENIENCE FEATURES	
TrueBalance™ Anti-Vibration System	Yes
4 Tray Dispenser	Prewash, Main Wash (with liquid detergent cup), Bleach, Fabric Softener
LoDecibel™ Quiet Operation	Yes
End of Cycle Signal	Yes
LoadSense	Yes
Child Lock	Yes
Auto Suds Removal	Yes
Leveling Legs	4 Adjustable Legs
Easy Loading Tilt™	Yes
SMARTTHINQ® TECHNOLOGY	
SmartDiagnosis™ (v3.0)	Yes
Wi-Fi	Yes
Cycle Monitoring and Notification	Yes
Energy Monitoring	Yes
MOTOR	
Motor Type	Inverter Direct Drive Motor
Axis	Horizontal
MATERIALS AND FINISHES	
NeverRust™ Stainless Steel Drum	Yes
Cabinet	PCM
Control Panel	Plastic
Top Plate	Painted
Door / Rim	Gloss/Silver Spray
Door Cover	Clear Round Cover
All Available Colors	White (W)

POWER SOURCE

Ratings	UL Listed
Electrical Requirements	120V, 10 Amps
Type	Electric
OPTIONS/ACCESSORIES	
Pedestal	WDP4W
Pedestal (WxHxD)	27 x 14 1/8 x 30 3/4 (50 5/16 D with door open)
LG SideKick™ Pedestal Washer	WD100CW
LG SideKick™ Pedestal Washer (WxHxD)	27 x 14 1/8 x 30 3/4 (50 9/16 D with door open)
Stacking Kit	KSTKT
DIMENSIONS	
Product (WxHxD)	27" x 39" x 30 1/4"
Depth with Door Open	(55" D with door open)
Carton (WxHxD)	29 23/32" x 41 27/32" x 31 17/32"
Weight (Product/Carton)	169.2 / 218.2 lbs.
LIMITED WARRANTY	
Parts and Labor	1 Year
Direct Drive Motor	10 Years
Drum	Limited Lifetime
UPC CODES	
WM3500CW (Washer White)	048231024990
DLE3500W (Electric Dryer White)	048231024983
DLG3501W (Gas Dryer White)	048231025003
WD100CW (LG SideKick™ White)	048231015172

WM3500CW

4.5 cu. ft. Front Load Washer

QUICK INSTALL & CLEARANCES

For full installation directions/clearances please refer to the corresponding User Manual and Installation Guide.

DIMENSIONS

A Width 27"

B Height 39"

C Depth 30 1/4"

D Depth with Door Open 55"

Carton (WxHxD) 29 23/32" x 41 27/32" x 37 17/32"


POWER SOURCE

Ratings UL Listed

Electrical Requirements 120V, 10 Amperes

Type Electric


DIMENSIONS AND CLEARANCES

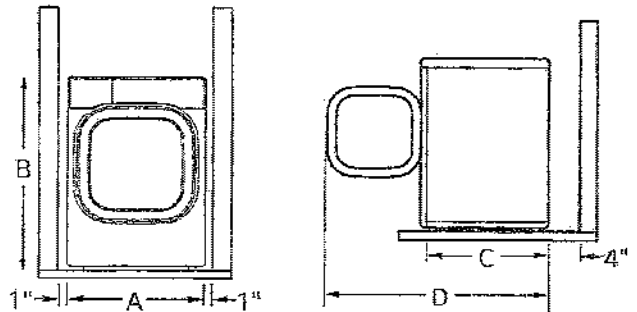

- Install the washing machine on a solid floor that is strong and rigid enough to support the weight of the washing machine, even when fully loaded, without flexing or bouncing. If the floor has too much flex, you may need to reinforce it to make it more rigid. If the floor is not solid, it may cause severe vibration and noise.

CONNECTING THE WATER LINES

- LG recommends the use of LG hoses. Any leaking, property damage, or damage to the washing machine caused by an improper installation or by the use of non-LG hoses is not covered under the terms of the LG warranty and is the sole responsibility of the customer and/or an installer.
- Water supply pressure must be between 20 psi and 120 psi (1.38-8.27 kPa). If the water supply pressure is more than 120 psi, a pressure-reducing valve must be installed.
- Inspect the threaded fitting on each hose and make sure there is a rubber seal in place in both ends of each hose.
- Connect the water supply hoses to the HOT and COLD water faucets tightly by hand and then tighten another 2/3 turn with pliers.
- Always run a gallon or two of water through each inlet hose to flush dirt, scale and other debris out of the water lines. Doing so will help prevent future problems with clogged filter screens, and will also allow you to verify which water line is hot and which is cold.
- Attach the hot water line to the hot water inlet on the back of the washer. Attach the cold water line to the cold water inlet on the back of the washer. Tighten the fittings securely. Turn ON both faucets all the way and check for leaks at both ends of the hoses.

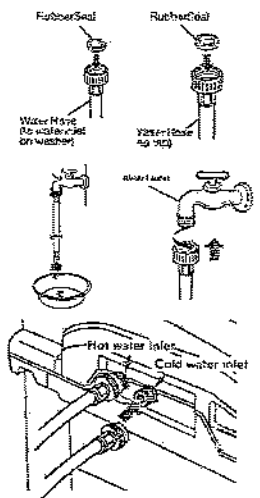


ELECTRICAL REQUIREMENTS

- The washer should be plugged into a 120-VAC, 60-Hz grounded 3-prong outlet. Plug in the washer. Improper connection of the equipment-grounding conductor can result in risk of electric shock. Check with a qualified electrician or service technician if you are in doubt as to whether the appliance is properly grounded. Do not modify the plug provided with the appliance. If it does not fit the outlet, have a proper outlet installed by a qualified electrician. Failure to follow these warnings can cause serious injury, fire, electrical shock, or death.
- The power outlet must be within 60 inches (1.5 m) of either side of the washer.
- The appliance and outlet must be positioned so that the plug is easily accessible.
- Do not overload the outlet with more than one appliance.
- The outlet must be grounded in accordance with current wiring codes and regulations.
- Time-delay fuse or circuit breaker is recommended.
- It is the personal responsibility and obligation of the product owner to have a proper outlet installed by a qualified electrician.



CONNECTING THE DRAIN HOSE

- The drain hose should always be properly secured. Failure to properly secure the drain hose can result in flooding and property damage.
- The drain must be installed in accordance with any applicable local codes and regulations.
- Make sure that the drain hose is not stretched, pinched, crushed, or kinked.
- Normal height of the end of the hose should be approximately 35"-47" (0.9-1.2 m) from the floor.
- Do not install the end of the drain hose lower than 29 in. (73.7 cm) or higher than 96 in. (243.8 cm) above the bottom of the washer or more than 60 in. (152.4 cm) away from the washer.
- Never create an airtight seal between the hose and the drain with tape or other means. If an air gap is present, water can be siphoned out of the tub resulting in poor wash/rinse performance or clothing damage.

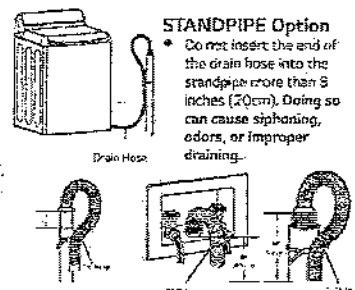

LAUNDRY TUB Option

- Do not use this drain hose with a floor drain. The end of the drain hose must be at least 29 inches above the floor for proper draining to occur.

HOME APPLIANCES


DLE3500W/DLG3501W

7.4 cu. ft. Front Load Dryer

- 7.4 cu. ft. Capacity
- 10 Dryer Programs
- Sensor Dry
- ENERGY STAR® Qualified
- SmartThinQ® Technology
- Wi-Fi Connectivity
- SmartDiagnosis™

Enjoy new ways to control your home with LG smart appliances


- Start the laundry while you're out shopping
- Get alerts when the cycle is finished
- Works with the LG SmartThinQ® app

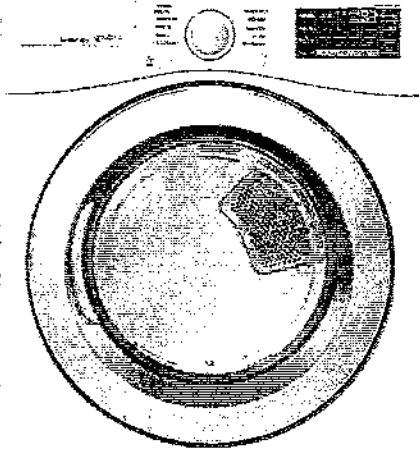

SUMMARY		CONVENIENCE FEATURES		POWER SOURCE	
Capacity	7.4 cu. ft.	3 Minute Installation Check	Yes	Ratings	CSA Listed
Matching Washer	WM3500CW	LoDecibel™ Quiet Operation	Yes	Electrical Requirements	Gas: 120V, 15 Amps Electric: 240V 30 Amps
Sensor Dry	Yes	End of Cycle Signal	Yes	Type	Electric (DLE3500W) Gas (DLG3501W)
Colors	White (W)	Reversible Door	Yes	BTU Rating	10,000 Feet
APPEARANCE		FlowSense™ Duct Clogging Indicator	Yes	OPTIONS/ACCESSORIES	
Intelligent Electronic Controls with LED Display	Yes	Wrinkle Care Option	Yes	LP Conversion Kit	363EEL30020
Dual-A-Cycle™	Yes	Child Lock	Yes	Side Venting Kit	363EEL90015
Touch Buttons	Yes	Venting Option	Gas: 3 Way Venting Electric: 4 Way Venting	Pedestal	WDP4W
DRYER PROGRAMS		4 Adjustable Legs	Yes	Pedestal (WxHxD)	27 x 14 1/8 x 30 3/4 (50 1/2 D with door open)
No. of Programs	10	Remaining Time Display/Status Indicator(s)	Yes	DIMENSIONS	
	Normal, Heavy Duty, Bedding, Towels, Small Load, Perm Press, Delicates, Speed Dry (Manual Dry), Air Dry (Manual Dry), Downloaded	SMARTTHINQ® TECHNOLOGY		Product (WxHxD)	27" x 38 11/16" x 30"
DRYER OPTIONS		SmartDiagnosis™	Yes	Depth with Door Open	51"
No. of Options	11	Wi-Fi	Yes	Carton (WxHxD)	29 13/32" x 43 5/8" x 31 3/8"
	More Time, Less Time, Damp Dry Signal, Wrinkle Care, Control Lock, Custom Program, PGM Save, Wi-Fi Connect, Anti-Bacterial, Energy Saver, Remote Start	Remote Control	Yes	Weight (Product)	Gas: 124.7 Electric: 122
Temperature Settings	High, Medium, Ultra Low	Cycle Monitoring and Notification	Yes	Weight Carton	Gas: 137.9 Electric: 135.2
Drying Levels	Very Dry, Normal Dry, Damp Dry	Energy Monitoring	Yes (Wi-Fi)	WARRANTY	
Annual Dry Times	60 min., 40 min., 20 min., More Time/Less Time	ENERGY		Parts and Labor	1 Year
FABRIC CARE FEATURES		ENERGY STAR® Qualified	Yes	UPC CODES	
Sensor Dry	Yes	MATERIALS AND FINISHES		DLE3500W (Electric Dryer White)	048231024953
Precise Temperature Control with Variable Heater	Yes	Aluminized Alloy Steel Drum	Yes	DLG3501W (Gas Dryer White)	048231025003
		Tub Rear	Painted	WM3500CW (Washer White)	048231024990
		Cabinet	Painted Steel	WDP4W (Pedestal White)	048231011211
		Door	Round w/ silver painted trim		
		All Available Colors	White (W)		

© 2015 LG Electronics USA, Inc. All rights reserved. "LG Life's Good" is a registered trademark of LG Corp. All other product and brand names are trademarks or registered trademarks of their respective owners. Design, features and specifications are subject to change without notice. Non-metric weights and measurements are approximate. Some features may require internet access. Content and services may vary by product and are subject to change without notice. 9/16/15

Clearances

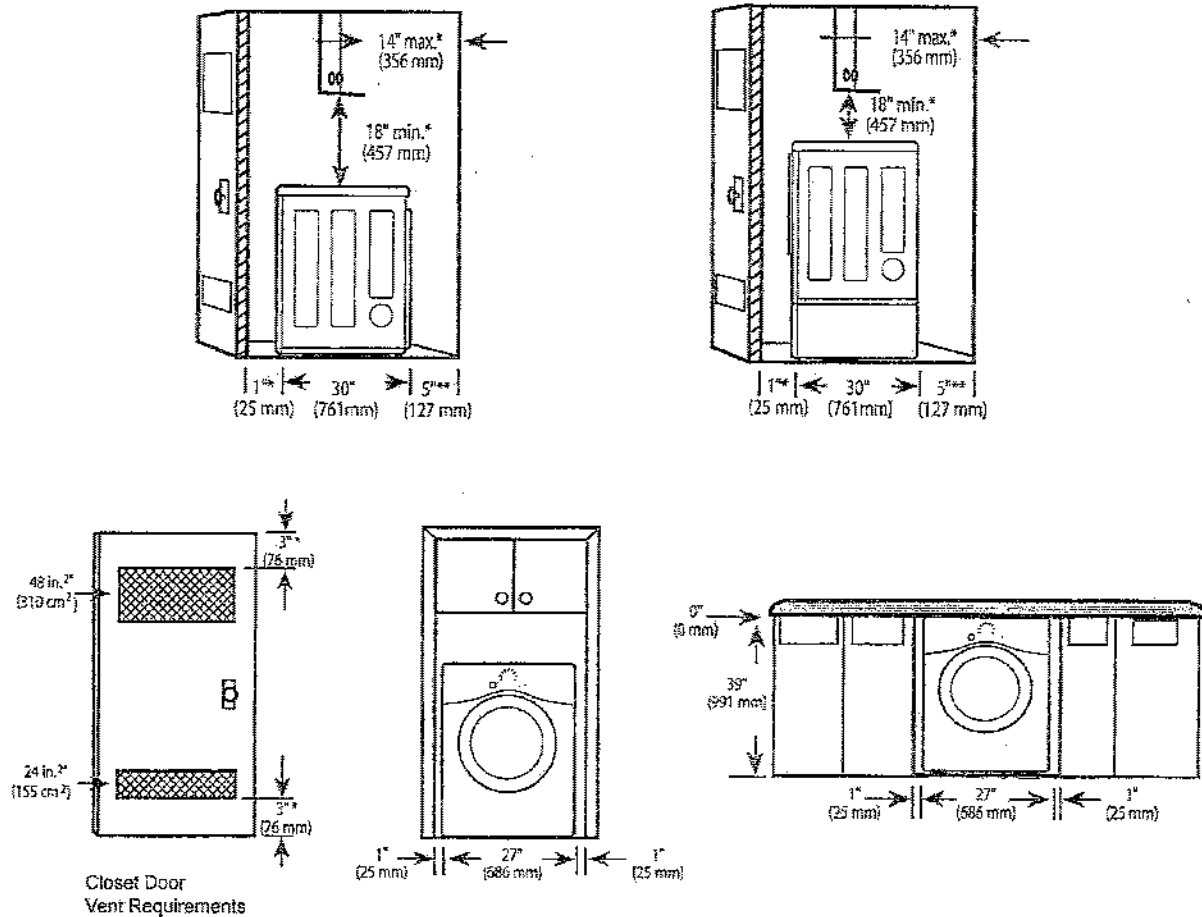

Installation Spacing for Recessed Area or Closet Installation

The following clearances are recommended for this dryer. This dryer has been tested for clearances of 1 inch (2.5 cm) on the sides and rear. Recommended clearances should be considered for the following reasons:

- Additional clearances should be considered for ease of installation and servicing.
- Additional clearances should be considered on all sides of the dryer to reduce noise transfer. For closet installation, with a door, minimum ventilation openings in the top and bottom of the door are required. Louvered doors with equivalent ventilation openings are acceptable.


Closet Ventilation Requirements

Closets with doors must have both an upper and lower vent to prevent heat and moisture buildup in the closet. One upper vent opening with a minimum opening of 48 sq. in. (310 cm²) must be installed no lower than 6 feet above the floor. One lower vent opening with a minimum opening of 24 sq. in. (155 cm²) must be installed no more than one foot above the floor. Install vent grills in the door or cut down the door at the top and bottom to form openings. Louvered doors with equivalent ventilation openings are also acceptable.

NOTE

- There should be at least a little space around the dryer (or any other appliance) to eliminate the transfer of vibration from one appliance to another. If there is enough vibration, it could cause appliances to make noise or come into contact, causing paint damage and further increasing noise.

Installation Spacing for Recessed Area or Closet, with Stacked Washer and Dryer

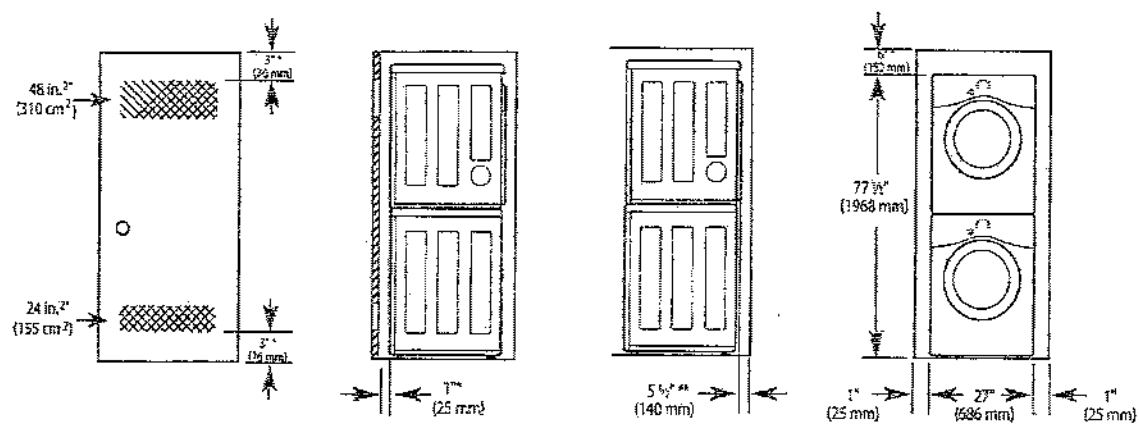


* Required spacing
** For side or bottom venting, 2-inch (5.1 cm) of spacing is allowed.

Installation Spacing for Cabinet

For cabinet installation with a door, minimum ventilation openings in the top of the cabinet are required.

* Required spacing

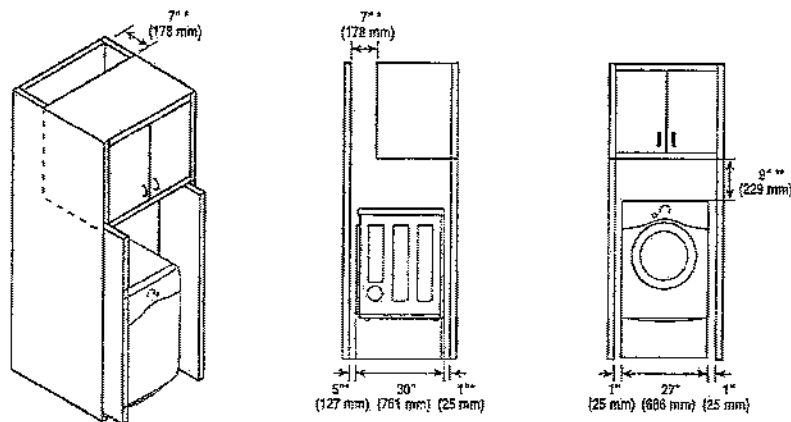




UNDER-CABINET


Updated with dual-level BriteStrip™ LED lighting the Breeze II's modern, clean lines provide a perfect complement to any interior. Equipped with 3-speed electronic controls, 400-CFM blower, convenient dishwasher-safe

aluminum filters and an auto delay-off feature that clears the air and powers down after 5 minutes. Available in black, white, stainless steel and black stainless finishes.


ZEPHYR
ZEPHYRONLINE.COM

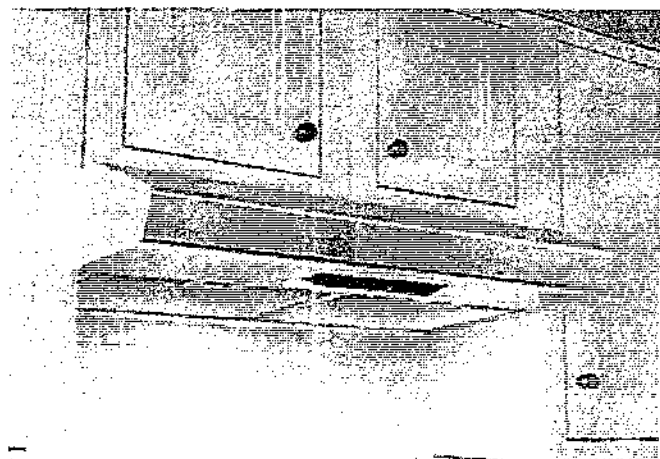


Stainless Steel

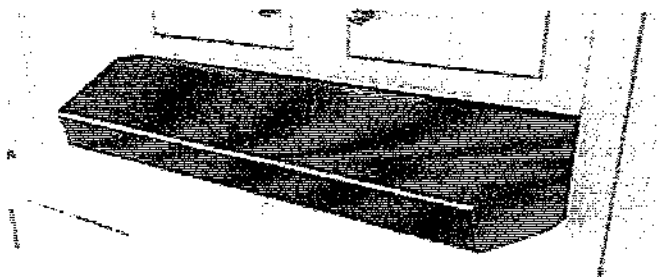


Black Stainless

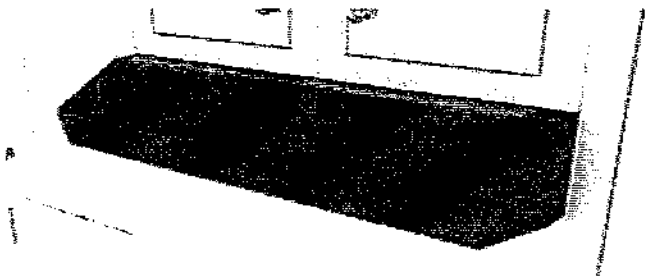


Black

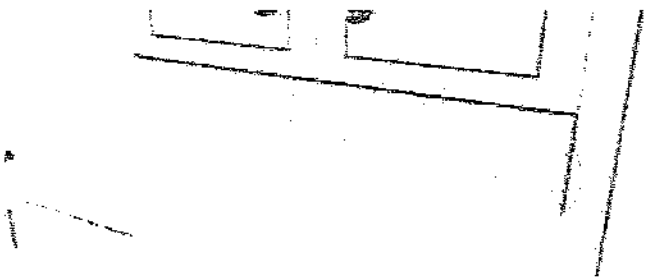


White

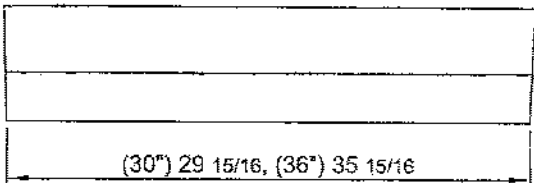


Front

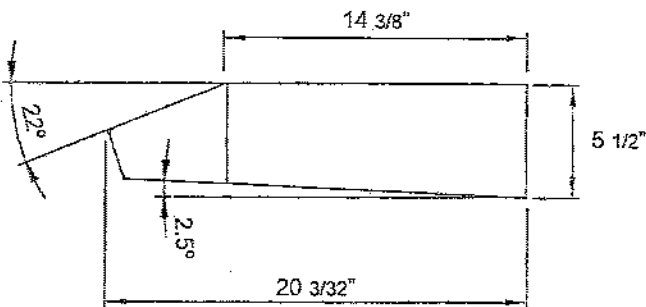

Side

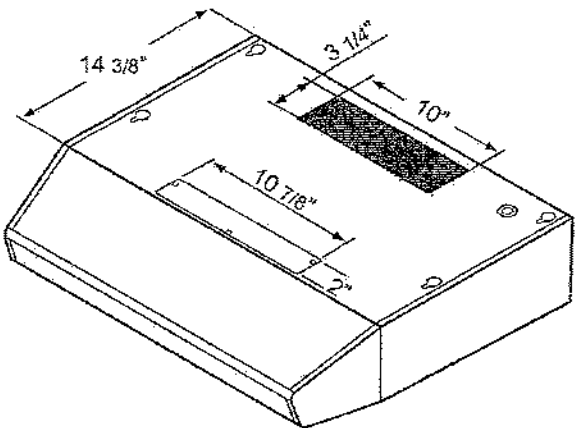

Top

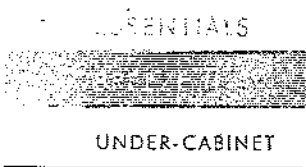

MODEL		
Black	AK1200BB	AK1236BB
White	AK1200BW	AK1236BW
Black Stainless	AK1200BBS	AK1236BBS
Stainless Steel	AK1200BS	AK1236BS
Size		
Blower CFM (Min. - Max.)	30" (29-15/16")	36" (35-15/16")
Sones (Min. - Max.)	175 - 400	175 - 400
	1.9 - 4.5	1.9 - 4.5
FEATURES		
Controls	Electronic Touch	Electronic Touch
Speed Levels	3	3
Auto Delay-Off	Yes	Yes
Lighting	BriteStrip™ LED x1	BriteStrip™ LED x1
Dual-Level Lighting	Yes	Yes
Filters	Aluminum Mesh x2	Aluminum Mesh x2
Recirculating Option	Yes	Yes
DUCT SPECIFICATIONS		
Vertical Internal Blower	3-1/4" x 10"	3-1/4" x 10"
Horizontal Internal Blower	3-1/4" x 10"	3-1/4" x 10"
AC POWER	120V, 60Hz at Max. 0.8A	120V, 60Hz at Max. 0.8A
OPTIONAL ACCESSORIES		
Recirculating Kit	OAK11-21001	OAK11-21001
MOUNTING HEIGHT RANGE*		
	24" - 32"	24" - 32"
WARRANTY		
	3 years parts, 1 year labor	3 years parts, 1 year labor

*Mounting height refers to distance between top of a 36" tall cooking surface and bottom of hood.




GBT632SSMSS



GE APPLIANCES

Fully Integrated Console Dishwasher, CleanSensor, 49
DBA

www.geappliances.ca

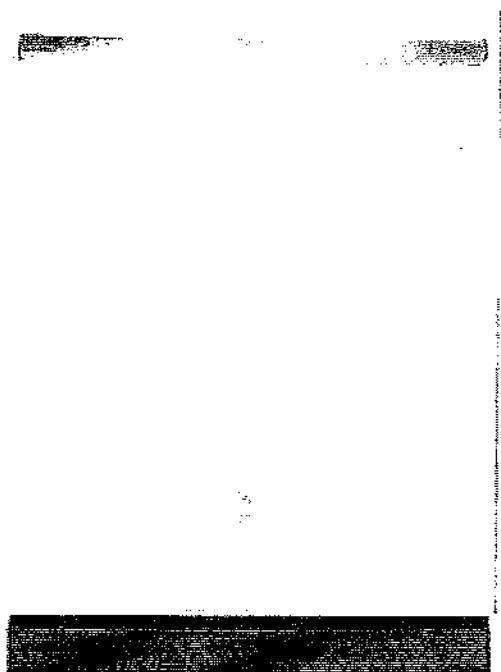

Color Stainless Steel

Dimensions

Overall Depth (in.)	22-13/32
Overall Height (in.)	32-1/2
Overall Width (in.)	23-1/2


Audible End-of-Cycle Signal	Yes
Drain Hose	Yes
Leveling Screws	Yes
Low Profile Installation	Yes
Rinse Aid Dispenser	Yes
Control Type	Fully Integrated Inlaid Electronic Light Touch
Countdown display	Yes - 3-digits
Cycles / Options	6 / 5
Place Settings	12
Touchpads	Top Controls
Tub & Door Liner	Stainless Steel
Energy Star Qualified	Yes
QuietPower Motor	Yes
Sound Insulation Package	49 dBA
AutoWash China / Crystal	Yes
Energy Saver Heavy Wash	Yes
Normal Wash Rinse Only	Yes
SpeedWash	Yes
Delay Start	1-24 hr.
Heated Dry On/Off Hi-Temp Wash	Yes
Sanitize Option	Yes
Start / Cancel / Reset Pad	Yes
Ball-Tipped Tines Utility Shelf	Yes
Lower Rack	Nylon Towerless
Upper Rack	Nylon
Silverware Basket	3-piece Long Silverware Cell Covers and Inserts
Automatic Temperature Control	Yes
Automatic Temperature Sensing	Yes
Dual Pumps and Motors	Yes
Wash Arm - Lower, Mid, & Upper Level	Yes
Wash System	5 Level Direct Feed

Product dimension, cutout and installation specifications are provided for planning purposes only. Before installing any product, be sure to verify cutout dimensions and electrical/gas connections with the installation guide.

* Registered trademark/TM Trademark of GE Appliances a HAIER company. © MC Commercial Inc. All Rights Reserved.
All other trademarks are owned by their respective companies.
Because GE Appliances policy includes a continuous commitment to improve our products, we reserve the right to change materials and specifications without notice. We also reserve the right to discontinue or transition products without notice.

Preparing the Dishwasher Enclosure

Product Dimensions

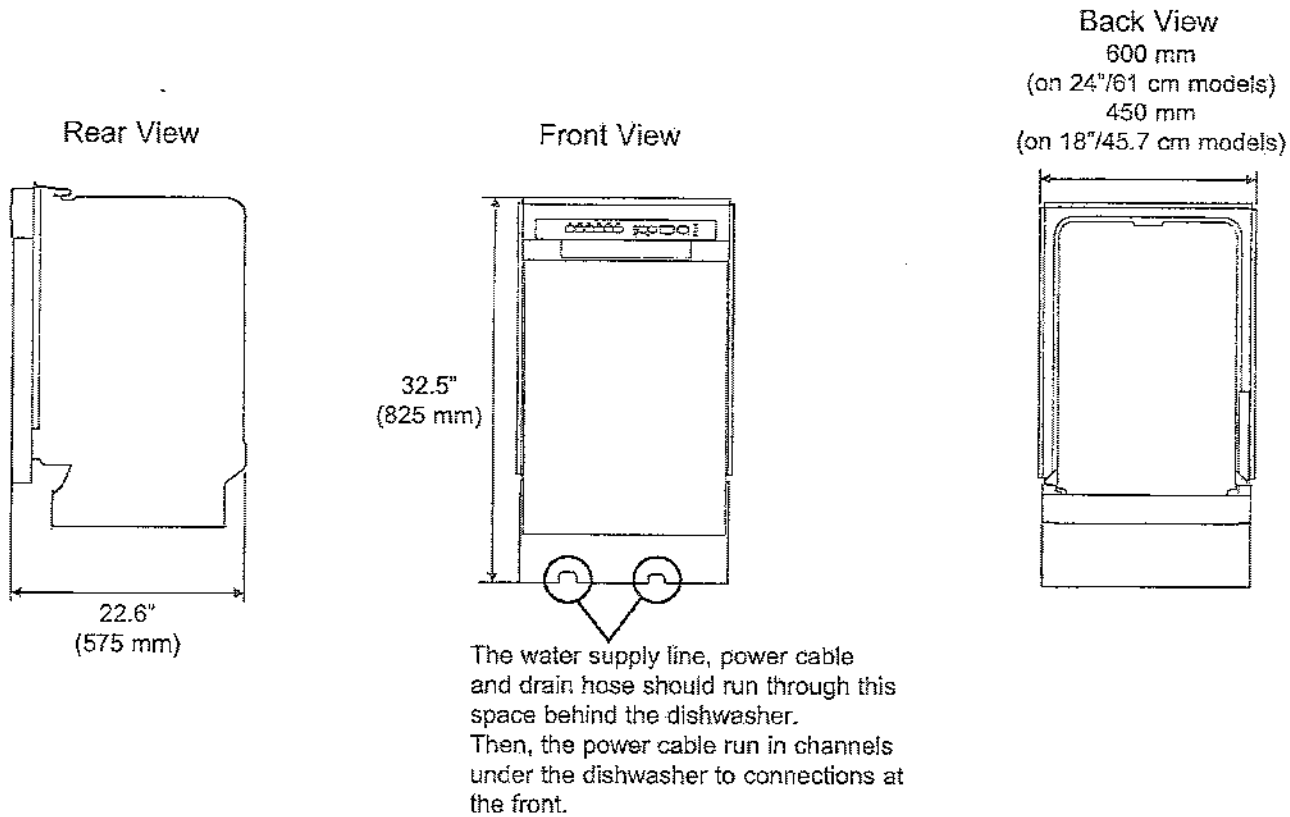

Enclosure Dimensions

This dishwasher is designed to be enclosed on the top and on both sides by a standard residential kitchen cabinet unit.

The installation enclosure must be clean and free of any obstruction.

The enclosure must be at least 23.6 inches (60 cm) wide for 24" (61 cm) models or 17.7 inches (45 cm) for 18" (45.7 cm) models, 23 inches (58.4 cm) deep and 32.5 inches (82.5 cm) high.

For the front door of the dishwasher to be flush with the leading edge of the counter top, the counter top must be at least 23 inches (58.4 cm) deep.

