

APPLIANCES

Invoice	Qty.	Description
2608	1	APPLIANCE SPECIFICATIONS ATTACHED - SIGNED COPY
10Mar21 NoCat		

BASEMENT WINDOWS

Invoice	Qty.	Description
2608 72,351 10Mar21	4	BASEMENT WINDOWS - UPGRADE BASEMENT WINDOW SIZE TO 30 " X 24" - 8" FRAME
10Mar21 NoCat		

CENTRAL VAC AND WIRING

Invoice	Qty.	Description
2608	1	THRU OUT: CYCLOVAC 215' CENTRAL VACUUM SYSTEM - COMPLETE WITH BEATER BAR & ACCESSORIES
10Mar21 NoCat		

CERAMIC

Invoice	Qty.	Description
2608	1	MASTER ENSUITE: SHOWER BENCH COMPLETE WITH STANDARD TILE AND MATCHING MARBLE JAMB COLOUR SEAT TOP
10Mar21 NoCat		
2608	1	ENSUITE 2: SHOWER NICHE [SHAMPOO SHELF] - COMPLETE WITH MATCHING MARBLE JAMBS ON 4 SIDES, STANDARD TILE, APPROX. 12 X 18 INSTALLED VERTICALLY - SEE PLAN FOR LOCATION
10Mar21 NoCat		
2608	1	MASTER ENSUITE: SHOWER NICHE [SHAMPOO SHELF] - COMPLETE WITH MATCHING MARBLE JAMBS ON 4 SIDES, STANDARD TILE, APPROX. 12 X 18 INSTALLED VERTICALLY - SEE PLAN FOR LOCATION
10Mar21 NoCat		
2625 37 23Mar21	1	POWDER ROOM: TILE, FLOOR, LEVEL 5 - 12X24" LAID IN STRAIGHT, STACKED PATTERN. SEE PLAN FOR TILE DIRECTION
2625 37 23Mar21	1	MUD ROOM: TILE, FLOOR, LEVEL 5 - 12X24" LAID IN STRAIGHT, STACKED PATTERN. SEE PLAN FOR TILE DIRECTION
2625 35 23Mar21	1	MASTER ENSUITE: TILE, FLOOR, LEVEL 3 - 12X24" LAID IN STRAIGHT, STACKED PATTERN. SEE PLAN FOR TILE DIRECTION
2625 25 23Mar21	1	MASTER ENSUITE: TILE INSTALLATION UPGRADE, FLOOR, HERRINGBONE
2625 51 23Mar21	1	MASTER ENSUITE: TILE, WALL, LEVEL 5 - 3X12" LAID IN VERTICAL, STACKED PATTERN

CERAMIC

Invoice	Qty.	Description
2625 45 23Mar21	1	MASTER ENSUITE: TILE, SHOWER FLOOR, LEVEL 4
2625 36 23Mar21	1	ENSUITE 2: TILE, FLOOR, LEVEL 4 - 12X24" LAID IN STRAIGHT, STACKED PATTERN. SEE PLAN FOR TILE DIRECTION
2625 51 23Mar21	1	ENSUITE 2: TILE, WALL, LEVEL 1 - 8x8"
2625 43 23Mar21	1	ENSUITE 2: TILE, SHOWER FLOOR, LEVEL 2 - 2X2" SQUARE
2625 35 23Mar21	1	ENSUITE 4: TILE, FLOOR, LEVEL 3 - 12X24" LAID IN STRAIGHT, STACKED PATTERN. SEE PLAN FOR TILE DIRECTION
2625 50 23Mar21	1	ENSUITE 4: TILE, WALL, LEVEL 4 - 12X24" LAID IN VERTICAL STACKED PATTERN
2625 37 23Mar21	1	ENSUITE 3: TILE, FLOOR, LEVEL 5 - HEX
2625 48 23Mar21	1	ENSUITE 3: TILE, WALL, LEVEL 2 - 2X16" - HORIZONTAL, STACKED PATTERN
2625 23Mar21 NoCat	1	FYI - KITCHEN/BREAKFAST: VINTAGE SERIES, 5" WHITE OAK, NSS ENGINEERED HARDWOOD, 3/4" THK, WIREBRUSH TEXTURE, UV OIL FINISH - LEVEL 3 DO NOT INSTALL/DO NOT SUPPLY CERAMIC (CREDIT)

DRYWALL

Invoice	Qty.	Description
2608 72,351 10Mar21 **	4	BASEMENT WINDOWS - UPGRADE BASEMENT WINDOW SIZE TO 30 " X 24" - 8" FRAME
2608 72,324 10Mar21 **	2	GARAGE DOOR OPENER (CHAMBERLAIN BELT DRIVE) - WITH 1 REMOTE - PRICE IS PER DOOR
2608 10Mar21 NoCat	1	FYI - BREAKFAST ROOM: UPGRADE REAR DOOR TO 96" GARDEN DOOR ASSEMBLY
2608 10Mar21 NoCat	1	FYI - STUDY: MODEL OPTIONS 40.03 - STUDY - ADD OPT. 8 FOOT HIGH DOUBLE FRENCH DOORS WITH SHAKER STYLE 3-LITE FROSTED GLASS DOORS
2608 10Mar21 NoCat	1	MASTER ENSUITE: SHOWER BENCH COMPLETE WITH STANDARD TILE AND MATCHING MARBLE JAMB COLOUR SEAT TOP
2608 10Mar21 NoCat	1	ENSUITE 2: SHOWER NICHE [SHAMPOO SHELF] - COMPLETE WITH MATCHING MARBLE JAMBS ON 4 SIDES, STANDARD TILE, APPROX. 12 X 18 INSTALLED VERTICALLY - SEE PLAN FOR LOCATION
2608 10Mar21 NoCat	1	MASTER ENSUITE: SHOWER NICHE [SHAMPOO SHELF] - COMPLETE WITH MATCHING MARBLE JAMBS ON 4 SIDES, STANDARD TILE, APPROX. 12 X 18 INSTALLED VERTICALLY - SEE PLAN FOR LOCATION

ELECTRICAL

Invoice		Qty.	Description
2608 72,351 10Mar21	4		BASEMENT WINDOWS - UPGRADE BASEMENT WINDOW SIZE TO 30 " X 24" - 8" FRAME
**			
2608 72,282 10Mar21	1		KITCHEN: ADDITIONAL 220V RECEPTACLE ON A SEPARATE CIRCUIT - FOR BUILT-IN WALL OVEN - APPLIANCE NOT INCLUDED - DOES NOT INCLUDE BREAKER THAT IS TO BE INSTALLED BY LICENSED ELECTRICIAN AND ARRANGED BY HOMEOWNER AFTER CLOSING FOR COMBO WALL OVENS
2608 72,307 10Mar21	1		KITCHEN: FIXTURE: RELOCATE STANDARD CEILING MOUNT FIXTURE - TO APPROX CENTERED ABOVE ISLAND SEE PLAN FOR LOCATION
2608 72,280 10Mar21	1		KITCHEN: CEILING OUTLET: ADDITIONAL REINFORCED CEILING OUTLET - LOCATE APPROX CENTERED ABOVE ISLAND, USE SAME SWITCH AS STANDARD CEILING LIGHT SEE PLAN FOR LOCATION
2608 72,289 10Mar21	2		KITCHEN: 4" E/S LED INTERIOR POT LIGHT - GROUND FLOOR - EACH SEE PLAN FOR LOCATION
2608 72,278 10Mar21	1		KITCHEN: ADDITIONAL INTERIOR SWITCH FOR POTTLIGHTS
2608 72,309 10Mar21	1		FRONT FOYER: UPGRADE STANDARD CEILING MOUNT FIXTURE TO (1) LED POT LIGHT - GROUND FLOOR - SEE PLAN FOR LOCATION
2608 72,289 10Mar21	1		FRONT FOYER: 4" E/S LED INTERIOR POT LIGHT - GROUND FLOOR - EACH SAME SWITCH AS STANDARD LIGHT
2608 72,309 10Mar21	1		MAIN HALL: UPGRADE STANDARD CEILING MOUNT FIXTURE TO (1) LED POT LIGHT - GROUND FLOOR - SEE PLAN FOR LOCATION
2608 72,289 10Mar21	2		MAIN HALL: 4" E/S LED INTERIOR POT LIGHT - GROUND FLOOR - EACH SAME SWITCH AS STANDARD LIGHT
2608 72,309 10Mar21	1		STUDY: UPGRADE STANDARD CEILING MOUNT FIXTURE TO (1) LED POT LIGHT - GROUND FLOOR - SEE PLAN FOR LOCATION
2608 72,289 10Mar21	3		STUDY: 4" E/S LED INTERIOR POT LIGHT - GROUND FLOOR - EACH USE SAME SWITCH AS STANDARD LIGHT
2608 72,281 10Mar21	1		STUDY: INTERIOR WALL OUTLET: ADDITIONAL 110V WALL INTERIOR RECEPTACLE ON EXISTING CIRCUIT FOR WALL MOUNTED TV - LOCATE ABOVE FIREPLACE, APPROX 66" A.F.F.

ELECTRICAL

Invoice	Qty.	Description
2608 72.289 10Mar21	6	GREAT ROOM: 4" E/S LED INTERIOR POT LIGHT - GROUND FLOOR - EACH INCLUDED IN APS
2608 72.283 10Mar21	1	GREAT ROOM: DIMMER SWITCH: DECORA DIMMER SWITCH - EACH FOR POTTLIGHTS
2608 72.310 10Mar21	1	UPPER HALL: UPGRADE STANDARD CEILING MOUNT FIXTURE TO (1) LED POT LIGHT - SECOND FLOOR - SEE PLAN FOR LOCATION
2608 72.290 10Mar21	2	UPPER HALL: 4" E/S LED INTERIOR POT LIGHT (INSULATED CEILING) - SECOND FLOOR - EACH SAME SWITCH AS STANDARD LIGHT
2608 72.280 10Mar21	1	MASTER ENSUITE: CEILING OUTLET: ADDITIONAL REINFORCED CEILING OUTLET - LOCATE APPROX CENTERED ABOVE TUB
2608 72.278 10Mar21	1	MASTER ENSUITE: ADDITIONAL INTERIOR SWITCH FOR LIGHT ABOVE TUB
2608 72.291 10Mar21	7	FRONT ELEVATION: EXTERIOR LED SOFFIT POT LIGHT - EACH SEE APPROX SEE ATTACHED FOR LOCATIONS
2608 72.278 10Mar21	1	FOYER: ADDITIONAL INTERIOR SWITCH FOR SOFFIT LIGHTS
2608 72.285 10Mar21	1	MASTER ENSUITE: INTERIOR WALL OUTLET: ADDITIONAL INTERIOR GFI RECEPTACLE AT VANITY
2608 10Mar21 NoCat	1	FYI-MUD ROOM: ADD ROUGH - IN FOR EXTRA SECURITY KEY PAD
2625 23Mar21 NoCat	1	FYI - KITCHEN: FULL HEIGHT SLAB BACKSPLASH - LEVEL 5 QUARTZ

EXTERIOR COLOURS

Invoice	Qty.	Description
2608 10Mar21 NoCat	1	EXTERIOR COLOURS PACKAGE: SRS-5

FIREPLACE

Invoice	Qty.	Description
2608 72,622	1	UPGRADE MAIN FLOOR LINEAR 2 SIDED FIREPLACE - HEATILATOR 36" SEE THROUGH DIRECT VENT GAS LINEAR FIREPLACE IN LIEU OF STANDARD
10Mar21		-BOTTOM OF GLASS TO BE APPROX 24" A.F.F. NO SURROUND - PLEASE LEAVE PAINTED DRYWALL ONLY includes 3x36" ventilation grill approx 6" from ceiling

FORM - FORMING

Invoice	Qty.	Description
2608 72,351 10Mar21 **	4	BASEMENT WINDOWS - UPGRADE BASEMENT WINDOW SIZE TO 30 " X 24" - 8" FRAME

FRAMING

Invoice	Qty.	Description
2608 72,671 10Mar21	1	MASTER ENSUITE: SHOWER BENCH COMPLETE WITH STANDARD TILE AND MATCHING MARBLE JAMB COLOUR SEAT TOP
2608 72,631 10Mar21	1	MASTER ENSUITE: SHOWER NICHE [SHAMPOO SHELF] - COMPLETE WITH MATCHING MARBLE JAMBS ON 4 SIDES, STANDARD TILE, APPROX. 12 X 18 INSTALLED VERTICALLY - SEE PLAN FOR LOCATION
2608 72,631 10Mar21	1	ENSUITE 2: SHOWER NICHE [SHAMPOO SHELF] - COMPLETE WITH MATCHING MARBLE JAMBS ON 4 SIDES, STANDARD TILE, APPROX. 12 X 18 INSTALLED VERTICALLY - SEE PLAN FOR LOCATION
2608 72,631 10Mar21	1	FYI - BREAKFAST ROOM: UPGRADE REAR DOOR TO 96" GARDEN DOOR ASSEMBLY
2608 72,631 10Mar21 NoCat	1	FYI - STUDY: MODEL OPTIONS 40.03 - STUDY - ADD OPT. 8 FOOT HIGH DOUBLE FRENCH DOORS WITH SHAKER STYLE 3-LITE FROSTED GLASS DOORS

GARAGE DOORS

Invoice	Qty.	Description
2608 72,324 10Mar21	2	GARAGE DOOR OPENER (CHAMBERLAIN BELT DRIVE) - WITH 1 REMOTE - PRICE IS PER DOOR
2608 72,323 10Mar21	1	GARAGE: WIRELESS KEYPAD GARAGE DOOR ENTRY 877LM

GLASS AND MIRROR

Invoice	Qty.	Description
2625 23Mar21 NoCat	2	MASTER ENSUITE + ENSUITE 3: UPGRADE SHOWER DOOR HANDLE TO SQ6X6

Lot: 39
Model: 40.04 C DALEBRIDGE
Project/Phase: Pine Valley Forevergreen / 1

GRANITE MARBLE QUARTZ

Invoice	Qty.	Description
2625 23Mar21 NoCat	1	KITCHEN: UPGRADE 5 QUARTZ COUNTER TOP
2625 23Mar21 NoCat	2	KITCHEN ISLAND: WATERFALL LEGS AT ISLAND - LEVEL 5 QUARTZ
2625 23Mar21 NoCat	1	KITCHEN: FULL HEIGHT SLAB BACKSPLASH - LEVEL 5 QUARTZ
2625 23Mar21 NoCat	1	KITCHEN: UPGRADE TO 3CM SLAB THICKNESS IN KITCHEN
2625 23Mar21 NoCat	1	POWDER ROOM: UPGRADE 4 QUARTZ COUNTER TOP
2625 23Mar21 NoCat	1	MUD ROOM: UPGRADE 4 QUARTZ COUNTER TOP (PRICE INCLUDES OVER LAUNDRY MACHINES)
2625 23Mar21 NoCat	1	MASTER ENSUITE: UPGRADE 3 QUARTZ COUNTER TOP
2625 23Mar21 NoCat	1	ENSUITE 2: UPGRADE 4 QUARTZ COUNTER TOP
2625 23Mar21 NoCat	1	ENSUITE 4: UPGRADE 4 QUARTZ COUNTER TOP
2625 23Mar21 NoCat	1	ENSUITE 3: UPGRADE 3 QUARTZ COUNTER TOP
2625 23Mar21 NoCat	1	KITCHEN: COOKTOP CUT OUT

HARDWOOD

Invoice	Qty.	Description
2625 4 23Mar21	1	THRU OUT - ALL STANDARD AREAS - MAIN HALL/ GREAT ROOM/ STUDY/ DINING ROOM/ STUDY LOFT/UPPER HALL/ MASTER BEDROOM/ BEDROOM 2/ BEDROOM 3/ BEDROOM 4: VINTAGE SERIES, 5" WHITE OAK, NSS ENGINEERED HARDWOOD, 3/4" THK, WIREBRUSH TEXTURE, UV OIL FINISH - LEVEL 3
2625 4 23Mar21	1	KITCHEN/BREAKFAST: VINTAGE SERIES, 5" WHITE OAK, NSS ENGINEERED HARDWOOD, 3/4" THK, WIREBRUSH TEXTURE, UV OIL FINISH -LEVEL 3
2625 4 23Mar21	1	FOYER: VINTAGE SERIES, 5" WHITE OAK, NSS ENGINEERED HARDWOOD, 3/4" THK, WIREBRUSH TEXTURE, UV OIL FINISH - LEVEL 3

HVAC

Invoice	Qty.	Description
2608 72,240 10Mar21	1	THRU OUT: 3.5 TON 14 ACX - WITH LOW VOLTAGE WIRING & WALL BRACKETS IN LIEU OF STANDARD 13ACX
2608 72,248 10Mar21	1	THRU OUT: APRILAIRE 600 WHOLE HOUSE STEAM HUMIDIFIER (UP TO 4,000 SQ.FT.) - COMPLETE WITH HI VOLTAGE WIRING, 240V DOUBLE BREAKER 20 AMP, SHUT OFF VALVE

INTERIOR DOORS AND TRIM

Invoice	Qty.	Description
2608 72,402 10Mar21	1	STUDY: MODEL OPTIONS 40.03 - STUDY - ADD OPT. 8 FOOT HIGH DOUBLE FRENCH DOORS WITH SHAKER STYLE 3-LITE FROSTED GLASS DOORS

INTERIOR TRIM/MOULDINGS

Invoice	Qty.	Description
2608 72,351 10Mar21 **	4	BASEMENT WINDOWS - UPGRADE BASEMENT WINDOW SIZE TO 30 " X 24" - 8" FRAME

INTERIOR TRIM AND DOORS

Invoice	Qty.	Description
2625 155,866 23Mar21	1	THRU OUT: ADD FOR HINGES 3X3 SQUARE FLAT TIP THROUGHOUT UPGRADE
2625 153,716 23Mar21	1	THRU OUT: HALIFAX LEVER, SATIN NICKLE INTERIOR DOOR HARDWARE UPGRADE
2625 153,276 23Mar21	1	THRU OUT: UPGRADE 3 1/4" STEP BEVEL BB CASING, 5 1/2" BASE BOARD UPGRADE
2625 155,362 23Mar21	1	THRU OUT: UPGRADE INTERIOR DOORS TO LINCOLN PARK, UPGRADE

KITCHEN AND BATH CABINETRY

Invoice	Qty.	Description
2625 23Mar21 NoCat	1	THRU OUT: SEE ATTACHED CABINETRY SCHEDULE
2625 23Mar21 NoCat	1	FYI - KITCHEN ISLAND: WATERFALL LEGS AT ISLAND - LEVEL 5 QUARTZ
2625 23Mar21 NoCat	1	FYI - KITCHEN: FULL HEIGHT SLAB BACKSPLASH - LEVEL 5 QUARTZ

MASONRY

Invoice	Qty.	Description
2608 10Mar21 NoCat	1	FYI - BREAKFAST ROOM: UPGRADE REAR DOOR TO 96" GARDEN DOOR ASSEMBLY

NETWORK AND WIRING

Invoice	Qty.	Description
2608 72.258 10Mar21	1	STUDY: ADDITIONAL CAT6 ETHERNET OUTLET - EACH SEE PLAN FOR LOCATION
2608 72.264 10Mar21	1	MUD ROOM: ADD ROUGH - IN FOR EXTRA SECURITY KEY PAD SEE PLAN FOR LOCATION
2608 10Mar21 NoCat	1	THRU OUT: PLEASE DO NOT INSTALL ANY PHONE ROUGH-INS
2608 72.258 10Mar21	1	MASTER BEDROOM: ADDITIONAL CAT6 ETHERNET OUTLET - EACH SEE PLAN FOR LOCATION

PAINT

Invoice	Qty.	Description
2608 10Mar21 NoCat	1	FYI - STUDY: MODEL OPTIONS 40.03 - STUDY - ADD OPT. 8 FOOT HIGH DOUBLE FRENCH DOORS WITH SHAKER STYLE 3-LITE FROSTED GLASS DOORS

PAINTING

Invoice	Qty.	Description
2608 72.351 10Mar21 **	4	BASEMENT WINDOWS - UPGRADE BASEMENT WINDOW SIZE TO 30 " X 24" - 8" FRAME

PANL - FRAMING

Invoice	Qty.	Description
2608 72.351 10Mar21 **	4	BASEMENT WINDOWS - UPGRADE BASEMENT WINDOW SIZE TO 30 " X 24" - 8" FRAME
2608 72.324 10Mar21 **	2	GARAGE DOOR OPENER (CHAMBERLAIN BELT DRIVE) - WITH 1 REMOTE - PRICE IS PER DOOR

PLUMBING

Invoice	Qty.	Description
2608 72,332 10Mar21	1	KITCHEN: ROUGH-IN 1/4" COLD WATER LINE TO FRIDGE
2608 10Mar21 NoCat	1	MASTER ENSUITE: MOEN DOUX SHOWER (from ceiling) + HAND SHOWER - CHROME
2608 75,845 10Mar21	1	MASTER ENSUITE: MOEN DOUX FREE-STANDING TUB FILLER - CHROME
2608 101,930 10Mar21	2	MASTER ENSUITE: MOEN DOUX SINGLE HANDLE LAV FAUCET - CHROME
2608 10Mar21 NoCat	1	THRU OUT: APRILAIRE 600 WHOLE HOUSE STEAM HUMIDIFIER (UP TO 4,000 SQ.FT.) - COMPLETE WITH HI VOLTAGE WIRING, 240V DOUBLE BREAKER 20 AMP, SHUT OFF VALVE ROUGH-IN VALVE FOR HUMIDIFIER
2625 23Mar21 NoCat	1	MUD ROOM: UPGRADE TO UNDERMOUNT STAINLESS STEEL LAUNDRY SINK + SINGLE HOLE FAUCET
2625 23Mar21 NoCat	1	KITCHEN: BLANCO QUATRUS R15 U2 SINK BOTTOM GRID NOT INCLUDED

ROUGH CARPENTRY

Invoice	Qty.	Description
2608 72,351 10Mar21 **	4	BASEMENT WINDOWS - UPGRADE BASEMENT WINDOW SIZE TO 30 " X 24" - 8" FRAME

STAIR AND RAILINGS

Invoice	Qty.	Description
2625 100,223 23Mar21	1	MAIN STAIRS: ADD FOR GLASS PANEL IN LIEU OF PICKETS - UPG - GLASS PANEL

STAIRS AND RAILINGS

Invoice	Qty.	Description
2625 23Mar21 NoCat	2	MAIN STAIRS: STAIN STAIRS AND LANDINGS STAIRS AND LANDINGS WILL NOT MATCH HARDWOOD IN COLOUR/TEXTURE/SPECIES

Lot: 39
Model: 40.04 C DALE RIDGE
Project/Phase: Pine Valley Forevergreen / 1

WINDOWS - BASEMENT

Invoice	Qty.	Description
2608 72.351 10Mar21 **	4	BASEMENT WINDOWS - UPGRADE BASEMENT WINDOW SIZE TO 30 " X 24" - 8" FRAME

WINDOWS AND DOORS

Invoice	Qty.	Description
2608 10Mar21 NoCat	1	BREAKFAST ROOM: UPGRADE REAR DOOR TO 96" GARDEN DOOR ASSEMBLY

Layout Changes: ☐ Yes ☒ No Sketch Attached: ☒ Yes ☐ No Exterior Colour Scheme:

1. Cabinetry

Style and Colour	Counter	Hardware
Kitchen / Breakfast	*2-TONE	*Quartz: Calacatta Nuvo attached
Laundry Room	Tribecca 'Stello' (mud room)	*Quartz: Alpine Mist attached
Powder Room	Tribecca 'Stello'	*Quartz: Alpine Mist attached
Ensuite 3	Tribecca 'Stello'	*Quartz: Ariel attached
Master Ensuite Bathroom	Bowery 'Ello'	*Quartz: Ariel attached
Second Ensuite Bathroom (If Applicable)	Modena 'Classic White'	*Quartz: Symphony Grey attached
Ensuite 4	Modena 'Classic White'	*Quartz: Symphony Grey attached

Comment

Kitchen: Tall / uppers: Manhattan 'Latte' // Base: Manhattan Zebirano 'Slate Grey'

2. Floor Tile

Selection	
Entrance Vestibule	hardwood
Main Hall	
Kitchen / Breakfast	hardwood
Laundry Room	*12x24" Design Industry 'Raw Light Pearl' (mud room)
Powder Room	*12x24" Design Industry 'Raw Light Pearl'
Ensuite 3	*Hex Roma 'Statuario'
Master Ensuite Bathroom	*12x24" Eterna Medium Grey matte
Second Ensuite Bathroom (If Applicable)	*12x24" Reye 'Fumee'
Lower Landing (If Applicable)	13x13" Costa matte white (basement foyer)
Ensuite 4	*12x24" Eterna Medium Grey matte

Comment

Shower Floor: Master Ensuite - Eterna 'med grey' matte herringbone // Ensuite 2 - 2x2" Ontario 'Taupe'

3. Wall Tile

Selection	Listello/Inserts	Describe
Ensuite 3	*2x16" CDC Arctic White matte	☐ Yes ☒ No
Master Ensuite Bathroom		
Tub Deck		☐ Yes ☒ No
Shower Stall	*3x12" Roma 'Statuario'	☐ Yes ☒ No
Bathroom Walls		☐ Yes ☒ No
Second Ensuite Bathroom (If Applicable)	*8x8" Marakesh 'LightGreyMatte'	☐ Yes ☒ No
Ensuite 4	*12x24" Arkistone 'Silver mt decor'	☐ Yes ☒ No
Kitchen Backsplash	☒ Yes ☐ No	Backsplash Behind Fridge
Comment	*FHBS - slab same as counter	

attached

4. Plumbing Fixtures

☐

Second Ensuite

☐

Powder Room

☐☐

Other Room - Specify

☐

Other Washroom

☐

Comment

See extras

5. Hardwood Flooring

Type and Stain

Upper Landing

Type and Stain

Main Hall

Upper Hall

Kitchen / Breakfast

*3/4x5" Wht oak wirebrush 'Orion'

Master Bedroom

Living Room

Master Bedroom

Dining Room

Bedroom #2

Family Room

Bedroom #3

Den/Library

Bedroom #4

Entrance Vestibule

*3/4x5" Wht oak wirebrush 'Orion'

Bedroom #5

Lower Landing
(If Applicable)

Other Room - Specify

*3/4x5" Wht oak wirebrush 'Orion'

Comment

6. Carpeting

Ground Floor

☐

Upgrade

Description

Second Floor

☐☐

Type

Area

Upgrade Underpad

Capped

Runner - *Upgrade

Carpet on Stairs

Comment

7. Fireplace

Living Room

Purchased

☐

As Per Plan

☐

N/A

☒

Family Room

Purchased

☐

As Per Plan

☒

N/A

☐

Other Room - Specify

Purchased

☐

As Per Plan

☐

N/A

☒

Fireplace Type

*2-sided linear

Mantle Type

none

Colour / Stain

n/a

Surround

none

Hearth

none

Comment

attached

Purchaser: JONATHAN, VICTOR, BOTTOS PICCIN

Property: 39 of Plan -

Telephone Res. / Bus: (416) 564-1027 / (416) 564-1027

Project: Pine Valley Forevergreen - Phase 1

Decor Advisor: Yolande Somerville

Model and Elevation: 40.04 C DALERIDGE

8. Trim Carpentry

Interior Doors *Lincoln Park Front Door Glass Inserts Standard Door Handles *Halfax brshd +hng

Interior Trim *Board 3

Comment

9. Plaster Mouldings and Medallions

Standard Throughout ☐ Yes ☐ No ☒ N/A

Entrance Vestibule Kitchen/Breakfast

Main Hall Den/Library

Living Room Lower Landing

Dining Room Other Room - Specify

Family Room

Comment

10. Railings and Spindles

Railing Package *Glass Railing Package

Railing Colour Stainless Spindle Colour *glass

Stringer / Riser *Rio - mirage Treads *Rio - mirage

Comment Oak Stairs ☐ Yes ☐ No ☐ N/A

11. Wall Paint / Ceilings

Throughout Finished Areas Cool White

Trim Paint White

Smooth Ceilings

Ground Floor ☒

Second Floor ☒

Note

Comment

attached

Purchaser: JONATHAN, VICTOR, BOTTOS PICCIN

Property: 39 of Plan -

Telephone Res. / Bus: (416) 564-1027 / (416) 564-1027

Project: Pine Valley Forevergreen - Phase 1

Decor Advisor: Yolande Somerville

Model and Elevation: 40.04 C DALERIDGE

12. Electrical

Hood Fan ☐ White ☐ Stainless ☒ N/A

Standard Appliances ☐

Above Kitchen Cabinet Light ☐ Yes ☒ No
Below Kitchen Cabinet Light ☐ Yes ☒ No

Over The Range Microwave ☐

Chimney Style Fan ☐

Comment

13. Heating and Air Conditioning

Air Conditioning

Gas Provisions Stove

Gas Provisions Dryer

Gas Provisions Barbecue

Comment

14. Additional Comments

15. Disclaimers and Notes

- 1) Colours of all materials are as close as possible to builder's selection, but not necessarily identical due to variances in manufacturing.
- 2) Any extras listed above are null and void unless accompanied by a separate invoice/amendment. Said invoice must be paid in full.
- 3) The Purchaser acknowledges that after Interior Colour Selection form is signed and dated, no further changes will be permitted other than re-selection due to unavailability. _____ Purchaser's Initials
- 4) The Purchaser acknowledges reading and accepting the "Gold Park Homes Decor Centre Disclaimers" form. This document contains other miscellaneous disclaimers.

This Interior Colour Selection is final and approved by:

Signature: Yolande Somerville Date: March 19, 2021



ROOM	DESCRIPTION	PRICE	QTY	TOTAL
KITCHEN	UPGRADE FROM SERIES 2 TO SERIES 3 - MANHATTAN LATTE (TALL + UPPERS) UPGRADE FROM SERIES 2 TO SERIES 4 - MANHATTAN SLATE GREY ZEBRANO (BASES)	\$	1	\$
	TOUCH LATCH HARDWARE TO TALL + UPPERS	\$	1	\$
	STANDARD HARDWARE TO BASES - H033-01 (N/C)	\$	1	\$
	RETURN TRIP FOR HARDWOOD	\$	1	\$
	FLAT PANEL IN USE OF CROWN MOLDING (N/C)	\$	1	\$
	FLUSH KICK AT BACK OF ISLAND	\$	1	\$
	TOUCH LATCH HARDWARE AT BACK OF ISLAND	\$	1	\$
	ADD TWO-SINK RECYCLE CENTRE AT ISLAND W/ TOP DUMMY PANEL FOR PLUG	\$	1	\$
	M/OE DISHWASHER TO SINK LOCATION AND SINK TO DISHWASHER LOCATION (N/C)	\$	1	\$
	CONVERT CABINETRY TO TALL DEEP BUILT IN OVEN UNIT WITH DRAWER BELOW	\$	1	\$
	ADD POTS AND PANS BELOW COOKTOP	\$	1	\$
	ADD DECORATIVE HOOD CANOPY	\$	1	\$
	CONVERT CABINETRY TO TALL DEEP PANTRY SINGLE DOOR	\$	1	\$
MASTER ENSUITE	ADD TOUCH LATCH HARDWARE	\$	1	\$
ENSUITE 2	ADD TOUCH LATCH HARDWARE	\$	1	\$
ENSUITE 3	ADD TOUCH LATCH HARDWARE	\$	1	\$
ENSUITE 4	ADD TOUCH LATCH HARDWARE	\$	1	\$
POWDER ROOM	ADD TOUCH LATCH HARDWARE	\$	1	\$
MUD ROOM	ADD OPTIONAL UPPERS - TRIBECCA STELLO ADD OPTIONAL BENCH ADD GABLES TO SUPPORT QUARTZ COUNTER ABOVE MACHINES ADD TOUCH LATCH HARDWARE	\$ \$ \$ \$	1 1 1 1	\$ \$ \$ \$
CABINETS TOTAL:		\$		\$

LOT #:	PV-59
DATE:	March 19, 2021
SIGNATURE:	
SIGNATURE:	

SCHEDULE 'F'

PN-39

Feb 26 2021

PINE VALLEY

FOREVERGREEN

21

Week 19 2021


attaché de

The Daleridge 40' SERIES

Elevation A • 3,335 sq.ft.
Elevation B • 3,395 sq.ft.

Elevation B • 3,395 sq.ft.

→ Elevation C • 3,370 sq.ft.

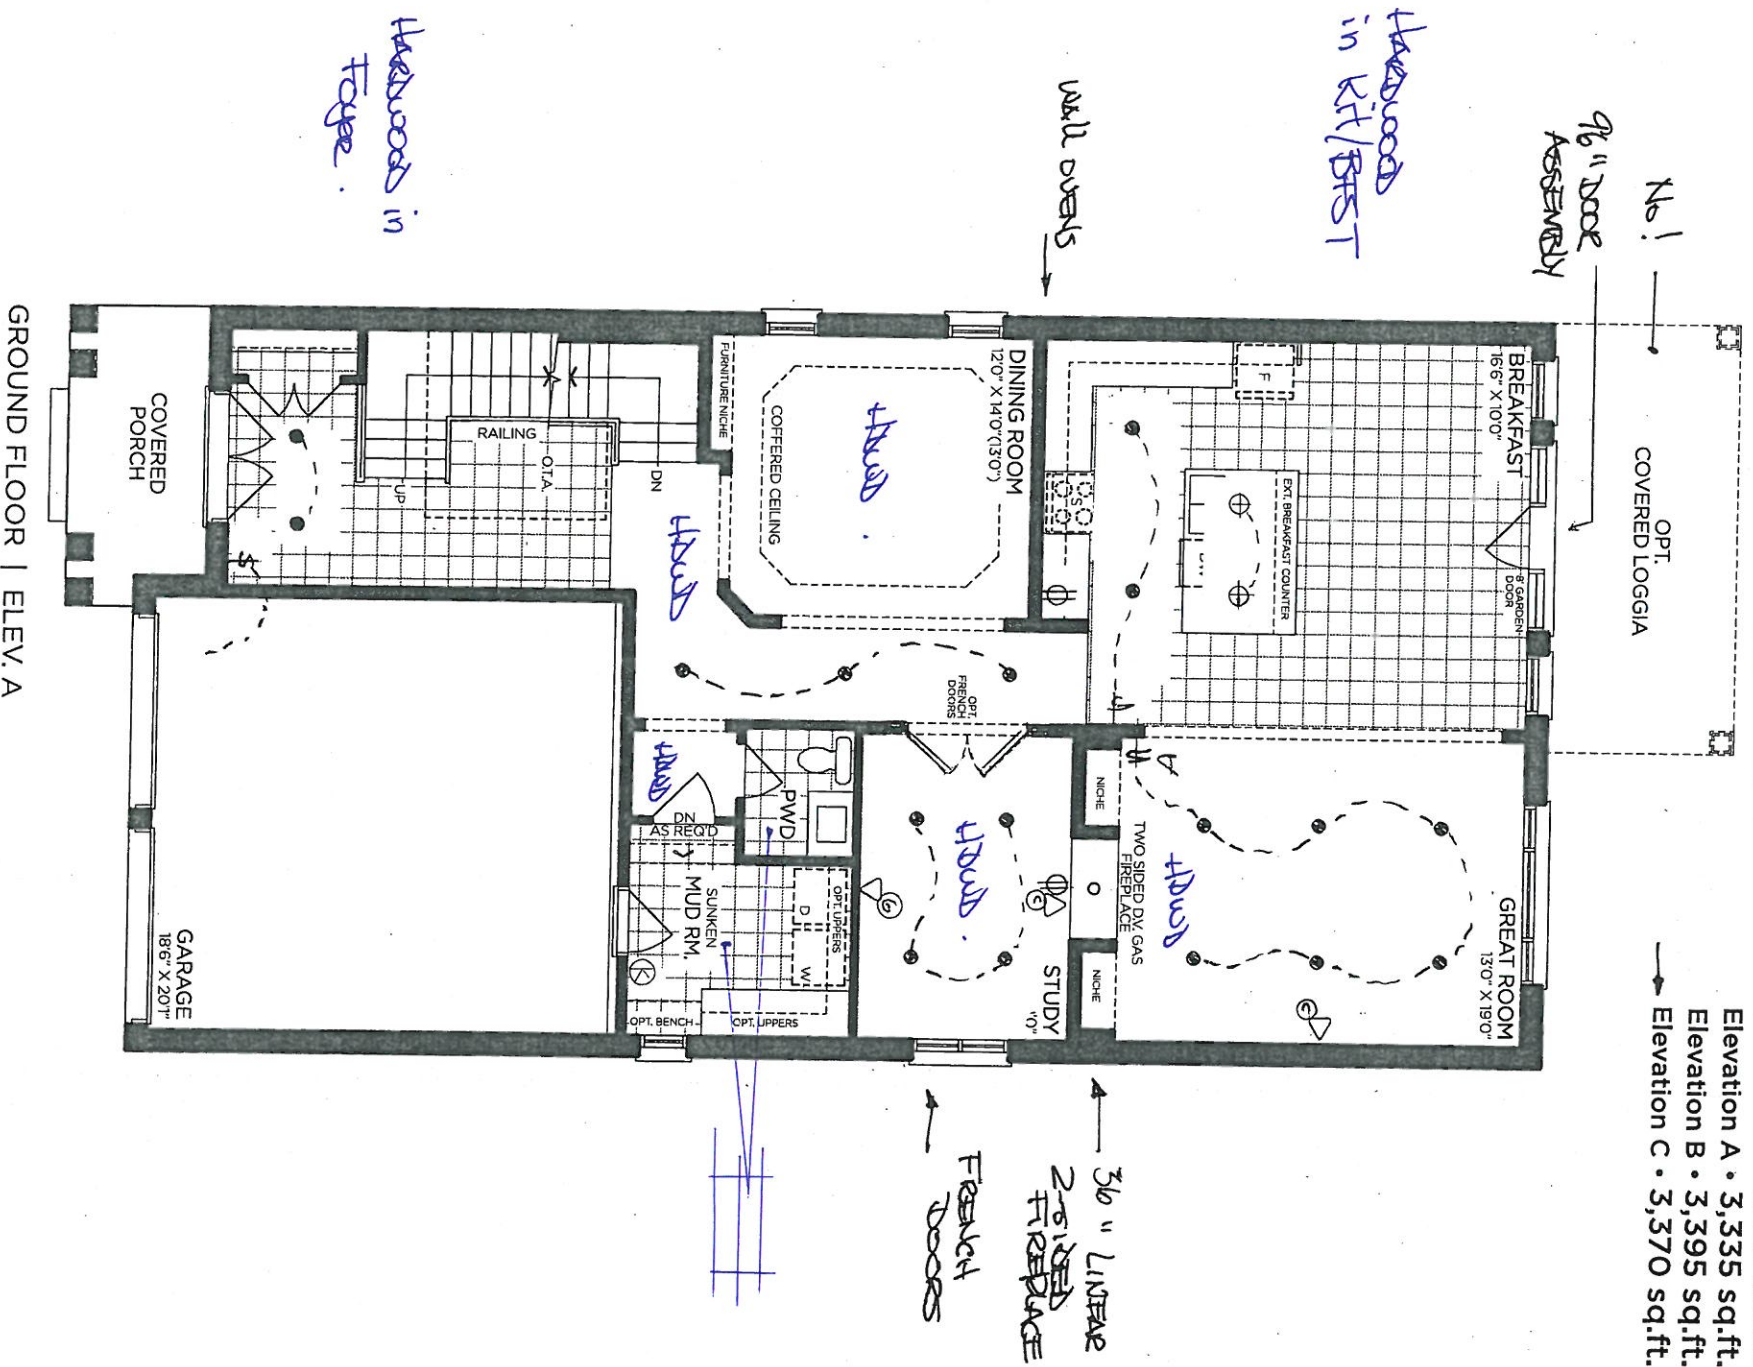

VENDOR

PURCHASER

PURCHASER

GOLDPARK

WORTH MORE™

Prices, figures, illustrations, sizes, features and finishes are subject to change without notice. Areas and dimensions are approximate and actual usable floor space may vary from the stated area. Layout may be reverse of the unit purchased. E. & O.E. 4004

PINE VALLEY
FOREVERGREEN



NO PHONES
HERE OUT


PV-33
FEB 26 2021
PV-33
March 19 2021

attached

SCHEDULE 'F'
50.

The Daleridge 40' SERIES

Elevation A • 3,335 sq.ft.
Elevation B • 3,395 sq.ft.
Elevation C • 3,370 sq.ft.

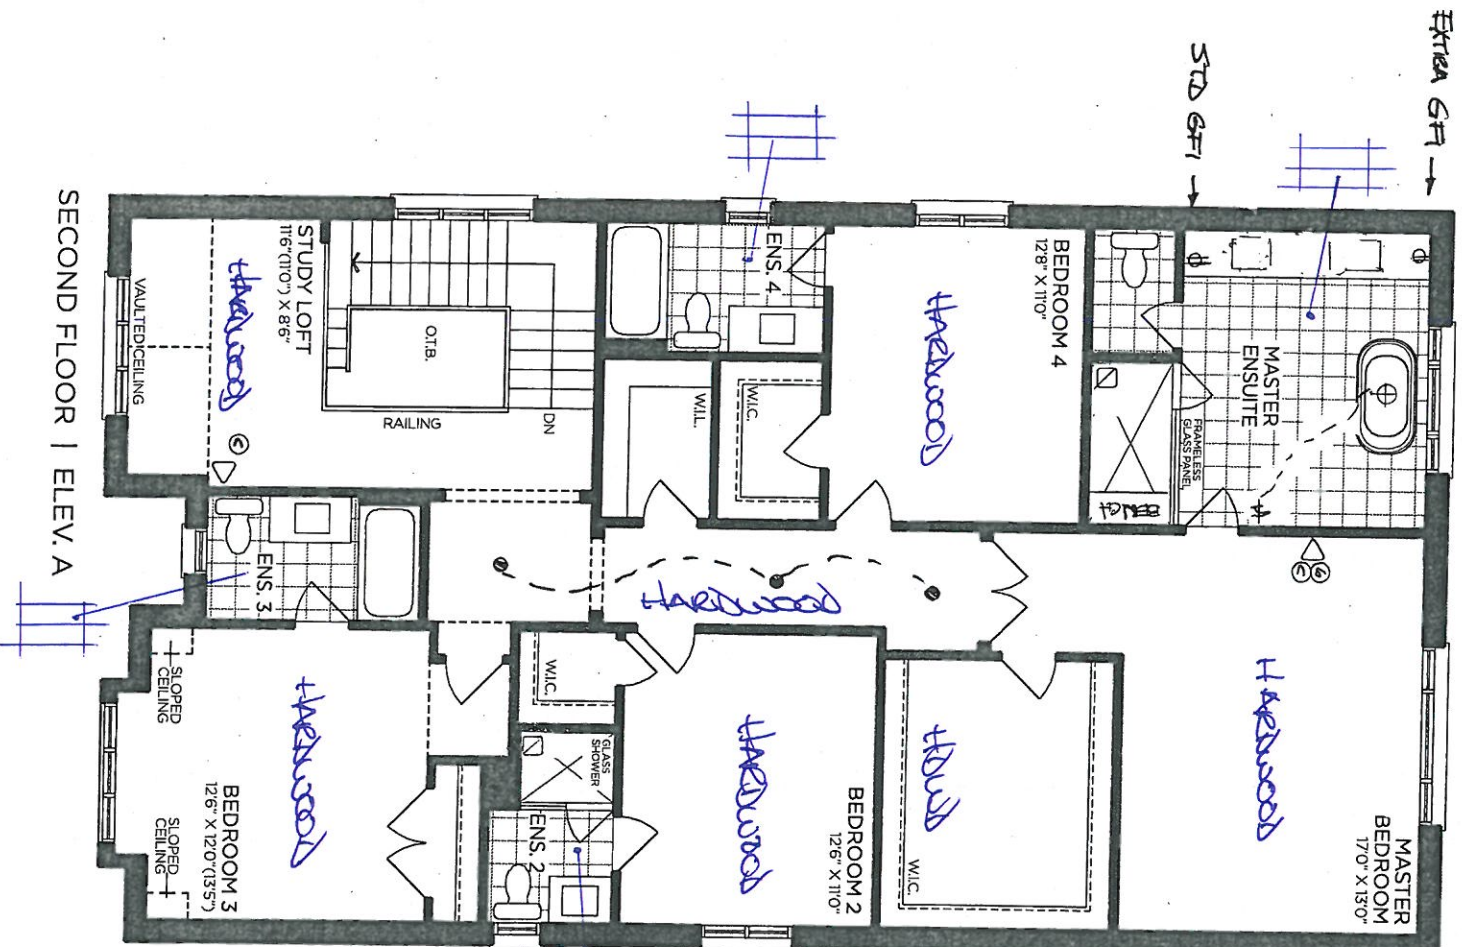

VENDOR

PURCHASER

PURCHASER

GOLDPARK
WORTH MORE


Prices, figures, illustrations, sizes, features and finishes are subject to change without notice. Areas and dimensions are approximate and actual usable floor space may vary from the stated area. Layout may be reverse of the unit purchased. E. & O.E. 4004

FOREVLA GREEN

58

attached

Elevation A • 3,335 sq.ft.
Elevation B • 3,395 sq.ft.
→ Elevation C • 3,370 sq.ft.

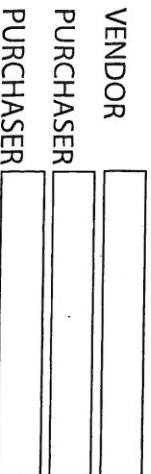

GOLD PARK
WORTH MORE™

WORTH MORE™

Prices, figures, illustrations, sizes, features and finishes are subject to change without notice. Areas and dimensions are approximate and actual usable floor space may vary from the stated area. Layout may be reverse of the unit purchased. E & OE, 4004





PN-39
~~PN-38~~ 26 22. 38

PN-39
March 19 2021 attached

SCHEDULE 'F'

The
Daleridge
40' SERIES


Elevation A • 3,335 sq.ft.
Elevation B • 3,395 sq.ft.
Elevation C • 3,370 sq.ft.

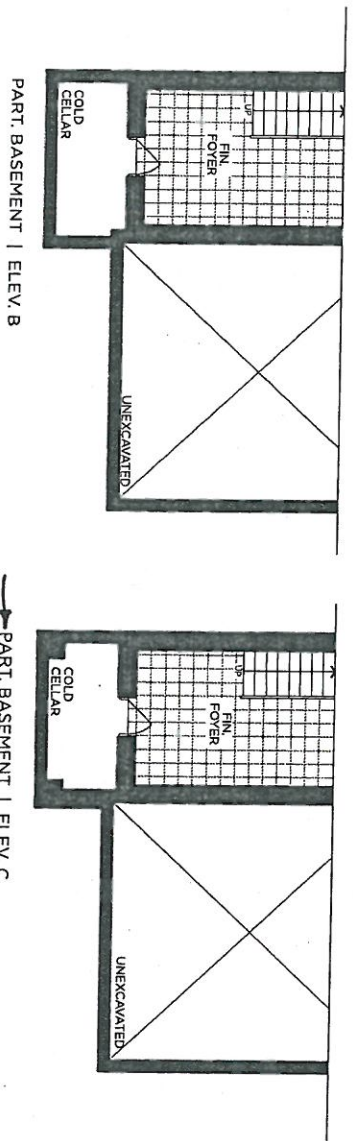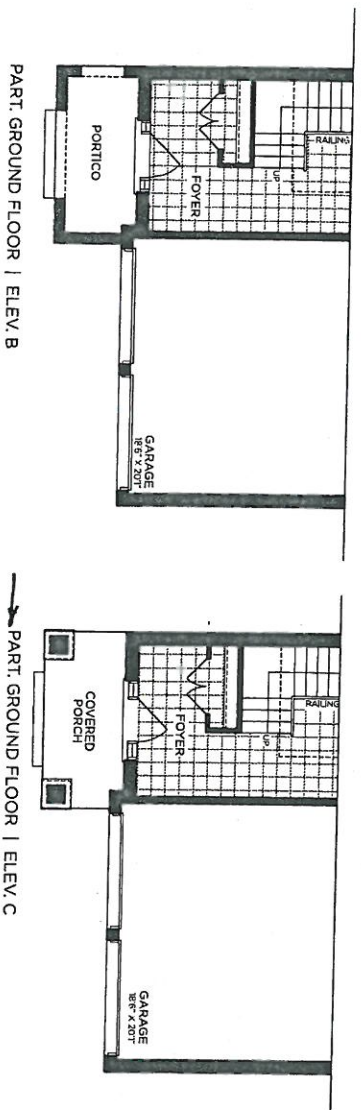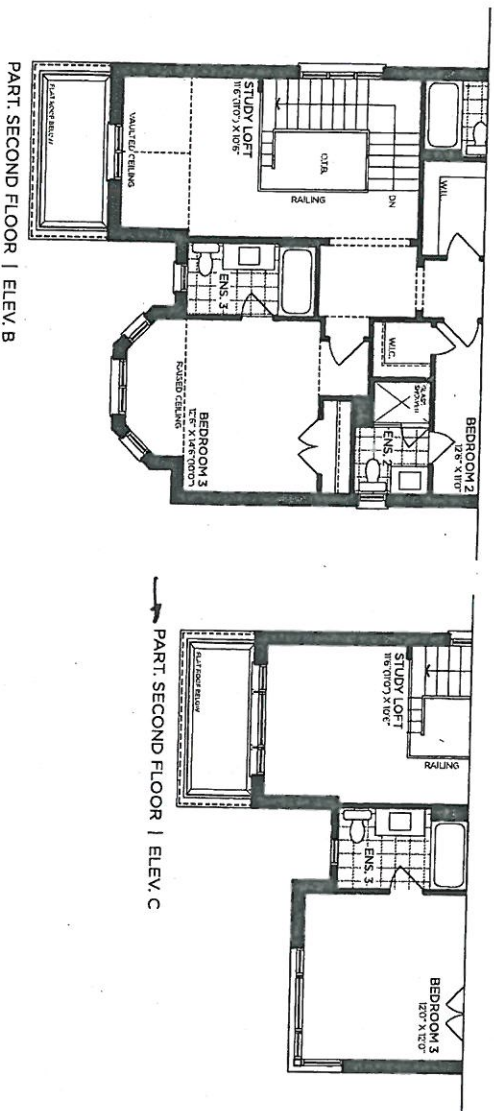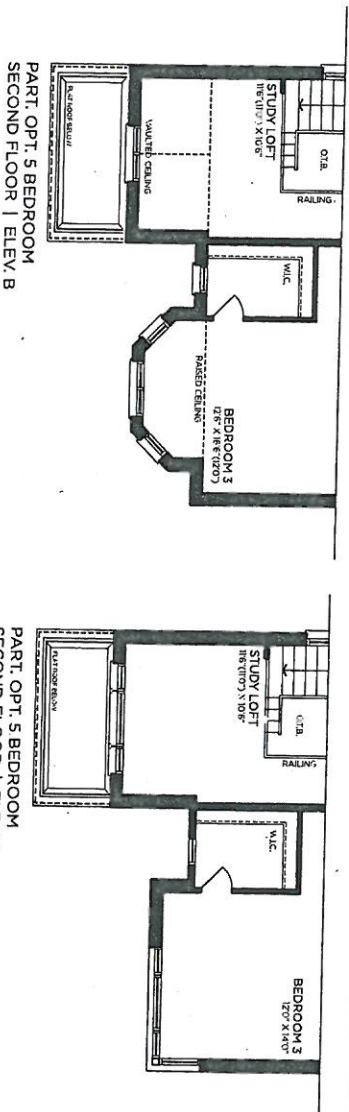

VENDOR
PURCHASER
PURCHASER

GOLDPARK
WORTH MORE™

Prices, figures, illustrations, sizes, features and finishes are subject to change without notice. Areas and dimensions are approximate and actual usable floor space may vary from the stated area. Layout may be reverse of the unit purchased E. & O.E. 4004

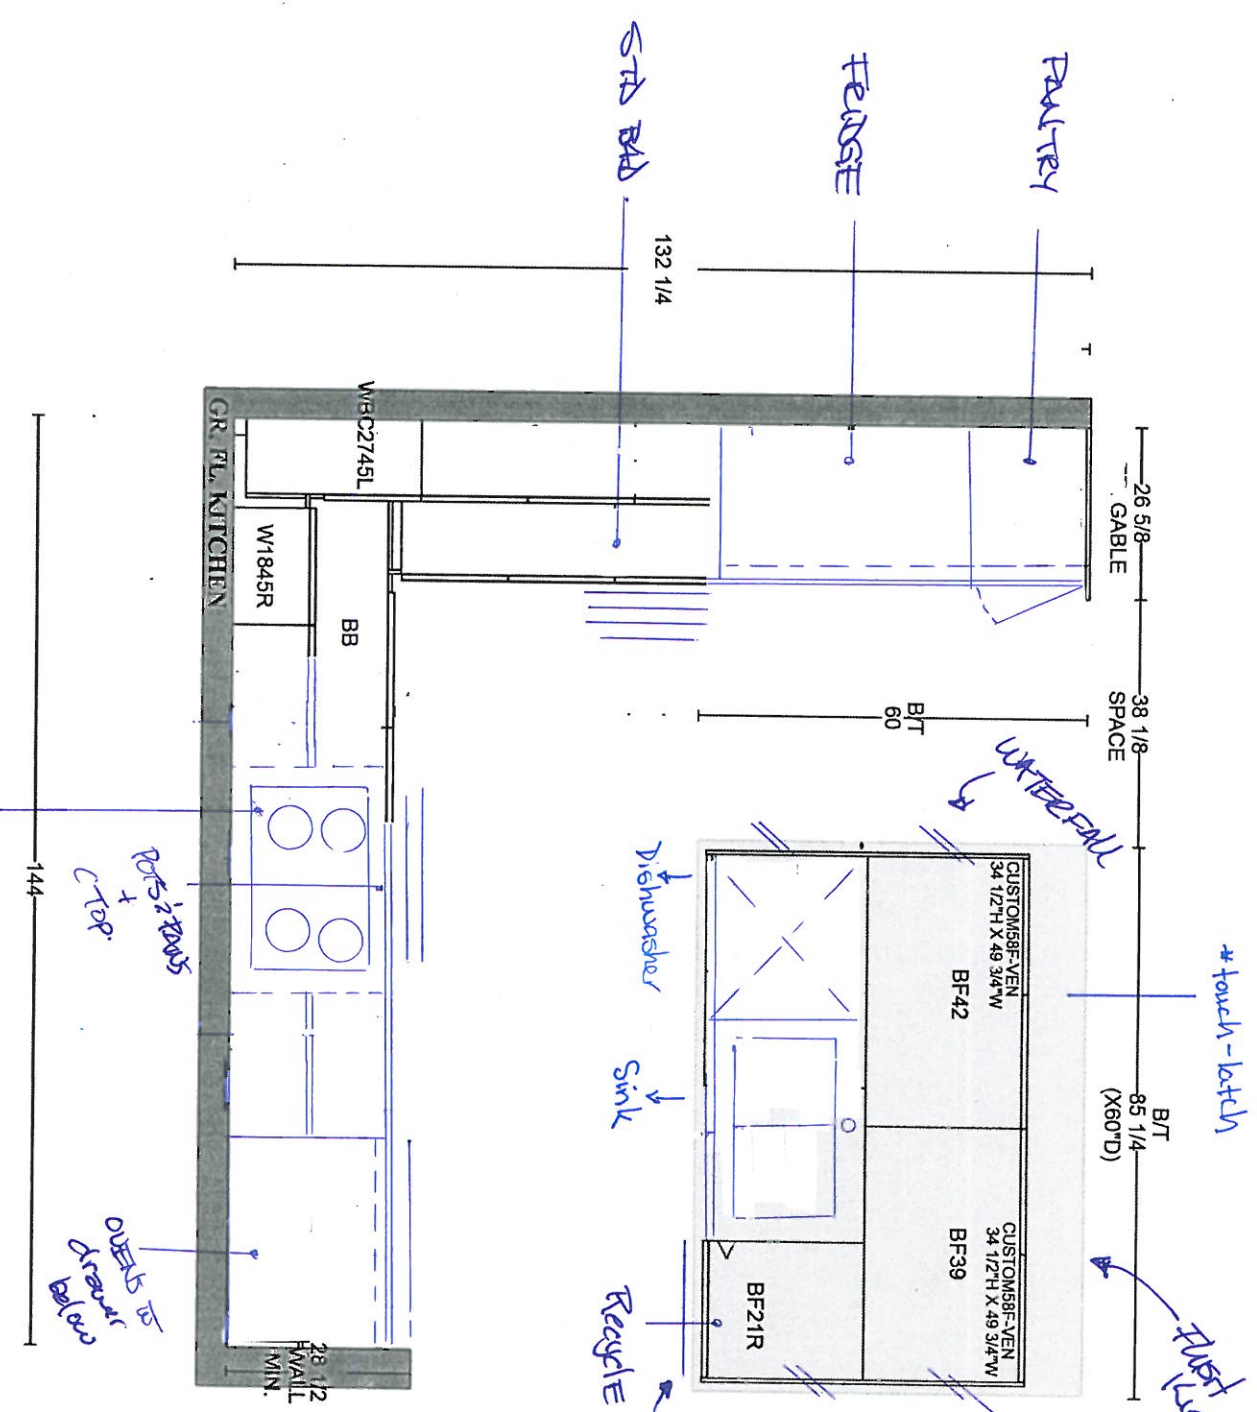

GOLDPARK HOMES
PINE VALLEY
VAUGHAN, ONTARIO
MODEL: (4004) DALEBRIDGE

SITE STANDARD: WHITE 3/4" EXTENSION
SOFT-CLOSE DRAWERS & SOFT-CLOSE
HINGES TO KITCHEN AREA

10' CEILING - 12"H COFFERED CEILING -
M.H. = 102" + 3/4"H CONTEMPORARY
MOLDING + 5 1/4"H FURRING RAIL
+ LARGE CORNICE MOLDING TO
UNDERSIDE OF BOX


PI-39 *attached*
March 19 2022

* Tall/Wipers: Manhattan 'Latic'!
* Base: Manhattan 'Slate Grey Zebrano'!
→ Tall/Wipers/Rear Island: 'touch-latch'!
→ base: H033-01
* return trip for hardwood
* flat furring panel


GOLDPARK HOMES
PINE VALLEY
VAUGHAN, ONTARIO
MODEL: (4004) DALERIDGE

SITE STANDARD: WHITE 3/4" EXTENSION
 SOFT-CLOSE DRAWERS & STANDARD SLAM DOOR HINGES
 TO VANITIES





ONE TOP DRAWER WHERE POSSIBLE THROUGHOUT EACH
 VANITY, ONE BANK OF DRAWERS WHERE POSSIBLE
 THROUGHOUT EACH MASTER ENSUITE VANITY

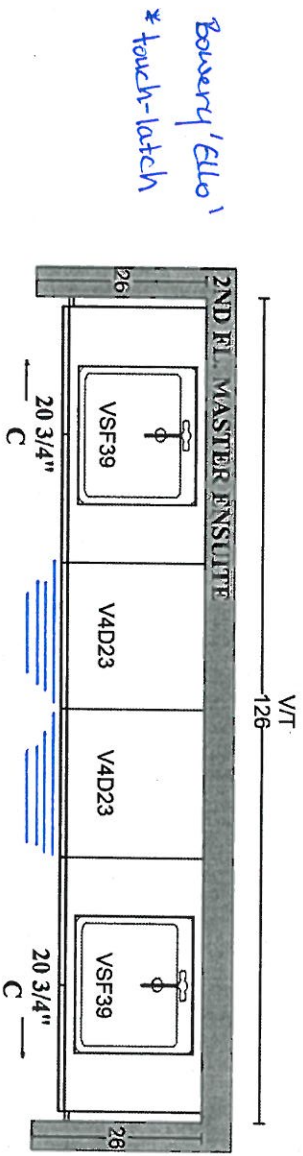

** Quartz over
 Dryer + Washer*

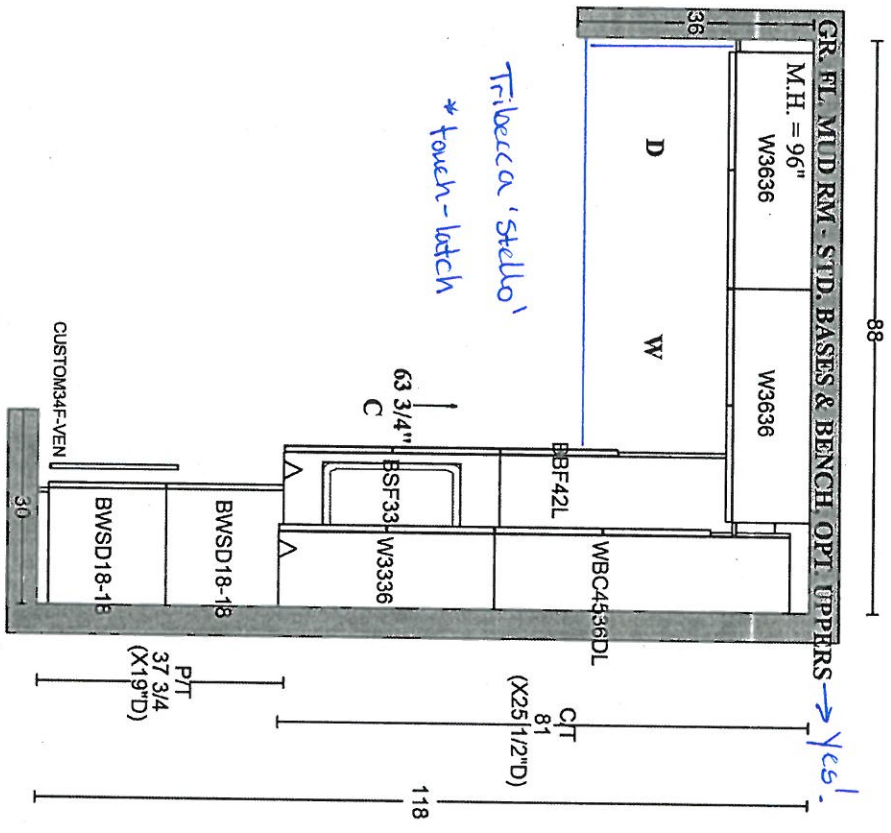

attached
FV-39
Model 19 2021

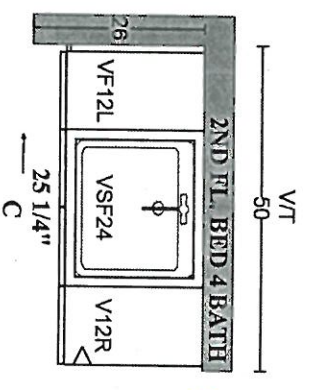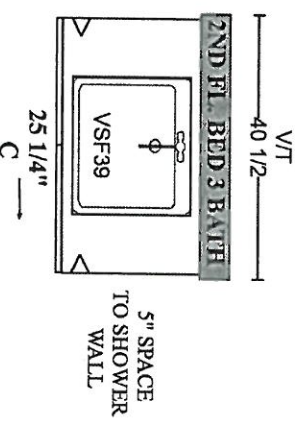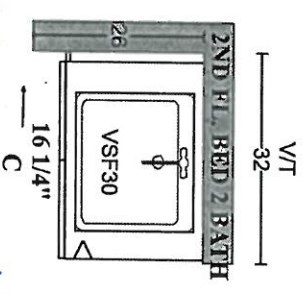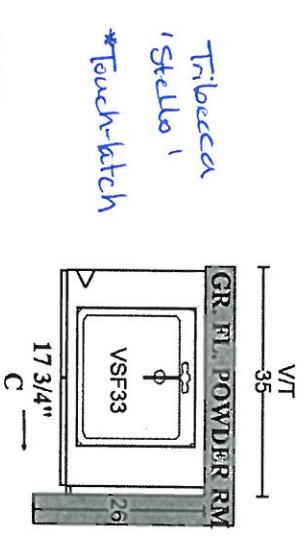

PLAN VIEW



PINE VALLEY
FOREVERGREEN


STONE COUNTERTOP EDGE PROFILES



STANDARD 2CM EASED EDGE

LOCATION:



THRU OUT

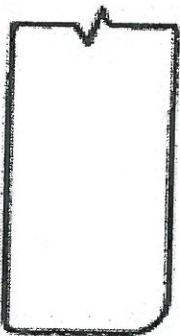

UPGRADE 3CM EASED EDGE


LOCATION:

Kitchen

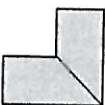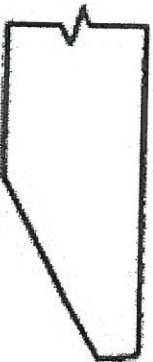

UPGRADE 4CM MITRED EDGE

LOCATION:

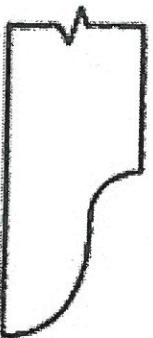

UPGRADE 2CM OGEE EDGE

LOCATION:

LOT #: PV-39

DATE: March 19, 2021

SIGNATURE: Attached

SIGNATURE:



PINE VALLEY
FOREVERGREEN

STANDARD HARDWARE / HANDLES

☐

H001-02

☐

H001-03

☐

H001-04

☐

H009-03

☐

H009-09

☐

H011-03

☐

H011-05

☐

H011-06

☒

H033-01

☐

H039-03

☒

*TOUCH-LATCH

→ ensuite 2

→ ensuite 3

→ ensuite 4

→ plaster ensuite

☐

*NO HARDWARE

→ kitchen (bases only)

↑
Tall/Uppers/Rear

LOT #

PV-39

DATE:

March 19, 2021

SIGNATURE:

attached

SIGNATURE:

GOLDPARK



NOT IN ADOBE



PINE VALLEY
FOREVERGREEN

UPGRADE KITCHEN SINK

BLANCO - QUATRUS R15 U 2
Stainless Steel - Undermount
32" x 18" x 9"

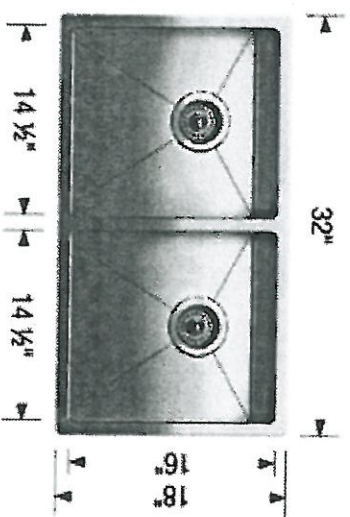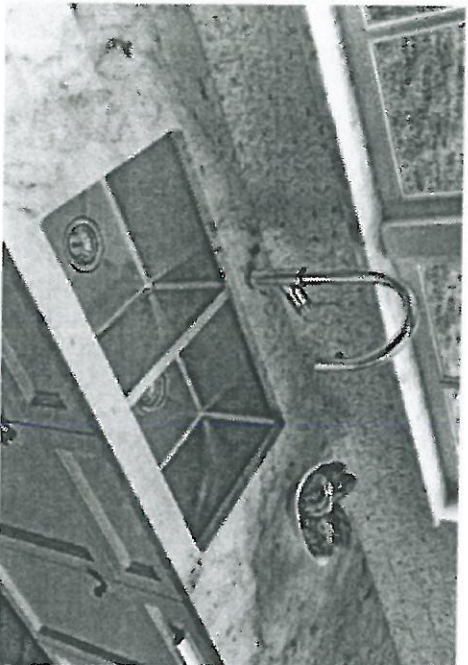

Stainless Steel

☐ GRID — No!

MODEL 401519 Stainless Steel / 406454 Grid

Lot# 39	
Room: Kitchen	Signature: Attached
Date: March 19 2021	Signature:




PINE VALLEY
FOREVERGREEN

UPGRADE KITCHEN FAUCET

MOEN - ALIGN

One-Handle Pulldown Kitchen Faucet

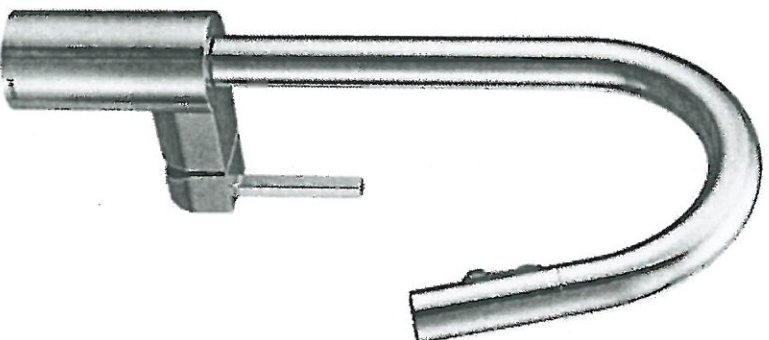

☒ CHROME

☐ STAINLESS (SRS)

☐ MATTE BLACK (BL)

☐ BRUSHED GOLD (BG)

MODEL: 7565 Chrome / 7565SRS Stainless / 7565BL Matte Black / 7565BG Brushed Gold

Lot#

39

Date:

March 19 2021

Room:

Kid Room.

Signature:

Attahud

Signature:

GOLDPARK



WORTH MORE



PINE VALLEY
FOREVERGREEN

UPGRADE LAUNDRY SINK

BLANCO - QUATRUS R15 LAUNDRY
Stainless Steel - Dual-Mount
25" x 22" x 12"

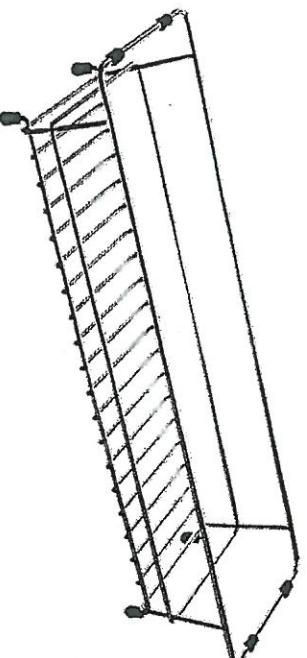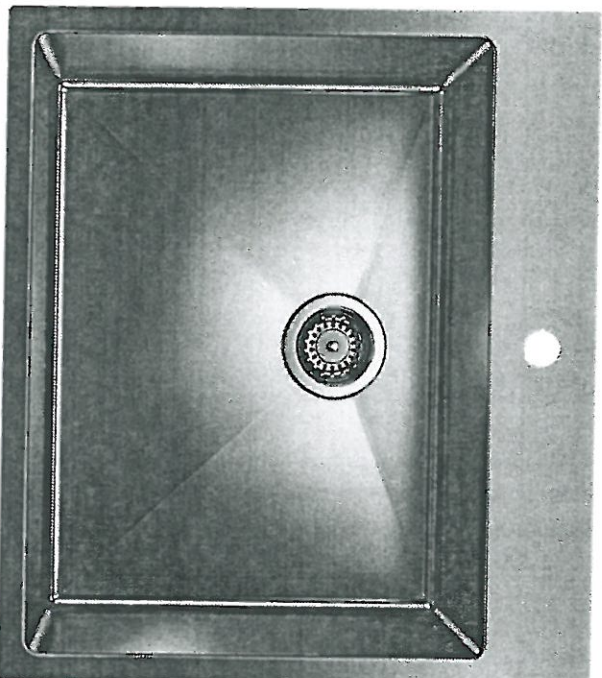

Stainless Steel

☐ LAUNDRY RACK x10

MODEL 401802 Stainless Steel / 401952 Grid


Lot# <u>39</u>		
Room: <u>Mud Room</u>	Signature: <u>attached</u>	
Date: <u>March 19, 2021</u>	Signature:	

UPGRADE SHOWER HARDWARE



SQ6X6

Shower Door Handle

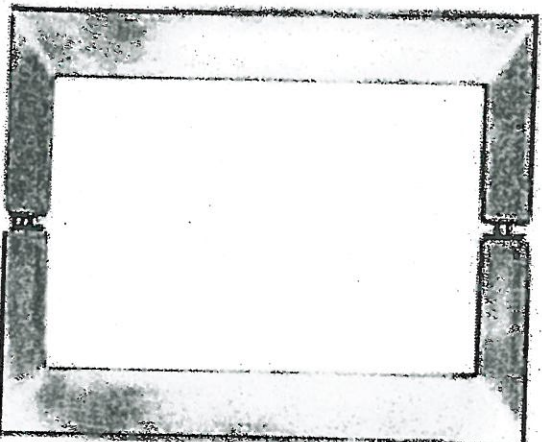

SQ6X6

Shower Door Handle

6" x 6" back-to-back
3/4" square tube

(Also available single sided)

☒ CHROME

☐ MATTE BLACK

Lot#

39

Date:

March 19 2021

Room:

MASTER + ENS 2.

Signature:


attached

Signature:


BATHROOM ACCESSORIES



PINE VALLEY
FOREVERGREEN

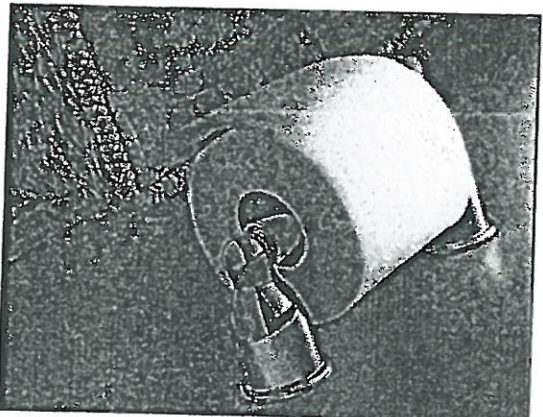

Tissue Holder
Mason - Chrome

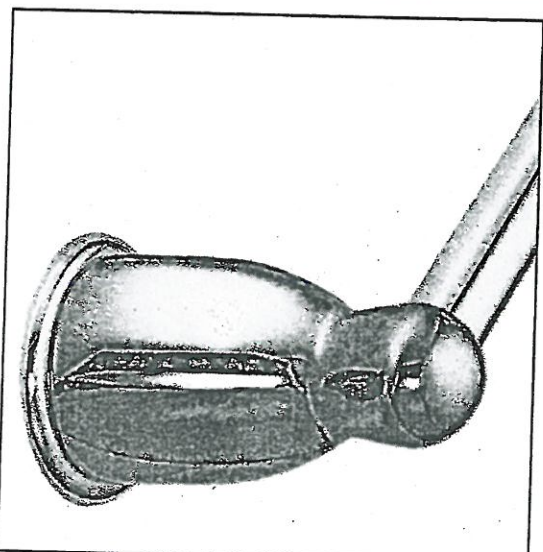

Towel Bar
Mason - Chrome

Please select one of the following:

- ☐ INSTALL STANDARD BATHROOM ACCESSORIES THRU OUT
(tissue holder + towel bar) **location as per vendors discretion**
- ☐ ***DO NOT*** INSTALL STANDARD BATHROOM ACCESSORIES
THRU OUT **tissue holder + towel bar will not be provided**

LOT #

PV-39

DATE:

March 19, 2021

SIGNATURE:

attached

SIGNATURE:



Project: Pine Valley

Lot: 39

Purchaser(s): Jonathan Piccin

Standard Hood Fan Deletion


We acknowledge that the builder's standard hood fan will not be installed.
Do not supply, install and/or credit. We will install our own hood fan after closing.

Signature: 

Signature: _____

Date: March 19, 2021

Range Hood - Mitred Square

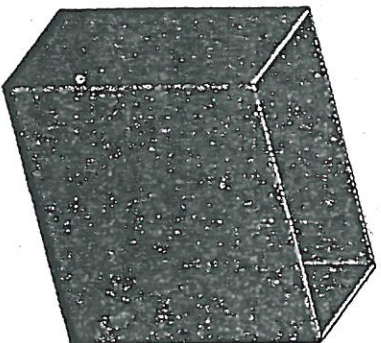

Lot#

8V-39

Room:

Kitchen

Date:

March 19, 2021

Signature:

attached

Signature:

Purchaser: JONATHAN, VICTOR, BOTTOS PICCIN

Property: 39 of Plan -

Telephone Res. / Bus: (416) 564-1027 / (416) 564-1027

Project: Pine Valley Forevergreen - Phase 1

Decor Advisor: Yolande Somerville

Model and Elevation: 40.04 C DALERIDGE

Layout Changes: ☐ Yes ☒ No

Sketch Attached: ☒ Yes ☐ No

Exterior Colour Scheme:

1. Cabinetry

	Style and Colour	Counter	Hardware
Kitchen / Breakfast	*2-TONE	*Quartz: Calacatta Nuvo	attached
Laundry Room	Tribeca 'Stello' (mud room)	*Quartz: Alpine Mist	attached
Powder Room	Tribeca 'Stello'	*Quartz: Alpine Mist	attached
Ensuite 3	Tribeca 'Stello'	*Quartz: Ariel	attached
Master Ensuite Bathroom	Bowery 'Elio'	*Quartz: Ariel	attached
Second Ensuite Bathroom (If Applicable)	Modena 'Classic White'	*Quartz: Symphony Grey	attached
Ensuite 4	Modena 'Classic White'	*Quartz: Symphony Grey	attached

Comment

Kitchen: Tall / upper: Manhattan 'Lette' // Base: Manhattan Zebra // 'Slate Grey'

2. Floor Tile

	Selection
Entrance Vestibule	hardwood
Main Hall	
Kitchen / Breakfast	hardwood
Laundry Room	*12x24" Design Industry 'Raw Light Pearl' (mud room)
Powder Room	*12x24" Design Industry 'Raw Light Pearl'
Ensuite 3	*Hex Roma 'Statuario'
Master Ensuite Bathroom	*12x24" Eterna Medium Grey matte
Second Ensuite Bathroom (If Applicable)	*12x24" Reve 'Fumee'
Lower Landing (If Applicable)	*13x13" Costa matte white (basement foyer)
Ensuite 4	*12x24" Eterna Medium Grey matte

Comment

Shower Floor: Master Ensuite - Eterna 'med grey' matte honingbone // Ensuite 2 - 2x2" Ontario 'Taupa'

3. Wall Tile

	Selection	Listello/Inserts	Describe
Ensuite 3	*2x16" CDC Arctic White matte	☐ Yes ☒ No	
Master Ensuite Bathroom			
Tub Deck		☐ Yes ☒ No	
Shower Stall	*3x12" Roma 'Statuario'	☐ Yes ☒ No	
Bathroom Walls		☐ Yes ☒ No	
Second Ensuite Bathroom (If Applicable)	*8x8" Marakesh 'Light Grey Matte'	☐ Yes ☒ No	
Ensuite 4	*12x24" Arkistone 'Silver mt decor'	☐ Yes ☒ No	
Kitchen Backsplash	☒ Yes ☐ No		Backsplash Behind Fridge

Comment

*FHBS - slab same as counter

SP.

Purchaser: JONATHAN, VICTOR, BOTTOS PICCIN

Property: 39 of Plan -

Telephone Res. / Bus: (416) 564-1027 / (416) 564-1027

Project: Pine Valley Forevergreen - Phase 1

Decor Advisor: Yolande Somerville

Model and Elevation: 40.04 C DALERIDGE

4. Plumbing Fixtures

Master Ensuite Bathroom	Second Ensuite	Powder Room
Other Room - Specify	Other Washroom	
Comment See extras		

5. Hardwood Flooring

	Type and Stain		Type and Stain
Main Hall		Upper Landing	
Kitchen / Breakfast	*3/4x5" Wht oak wirebrush 'Orion'	Upper Hall	
Living Room		Master Bedroom	
Dining Room		Bedroom #2	
Family Room		Bedroom #3	
Den/Library		Bedroom #4	
Entrance Vestibule	*3/4x5" Wht oak wirebrush 'Orion'	Bedroom #5	
Lower Landing (If Applicable)		Other Room - Specify	*3/4x5" Wht oak wirebrush 'Orion'
Comment		Thru out standard area	

6. Carpeting

	Upgrade	Description
Ground Floor	☐	
Second Floor	☐	
Upgrade Underpad Type: Area:		
Carpet on Stairs Capped: Runner - *Upgrade:		
Comment		

7. Fireplace

	Living Room	Family Room	Other Room - Specify
	Purchased	As Per Plan	N/A
Fireplace Type	☐	☒	☐
Mantle Type	☐	☒	☐
Colour / Stain	☐	☒	☐
Surround	☐	☒	☐
Hearth	☐	☒	☐
Comment 			

Purchaser: JONATHAN, VICTOR, BOTTOS PICCIN Property: 33 of Plan -
Telephone Res. / Bus: (416) 564-1027 / (416) 564-1027 Project: Pine Valley Forevergreen - Phase 1
Decor Advisor: Yolande Somerville Model and Elevation: 40.04 C DALERIDGE

8. Trim Carpentry

Interior Doors *Lincoln Park Front Door Glass Inserts Standard Door Handles *Halifax brand + hng
Interior Trim *Board 3
Comment

9. Plaster Mouldings and Medallions

Standard Throughout ☐ Yes ☐ No ☒ N/A

Entrance Vestibule			Kitchen/Breakfast		
Main Hall			Den/Library		
Living Room			Lower Landing		
Dining Room			Other Room - Specify		
Family Room					
Comment					

10. Railings and Spindles

Railing Package *Glass Railing Package
Railing Colour Stainless Spindle Colour *glass
Stringer / Riser *Rio - mirage Treads *Rio - mirage
Oak Stairs ☐ Yes ☐ No ☐ N/A
Comment

11. Wall Paint / Ceilings

Throughout Finished Areas Cool White
Trim Paint White
Smooth Ceilings
Ground Floor ☒
Second Floor ☒
Note

Comment

DP

Purchaser: JONATHAN, VICTOR, BOTTOS PICCIN

Property: 39 of Plan -

Telephone Res. / Bus: (416) 564-1027 / (416) 564-1027

Project: Pine Valley Forevergreen - Phase 1

Decor Advisor: Yolande Somerville

Model and Elevation: 40.04 C DALERIDGE

12. Electrical

Hood Fan ☐ White ☐ Stainless ☒ N/A

Above Kitchen Cabinet Light ☐ Yes ☒ No

Below Kitchen Cabinet Light ☐ Yes ☒ No

Standard Appliances ☐

Over The Range Microwave ☐

Chimney Style Fan ☐

Comment

13. Heating and Air Conditioning

Air Conditioning ☒ yes

Gas Provisions Stove ☒ no

Gas Provisions Dryer ☒ no

Gas Provisions Barbecue ☒ std

Comment

14. Additional Comments

15. Disclaimers and Notes

- Colours of all materials are as close as possible to builder's selection, but not necessarily identical due to variances in manufacturing.
- Any extras listed above are null and void unless accompanied by a separate invoice/amendment. Said invoice must be paid in full.
- The Purchaser acknowledges that after Interior Colour Selection form is signed and dated, no further changes will be permitted other than re-selection due to unavailability. Purchaser's Initials _____
- The Purchaser acknowledges reading and accepting the "Gold Park Homes Decor Centre Disclaimers" form. This document contains other miscellaneous disclaimers.

This Interior Colour Selection is final and approved by:

Signature: 

Date: March 19, 2021



PV-39 Cabinetry Schedule

ITEM	DESCRIPTION	PRICE	QTY	TOTAL
BEDROOM	UPGRADE FROM SERIES 9 TO SERIES 3 - MANHATTAN LATTE (TALL - UPPERS)	1,418.60	1	\$ 1,418.60
	UPGRADE FROM SERIES 9 TO SERIES 3 - MANHATTAN SLATE GRAY (BEDROOM (BUSES))	3,187.20	1	\$ 3,187.20
	TOUCH LATCH HARDWARE TO TALL - UPPERS	1,155.00	1	\$ 1,155.00
	STANDARD HARDWARE TO BUSES - NOSS (B. DUTY)	-	1	\$ -
	RETURN TRIP FOR HARDWARE	1,000.00	1	\$ 1,000.00
	FLUSH BIN IN BUILT-IN CROWN MOLDING (BUILT)	-	1	\$ -
	TOUCH LATCH HARDWARE AT BUILT-IN BUILT	500.00	1	\$ 500.00
	FLUSH BIN AT BUILT-IN BUILT	500.00	1	\$ 500.00
	ALSO TWO BIN RECIPE CENTRE AT BUILT-IN BUILT TOP DUNNIP PANEL FOR PLUS	2,500.00	1	\$ 2,500.00
	TAKE DOWN HARDWARE TO BUILT-IN BUILT, AND BUILT-IN BUILT TO BUILT-IN BUILT (BUILT)	-	1	\$ -
	CONVERT CABINETS TO TALL, BUILT-IN BUILT, BUILT-IN BUILT, BUILT-IN BUILT, BUILT-IN BUILT	2,488.00	1	\$ 2,488.00
	CONVERT CABINETS TO TALL, BUILT-IN BUILT, BUILT-IN BUILT, BUILT-IN BUILT, BUILT-IN BUILT	1,520.00	1	\$ 1,520.00
MASTER SUITE	ADD TOUCH LATCH HARDWARE	900.00	1	\$ 900.00
				\$ 900.00
ENCLAVE 2	ADD TOUCH LATCH HARDWARE	285.00	1	\$ 285.00
				\$ 285.00
ENCLAVE 3	ADD TOUCH LATCH HARDWARE	265.00	1	\$ 265.00
				\$ 265.00
ENCLAVE 4	ADD TOUCH LATCH HARDWARE	300.00	1	\$ 300.00
				\$ 300.00
POWDER ROOM	ADD TOUCH LATCH HARDWARE	165.00	1	\$ 165.00
				\$ 165.00
MUD ROOM	ADD TOUCH LATCH HARDWARE - TRIPPLICA STEEL	2,488.00	1	\$ 2,488.00
	ADD TOUCH LATCH HARDWARE	400.00	1	\$ 400.00
	ADD ISLANDS TO SUPPORT ISLANDS (BUILT-IN BUILT)	500.00	1	\$ 500.00
	ADD TOUCH LATCH HARDWARE	1,155.00	1	\$ 1,155.00
CABINETS TOTAL:				\$ 23,925.20

HANDLE PLACEMENT AT INSTALLERS DISCRETION

LOT #:	PV-39	DATE:	March 19, 2021
SIGNATURE:	SP		
SIGNATURE:			

GOLD P.S.S.

REVISED:
2/22/09-18




PV-39
FEB 26 2021

PV-39
MARCH 17 2021 J.P.

SCHEDULE 'F'

The Daleridge 40' SERIES

Elevation A • 3,335 sq.ft.
Elevation B • 3,395 sq.ft.
→ Elevation C • 3,370 sq.ft.

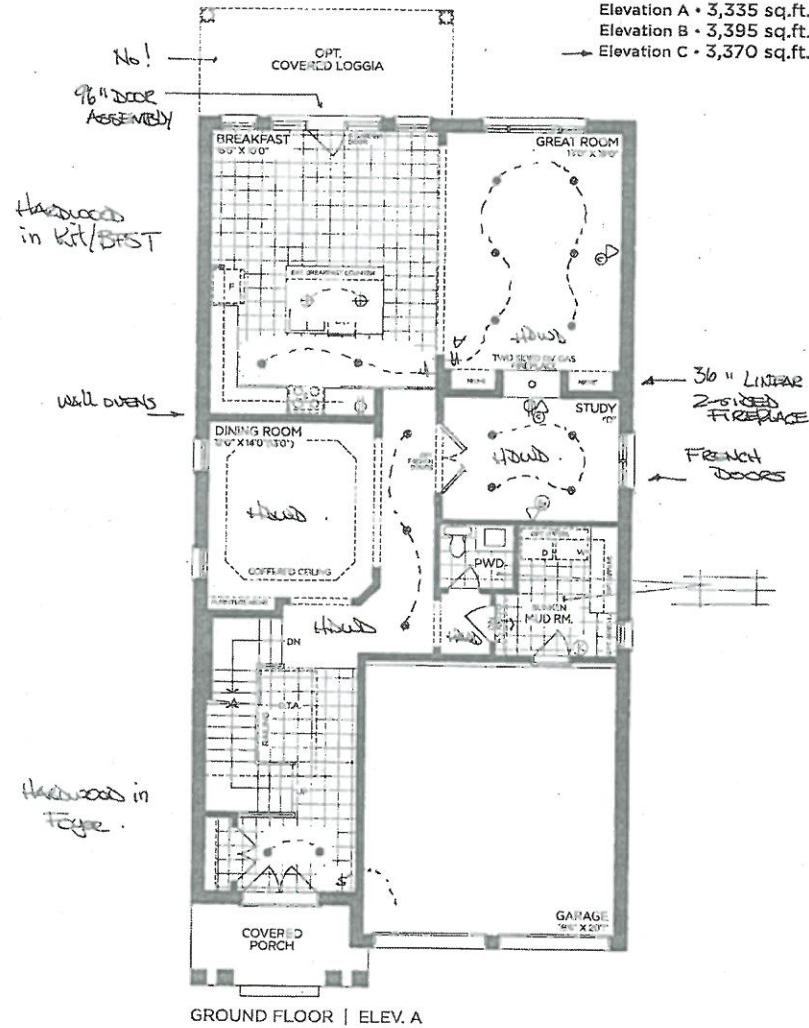

VENDOR
PURCHASER
PURCHASER

GOLDPARK
WORTH MORE

Prices, features, illustrations, sizes, features and finishes are subject to change without notice. Areas and dimensions are approximate and actual usable floor space may vary from the stated area. Layout may be reverse of the unit purchased. E & C.E. 1004



NO PHONES
THRU OUT

SCHEDULE 'F'

PV-30
FEB 26 2021

PV-30
MAR 19 2021


The Daleridge

40' SERIES

Elevation A • 3,335 sq.ft.

Elevation B • 3,395 sq.ft.

Elevation C • 3,370 sq.ft.

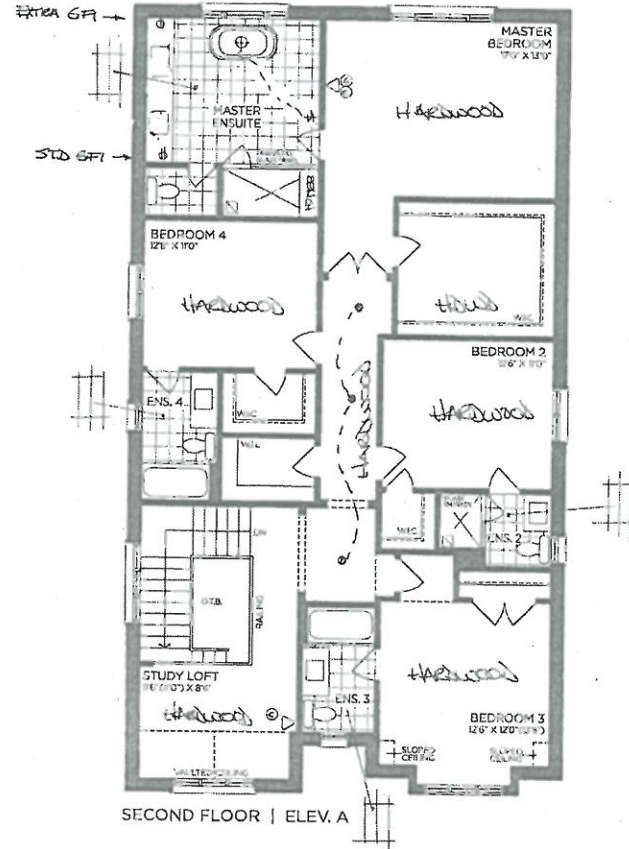

VENDOR
PURCHASER
PURCHASER


GOLDPARK
WORTH MORE™

Prices, figures, illustrations, notes, features and finishes are subject to change without notice. Areas and dimensions are approximate and actual usable floor space may vary from the stated area. Layout may be reverse of the unit purchased. I. & G.E. 4004



SCHEDULE 'F'
PV-30. 38.
~~26~~ 26 2021
PV-30
March 19 2021 JP

The
Daleridge
40' SERIES
Elevation A • 3,335 sq.ft.
Elevation B • 3,395 sq.ft.
→ Elevation C • 3,370 sq.ft.

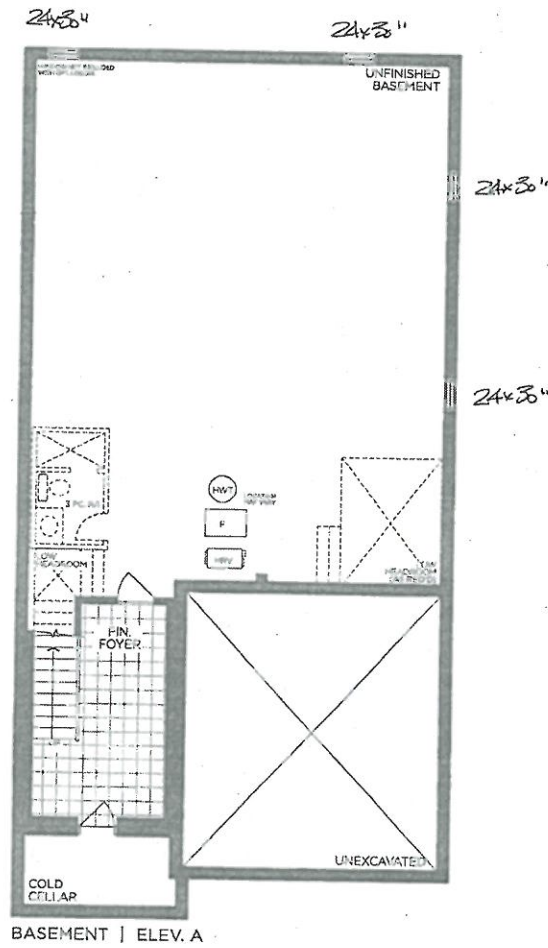

VENDOR
PURCHASER
PURCHASER

GOLDPARK
WORTH MORE™

Prices, figures, illustrations, views, features and finishes are subject to change without notice. Areas and dimensions are approximate and actual usable floor areas may vary from the stated area. Layout may be reverse of the unit purchased. E & QJ 4004

SCHEDULE 'F'











PV-30
FEB 26 2021 SP.
PV-30
MARCH 19 2021 J.P.

The Daleridge

40' SERIES


Elevation A • 3,335 sq.ft.
Elevation B • 3,395 sq.ft.
→ Elevation C • 3,370 sq.ft.

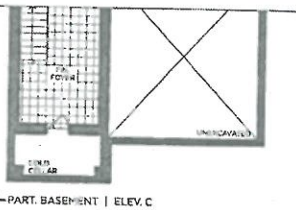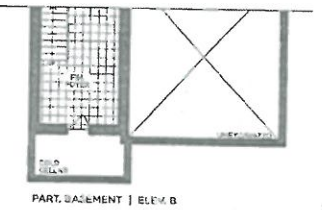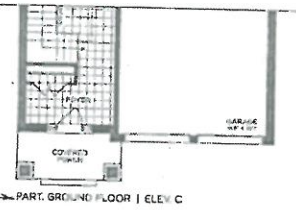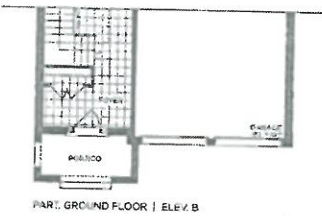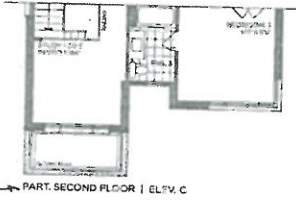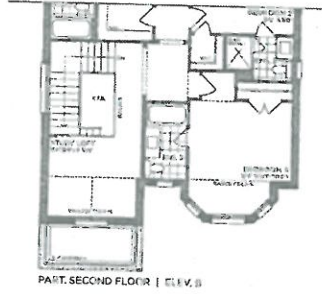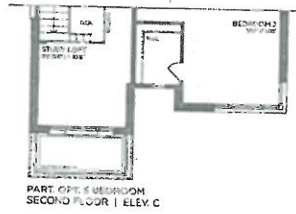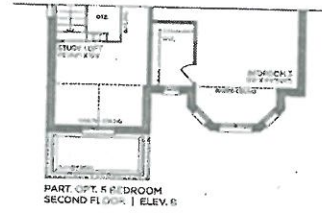

VENDOR
PURCHASER
PURCHASER



GOLDPARK
WORTH MORE™

Prices, figures, illustrations, sizes, features and finishes are subject to change without notice. Areas and dimensions are approximate and actual usable floor space may vary from the stated area. Layout may be reverse of the unit purchased. E & C.E. 4004




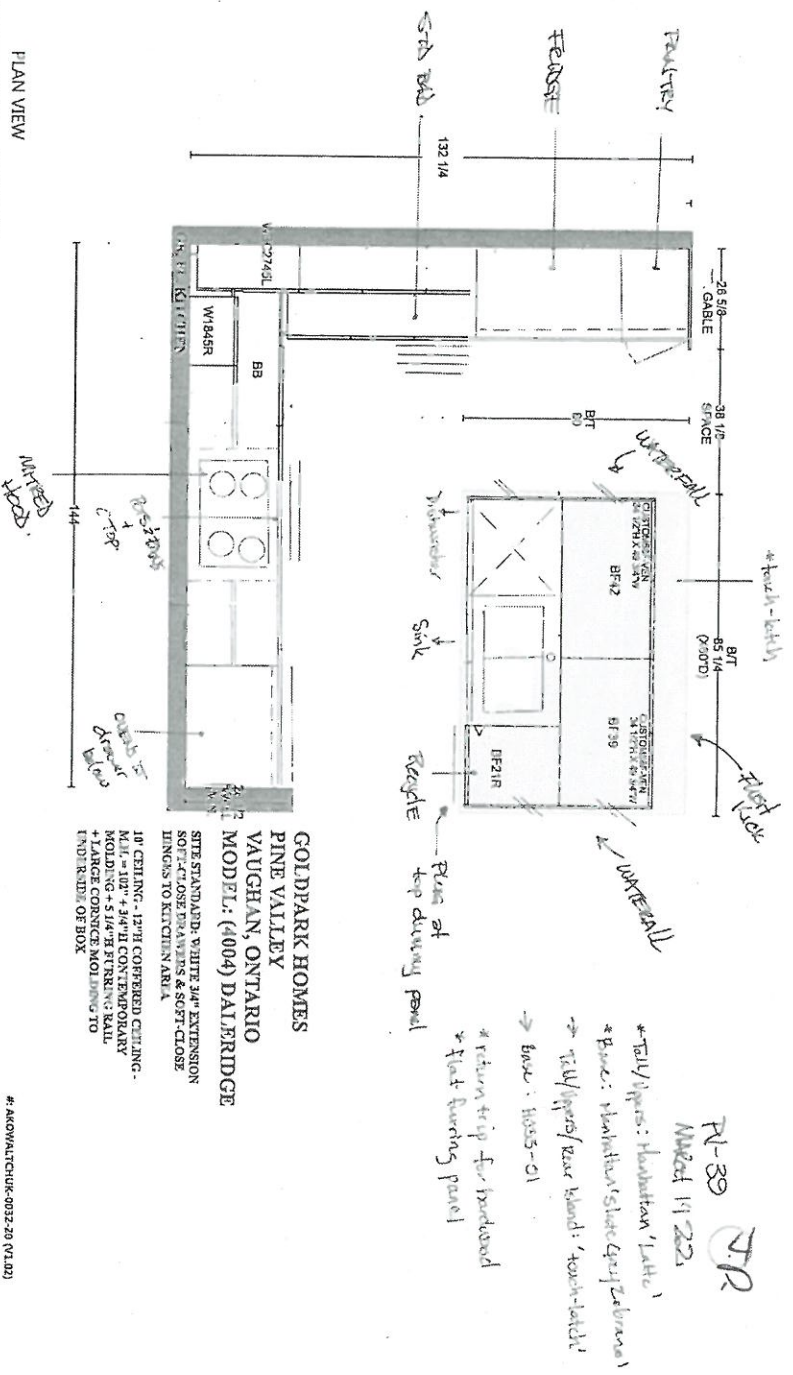


GOLDPARK HOMES
PINE VALLEY
VAUGHAN, ONTARIO
MODEL: (4004) DALLERIDGE

SITE STANDARD: WHITE 3/4" EXTENSION
SOFT-CLOSE DRAWERS & STANDARD SLAM DOOR HINGES
TO VANITIES
O/E TOP DRAWER WHERE POSSIBLE THROUGHOUT EACH
VANITY, ONE BANK OF DRAWERS WHERE POSSIBLE
THROUGHOUT EACH MASTER ENSUITE VANITY

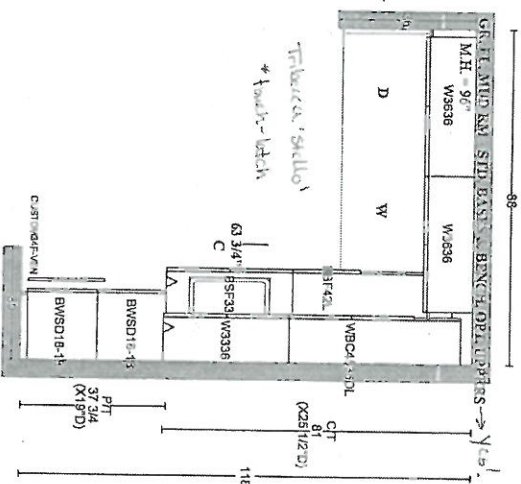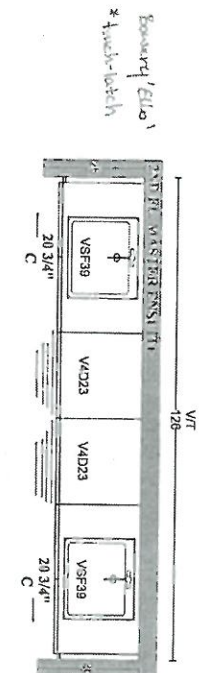

TV-39
NWB 19 2021

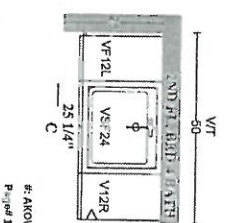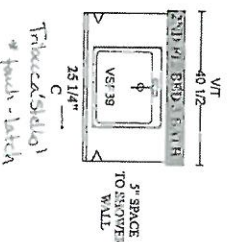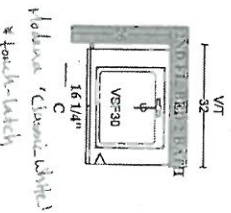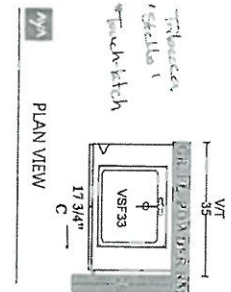

F: AROMATYCHUK-003, 20 (N.M.D.)
P: 19/22

STONE COUNTERTOP EDGE PROFILES



STANDARD 2CM EASED EDGE

LOCATION:

THROAT



UPGRADE 3CM EASED EDGE

LOCATION:


Kitchen



UPGRADE 4CM MITRED EDGE



LOCATION:

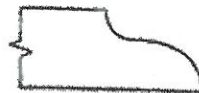

UPGRADE 2CM OGEE EDGE

LOCATION:

LOT #: PV-39	DATE: March 19, 2021
SIGNATURE: <i>[Signature]</i>	
SIGNATURE: _____	

STANDARD HARDWARE / HANDLES



☐ H001-02



☐ H001-03



☐ H001-04



☐ H009-03



☐ H009-09



☐ H011-03



☐ H011-05



☐ H011-06



☒ H033-01



☐ H039-03



☒ *TOUCH-LATCH

→ ensuite 2

→ ensuite 3

→ ensuite 4

→ Master Ensuite

☐ *NO HARDWARE

Tail/Upper/Rear

→ Kitchen (kitchens only)

LOT # PY-39

DATE: March 19, 2021



SIGNATURE: *JP*

SIGNATURE:

UPGRADE KITCHEN SINK



BLANCO - QUATRUS R15 U 2
 Stainless Steel - Undermount
 32" x 18" x 9"

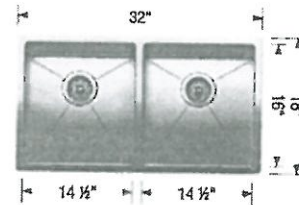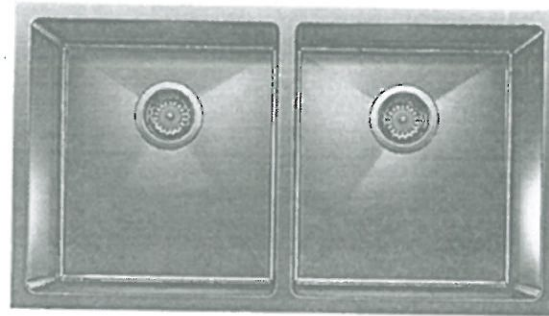

Stainless Steel

☐ GRID — No!

MODEL 401519 Stainless Steel / 406454 Grid

Lot# 39	
Room: KITCHEN	Signature: <i>[Signature]</i>
Date: MAR 19 2021	Signature: <i>[Signature]</i>

UPGRADE KITCHEN FAUCET




MOEN - ALIGN

One-Handle Pulldown Kitchen Faucet



- ☒ CHROME
- ☐ STAINLESS (SRS)
- ☐ MATTE BLACK (BL)
- ☐ BRUSHED GOLD (BG)



MODEL: 7565 Chrome / 7565SRS Stainless / 7565BL Matte Black / 7565BG Brushed Gold

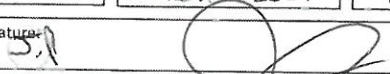Lot# 39	Date: March 17, 2021	Room: Kids Room
Signature: 		
Signature:		

UPGRADE LAUNDRY SINK



BLANCO - QUATRUS R15 LAUNDRY
Stainless Steel - Dual-Mount
25" x 22" x 12"

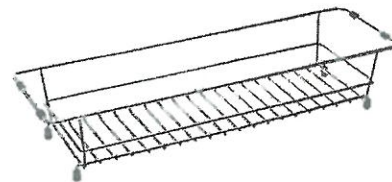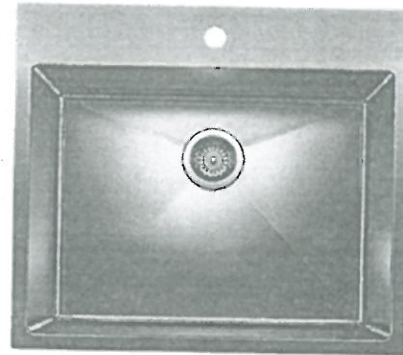

Stainless Steel

☐ LAUNDRY RACK ~~no~~

MODEL 401802 Stainless Steel / 401952 Grid

Lot# 39	
Room: Mud Room	Signature: S.D.
Date: March 17 2022	Signature:


GOLDPARK
WORTH ADIR

UPGRADE SHOWER HARDWARE



SQ6X6

Shower Door Handle

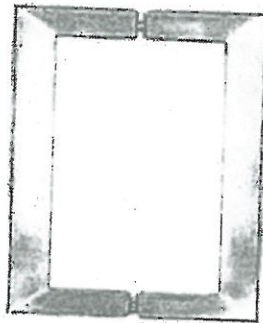

SQ6X6
Shower Door Handle
6" x 6" back-to-back
3/4" square tube
(Also available single sided)

☒ CHROME
☐ MATTE BLACK


Lot# 33	Date: March 19, 2021	Room: MASTER + ENS 2.
Signature: SP.		
Signature:		

GOLDPARK

BATHROOM ACCESSORIES



Tissue Holder
Mason - Chrome

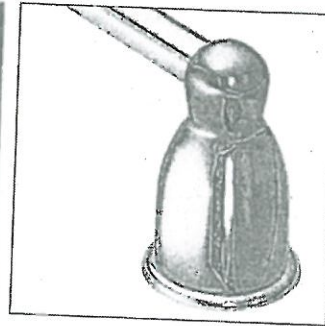

Towel Bar
Mason - Chrome

Please select one of the following:

- ☒ INSTALL STANDARD BATHROOM ACCESSORIES THRU OUT
(tissue holder + towel bar) **location as per vendors discretion**
- ☐ ***DO NOT*** INSTALL STANDARD BATHROOM ACCESSORIES
THRU OUT **tissue holder + towel bar will not be provided**

LOT # PV-39	DATE: March 19, 2021
SIGNATURE: 	
SIGNATURE:	




Project: Pine Valley

Lot: 39

Purchaser(s): Jonathan Piccin

Standard Hood Fan Deletion

We acknowledge that the builder's standard hood fan will not be installed.
Do not supply, install and/or credit. We will install our own hood fan after closing.

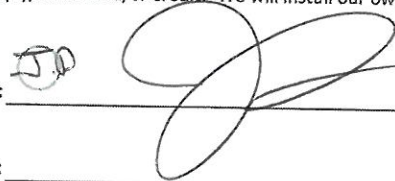Signature: 


Signature: _____

Date: March 17, 2021



Range Hood - Mitred Square

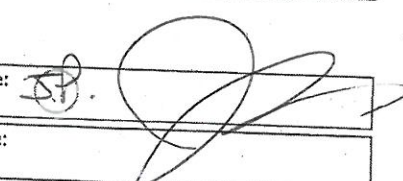

Lot#	8V-39	Signature:	
Room:	Kitchen	Signature:	
Date:	March 19, 2021	Signature:	