

APPLIANCES

Invoice	Qty.	Description
2612	1	APPLIANCE SPECIFICATIONS - SIGNED
26Feb21 NoCat		

BASEMENT WINDOWS

Invoice	Qty.	Description
2626 72,351 10Mar21	3	BASEMENT WINDOWS - UPGRADE BASEMENT WINDOW SIZE TO 30 " X 24" - 8" FRAME

DRYWALL

Invoice	Qty.	Description
2626 72,351 10Mar21 **	3	BASEMENT WINDOWS - UPGRADE BASEMENT WINDOW SIZE TO 30 " X 24" - 8" FRAME
2619 101,930 24Mar21	1	GREAT ROOM: DELETE STANDARD FIREPLACE - EXTERIOR BUMPOUT TO REMAIN - INTERIOR TO BE DRYWALLED PAINTED FLAT FINISH INCLUDING STANDARD TRIM
2619 24Mar21 NoCat	1	**CUSTOM LAYOUT** MUDROOM: DELETE STANDARD CLOSET
2619 24Mar21 NoCat	1	FYI - GARAGE: INCREASED HEIGHT TO MAN DOOR FROM HOUSE TO GARAGE [32 X 94] TALL HEIGHT * WOOD FRAME - IF GRADE PERMITS [EACH]
2619 24Mar21 NoCat	1	**CUSTOM LAYOUT** MASTER BEDROOM WIC: MOVE WALL OF WIC APPROX. ONE (1) FOOT INTO MASTER BEDROOM SPACE. MOVE WALL OF WIC BACKING ONTO BEDROOM 2 APPROX. TWO (2) FEET INTO BEDROOM 2 SPACE - SEE PLAN FOR LAYOUT WIC INCREASED IN WIDTH BY APPROX. THREE (3) FEET

ELECTRICAL

Invoice		Qty.	Description
2626 72,351 10Mar21	3		BASEMENT WINDOWS - UPGRADE BASEMENT WINDOW SIZE TO 30 " X 24" - 8" FRAME
**			
2619 72,278 24Mar21	1		FRONT PORTICO: DELETE STANDARD COACH LIGHT - SWITCH TO REMAIN FOR CAPPED CEILING LIGHT FIXTURE CENTERED ON CEILING OF PORTICO - SEE PLAN
2619 72,278 24Mar21	1		FOYER: ADDITIONAL INTERIOR SWITCH FOR EXTERIOR POT LIGHT IN CORNER OF UPPER SOFFIT
2619 72,278 24Mar21	1		BREAKFAST: ADDITONAL INTERIOR SWITCH FOR EXTERIOR POT LIGHT IN CORNER OF UPPER SOFFIT
2619 72,291 24Mar21	1		FRONT EXTERIOR: LED SOFFIT POT LIGHT ON SEPARATE SWITCH - SEE PLAN FOR LOCATION
2619 72,291 24Mar21	1		REAR EXTERIOR: LED SOFFIT POT LIGHT ON SEPARATE SWITCH - SEE PLAN FOR LOCATION
2619 72,280 24Mar21	1		FRONT PORTICO: INSTALL CAPPED CEILING FIXTURE CENTERED ON PORTICO CEILING ON EXISTING SWITCH - SEE PLAN
2619 72,269 24Mar21	2		GARAGE: INTERIOR WALL OUTLET: 110V WALL INTERIOR RECEPTACLE ON SEPARATE CIRCUIT - APPROX 8" A.F.F. - SEE PLAN FOR LOCATION
2619 72,273 24Mar21	1		KITCHEN: 110V WALL RECEPTACLE ON SEPARATE CIRCUIT - GAS FIRED APPLIANCE - FOR AUX. EQUIPMENT - NOT A STOVE PLUG
2619 72,274 24Mar21	1		KITCHEN: 220V WALL RECEPTACLE ON SEPARATE CIRCUIT - FOR WALL OVEN - SEE PLAN
2619 72,294 24Mar21	1		EXTERIOR RECEPTACLE: ADDITIONAL EXTERIOR GFI RECEPTACLE WITH COVER AND SWITCH FOR HOLIDAY LIGHTS
2619 72,281 24Mar21	1		GREAT ROOM: INTERIOR WALL OUTLET: ADDITIONAL 110V WALL INTERIOR RECEPTACLE ON EXISTING CIRCUIT FOR WALL MOUNTED TV - INSTALL ABOVE FIREPLACE - APPROX 64" A.F.F.
2619 101,930 24Mar21	1		KITCHEN: RELOCATE FRIDGE SPACE AS PER PLAN

ELECTRICAL

Invoice	Qty.	Description
2619 72,289 24Mar21	4	STUDY: 4" E/S LED INTERIOR POT LIGHT - GROUND FLOOR - EACH - SEE PLAN INCLUDED IN APS

2619 72,289 24Mar21	2	MAIN HALL OUTSIDE STUDY: 4" E/S LED INTERIOR POT LIGHT - GROUND FLOOR - EACH - SEE PLAN INCLUDED IN APS
---------------------------	---	--

2619 24Mar21 NoCat	1	GARAGE: INCREASED HEIGHT TO MAN DOOR FROM HOUSE TO GARAGE [32 X 94] TALL HEIGHT * WOOD FRAME - IF GRADE PERMITS [EACH]
--------------------------	---	---

EXTERIOR DOORS

Invoice	Qty.	Description
2619 72,363 24Mar21	1	GARAGE: INCREASED HEIGHT TO MAN DOOR FROM HOUSE TO GARAGE [32 X 94] TALL HEIGHT * WOOD FRAME - IF GRADE PERMITS [EACH]

FIREPLACE

Invoice	Qty.	Description
2619 24Mar21 NoCat	1	GREAT ROOM: DELETE STANDARD FIREPLACE - EXTERIOR BUMPOUT TO REMAIN - INTERIOR TO BE DRYWALLED PAINTED FLAT FINISH INCLUDING STANDARD TRIM

FORM - FORMING

Invoice	Qty.	Description
2626 72,351 10Mar21 **	3	BASEMENT WINDOWS - UPGRADE BASEMENT WINDOW SIZE TO 30 " X 24" - 8" FRAME

FORMING

Invoice	Qty.	Description
2619 24Mar21 NoCat	1	GARAGE: INCREASED HEIGHT TO MAN DOOR FROM HOUSE TO GARAGE [32 X 94] TALL HEIGHT * WOOD FRAME - IF GRADE PERMITS [EACH]

FRAMING

Invoice	Qty.	Description
2619 101,930 24Mar21	1	**CUSTOM LAYOUT** MUDROOM: DELETE STANDARD CLOSET
2619 72,690 24Mar21	1	DELETE KITCHEN BULKHEAD AND LEAVE GAP, IF POSSIBLE, SITE APPROVAL REQUIRED
2619 101,930 24Mar21	1	**CUSTOM LAYOUT** MASTER BEDROOM WIC: MOVE WALL OF WIC APPROX. ONE (1) FOOT INTO MASTER BEDROOM SPACE. MOVE WALL OF WIC BACKING ONTO BEDROOM 2 APPROX. TWO (2) FEET INTO BEDROOM 2 SPACE - SEE PLAN FOR LAYOUT WIC INCREASED IN WIDTH BY APPROX. THREE (3) FEET
2619 24Mar21 NoCat	1	GARAGE: INCREASED HEIGHT TO MAN DOOR FROM HOUSE TO GARAGE [32 X 94] TALL HEIGHT * WOOD FRAME - IF GRADE PERMITS [EACH]
2619 24Mar21 NoCat	1	GREAT ROOM: DELETE STANDARD FIREPLACE - EXTERIOR BUMP OUT TO REMAIN - INTERIOR TO BE DRY WALLED PAINTED FLAT FINISH INCLUDING STANDARD TRIM

GLASS AND MIRROR

Invoice	Qty.	Description
2619 101,930 24Mar21	1	**DELETE ALL STANDARD MIRRORS THRU OUT**

HVAC

Invoice	Qty.	Description
2619 72,224 24Mar21	1	KITCHEN: GAS LINE ROUGH-IN - MAIN FLOOR FOR APPLIANCE - SEE PLAN FOR LOCATION
2619 72,217 24Mar21	1	KITCHEN: - UPGRADE TO 8" DUCT (EXTERIOR WALL) IN LIEU OF STANDARD OFFERING
2619 101,930 24Mar21	1	GARAGE: INSTALL COMPLETE CENTRAL VAC - CYCLOVAC 215 - BEATER BAR + ACCESSORIES INCLUDED

INTERIOR TRIM /MOULDINGS

Invoice	Qty.	Description
2626 72,351 10Mar21 **	3	BASEMENT WINDOWS - UPGRADE BASEMENT WINDOW SIZE TO 30 " X 24" - 8" FRAME

INTERIOR TRIM AND DOORS

Invoice	Qty.	Description
2619 101,930 24Mar21	1	**THRU OUT: DELETE ALL WHITE WIRE SHELVING**
2619 24Mar21 NoCat	1	**CUSTOM LAYOUT** MUDROOM: DELETE STANDARD CLOSET
2619 24Mar21 NoCat	1	GARAGE: INCREASED HEIGHT TO MAN DOOR FROM HOUSE TO GARAGE [32 X 94] TALL HEIGHT * WOOD FRAME - IF GRADE PERMITS [EACH]
2619 24Mar21 NoCat	1	**CUSTOM LAYOUT** MASTER BEDROOM WIC: MOVE WALL OF WIC APPROX. ONE (1) FOOT INTO MASTER BEDROOM SPACE. MOVE WALL OF WIC BACKING ONTO BEDROOM 2 APPROX. TWO (2) FEET INTO BEDROOM 2 SPACE - SEE PLAN FOR LAYOUT
24Mar21 NoCat		WIC INCREASED IN WIDTH BY APPROX. THREE (3) FEET
2619 24Mar21 NoCat	1	FYI - GREAT ROOM: DELETE STANDARD FIREPLACE - EXTERIOR BUMP OUT TO REMAIN - INTERIOR TO BE DRY WALLED PAINTED FLAT FINISH INCLUDING STANDARD TRIM

KITCHEN AND BATH CABINETRY

Invoice	Qty.	Description
2619 24Mar21 NoCat	1	KITCHEN: RELOCATE FRIDGE SPACE AS PER PLAN

MASONRY

Invoice	Qty.	Description
2619 24Mar21 NoCat	1	FYI-GARAGE: INCREASED HEIGHT TO MAN DOOR FROM HOUSE TO GARAGE [32 X 94] TALL HEIGHT * WOOD FRAME - IF GRADE PERMITS [EACH]

MISC.

Invoice	Qty.	Description
2619 101,930 24Mar21	1	**THRU OUT: DO NOT INSTALL BATHROOM ACCESSORIES**

NETWORK AND WIRING

Invoice	Qty.	Description
2619 72,259 24Mar21	1	GREAT ROOM: CONDUIT PIPE - FOR WALL HUNG TV - INSTALL AT FIREPLACE APPROX 64" A.F.F. - TERMINATING AT GABLE SEE PLAN
2619 72,260 24Mar21	1	CONDUIT PIPE - FROM ATTIC TO BASEMENT
2619 72,258 24Mar21	1	MEDIA ROOM: ADDITIONAL CAT6 ETHERNET OUTLET - EACH - SEE PLAN FOR LOCATION

PAINT

Invoice	Qty.	Description
2619 24Mar21 NoCat	1	FYT -**CUSTOM LAYOUT** MUDDROOM: DELETE STANDARD CLOSET
2619 24Mar21 NoCat	1	GARAGE: INCREASED HEIGHT TO MAN DOOR FROM HOUSE TO GARAGE [32 X 94] TALL HEIGHT * WOOD FRAME - IF GRADE PERMITS [EACH]

2619 24Mar21 NoCat	1	**CUSTOM LAYOUT** MASTER BEDROOM WIC: MOVE WALL OF WIC APPROX. ONE (1) FOOT INTO MASTER BEDROOM SPACE. MOVE WALL OF WIC BACKING ONTO BEDROOM 2 APPROX. TWO (2) FEET INTO BEDROOM 2 SPACE - SEE PLAN FOR LAYOUT
2619 24Mar21 NoCat	1	WIC INCREASED IN WIDTH BY APPROX. THREE (3) FEET
2619 24Mar21 NoCat	1	GREAT ROOM: DELETE STANDARD FIREPLACE - EXTERIOR BUMPOUT TO REMAIN - INTERIOR TO BE DRYWALLED PAINTED FLAT FINISH INCLUDING STANDARD TRIM

PAINTING

Invoice	Qty.	Description
2626 72,351 10Mar21 **	3	BASEMENT WINDOWS - UPGRADE BASEMENT WINDOW SIZE TO 30 " X 24" - 8" FRAME

PANL - FRAMING

Invoice	Qty.	Description
2626 72,351 10Mar21 **	3	BASEMENT WINDOWS - UPGRADE BASEMENT WINDOW SIZE TO 30 " X 24" - 8" FRAME

PLUMBING

Invoice	Qty.	Description
2619 72,332 24Mar21	1	KITCHEN: ROUGH-IN 1/4" COLD WATER LINE TO FRIDGE

Lot: 43  
Model: 40.03 B BROOKSIDE  
Project/Phase: Pine Valley Forevergreen / 1

PLUMBING FIXTURE

Invoice	Qty.	Description
2619 75,845 24Mar21	1	MASTER ENSUITE: UPGRADE SHOWER FAUCET PACKAGE - MOEN DOUX THERMOSTATIC VERTICAL SPA WITH BODY SPRAYS - MATTE BLACK

PLUMBING FIXTURES

Invoice	Qty.	Description
2619 101,930 24Mar21	1	KITCHEN: UPGRADE MOEN MODERN POT FILLER - AT STOVE WALL

ROUGH CARPENTRY


Invoice	Qty.	Description
2626 72,351 10Mar21 **	3	BASEMENT WINDOWS - UPGRADE BASEMENT WINDOW SIZE TO 30 " X 24" - 8" FRAME

WINDOWS - BASEMENT

Invoice	Qty.	Description
2626 72,351 10Mar21 **	3	BASEMENT WINDOWS - UPGRADE BASEMENT WINDOW SIZE TO 30 " X 24" - 8" FRAME



SCHEDULE 'F'  
PV-43. *attached*  
March 8, 2021  
PV-43 *attached*  
March 22, 2021  
**The Brookside**  
40' SERIES  
Elevation A • 3,380 sq.ft.  
Elevation B • 3,350 sq.ft.

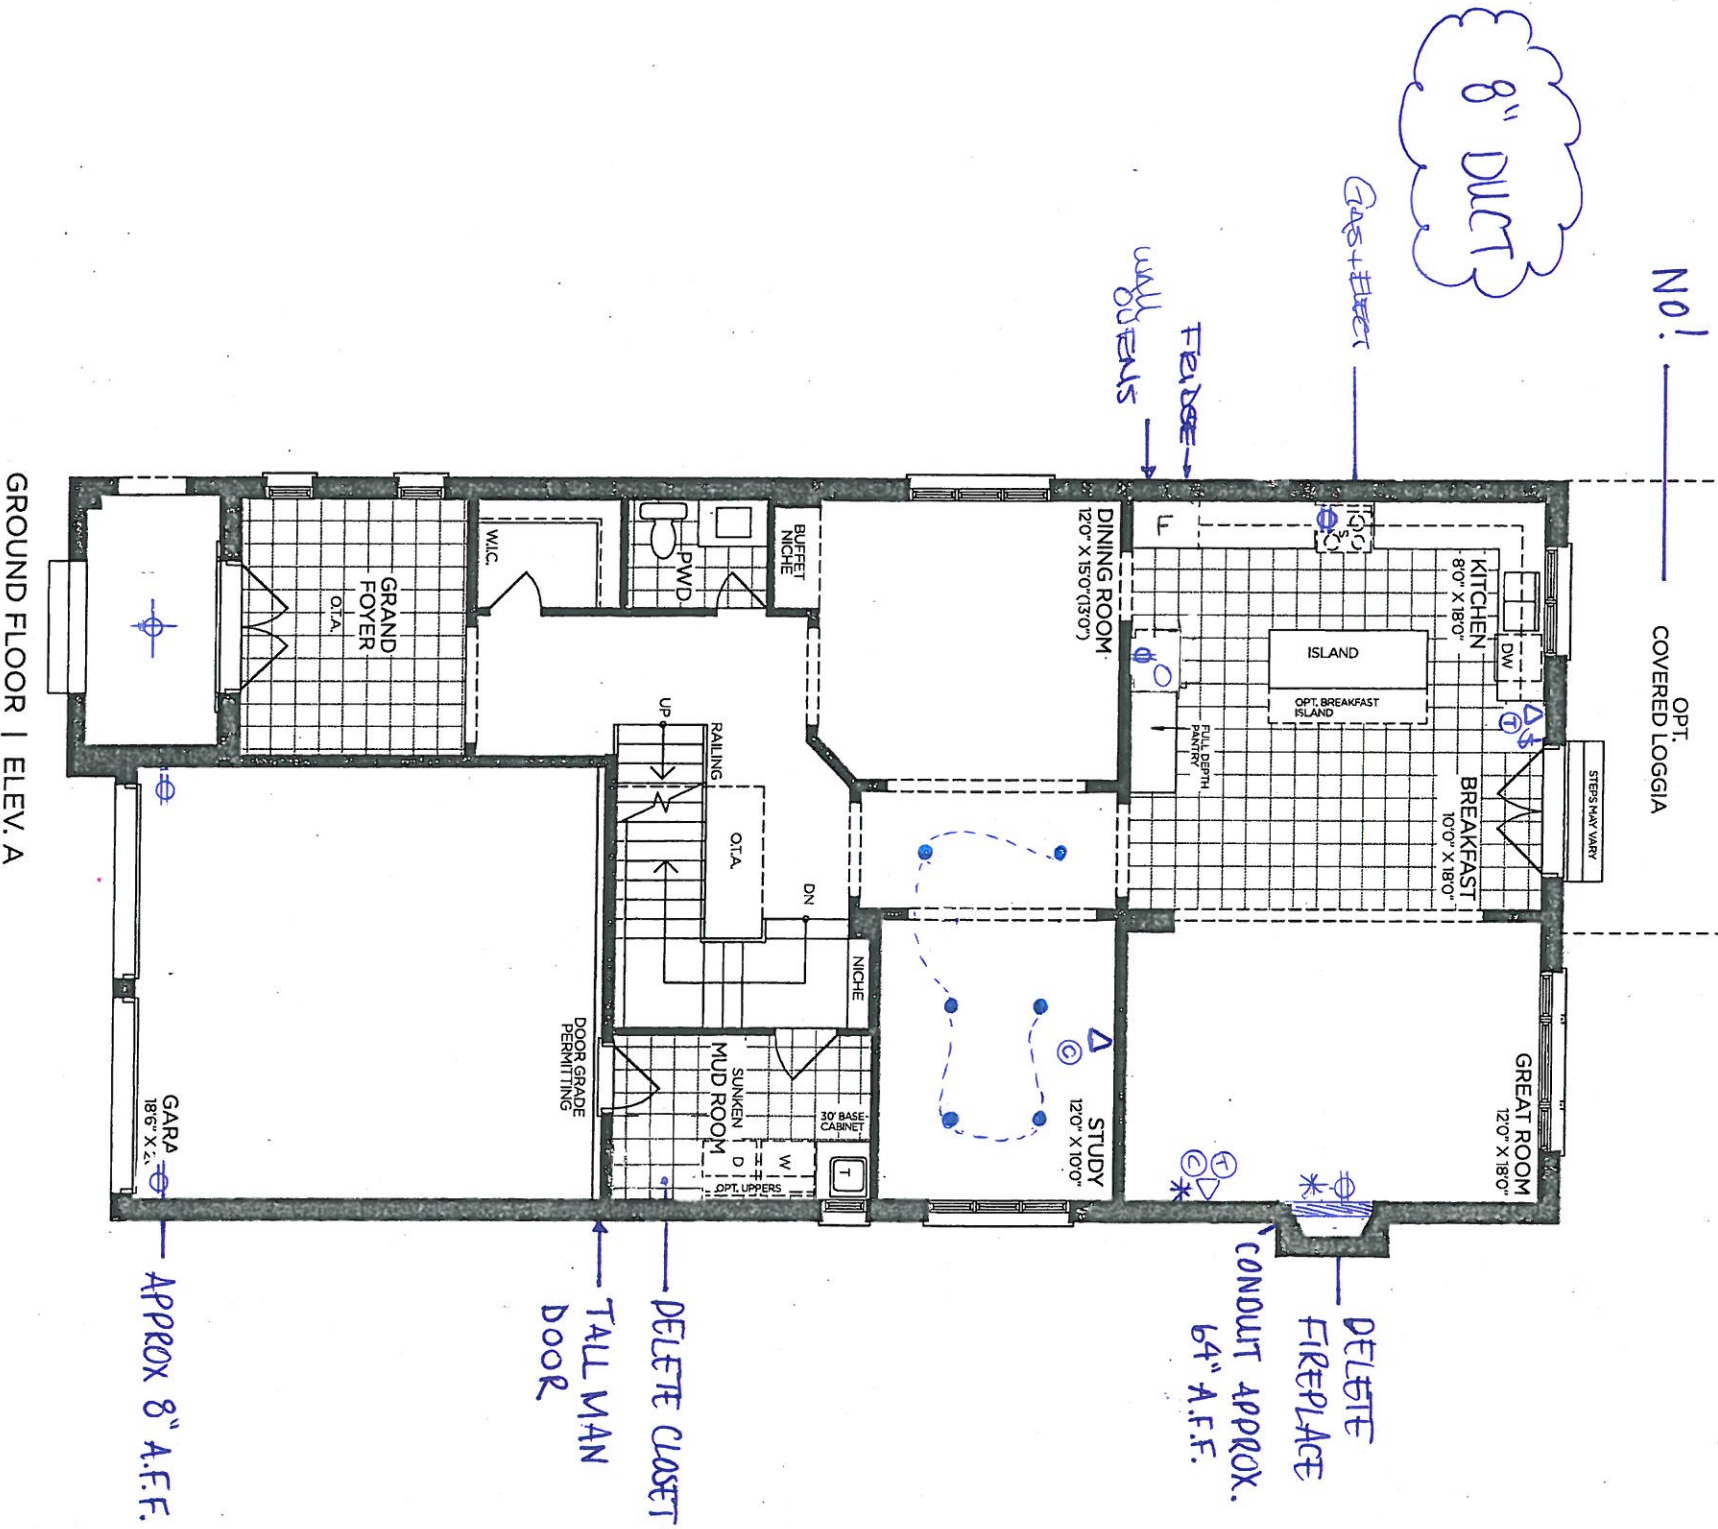

VENDOR



PURCHASER

PURCHASER


**GOLDPARK**  
WORTH MORE

Prices, figures, illustrations, sizes, features and finishes are subject to change without notice. Areas and dimensions are approximate and actual usable floor space may vary from the stated area. Layout may be reverse of the unit purchased. E. & O.E. 4003



SCHEDULE 'F'  
PV-43   
March 8, 2021  
PV-43  attached  
March 22, 2021

The  
Brookside  
40' SERIES  
Elevation A • 3,380 sq.ft.  
→ Elevation B • 3,350 sq.ft.

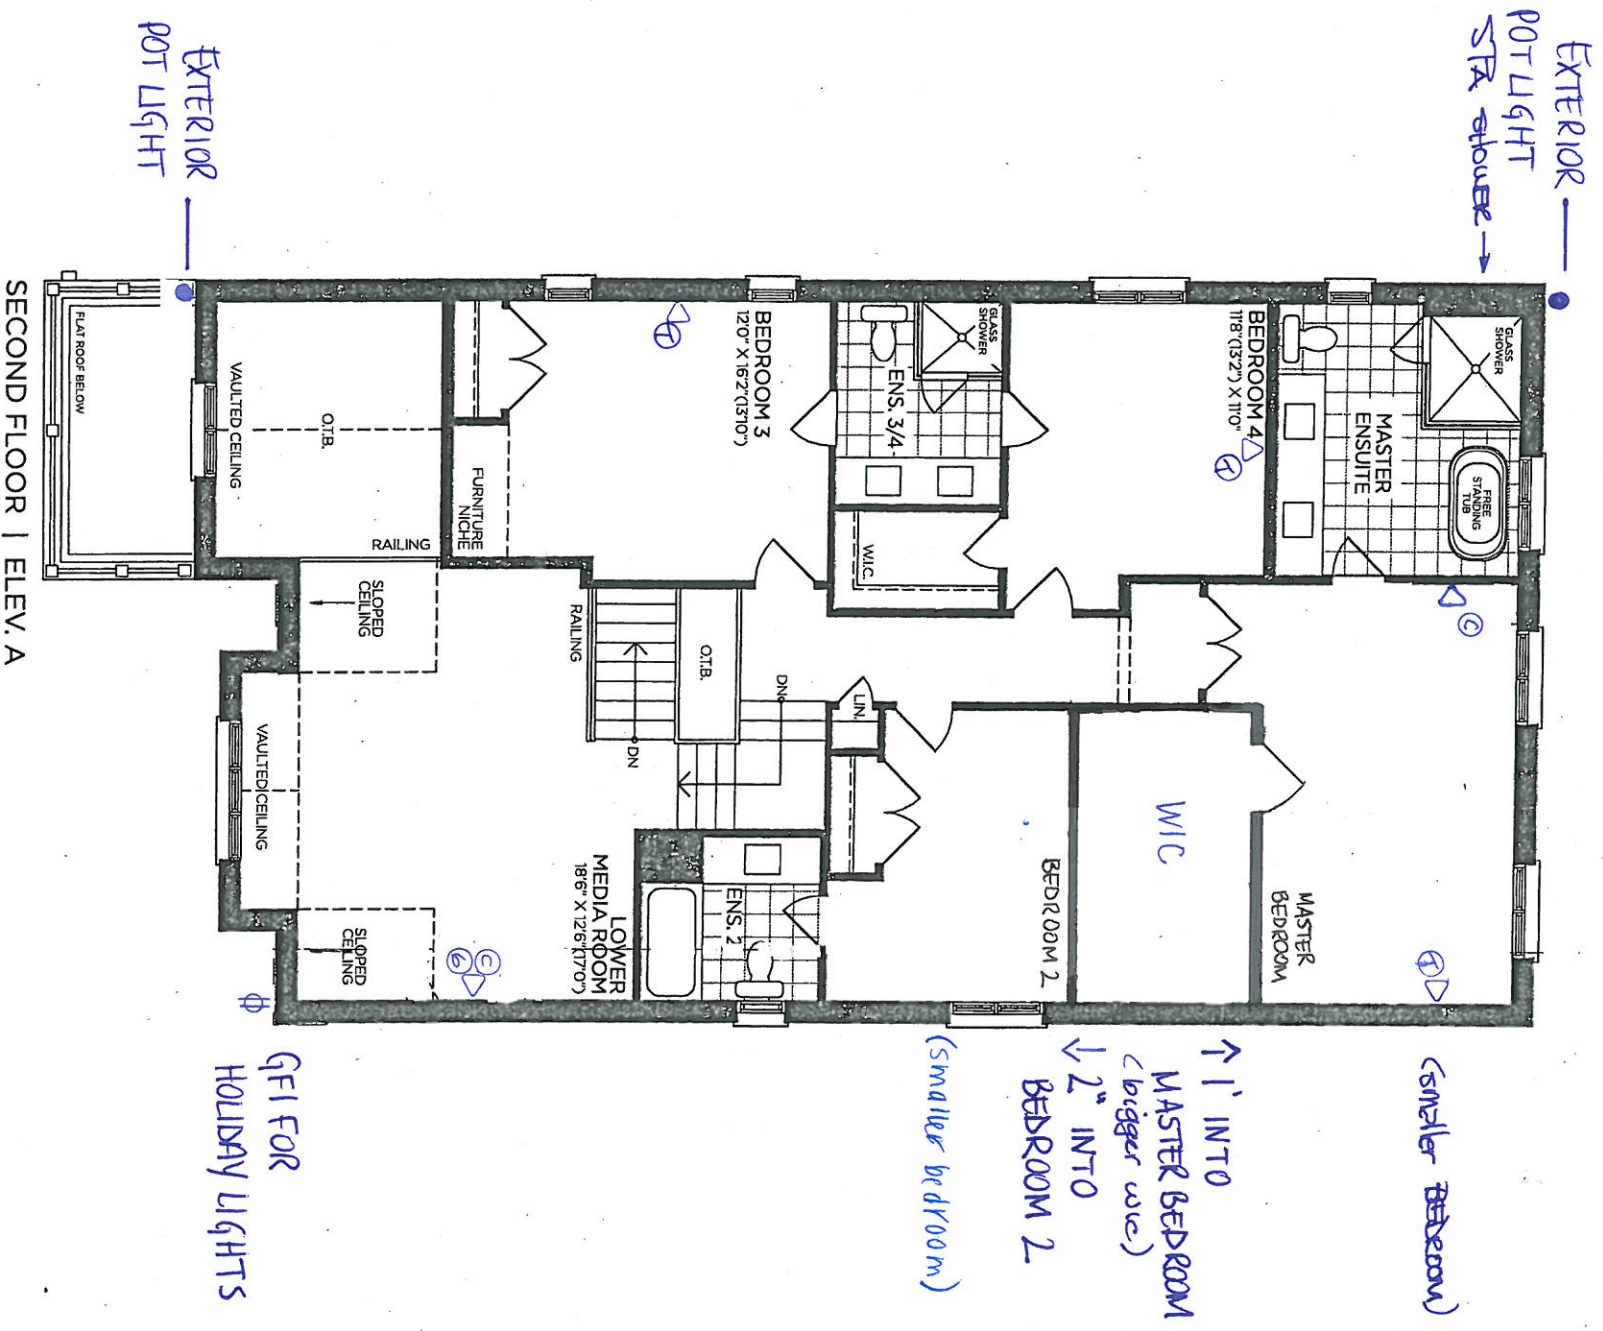


VENDOR \_\_\_\_\_  
PURCHASER \_\_\_\_\_  
PURCHASER \_\_\_\_\_

GOLDPARK  
WORTH MORE™  
Prices, figures, illustrations, sizes, features and finishes are subject to change without notice. Areas and dimensions are approximate and actual usable floor space may vary from the stated area. Layout may be reverse of the unit purchased. E. & O.E. 4003

SCHEDULE 'F'  
PV-43 attached  
March 8, 2021  
PV-43 attached  
March 22, 2021

The  
Brookside  
40' SERIES  
Elevation A • 3,380 sq.ft.  
Elevation B • 3,350 sq.ft.

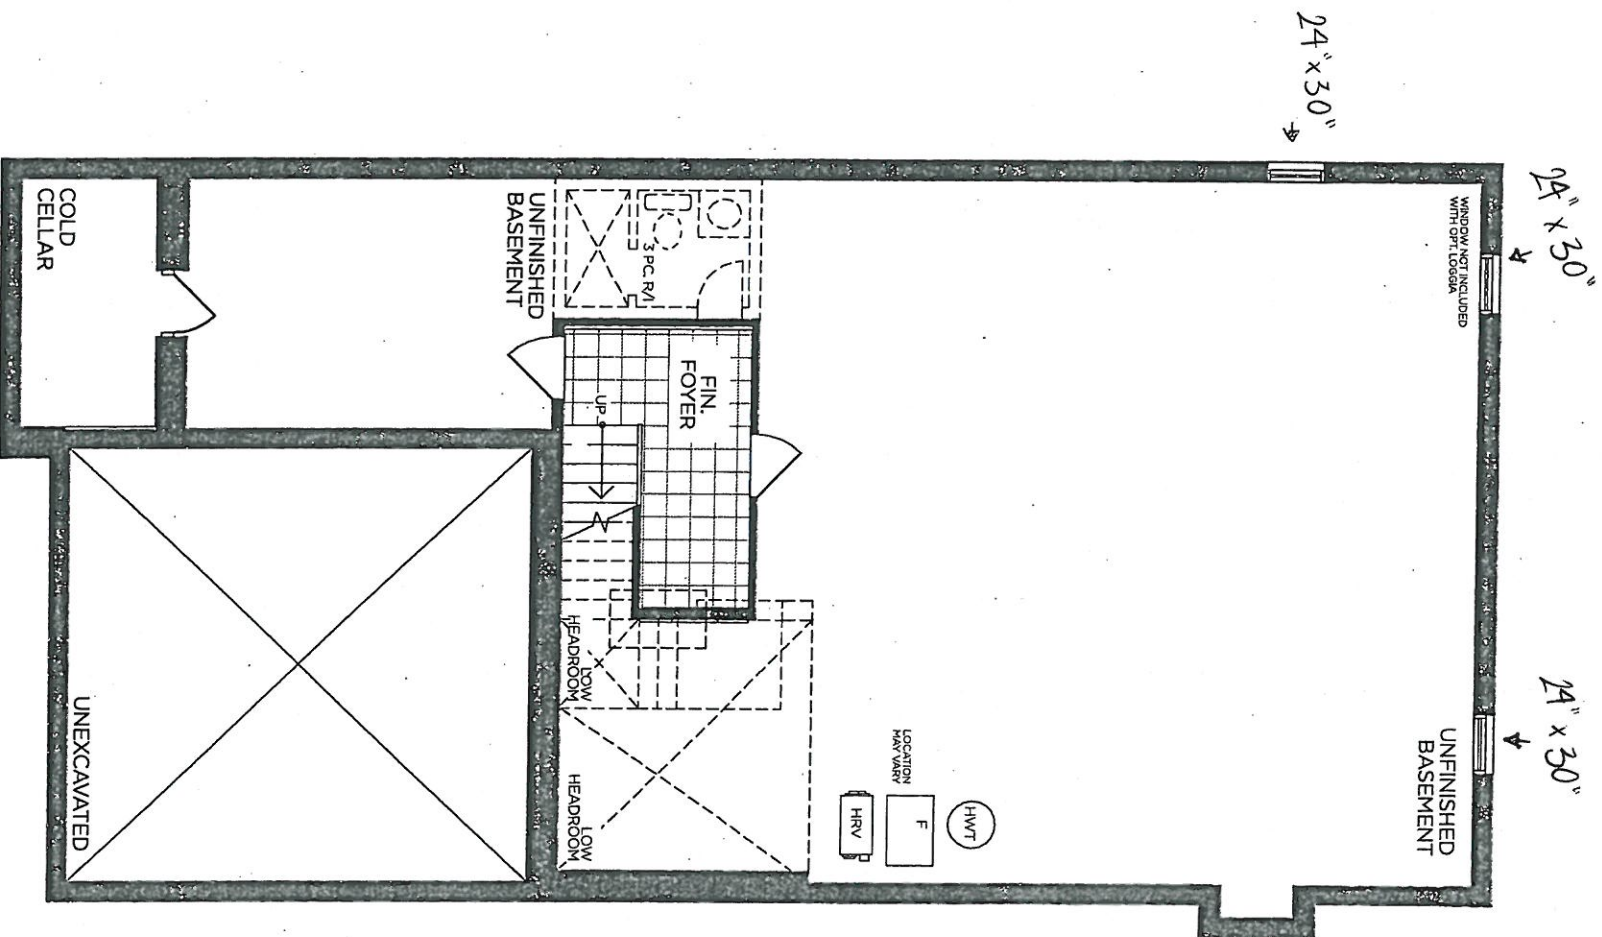

BASEMENT | ELEV. A

VENDOR

PURCHASER

PURCHASER


Prices, figures, illustrations, sizes, features and finishes are subject to change without notice. Areas and dimensions are approximate and actual usable floor space may vary from the stated area. Layout may be reverse of the unit purchased. E. & O.E. 4003

GOLDPARK  
WORTH MORE™




SCHEDULE 'F'  
PV-43 attached  
March 8, 2021  
PV-43 attached  
March 22, 2021


The  
**Brookside**  
40' SERIES  
Elevation A • 3,380 sq.ft.  
Elevation B • 3,350 sq.ft.

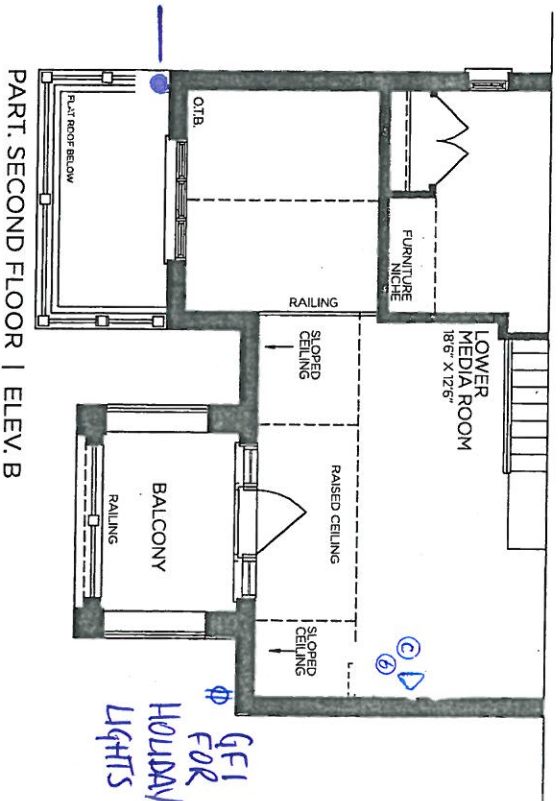


PART. SECOND FLOOR | ELEV. B

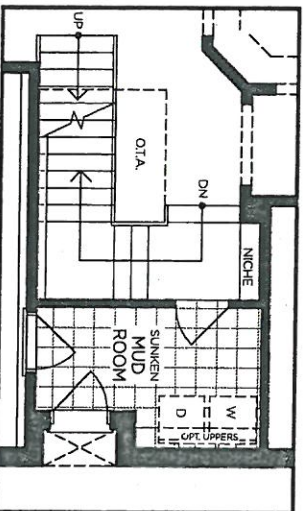

PART. OPT. GROUND FLOOR  
W/ OPT. SIDE ENTRANCE | ELEV. A  
(ELEV. B SIMILAR)

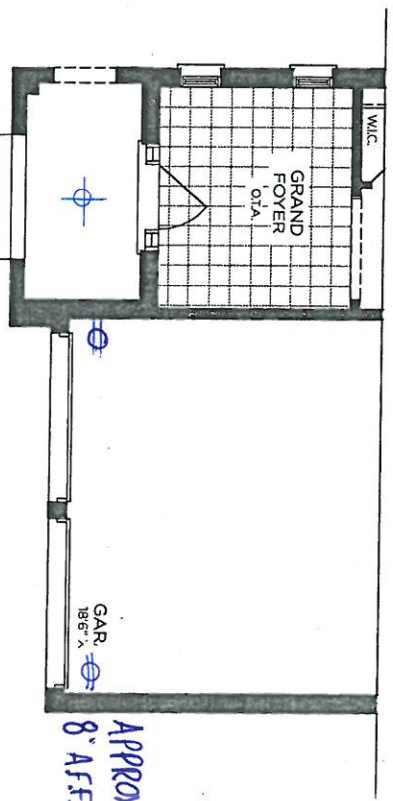

PART. GROUND FLOOR | ELEV. B

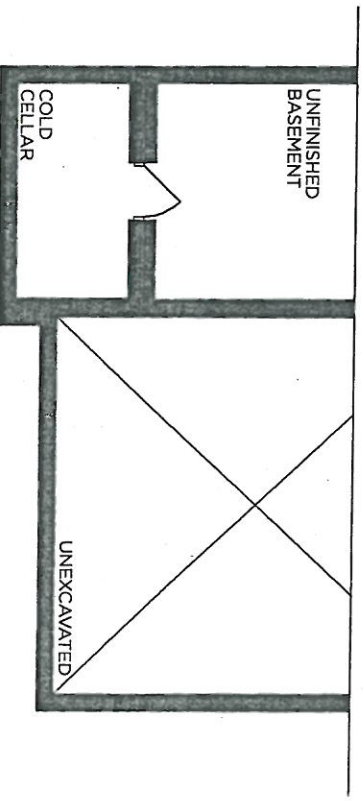

PART. BASEMENT | ELEV. B

VENDOR   
PURCHASER   
PURCHASER

**GOLDPARK**  
WORTH MORE™

Prices, figures, illustrations, sizes, features and finishes are subject to change without notice. Areas and dimensions are approximate and actual usable floor space may vary from the stated area. Layout may be reverse of the unit purchased. E. & O.E. 4003






PINE VALLEY  
FOREVERGREEN

## UPGRADE KITCHEN EXTRA

MOEN - MODERN

Pot Filler

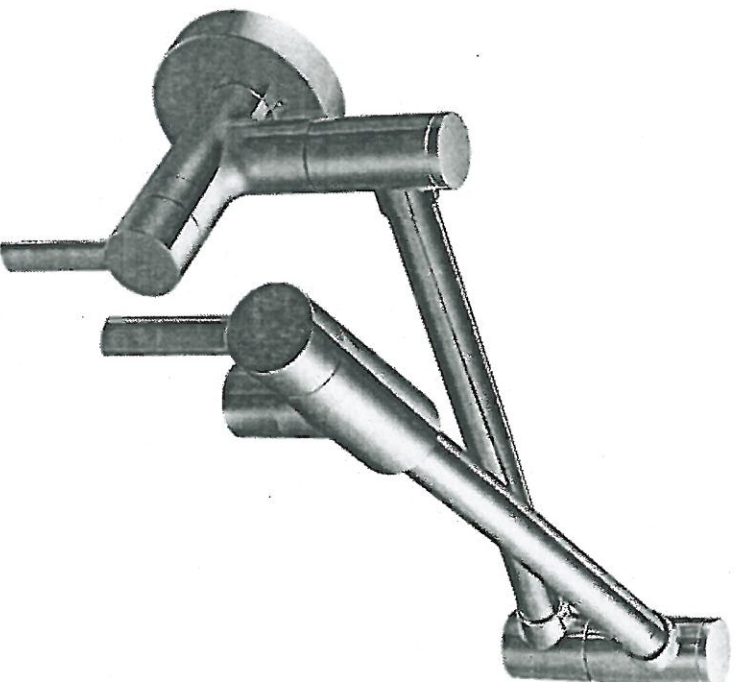

☐ CHROME

☐ STAINLESS (SRS)

☐ POLISHED NICKEL (NL)

☒ MATTE BLACK (BL)

☐ BRUSHED GOLD (BG)

MODEL: S665 Pot Filler

Lot#

PV-43

Date:

March 22, 2021

Room:

Kitchen

Signature:

attached

Signature:

attached

GOLDPARK  
WORTH MORE

PN-43

10

Elevation A • 3,380 sq.ft.  
Elevation B • 3,350 sq.ft.



PURCHASER

**WORTH MORE**


Prices, figures, illustrations, sizes, features and finishes are subject to change without notice. Areas and dimensions are approximate and actual usable floor space may vary from the stated area. Layout may be reverse of the unit purchased. E & OE. 4903



SCHEDULE 'F'

PV-43  
March 8, 2021  
PV-43  
March 22, 2021

The  
Brookside  
40' SERIES  
Elevation A • 3,380 sq.ft.  
Elevation B • 3,350 sq.ft.

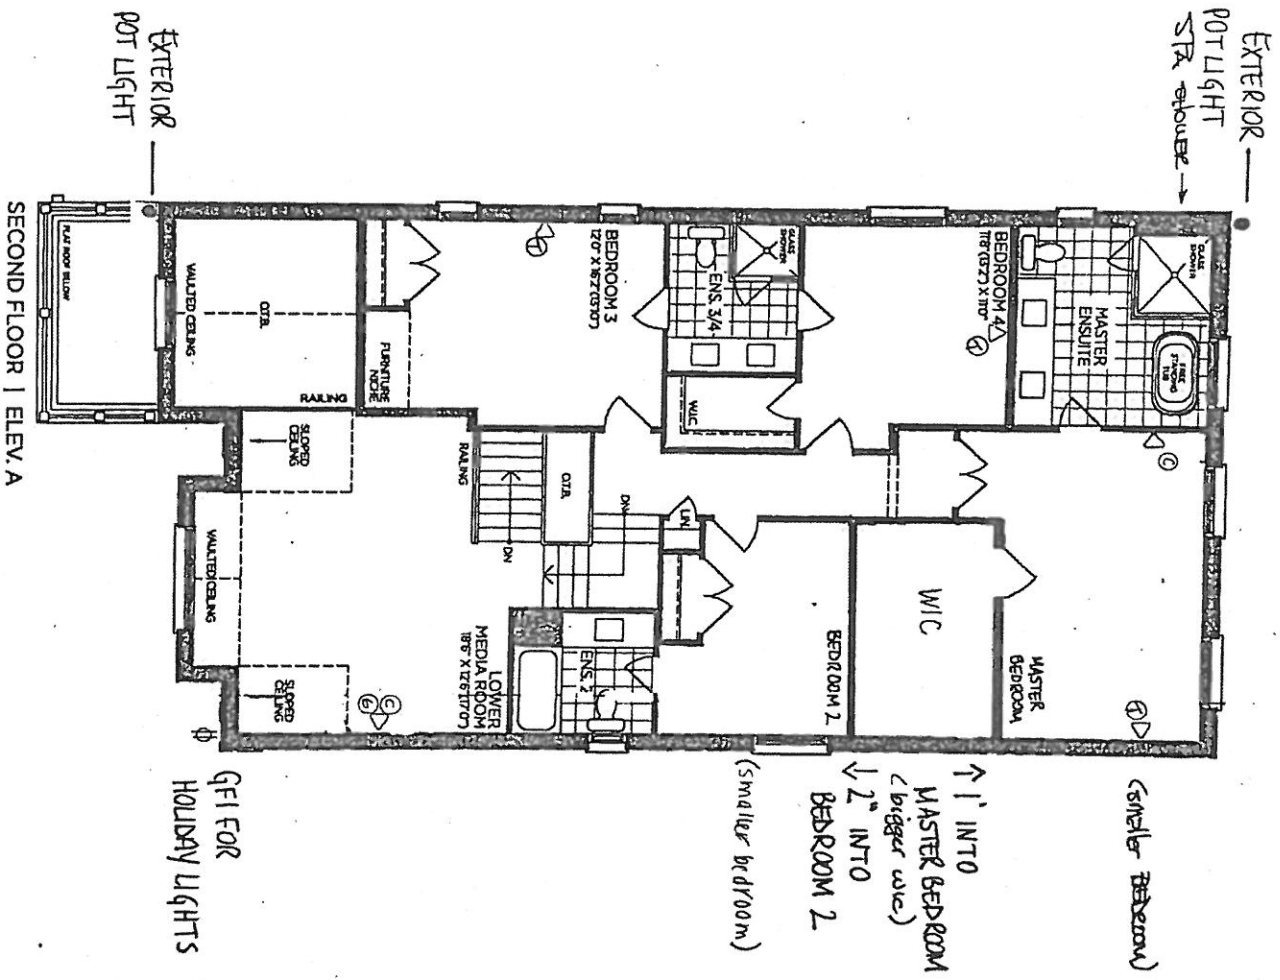

VENDOR

PURCHASER

PURCHASER


GOLDPARK  
WORTH MORE

Prices, figures, illustrations, sizes, features and finishes are subject to change without notice. Areas and dimensions are approximate and actual usable floor space may vary from the stated area. Layout may be reverse of the unit purchased. E & OE 4003



SCHEDULE 'F'  
PV-43 (March 8, 2021)  
March 8, 2021  
PV-43  
March 22, 2021

The  
Brookside  
40' SERIES  
Elevation A • 3,380 sq.ft.  
→ Elevation B • 3,350 sq.ft.

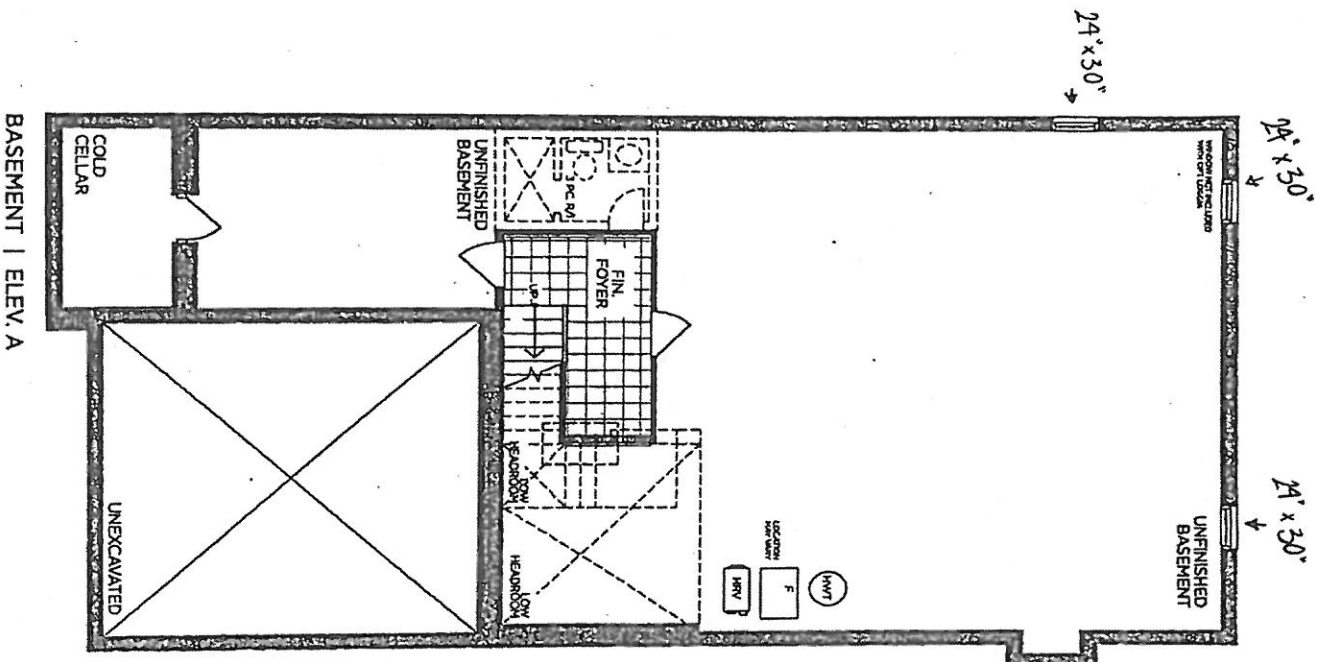

VENDOR

PURCHASER

PURCHASER

GOLDPARK  
WORTH MORE





Prices, figures, illustrations, sizes, features and finishes are subject to change without notice. Areas and dimensions are approximate and actual usable floor space may vary from the stated area. Layout may be reverse of the unit purchased. E. & O.E. 4003





SCHEDULE 'F'  
PR-43 (C) (A) (B) (C)  
March 8, 2021  
PR-43 (C) (A) (B) (C)  
March 22, 2021

The  
**Brookside**  
40' SERIES  
Elevation A • 3,380 sq.ft.  
Elevation B • 3,350 sq.ft.

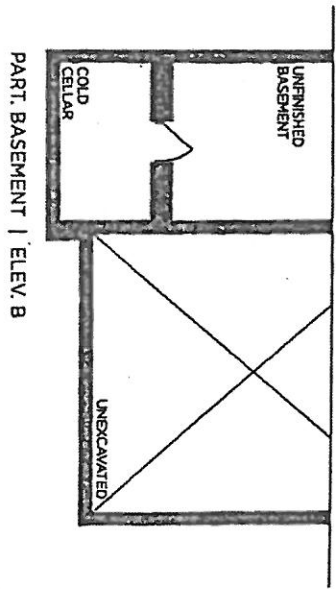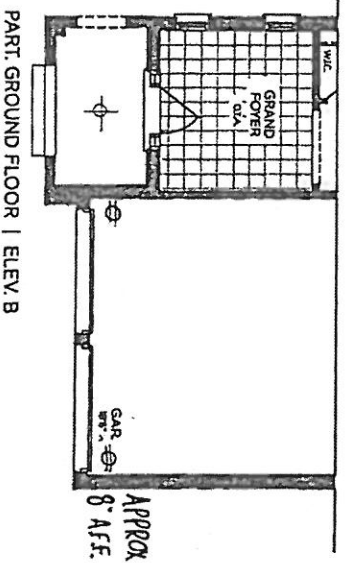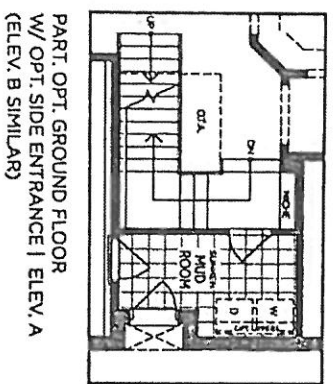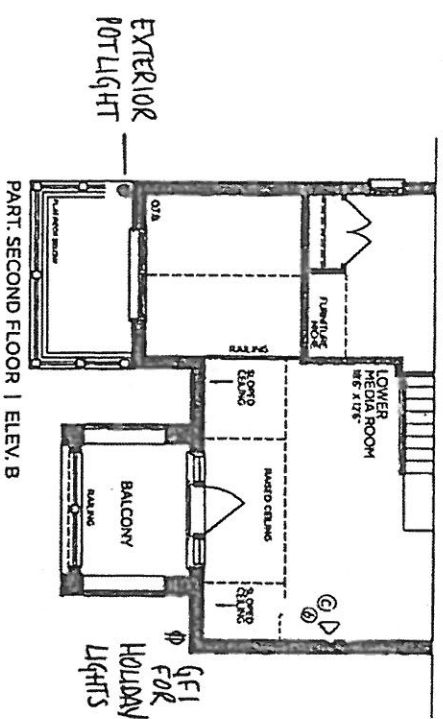

VENDOR \_\_\_\_\_  
PURCHASER \_\_\_\_\_  
PURCHASER \_\_\_\_\_


**GOLDPARK**  
WORTH MORE  
Prices, figures, illustrations, sizes, features and finishes are subject to change without notice. Areas and dimensions are approximate and actual inside floor space may vary from the stated area. Layout may be reverse of the unit purchased. E & OE, 4003

UPGRADE KITCHEN EXTRA





MOEN - MODERN

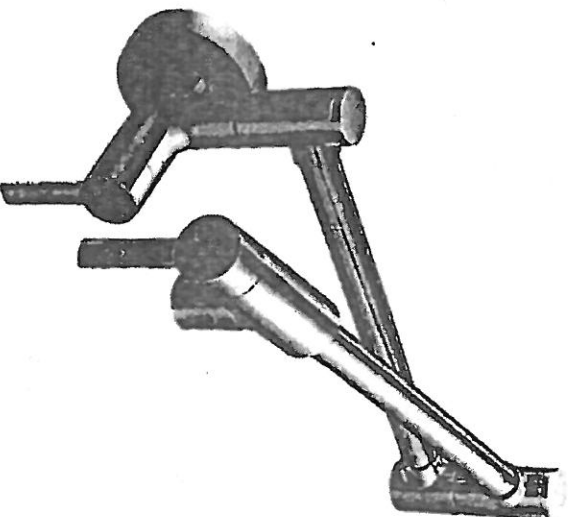Pot Filler



- ☐ CHROME
- ☐ STAINLESS (SRS)
- ☐ POLISHED NICKEL (NL)
- ☒ MATTE BLACK (BL)
- ☐ BRUSHED GOLD (BG)

MODEL: S665 Pot Filler

Lot# PV-43	Date: March 22, 2021	Room: Kitchen
Signature: 		
Signature: 		

GOLDPARK