

BASEMENT WINDOWS

Invoice	Qty.	Description
2638 72,351 17Mar21	4	BASEMENT WINDOWS - UPGRADE BASEMENT WINDOW SIZE TO 30 " X 24" - 8" FRAME

CONCRETE AND DRAIN

Invoice	Qty.	Description
2638 101,930 17Mar21	1	BACK FLOW PREVENTER VALVE

DRYWALL

Invoice	Qty.	Description
2638 72,351 17Mar21 **	4	BASEMENT WINDOWS - UPGRADE BASEMENT WINDOW SIZE TO 30 " X 24" - 8" FRAME
2658 72,438 25Mar21	1	GREAT ROOM: MODEL OPTIONS 40.06 - GREAT ROOM - OPT. COFERED CEILING AS PER PLAN

ELECTRICAL

Invoice	Qty.	Description
2638 72,351 17Mar21 **	4	BASEMENT WINDOWS - UPGRADE BASEMENT WINDOW SIZE TO 30 " X 24" - 8" FRAME
2658 72,281 25Mar21	1	GREAT ROOM: INTERIOR WALL OUTLET: ADDITIONAL 110V WALL INTERIOR RECEPTACLE ON EXISTING CIRCUIT FOR WALL MOUNTED TV - APPROX 64" A.F.F. ABOVE FIREPLACE
2658 72,273 25Mar21	1	KITCHEN: 110V WALL RECEPTACLE ON SEPARATE CIRCUIT - GAS FIRED APPLIANCE - FOR AUX. EQUIPMENT - NOT A STOVE PLUG
2658 72,307 25Mar21	1	KITCHEN: RELOCATE STANDARD CEILING MOUNT FIXTURE TO CENTRE ON CEILING ABOVE ISLAND
2658 72,289 25Mar21	6	KITCHEN: 4" E/S LED INTERIOR POT LIGHT - GROUND FLOOR INCLUDED IN APS

FORM - FORMING

Invoice	Qty.	Description
2638 72,351 17Mar21 **	4	BASEMENT WINDOWS - UPGRADE BASEMENT WINDOW SIZE TO 30 " X 24" - 8" FRAME

FORMING

Invoice	Qty.	Description
2638 72,208 17Mar21	1	PINE VALLEY MODEL 42.03 FORESTCREST ELEV A - 9 FOOT BASEMENT CEILING HEIGHT IN LIEU OF STANDARD 8 FOOT CEILING.

FRAMING

Invoice	Qty.	Description
2658 72,224 25Mar21 NoCat	1	GREAT ROOM: MODEL OPTIONS 40.06 - GREAT ROOM - OPT. COFFERED CEILING AS PER PLAN

HVAC

Invoice	Qty.	Description
2658 72,224 25Mar21	1	KITCHEN: GAS LINE ROUGH-IN - MAIN FLOOR FOR APPLIANCE - SEE PLAN

INTERIOR TRIM /MOULDINGS

Invoice	Qty.	Description
2638 72,351 17Mar21 **	4	BASEMENT WINDOWS - UPGRADE BASEMENT WINDOW SIZE TO 30 " X 24" - 8" FRAME

PAINT

Invoice	Qty.	Description
2658 72,351 17Mar21 **	4	BASEMENT WINDOWS - UPGRADE BASEMENT WINDOW SIZE TO 30 " X 24" - 8" FRAME

PAINTING

Invoice	Qty.	Description
2638 72,351 17Mar21 **	4	BASEMENT WINDOWS - UPGRADE BASEMENT WINDOW SIZE TO 30 " X 24" - 8" FRAME

PANL - FRAMING

Invoice	Qty.	Description
2638 72,351 17Mar21 **	4	BASEMENT WINDOWS - UPGRADE BASEMENT WINDOW SIZE TO 30 " X 24" - 8" FRAME

ROUGH CARPENTRY

Invoice	Qty.	Description
2638 72,351 17Mar21 **	4	BASEMENT WINDOWS - UPGRADE BASEMENT WINDOW SIZE TO 30 " X 24" - 8" FRAME



CONSTRUCTION SUMMARY

Lot: 27
Model: 42.03 A FORESTCREST
Project/Phase: Pine Valley Forevergreen / 1

WINDOWS - BASEMENT

Invoice	Qty.	Description
2638 72,351 17Mar21 **	4	BASEMENT WINDOWS - UPGRADE BASEMENT WINDOW SIZE TO 30 " X 24" - 8" FRAME



PINE VALLEY
FOREVERGREEN

SCHEDULE 'F'

PV-27 *attached*

March 16, 2021

PV-27

March 23, 2021

The
Forestcrest
42' SERIES


→ Elevation A • 3,800 sq.ft.
Elevation B • 3,785 sq.ft.
Elevation C • 3,800 sq.ft.

OPT.
COVERED LOGGIA

NO!

GAS +
ELECT

COFFER
APPROX
64" A.F.F.

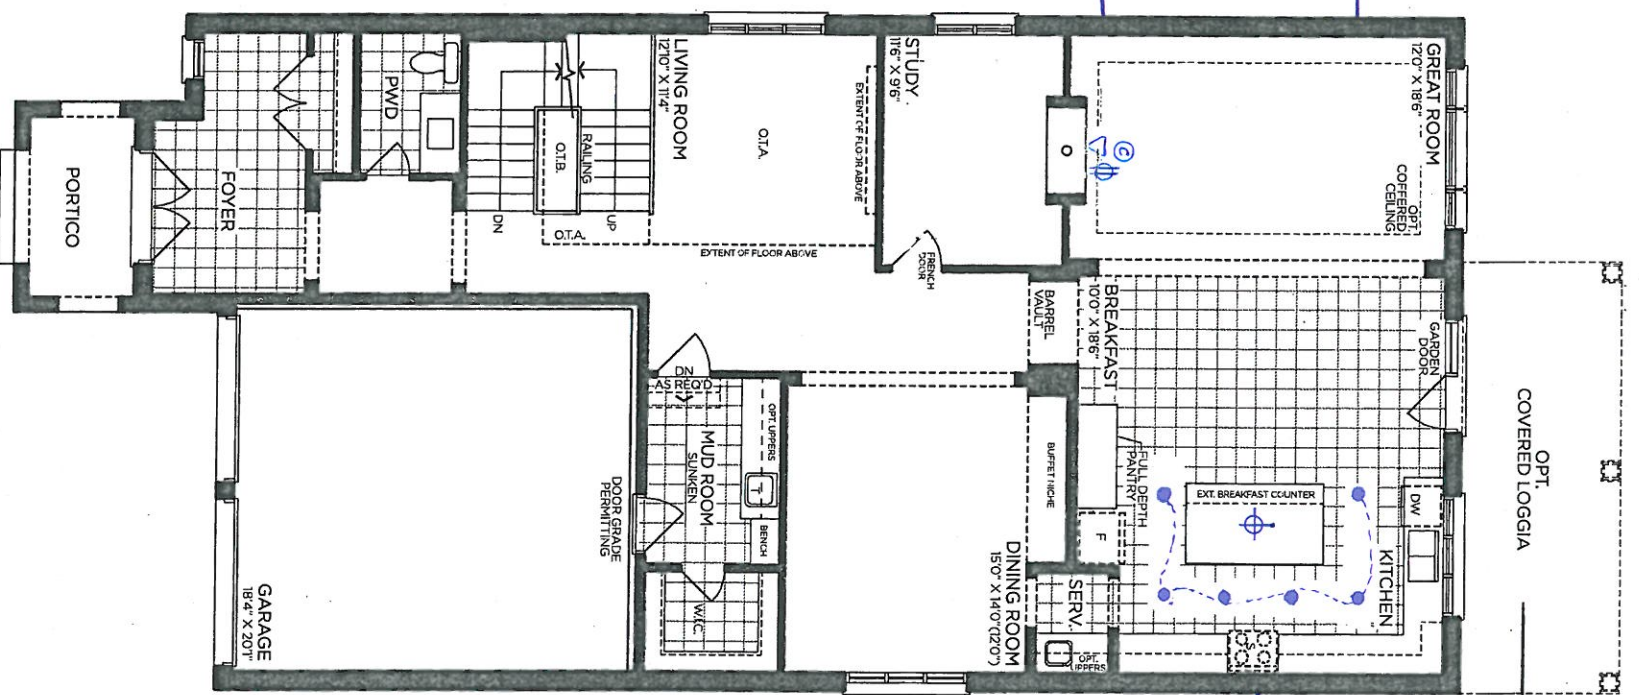

GROUND FLOOR | ELEV. A

VENDOR

PURCHASER

PURCHASER

GOLDPARK
WORTH MORE™

Prices, figures, illustrations, sizes, features and finishes are subject to change without notice. Areas and dimensions are approximate and actual usable floor space may vary from the stated area. Layout may be reverse of the unit purchased. E. & O.E. 4203

SCHEDULE 'F'

PV-27 *attached*
March 16, 2021

PV-27

March 23, 2021

**The
Forestcrest**


42' SERIES



Elevation A • 3,800 sq.ft.

Elevation B • 3,785 sq.ft.

Elevation C • 3,800 sq.ft.

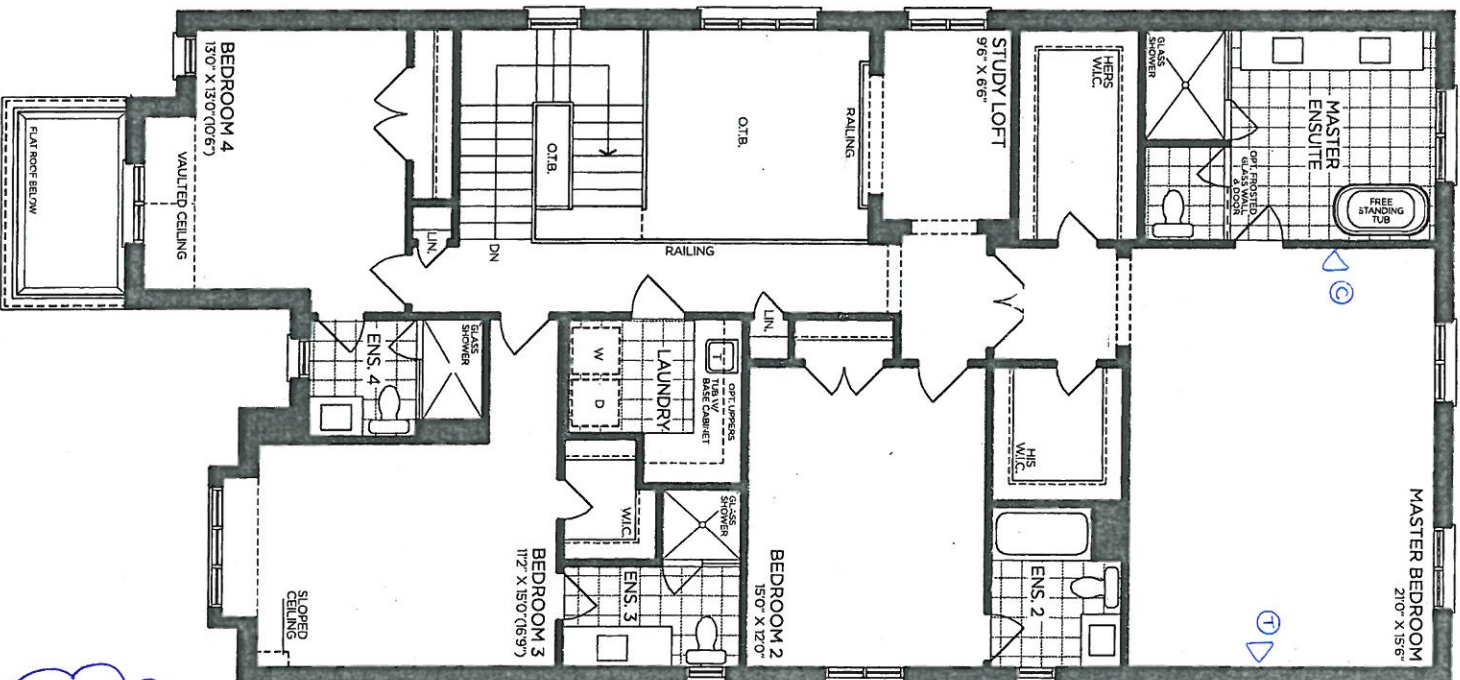

SECOND FLOOR | ELEV. A

NO PHONES IN
BEDROOM 2, 3, 4, 5

VENDOR

PURCHASER

PURCHASER

GOLDPARK

WORTH MORE™


Prices, figures, illustrations, sizes, features and finishes are subject to change without notice. Areas and dimensions are approximate and actual usable floor space may vary from the stated area. Layout may be reverse of the unit purchased. E. & O.E. 4203

SCHEDULE 'F'

PV-27 
March 16, 2021
PV-27 
March 23, 2021

The
Forestcrest
42' SERIES
➤ Elevation A • 3,800 sq.ft.
Elevation B • 3,785 sq.ft.
Elevation C • 3,800 sq.ft.

9' BASEMENT

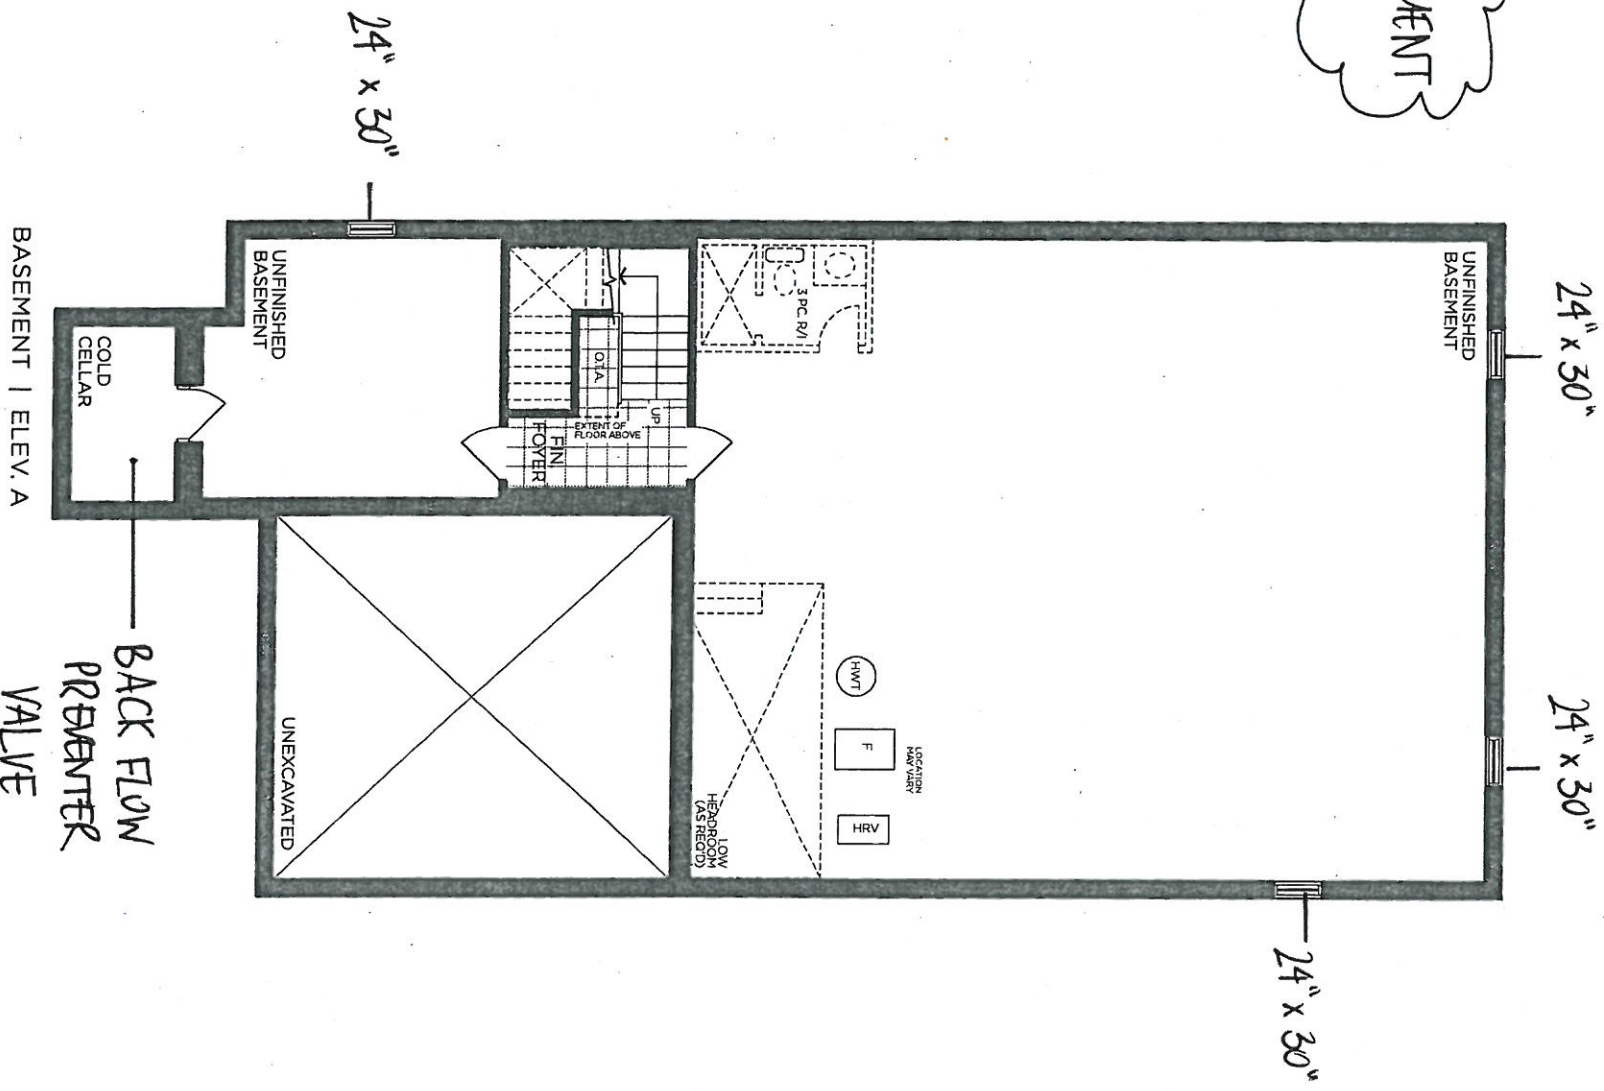

VENDOR

PURCHASER









PURCHASER

GOLDPARK
WORTH MORE™

Prices, figures, illustrations, sizes, features and finishes are subject to change without notice. Areas and dimensions are approximate and actual usable floor space may vary from the stated area. Layout may be reverse of the unit purchased. E. & O.E. 4203

SCHEDULE 'F'
PV-27 *attached*
March 16, 2021
PV-27  
March 23, 2021

The Forestcreek
42' SERIES
Elevation A • 3,800 sq.ft.
Elevation B • 3,785 sq.ft.
Elevation C • 3,800 sq.ft.

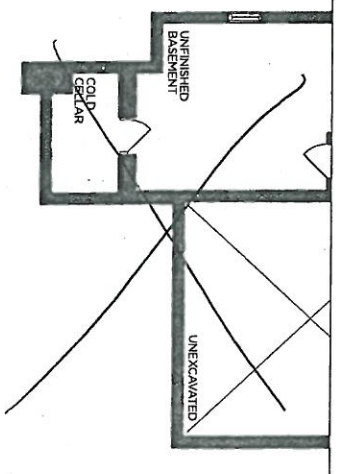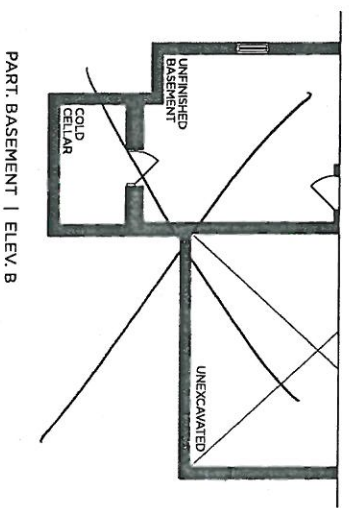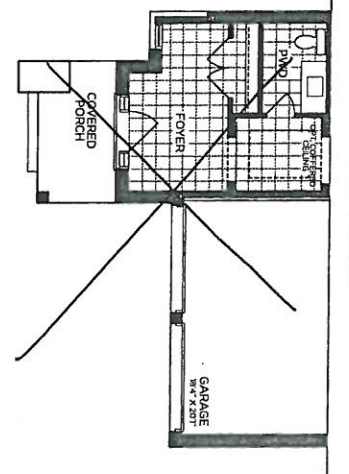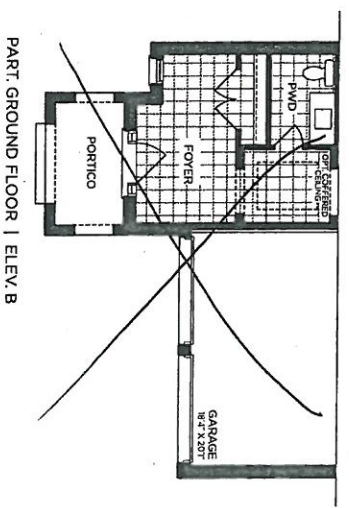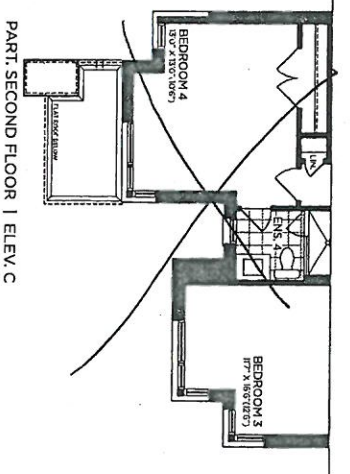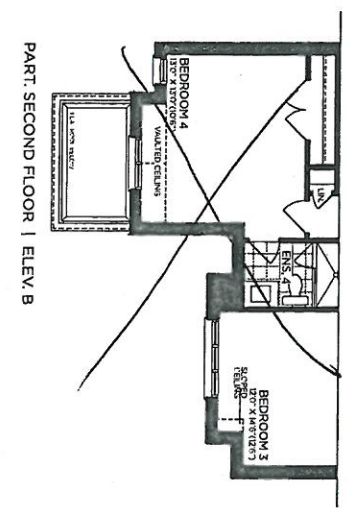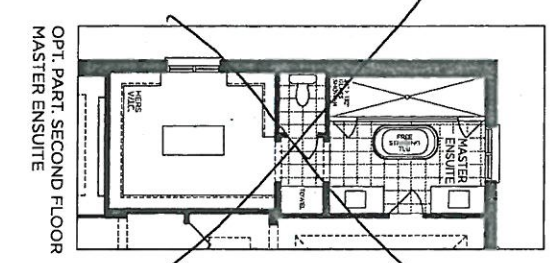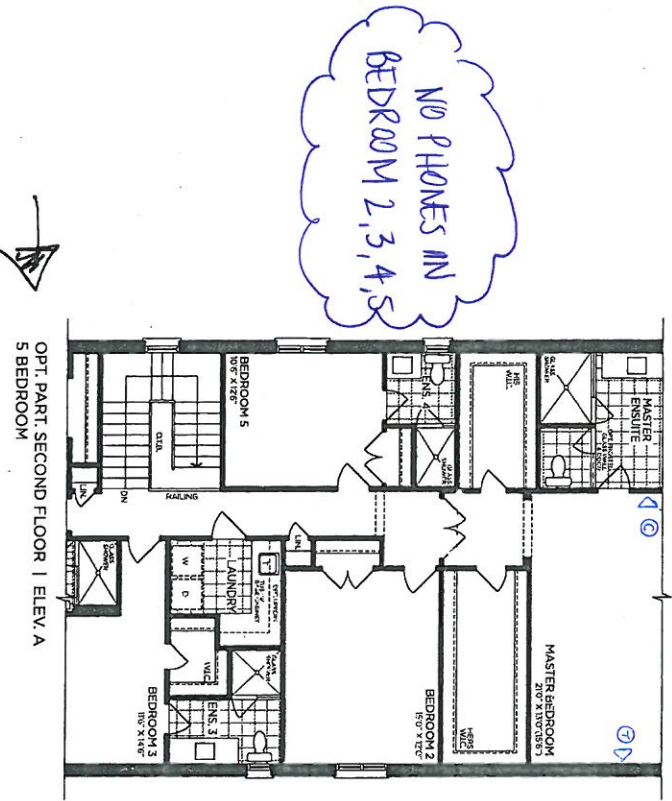

VENDOR _____
PURCHASER _____
PURCHASER _____

GOLDPARK
WORTH MORE™

Prices, figures, illustrations, sizes, features and finishes are subject to change without notice. Areas and dimensions are approximate and actual usable floor space may vary from the stated area. Layout may be reverse of the unit purchased. E. & O.E. 4203

PV-27-80

March 16, 2021

PV-27-80

March 23, 2021

The

Forestcrest

42' SERIES

→ Elevation A = 3,800 sq.ft.

Elevation B = 3,785 sq.ft.


Elevation C = 3,800 sq.ft.

NO!

ELECT

COFFER

APPROX
64 AFF.

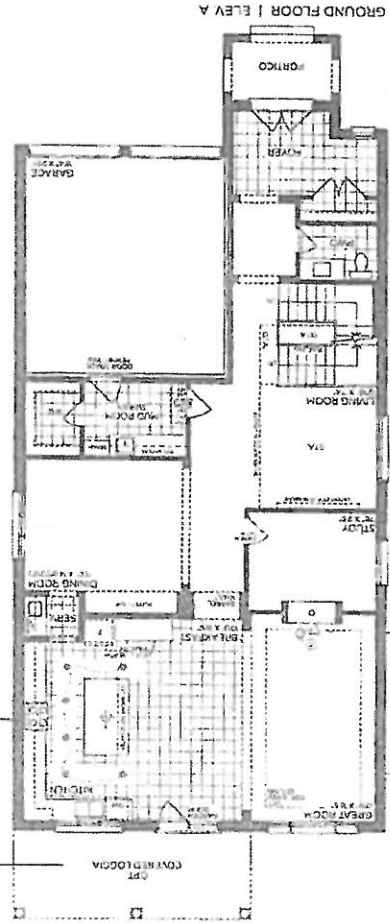

GOLDPARK


WORK MORE

Notes: Figures, dimensions, materials, and finishes are subject to change without notice. Areas and dimensions are approximate and should be verified in the field. From the field and layout may be revised to meet the needs of the project. 11.5.01.003

VENDOR


PURCHASER

PURCHASER

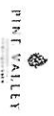

SCHEDULE F
PV-24 (3) Q
March 16, 2011
PV-24 (3) Q
March 12, 2011

The
Forestcrest
42' SERIES
Elevation A - 3,800 sq.ft.
Elevation B - 3,785 sq.ft.
Elevation C - 3,800 sq.ft.

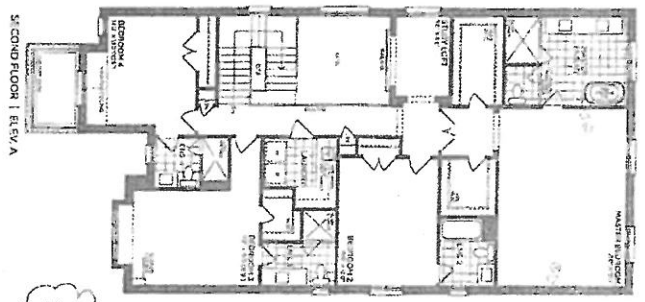

VENDOR _____
PURCHASER _____
PURCHASER _____

GOLDPARK
NORTH 4000' E
Elevation 12' - 14' 8" High, 100' Long, 100' Wide, and 100' High are subject to Goldpark's
and Goldpark's policies. All other policies are subject to Goldpark's policies.
Policies are subject to Goldpark's policies. Policies are subject to Goldpark's policies.
Policies are subject to Goldpark's policies. Policies are subject to Goldpark's policies.




SCHEDULE 'F'

PV-27 (80) (80)
March 16, 2021
PV-27 (80) (80)
March 23, 2021

The
Forestcrest
42' SERIES
→ Elevation A • 3,800 sq.ft.
Elevation B • 3,785 sq.ft.
Elevation C • 3,800 sq.ft.

9' BASEMENT

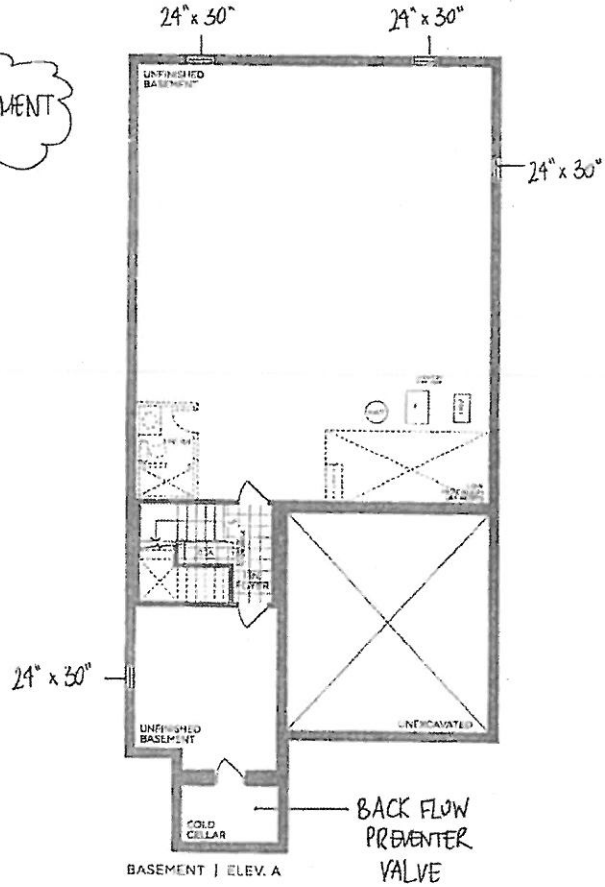

VENDOR
PURCHASER
PURCHASER

GOLDPARK
WORTH, ILLINOIS

Prices, figures, illustrations, sizes, finishes and features are subject to change without notice. Areas and dimensions are approximate and do not include floor space may vary from the stated area. Load may be reverse of the unit purchase S. & G.E. 1001

PINE VALLEY

SCHEDULE F*

PI-24

March 16, 1991

PI-24

March 23, 1991

The
Forestcrest
42' SERIES
Elevation A - 3,800 sq.ft.
Elevation B - 3,785 sq.ft.
Elevation C - 3,800 sq.ft.

NO FLOODS IN
ELEVATION 3,34


20' NEST ELEVATION 3,34 A

20' NEST ELEVATION 3,34 A


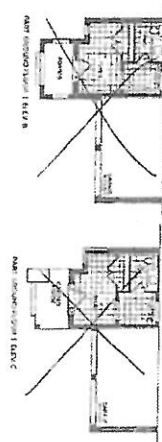

20' NEST ELEVATION 3,34 A

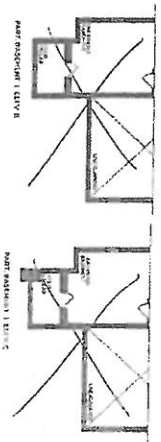

20' NEST ELEVATION 3,34 A

20' NEST ELEVATION 3,34 A

VENDOR
PURCHASER
PURCHASER

GOLDPARK

These drawings are for informational purposes only and do not constitute a contract. The purchaser is responsible for obtaining all necessary permits and approvals from the appropriate authorities. The drawings are subject to change without notice.