

BASEMENT WINDOWS

Invoice	Qty.	Description
2657 72,351 25Mar21	2	BASEMENT WINDOWS - UPGRADE BASEMENT WINDOW SIZE TO 30 " X 24" - 8" FRAME

DRYWALL

Invoice	Qty.	Description
2657 72,351 25Mar21 **	2	BASEMENT WINDOWS - UPGRADE BASEMENT WINDOW SIZE TO 30 " X 24" - 8" FRAME

ELECTRICAL

Invoice	Qty.	Description
2657 72,351 25Mar21 **	2	BASEMENT WINDOWS - UPGRADE BASEMENT WINDOW SIZE TO 30 " X 24" - 8" FRAME

2657 25Mar21 NoCat	1	4.0 TON AC - WITH LOW VOLTAGE WIRING & WALL BRACKETS
--------------------------	---	--

FORM - FORMING

Invoice	Qty.	Description
2657 72,351 25Mar21 **	2	BASEMENT WINDOWS - UPGRADE BASEMENT WINDOW SIZE TO 30 " X 24" - 8" FRAME

FORMING

Invoice	Qty.	Description
2657 72,202 25Mar21	1	PINE VALLEY MODEL 40.06 LILAC ELEV A - 9 FOOT BASEMENT CEILING HEIGHT IN LIEU OF STANDARD 8 FOOT CEILING. INCLUDED IN APS

HVAC

Invoice	Qty.	Description
2657 72,241 25Mar21	1	4.0 TON AC - WITH LOW VOLTAGE WIRING & WALL BRACKETS INCLUDED IN APS

INTERIOR TRIM /MOULDINGS

Invoice	Qty.	Description
2657 72,351 25Mar21 **	2	BASEMENT WINDOWS - UPGRADE BASEMENT WINDOW SIZE TO 30 " X 24" - 8" FRAME

Lot: 26
Model: 40.06 A LILAC
Project/Phase: Pine Valley Forevergreen / 1

PAINTING

Invoice	Qty.	Description
2657 72,351 25Mar21 **	2	BASEMENT WINDOWS - UPGRADE BASEMENT WINDOW SIZE TO 30 " X 24" - 8" FRAME

PANL - FRAMING

Invoice	Qty.	Description
2657 72,351 25Mar21 **	2	BASEMENT WINDOWS - UPGRADE BASEMENT WINDOW SIZE TO 30 " X 24" - 8" FRAME

ROUGH CARPENTRY

Invoice	Qty.	Description
2657 72,351 25Mar21 **	2	BASEMENT WINDOWS - UPGRADE BASEMENT WINDOW SIZE TO 30 " X 24" - 8" FRAME


WINDOWS - BASEMENT

Invoice	Qty.	Description
2657 72,351 25Mar21 **	2	BASEMENT WINDOWS - UPGRADE BASEMENT WINDOW SIZE TO 30 " X 24" - 8" FRAME

SCHEDULE 'F'

PV-26 *attach*
March 23, 2021

The
Lilac
40' SERIES
→ Elevation A • 3,425 sq.ft.
Elevation B • 3,385 sq.ft.

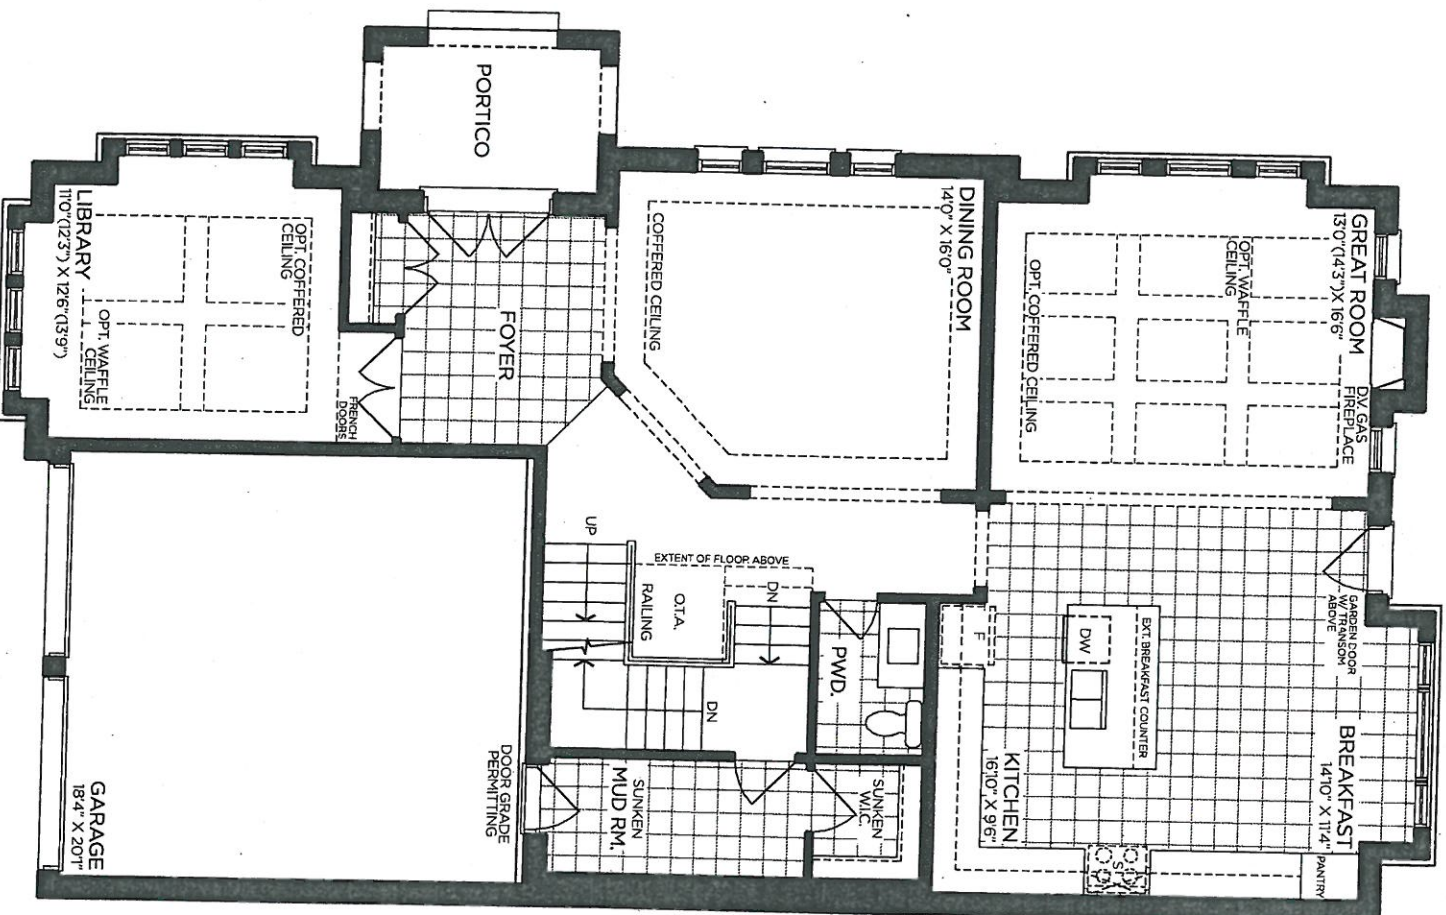

GROUND FLOOR | ELEV. A


VENDOR

PURCHASER

PURCHASER

SCHEDULE 'F'
PV-26 attchd
March 23, 2021

The
Lilac
40' SERIES
→ Elevation A • 3,425 sq.ft.
Elevation B • 3,385 sq.ft.

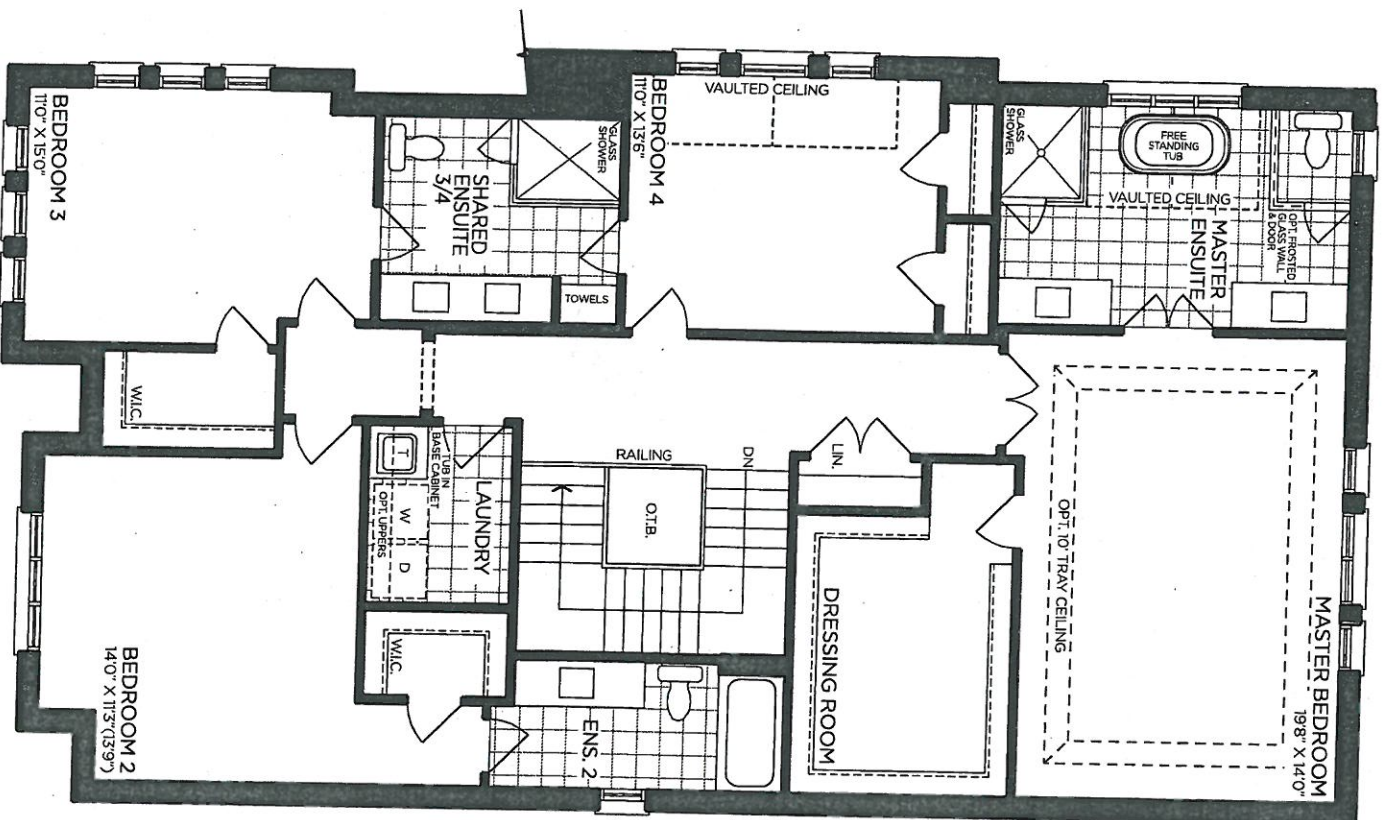

SECOND FLOOR | ELEV. A

VENDOR

PURCHASER

PURCHASER

Prices, figures, illustrations, sizes, features and finishes are subject to change without notice. Areas and dimensions are approximate and actual usable floor space may vary from the stated area. Layout may be reverse of the unit purchased. E. & O.E. 4006

GOLDPARK
WORTH MORE™

PINE VALLEY
FOREVERGREEN


PV-26 attach
March 23, 2021

The Lilac
40' SERIES
→ Elevation A • 3,425 sq.ft.
Elevation B • 3,385 sq.ft.

9 FT
BASEMENT

24" x 30"

24" x 30"

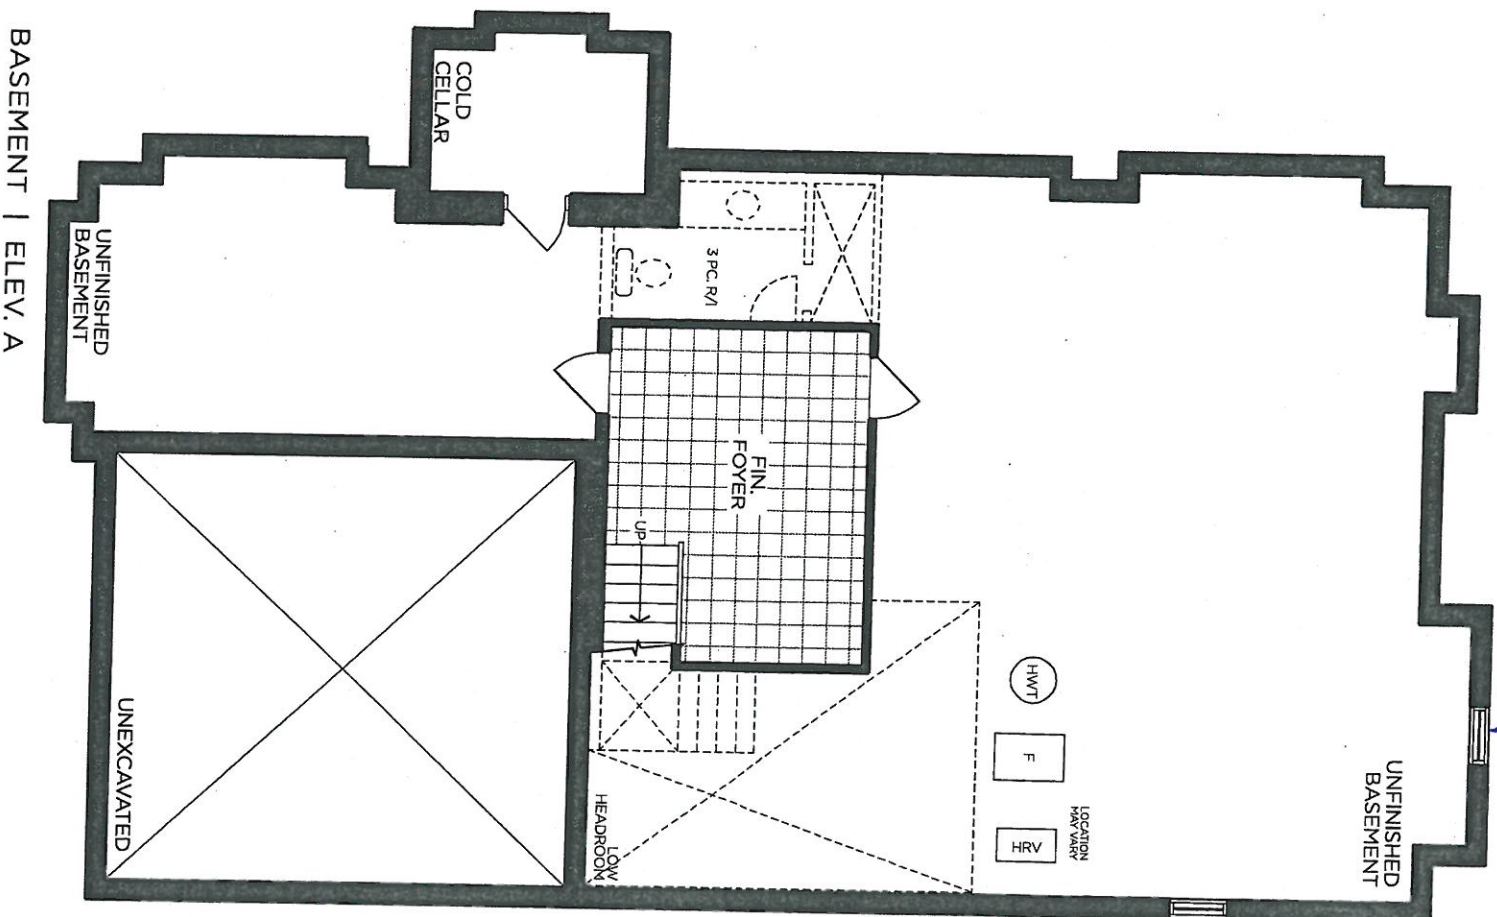

VENDOR

PURCHASER

PURCHASER

GOLDPARK
WORTH MORE™

Prices, figures, illustrations, sizes, features and finishes are subject to change without notice. Areas and dimensions are approximate and actual usable floor space may vary from the stated area. Layout may be reverse of the unit purchased. E. & O.E. 4006




PINE VALLEY
REAL ESTATE

PV-26 (A) (H)
March 23, 2021

The Lilac
40' SERIES
Elevation A • 3,425 sq.ft.
Elevation B • 3,385 sq.ft.

SCHEDULE

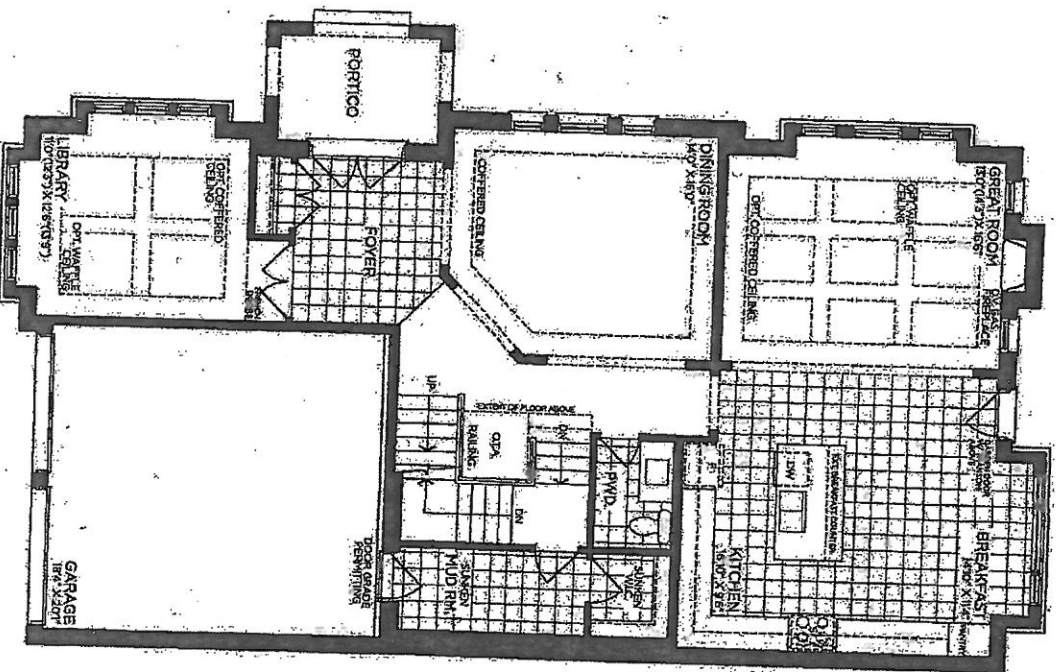

GROUND FLOOR | ELEV. A

VENDOR _____
PURCHASER _____
PURCHASER _____


GOLDPARK
WORTH MORE

Price, layout, materials, etc., features and finishes are subject to change without notice. Areas and dimensions are approximate and actual results may vary from the stated area. Layout may be revised at the time purchased. E & OE 4005

PINE VALLEY
HOUSING

SCHEDULE F
PV-26 01 412
March 23, 2021

The
Lilac
40' SERIES
→ Elevation A • 3,425 sq.ft.
Elevation B • 3,385 sq.ft.

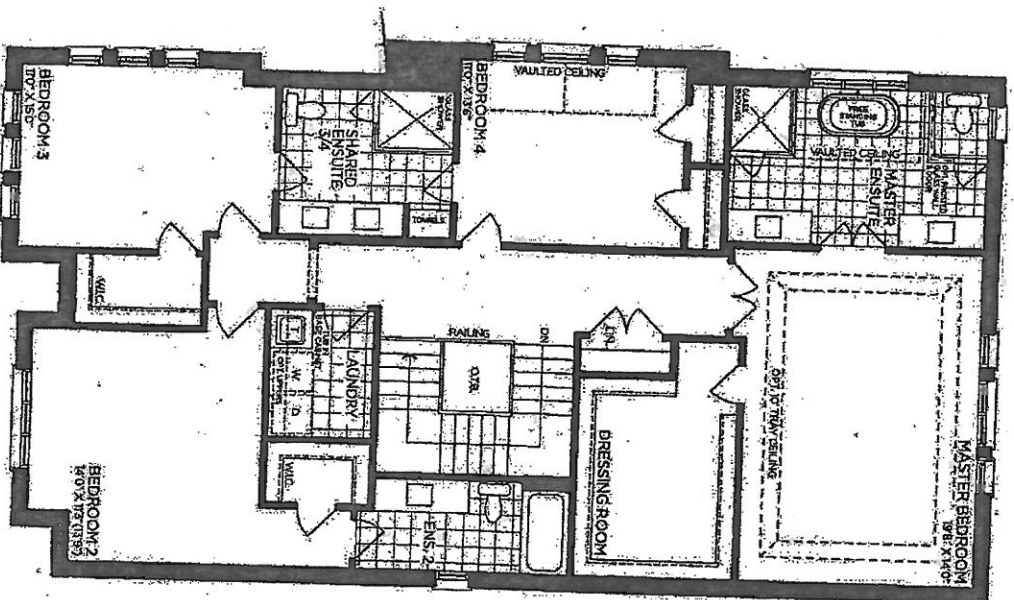

SECOND FLOOR - ELEV. A

VENDOR
PURCHASER
PURCHASER

GOLDPARK
WORTH MORE

Prices, figures, illustrations, show features and finishes are subject to change without notice. Areas and dimensions are approximate and actual usable floor space may vary from the stated floor layout. May be revised at the discretion of the unit purchaser. E. & O.E. 4006

PINE VALLEY
FOUNDATION


SCHEDULE/F
PV-26 (AE) (HX)
March 23, 2021

The
Lilac
40' SERIES
→ Elevation A: 3,425 sq.ft.
Elevation B: 3,385 sq.ft.

9 FT
BASEMENT

24' x 30"

24' x 30"

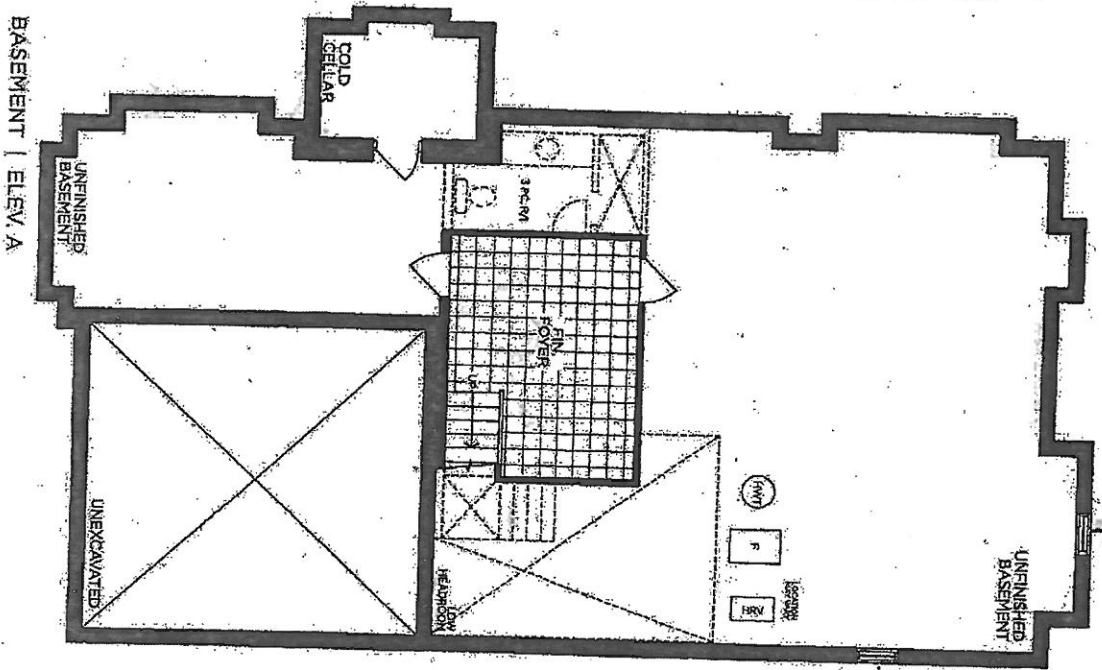

BASEMENT | ELEV. A

VENDOR
PURCHASER
PURCHASER

GOLDPARK
WORTH MORE

Please, figures, illustrations, text, features and finishes are subject to change without notice. Areas and dimensions are approximate and actual results may vary. From the standard design layout (not) for items of the unit purchased. E. & OE. 4006.