



CONSTRUCTION SUMMARY

Lot: 37
Model: 40.04 A DALERIDGE
Project/Phase: Pine Valley Forevergreen / 1

BASEMENT WINDOWS

Invoice	Qty.	Description
2615 72,351 26Mar21	4	BASEMENT WINDOWS: UPGRADE ALL BASEMENT WINDOWS TO APPROX. 30 " X 24" IN LIEU OF STANDARD

DRYWALL

Invoice	Qty.	Description
2615 72,690 26Mar21 **	1	DELETE KITCHEN BULKHEAD, IF POSSIBLE, SITE APPROVAL REQUIRED
2615 26Mar21 NoCat	1	FYI - KITCHEN: PATIO SLIDERS - 6 FOOT VINYL PATIO DOORS WITH WHITE FRAME IN LIEU OF STANDARD GARDEN DOOR
2615 26Mar21 NoCat	1	FYI - BASEMENT: 9 FOOT BASEMENT CEILING HEIGHT IN LIEU OF STANDARD 8 FOOT CEILING.

ELECTRICAL

Invoice	Qty.	Description
2615 72,292 26Mar21	1	FRONT EXTERIOR: ADDITIONAL EXTERIOR COACH LIGHT ON EXISTING SWITCH (BUILDERS STANDARD FIXTURE) - SEE PLAN
2615 72,273 26Mar21	1	KITCHEN: 110V WALL RECEPTACLE ON SEPARATE CIRCUIT - GAS FIRED APPLIANCE - FOR AUX. EQUIPMENT - NOT A STOVE PLUG
2615 72,307 26Mar21	1	KITCHEN: RELOCATE STANDARD CEILING MOUNT FIXTURE TO CEILING CENTERED ABOVE KITCHEN ISLAND - SEE PLAN
2615 72,289 26Mar21	6	KITCHEN: 4" E/S LED INTERIOR POT LIGHT - SEE PLAN
2615 72,281 26Mar21	1	GREAT ROOM: ADDITIONAL WALL OUTLET FOR FUTURE WALL MOUNTED TV - INSTALL ABOVE STANDARD FIREPLACE - APPROX. 64" A.F.F. - SEE PLAN
2615 26Mar21 NoCat	1	FYI - KITCHEN: PATIO SLIDERS - 6 FOOT VINYL PATIO DOORS WITH WHITE FRAME IN LIEU OF STANDARD GARDEN DOOR
2615 26Mar21 NoCat	1	FYI - BASEMENT: 9 FOOT BASEMENT CEILING HEIGHT IN LIEU OF STANDARD 8 FOOT CEILING.



CONSTRUCTION SUMMARY

Lot: 37
Model: 40.04 A DALERIDGE
Project/Phase: Pine Valley Forevergreen / 1

EXTERIOR COLOURS

Invoice	Qty.	Description
2615 26Mar21 NoCat	1	EXTERIOR COLOURS PACKAGE: BR9

EXTERIOR DOORS

Invoice	Qty.	Description
2615 72,359 26Mar21	1	KITCHEN: PATIO SLIDERS - 6 FOOT VINYL PATIO DOORS WITH WHITE FRAME IN LIEU OF STANDARD GARDEN DOOR

FORMING

Invoice	Qty.	Description
2615 72,196 26Mar21	1	BASEMENT: 9 FOOT BASEMENT CEILING HEIGHT IN LIEU OF STANDARD 8 FOOT CEILING.

FRAMING

Invoice	Qty.	Description
2615 72,690 26Mar21	1	DELETE KITCHEN BULKHEAD, IF POSSIBLE, SITE APPROVAL REQUIRED
2615 26Mar21 NoCat	1	FYI - KITCHEN: PATIO SLIDERS - 6 FOOT VINYL PATIO DOORS WITH WHITE FRAME IN LIEU OF STANDARD GARDEN DOOR

HVAC

Invoice	Qty.	Description
2615 72,224 26Mar21	1	KITCHEN: INSTALL GAS LINE ROUGH-IN - FOR STOVE - SEE PLAN
2615 72,690 26Mar21 **	1	DELETE KITCHEN BULKHEAD, IF POSSIBLE, SITE APPROVAL REQUIRED

INTERIOR TRIM AND DOORS

Invoice	Qty.	Description
2615 26Mar21 NoCat	1	FYI - BASEMENT: 9 FOOT BASEMENT CEILING HEIGHT IN LIEU OF STANDARD 8 FOOT CEILING.

KITCHEN AND BATH CABINETRY

Invoice	Qty.	Description
2615 72,690 26Mar21 **	1	DELETE KITCHEN BULKHEAD, IF POSSIBLE, SITE APPROVAL REQUIRED



CONSTRUCTION SUMMARY

Lot: 37
Model: 40.04 A DALERIDGE
Project/Phase: Pine Valley Forevergreen / 1

MASONRY

Invoice	Qty.	Description
2615 26Mar21 NoCat	1	FYI - FRONT EXTERIOR: ADDITIONAL EXTERIOR COACH LIGHT ON EXISTING SWITCH (BUILDERS STANDARD FIXTURE) - SEE PLAN
2615 26Mar21 NoCat	1	FYI - KITCHEN: PATIO SLIDERS - 6 FOOT VINYL PATIO DOORS WITH WHITE FRAME IN LIEU OF STANDARD GARDEN DOOR

PAINTING

Invoice	Qty.	Description
2615 72,690 26Mar21 **	1	DELETE KITCHEN BULKHEAD, IF POSSIBLE, SITE APPROVAL REQUIRED

PANL - FRAMING

Invoice	Qty.	Description
2615 72,690 26Mar21 **	1	DELETE KITCHEN BULKHEAD, IF POSSIBLE, SITE APPROVAL REQUIRED

PLUMBING

Invoice	Qty.	Description
2615 26Mar21 NoCat	1	FYI - BASEMENT: 9 FOOT BASEMENT CEILING HEIGHT IN LIEU OF STANDARD 8 FOOT CEILING.




SCHEDULE 'F'

PV-37
March 8 2021
attached

The Daleridge

40' SERIES

→ Elevation A • 3,335 sq.ft.
Elevation B • 3,395 sq.ft.
Elevation C • 3,370 sq.ft.

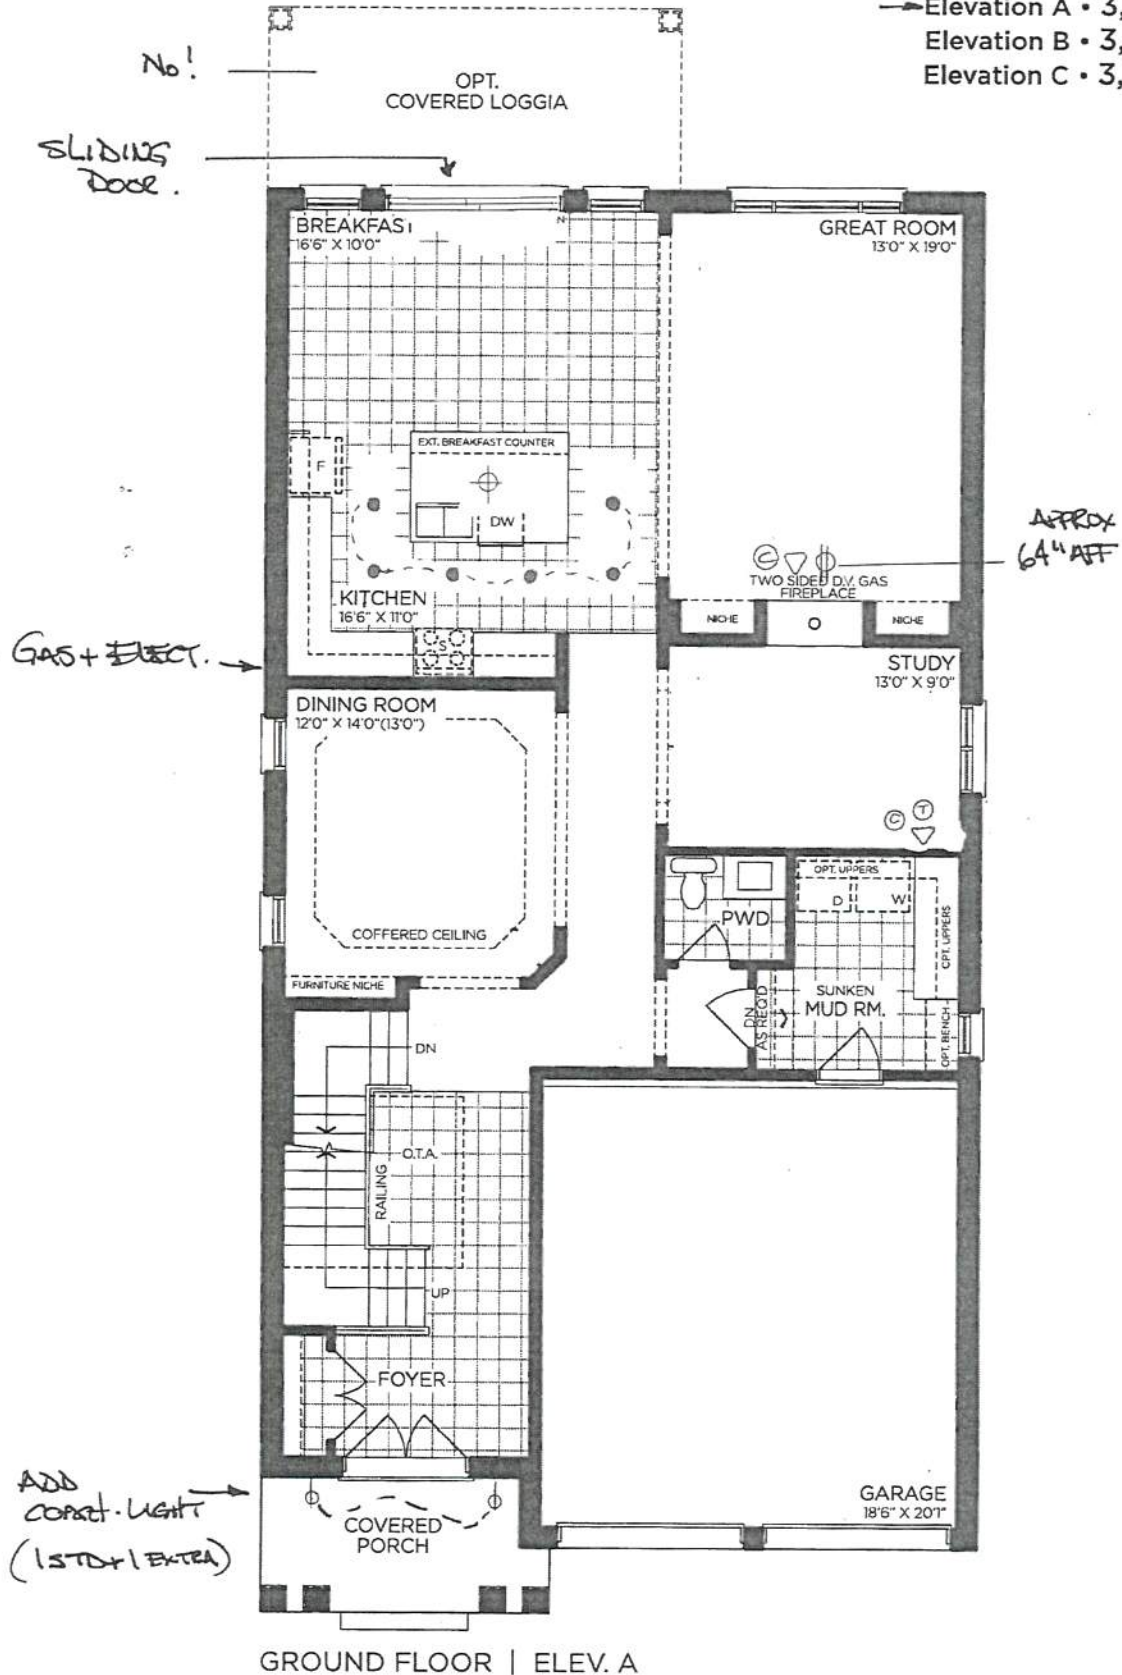

VENDOR


PURCHASER

PURCHASER

GOLDPARK
WORTH MORE™

Prices, figures, illustrations, sizes, features and finishes are subject to change without notice. Areas and dimensions are approximate and actual usable floor space may vary from the stated area. Layout may be reverse of the unit purchased. E. & O.E. 4004

attached

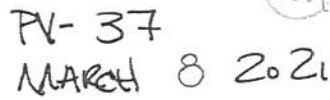

→ Elevation A • 3,335 sq.ft.
Elevation B • 3,395 sq.ft.
Elevation C • 3,370 sq.ft.



VENDOR	
PURCHASER	
PURCHASER	

GOLDPARK
WORTH MORE™

Prices, figures, illustrations, sizes, features and finishes are subject to change without notice. Areas and dimensions are approximate and actual usable floor space may vary from the stated area. Layout may be reverse of the unit purchased. E. & O.E. 4004




SCHEDULE 'F'

PV-37
MAR 8 2021
attached

The Daleridge
40' SERIES

- Elevation A • 3,335 sq.ft.
- Elevation B • 3,395 sq.ft.
- Elevation C • 3,370 sq.ft.

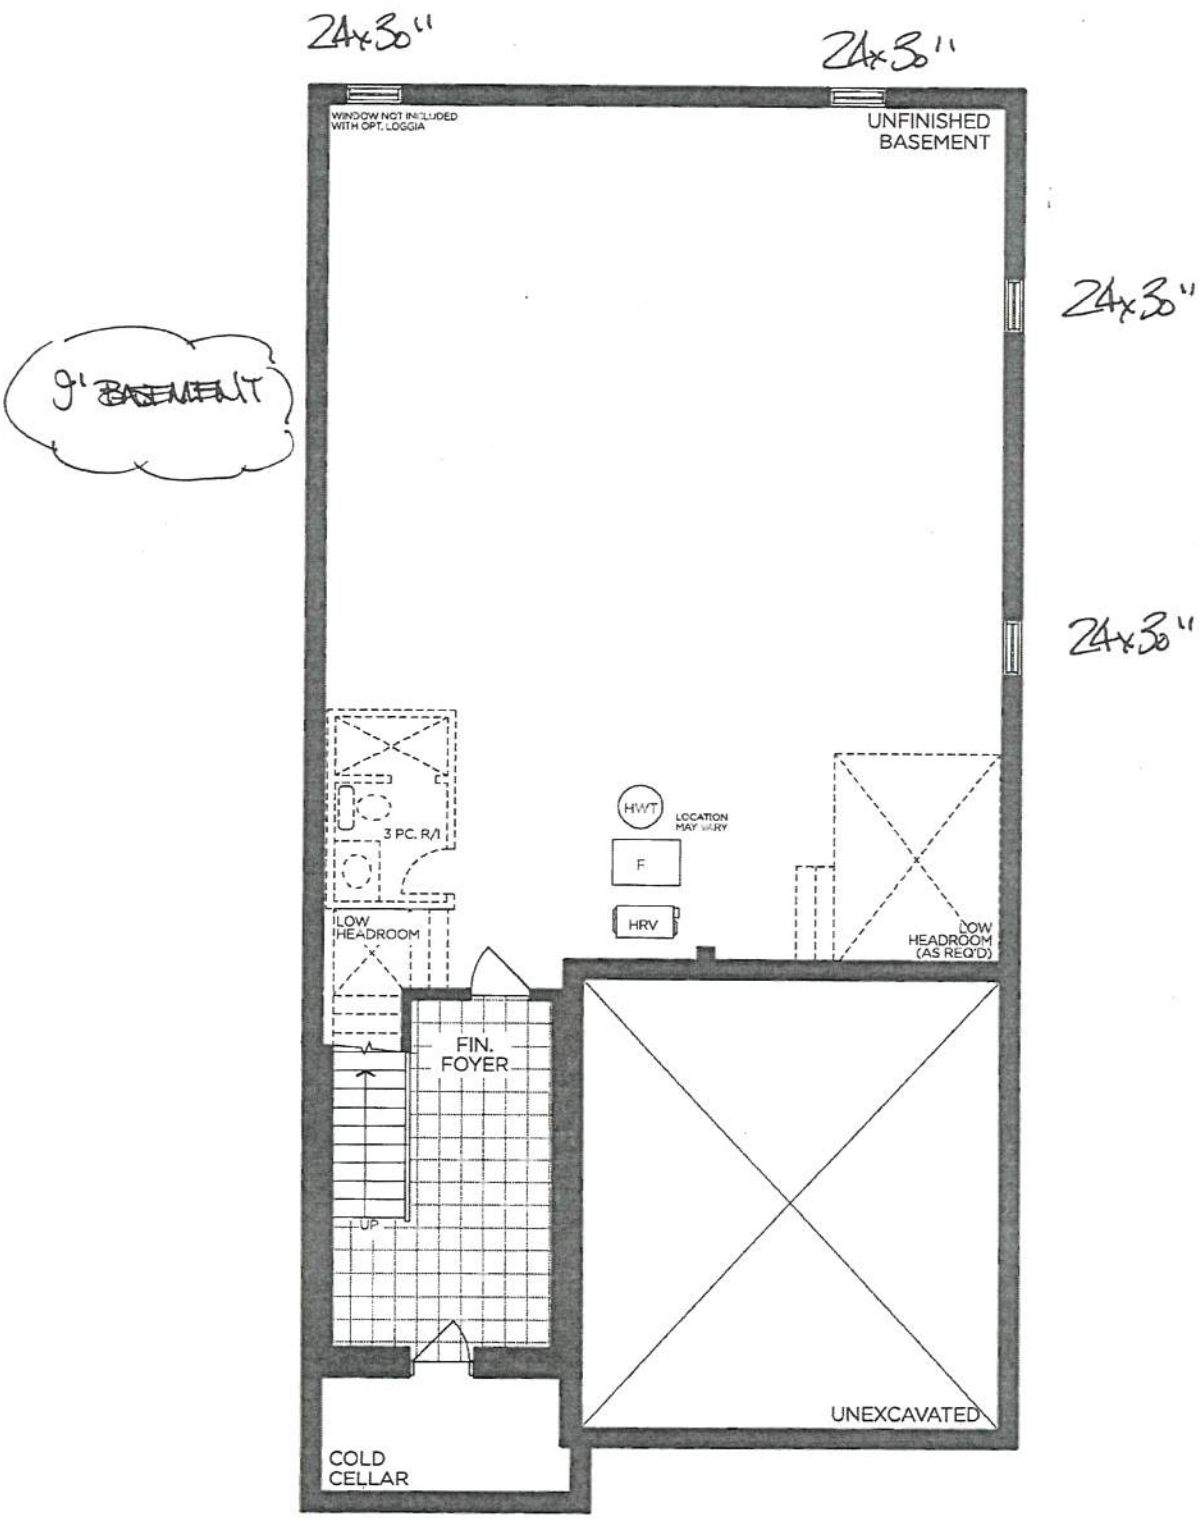

BASEMENT | ELEV. A

VENDOR

PURCHASER

PURCHASER

GOLDPARK
WORTH MORE™


Prices, figures, illustrations, sizes, features and finishes are subject to change without notice. Areas and dimensions are approximate and actual usable floor space may vary from the stated area. Layout may be reverse of the unit purchased. E. & O.E. 4004



SCHEDULE 'F'
PV-37 09
March 8 2021 BS

The Daleridge 40' SERIES

Elevation A • 3,335 sq.ft.
Elevation B • 3,395 sq.ft.
Elevation C • 3,370 sq.ft.

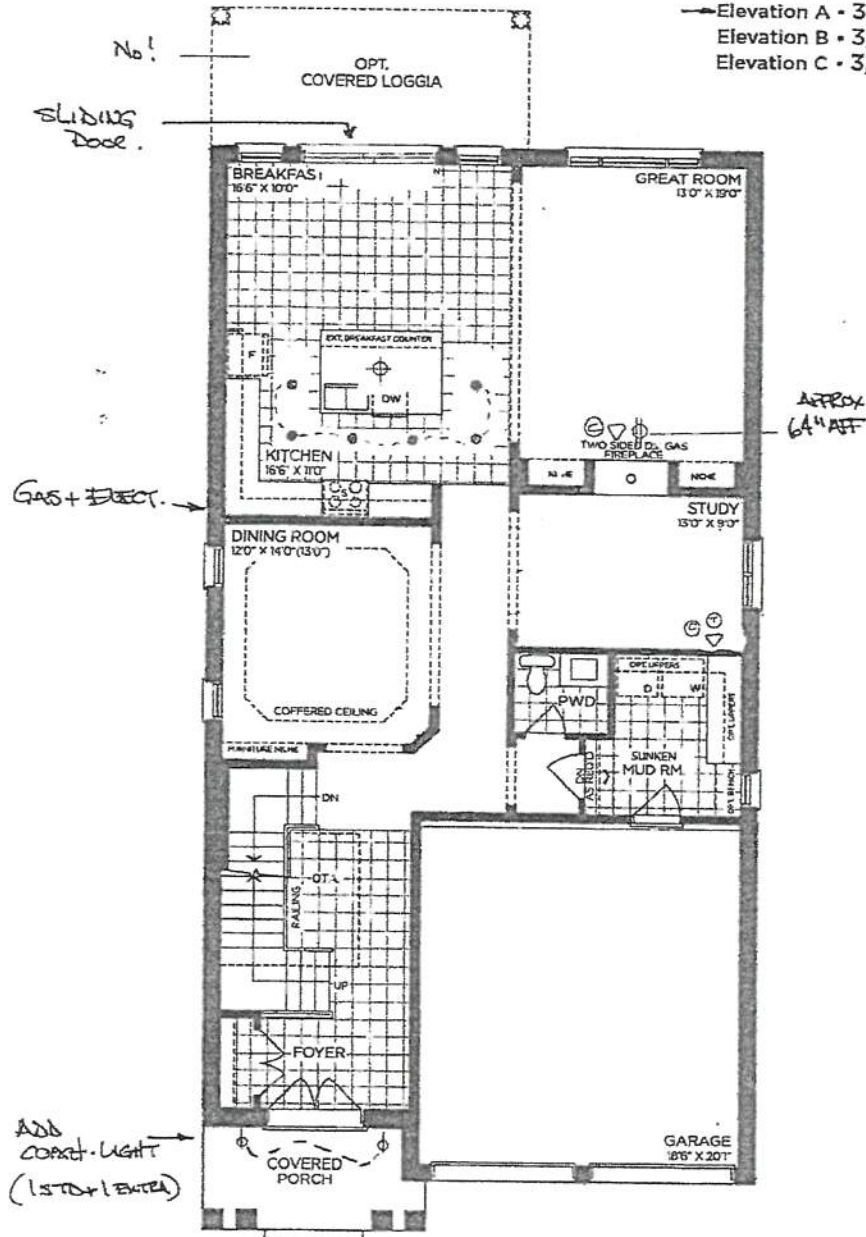

GROUND FLOOR | ELEV. A

VENDOR
PURCHASER Dr. Oliver
PURCHASER

GOLDPARK
WORTH MORE

Prices, figures, illustrations, sizes, features and finishes are subject to change without notice. Areas and dimensions are approximate and actual usable floor space may vary from the stated area. Layout may be reverse of the unit purchased. E. & O.E. 4004




SCHEDULE 'F'

12th B.S.
PV- 37
MARCH 8 2021

The
Daleridge
40' SERIES

→ Elevation A • 3,335 sq.ft.
Elevation B • 3,395 sq.ft.
Elevation C • 3,370 sq.ft.

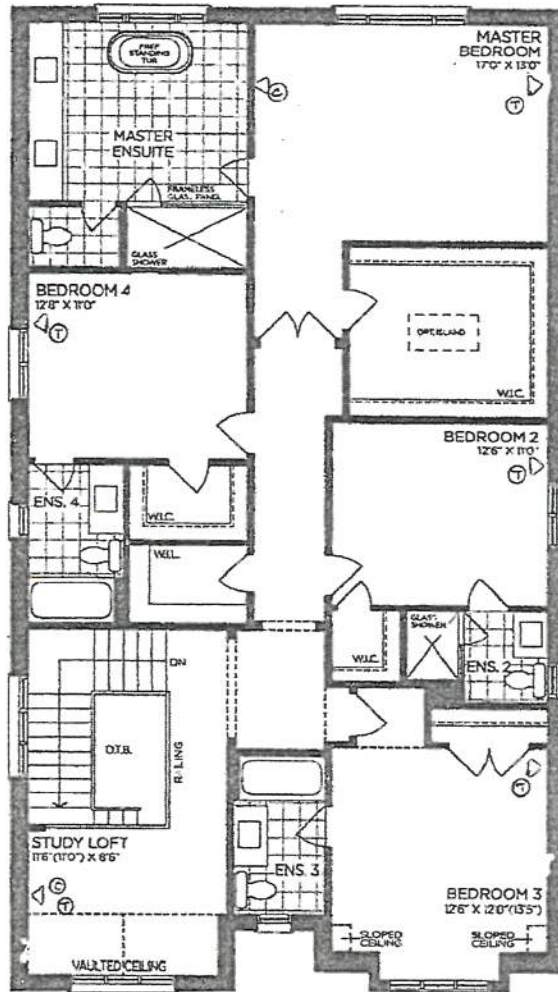

SECOND FLOOR | ELEV. A

VENDOR
PURCHASER
PURCHASER

GOLDPARK
WORTH MORE™

Prices, figures, illustrations, sizes, features and finishes are subject to change without notice. Areas and dimensions are approximate and actual usable floor space may vary from the stated area. Layout may be reverse of the unit purchased. E & O.E. 4004




SCHEDULE 'F'

PV-37
MARCH 5 2021 B.S.

The Daleridge 40' SERIES

Elevation A • 3,335 sq.ft.
Elevation B • 3,395 sq.ft.
Elevation C • 3,370 sq.ft.

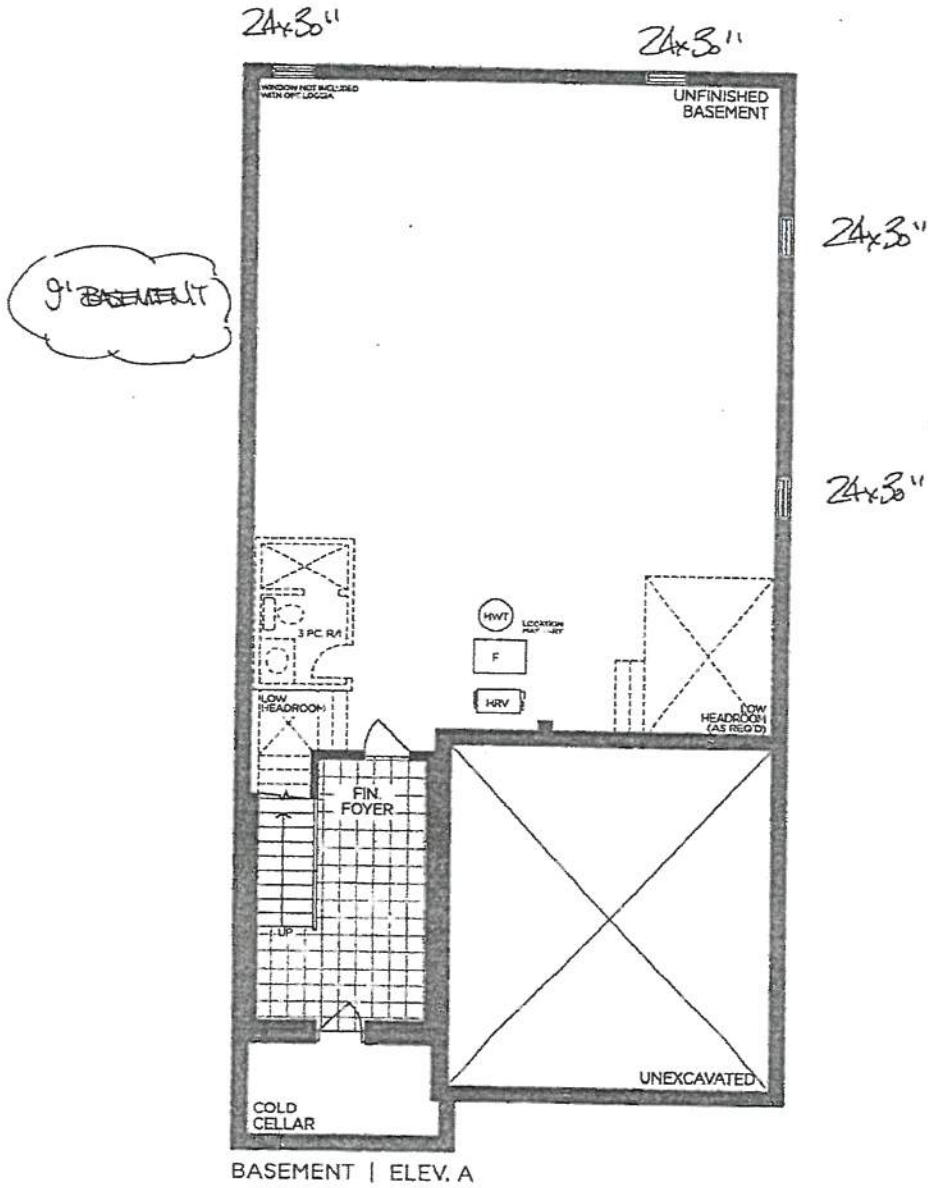

VENDOR

PURCHASER

PURCHASER

GOLDPARK
WORTH MORE

Prices, figures, illustrations, sizes, features and finishes are subject to change without notice. Areas and dimensions are approximate and actual usable floor space may vary from the stated area. Layout may be reverse of the unit purchased. E. & O.E. 4004