



CONSTRUCTION SUMMARY

Lot: 42
Model: 40.02 A VALLEYVIEW
Project/Phase: Pine Valley Forevergreen / 1

BASEMENT WINDOWS

Invoice	Qty.	Description
2620 26Mar21 ** NoCat	4	BASEMENT WINDOWS - UPGRADE BASEMENT WINDOW SIZE TO 30 " X 24" - 8" FRAME

DRYWALL

Invoice	Qty.	Description
2620 26Mar21 NoCat	1	MASTER BEDROOM: OPT. 10 FOOT TRAY CEILING AS PER PLAN

2620 26Mar21 NoCat	1	FYI - BASEMENT: 9 FOOT BASEMENT CEILING HEIGHT IN LIEU OF STANDARD 8 FOOT CEILING
------------------------------	---	---

ELECTRICAL

Invoice	Qty.	Description
2620 26Mar21 ** NoCat	4	BASEMENT WINDOWS - UPGRADE BASEMENT WINDOW SIZE TO 30 " X 24" - 8" FRAME

2620 26Mar21 NoCat	1	FYI - BASEMENT: 9 FOOT BASEMENT CEILING HEIGHT IN LIEU OF STANDARD 8 FOOT CEILING
------------------------------	---	---

FORMING

Invoice	Qty.	Description
2620 26Mar21 ** NoCat	4	BASEMENT WINDOWS - UPGRADE BASEMENT WINDOW SIZE TO 30 " X 24" - 8" FRAME

2620 72,193 26Mar21	1	BASEMENT: 9 FOOT BASEMENT CEILING HEIGHT IN LIEU OF STANDARD 8 FOOT CEILING
---------------------------	---	---

FRAMING

Invoice	Qty.	Description
2620 72,388 26Mar21	1	MASTER BEDROOM: OPT. 10 FOOT TRAY CEILING AS PER PLAN



CONSTRUCTION SUMMARY

Lot: 42
Model: 40.02 A VALLEYVIEW
Project/Phase: Pine Valley Forevergreen / 1

INTERIOR TRIM AND DOORS

Invoice	Qty.	Description
2620 26Mar21 NoCat	1	FYI - BASEMENT: 9 FOOT BASEMENT CEILING HEIGHT IN LIEU OF STANDARD 8 FOOT CEILING

PAINT

Invoice	Qty.	Description
2620 26Mar21 NoCat	1	MASTER BEDROOM: OPT. 10 FOOT TRAY CEILING AS PER PLAN
2620 26Mar21 NoCat	1	FYI - BASEMENT: 9 FOOT BASEMENT CEILING HEIGHT IN LIEU OF STANDARD 8 FOOT CEILING

PLUMBING

Invoice	Qty.	Description
2620 26Mar21 NoCat	1	FYI - BASEMENT: 9 FOOT BASEMENT CEILING HEIGHT IN LIEU OF STANDARD 8 FOOT CEILING


SCHEDULE 'F'



PV-42
MARCH 5 2021
see attach

The
Valleyview
40' SERIES

→ Elevation A • 3,145 sq.ft.
Elevation B • 3,170 sq.ft.

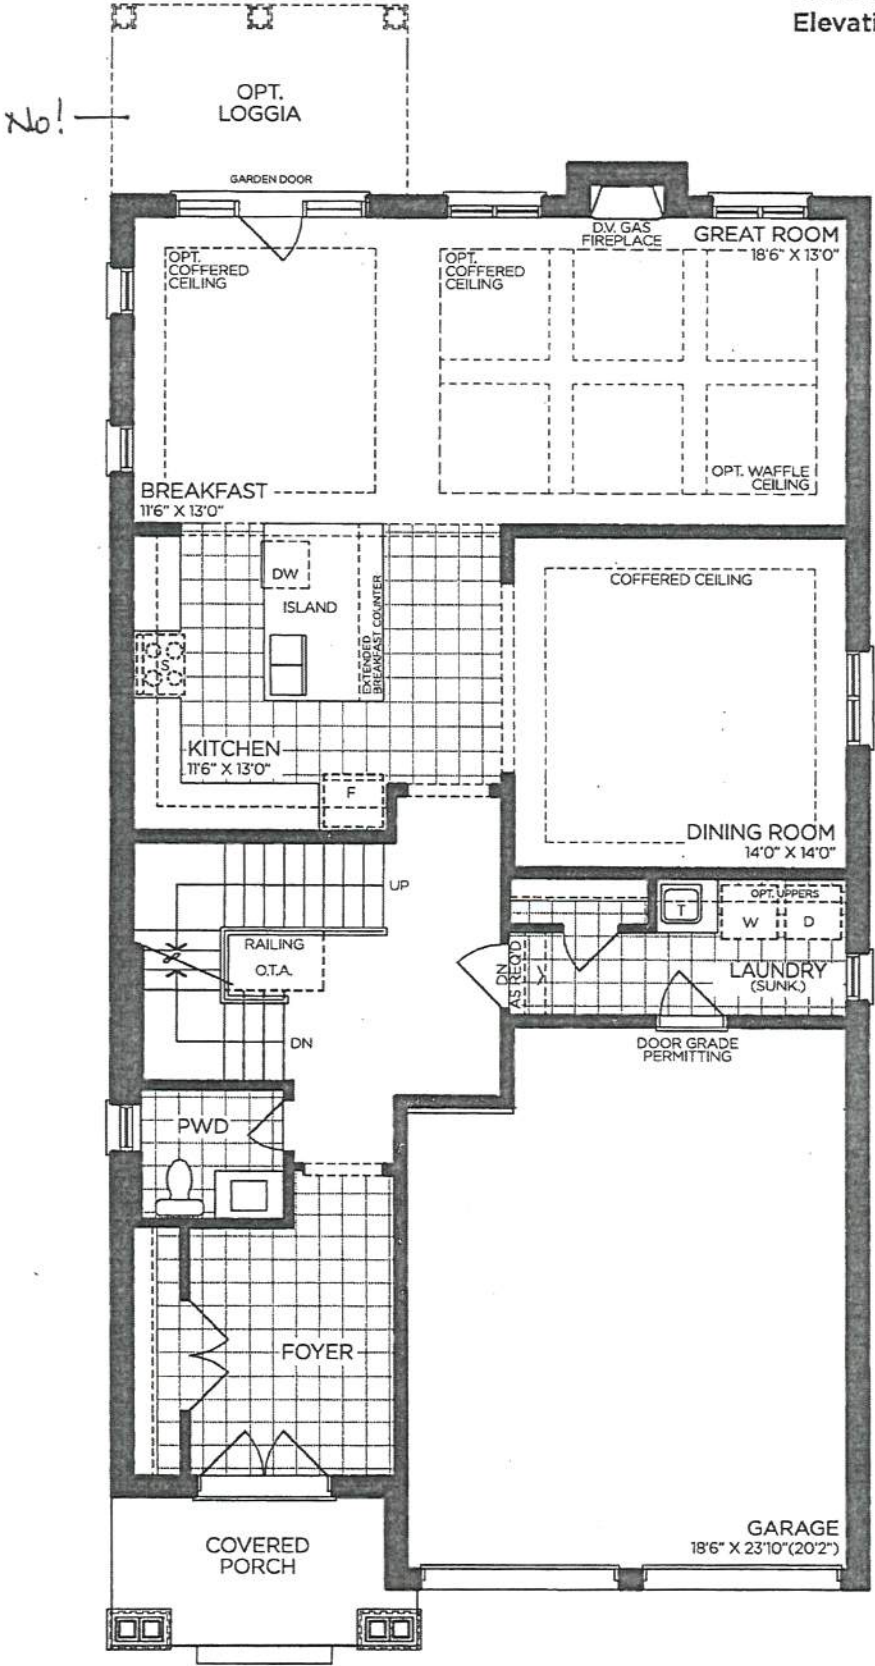

GROUND FLOOR | ELEV. A

VENDOR

PURCHASER

PURCHASER

GOLDPARK
WORTH MORE™

Prices, figures, illustrations, sizes, features and finishes are subject to change without notice. Areas and dimensions are approximate and actual usable floor space may vary from the stated area. Layout may be reverse of the unit purchased. E. & O.E. 4002



SCHEDULE 'F'

PV-42


March 5 2021

see attach.

The Valleyview

40' SERIES

→ Elevation A • 3,145 sq.ft.
Elevation B • 3,170 sq.ft.

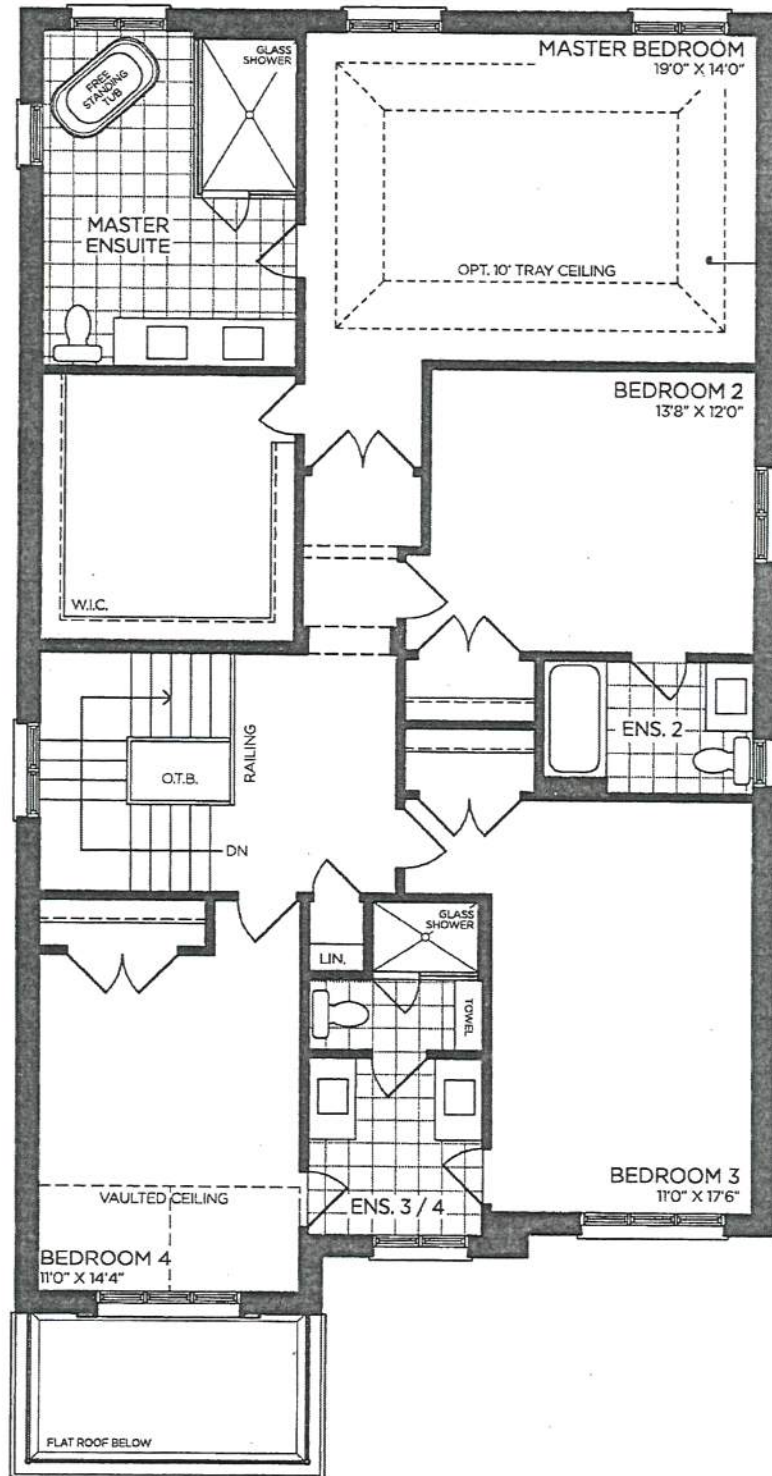

SECOND FLOOR | ELEV. A

VENDOR	
PURCHASER	
PURCHASER	

GOLDPARK
WORTH MORE™

Prices, figures, illustrations, sizes, features and finishes are subject to change without notice. Areas and dimensions are approximate and actual usable floor space may vary from the stated area. Layout may be reverse of the unit purchased. E. & O.E. 4002




SCHEDULE 'F'

PV-42
March 5 2021
see attach.

The Valleyview

40' SERIES

→ Elevation A • 3,145 sq.ft.
Elevation B • 3,170 sq.ft.

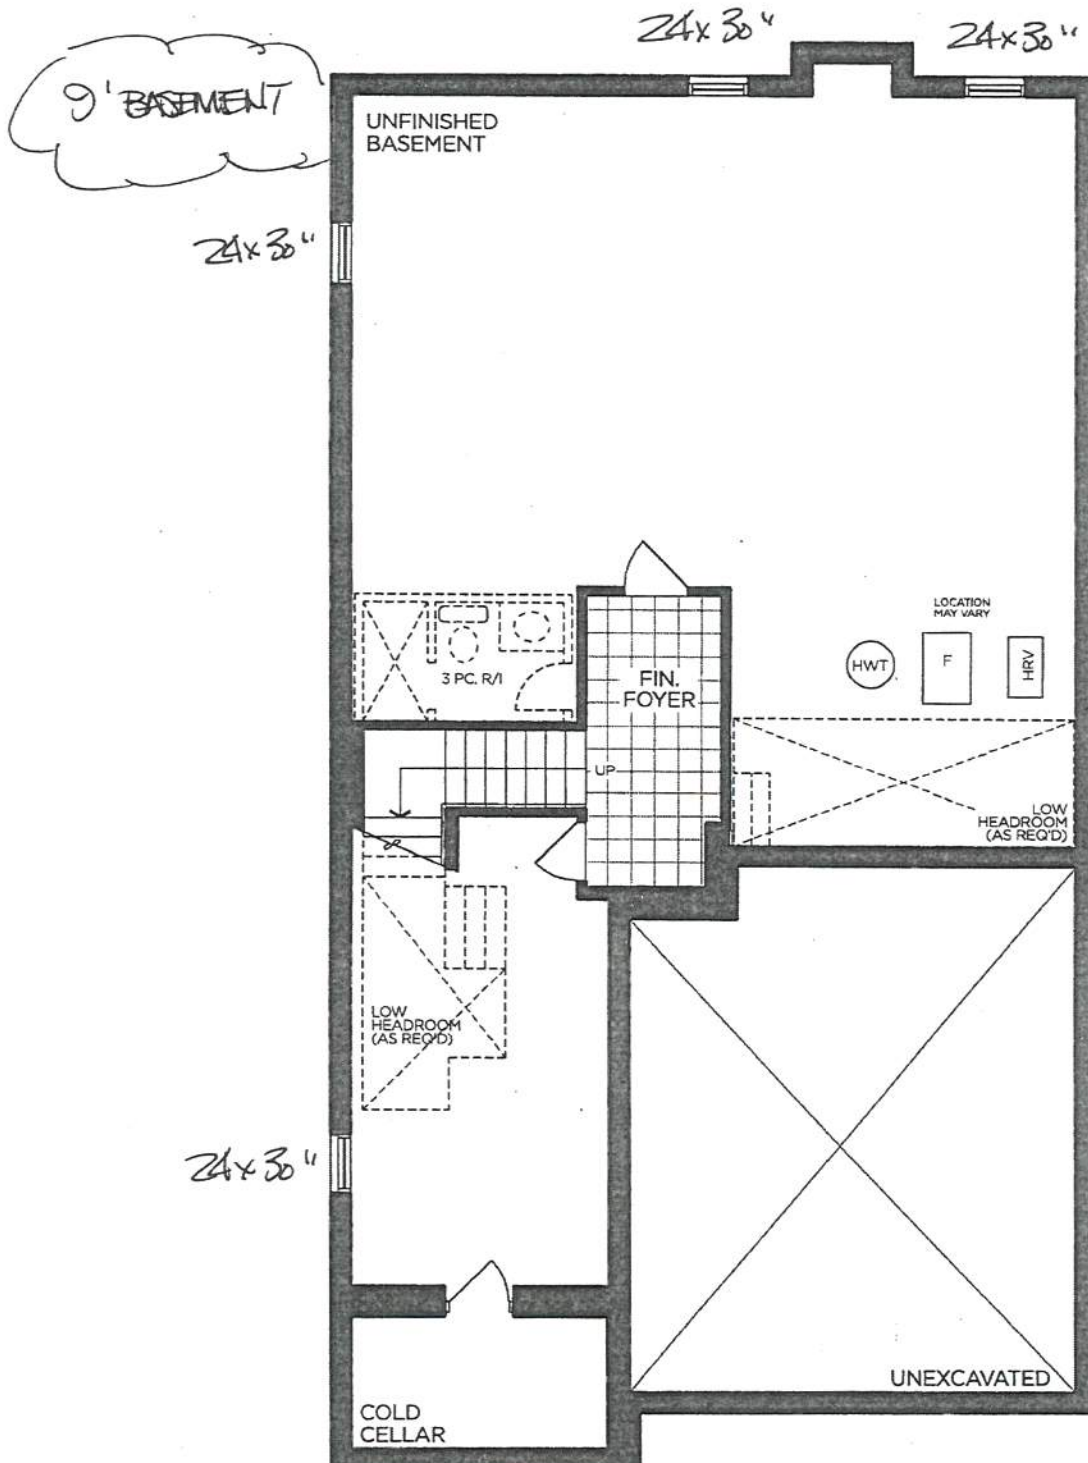

BASEMENT | ELEV. A

VENDOR

PURCHASER

PURCHASER

GOLDPARK
WORTH MORE™

Prices, figures, illustrations, sizes, features and finishes are subject to change without notice. Areas and dimensions are approximate and actual usable floor space may vary from the stated area. Layout may be reverse of the unit purchased. E. & O.E. 4002


SCHEDULE 'F'



PV-42
MARCH 5 2021

The Valleyview 40' SERIES

→ Elevation A • 3,145 sq.ft.
Elevation B • 3,170 sq.ft.

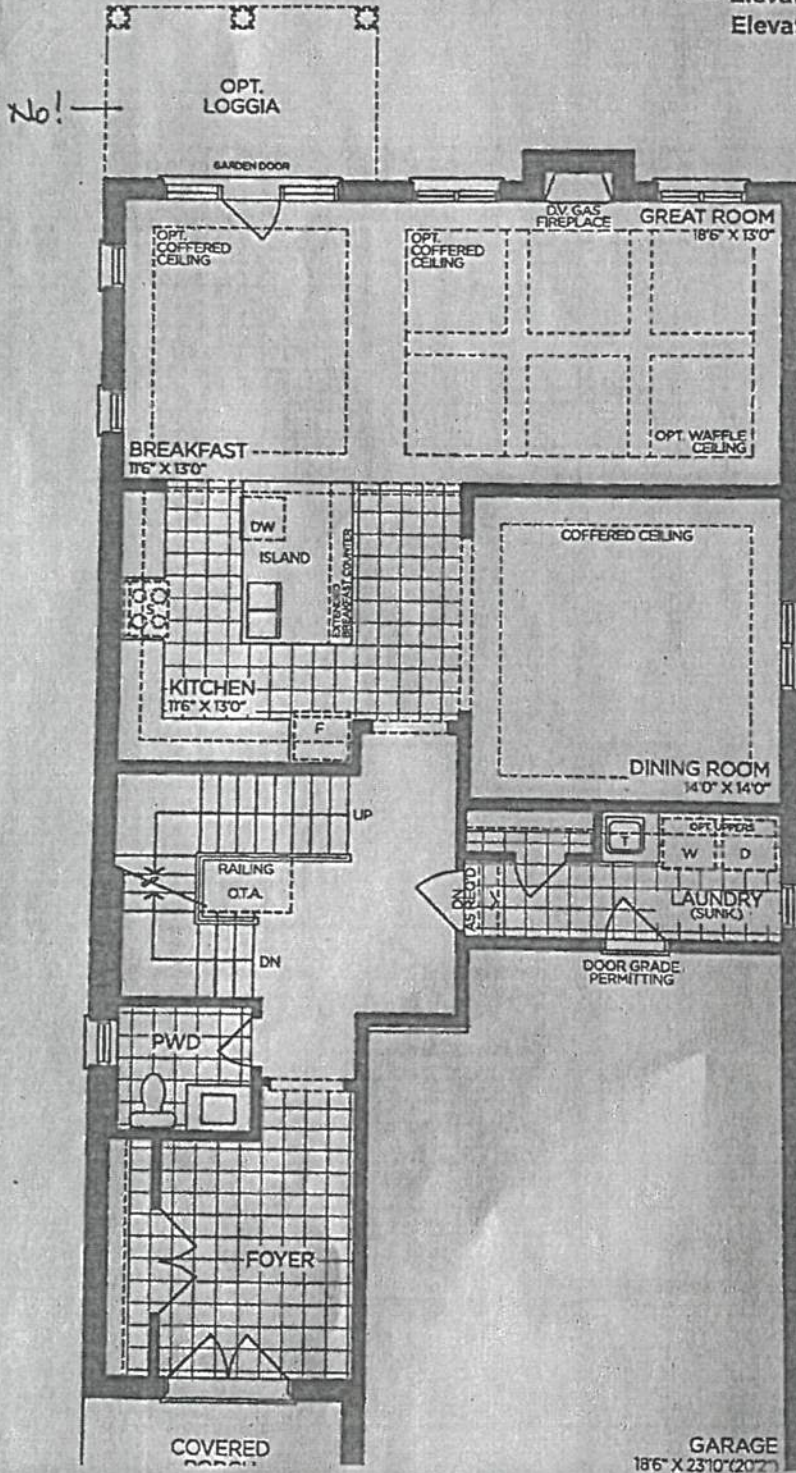

SCHEDULE 'F'


PV-42
March 5 2021



The Valleyview

40' SERIES

Elevation A • 3,145 sq.ft.
Elevation B • 3,170 sq.ft.

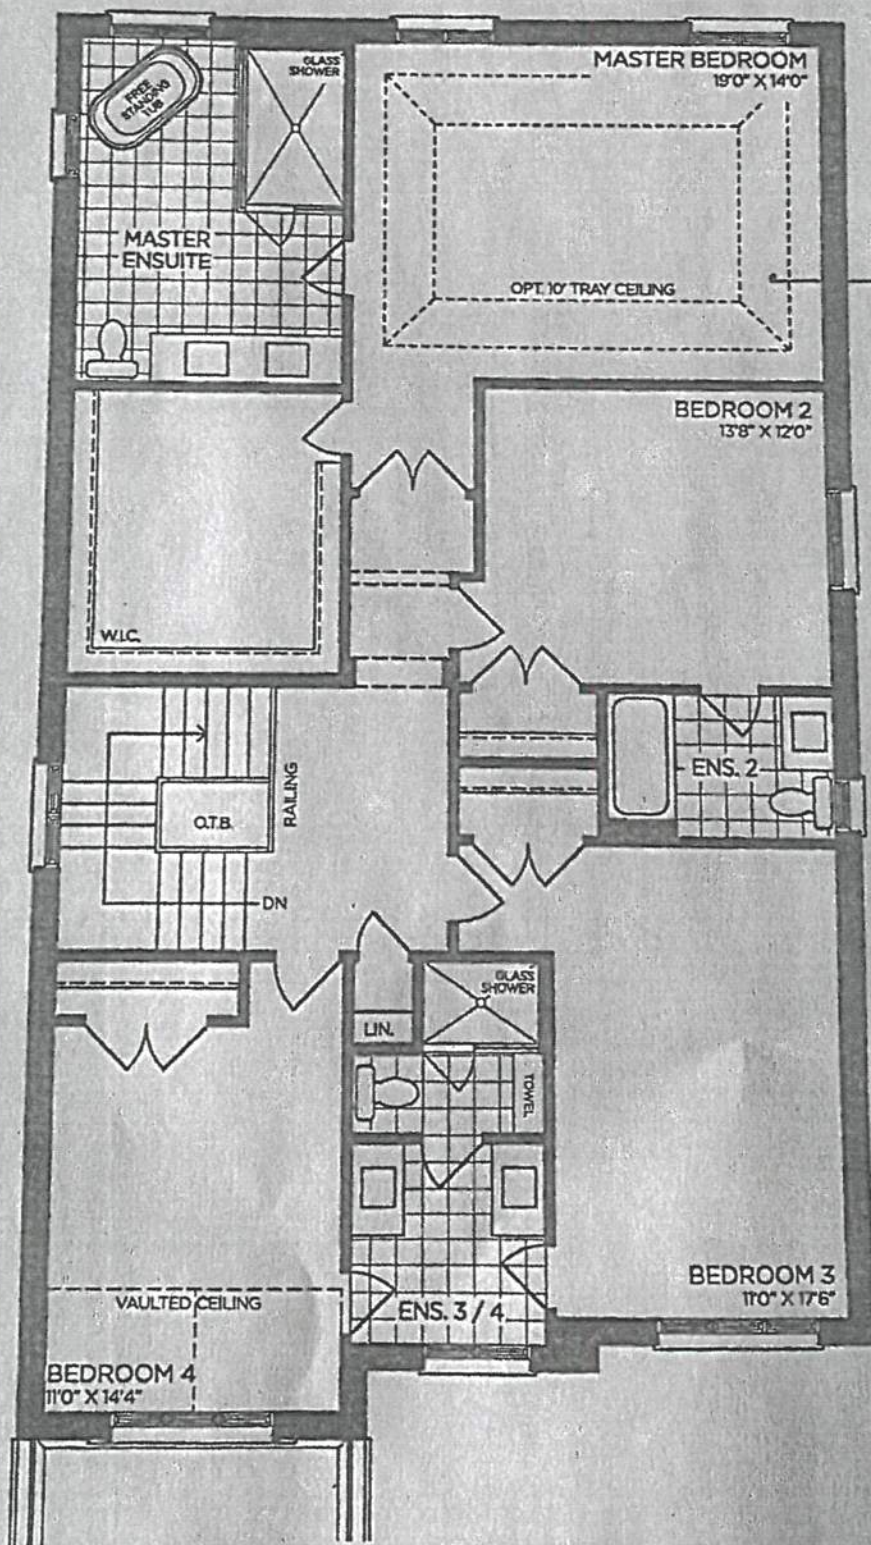




PV-42
March 5 2021

SCHEDULE 'F'

The Valleyview 40' SERIES

→ Elevation A • 3,145 sq.ft.
Elevation B • 3,170 sq.ft.

9' BASEMENT

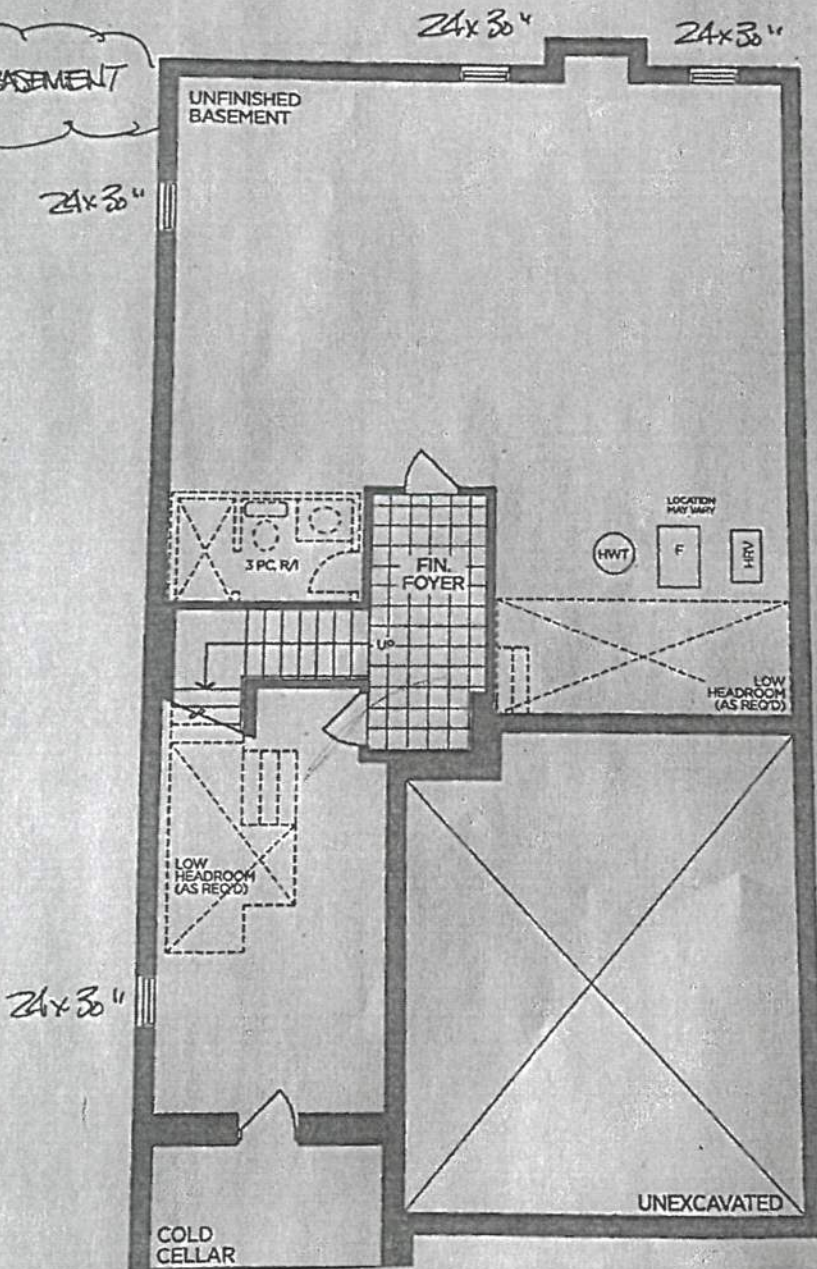

al m