

Lot: 40

Model: 40.02 B VALLEYVIEW

Project/Phase: Pine Valley Forevergreen / 1

Invoice Qty. Description	APPLIANCES				
		Invoice	7. Description		

2600	1	ATTACHED SIGNED APPLIANCE SPECIFICATIONS
23Feb21 NoCat		
2634	1	APPLIANCES: HOOD FAN SPECIFICATIONS - SIGNED/APPROVED ATTACHED
11Mar21		

CERAMIC

CEILINIE		
Invoice	Qty.	Description
2600	1	MASTER ENSUITE: SHOWER NICHE [SHAMPOO SHELF] - COMPLETE WITH MATCHING MARBLE JAMBS ON 4 SIDES, STANDARD TILE, APPROX. 12 X 18 INSTALLED VERTICALLY - SEE PLAN FOR LOCATION
23Feb21 NoCat		
2603 37 11Mar21	1	POWDER ROOM: TILE, FLOOR , LEVEL 5 - 12X24" LAID IN STRAIGHT, STACKED PATTERN. SEE PLAN FOR TILE DIRECTION
2603 37 11Mar21	1	MASTER ENSUITE: TILE, FLOOR , LEVEL 5 - 24X24" LAID IN STRAIGHT, STACKED PATTERN.
2603 51 11Mar21	1	MASTER ENSUITE: TILE, WALL, LEVEL 3 - 12X24" LAID IN HORIZONTAL, STACKED PATTERN.

CROWN MOULDING

Invoice	Qty.	Description
2600	-	GREAT ROOM: MODEL OPTIONS 40.02 - GREAT ROOM - OPT. WAFFLE CEILING, BEAM DETAIL AS PER PLAN (6 BOXES) OPTION # 1 - CTR-B07
23Feb21 NoCat		

DisciplineMS.rpt 23feb21 Page 1 of 7



Lot: 40

Model: 40.02 B VALLEYVIEW

Project/Phase: Pine Valley Forevergreen / 1

DRYWALL

Invoice	Qty.	Description
2600 72,373 23Feb21	1	MASTER BEDROOM: MODEL OPTIONS 40.02 - MASTER BEDROOM - OPT. 10 FOOT TRAY CEILING
2600 72,384 23Feb21	1	BREAKFAST: MODEL OPTIONS 40.02 - BREAKFAST ROOM OPT. COFFERED CEILING - AS PER PLAN
2600 72,385 23Feb21	1	GREAT ROOM: MODEL OPTIONS 40.02 - GREAT ROOM - OPT. COFFERED CEILING - AS PER PLAN
2600 72,387 23Feb21	1	GREAT ROOM: MODEL OPTIONS 40.02 - GREAT ROOM - OPT. WAFFLE CEILING, BEAM DETAIL AS PER PLAN (6 BOXES) OPTION # 1 - CTR-B07
2600 23Feb21 NoCat	1	MASTER ENSUITE: SHOWER NICHE [SHAMPOO SHELF] - COMPLETE WITH MATCHING MARBLE JAMBS ON 4 SIDES, STANDARD TILE, APPROX. 12 X 18 INSTALLED VERTICALLY - SEE PLAN FOR LOCATION

DisciplineMS.rpt 23feb21 Page 2 of 7



Lot: 40

Model: 40.02 B VALLEYVIEW

Project/Phase: Pine Valley Forevergreen / 1

ELECTRICAL

ELECTRICAL TO A CONTRACT OF THE PROPERTY OF TH				
Invoice	Qty.	Description		
2600 72,281 23Feb21	1	GREAT ROOM: INTERIOR WALL OUTLET: ADDITIONAL 110V WALL INTERIOR RECEPTACLE ON EXISTING CIRCUIT FOR WALL MOUNTED TV - LOCATE APPROX 66" A.F.F. ABOVE FIREPLACE		
2600 72,273 23Feb21	1	KITCHEN: 110V WALL RECEPTACLE ON SEPARATE CIRCUIT - GAS FIRED RANGE - FOR AUX. EQUIPMENT - NOT A STOVE PLUG		
2600 72,272 23Feb21	1	KITCHEN: 110V WALL RECEPTACLE ON SEPARATE CIRCUIT - FOR MICROWAVE - MICROWAVE NOT INCLUDED SEE PLAN FOR LOCATION		
2600 72,303 23Feb21	1	KITCHEN: FIXTURE: UNDER CABINET FLUORESCENT LIGHT FIXTURES **INCLUDES RECESSED CABINETRY VALANCE**		
2600 72,289 23Feb21	6	GREAT ROOM / BREAKFAST: 4" E/S LED INTERIOR POT LIGHT - GROUND FLOOR - EACH INCLUDED IN APS		
2600 72,278 23Feb21	2	GREAT ROOM + BREAKFAST ROOM: ADDITIONAL INTERIOR SWITCH FOR POTLIGHTS		
2600 72,288 23Feb21	2	MASTER ENSUITE: ROUGH-IN FOR ADDITIONAL WALL SCONCE (I) CAPPED OUTLET ON EXISTING SWITCH - FIXTURE NOT INCLUDED LOCATE OPPOSITE ENDS OF VANITY - SAME HEIGHT AND SWITCH AS STANDARD VANITY LIGHT		
2600 72,310 23Feb21	1	MASTER ENSUTIE: UPGRADE STANDARD CEILING MOUNT FIXTURE TO (1) LED POT LIGHT - SECOND FLOOR - SEE PLAN FOR LOCATION		
2600 72,290 23Feb21	2	MASTER ENSUITE: 4" E/S LED INTERIOR POT LIGHT (INSULATED CEILING) - SECOND FLOOR - EACH USE SAME SWITCH AS STANDARD		
2600 72,307 23Feb21	1	KITCHEN: FIXTURE: RELOCATE STANDARD CEILING MOUNT FIXTURE - LOCATE APPROX CENTERED ABOVE ISLAND - SEE PLAN FOR LOCATION		
2600 72,280 23Feb21	1	KITCHEN: CEILING OUTLET: ADDITIONAL REINFORCED CEILING OUTLET - LOCATE APPROX CENTERED ABOVE ISLAND - SEE PLAN FOR LOCATION USE SAME SWITCH AS STANDARD		

EXTERIOR COLOURS

Entremon colocus			
Invoice	Qty.	Description	
2603	1	EXTERIOR COLOUR PACKAGE: BR5	
11Mar21 NoCat			

DisciplineMS.rpt 23feb21 Page 3 of 7



Lot: 40

Model: 40.02 B VALLEYVIEW

Project/Phase: Pine Valley Forevergreen / 1

FR	A	M	IN	G
	$\overline{}$			•

Invoice	Qty.	Description
2600 72,631 23Feb21	1	MASTER ENSUITE: SHOWER NICHE [SHAMPOO SHELF] - COMPLETE WITH MATCHING MARBLE JAMBS ON 4 SIDES, STANDARD TILE, APPROX. 12 X 18 INSTALLED VERTICALLY - SEE PLAN FOR LOCATION
2600	1	MASTER BEDROOM: MODEL OPTIONS 40.02 - MASTER BEDROOM - OPT. 10 FOOT TRAY CEILING
23Feb21 NoCat		
2600	1	REAR DOOR: UPGRADE TO 96" GARDEN DOOR ASSEMBLY
23Feb21 NoCat		
2600	1	BREAKFAST: MODEL OPTIONS 40.02 - BREAKFAST ROOM OPT. COFFERED CEILING - AS PER PLAN
23Feb21 NoCat		
2600	1	GREAT ROOM: MODEL OPTIONS 40.02 - GREAT ROOM - OPT. COFFERED CEILING - AS PER PLAN
23Feb21 NoCat		

GLASS AND MIRROR

GLASS .	GLASS AND WIRKOK			
Invoice	Qty.	Description		
2603	2	MASTER ENSUITE + SHARED ENSUITE: UPGRADE SHOWER DOOR HANDLE SQ6X6 - CHROME		
11Mar21 NoCat				

DisciplineMS.rpt 23feb21 Page 4 of 7



Lot: 40

Model: 40.02 B VALLEYVIEW

Project/Phase: Pine Valley Forevergreen / 1

GRANITE MARBLE QUARTZ

Invoice	Qty.	Description
2603	1	POWDER ROOM: UPGRADE 3 QUARTZ COUNTER
11Mar21 NoCat		
2603	1	KITCHEN: UPGRADE 6 QUARTZ COUNTER TOP
11Mar21 NoCat		
2603	1	KITCHEN: ADD WATERFALL LEG TO ONE SIDE OF ISLAND - LEVEL 6 QUARTZ
11Mar21 NoCat		SEE PLAN FOR LOCATION
2603	1	MASTER ENSUITE: UPGRADE 3 QUARTZ COUNTER TOP
11Mar21 NoCat		
2603	1	ENSUITE 2: UPGRADE 3 QUARTZ COUNTER TOP
11Mar21 NoCat		
2603	1	SHARED ENSUITE: UPGRADE 3 QUARTZ COUNTER
11Mar21 NoCat		

HARDWOOD

Invoice Qty		Description
2603 4 11Mar21	1	KITCHEN: VINTAGE SERIES, 5" WHITE OAK, NSS ENGINEERED HARDWOOD, 3/4" THK, WIREBRUSH TEXTURE, UV OIL FINISH - LEVEL 3
2603 4 11Mar21	1	FOYER: VINTAGE SERIES, 5" WHITE OAK, NSS ENGINEERED HARDWOOD, 3/4" THK, WIREBRUSH TEXTURE, UV OIL FINISH - LEVEL 3
2603 4 11Mar21	1	THRU OUT STANDARD AREAS - MAIN HALL/ GREAT ROOM/BREAKFAST/ DINING ROOM/ UPPER HALL/ MASTER BEDROOM/ BEDROOM 2/ BEDROOM 3/ BEDROOM 4: VINTAGE SERIES, 5" WHITE OAK, NSS ENGINEERED HARDWOOD, 3/4" THK, WIREBRUSH TEXTURE, UV OIL FINISH - LEVEL 3

HVAC

HVAC		
Invoice	Qty.	Description
2600	1	KITCHEN: GAS LINE ROUGH-IN - MAIN FLOOR FOR GAS RANGE
72,224		
23Feb21		

INTERIOR TRIM AND DOORS

Invoice	Qty.	Description
2603	1	THRU OUT: HALIFAX LEVER, IRON BLACK INTERIOR DOOR HARDWARE
153,783		
11Mar21		leave standard hinges

DisciplineMS.rpt 23feb21 Page 5 of 7



Lot: 40

Model: 40.02 B VALLEYVIEW

Project/Phase: Pine Valley Forevergreen / 1

KITCHEN AND BATH CABINETRY

Invoice	Qty.	Description
2600	1	THRU OUT: SEE ATTACHED CABINETRY SCHEDULE
23Feb21 NoCat		
2603	1	THRU OUT: SEE ATTACHED CABINETRY SCHEDULE
11Mar21 NoCat		
2603	1	FYI - KITCHEN: ADD WATERFALL LEG TO ONE SIDE OF ISLAND - LEVEL 6 QUARTZ
11Mar21 NoCat		

MASONRY

Invoice	Qty.	Description			
2600	1	REAR DOOR: UPGRADE TO 96" GARDEN DOOR ASSEMBLY			
23Feb21 NoCat					

NETWORK AND WIRING

Invoice		Description
2600 72,259 23Feb21	1	GREAT ROOM: CONDUIT PIPE - FOR WALL MOUNT TV - LOCATE APPROX 66" A.F.F. ABOVE FIREPLACE, THRU BASEMENT, TERMINATE AT CABLE - SEE PLAN FOR LOCATION
2600 72,258 23Feb21	1	GREAT ROOM: ADDITIONAL CAT6 ETHERNET OUTLET - EACH SEE PLAN FOR LOCATION
2600 72,258 23Feb21	1	BEDROOM 4: ADDITIONAL CAT6 ETHERNET OUTLET - EACH SEE PLAN FOR LOCATION
2600 72,260 23Feb21	1	CONDUIT PIPE - FROM ATTIC TO BASEMENT - FROM AT ELECTRICAL PANEL IN BASEMENT TO APPROX CENTER OF ATTIC

DisciplineMS.rpt 23feb21 Page 6 of 7



Lot: 40

Model: 40.02 B VALLEYVIEW

Project/Phase: Pine Valley Forevergreen / 1

P	A	T	N	Γ

Invoice	Qty.	Description
2600	1	MASTER BEDROOM: MODEL OPTIONS 40.02 - MASTER BEDROOM - OPT. 10 FOOT TRAY CEILING
23Feb21 NoCat		
2600	1	BREAKFAST: MODEL OPTIONS 40.02 - BREAKFAST ROOM OPT. COFFERED CEILING - AS PER PLAN
23Feb21 NoCat		
2600	1	GREAT ROOM: MODEL OPTIONS 40.02 - GREAT ROOM - OPT. COFFERED CEILING - AS PER PLAN
23Feb21 NoCat		
2603	2	MAIN STAIRS: BASEMENT TO 2ND FLOOR - STAIN STAIRS AND LANDINGS
11Mar21 NoCat		STAIRS AND LANDINGS WILL NOT MATCH HARDWOOD FLOORS IN COLOUR/TEXTURE/SPECIES
2603	1	FYI - MAIN STAIRS - 2ND FLOOR TO BASEMENT: UPGRADE - EURONLINE (ALL PLAIN) PICKET, 3" HALF-ROUND W/V-GROOVE HANDRAIL, 3 1/2" ALL SQUARE POST WITH PYRAMID TOP POST CAP - PACKAGE A-2
11Mar21 NoCat		

PLUMBING

Invoice	Qty.	Description
2600 72,332 23Feb21	1	KITCHEN: ROUGH-IN 1/4" COLD WATER LINE TO FRIDGE
2600	1	MASTER ENSUITE: MOEN '90*' RAIN SHOWER (from ceiling) + HAND SHOWER/SLIDE BAR - CHROME
23Feb21 NoCat		
2600	1	KITCHEN: MOEN 'MODERN' POTFILLER
23Feb21 NoCat		INCLUDES ROUGH IN

STAIR AND RAILINGS

Invoice	Qty.	Description
2603 93,780 11Mar21		MAIN STAIRS - 2ND FLOOR TO BASEMENT: UPGRADE - EURONLINE (ALL PLAIN) PICKET, 3" HALF-ROUND W/V-GROOVE HANDRAIL, 3 1/2" ALL SQUARE POST WITH PYRAMID TOP POST CAP - PACKAGE A-2

WINDOWS AND DOORS

Invoice	Qty.	Description
2600	1	REAR DOOR: UPGRADE TO 96" GARDEN DOOR ASSEMBLY
23Feb21		
NoCat		

DisciplineMS.rpt 23feb21 Page 7 of 7



PV-40 Cabinetry Schedule

ROOM	DESCRIPTION	PRICE	QTY	TOTAL
KITCHEN	UPGRADE PERIMETER + ISLAND FROM SERIES 2 TO SERIES 5 - MEDIO 6 OYSTER			
	STANDARD HARDWARE: K002-05 (N/C)		1	
	RETURN TRIP FOR HARDWOOD		1	
	CONVERT STD. BASE CABINETS INTO BASE POTS AND PANS DRAWERS		1	
	BUILT IN MICROWAVE CABINET WITH DRAWER BELOW		1	
	ADD ONE-DOOR TALL DEEP PANTRY		1	
	ADD PROUD CAMDEN FURNITURE KICK TO ONE SIDE OF ISLAND W/ RECESSED OVERSIZED PANEL END		1	
	ADD DECORATIVE HOOD FAN CABINET - ASPEN		1	
	LEAVE 3" GAP ON EITHER SIDE OF HOOD FAN (N/C)		1	
	ADD LIGHT VALANCE (PURCHASED ON PE #2600)		1	
MASTER ENSUITE	UPGRADE FROM SERIES 2 TO SERIES 5 - MEDIO 6 OYSTER			
THE CHOOSE	STANDARD HARDWARE: K002-05 (N/C)		1	
ENSUITE 2	LIDCDANG FROM SERVICE OF A SERVICE A MARKANA A A A			
ENSUITE 2	UPGRADE FROM SERIES 2 TO SERIES 5 - MEDIO 6 FOG STANDARD HARDWARE: H011-03 (N/C)		1	
	STANDARD RARDWARE: HULL-US (N/C)		1	
		CABINETRY	TOTAL:	

HANDLE PLACEMENT: AT INSTALLERS DISCRETION

LOT#: PV-40	DATE: March 5, 2021	
SIGNATURE: A-P		
SIGNATURE:		

GOLDPARK .

INTERIOR COLOUR SCHEME

WORTH MORE *** NOTE: This is not an approved document. Document must be locked ***

Scheduled Closing Date:

Purchasers:

Matthew Gabriel Papas & Andreea Cristina Papa Property: 40 of Plan -

Telephone Res. / Bus:	/	Project:	Pine Valley Forevergreen - Phase 1
Decor Advisor:	Yolande Somerville	Model and Elevation:	40.02 B VALLEYVIEW

elephone Res. / Bus: / ecor Advisor: Yolan	de Somerville Mode	Project: Pine Valley Forevergre and Elevation: 40.02 B VALLEYVIEW		
yout Changes: O Yes	No Sketch Attached: Ye	s No Exterior Colour Scheme:		
. Cabinetry	Style and Colour (Counter	Hardware	
Kitchen / Breakfast		Quartz: Calacatta Gold	attched	
Laundry Room		P-Lam: Standard White	attched	
Powder Room		Quartz: Pure White	attched	
]	addite. I dro Willo	attorieu	
Master Ensuite Bathroom	*Medio 6 'Oyster'	Quartz: Pure White	attched	
			attoriou	
Second Ensuite Bathroom (If Applicable)	*Medio 6 'Fog'	Quartz: Pure White	attched	
Shared Ensuite	Bowery 'Avenza'	Quartz: Pure White	attched	
Comment				
Main Hall Kitchen / Breakfast Laundry Room Powder Room Master Ensuite Bathroom	hardwood 13x13" New Byzantine 'Pentellic Grey' *12x24" Marmorea matte 'Bianco Calacatta' *24x24" Carrara X polished 'White'			
Second Ensuite Bathroom (If Applicable) Lower Landing	*12x24" Reve 'Neige'			
(If Applicable)	13x13" New Byzantine 'Pentellic G	rey' (basement)		
Shared Ensuite	13x13" New Byzantine 'Pentellic G	rey'		
Comment				
Thru out: shower floors - std 2x2" w	vhite			
Wall Tile	Selection	Listello/Inserts Describe		
		○ Yes ● No		
Waster Ensuite Bathroom	• 1			
Tub De		Yes No		
	tall *24x24" Carrara X polished 'Wh			
Bathroom Wa Second Ensuite	8x10" Uniwall 'Tender Grey'	Yes No		
Bathroom (If Applicable)				
Shared Ensuite	8x10" Uniwall 'White'	Yes No		
Kitchen Backsplash Comment		Backsplash Behind Fridge		

GOLDPAR INTERIOR COLOUR SCHEME *** NOTE: This is not an approved document. Document must be locked *** Scheduled Closing Date: Purchasers: Matthew Gabriel Papas & Andreea Cristina Papa Property: 40 of Plan -Telephone Res. / Bus: / Project: Pine Valley Forevergreen - Phase 1 Decor Advisor: Yolande Somerville Model and Elevation: 40.02 B VALLEYVIEW 4. Plumbing Fixtures Second Ensuite Powder Room Master Ensuite Bathroom Other Room - Specify Other Washroom Comment See extras 5. Hardwood Flooring Type and Stain Type and Stain Main Hall **Upper Landing** Kitchen / Breakfast *3/4x5" wht oak wirebrush 'Atlantis' **Upper Hall** Living Room Master Bedroom **Dining Room** Bedroom #2 **Family Room** Bedroom #3 Den/Library Bedroom #4 Entrance Vestibule *3/4x5" wht oak wirebrush 'Atlantis' Bedroom #5 Other Room - Specify *3/4x5" wht oak wirebrush 'Atlantis' Lower Landing (If Applicable) Comment 6. Carpeting Description Upgrade **Ground Floor** Second Floor Type Area **Upgrade Underpad** Capped Runner - *Upgrade Carpet on Stairs Comment

	Living Room			Family Room			Other Room -	Specify	
	Purchased	As Per Plan	N/A	Purchased	As Per Plan	N/A	Purchased	As Per Plan	N/A
	\bigcirc	\bigcirc				\bigcirc	\circ	\bigcirc	
ireplace Type				Standard Ga	as				
Mantle Type				Mediterrane	an				
Colour / Stain				Arctic White					
Surround				n/a					
Hearth				none					
Comment									
12	-		<u> </u>						
								AP	


GOLDPARK INTERIOR COLOUR SCHEME WORTH MORE: *** NOTE: This is not an approved document. Document must be locked *** Scheduled Closing Date: Purchasers: Matthew Gabriel Papas & Andreea Cristina Papa Property: 40 of Plan -Telephone Res. / Bus: / Project: Pine Valley Forevergreen - Phase 1 Decor Advisor: Model and Elevation: 40.02 B VALLEYVIEW Yolande Somerville 8. Trim Carpentry Interior Doors Std Carrara Front Door Glass Inserts Standard Door Handles *Halifax blk/std hng **Interior Trim** Standard Package Comment 9. Plaster Mouldings and Medallions Standard Throughout Yes ○ No N/A **Entrance Vestibule** Kitchen/Breakfast Main Hall Den/Library Living Room **Lower Landing Dining Room** Other Room - Specify **Family Room** Comment 10. Railings and Spindles Railing Package *A-2 Railing Colour *Mirage Charcoal Spindle Colour *Black Stringer / Riser *Mirage Charcoal **Treads** *Mirage Charcoal Oak Stairs Yes O No O N/A Comment

Trim Paint White

Smooth Ceilings
Ground Floor
Second Floor
Note

Comment

GOLDPARK *** NOTE	INTERIOR COLOUR SCHEME E: This is not an approved document. Document must be locked *** Scheduled Closing Date:
Purchasers: Matthew Gabriel	Papas & Andreea Cristina Papa Property: 40 of Plan -
Telephone Res. / Bus: /	Project: Pine Valley Forevergreen - Phase 1
Decor Advisor: Yolande Somerv	ille Model and Elevation: 40.02 B VALLEYVIEW
12. Electrical	
Hood Fan White Stainle	Above Kitchen Cabinet Light Yes No
	Below Kitchen Cabinet Light Yes No
Standard Appliances	
Over The Range Microwave	
Chimney Style Fan	
Chiliney Style Fall	
Comment	
	•
13. Heating and Air Conditioning	
A'- O - I''	
C . D D	Gas Provisions Stove yes Gas Provisions Barbecue std
Comment	Gas Provisions Barbecue std
Comment	
,	
14. Additional Comments	
15. Disclaimers and Notes	
	ble to builder's selection, but not necessarily identical due to variances in manufacturing.
	ess accompanied by a separate invoice/amendment. Said invoice must be paid in full.
	for Colour Selection form is signed and dated, no further changes will be permitted other
than re-selection due to unavailability.	Purchaser's Initials ccepting the "Gold Park Homes Decor Centre Disclaimers" form. This document contains
other miscellaneous disclaimers. This Interior Colour Selection is final and app	
Signature:	Date:

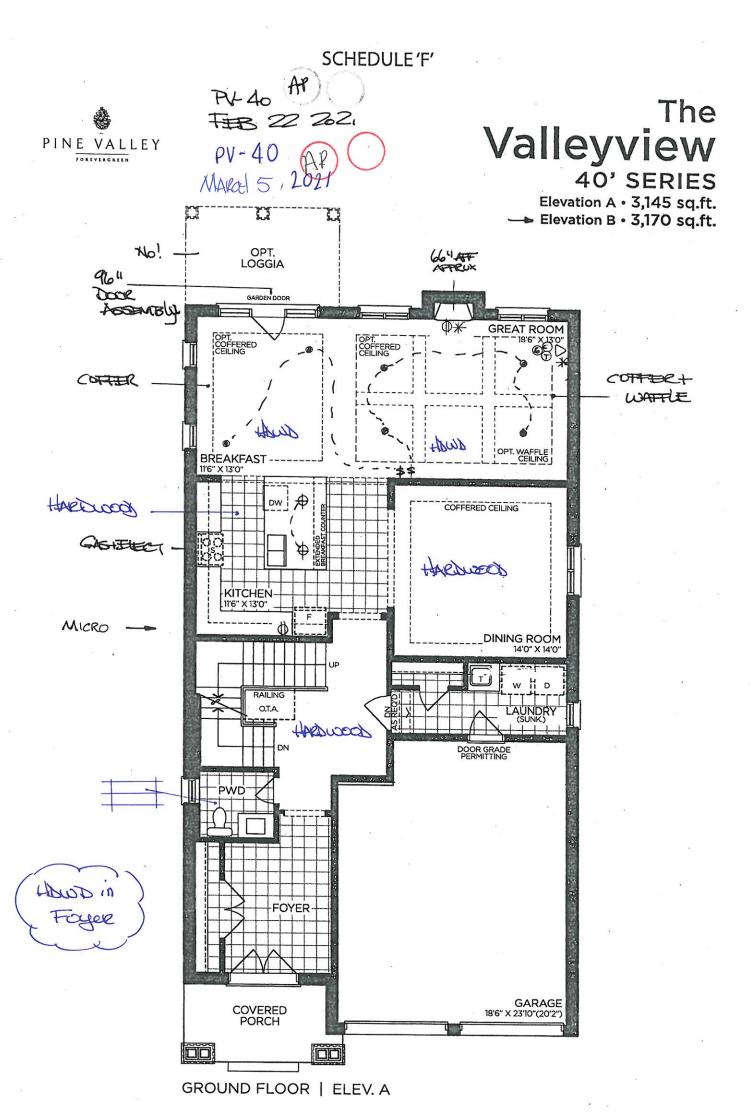

VENDOR PURCHASER PURCHASER


GOLDPARK

WORTH MORE

Prices, figures, illustrations, sizes, features and finishes are subject to change without notice. Areas and dimensions are approximate and actual usable floor space may vary from the stated area. Layout may be reverse of the unit purchased. E. & O.E. 4002

SCHEDULE'F'




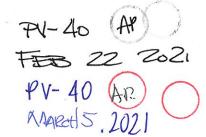


The Valleyview

40' SERIES

Elevation A • 3,145 sq.ft. Elevation B • 3,170 sq.ft.

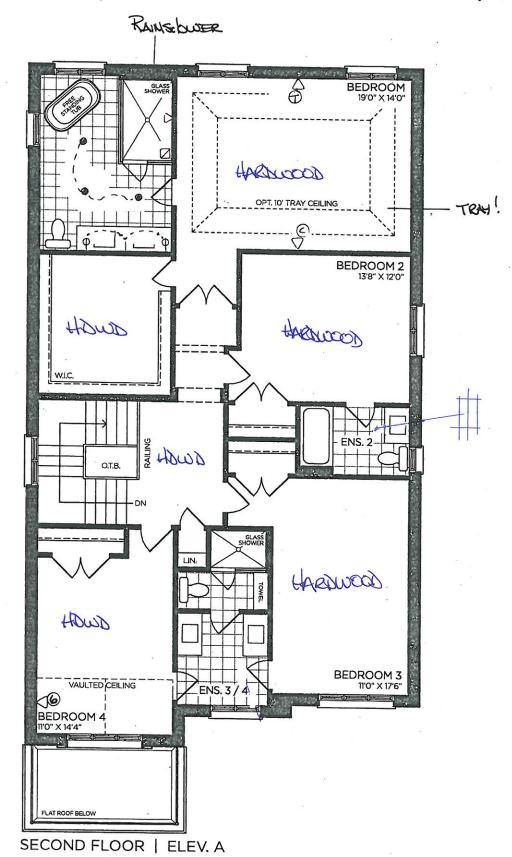

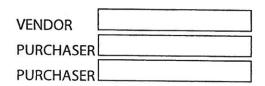

GOLDPARK

Prices, figures, illustrations, sizes, features and finishes are subject to change without notice. Areas and dimensions are approximate and actual usable floor space may vary from the stated area. Layout may be reverse of the unit purchased. E. & O.E. 4002

SCHEDULE'F'





PV-40 (AP) FEB 22 2021 PV-40 (AP) MARCH 5, 2021

The Valleyview

40' SERIES

Elevation A • 3,145 sq.ft. ←Elevation B • 3,170 sq.ft.

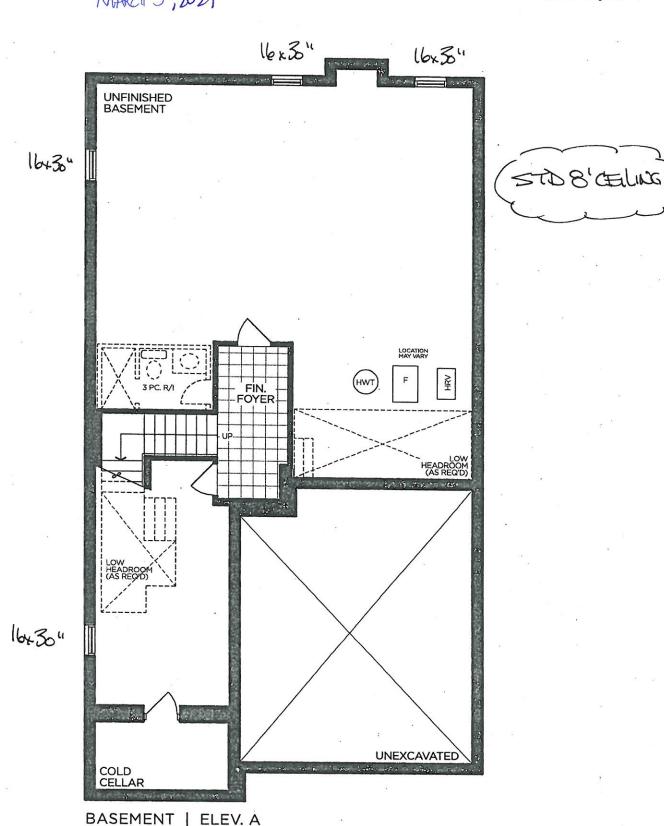

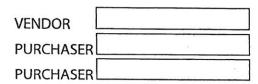


GOLDPARK

Prices, figures, illustrations, sizes, features and finishes are subject to change without notice. Areas and dimensions are approximate and actual usable floor space may vary from the stated area. Layout may be reverse of the unit purchased. E. & O.E. 4002

SCHEDULE'F'




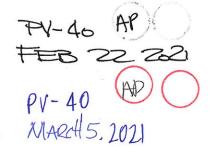


The Valleyview

40' SERIES


Elevation A • 3,145 sq.ft.
Elevation B • 3,170 sq.ft.

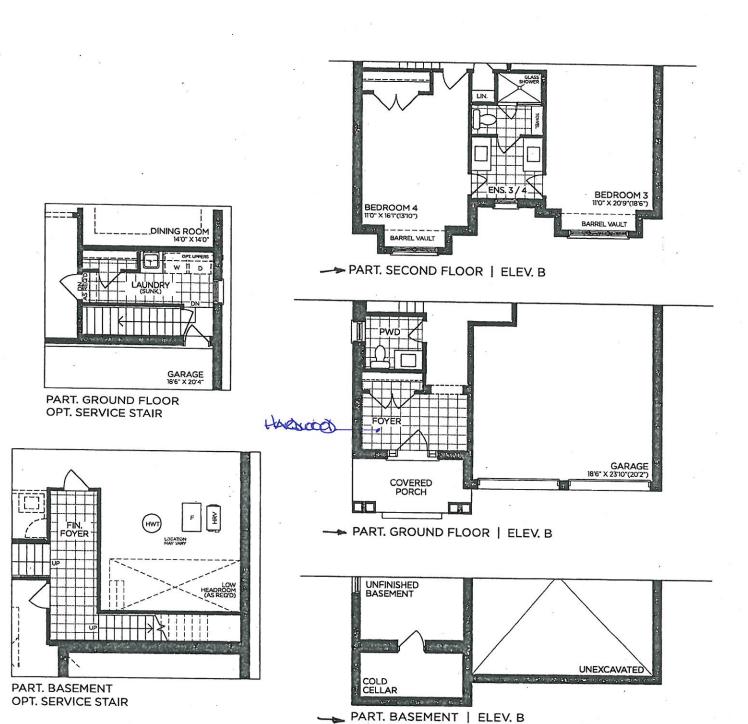

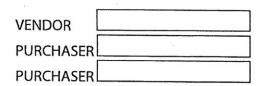

GOLDPARK


Prices, figures, illustrations, sizes, features and finishes are subject to change without notice. Areas and dimensions are approximate and actual usable floor space may vary from the stated area. L'ayout may be reverse of the unit purchased. E. & O.E. 4002

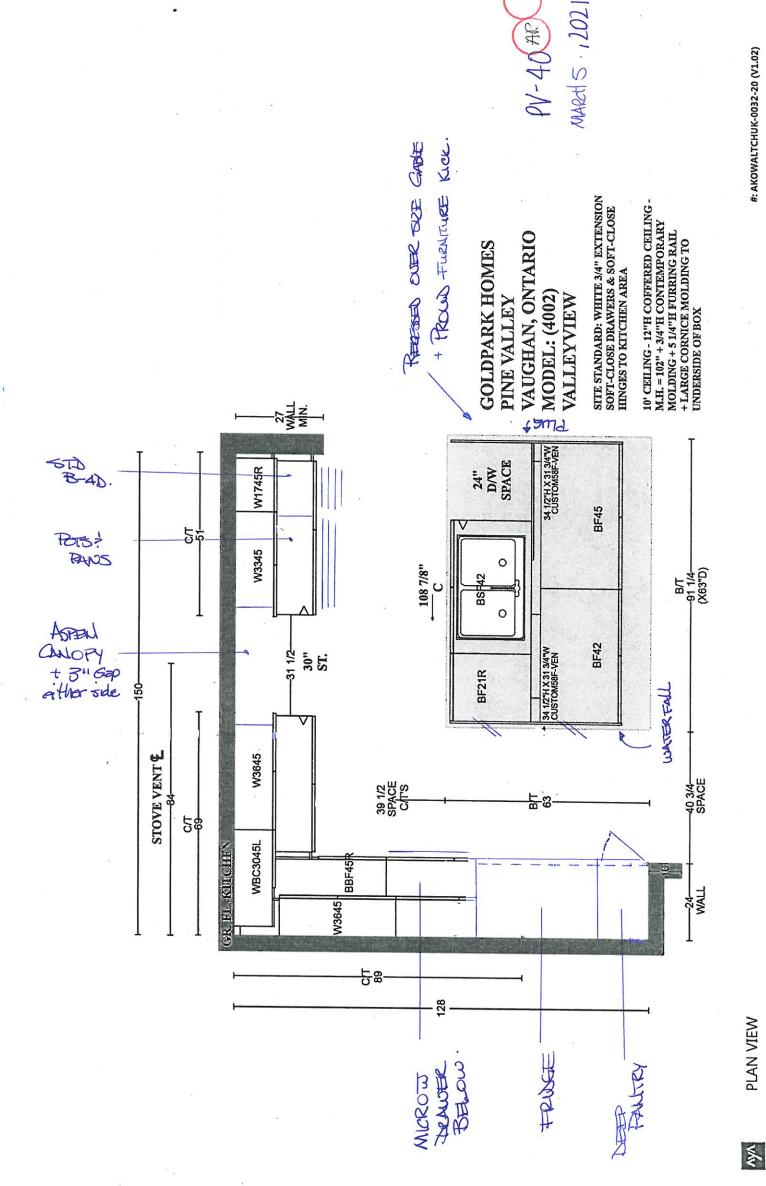

MODEL: (4002) VALLEYVIEW VAUGHAN, ONTARIO GOLDPARK HOMES PINE VALLEY

SITE STANDARD: WHITE 3/4" EXTENSION SOFT-CLOSE DRAWERS & STANDARD SLAM DOOR HINGES TO VANITIES


ONE TOP DRAWER WHERE POSSIBLE THROUGHOUT EACH VANITY, ONE BANK OF DRAWERS WHERE POSSIBLE THROUGHOUT EACH MASTER ENSUITE VANITY

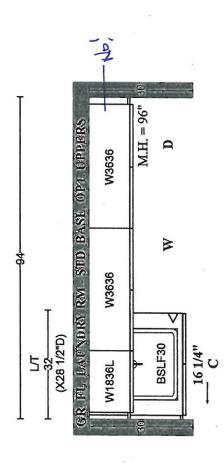


OR ILL PUNNDER RAY


VSF36


19 1/4"

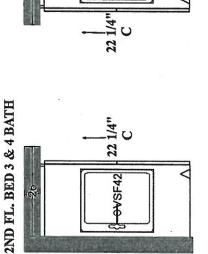

VSF420

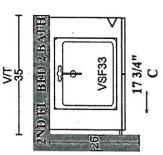

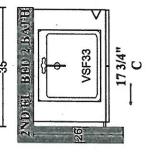

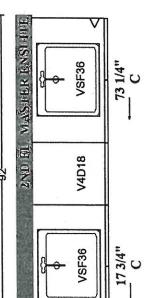


*



ASPEN RANGE HOOD

(Insert fan not included)

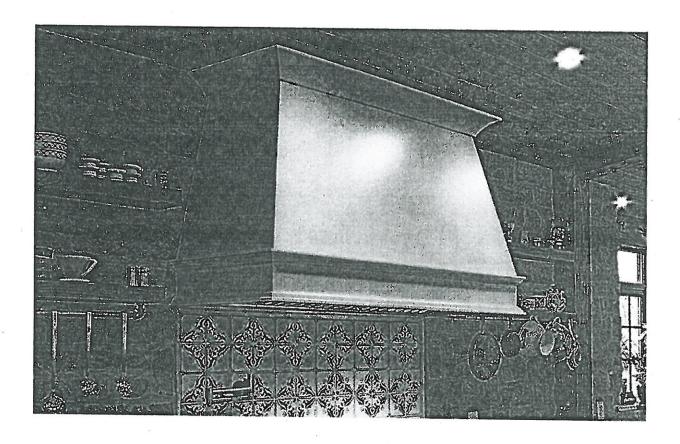

LOT# PV -40	DATE: , 2021	ROOM: Kitchen	
SIGNATURE:			
SIGNATURE:			




STONE COUNTERTOP EDGE PROFILES

	STANDARD 2CM EASED EDGE	LOCATION: THEU OUT
	UPGRADE 3CM EASED EDGE	LOCATION:
	UPGRADE 4CM MITRED EDGE	LOCATION:
	UPGRADE 2CM OGEE EDGE	LOCATION:
SIGNATURE:	DATE: MARAH 5	2021



				9			∌
	H001-02		H001-03			H001-04	r
ì.		e e		, 8			- -
		68					
	H009-03		H009-09	•			E 20
						,	. !
				· ·			
✓ E	H011-03		H011-05	÷ .	Н	011-06	
	H033-01		11020.00	5 g 5			
,			H039-03	2	*NO	HARDWARE	
							1 .
LOT# PV-	40 DATE:	Rat 5,2	021				
SIGNATURE:	(AP-)						
SIGNATURE:					: a		

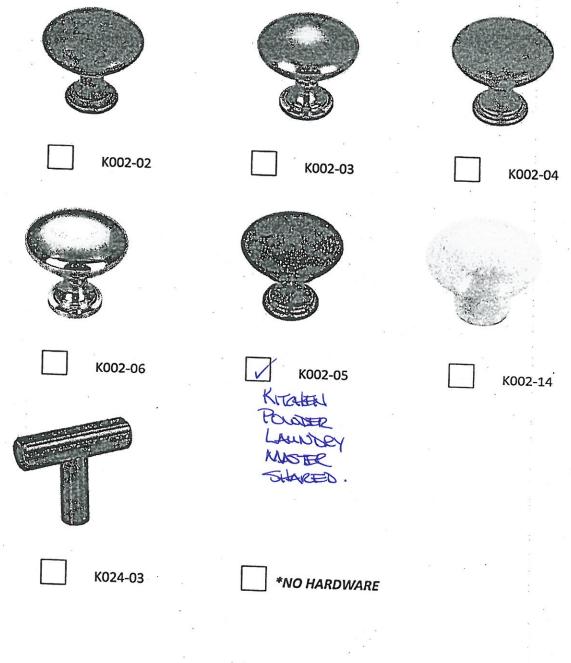


LOT# PV- 40	DATE: MARCH 5 12021		
SIGNATURE:			9
SIGNATURE:			



SQ6X6

Shower Door Handle

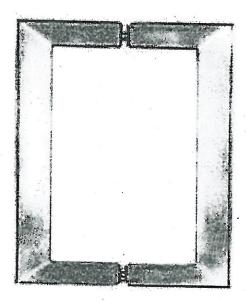

SQ6X6 Shower Door Handle

6" x 6" back-to-back 3/4" square tube (Also available single sided)


V	CHROME
П	MATTE BLACI


Lot#	Date: MARCH 5 2.21	Room: MASTER + STARRED.
Signature:		
Signature:		



Project: Pine Valley Lot: 40
Purchaser(s): Matthew Gabriel Papas & Andreea Cristina Papas
Standard Hood Fan Deletion
We acknowledge that the builder's standard hood fan will not be installed. Do not supply, install and/or credit. We will install our own hood fan after closing
Signature:
Signature:
Date: MARCH 5, 2021



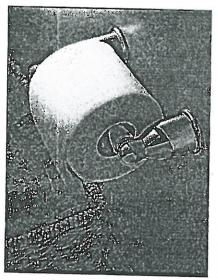

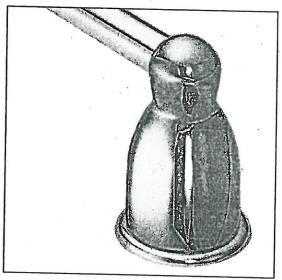

Tissue Holder Mason - Chrome

Towel Bar Mason - Chrome

Please select one of the following:

INSTALL STANDARD BATHROOM ACCESSORIES THRU OUT (tissue holder + towel bar) *location as per vendors discretion*
DO NOT INSTALL STANDARD BATHROOM ACCESSORIES THRU OUT *tissue holder + towel bar will not be provided*

LOT # PV - 40	DATE: MARCH 5, 2021
SIGNATURE:	AP.
SIGNATURE:	