

BASEMENT WINDOWS

Invoice	Qty.	Description
2657 72,351 25Mar21	2	BASEMENT WINDOWS - UPGRADE BASEMENT WINDOW SIZE TO 30 " X 24" - 8" FRAME
25Mar21 **		

DRYWALL

Invoice	Qty.	Description
2657 72,351 25Mar21 **	2	BASEMENT WINDOWS - UPGRADE BASEMENT WINDOW SIZE TO 30 " X 24" - 8" FRAME

ELECTRICAL

Invoice	Qty.	Description
2657 72,351 25Mar21 **	2	BASEMENT WINDOWS - UPGRADE BASEMENT WINDOW SIZE TO 30 " X 24" - 8" FRAME
2657 72,261 08Apr21	1	4.0 TON AC - WITH LOW VOLTAGE WIRING & WALL BRACKETS
25Mar21 NoCal		
2670 72,280 08Apr21	1	KITCHEN: INSTALL VAC PAN UNDER KITCHEN SINK
2670 72,273 08Apr21	1	KITCHEN: 110V WALL RECEPTACLE ON SEPARATE CIRCUIT - GAS FIRED APPLIANCE - FOR AUX. EQUIPMENT - NOT A STOVE PLUG - SEE PLAN
2670 72,307 08Apr21	1	KITCHEN: RELOCATE STANDARD CEILING MOUNT FIXTURE - APPROX. CENTERED ABOVE ISLAND - SEE PLAN
2670 72,280 08Apr21	1	KITCHEN: ADDITIONAL REINFORCED CEILING OUTLET - APPROX. CENTERED ABOVE KITCHEN ISLAND - SAME SWITCH AS STANDARD
2670 72,303 08Apr21	1	KITCHEN: UNDER CABINET FLUORESCENT LIGHT FIXTURES - BUNDLE INCLUDING LIGHT VALANCE
2670 72,289 08Apr21	6	GREAT ROOM: 4" E/S LED INTERIOR POT LIGHT - GROUND FLOOR - INCLUDES ONE SWITCH INCLUDED IN APS
2670 72,281 08Apr21	1	GREAT ROOM: INTERIOR WALL OUTLET; ADDITIONAL 110V WALL INTERIOR RECEPTACLE ON EXISTING CIRCUIT FOR WALL MOUNTED TV - APPROX. 64" A.F.F.
2670 72,307 08Apr21	1	UPPER HALL: RELOCATE STANDARD CEILING MOUNT FIXTURE TO APPROX. CENTRE AT OTB - SEE PLAN

FORM - FORMING

Invoice	Qty.	Description
2657 72,351 25Mar21 **	2	BASEMENT WINDOWS - UPGRADE BASEMENT WINDOW SIZE TO 30 " X 24" - 8" FRAME

FORMING

Invoice	Qty.	Description
2657 72,202 25Mar21	1	PINE VALLEY MODEL 40.06 LILAC ELEV A - 9 FOOT BASEMENT CEILING HEIGHT IN LIEU OF STANDARD 8 FOOT CEILING. INCLUDED IN APS

HVAC

Invoice	Qty.	Description
2657 72,241 25Mar21	1	4.0 TON AC - WITH LOW VOLTAGE WIRING & WALL BRACKETS INCLUDED IN APS

2670 72,224 08Apr21	1	KITCHEN: GAS LINE ROUGH-IN - MAIN FLOOR FOR APPLIANCE - SEE PLAN
---------------------------	---	--

2670 08Apr21 NoCat	1	KITCHEN: INSTALL VAC PAN UNDER KITCHEN SINK
--------------------------	---	---

INTERIOR TRIM /MOULDINGS

Invoice	Qty.	Description
2657 72,351 25Mar21 **	2	BASEMENT WINDOWS - UPGRADE BASEMENT WINDOW SIZE TO 30 " X 24" - 8" FRAME

KITCHEN AND BATH CABINETRY

Invoice	Qty.	Description
2670 08Apr21 NoCat	1	FYI - KITCHEN: GAS LINE ROUGH-IN - MAIN FLOOR FOR APPLIANCE - SEE PLAN
2670 08Apr21 NoCat	1	KITCHEN: UNDER CABINET FLUORESCENT LIGHT FIXTURES - BUNDLE INCLUDING LIGHT VALANCE
2670 08Apr21 NoCat	1	KITCHEN: INSTALL VAC PAN UNDER KITCHEN SINK TOE KICK CUT OUT REQUIRED

NETWORK AND WIRING

Invoice	Qty.	Description
2670 72,259 08Apr21	1	GREAT ROOM: CONDUIT PIPE - FOR WALL MOUNT TV - APPROX 64" A.F.F., ABOVE FIREPLACE, THRU BASEMENT, TERMINATE AT CABLE LOCATION

PAINTING

Invoice	Qty.	Description
2657 72,351 25Mar21 **	2	BASEMENT WINDOWS - UPGRADE BASEMENT WINDOW SIZE TO 30 " X 24" - 8" FRAME

PANL - FRAMING

Invoice	Qty.	Description
2657 72,351 25Mar21 **	2	BASEMENT WINDOWS - UPGRADE BASEMENT WINDOW SIZE TO 30 " X 24" - 8" FRAME

PLUMBING

Invoice	Qty.	Description
2670 72,332 08Apr21	1	KITCHEN: ROUGH-IN 1/4" COLD WATER LINE TO FRIDGE

ROUGH CARPENTRY

Invoice	Qty.	Description
2657 72,351 25Mar21 **	2	BASEMENT WINDOWS - UPGRADE BASEMENT WINDOW SIZE TO 30 " X 24" - 8" FRAME

WINDOWS - BASEMENT

Invoice	Qty.	Description
2657 72,351 25Mar21 **	2	BASEMENT WINDOWS - UPGRADE BASEMENT WINDOW SIZE TO 30 " X 24" - 8" FRAME


attach

March 23, 2021

attache

April 6, 2021

- Elevation A • 3,425 sq.ft.
- Elevation B • 3,385 sq.ft.

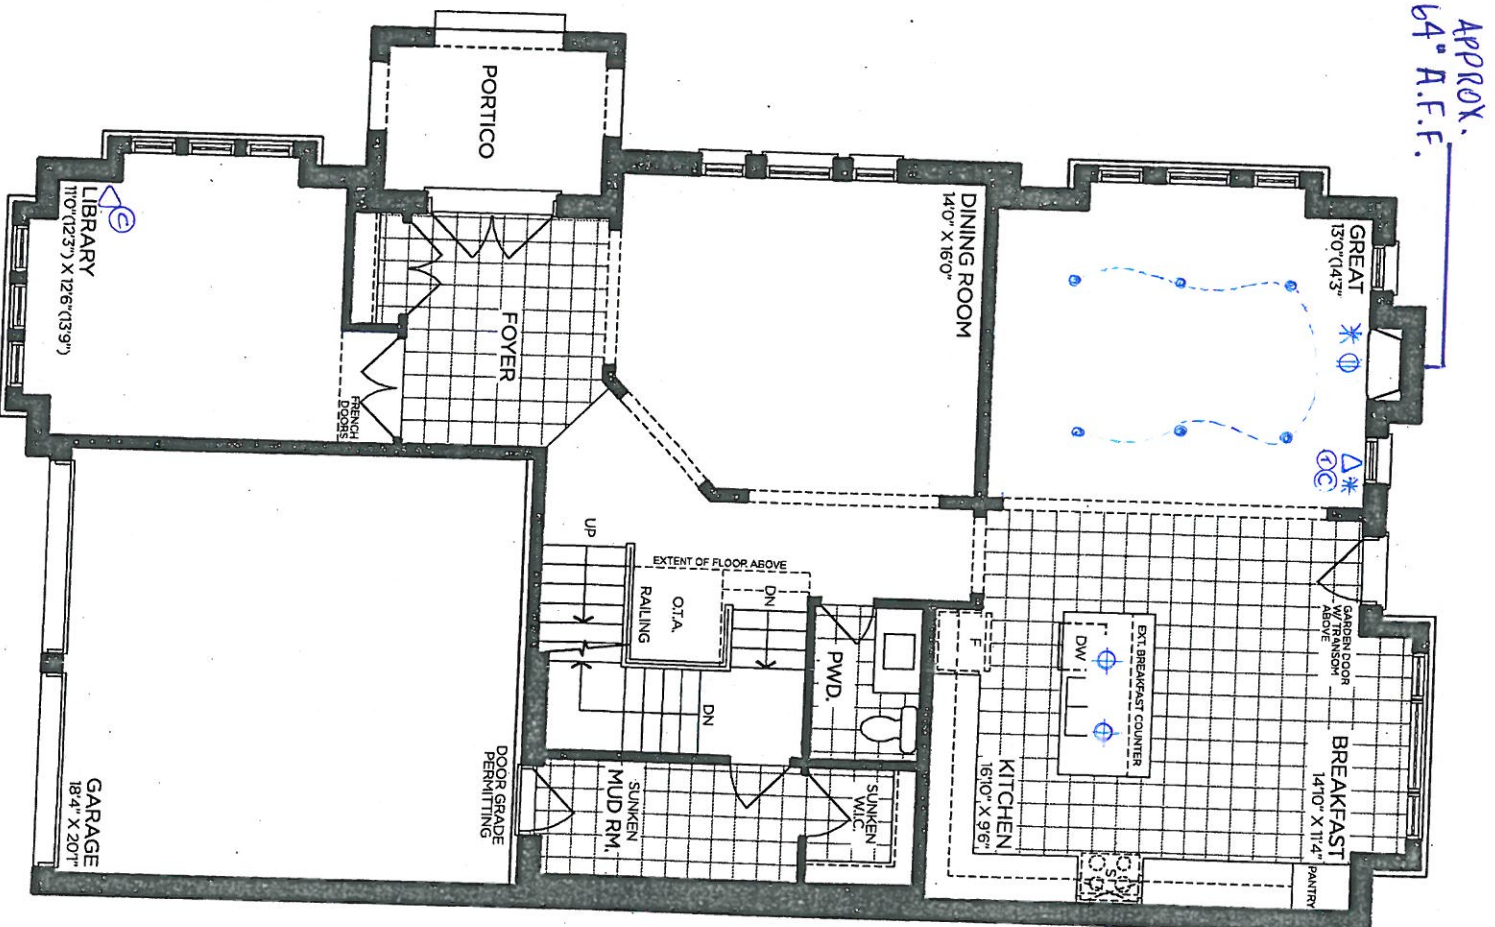


VENDOR	
PURCHASER	
PURCHASER	

GOLDPARK
WORTH MORE™

Prices, figures, illustrations, sizes, features and finishes are subject to change without notice. Areas and dimensions are approximate and actual usable floor space may vary from the stated area. Layout may be reverse of the unit purchased. E. & O.E. 4/006

SCHEDULE 'F'
PV-26 attach
March 23, 2021
PV-26 attached
April 6, 2021

The
Lilac
40' SERIES
→ Elevation A • 3,425 sq.ft.
Elevation B • 3,385 sq.ft.

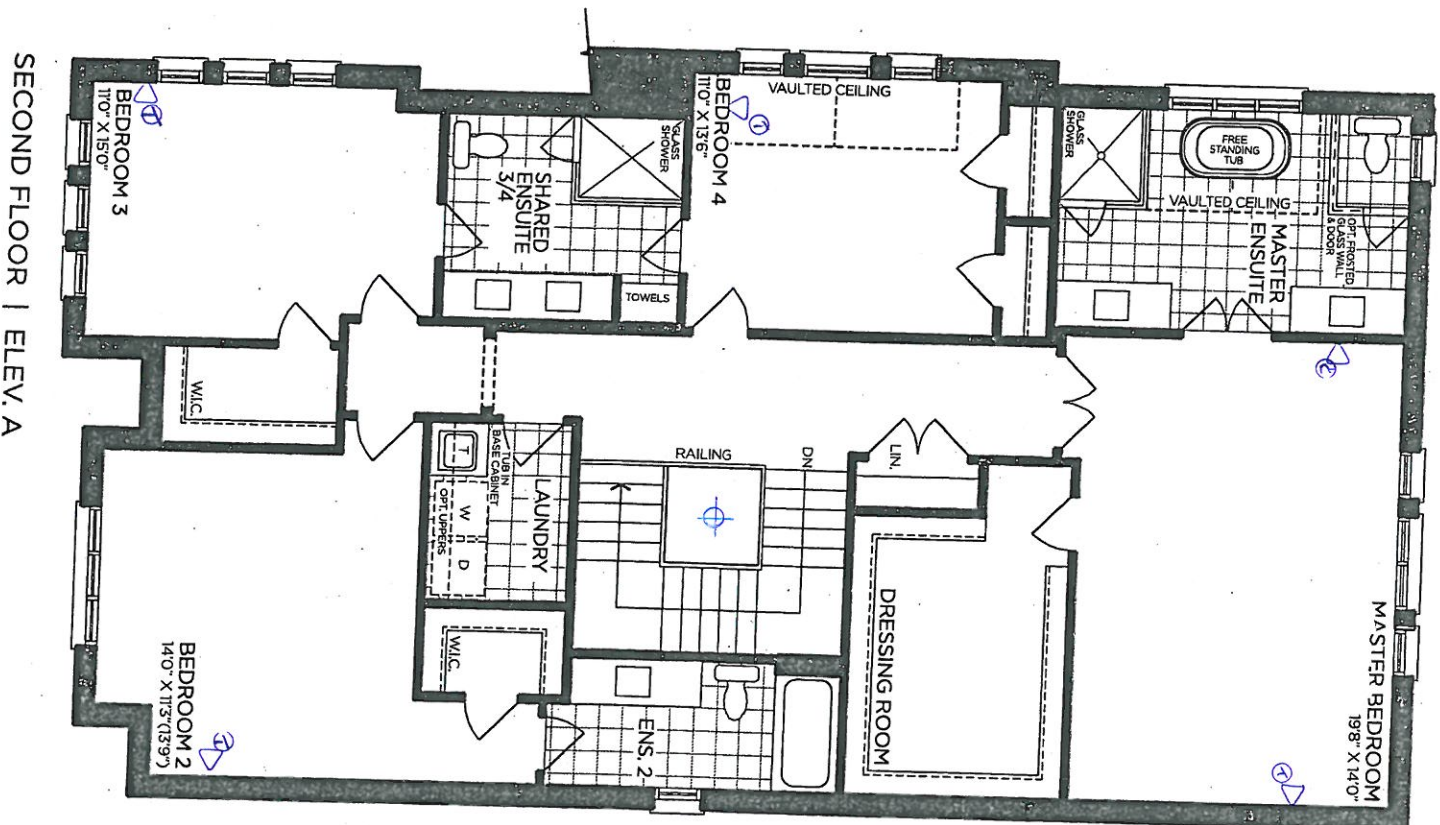

SECOND FLOOR | ELEV. A

VENDOR _____
PURCHASER _____
PURCHASER _____

GOLDPARK
WORTH MORE™

Prices, figures, illustrations, sizes, features and finishes are subject to change without notice. Areas and dimensions are approximate and actual usable floor space may vary from the stated area. Layout may be reverse of the unit purchased. E. & O.E. 4006

PINE VALLEY
FOREVERGREEN


9 FT
BASEMENT

SCHEDULE 'F'

PV-26 attach
March 23, 2021
PV-26 attach
April 6, 2021

24" x 30"

The Lilac
40' SERIES
→ Elevation A • 3,425 sq.ft.
Elevation B • 3,385 sq.ft.

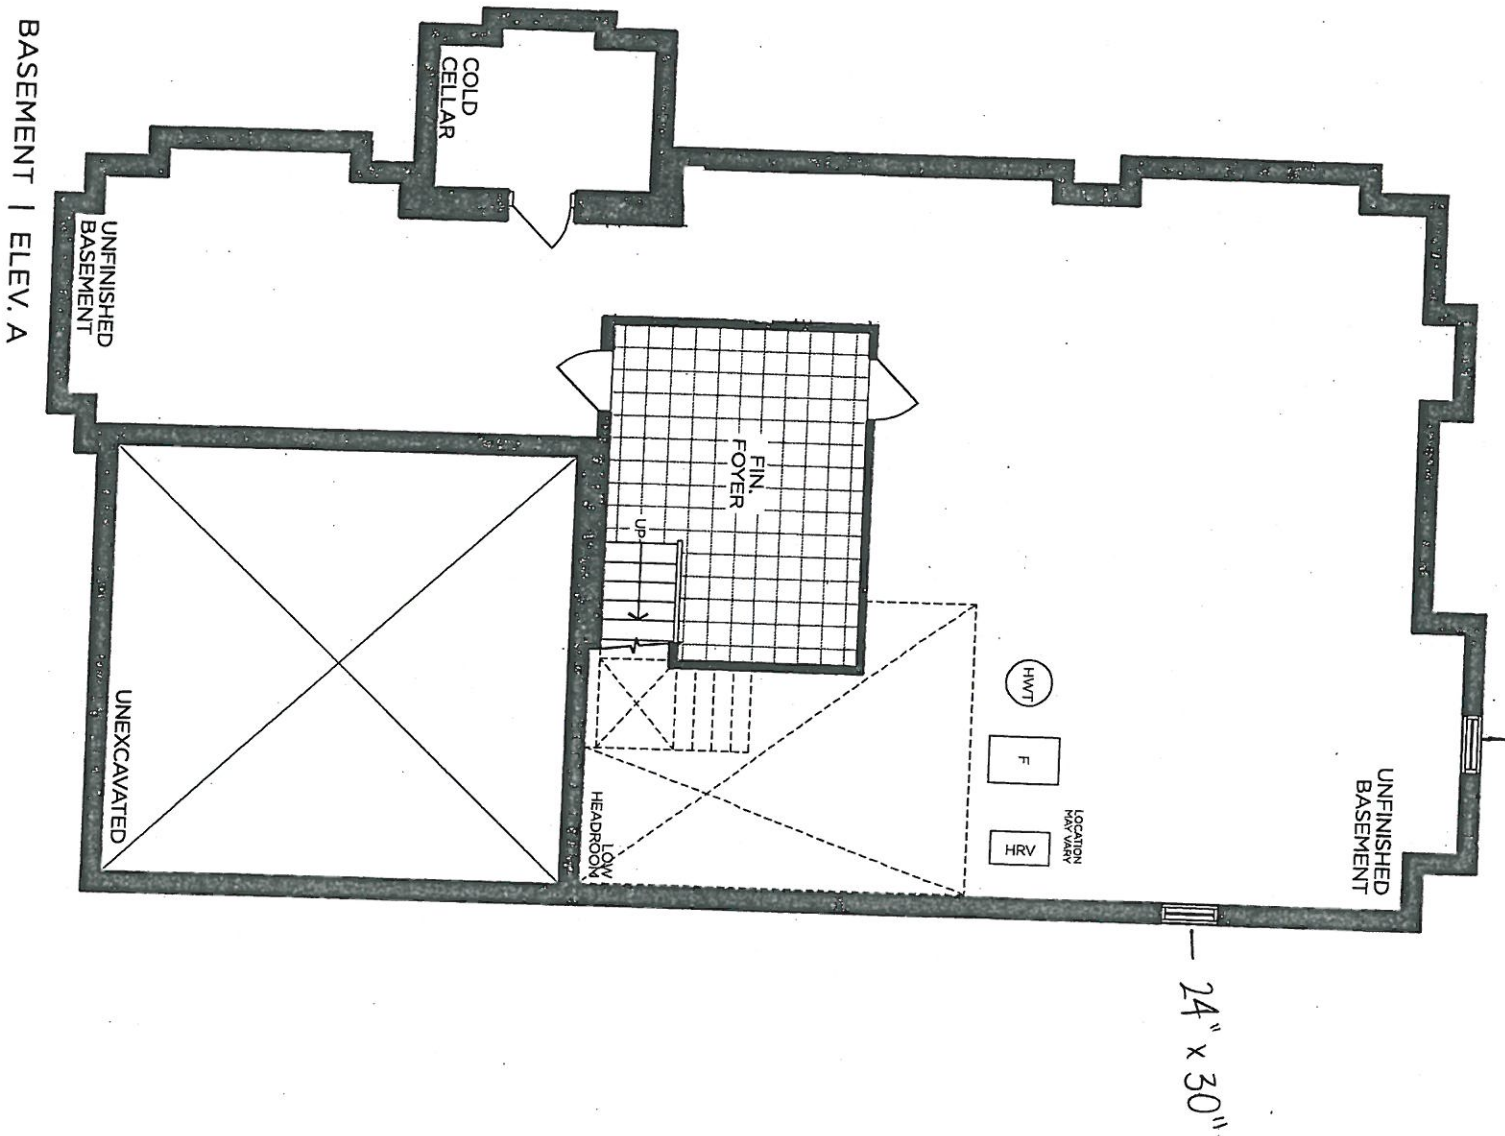

VENDOR

PURCHASER

PURCHASER


GOLDPARK
WORTH MORE™

Prices, figures, illustrations, sizes, features and finishes are subject to change without notice. Areas and dimensions are approximate and actual usable floor space may vary from the stated area. Layout may be reverse of the unit purchased. E. & O.E. 4006

PINE VALLEY
RESORTS

SCHEDULE P
PV-26 
March 13, 2011
N-26 42 48
April 6, 2011

The
Lilac
40' SERIES
Elevation A - 3,425 sq.ft.
Elevation B - 3,585 sq.ft.

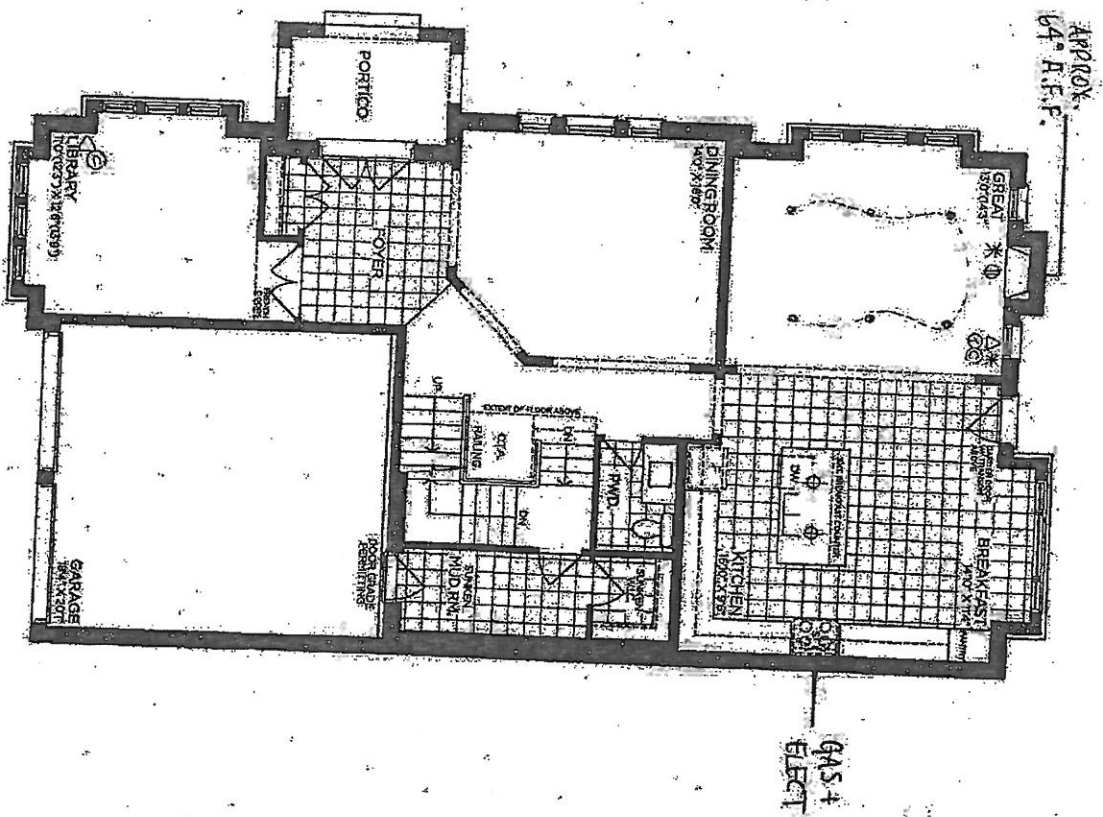

GROUND FLOOR | ELEV. A

VENDOR
PURCHASER
PURCHASER


GOLDPARK
WORTH MORE
Plans, layouts, illustrations, specs, features and finishes are subject to change without notice. Areas and dimensions are approximate and actual build-out space may vary from the stated area. Layout may be revised at the discretion of the architect.



PINE VALLEY

SCHEDULE F
PV-26 afford
March 23, 2021
PV-26 02 147
April 6, 2021

The
Lilac
40' SERIES
→ Elevation A • 3,425 sq.ft.
Elevation B • 3,385 sq.ft.

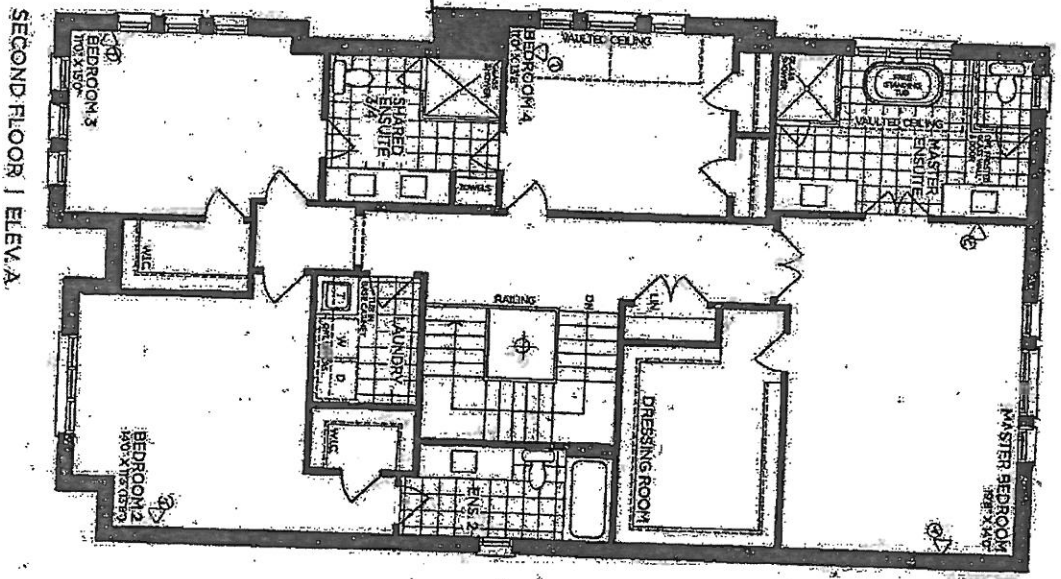

SECOND FLOOR | ELEV. A

VENDOR	
PURCHASER	
PURCHASER	

GOLDPARK
WORTH, MO
Prices, figures, illustrations, sites, setbacks and profiles are subject to change without notice. Areas and dimensions are approximate and actual usable floor space may vary from the stated area depending on the layout purchased. E. 8025 4005

PINE VALLEY

PAVING

9 FT
BASEMENT

SCHEDULE F

PV-26 OK'd

March 23, 2011


PV-26 HP HP

April 6, 2011

The
Lilac
40' SERIES
→ Elevation A = 3,425 sq.ft.
Elevation B = 3,385 sq.ft.

24" x 30"

24" x 30"

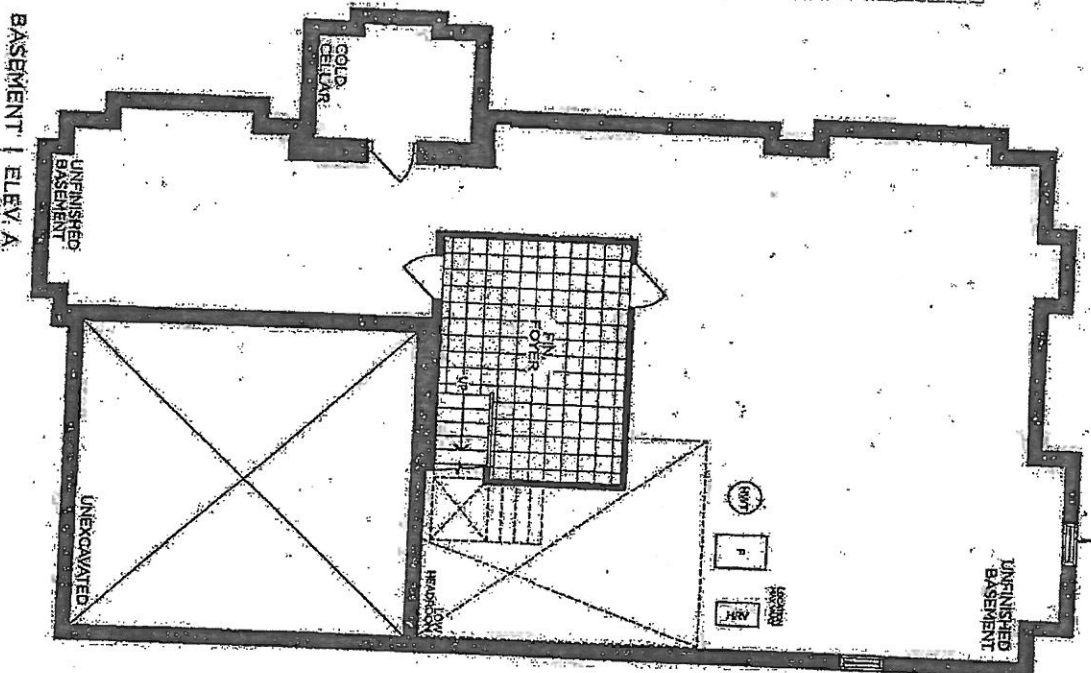

VENDOR
PURCHASER
PURCHASER

GOLDPARK

WORTHMORE

Notes: Figures, dimensions, areas, finishes and fixtures subject to change without notice. Area and dimensions are approximate and actual usable floor space may vary from the stated area. Layout may be revised at the time of purchase. E & O.E. 4/06.