



CONSTRUCTION SUMMARY

Lot: 81
Model: 50.05 C KNIGHTSWOOD
Project/Phase: Pine Valley Forevergreen / 1

BASEMENT WINDOWS

Invoice	Qty.	Description
2558 72,675 16Feb21	4	BASEMENT WINDOWS - UPGRADE BASEMENT WINDOW SIZE TO 30 " X 24" - 10" FRAME (PINEVALLEY 50 FOOT LOTS ONLY) SEE PLAN FOR LOCATION

CERAMIC

Invoice	Qty.	Description
2558 16Feb21 NoCat	2	MASTER ENSUITE: SHOWER NICHE [SHAMPOO SHELF] - COMPLETE WITH MATCHING MARBLE JAMBS ON 4 SIDES, STANDARD TILE, APPROX. 12 X 18 INSTALLED VERTICALLY - SEE PLAN FOR LOCATION
2558 16Feb21 NoCat	1	ENSUITE 3: SHOWER NICHE [SHAMPOO SHELF] - COMPLETE WITH MATCHING MARBLE JAMBS ON 4 SIDES, STANDARD TILE, APPROX. 12 X 18 INSTALLED VERTICALLY - SEE PLAN FOR LOCATION
2558 16Feb21 NoCat	1	ENSUITE 4: SHOWER NICHE [SHAMPOO SHELF] - COMPLETE WITH MATCHING MARBLE JAMBS ON 4 SIDES, STANDARD TILE, APPROX. 12 X 18 INSTALLED VERTICALLY - SEE PLAN FOR LOCATION

CONCRETE AND DRAIN

Invoice	Qty.	Description
2558 16Feb21 NoCat	1	BACK-FLOW PREVENTER VALVE

DRYWALL

Invoice	Qty.	Description
2558 16Feb21 NoCat	1	**CUSTOM LAYOUT** - LIBRARY - ADD 96" DOUBLE FRENCH DOORS AT LIBRARY - 3-LITE SHAKER WITH FLAT CLEAR GLASS
2558 16Feb21 NoCat	1	**CUSTOM LAYOUT** ADD INTERIOR DOOR MASTER BEDROOM TO MASTER ENSUITE - SEE PLAN FOR LOCATION BASED ON STANDARD FINISHES



CONSTRUCTION SUMMARY

Lot: 81
Model: 50.05 C KNIGHTSWOOD
Project/Phase: Pine Valley Forevergreen / 1

ELECTRICAL

Invoice	Qty.	Description
2558 72,281 16Feb21	1	GREAT ROOM: INTERIOR WALL OUTLET: ADDITIONAL 110V WALL INTERIOR RECEPTACLE ON EXISTING CIRCUIT FOR WALL MOUNTED TV - LOCATE ABOVE FIREPLACE, APPROX 66" A.F.F.
2558 72,280 16Feb21	1	POWDER ROOM (at dining) : CEILING OUTLET: ADDITIONAL REINFORCED CEILING OUTLET - USE SAME SWITCH AS STANDARD VANITY LIGHT
2558 72,280 16Feb21	1	POWDER ROOM (at cabana) : CEILING OUTLET: ADDITIONAL REINFORCED CEILING OUTLET - USE SAME SWITCH AS STANDARD VANITY LIGHT
2558 72,273 16Feb21	1	KITCHEN: 110V WALL RECEPTACLE ON SEPARATE CIRCUIT - GAS FIRED COOKTOP - FOR AUX. EQUIPMENT - NOT A STOVE PLUG
2558 72,282 16Feb21	1	KITCHEN: ADDITIONAL 220V RECEPTACLE ON A SEPARATE CIRCUIT - FOR BUILT-IN WALL OVEN - APPLIANCE NOT INCLUDED - DOES NOT INCLUDE BREAKER THAT IS TO BE INSTALLED BY LICENSED ELECTRICIAN AND ARRANGED BY HOMEOWNER AFTER CLOSING
2558 72,289 16Feb21	6	GREAT ROOM: 4" E/S LED INTERIOR POT LIGHT - GROUND FLOOR - EACH - 1 SWITCH INCLUDED INCLUDED IN APS

FRAMING

Invoice	Qty.	Description
2558 72,631 16Feb21	2	MASTER ENSUITE: SHOWER NICHE [SHAMPOO SHELF] - COMPLETE WITH MATCHING MARBLE JAMBS ON 4 SIDES, STANDARD TILE, APPROX. 12 X 18 INSTALLED VERTICALLY - SEE PLAN FOR LOCATION
2558 72,631 16Feb21	1	ENSUITE 3: SHOWER NICHE [SHAMPOO SHELF] - COMPLETE WITH MATCHING MARBLE JAMBS ON 4 SIDES, STANDARD TILE, APPROX. 12 X 18 INSTALLED VERTICALLY - SEE PLAN FOR LOCATION
2558 72,631 16Feb21	1	ENSUITE 4: SHOWER NICHE [SHAMPOO SHELF] - COMPLETE WITH MATCHING MARBLE JAMBS ON 4 SIDES, STANDARD TILE, APPROX. 12 X 18 INSTALLED VERTICALLY - SEE PLAN FOR LOCATION
2558 16Feb21 NoCat	1	**CUSTOM LAYOUT** - LIBRARY - ADD 96" DOUBLE FRENCH DOORS AT LIBRARY - 3-LITE SHAKER WITH FLAT CLEAR GLASS
2558 16Feb21 NoCat	1	**CUSTOM LAYOUT** ADD INTERIOR DOOR MASTER BEDROOM TO MASTER ENSUITE - SEE PLAN FOR LOCATION BASED ON STANDARD FINISHES



CONSTRUCTION SUMMARY

Lot: 81
Model: 50.05 C KNIGHTSWOOD
Project/Phase: Pine Valley Forevergreen / 1

GLASS AND MIRROR

Invoice	Qty.	Description
2690 08Apr21 NoCat	1	MASTER ENSUITE: UPGRADE SHOWER DOOR HANDLE - CHROME

HARDWOOD

Invoice	Qty.	Description
2690 7 08Apr21	1	THRU OUT ALL STANDARD AREAS: DINING ROOM, GREAT ROOM, MAIN HALL, LIBRARY, CABANA, MASTER BEDROOM, BEDROOM 2, BEDROOM 3, BEDROOM 4, UPPER HALL - VINTAGE SERIES, 5" WHITE OAK, NSS ENGINEERED HARDWOOD, 3/4" THK, SCULPTED TEXTURE, UVF FINISH - LEVEL 4

HVAC

Invoice	Qty.	Description
2558 72,224 16Feb21	1	KITCHEN: GAS LINE ROUGH-IN - MAIN FLOOR FOR GAS COOKTOP SEE PLAN FOR LOCATION

INTERIOR DOORS AND TRIM

Invoice	Qty.	Description
2558 72,561 16Feb21	1	**CUSTOM LAYOUT** - LIBRARY - ADD 96" DOUBLE FRENCH DOORS AT LIBRARY - 3-LITE SHAKER WITH FLAT CLEAR GLASS

INTERIOR TRIM AND DOORS

Invoice	Qty.	Description
2558 16Feb21 NoCat	1	**CUSTOM LAYOUT** ADD INTERIOR DOOR MASTER BEDROOM TO MASTER ENSUITE - SEE PLAN FOR LOCATION BASED ON STANDARD FINISHES

KITCHEN AND BATH CABINETRY

Invoice	Qty.	Description
2690 101,930 08Apr21	1	THRU OUT: SEE ATTACHED CABINETRY SCHEDULE

NETWORK AND WIRING

Invoice	Qty.	Description
2558 72,259 16Feb21	1	GREAT ROOM: CONDUIT PIPE - FOR WALL MOUNT TV - LOCATE ABOVE FIREPLACE, APPROX 66" A.F.F. THRU BASEMENT, TERMINATING AT CABLE LOCATION - SEE PLAN FOR LOCATION
2558 72,258 16Feb21	1	GREAT ROOM: ADDITIONAL CAT6 ETHERNET OUTLET - EACH - SEE PLAN FOR LOCATION
2558 72,258 16Feb21	1	BEDROOM 3: ADDITIONAL CAT6 ETHERNET OUTLET - EACH -SEE PLAN FOR LOCATION

PAINT

Invoice	Qty.	Description
2558 16Feb21 NoCat	1	**CUSTOM LAYOUT** - LIBRARY - ADD 96" DOUBLE FRENCH DOORS AT LIBRARY - 3-LITE SHAKER WITH FLAT CLEAR GLASS
2558 16Feb21 NoCat	1	**CUSTOM LAYOUT** ADD INTERIOR DOOR MASTER BEDROOM TO MASTER ENSUITE - SEE PLAN FOR LOCATION BASED ON STANDARD FINISHES
2690 100,369 08Apr21	2	MAIN STAIRS: 2ND FLOOR TO BASEMENT - STAIN STAIRS AND LANDINGS STAIRS AND LANDINGS WILL NOT MATCH HARDWOOD IN COLOUR/TEXTURE/SPECIES

PLUMBING

Invoice	Qty.	Description
2558 16Feb21 NoCat	1	**CUSTOM LAYOUT** POWDER ROOM (near dining) - RELOCATE TOILET TO BE OPPOSITE DOOR - SEE PLAN FOR LOCATION
2558 72,332 16Feb21	1	KITCHEN: ROUGH-IN 1/4" COLD WATER LINE TO FRIDGE
2558 72,346 16Feb21	1	KITCHEN: MOEN 'MODERN' KITCHEN POT FILLER - CHROME INCLUDES ROUGH-IN
2558 16Feb21 NoCat	1	MASTER ENSUITE: MOEN 'ALIGN' RAIN SHOWER HEADS x 2 (from ceiling) + HAND SHOWER/SLIDE BAR x1 - CHROME same as lot 93 model home master ensuite shower
2558 75,841 16Feb21	2	ENSUITE 3 + ENSUITE 4: 'MOEN 'ENGAGE' HANDSHOWER WITH MAGNETIC DOCKING - CHROME
2558 101,930 16Feb21	1	**CUSTOM LAYOUT** ENSUITE 2: RELOCATE TOILET + VANITY - SEE PLAN FOR LOCATION
2558 16Feb21 NoCat	1	BACK-FLOW PREVENTER VALVE

64

PV-81

April 7, 2021


Medio b 'Fog'

1039-03

**GOLDPARK HOMES
PINE VALLEY
VAUGHAN, ONTARIO
MODEL: (5005) KNIGHTSWOOD**

SITE STANDARD: WHITE 3/4" EXTENSION
SOFT-CLOSE DRAWERS & SOFT-CLOSE
HINGES TO KITCHEN AREA

10' CEILING - 12" H COFFERED CEILING -
M.H. = 102" + 3/4" H CONTEMPORARY
MOLDING + 5 1/4" H FURRING RAIL
+ LARGE CORNICE MOLDING TO
UNDERSIDE OF BOX

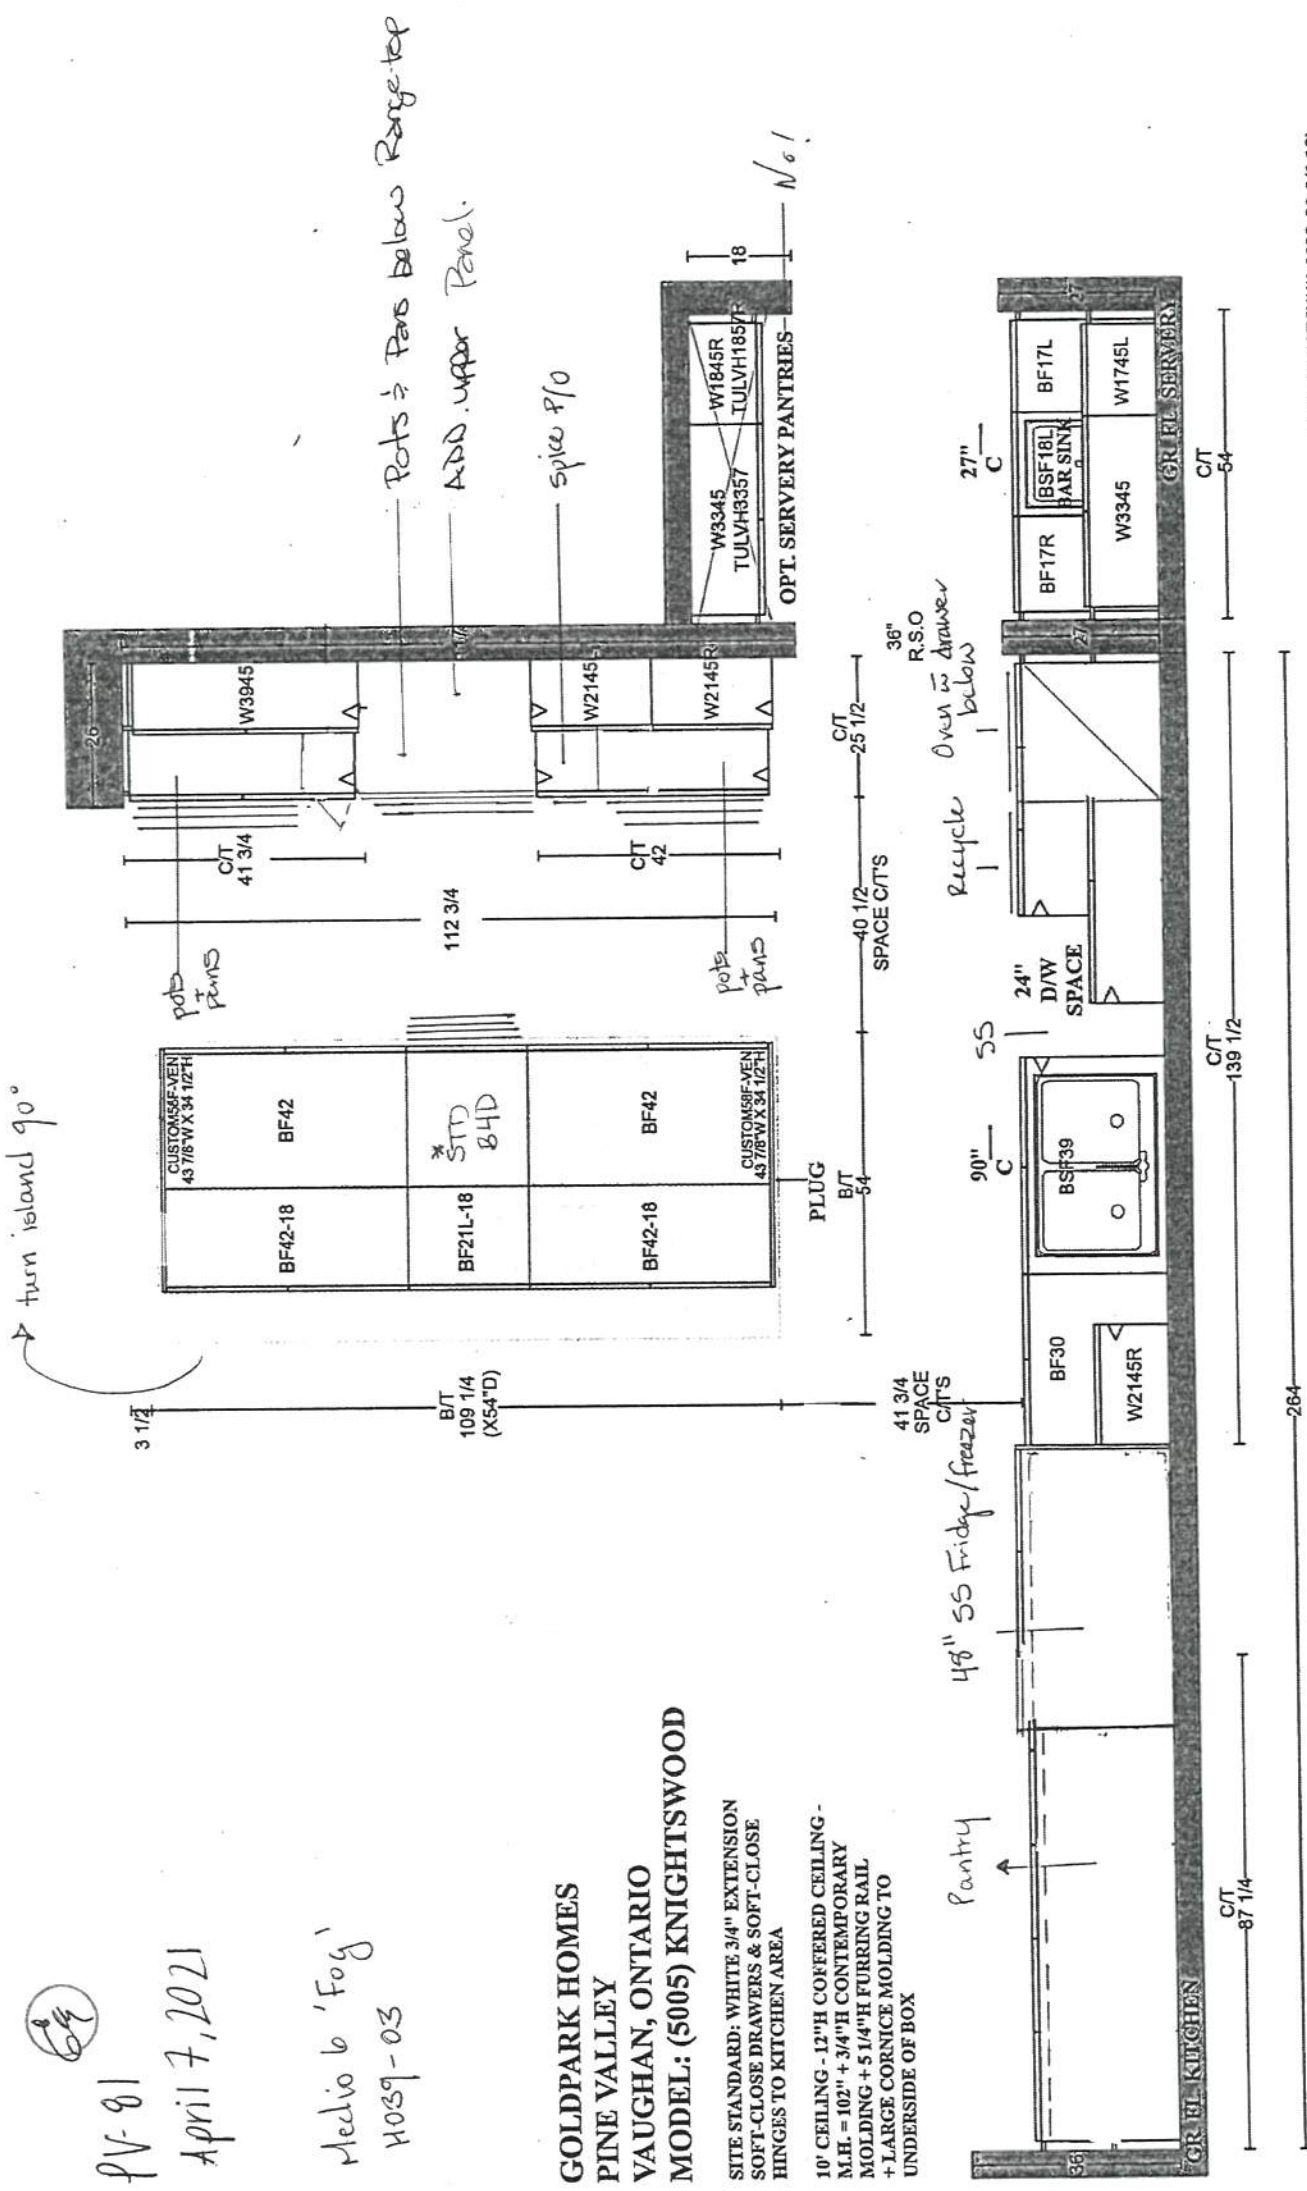

PLAN VIEW




Modena 'Classic Whites'
H039-03


GOLDPARK HOMES

SITE STAND APPD. WHITE 3/4" EXTENSION




CAN TON BE AVOIDED WHERE POSSIBLE THROUGHOUT

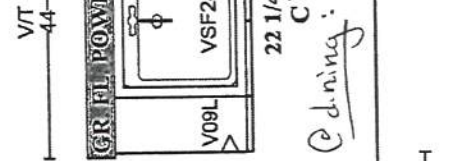



@dining: Modena
'Classic White'
H034-03

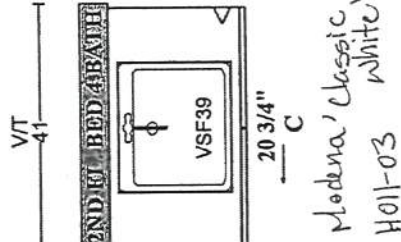

Modena, classic white
Holl-03

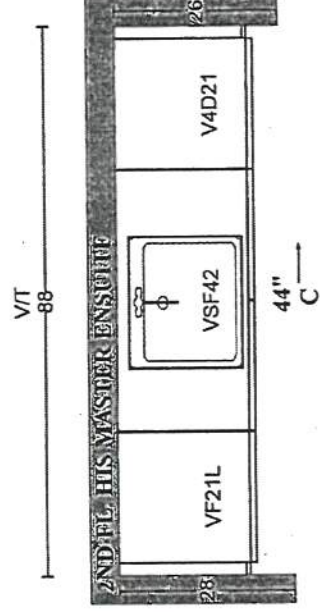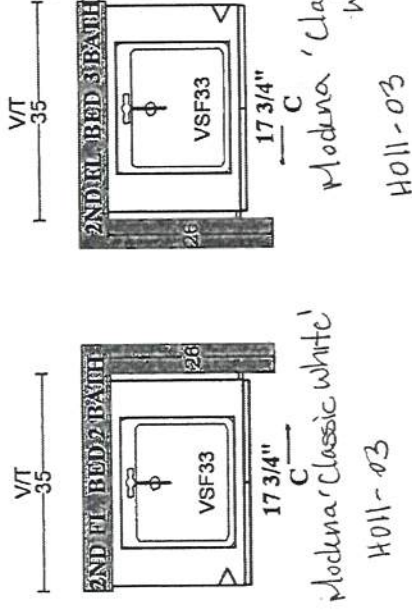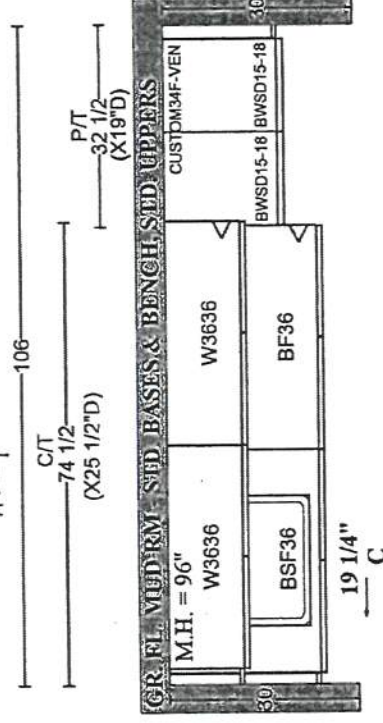

Modena 'Classic
White'
H039-03

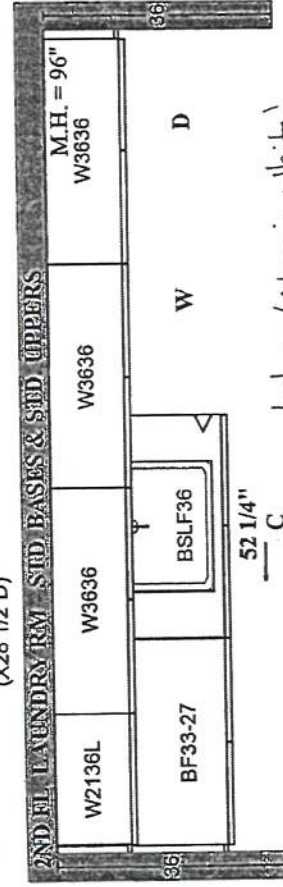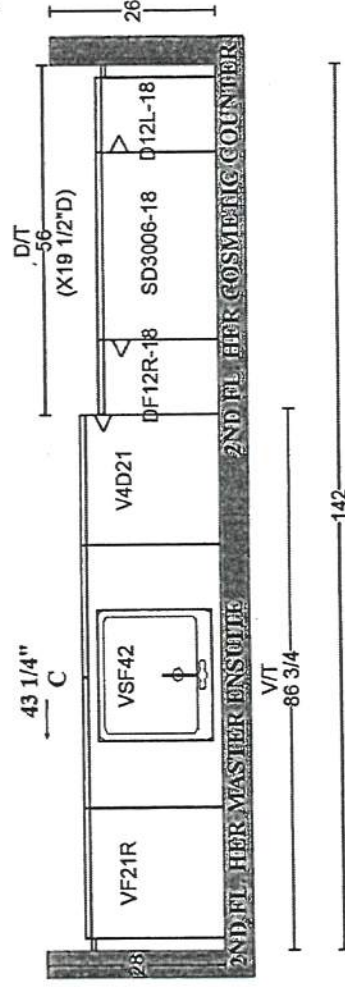

Modena 'classic white'


PV - 81 Cabinetry Schedule

ROOM	DESCRIPTION	PRICE	QTY	TOTAL
KITCHEN	UPGRADE FROM SERIES 2 TO SERIES 6 - <i>MEDIO 6 FOG</i>		1	
	ADJUST CABINETRY FOR 36" RANGETOP (N/C)		1	
	ADD UPPER CABINETS ABOVE HOOD FAN		1	
	ADD BASE POTS AND PANS BELOW RANGETOP		1	
	CONVERT BASE CABINETS TO BASE POTS AND PANS DRAWERS		2	
	ADD SPICE PULL OUT ACCESSORY TO BASE CABINETS FLANKING RANGETOP		1	
	ADD TWO-BIN RECYCLE CENTRE		1	
	ADJUST CABINETRY FOR 48" FRIDGE/FREEZER (N/C)		1	
	CONVERT STD CABINETRY TO TALL DEEP PANTRY UNIT BESIDE FRIDGE/FREEZER		1	
ISLAND	UPGRADE FROM SERIES 2 TO SERIES 6 - <i>MEDIO 6 FOG</i>		1	
	RELOCATE STD BANK OF 4 DRAWERS TO ISLAND (N/C)		1	
	**NOTE: ISLAND TO ROTATE 90 DEGREES - SEE PLAN (N/C)		1	
SERVERY	UPGRADE FROM SERIES 2 TO SERIES 6 - <i>MEDIO 6 FOG</i>		1	
CABINETRY TOTAL:				

HANDLE PLACEMENT: AT INSTALLERS DISCRETION

LOT #: PV-81

DATE: April 7, 2021

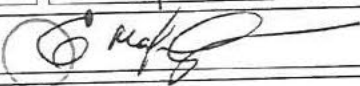SIGNATURE: 

SIGNATURE:

Purchaser: EKATERINA MARKEVICH

Property: 81 of Plan -

Telephone Res. / Bus: / (416) 388-8153

Project: Pine Valley Forevergreen - Phase 1

Decor Advisor: Angela Phim

Model and Elevation: 50.05 C KNIGHTSWOOD

Layout Changes: ☒ Yes ☐ No

Sketch Attached: ☒ Yes ☐ No

Exterior Colour Scheme:

1. Cabinetry

	Style and Colour	Counter	Hardware
Kitchen / Breakfast	Medio 6 'Fog'	Granite: 'Arctic White'	attach
Laundry Room	Modena 'Classic White'	P-Lam: 'White'	attach
Powder Room	see below	see below	attach
Mudroom	Modena 'Classic White'	P-Lam: 'White'	attach
Master Ensuite Bathroom	Modena 'Classic White'	Quartz: 'Ice Snow'	attach
Second Ensuite Bathroom (If Applicable)	Modena 'Classic White'	Quartz: 'Ice Snow'	attach
Ensuite 3	Modena 'Classic White'	Quartz: 'Ice Snow'	attach

Comment

Powder Rm @ Dining: Modena 'Classic White' + Countertop: Nordic Loft / Powder Rm @ Cabana: Tribeca 'Bianca' + Countertop: Nordic Loft / ENSUITE 4: Modena 'Classic White' + Countertop: Nordic Loft

2. Floor Tile

	Selection
Entrance Vestibule	13x13" Serpentine 'Beyaz White'
Main Hall	
Kitchen / Breakfast	13x13" Serpentine 'Beyaz White'
Laundry Room	13x13" New Reeds 'Silver'
Powder Room	see below
Mudroom	13x13" Cambridge 'White' Matte
Master Ensuite Bathroom	13x13" Costa 'White'
Second Ensuite Bathroom (If Applicable)	13x13" Costa 'White'
Lower Landing (If Applicable)	13x13" Serpentine 'Beyaz White' (basement)
Ensuite 3	12x12" Construct 'White'

Comment

Powder Rm @ Dining: 13x13" Serpentine 'Beyaz White' / Powder Rm @ Cabana: 13x13" Reflex 'White' / ENSUITE 4: 13x13" New Reeds 'Silver' / THRU-OUT Shower Floor: 2x2" white standard

3. Wall Tile

	Selection	Listello/Inserts	Describe
Ensuite 4	8x10" Weave 'Tender Grey'	☐ Yes ☒ No	
Master Ensuite Bathroom		☐ Yes ☒ No	
Tub Deck		☐ Yes ☒ No	
Shower Stall	8x10" Weave 'Tender Grey'	☐ Yes ☒ No	
Bathroom Walls		☐ Yes ☒ No	
Second Ensuite Bathroom (If Applicable)	8x10" Weave 'White'	☐ Yes ☒ No	
Ensuite 3	8x10" Splendor 'White'	☐ Yes ☒ No	
Kitchen Backsplash	☐ Yes ☒ No	Backsplash Behind Fridge	

Comment

64

Purchaser: EKATERINA MARKEVICH

Property: 81 of Plan -

Telephone Res. / Bus: / (416) 388-8153

Project: Pine Valley Forevergreen - Phase 1

Decor Advisor: Angela Phim

Model and Elevation: 50.05 C KNIGHTSWOOD

4. Plumbing Fixtures

Master Ensuite Bathroom Second Ensuite Powder Room
Other Room - Specify Other Washroom

Comment

*see attached for plumbing upgrades

5. Hardwood Flooring

	Type and Stain		Type and Stain
Main Hall		Upper Landing	
Kitchen / Breakfast		Upper Hall	
Living Room		Master Bedroom	
Dining Room		Bedroom #2	
Family Room		Bedroom #3	
Den/Library		Bedroom #4	
Entrance Vestibule		Bedroom #5	
Lower Landing (If Applicable)		Other Room - Specify thru-out standard areas	*5x3/4" white oak, sculpted, 'Athena'

Comment

6. Carpeting

	Upgrade	Description
Ground Floor	☐	
Second Floor	☐	
	☐	

	Type	Area
Upgrade Underpad		
	Capped	Runner - *Upgrade
Carpet on Stairs		

Comment

7. Fireplace

	Living Room			Family Room			Other Room - Specify			Great Room
	Purchased	As Per Plan	N/A	Purchased	As Per Plan	N/A	Purchased	As Per Plan	N/A	
Fireplace Type	☐	☐	☐	☐	☐	☐	☐	☒	☐	Standard Gas
Mantle Type										Mediterranean
Colour / Stain										Arctic White
Surround										n/a
Hearth										n/a

Comment

EM

Purchaser: EKATERINA MARKEVICH
Telephone Res. / Bus: / (416) 388-8153
Decorator Advisor: Angela Phim

Property: 81 of Plan -

Project: Pine Valley Forevergreen - Phase 1

Model and Elevation: 50.05 C KNIGHTSWOOD

8. Trim Carpentry

Interior Doors Carrara Front Door Glass Inserts std Door Handles std
Interior Trim Standard Package
Comment

9. Plaster Mouldings and Medallions

Standard Throughout ☐ Yes ☐ No ☒ N/A

Entrance Vestibule			Kitchen/Breakfast		
Main Hall			Den/Library		
Living Room			Lower Landing		
Dining Room			Other Room - Specify		
Family Room					
Comment					

10. Railings and Spindles

Railing Package Standard 2 Package
Railing Colour *Mirage 'Hopsctoch'
Stringer / Riser *Mirage 'Hopsctoch'
Spindle Colour *Mirage 'Hopsctoch'
Treads *Mirage 'Hopsctoch'
Oak Stairs ☒ Yes ☐ No ☐ N/A
Comment

11. Wall Paint / Ceilings

Throughout Finished Areas Warm Grey
Trim Paint White
Smooth Ceilings
Ground Floor ☒
Second Floor ☒
Note

Comment

AM

Purchaser: EKATERINA MARKEVICH

Property: 81 of Plan -

Telephone Res. / Bus: / (416) 388-8153

Project: Pine Valley Forevergreen - Phase 1

Decor Advisor: Angela Phim

Model and Elevation: 50.05 C KNIGHTSWOOD

12. Electrical

Hood Fan ☐ White ☐ Stainless ☒ N/A

Above Kitchen Cabinet Light ☐ Yes ☒ No

Below Kitchen Cabinet Light ☐ Yes ☒ No

Standard Appliances ☐

Over The Range Microwave ☐

Chimney Style Fan ☐

Comment

13. Heating and Air Conditioning

Air Conditioning

Gas Provisions Stove

Gas Provisions Dryer

Gas Provisions Barbecue

Comment

14. Additional Comments

15. Disclaimers and Notes

- Colours of all materials are as close as possible to builder's selection, but not necessarily identical due to variances in manufacturing.
- Any extras listed above are null and void unless accompanied by a separate invoice/amendment. Said invoice must be paid in full.
- The Purchaser acknowledges that after Interior Colour Selection form is signed and dated, no further changes will be permitted other than re-selection due to unavailability. _____ Purchaser's Initials
- The Purchaser acknowledges reading and accepting the "Gold Park Homes Decor Centre Disclaimers" form. This document contains other miscellaneous disclaimers.

This Interior Colour Selection is final and approved by:

Signature:  Date: Apr. 7 / 21

SCHEDULE 'F'




PV-81
Feb 16 2021

PV-81
April 7, 2021

The Knightswood 50' SERIES

Elevation A • 4,445 sq.ft.
4,475 sq.ft. Opt. Elevator / 4,575 sq.ft. Opt. Service Stairs
Elevation B • 4,440 sq.ft.
4,475 sq.ft. Opt. Elevator / 4,575 sq.ft. Opt. Service Stairs
Elevation C • 4,525 sq.ft.
4,560 sq.ft. Opt. Elevator / 4,660 sq.ft. Opt. Service Stairs

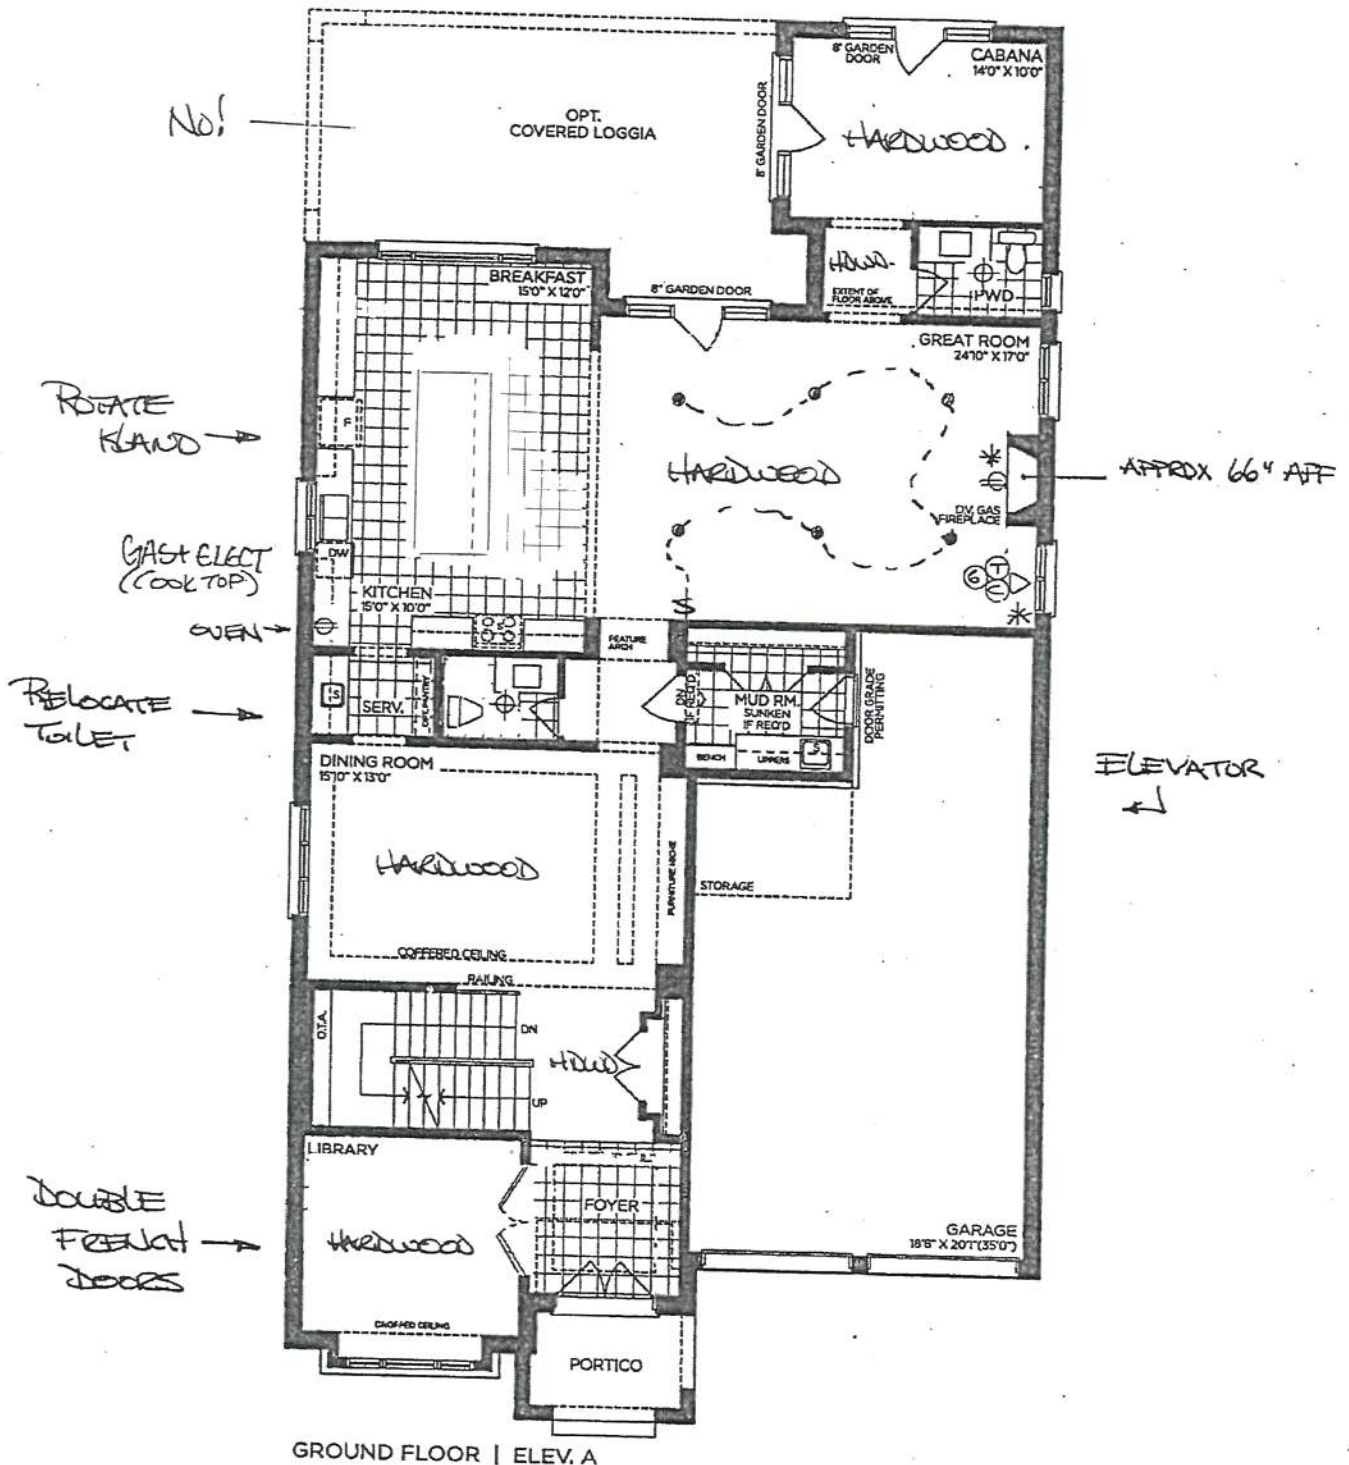

VENDOR

PURCHASER

PURCHASER

GOLDPARK
WORTH MORE™

Prices, figures, illustrations, sizes, features and finishes are subject to change without notice. Areas and dimensions are approximate and actual usable floor space may vary from the stated area. Layout may be reverse of the unit purchased. E. & O.E. 5005

SCHEDULE 'F'




PV-81
Feb 16 2021


5m
PV-81
April 7, 2021

The Knightswood 50' SERIES


Elevation A • 4,445 sq.ft.
4,475 sq.ft. Opt. Elevator / 4,575 sq.ft. Opt. Service Stairs
Elevation B • 4,440 sq.ft.
4,475 sq.ft. Opt. Elevator / 4,575 sq.ft. Opt. Service Stairs
→ Elevation C • 4,525 sq.ft.
4,560 sq.ft. Opt. Elevator / 4,660 sq.ft. Opt. Service Stairs

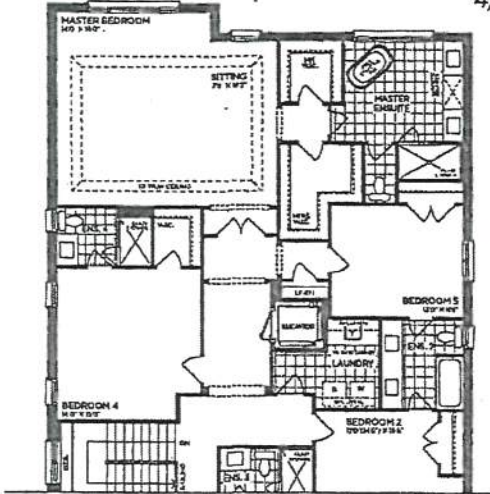


PART, OPT. SECOND FLOOR | ELEV. A (5 BEDROOMS - ELEVATOR)

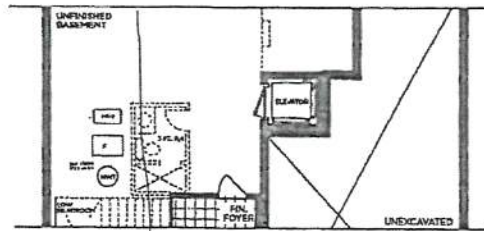


PART, OPT. BASEMENT | ELEV. A (ELEVATOR)

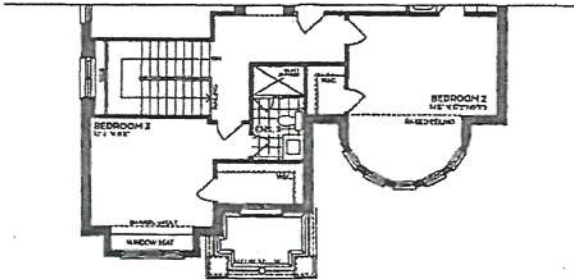


PART, SECOND FLOOR | ELEV. B

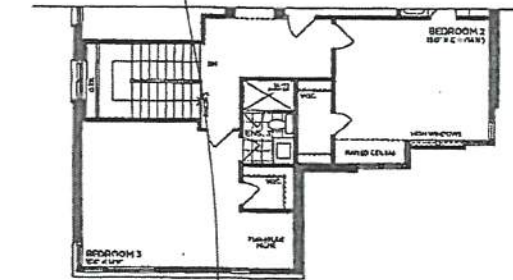


PART, SECOND FLOOR | ELEV. C

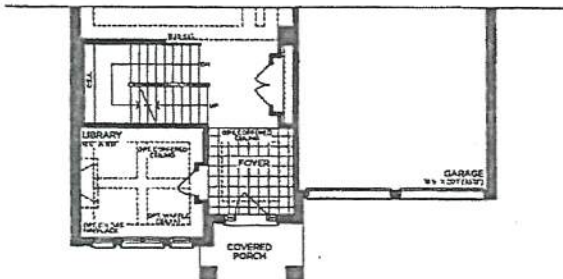


PART, GROUND FLOOR | ELEV. B

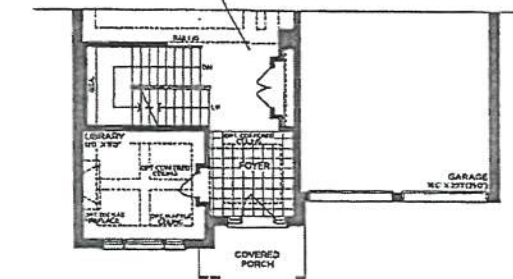

PART, GROUND FLOOR | ELEV. C

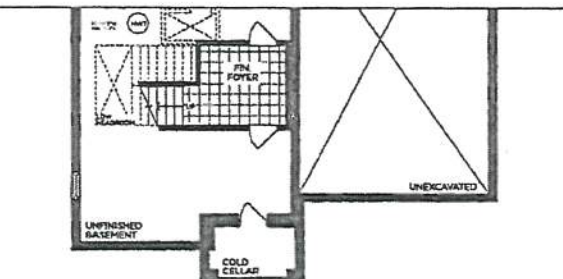

PART, BASEMENT | ELEV. B

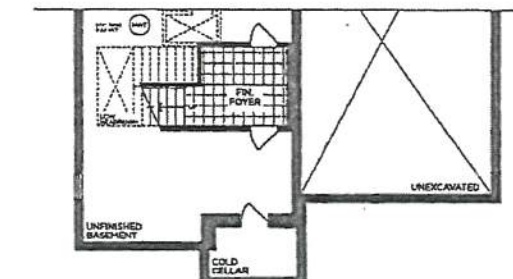

PART, BASEMENT | ELEV. C

VENDOR
PURCHASER
PURCHASER

GOLDPARK
WORTH MORE™

Prices, figures, illustrations, sizes, features and finishes are subject to change without notice. Areas and dimensions are approximate and actual usable floor space may vary from the stated area. Layout may be reverse of the unit purchased. E. & O.E. 5005

SCHEDULE 'F'




PV-81
Feb 16 221

GM
PV-91 GM
April 7, 2021

The Knightswood 50' SERIES

Elevation A • 4,445 sq.ft.
4,475 sq.ft. Opt. Elevator / 4,575 sq.ft. Opt. Service Stairs
Elevation B • 4,440 sq.ft.
4,475 sq.ft. Opt. Elevator / 4,575 sq.ft. Opt. Service Stairs
Elevation C • 4,525 sq.ft.
4,560 sq.ft. Opt. Elevator / 4,660 sq.ft. Opt. Service Stairs

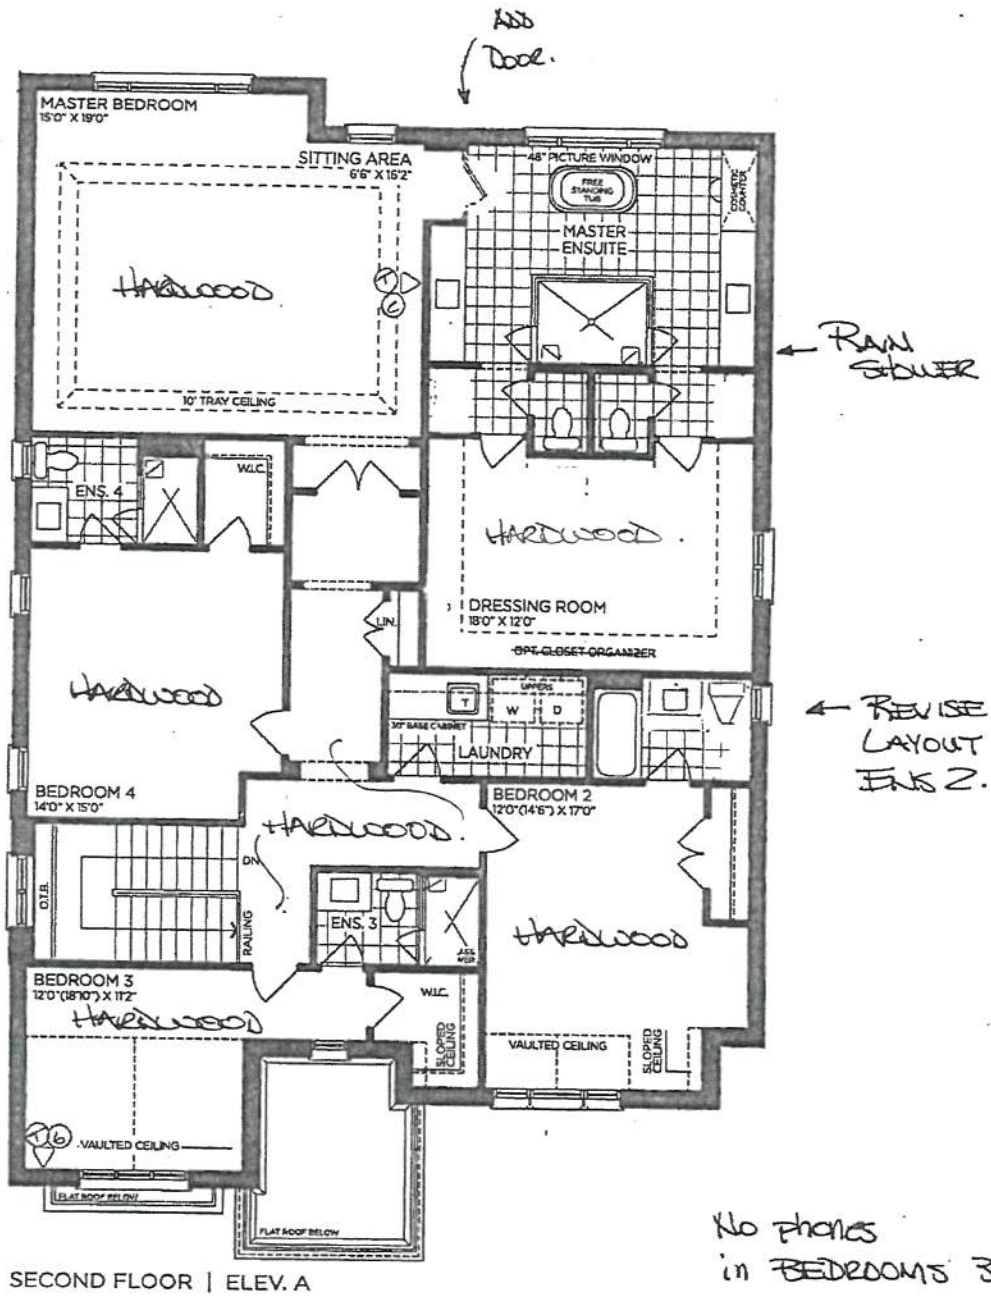

VENDOR
PURCHASER
PURCHASER

GOLDPARK
WORTH MORE™

Prices, figures, illustrations, sizes, features and finishes are subject to change without notice. Areas and dimensions are approximate and actual usable floor space may vary from the stated area. Layout may be reverse of the unit purchased. E. & O.E. 5005

SCHEDULE 'F'




PV-81
Feb 16 2021


PV-81
April 7, 2021

The Knightswood 50' SERIES


Elevation A • 4,445 sq.ft.
4,475 sq.ft. Opt. Elevator / 4,575 sq.ft. Opt. Service Stairs
Elevation B • 4,440 sq.ft.
4,475 sq.ft. Opt. Elevator / 4,575 sq.ft. Opt. Service Stairs
Elevation C • 4,525 sq.ft.
4,560 sq.ft. Opt. Elevator / 4,660 sq.ft. Opt. Service Stairs

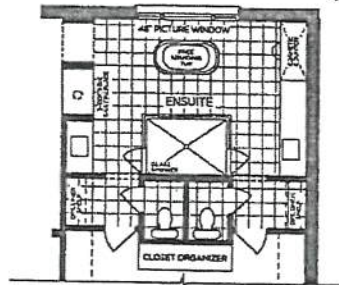


PART. OPT. ENSUITE LAYOUT

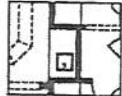


PART. OPT. WETBAR SITTING AREA

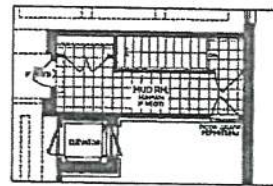


OPT. PART. GROUND FLOOR SERVICE STAIR W/ ELEVATOR | ELEV. A

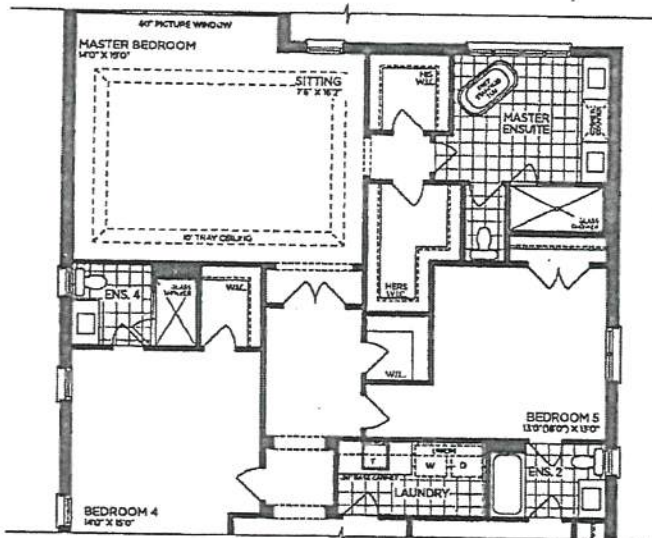


PART. OPT. SECOND FLOOR | ELEV. A (5 BEDROOMS)

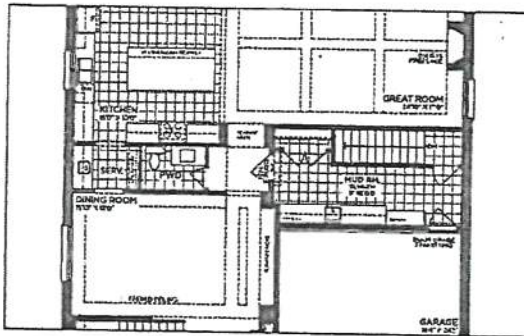


OPT. PART. GROUND FLOOR W/ SERVICE STAIR | ELEV. A

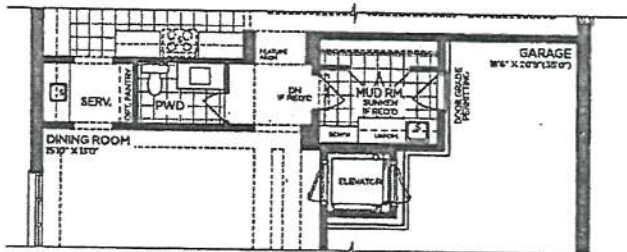

PART. OPT. GROUND FLOOR | ELEV. A (ELEVATOR)

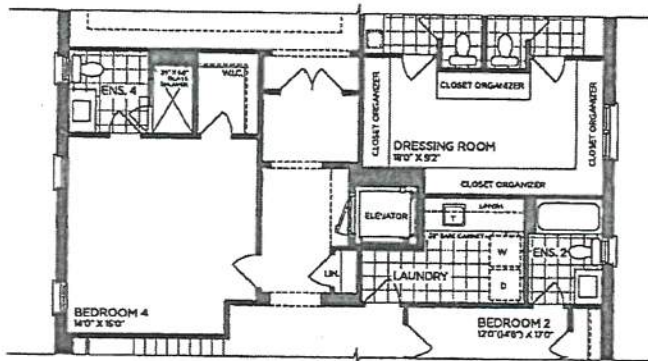

PART. OPT. SECOND FLOOR | ELEV. A (ELEVATOR)

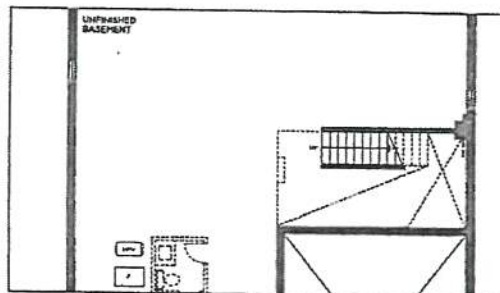

OPT. PART. BASEMENT W/ SERVICE STAIR | ELEV. A

VENDOR
PURCHASER
PURCHASER

GOLDPARK
WORTH MORE™

Prices, figures, illustrations, sizes, features and finishes are subject to change without notice. Areas and dimensions are approximate and actual usable floor space may vary from the stated area. Layout may be reverse of the unit purchased. E. & O.E. 5005

SCHEDULE 'F'



PV-81
Feb 16 2021




PV-91
April 7, 2021



The Knightswood 50' SERIES

Elevation A • 4,445 sq.ft.
4,475 sq.ft. Opt. Elevator / 4,575 sq.ft. Opt. Service Stairs
Elevation B • 4,440 sq.ft.
4,475 sq.ft. Opt. Elevator / 4,575 sq.ft. Opt. Service Stairs
→ Elevation C • 4,525 sq.ft.
4,560 sq.ft. Opt. Elevator / 4,660 sq.ft. Opt. Service Stairs

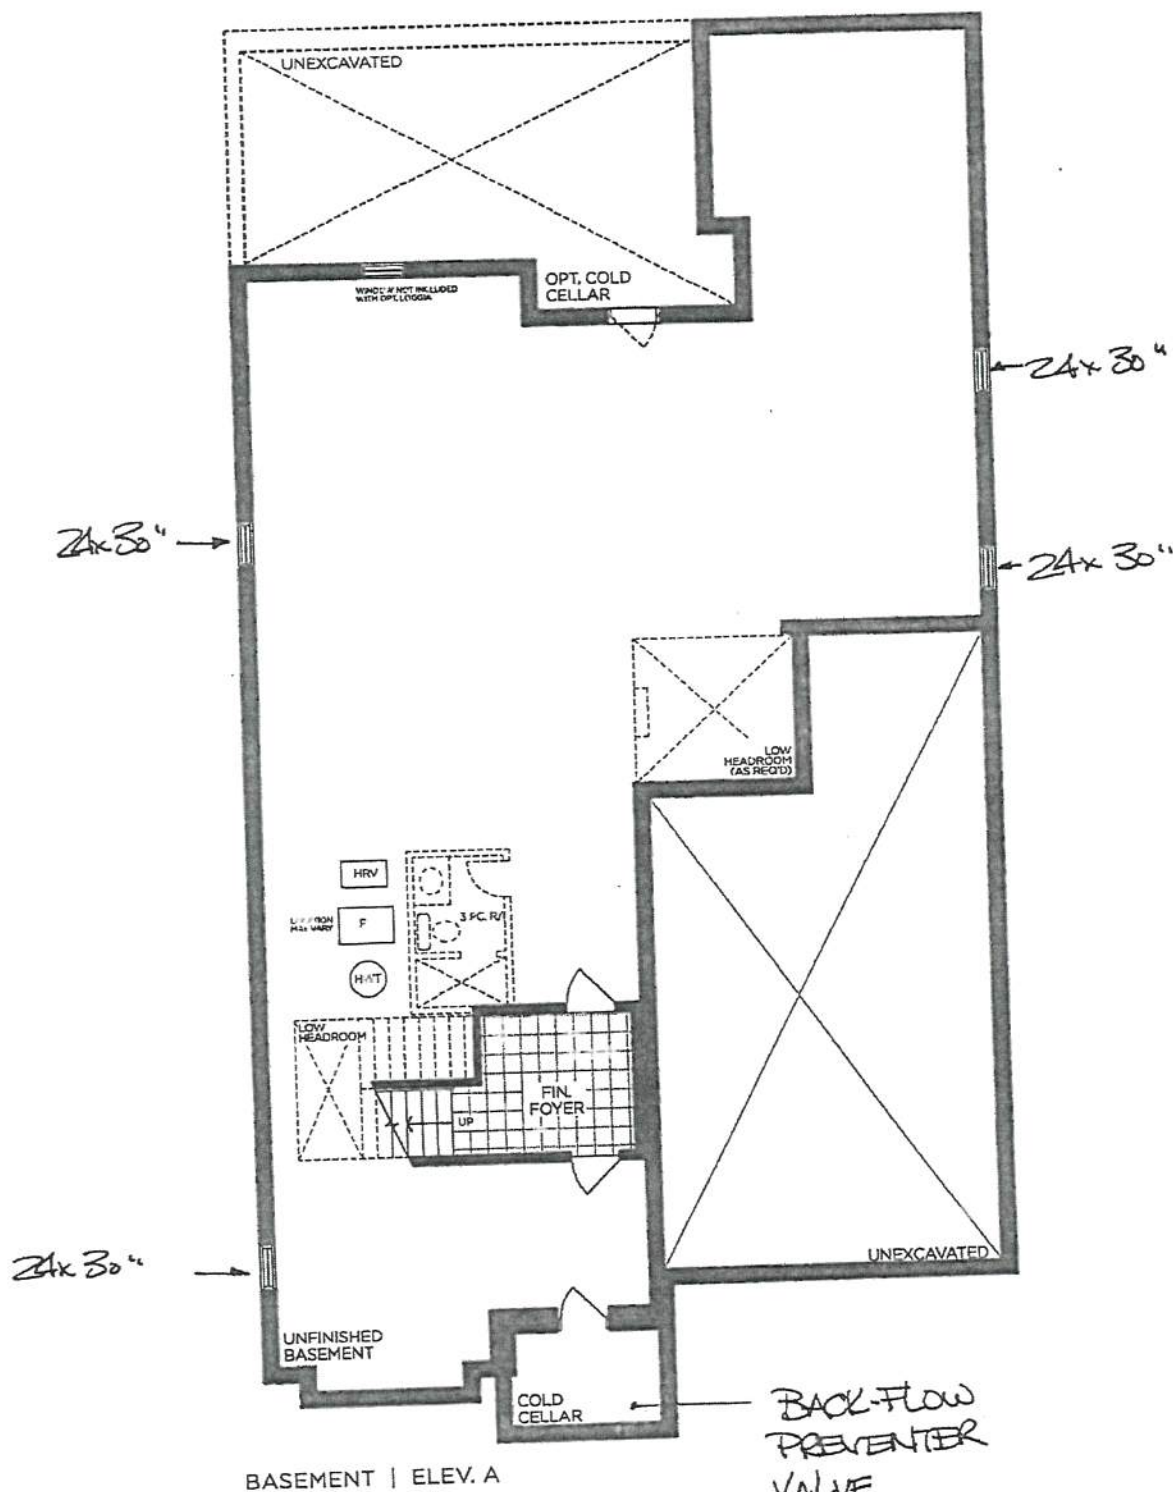

BASEMENT | ELEV. A

VENDOR


PURCHASER

PURCHASER

GOLDPARK
WORTH MORE

Prices, figures, illustrations, sizes, features and finishes are subject to change without notice. Areas and dimensions are approximate and actual usable floor space may vary from the stated area. Layout may be reverse of the unit purchased. E. & O.E. 5005

STONE COUNTERTOP EDGE PROFILES

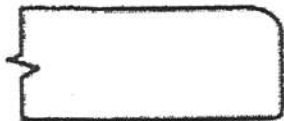

STANDARD 2CM EASED EDGE


LOCATION:

Thru out




UPGRADE 3CM EASED EDGE


LOCATION:

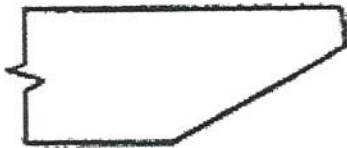

UPGRADE 4CM MITRED EDGE

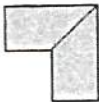

LOCATION:

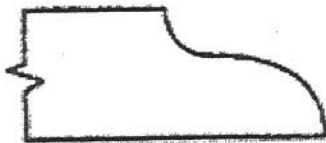

UPGRADE 2CM OGEE EDGE

LOCATION:

LOT #:

81

DATE:

Apr 7. 2021

SIGNATURE:



SIGNATURE:





PINE VALLEY
FOREVERGREEN

STANDARD HARDWARE / HANDLES

☐

H001-02

☐

H001-03

☐

H001-04

☐

H009-03

☐

H009-09

☒

H011-03

Ens 2
Ens 4.


☐

H011-05

☒

H011-06

Ens 3.

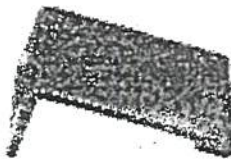☐

H033-01

☒

H039-03

KITCHEN
New Room + Laundry.
POWDER x 2.
MASTER.

☐

*NO HARDWARE

LOT #

81

DATE:

April 7, 2021

SIGNATURE:

[Signature]

SIGNATURE:

[Signature]

GOLDPARK
WORTH MORE




PINE VALLEY
FOREVERGREEN

UPGRADE SHOWER HARDWARE

SQ6X6

Shower Door Handle

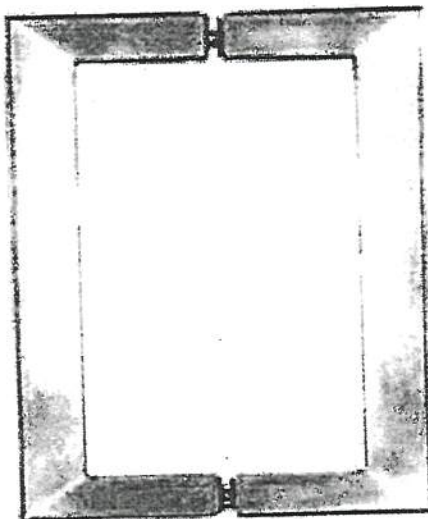

SQ6X6
Shower Door Handle

6" x 6" back-to-back
3/4" square tube
(Also available single sided)

☒ CHROME

☐ MATTE BLACK

Lot# 81	Date: APRIL 7 2021	Room: MASTER ENSUITE
Signature: 		
Signature:		


GOLDPARK
WORTH MORE

STANDARD SHOWER HARDWARE



SDK106

Shower Door Knob

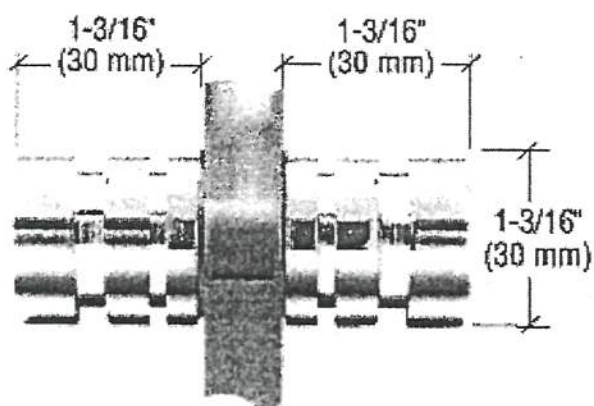

SDK106

Shower Door Knob

1-3/16" dia.

Contemporary Style

(Also available single sided)


CHROME

Lot# 81	Date: April 7 2021	Room: ENS 3 + 4.
Signature: 		
Signature:		




PINE VALLEY
FOREVERGREEN


ELEVATOR WALL FINISH OPTIONS

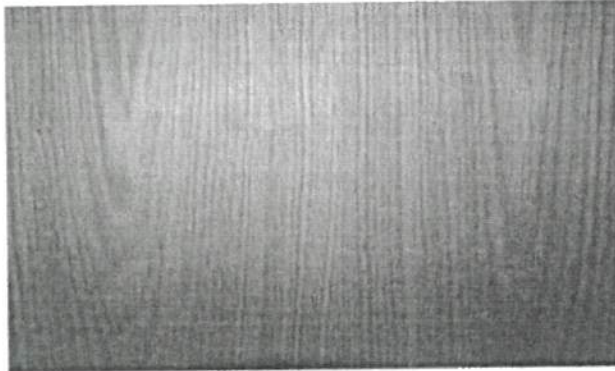

UNFINISHED OAK ☐

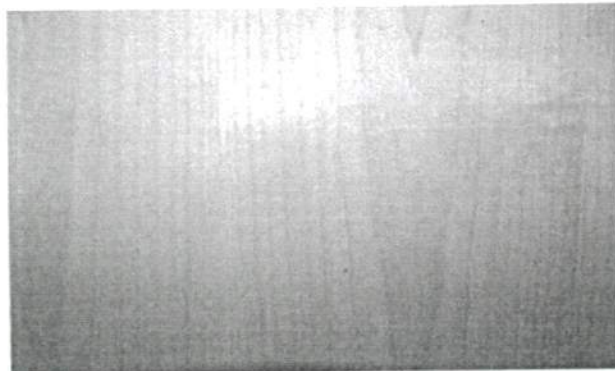

UNFINISHED MAPLE ☐

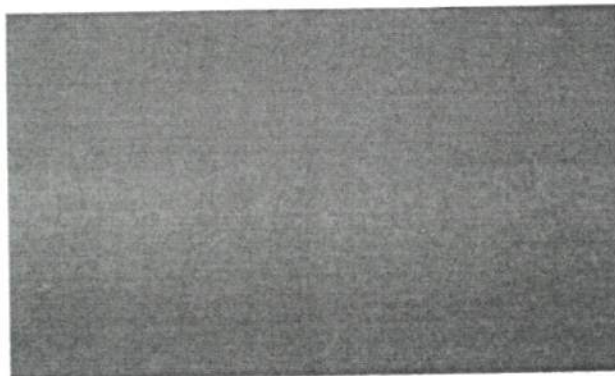

UNFINISHED MDF ☒

↳ PAINTED WHITE
+ HARDWOOD ON FLOOR

LOT #:

81

DATE:

APRIL 7 2021


SIGNATURE:

[Handwritten Signature]


SIGNATURE:

GOLD PARK
WORTH MORE

BATHROOM ACCESSORIES

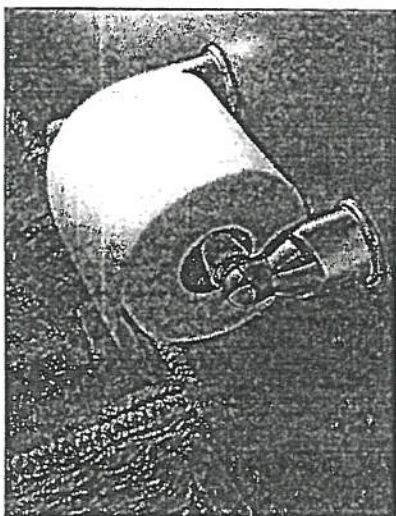

Tissue Holder
Mason - Chrome

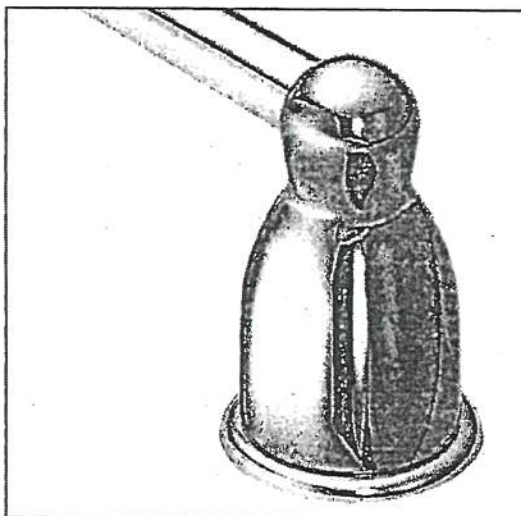

Towel Bar
Mason - Chrome

Please select one of the following:

☒ **INSTALL STANDARD BATHROOM ACCESSORIES THRU OUT**
(tissue holder + towel bar) **location as per vendors discretion**

☐ ***DO NOT* INSTALL STANDARD BATHROOM ACCESSORIES**
THRU OUT **tissue holder + towel bar will not be provided**

LOT #

81

DATE:

April 7, 2021

SIGNATURE:

SIGNATURE:





Project: Pine Valley

Lot: 81

Purchaser(s): Ekaterina Markevich

Standard Hood Fan Deletion

We acknowledge that the builder's standard hood fan will not be installed.
Do not supply, install and/or credit. We will install our own hood fan after closing.

Signature: 

Signature: 

Date: April 7, 2021