



CONSTRUCTION SUMMARY

Lot: 117
Model: 38-1 Elev.B BIZET
Project/Phase: Brampton Encore / 2

APPLIANCES

Invoice	Qty.	Description
2277 21Jul20 NoCat	1	APPLIANCE PACKAGE: FRIDGE/STOVE/DISHWASHER - STAINLESS STEEL + WASHER/DRYER - WHITE INCLUDED IN APS

CENTRAL VAC AND WIRING

Invoice	Qty.	Description
2277 28,799 21Jul20	1	FAMILY ROOM: CONDUIT PIPE- FOR TELEVISION- LOCATE APPROX. 66" A.F.F. ABOVE FIREPLACE, TERMINATING AT CABLE - SEE PLAN
2277 28,794 21Jul20	1	FAMILY ROOM: CAT 6 WIRING - ADD CAT 6 OUTLET- SEE PLAN FOR LOCATION
2277 28,800 21Jul20	1	CONDUIT PIPE- FROM ATTIC TO ELECTRICAL PANEL- FROM ELECTRICAL PANEL IN BASEMENT, TERMINATING AT APPROX CENTER OF ATTIC

CERAMIC

Invoice	Qty.	Description
2373 13Apr21 NoCat	1	FOYER / POWDER / MUD ROOM: UPGRADE 4 FLOOR TILE - 12X24" LAID IN STRAIGHT, STACKED PATTERN. SEE PLAN FOR TILE DIRECTION
2373 13Apr21 NoCat	1	MASTER ENSUITE-FLOOR *AND* TUB SKIRT/SPLASH/DECK: UPGRADE 4 TILE - 12X24" LAID IN STRAIGHT, STACKED PATTERN. SEE PLAN FOR TILE DIRECTION **not** SHOWER WALLS
2373 13Apr21 NoCat	1	MASTER ENSUITE - SHOWER WALLS & SHOWER CEILING: UPGRADE 2 - 8X24" LAID IN HORIZONTAL STACKED PATTERN
2373 13Apr21 NoCat	1	MASTER ENSUITE: UPGRADE 4 SHOWER FLOOR TILE - 2X2" POLISHED MOSAIC
2373 13Apr21 NoCat	1	2ND FLOOR LAUNDRY: UPGRADE 4 FLOOR TILE - 12X24" LAID IN STRAIGHT, STACKED PATTERN - SEE PLAN FOR TILE DIRECTION

CONCRETE AND DRAIN

Invoice	Qty.	Description
2277 28,894 21Jul20 **	1	ROUGH-IN - 3PC BASEMENT ROUGH-IN INCLUDED IN APS



CONSTRUCTION SUMMARY

Lot: 117
Model: 38-1 Elev.B BIZET
Project/Phase: Brampton Encore / 2

DRYWALL

Invoice	Qty.	Description
2277 28,855 21Jul20	1	2ND FLOOR: SMOOTH CEILINGS - (2-Story Design) 2ND FLOOR

ELECTRICAL

Invoice	Qty.	Description
2277 28,804 21Jul20	1	FAMILY ROOM: 110V WALL RECEPTACLE ON DEDICATED CIRCUIT - LOCATE APPROX. 66" A.F.F. ABOVE FIREPLACE
2277 21Jul20 NoCat	1	FAMILY ROOM: INSTALL LED POTLIGHT (IN LIEU OF STANDARD CEILING LIGHT IN FAMILY ROOM), SEE PLAN FOR LOCATION. LOCATE APPROX. 30" FROM EACH WALL - SEE PLAN FOR LOCATION
2277 21Jul20 NoCat	1	MASTER ENSUITE: RELOCATE STANDARD VANITY LIGHT TO BE CENTERED ABOVE *LEFT* SINK
2277 21Jul20 NoCat	1	MASTER ENSUITE: ADD CAPPED WALL SCONCE ABOVE *RIGHT* SINK - USE SAME SWITCH AS STANDARD VANITY LIGHT LOCATE SAME HEIGHT AS STANDARD VANITY LIGHT
2277 21Jul20 NoCat	1	KITCHEN: SINGLE POLE SWITCH FOR ISLAND LIGHTS
2277 21Jul20 NoCat	1	KITCHEN: INSTALL LED POTLIGHT (IN LIEU OF STANDARD CEILING LIGHT IN KITCHEN), SEE PLAN FOR LOCATION
2277 28,808 21Jul20	1	KITCHEN: 110V WALL RECEPTACLE ON DEDICATED CIRCUIT - GAS FIRED APPLIANCE - FOR AUX. EQUIPMENT - NOT A STOVE PLUG
2277 28,830 21Jul20	1	KITCHEN CABINET VALANCE LIGHTS (UNDER CABINETS) - WITH STRIP LIGHTS - DOES NOT INCLUDE (AND REQUIRES) KITCHEN UPGRADE PRICING
2373 28,807 13Apr21	1	KITCHEN: 110V WALL RECEPTACLE ON DEDICATED CIRCUIT - FOR MICROWAVE - MICROWAVE NOT INCLUDED



CONSTRUCTION SUMMARY

Lot: 117
Model: 38-1 Elev.B BIZET
Project/Phase: Brampton Encore / 2

FORMING

Invoice	Qty.	Description
2277 28,841 21Jul20	1	SIDE DOOR- HOME TO EXTERIOR- AS PER PLAN AND GRADE PERMITTING INCLUDED IN APS
2277 21Jul20 ** NoCat	1	SIDE DOOR- HOME TO EXTERIOR- AS PER PLAN AND GRADE PERMITTING
2277 21Jul20 ** NoCat	1	SIDE DOOR- HOME TO EXTERIOR- AS PER PLAN AND GRADE PERMITTING
2277 21Jul20 ** NoCat	1	SIDE DOOR- HOME TO EXTERIOR- AS PER PLAN AND GRADE PERMITTING
2277 21Jul20 NoCat	1	MANDOOR - GARAGE TO HOUSE- AS PER PLAN AND GRADE PERMITTING
2277 21Jul20 NoCat	1	BASEMENT WINDOWS - UPGRADE EXISTING BASEMENT WINDOW TO 30 INCH X 16 INCH SEE PLAN FOR LOCATION
2277 21Jul20 NoCat	1	LOOK OUT BASEMENT CONDITION

FRAMING

Invoice	Qty.	Description
2277 28,842 21Jul20	1	MANDOOR - GARAGE TO HOUSE- AS PER PLAN AND GRADE PERMITTING INCLUDED IN APS
2277 21Jul20 NoCat	3	MAIN FLOOR: EXTENDED HEIGHT ARCHWAY (PRICE PER DOORWAY) - 96" (DOORS ON MAIN FLOOR TO REMAIN STANDARD 80")
2277 21Jul20 NoCat	1	BASEMENT WINDOWS - UPGRADE EXISTING BASEMENT WINDOW TO 30 INCH X 16 INCH SEE PLAN FOR LOCATION
2277 21Jul20 NoCat	1	LOOK OUT BASEMENT CONDITION



CONSTRUCTION SUMMARY

Lot: 117
Model: 38-1 Elev.B BIZET
Project/Phase: Brampton Encore / 2

GLASS AND MIRROR

Invoice	Qty.	Description
2373 28,868 13Apr21	1	MASTER ENSUITE: CONVERT FRAMED SHOWER TO 10MM FRAMLESS SHOWER ENCLOSURE WITH DOOR AND 10MM SIDE PANEL

GRANITE MARBLE QUARTZ

Invoice	Qty.	Description
2373 13Apr21 NoCat	1	KITCHEN: UPGRADE 1 QUARTZ
2373 13Apr21 NoCat	1	KITCHEN: FLUSH BREAKFAST BAR
2373 13Apr21 NoCat	1	MASTER ENSUITE: UPGRADE 2 QUARTZ COUNTER

HARDWOOD

Invoice	Qty.	Description
2373 13Apr21 NoCat	1	MAIN FLOOR - FAMILY / MAIN HALL / DINING ROOM: UPGRADE 3 HARDWOOD - VINTAGE WHITE OAK WIRE BRUSH 3/4X5"
2373 13Apr21 NoCat	1	KITCHEN/BREAKFAST: UPGRADE 3 HARDWOOD - VINTAGE WHITE OAK WIRE BRUSH 3/4X5"
2373 13Apr21 NoCat	1	**MAIN STAIRS** LANDINGS TO BE 3/4X3" RED OAK SMOOTH - STAINED ON SITE TO MATCH STAIRS - NOT HARDWOOD FLOORING

HVAC

Invoice	Qty.	Description
2277 28,874 21Jul20	1	KITCHEN: GAS LINE ROUGH - GROUND FLOOR
2277 28,879 21Jul20	1	HUMIDIFIER: WB3 - 17 (UP TO 3,000 SQ.FT.)
2277 21Jul20 NoCat	1	A/C- 2.5 TON INCLUDED IN APS



CONSTRUCTION SUMMARY

Lot: 117
Model: 38-1 Elev.B BIZET
Project/Phase: Brampton Encore / 2

INTERIOR TRIM AND DOORS

Invoice	Qty.	Description
2277 28,885 21Jul20	3	MAIN FLOOR: EXTENDED HEIGHT ARCHWAY (PRICE PER DOORWAY) - 96" (DOORS ON MAIN FLOOR TO REMAIN STANDARD 80")
2277 28,841 21Jul20 **	1	SIDE DOOR- HOME TO EXTERIOR- AS PER PLAN AND GRADE PERMITTING INCLUDED IN APS
2277 21Jul20 ** NoCat	1	SIDE DOOR- HOME TO EXTERIOR- AS PER PLAN AND GRADE PERMITTING
2277 21Jul20 NoCat	1	SIDE DOOR- HOME TO EXTERIOR- AS PER PLAN AND GRADE PERMITTING
2277 21Jul20 ** NoCat	1	SIDE DOOR- HOME TO EXTERIOR- AS PER PLAN AND GRADE PERMITTING
2373 13Apr21 NoCat	1	THRU OUT: UPGRADE 1 INTERIOR TRIM - 2-3/4 X 5-1/4" BASEBOARD



CONSTRUCTION SUMMARY

Lot: 117
Model: 38-1 Elev.B BIZET
Project/Phase: Brampton Encore / 2

KITCHEN AND BATH CABINETRY

Invoice	Qty.	Description
2277 21Jul20 NoCat	2	KITCHEN: ADD CAPPED CEILING OUTLET APPROX CENTERED ABOVE ISLAND
2277 28,830 21Jul20 **	1	KITCHEN CABINET VALANCE LIGHTS (UNDER CABINETS) - WITH STRIP LIGHTS - DOES NOT INCLUDE (AND REQUIRES) KITCHEN UPGRADE PRICING
2277 21Jul20 NoCat	1	KITCHEN: CABINET VALANCE (ELECTRICAL NOT INCLUDED)
2373 13Apr21 NoCat	1	KITCHEN: DELETE UPPERS ABOVE STOVE, FINISH SIDES OF CABINETS - LEAVE APPROX 36" SPACE FOR FUTURE 30" CHIMNEY-STYLE HOOD FAN
2373 13Apr21 NoCat	1	KITCHEN: POTS AND PANS DRAWERS - 1 SHALLOW TOP DRAWER + 2 DEEP DRAWERS BELOW.
2373 13Apr21 NoCat	1	KITCHEN: UPGRADE 6 MDF PROFILE
2373 13Apr21 NoCat	1	KITCHEN: 2-TIER SPICE PULL OUT
2373 13Apr21 NoCat	1	KITCHEN: UPGRADE HARDWARE
2373 13Apr21 NoCat	1	KITCHEN: RAISE CABINETS FOR HARDWOOD IN KITCHEN
2373 13Apr21 NoCat	1	MASTER ENSUITE: UPGRADE 6 PROFILE - MDF
2373 13Apr21 NoCat	1	KITCHEN: ADD MICROWAVE CABINET WITH MATCHING INTERIOR OPEN SHELF



CONSTRUCTION SUMMARY

Lot: 117
Model: 38-1 Elev.B BIZET
Project/Phase: Brampton Encore / 2

PAINT

Invoice	Qty.	Description
2277 21Jul20 NoCat	1	MANDOOR - GARAGE TO HOUSE- AS PER PLAN AND GRADE PERMITTING
2277 21Jul20 NoCat	3	MAIN FLOOR: EXTENDED HEIGHT ARCHWAY (PRICE PER DOORWAY) - 96" (DOORS ON MAIN FLOOR TO REMAIN STANDARD 80")
2373 13Apr21 NoCat	1	MAIN STAIRS: STAIN STAIRS DARK COLOUR STAIRS WILL NOT MATCH HARDWOOD IN COLOUR, TEXTURE OR SPECIES

PLUMBING

Invoice	Qty.	Description
2277 28,894 21Jul20	1	ROUGH-IN - 3PC BASEMENT ROUGH-IN INCLUDED IN APS
2373 13Apr21 NoCat	2	MASTER ENSUITE: CONTRAC 'COLLETTE' RECTANGULAR UNDERMOUNT SINK #4220-CIY

WINDOWS - BASEMENT

Invoice	Qty.	Description
2277 28,915 21Jul20	1	BASEMENT WINDOWS - UPGRADE EXISTING BASEMENT WINDOW TO 30 INCH X 16 INCH SEE PLAN FOR LOCATION INCLUDED IN APS
2277 21Jul20 NoCat	1	LOOK OUT BASEMENT CONDITION INCLUDED IN APS



CONSTRUCTION SUMMARY

Lot: 117
Model: 38-1 Elev.B BIZET
Project/Phase: Brampton Encore / 2

WINDOWS AND DOORS

Invoice	Qty.	Description
2277 28,841 21Jul20 **	1	SIDE DOOR- HOME TO EXTERIOR- AS PER PLAN AND GRADE PERMITTING INCLUDED IN APS
2277 21Jul20 ** NoCat	1	SIDE DOOR- HOME TO EXTERIOR- AS PER PLAN AND GRADE PERMITTING
2277 21Jul20 ** NoCat	1	SIDE DOOR- HOME TO EXTERIOR- AS PER PLAN AND GRADE PERMITTING
2277 21Jul20 ** NoCat	1	SIDE DOOR- HOME TO EXTERIOR- AS PER PLAN AND GRADE PERMITTING
2277 21Jul20 NoCat	1	MANDOOR - GARAGE TO HOUSE- AS PER PLAN AND GRADE PERMITTING

Scheduled Closing Date:

Purchasers: JASON MICHAEL SHANE & JAINITA VASANTLA Property: 117

Telephone Res. / Bus: (416) 316-8599

Project: Brampton Encore - Phase 2

Decor Advisor: Yolande Somerville

Model and Elevation: 38-1 Elev.B BIZET

Layout Changes: ☐ Yes ☒ No

Sketch Attached: ☒ Yes ☐ No

Exterior Colour Scheme:

1. Cabinetry

	Style and Colour	Counter	Hardware
Kitchen / Breakfast	*Florentine mdf 'Fog Grey' mt	*Quartz 'Cotton Knit	*CH-47
Laundry Room	n/a	n/a	n/a
Powder Room	n/a	n/a	n/a
Main Bath	Siena oak 'Greystone'	P-Lam #8698-46	cs1-24
Master Ensuite Bathroom	*Florentine mdf 'Fog Grey' mt	*Quartz 'Pure White'	cs1-23
Second Ensuite Bathroom (If Applicable)	n/a	n/a	n/a

Comment

2. Floor Tile

	Selection
Entrance Vestibule	*12x24" Eterna Silver polished 'Medium Grey'
Main Hall	n/a
Kitchen / Breakfast	see hardwood
Laundry Room	*12x24" Eterna Silver **MATTE** 'Medium Grey'
Powder Room	*12x24" Eterna Silver polished 'Medium Grey'
Mud Room	*12x24" Eterna Silver **MATTE** 'Medium Grey'
Master Ensuite Bathroom	*12X24" Carrara X polished 'White'
Second Ensuite Bathroom (If Applicable)	n/a
Lower Landing (If Applicable)	n/a
Main Bath	13x13" Costa 'White' matte

Comment

*Master Ensuite Shower Floor: 2x2" Carrara X 'White pol.' Mosaic

Jan. 11, 2021

3. Wall Tile

	Selection	Listello/Inserts	Describe
M. Ens. tub skirt/splash	*12X24" Carrara X polished 'White'	<input type="radio"/> Yes <input checked="" type="radio"/> No	
Master Ensuite Bathroom			
Tub Deck	*12X24" Carrara X polished 'White'	<input type="radio"/> Yes <input checked="" type="radio"/> No	
Shower Stall	*8x24" Laguna 'White Wave'	<input type="radio"/> Yes <input checked="" type="radio"/> No	
Bathroom Walls	n/a	<input type="radio"/> Yes <input checked="" type="radio"/> No	
Second Ensuite Bathroom (If Applicable)	n/a	<input type="radio"/> Yes <input checked="" type="radio"/> No	
Main Bath	8x10" Weave 'White'	<input type="radio"/> Yes <input checked="" type="radio"/> No	
Kitchen Backsplash	<input type="radio"/> Yes <input checked="" type="radio"/> No		Backsplash Behind Fridge <input type="text"/>

Comment

Master ensuite and Main Bath wall tiles - horizontal stacked

See attach
B62-117
June 5, 2020

Purchasers: JASON MICHAEL SHANE & JAINITA VASANTLI Property: 117

Telephone Res. / Bus: (416) 316-8599

Project: Brampton Encore - Phase 2

Decor Advisor: Yolande Somerville

Model and Elevation: 38-1 Elev.B BIZET

4. Plumbing Fixtures

Master Ensuite Bathroom ☐ Second Ensuite ☐ Powder Room ☐
Other Room - Specify ☐ Other Washroom ☐

Comment

Standard thru out except bathroom sinks

5. Hardwood Flooring

	Type and Stain		Type and Stain
Main Hall	*3/4x5" wht oak wirebrush 'atlantis'	Upper Landing	****see note****
Kitchen / Breakfast	*3/4x5" wht oak wirebrush 'atlantis'	Upper Hall	n/a
Living Room	n/a	Master Bedroom	n/a
Dining Room	*3/4x5" wht oak wirebrush 'atlantis'	Bedroom #2	n/a
Family Room	*3/4x5" wht oak wirebrush 'atlantis'	Bedroom #3	n/a
Den/Library	n/a	Bedroom #4	n/a
Entrance Vestibule	n/a	Bedroom #5	n/a
Lower Landing (If Applicable)	n/a	Other Room - Specify	

Comment

Stair landing will be stained on site 3/4x3" red oak smooth to match hardwood stair colour

6. Carpeting

	Upgrade	Description
Ground Floor	<input type="checkbox"/>	
Second Floor	<input type="checkbox"/>	Std 4002-02 with std u/pad

Revised
STD 4002-02 with std u/pad
PV-117
Oct. 23, 2020.

Upgrade Underpad ☐ Type ☐ Area ☐
Capped ☐ Runner - *Upgrade ☐

Comment

7. Fireplace

	Living Room			Family Room			Other Room - Specify		
	Purchased	As Per Plan	N/A	Purchased	As Per Plan	N/A	Purchased	As Per Plan	N/A
Fireplace Type	<input type="radio"/>	<input type="radio"/>	<input checked="" type="radio"/>	<input type="radio"/>	<input checked="" type="radio"/>	<input type="radio"/>	<input type="radio"/>	<input type="radio"/>	<input checked="" type="radio"/>
Mantle Type									
Colour / Stain									
Surround									
Hearth									

Comment

See attach
Bed-117
June 5, 2020

Scheduled Closing Date:

Purchasers: JASON MICHAEL SHANE & JAINITA VASANTL/ Property: 117

Telephone Res. / Bus: (416) 316-8599

Project: Brampton Encore - Phase 2

Decor Advisor: Yolande Somerville

Model and Elevation: 38-1 Elev.B BIZET

8. Trim Carpentry

Interior Doors Front Door Glass Inserts Door Handles

Interior Trim

Comment

9. Plaster Mouldings and Medallions

Standard Throughout ☐ Yes ☐ No ☒ N/A

Entrance Vestibule	<input type="text"/>	<input type="text"/>	Kitchen/Breakfast	<input type="text"/>	<input type="text"/>
Main Hall	<input type="text"/>	<input type="text"/>	Den/Library	<input type="text"/>	<input type="text"/>
Living Room	<input type="text"/>	<input type="text"/>	Lower Landing	<input type="text"/>	<input type="text"/>
Dining Room	<input type="text"/>	<input type="text"/>	Other Room - Specify	<input type="text"/>	<input type="text"/>
Family Room	<input type="text"/>	<input type="text"/>			

Comment

10. Railings and Spindles

Railing Package

Railing Colour

Stringer / Riser

Spindle Colour

Treads

Comment

Oak Stairs ☒ Yes ☐ No ☐ N/A

Stairs will not match hardwood floors in colour, texture or species

11. Wall Paint / Ceilings

Throughout Finished Areas

Trim Paint

Smooth Ceilings

Ground Floor ☒

Second Floor ☒

Note

Comment

See attach.
B&B-117
June 5, 2020

Scheduled Closing Date:

Purchasers: JASON MICHAEL SHANE & JAINITA VASANTL/ Property: 117

Telephone Res. / Bus: (416) 316-8599

Project: Brampton Encore - Phase 2

Decor Advisor: Yolande Somerville

Model and Elevation: 38-1 Elev.B BIZET

12. Electrical

Hood Fan ☐ White ☒ Stainless ☐ N/A

Above Kitchen Cabinet Light ☐ Yes ☒ No

Below Kitchen Cabinet Light ☐ Yes ☒ No

Standard Appliances ☐

Over The Range Microwave ☐

Chimney Style Fan ☒

Comment

13. Heating and Air Conditioning

Air Conditioning

Gas Provisions Stove

Gas Provisions Dryer

Gas Provisions Barbecue

Comment

14. Additional Comments

15. Disclaimers and Notes

- 1) Colours of all materials are as close as possible to builder's selection, but not necessarily identical due to variances in manufacturing.
- 2) Any extras listed above are null and void unless accompanied by a separate invoice/amendment. Said invoice must be paid in full.
- 3) The Purchaser acknowledges that after Interior Colour Selection form is signed and dated, no further changes will be permitted other than re-selection due to unavailability. _____ Purchaser's Initials
- 4) The Purchaser acknowledges reading and accepting the "Gold Park Homes Decor Centre Disclaimers" form. This document contains other miscellaneous disclaimers.



This Interior Colour Selection is final and approved by:

Signature: See attach. Date: BE2-117 June 5, 2020

2-117
APRIL 8 2020
JUNE 5 2020
See attached
See attached
See attached

The Bizet 38' SERIES

Elevation A • 2,234 sq.ft. | Elevation B • 2,222 sq.ft.

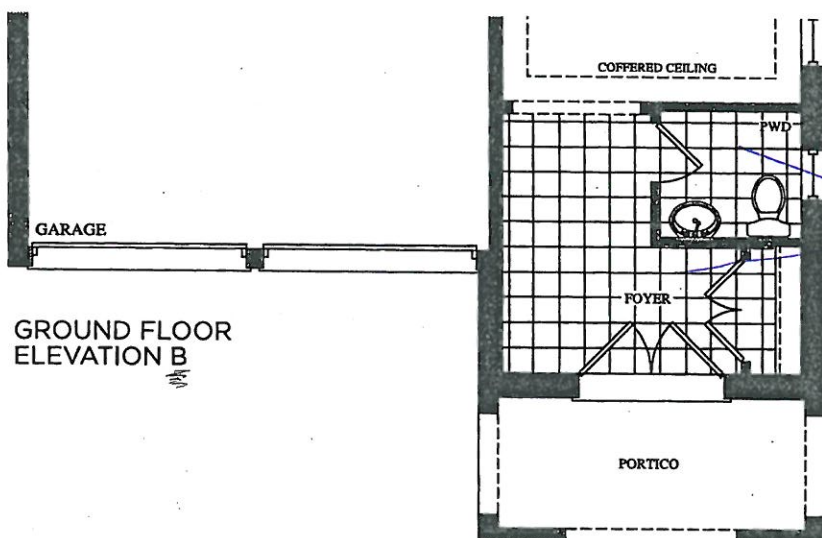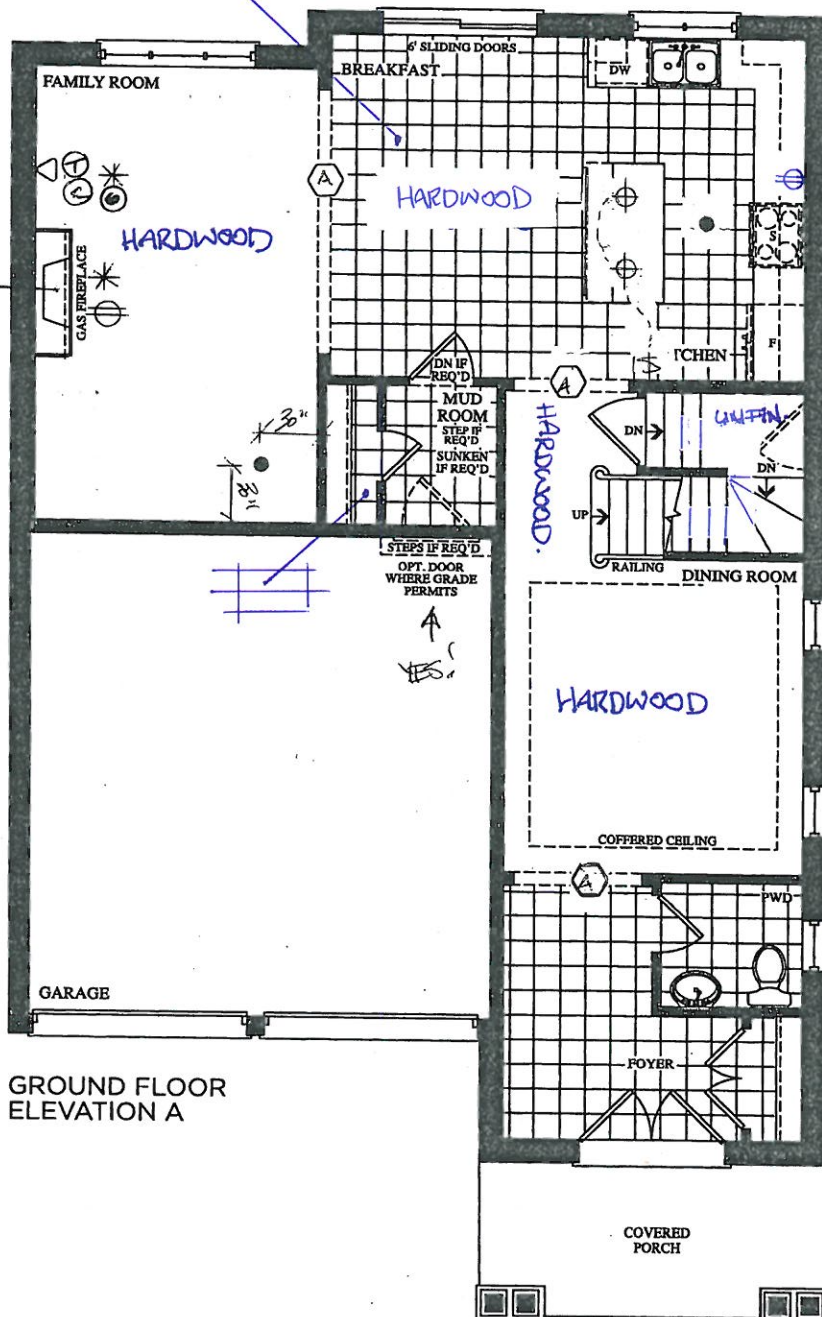

- LEGEND**
- ⊙ CAT 6
 - BRIGHT
 - ⊕ COFFERED CEILING R/W
 - ⊕ ELECT REC.
 - ⊕ SCONCE
 - ⊕ SWITCH
 - * 2" CONDUIT

BE2-117
APRIL 8 2020

See attached
See attached
JUNE 5 2020


See attached

The Bizet

38' SERIES


Elevation A • 2,234 sq.ft. | Elevation B • 2,222 sq.ft.

SMOOTH CEILING!

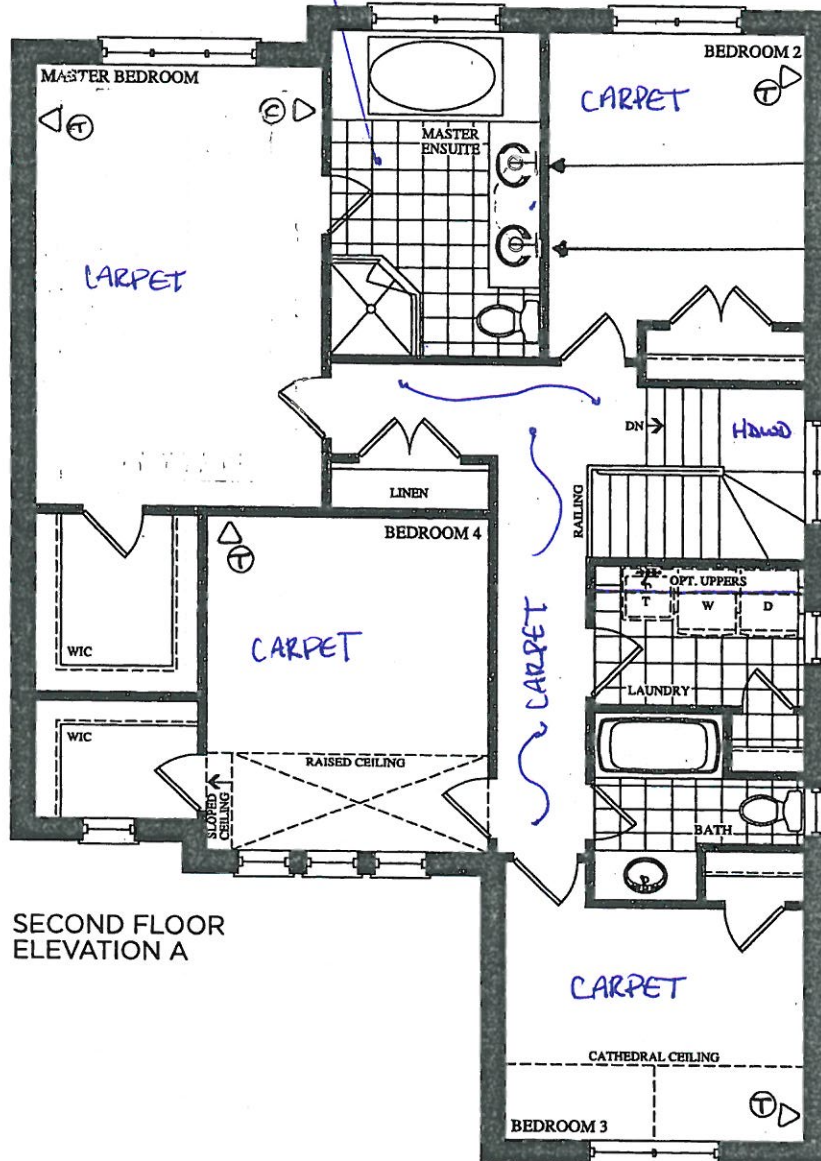

ADD CARPETED ESCAPE

SO LIGHT

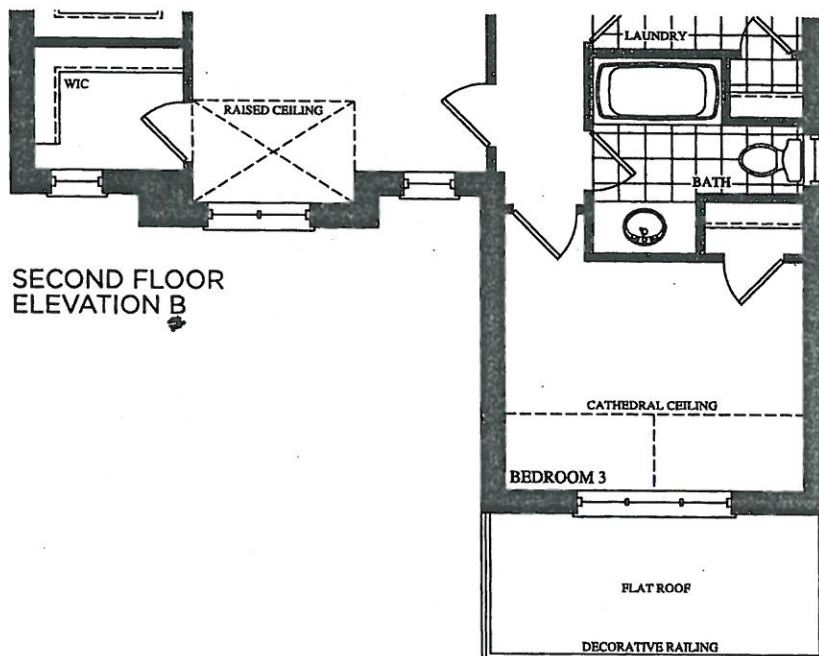


DE2-117
APRIL 8 2020
JUNE 5 2020
see attached
see attached
see attached

The Bizet
38' SERIES

Elevation A • 2,234 sq.ft. | Elevation B • 2,222 sq.ft.

LOB.

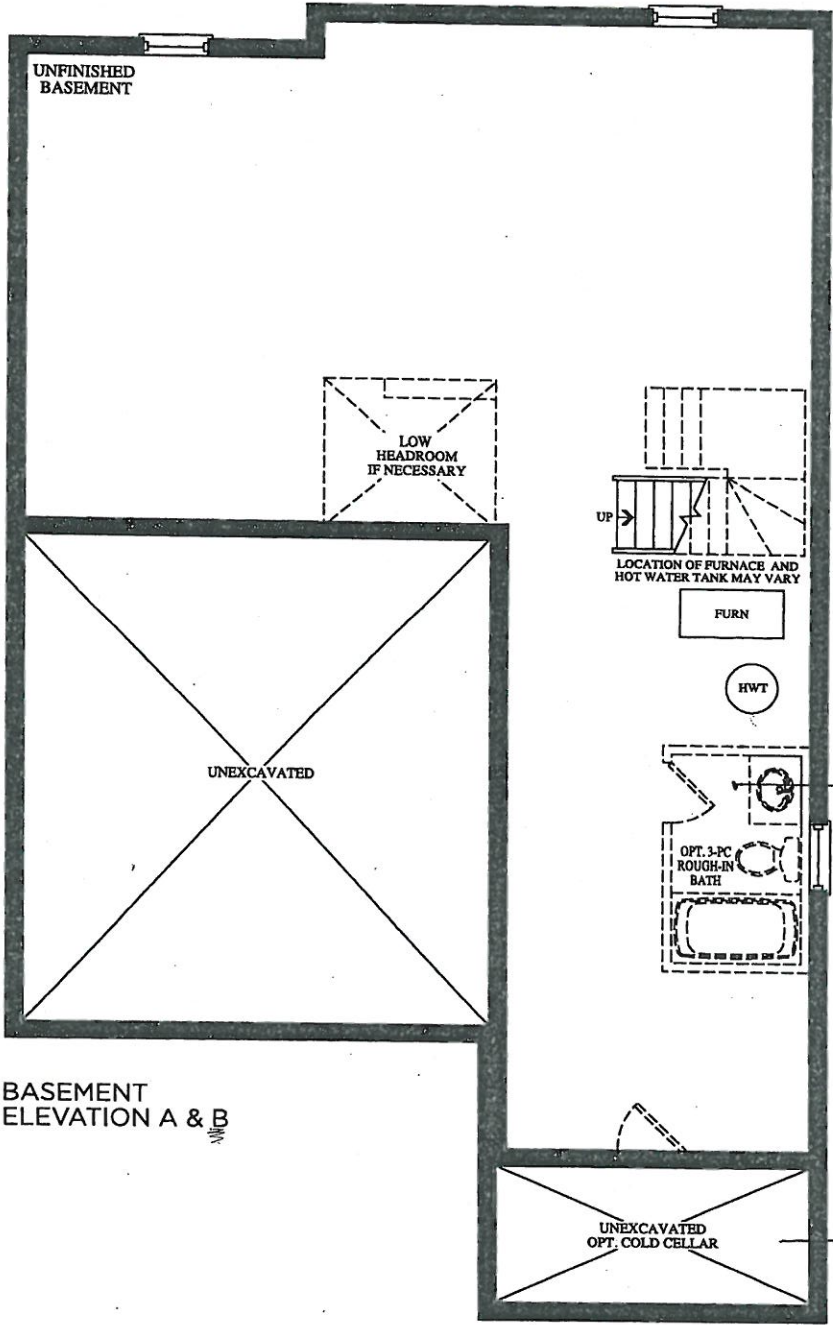

BASEMENT
ELEVATION A & B

YES!
16x30"

No!

Prices, figures, illustrations, sizes, features and finishes are subject to change without notice. E.&O.E. Areas and dimensions are approximate and actual usable floor space may vary from the stated area. Layout may be reverse of the unit purchased. E. & O.E.

CORTINA

KITCHENS INC.
70 Regina Road, Woodbridge, Ontario L4L 8L8
Tel: 905-264-6464 Fax: 905-264-0664
www.CortinaKitchens.com

BE2-117

JUNE 5 2020

See
attach.

QUOTATION

Date: 06/23/16

Trade Name: Gold Park Homes

Site location: Brampton


Model: 38-1

Address:

Project: Encore

Phase:

This layout has been explained to the purchaser by Cortina Kitchens Inc. and is understood by the purchaser.

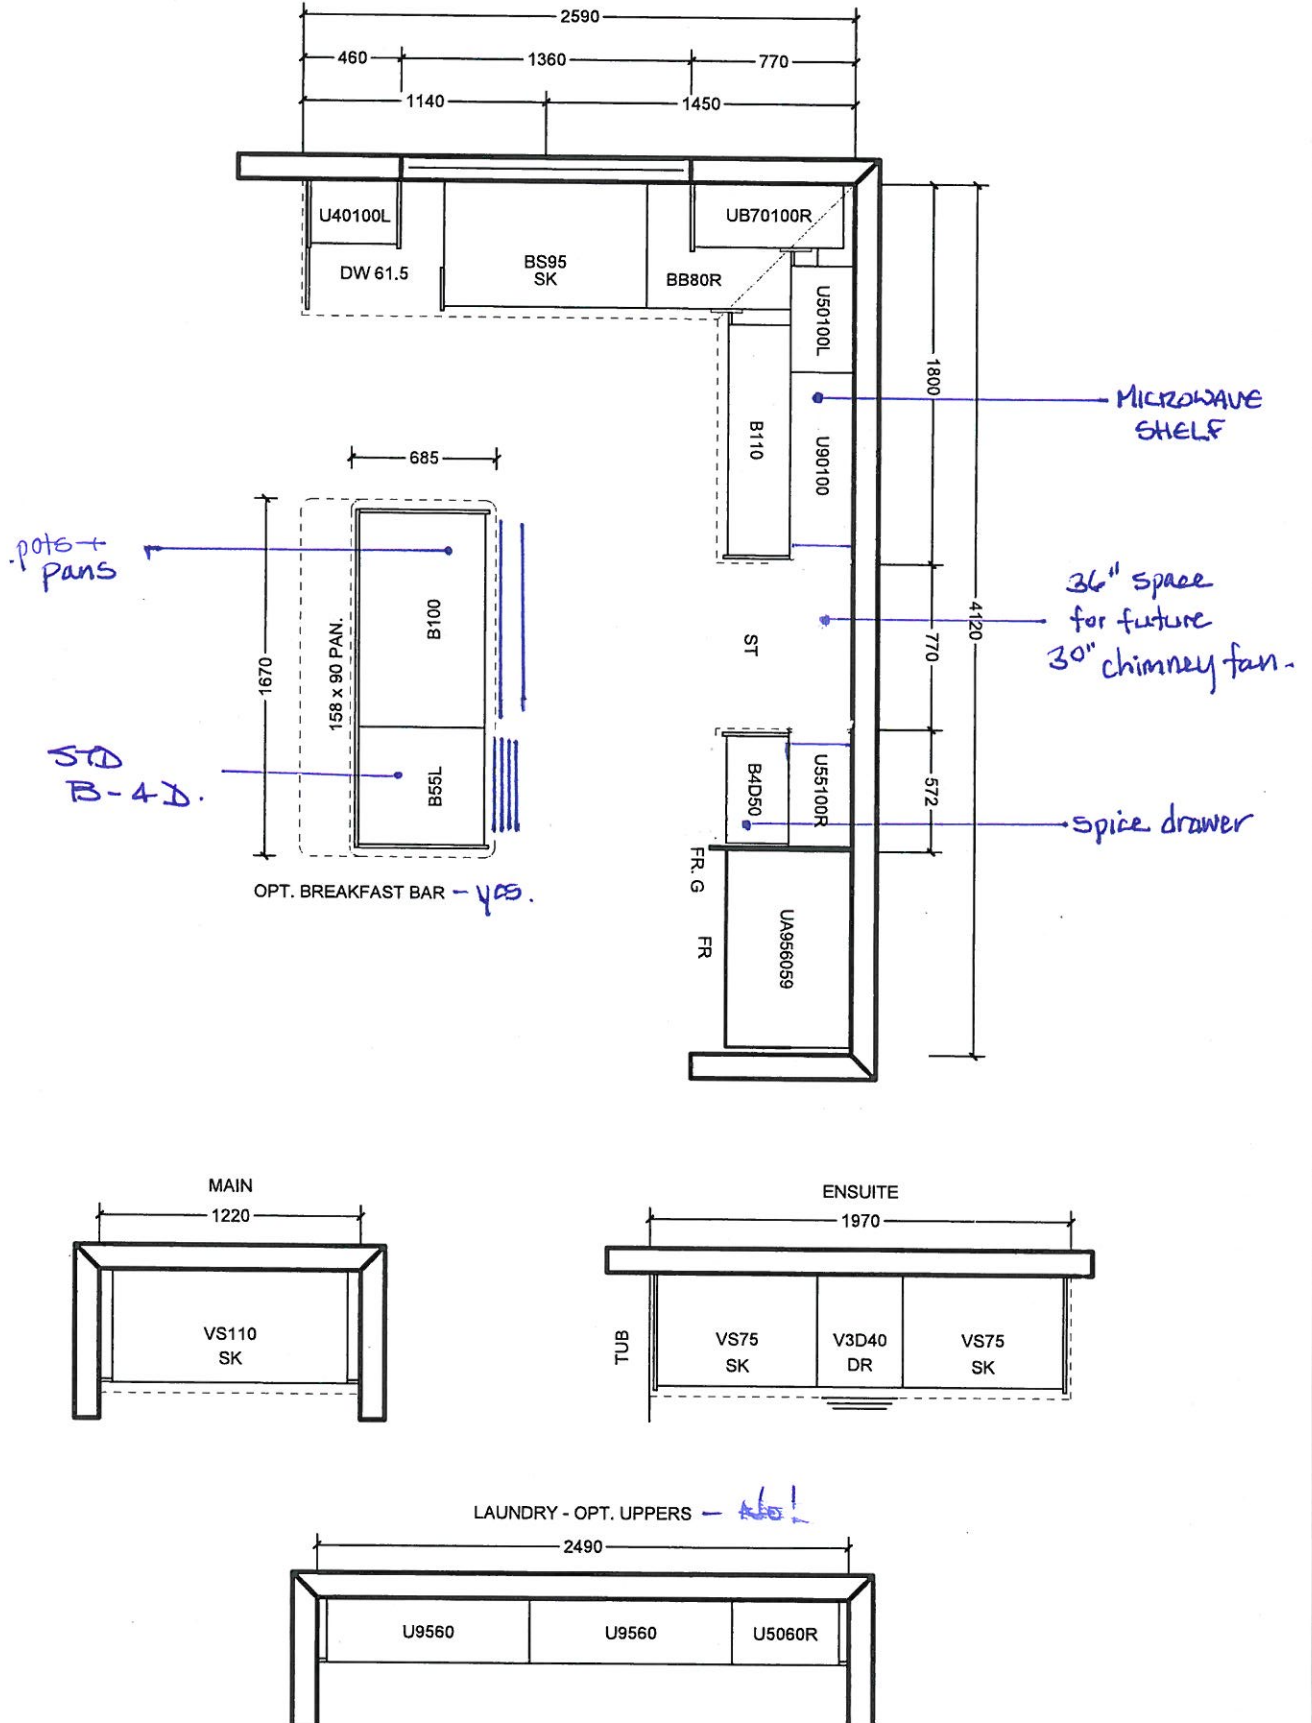

All prices subject to confirmation from head office.
This quotation is subject to the terms & conditions set out
in Cortina's Agreement of Purchase and Sale

All agreements are contingent upon strikes, accidents, and delay beyond our control.
Please provide our installer with template for sinkholes or \$150.00 will be charged for callback.

ACCEPTED DATE: _____

CUSTOMER SIGNATURE

SALESPERSON SIGNATURE

CORTINA HEAD OFFICE APPROVAL

ITEM A. Wood grain and colour are characteristics of the product, we cannot guarantee that such grain and colour will always match
ITEM B. Cortina Kitchens reserves the right to alter dimensions and make technical changes without notice.

GOLDPARK
HOMES



**Granite, Marble,
Engineered Surfaces**


- Standard 2CM & 3CM
- ◐ Upgrade 1 2CM & 3CM
- ◑ Upgrade 1 4 CM
- Upgrade 2

KITCHEN
+
MASTER
+
MAIN


20mm (3/4") Profiles



30mm (1 1/4") Profiles

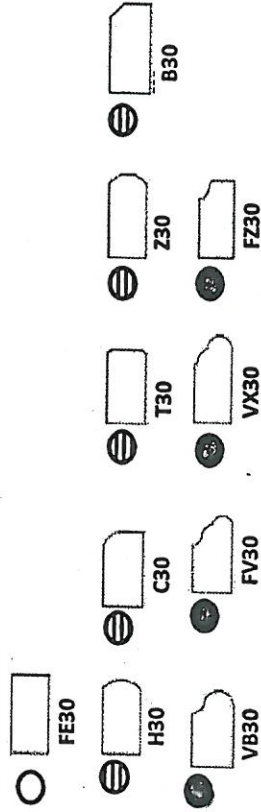

40mm (1 1/2") Profiles

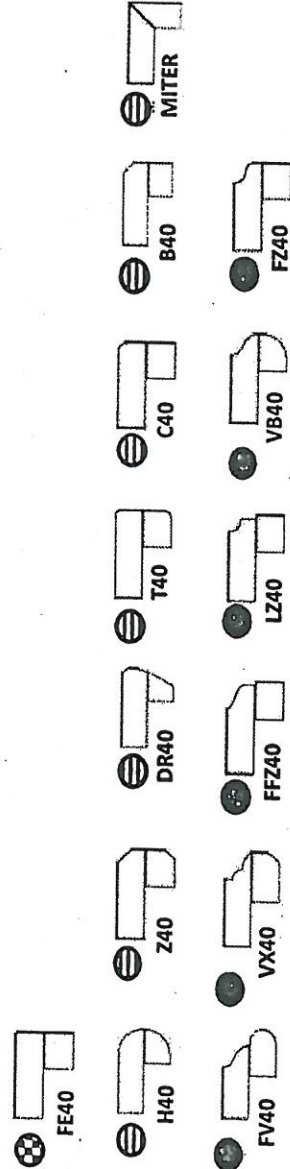

Note: All colours may not be available in 30mm at time ordered. Vendor reserves the right to use 40 mm edges (by lamination process).


*Mitre edge is available in Upgrade 1 for an overall thickness of 2". All other Mitre edge options will be an Upgrade 2 Edge.

RED-117
JUNE 5 2020
see
attach.

BE2-117

June 5 2020

See attach.

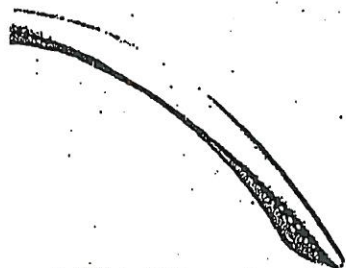


CH-32




CH-38




CH-44

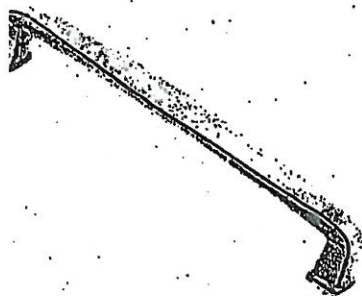


CH-45

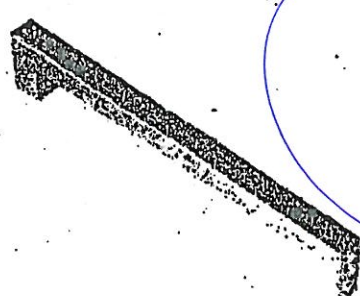

CH-46

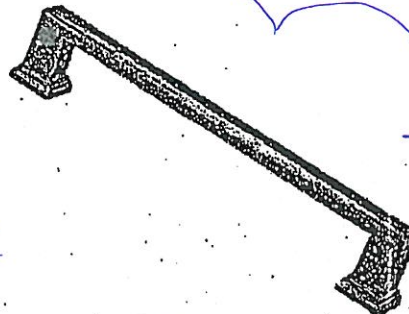


CH-47

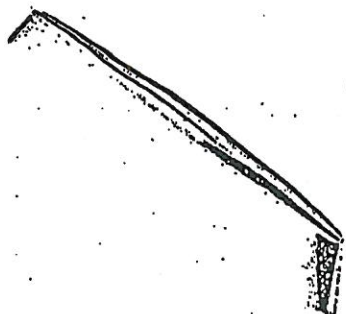


CH-48




CH-49

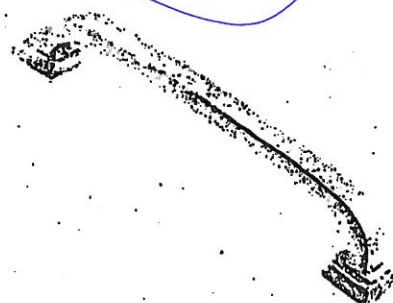


CH-50

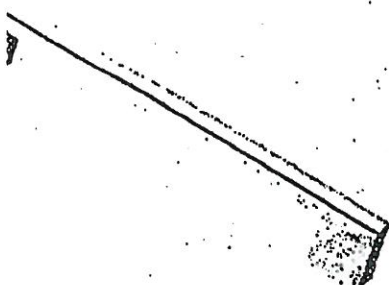

CH-51

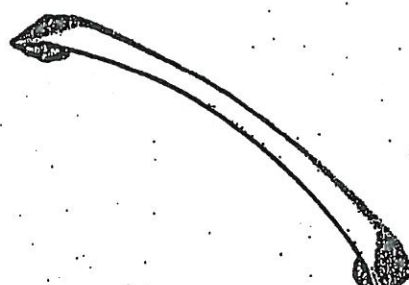

CH-52

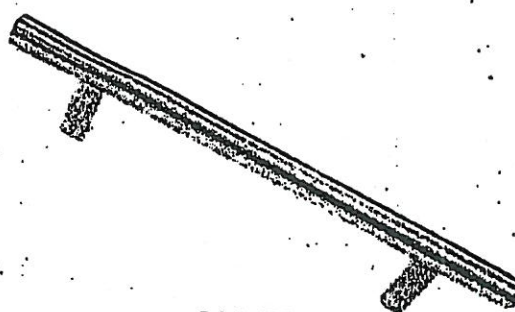

CH-53

NOTES:
IMAGES ARE FOR QUICK REFERENCE PURPOSES ONLY
ACTUAL SIZES AND FINISHES AS PER HARDWARE
SAMPLE BOARD PROVIDED TO DECOR CENTRE

ARTINA

STANDARD HARDWARE

BE2-117
JUNE 5 2026

MODIFIED: 19/05/18 K

STANDARD HARDWARE




CSI-6




CSI-10




CSI-14

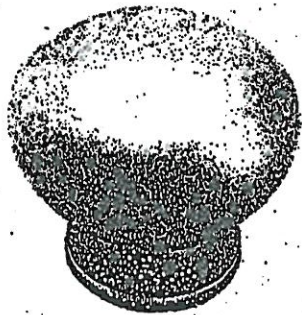

CSI-16

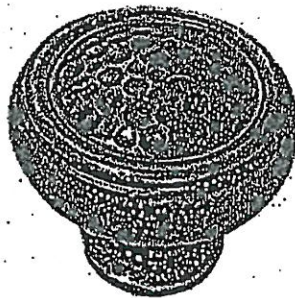

CSI-18

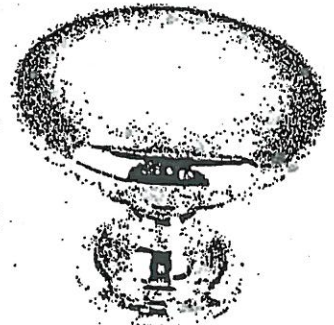

CSI-19




CSI-20




CSI-21




CSI-22

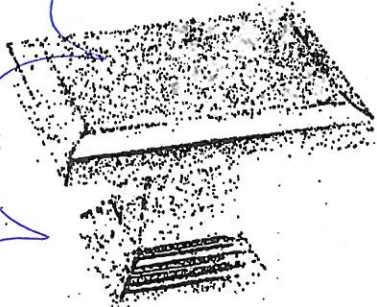

CSI-23

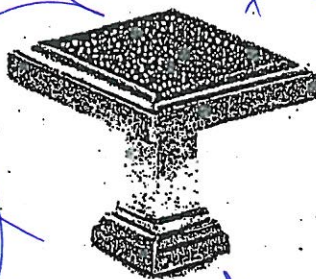

CSI-24

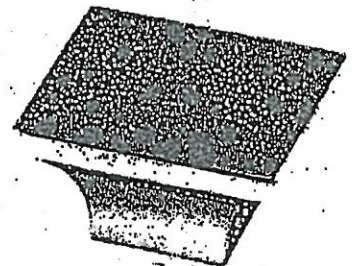

CSI-25

1. Master Ensuite

1. Main Bath

*NOTES:

- IMAGES ARE FOR QUICK REFERENCE PURPOSES ONLY
- ACTUAL SIZES AND FINISHES AS PER HARDWARE SAMPLE BOARD PROVIDED TO DECOR CENTRE

see attach



BATHROOM ACCESSORIES

PROJECT: ENCORE 2


LOT: 117


INSTALL STANDARD BATHROOM ACCESSORIES
THRU OUT (TOWEL BAR, SOAP DISH, TISSUE
HOLDER) **location as per vendors discretion

☐

DO *NOT* INSTALL STANDARD BATHROOM
ACCESSORIES THRU OUT (TOWEL BAR, SOAP
DISH, TISSUE HOLDER)

☒

SIGNATURE:  *see attach.*

SIGNATURE: 

DATE: JUNE 5 2020



Project: Encore 2

Lot: 617

Purchaser(s): JASON SHADE & JANITA VARANJAL-MISTRY

Standard Hood Fan Deletion

We acknowledge that the builder's standard hood fan will not be installed.
Do not supply, install and/or credit. We will install our own hood fan after closing.

Signature: See attach.

Signature:

Date: JUNE 5 2020