



CONSTRUCTION SUMMARY

Lot: 29  
Model: 42.02 C ROSEDALE  
Project/Phase: Pine Valley Forevergreen / 1

BASEMENT WINDOWS

Invoice	Qty.	Description
2668 72,351 13Apr21	2	BASEMENT WINDOWS - UPGRADE BASEMENT WINDOW SIZE TO 30 " X 24" - 8" FRAME

CONCRETE AND DRAIN

Invoice	Qty.	Description
2668 101,930 13Apr21	1	BACK FLOW PREVENTER VALVE

DRYWALL

Invoice	Qty.	Description
2668 72,351 13Apr21 **	2	BASEMENT WINDOWS - UPGRADE BASEMENT WINDOW SIZE TO 30 " X 24" - 8" FRAME
2668  13Apr21 NoCat	1	MASTER BEDROOM: MODEL OPTIONS 42.02.C - OPT. 10 FOOT TRAY CEILING AS PER PLAN

ELECTRICAL

Invoice	Qty.	Description
2668 72,351 13Apr21 **	2	BASEMENT WINDOWS - UPGRADE BASEMENT WINDOW SIZE TO 30 " X 24" - 8" FRAME

FORM - FORMING

Invoice	Qty.	Description
2668 72,351 13Apr21 **	2	BASEMENT WINDOWS - UPGRADE BASEMENT WINDOW SIZE TO 30 " X 24" - 8" FRAME



CONSTRUCTION SUMMARY

Lot: 29  
Model: 42.02 C ROSEDALE  
Project/Phase: Pine Valley Forevergreen / 1

FORMING

Invoice	Qty.	Description
2704 72,207 13Apr21	1	PINE VALLEY MODEL 42.02 ROSEDALE ELEV C - 9 FOOT BASEMENT CEILING HEIGHT IN LIEU OF STANDARD 8 FOOT CEILING.  TO BE AMENDED TO PURCHASE PRICE - NO DEPOSIT RECEIVED
2704  13Apr21 ** NoCat	1	PINE VALLEY MODEL 42.02 ROSEDALE ELEV C - 9 FOOT BASEMENT CEILING HEIGHT IN LIEU OF STANDARD 8 FOOT CEILING.  TO BE AMENDED TO PURCHASE PRICE - NO DEPOSIT RECEIVED
2704  13Apr21 ** NoCat	1	PINE VALLEY MODEL 42.02 ROSEDALE ELEV C - 9 FOOT BASEMENT CEILING HEIGHT IN LIEU OF STANDARD 8 FOOT CEILING.  TO BE AMENDED TO PURCHASE PRICE - NO DEPOSIT RECEIVED
2668 72,463 13Apr21	1	MODEL OPTIONS 42.02 - BREAKFAST ROOM - OPT. COVERED LOGGIA AS PER PLAN  INCLUDED IN APS
2668  13Apr21 ** NoCat	1	MODEL OPTIONS 42.02 - BREAKFAST ROOM - OPT. COVERED LOGGIA AS PER PLAN
2668  13Apr21 ** NoCat	1	MODEL OPTIONS 42.02 - BREAKFAST ROOM - OPT. COVERED LOGGIA AS PER PLAN
CONSTRUCTION SUMMARY

Lot: 29  
Model: 42.02 C ROSEDALE  
Project/Phase: Pine Valley Forevergreen / 1

FORMING

Invoice	Qty.	Description
2668	1	MODEL OPTIONS 42.02 - BREAKFAST ROOM - OPT. COVERED LOGGIA AS PER PLAN
13Apr21 ** NoCat		

FRAMING

Invoice	Qty.	Description
2668 72,492 13Apr21	1	MASTER BEDROOM: MODEL OPTIONS 42.02.C - OPT. 10 FOOT TRAY CEILING AS PER PLAN

INTERIOR TRIM /MOULDINGS

Invoice	Qty.	Description
2668 72,351 13Apr21 **	2	BASEMENT WINDOWS - UPGRADE BASEMENT WINDOW SIZE TO 30 " X 24" - 8" FRAME

PAINT

Invoice	Qty.	Description
2668 13Apr21 NoCat	1	MASTER BEDROOM: MODEL OPTIONS 42.02.C - OPT. 10 FOOT TRAY CEILING AS PER PLAN

PAINTING

Invoice	Qty.	Description
2668 72,351 13Apr21 **	2	BASEMENT WINDOWS - UPGRADE BASEMENT WINDOW SIZE TO 30 " X 24" - 8" FRAME

PANL - FRAMING

Invoice	Qty.	Description
2668 72,351 13Apr21 **	2	BASEMENT WINDOWS - UPGRADE BASEMENT WINDOW SIZE TO 30 " X 24" - 8" FRAME

ROUGH CARPENTRY

Invoice	Qty.	Description
2668 72,351 13Apr21 **	2	BASEMENT WINDOWS - UPGRADE BASEMENT WINDOW SIZE TO 30 " X 24" - 8" FRAME

WINDOWS - BASEMENT

Invoice	Qty.	Description
2668 72,351 13Apr21 **	2	BASEMENT WINDOWS - UPGRADE BASEMENT WINDOW SIZE TO 30 " X 24" - 8" FRAME



SCHEDULE 'F'

PV-29 see attached  
April 12 2022


# The Rosedale

## 42' SERIES

Elevation A • 3,655 sq.ft.

Elevation B • 3,605 sq.ft.

→ Elevation C • 3,590 sq.ft.

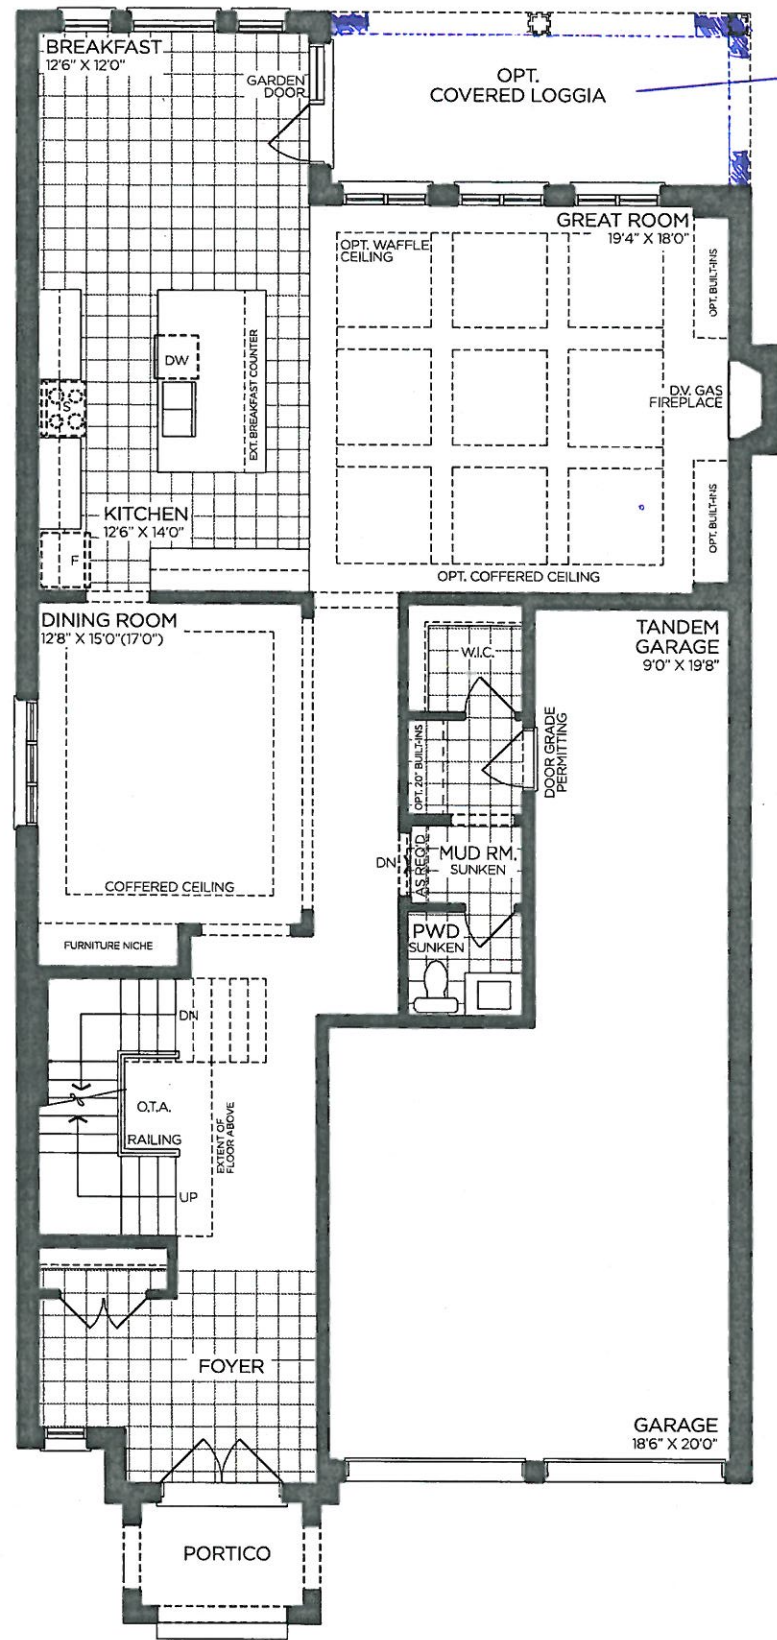

GROUND FLOOR | ELEV. A

VENDOR	<input type="text"/>
PURCHASER	<input type="text"/>
PURCHASER	<input type="text"/>

# GOLDPARK

WORTH MORE™

Prices, figures, illustrations, sizes, features and finishes are subject to change without notice. Areas and dimensions are approximate and actual usable floor space may vary from the stated area. Layout may be reverse of the unit purchased. E. & O.E. 4202




SCHEDULE 'F'

PV-29 *see attached*  
APRIL 12 2021

# The Rosedale

## 42' SERIES

Elevation A • 3,655 sq.ft.  
Elevation B • 3,605 sq.ft.  
Elevation C • 3,590 sq.ft.

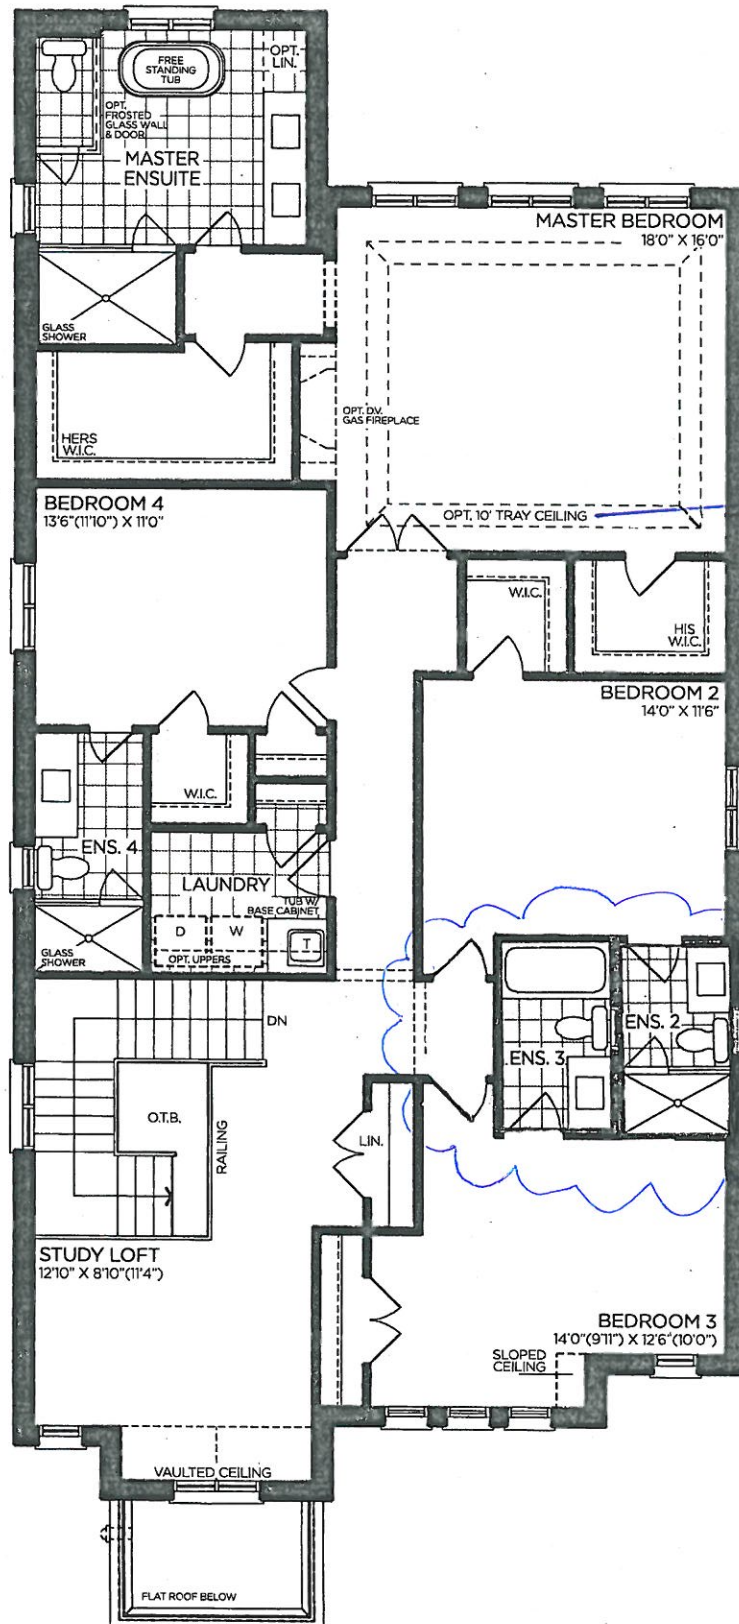

SECOND FLOOR | ELEV. A

TRAY  
YES!

SWITCH ENSUITE 2  
AND ENSUITE 3  
THIS IS THE REVERSED  
LAYOUT

VENDOR

PURCHASER

PURCHASER

# GOLDPARK

WORTH MORE™

Prices, figures, illustrations, sizes, features and finishes are subject to change without notice. Areas and dimensions are approximate and actual usable floor space may vary from the stated area. Layout may be reverse of the unit purchased. E. & O.E. 4202





SCHEDULE 'F'

PV-29 see attached  
April 12 2021


# The Rosedale

## 42' SERIES

Elevation A • 3,655 sq.ft.

Elevation B • 3,605 sq.ft.

→ Elevation C • 3,590 sq.ft.

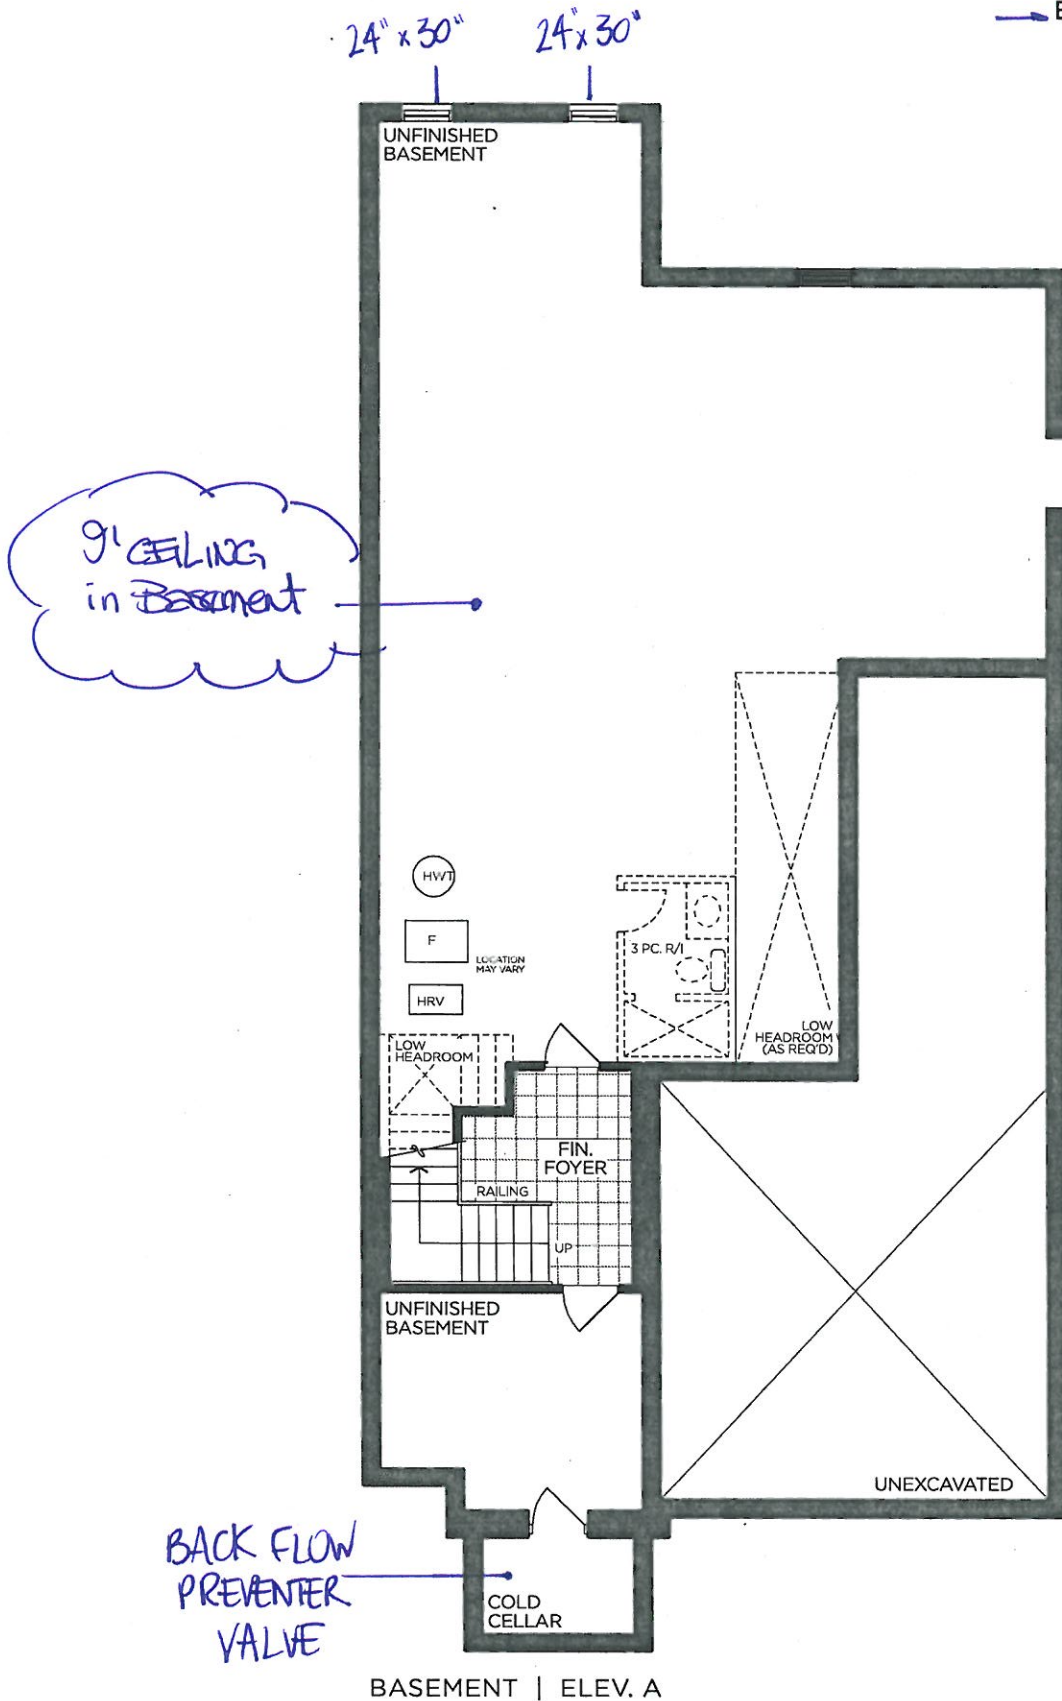

VENDOR   
PURCHASER   
PURCHASER

**GOLDPARK**  
WORTH MORE™

Prices, figures, illustrations, sizes, features and finishes are subject to change without notice. Areas and dimensions are approximate and actual usable floor space may vary from the stated area. Layout may be reverse of the unit purchased. E. & O.E. 4202




SCHEDULE 'F'  
PV-29 *see attached*  
April 12 2021

# The Rosedale 42' SERIES


Elevation A • 3,655 sq.ft.

Elevation B • 3,605 sq.ft.


→ Elevation C • 3,590 sq.ft.

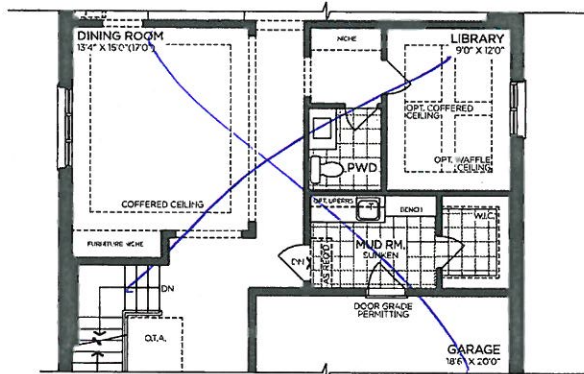


OPT. PART. GROUND FLOOR (LIBRARY)

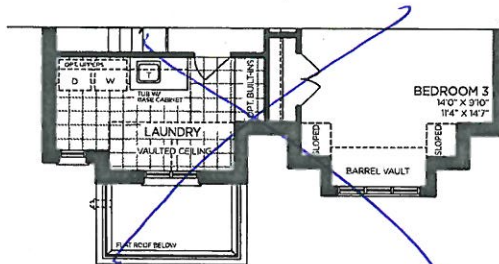


PART. OPT. SECOND FLOOR | ELEV. B  
5 BEDROOM

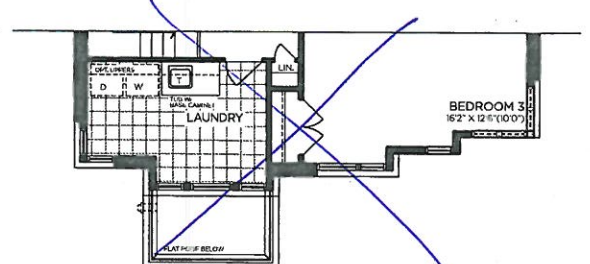


PART. OPT. SECOND FLOOR | ELEV. C  
5 BEDROOM

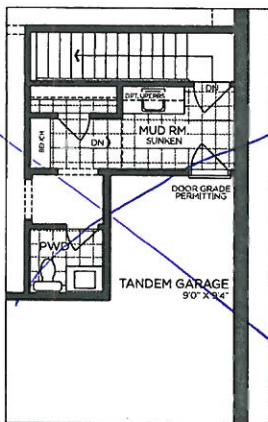


OPT. PART. SERVICE STAIRS

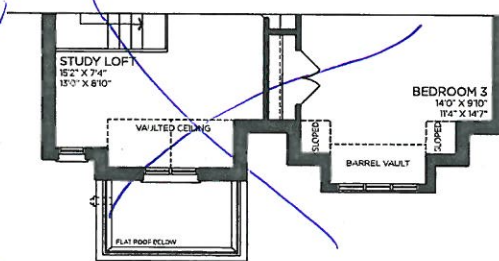


PART. SECOND FLOOR | ELEV. B

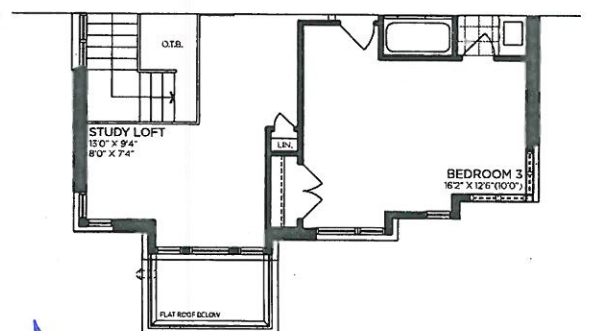


→ PART. SECOND FLOOR | ELEV. C

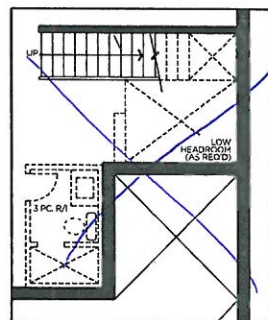


OPT. PART. SERVICE STAIRS

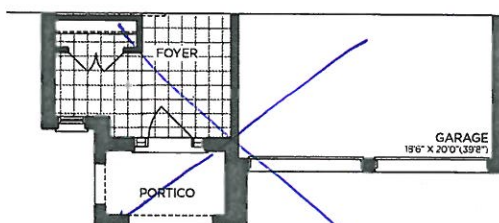


PART. GROUND FLOOR | ELEV. B

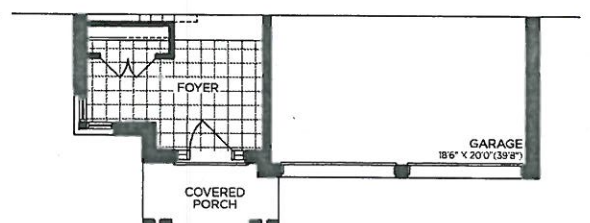

→ PART. GROUND FLOOR | ELEV. C

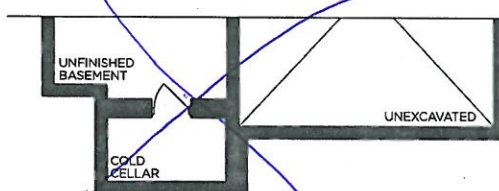

PART. BASEMENT | ELEV. B

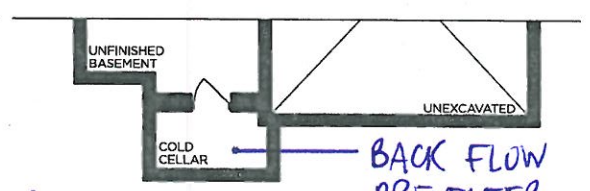

→ PART. BASEMENT | ELEV. C  
*BACK FLOW PREVENTER VALVE*

VENDOR

PURCHASER

PURCHASER

**GOLDPARK**  
WORTH MORE™

Prices, figures, illustrations, sizes, features and finishes are subject to change without notice. Areas and dimensions are approximate and actual usable floor space may vary from the stated area. Layout may be reverse of the unit purchased. E. & O.E. 4202



SCHEDULE 'F'

PV-29 NW NA

APRIL 12 2022


# The Rosedale

## 42' SERIES

Elevation A • 3,655 sq.ft.

Elevation B • 3,605 sq.ft.

—Elevation C • 3,590 sq.ft.

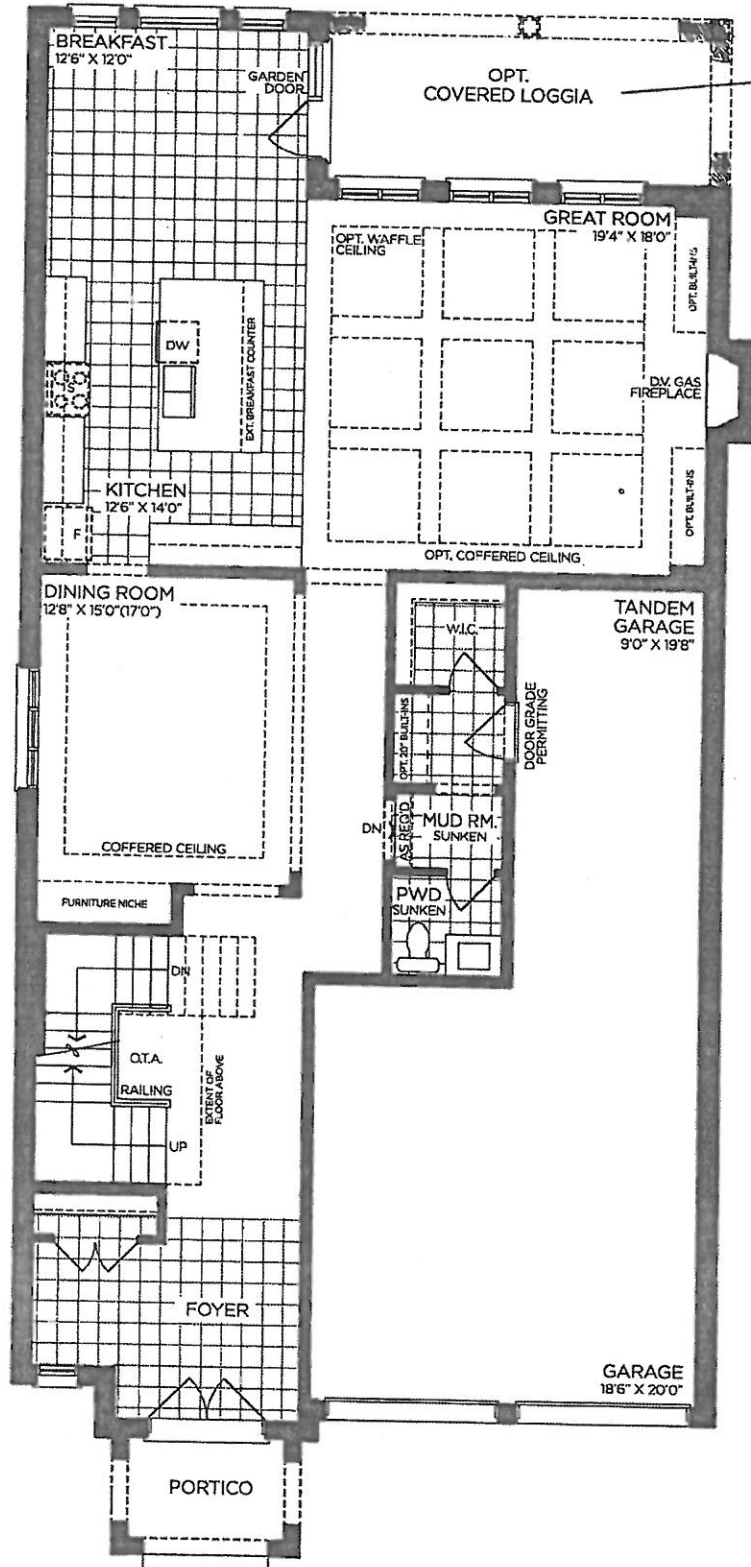

GROUND FLOOR | ELEV. A

VENDOR   
PURCHASER   
PURCHASER

**GOLDPARK**  
WORTH MORE™

Prices, figures, illustrations, sizes, features and finishes are subject to change without notice. Areas and dimensions are approximate and actual usable floor space may vary from the stated area. Layout may be reverse of the unit purchased. E. & O.E. 4202



Prices, figures, illustrations, sizes, features and finishes are subject to change without notice. Areas and dimensions are approximate and actual usable floor space may vary from the stated area. Layout may be reverse of the unit purchased. E. & O.E. 4202



SCHEDULE 'F'

PV-29    (NW) (NA)  
APRIL 12 2021


# The Rosedale

## 42' SERIES

Elevation A • 3,655 sq.ft.

Elevation B • 3,605 sq.ft.

→ Elevation C • 3,590 sq.ft.

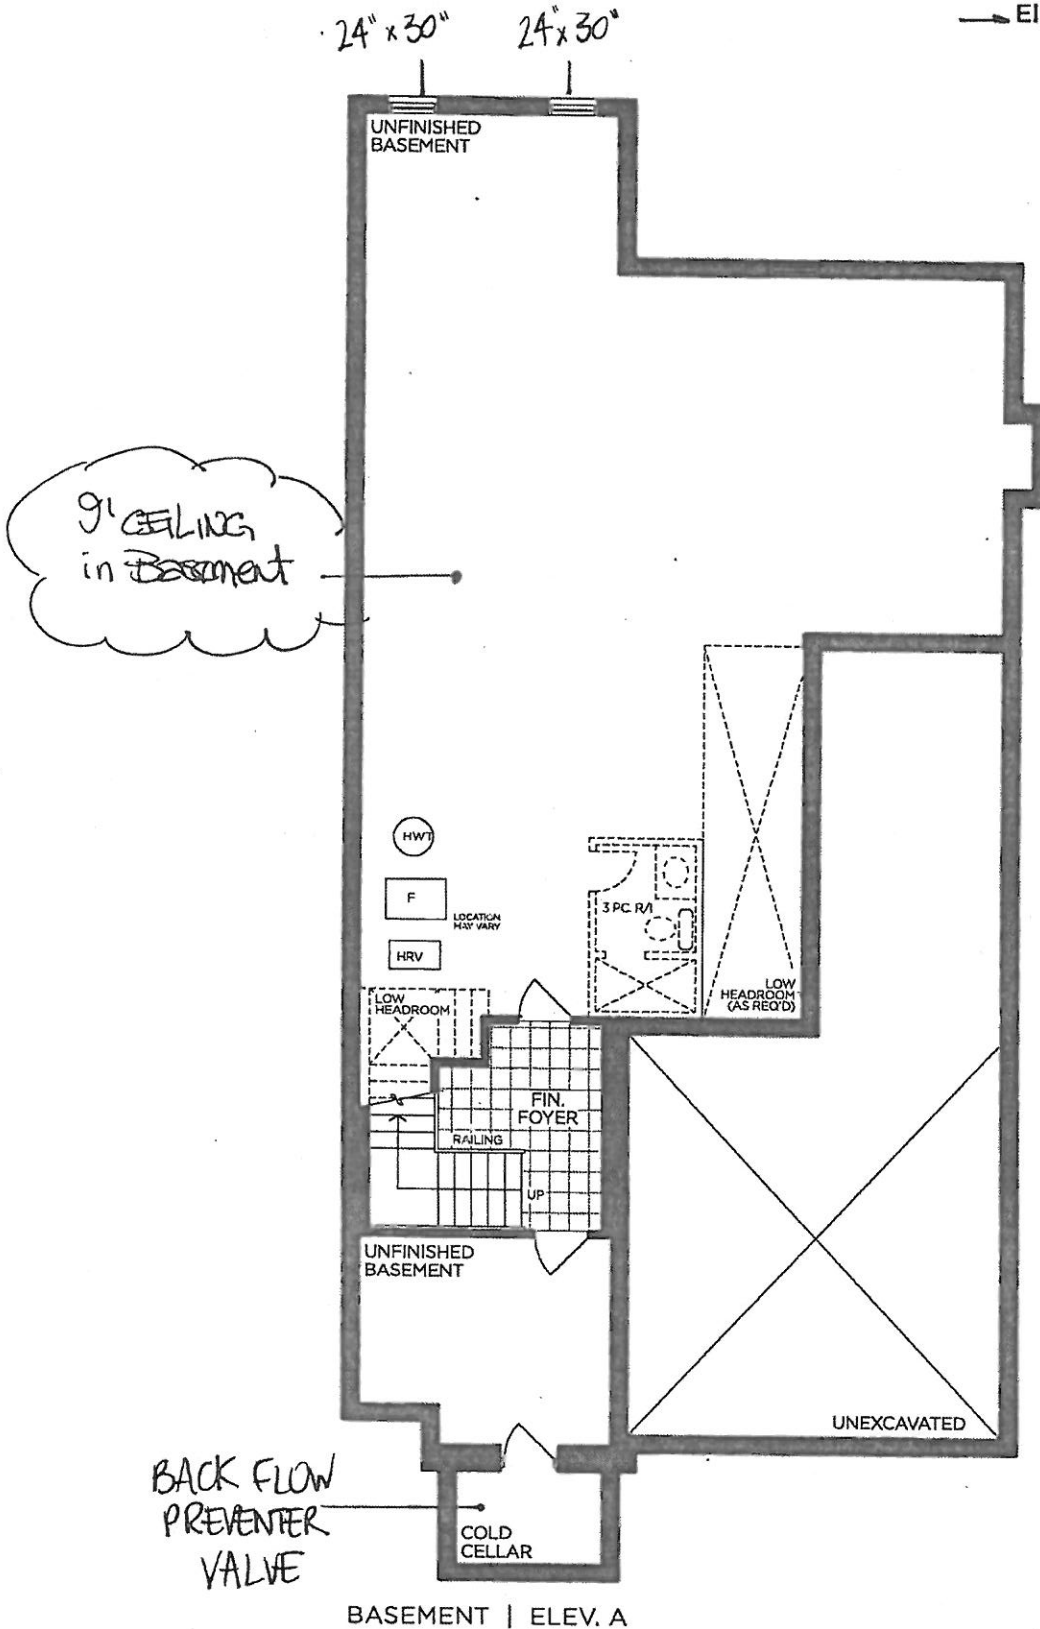

VENDOR

PURCHASER

PURCHASER

# GOLDPARK

WORTH MORE™

Prices, figures, illustrations, sizes, features and finishes are subject to change without notice. Areas and dimensions are approximate and actual usable floor space may vary from the stated area. Layout may be reverse of the unit purchased. E. & O.E. 4202



SCHEDULE 'F'  
PV-29 NW NA  
APRIL 12 2021


# The Rosedale

## 42' SERIES


Elevation A • 3,655 sq.ft.

Elevation B • 3,605 sq.ft.


→ Elevation C • 3,590 sq.ft.

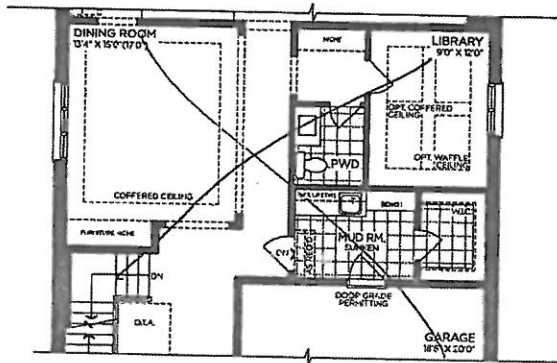


OPT. PART. GROUND FLOOR (LIBRARY)

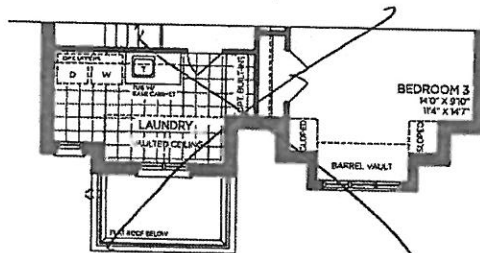


PART. OPT. SECOND FLOOR | ELEV. B  
5 BEDROOM

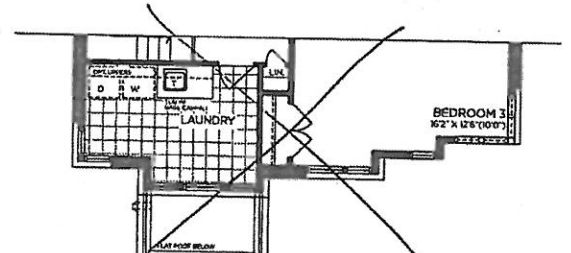


PART. OPT. SECOND FLOOR | ELEV. C  
5 BEDROOM

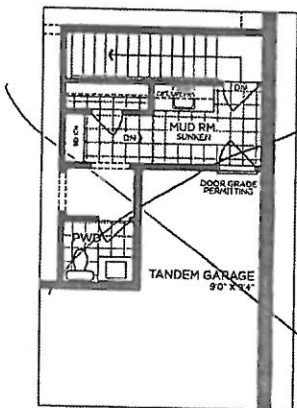


OPT. PART. SERVICE STAIRS

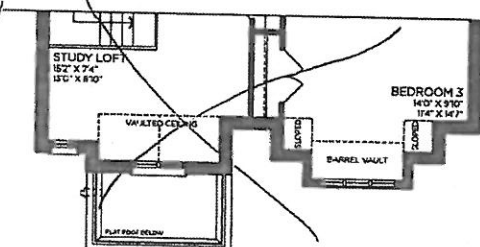


PART. SECOND FLOOR | ELEV. B

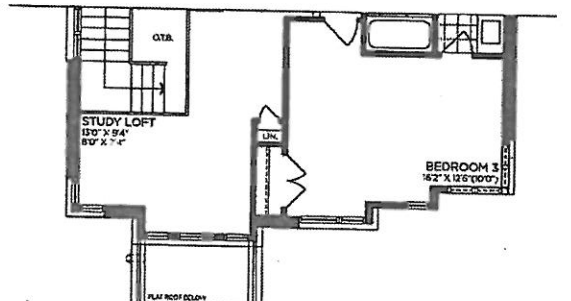


PART. SECOND FLOOR | ELEV. C

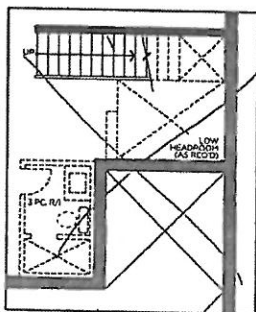


OPT. PART. SERVICE STAIRS

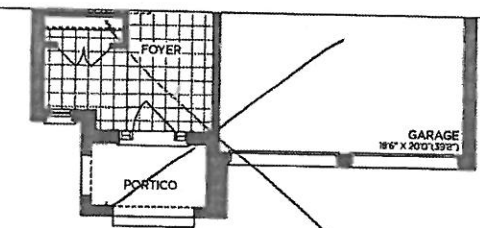


PART. GROUND FLOOR | ELEV. B

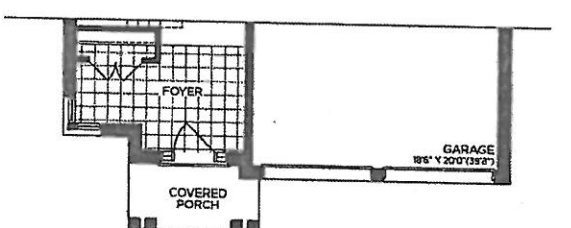

PART. GROUND FLOOR | ELEV. C

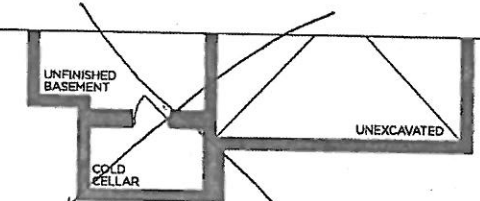

PART. BASEMENT | ELEV. B

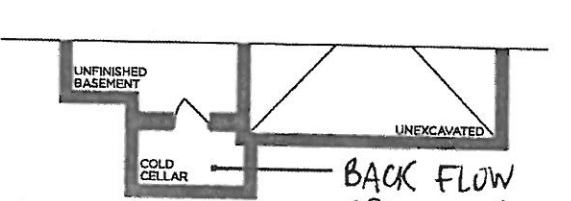

PART. BASEMENT | ELEV. C

BACK FLOW  
PREVENTER  
VALVE

VENDOR   
PURCHASER   
PURCHASER

**GOLDPARK**  
WORTH MORE™

Prices, figures, illustrations, sizes, features and finishes are subject to change without notice. Areas and dimensions are approximate and actual usable floor space may vary from the stated area. Layout may be reverse of the unit purchased. E. & O.E. 4202