



CONSTRUCTION SUMMARY

Lot: 42
Model: 40.02 A VALLEYVIEW
Project/Phase: Pine Valley Forevergreen / 1

BASEMENT WINDOWS

Invoice	Qty.	Description
2620 26Mar21 ** NoCat	4	BASEMENT WINDOWS - UPGRADE BASEMENT WINDOW SIZE TO 30 " X 24" - 8" FRAME

CERAMIC

Invoice	Qty.	Description
2645 29Apr21 NoCat	1	MASTER ENSUITE: SHOWER BENCH COMPLETE WITH STANDARD TILE AND MATCHING MARBLE JAMB COLOUR SEAT TOP
2645 29Apr21 NoCat	1	MASTER ENSUITE: SHOWER NICHE [SHAMPOO SHELF] - COMPLETE WITH MATCHING MARBLE JAMBS ON 4 SIDES, STANDARD TILE, APPROX. 12 X 18 INSTALLED VERTICALLY - SEE PLAN FOR LOCATION

CROWN MOULDING

Invoice	Qty.	Description
2645 72,387 29Apr21	1	GREAT ROOM: MODEL OPTIONS 40.02 - OPT. WAFFLE CEILING, BEAM DETAIL AS PER PLAN (6 BOXES) OPTION # 1 - CTR-B07
2645 29Apr21 NoCat	1	DINING ROOM: INSTALL WAFFLE CEILING - 4 BOXES - SEE PLAN



CONSTRUCTION SUMMARY

Lot: 42
Model: 40.02 A VALLEYVIEW
Project/Phase: Pine Valley Forevergreen / 1

DRYWALL

Invoice	Qty.	Description
2620 26Mar21 NoCat	1	MASTER BEDROOM: OPT. 10 FOOT TRAY CEILING AS PER PLAN
2620 26Mar21 ** NoCat	4	BASEMENT WINDOWS - UPGRADE BASEMENT WINDOW SIZE TO 30 " X 24" - 8" FRAME
2620 26Mar21 NoCat	1	FYI - BASEMENT: 9 FOOT BASEMENT CEILING HEIGHT IN LIEU OF STANDARD 8 FOOT CEILING
2645 72,385 29Apr21	1	GREAT ROOM: MODEL OPTIONS 40.02 - OPT. COFFERED CEILING - AS PER PLAN
2645 72,384 29Apr21	1	DINING ROOM: INSTALL WAFFLE CEILING - 4 BOXES - SEE PLAN
2645 72,690 29Apr21 **	1	DELETE KITCHEN BULKHEAD, IF POSSIBLE, SITE APPROVAL REQUIRED
2645 29Apr21 NoCat	1	KITCHEN/BREAKFAST: INSTALL EXTERIOR 8' FRENCH DOORS IN LIEU OF STANDARD GARDEN DOOR
2645 29Apr21 ** NoCat	1	DELETE KITCHEN BULKHEAD, IF POSSIBLE, SITE APPROVAL REQUIRED
2645 29Apr21 ** NoCat	1	DELETE KITCHEN BULKHEAD, IF POSSIBLE, SITE APPROVAL REQUIRED
2645 29Apr21 ** NoCat	1	DELETE KITCHEN BULKHEAD, IF POSSIBLE, SITE APPROVAL REQUIRED
2645 29Apr21 NoCat	1	THRU OUT 2ND FLOOR: INCREASE HEIGHT OF DOOR TO 8FT SECOND FLOOR - PER DOOR
2645 29Apr21 NoCat	1	MASTER ENSUITE: SHOWER BENCH COMPLETE WITH STANDARD TILE AND MATCHING MARBLE JAMB COLOUR SEAT TOP
2645 29Apr21 NoCat	1	MASTER ENSUITE: SHOWER NICHE [SHAMPOO SHELF] - COMPLETE WITH MATCHING MARBLE JAMBS ON 4 SIDES, STANDARD TILE, APPROX. 12 X 18 INSTALLED VERTICALLY - SEE PLAN FOR LOCATION



CONSTRUCTION SUMMARY

Lot: 42

Model: 40.02 A VALLEYVIEW

Project/Phase: Pine Valley Forevergreen / 1

DRYWALL

Invoice	Qty.	Description
2645 29Apr21 NoCat	1	GARAGE: INCREASED HEIGHT TO MAN DOOR FROM HOUSE TO GARAGE [32 X 94] TALL HEIGHT * WOOD FRAME - IF GRADE PERMITS [EACH]
2645 29Apr21 NoCat	1	GREAT ROOM: UPGRADE MAIN FLOOR LINEAR 1 SIDED FIREPLACE - JADE SERIES 42" LINEAR DIRECT VENT GAS FIREPLACE IN LIEU OF STANDARD



CONSTRUCTION SUMMARY

Lot: 42
Model: 40.02 A VALLEYVIEW
Project/Phase: Pine Valley Forevergreen / 1

ELECTRICAL

Invoice	Qty.	Description
2620 26Mar21 ** NoCat	4	BASEMENT WINDOWS - UPGRADE BASEMENT WINDOW SIZE TO 30 " X 24" - 8" FRAME
2620 26Mar21 NoCat	1	FYI - BASEMENT: 9 FOOT BASEMENT CEILING HEIGHT IN LIEU OF STANDARD 8 FOOT CEILING
2645 72,289 29Apr21	4	FOYER: 4" E/S LED INTERIOR POT LIGHT - GROUND FLOOR - EACH
2645 72,289 29Apr21	1	FOYER: ADDITIONAL INTERIOR SWITCH FOR POT LIGHTS
2645 72,289 29Apr21	2	POWDER ROOM: 4" E/S LED INTERIOR POT LIGHT - GROUND FLOOR - EACH
2645 72,278 29Apr21	1	POWDER ROOM: ADDITIONAL INTERIOR SWITCH FOR POT LIGHTS
2645 72,289 29Apr21	4	MAIN HALL: 4" E/S LED INTERIOR POT LIGHT - GROUND FLOOR - EACH - ON EXISTING SWITCH DELETE STANDARD CEILING LIGHT FIXTURE
2645 72,289 29Apr21	3	LAUNDRY ROOM: 4" E/S LED INTERIOR POT LIGHT - GROUND FLOOR - EACH - ON EXISTING SWITCH DELETE STANDARD CEILING LIGHT FIXTURE
2645 72,289 29Apr21	4	DINING ROOM: 4" E/S LED INTERIOR POT LIGHT - GROUND FLOOR - EACH
2645 72,278 29Apr21	1	DINING ROOM: ADDITIONAL INTERIOR SWITCH FOR POT LIGHTS
2645 72,289 29Apr21	6	GREAT ROOM: 4" E/S LED INTERIOR POT LIGHT - GROUND FLOOR - EACH - ON EXISTING SWITCH DELETE STANDARD CEILING LIGHT FIXTURE
2645 72,289 29Apr21	4	BREAKFAST: 4" E/S LED INTERIOR POT LIGHT - GROUND FLOOR - EACH
2645 72,278 29Apr21	1	BREAKFAST: ADDITIONAL INTERIOR SWITCH FOR POT LIGHTS



CONSTRUCTION SUMMARY

Lot: 42
Model: 40.02 A VALLEYVIEW
Project/Phase: Pine Valley Forevergreen / 1

ELECTRICAL

Invoice	Qty.	Description
2645 72,289 29Apr21	6	KITCHEN: 4" E/S LED INTERIOR POT LIGHT - GROUND FLOOR - EACH - INCLUDES ONE SWITCH INCLUDED IN APS
2645 72,289 29Apr21	2	KITCHEN: 4" E/S LED INTERIOR POT LIGHT - GROUND FLOOR - EACH - ON EXISTING SWITCH
2645 72,290 29Apr21	4	MASTER BEDROOM: 4" E/S LED INTERIOR POT LIGHT (INSULATED CEILING) - SECOND FLOOR - EACH
2645 72,278 29Apr21	1	MASTER BEDROOM: ADDITIONAL INTERIOR SWITCH FOR POT LIGHTS
2645 72,290 29Apr21	4	MASTER ENSUITE: 4" E/S LED INTERIOR POT LIGHT (INSULATED CEILING) - SECOND FLOOR - EACH - ON EXISTING SWITCH DELETE STANDARD CEILING LIGHT FIXTURE
2645 72,279 29Apr21	1	MASTER ENSUITE: SHOWER POT LIGHT: 6" RECESSED SHOWER POT LIGHT ON EXISTING SWITCH
2645 72,307 29Apr21	1	MASTER ENSUITE: RELOCATE STANDARD SHOWER POT LIGHT AS PER PLAN
2645 72,290 29Apr21	4	MASTER BEDROOM WIC: 4" E/S LED INTERIOR POT LIGHT (INSULATED CEILING) - SECOND FLOOR - EACH - ON EXISTING SWITCH DELETE STANDARD CEILING LIGHT FIXTURE
2645 72,290 29Apr21	4	BEDROOM 2: 4" E/S LED INTERIOR POT LIGHT (INSULATED CEILING) - SECOND FLOOR - EACH - ON EXISTING SWITCH DELETE STANDARD CEILING LIGHT FIXTURE
2645 72,290 29Apr21	4	BEDROOM 3: 4" E/S LED INTERIOR POT LIGHT (INSULATED CEILING) - SECOND FLOOR - EACH - ON EXISTING SWITCH DELETE STANDARD CEILING LIGHT FIXTURE
2645 72,290 29Apr21	4	BEDROOM 4: 4" E/S LED INTERIOR POT LIGHT (INSULATED CEILING) - SECOND FLOOR - EACH - ON EXISTING SWITCH DELETE STANDARD CEILING LIGHT FIXTURE
2645 72,290 29Apr21	6	UPPER HALL: 4" E/S LED INTERIOR POT LIGHT (INSULATED CEILING) - SECOND FLOOR - EACH - ON EXISTING SWITCH DELETE ALL STANDARD CEILING LIGHT FIXTURES
2645 72,290 29Apr21	2	ENSUITE 2: 4" E/S LED INTERIOR POT LIGHT (INSULATED CEILING) - SECOND FLOOR - EACH STANDARD VANITY LIGHT TO REMAIN



CONSTRUCTION SUMMARY

Lot: 42
Model: 40.02 A VALLEYVIEW
Project/Phase: Pine Valley Forevergreen / 1

ELECTRICAL

Invoice	Qty.	Description
2645 72,278 29Apr21	1	ENSUITE 2: ADDITIONAL INTERIOR SWITCH FOR POT LIGHTS
2645 72,279 29Apr21	1	ENSUITE 2: SHOWER POT LIGHT: 6" RECESSED SHOWER POT LIGHT
2645 72,278 29Apr21	1	ENSUITE 2: ADDITIONAL INTERIOR SWITCH FOR SHOWER POT LIGHT
2645 72,290 29Apr21	4	SHARED ENSUITE: 4" E/S LED INTERIOR POT LIGHT (INSULATED CEILING) - SECOND FLOOR - EACH - ON EXISTING SWITCH DELETE STANDARD CEILING LIGHT FIXTURE - STANDARD VANITY LIGHT TO REMAIN
2645 72,279 29Apr21	1	SHARED ENSUITE: SHOWER POT LIGHT: 6" RECESSED SHOWER POT LIGHT ON EXISTING SWITCH
2645 72,307 29Apr21	1	SHARED ENSUITE: RELOCATE STANDARD SHOWER POT LIGHT AS PER PLAN
2645 72,291 29Apr21	2	FRONT EXTERIOR: EXTERIOR LED SOFFIT POT LIGHT - EACH - INSTALL IN UPPER SOFFIT - SEE PLAN / ATTACHED ELEVATION FOR LOCATION
2645 72,278 29Apr21	1	FOYER: ADDITIONAL INTERIOR SWITCH FOR EXTERIOR POT LIGHTS
2645 72,280 29Apr21	1	MASTER ENSUITE: INSTALL CAPPED CEILING LIGHT FIXTURE - APPROX. CENTRE ON CEILING OVER FREE STANDING TUB
2645 72,278 29Apr21	1	MASTER ENSUITE: ADDITIONAL INTERIOR SWITCH - FOR FIXTURE OVER TUB
2645 72,273 29Apr21	1	KITCHEN: 110V WALL RECEPTACLE ON SEPARATE CIRCUIT - GAS FIRED APPLIANCE - FOR AUX. EQUIPMENT - NOT A STOVE PLUG
2645 72,271 29Apr21	1	KITCHEN: 110V WALL RECEPTACLE ON SEPARATE CIRCUIT - FOR WINE FRIDGE
2645 72,307 29Apr21	1	KITCHEN: RELOCATE STANDARD CEILING MOUNT FIXTURE - APPROX. CENTRE OVER ISLAND - SEE PLAN



CONSTRUCTION SUMMARY

Lot: 42
Model: 40.02 A VALLEYVIEW
Project/Phase: Pine Valley Forevergreen / 1

ELECTRICAL

Invoice	Qty.	Description
2645 72,280 29Apr21	1	KITCHEN: ADDITIONAL CAPPED CEILING LIGHT FIXTURE APPROX. CENTRE ON CEILING OVER KITCHEN ISLAND - ON EXISTING SWITCH - SEE PLAN
2645 72,281 29Apr21	1	GREAT ROOM: INTERIOR WALL OUTLET: ADDITIONAL 110V WALL INTERIOR RECEPTACLE ON EXISTING CIRCUIT FOR WALL MOUNTED TV - INSTALL APPROX. 64" A.F.F.
2645 72,291 29Apr21	5	GARAGE: INSTALL EXTERIOR LED POT LIGHTS ON INSIDE OF GARAGE CEILING - ON EXISTING SWITCH - SEE PLAN DELETE STANDARD GARAGE CEILING LIGHT FIXTURE
2645 72,303 29Apr21	1	KITCHEN: INSTALL LED LIGHT BUNDLE INCLUDING CABINETRY VALANCE LED STRIP LIGHT AND ACCESSORY + NOTCHED CUSTOM ENGINEERED ROUTING TO EACH UPPER CABINET INTENDED FOR LED CHANNELS
2645 72,291 29Apr21	2	REAR EXTERIOR: EXTERIOR LED SOFFIT POT LIGHT - EACH - INSTALL IN UPPER SOFFIT - SEE PLAN / ATTACHED ELEVATION FOR LOCATION
2645 72,278 29Apr21	1	BREAKFAST: ADDITIONAL INTERIOR SWITCH FOR EXTERIOR POT LIGHTS
2645 29Apr21 NoCat	1	KITCHEN/BREAKFAST: INSTALL EXTERIOR 8' FRENCH DOORS IN LIEU OF STANDARD GARDEN DOOR
2645 29Apr21 NoCat	1	THRU OUT 2ND FLOOR: INCREASE HEIGHT OF DOOR TO 8FT SECOND FLOOR - PER DOOR
2645 29Apr21 NoCat	1	GREAT ROOM: UPGRADE MAIN FLOOR LINEAR 1 SIDED FIREPLACE - JADE SERIES 42" LINEAR DIRECT VENT GAS FIREPLACE IN LIEU OF STANDARD BOTTOM OF GLASS APPROX. 12" A.F.F. + ADD VENT GRILL APPROX. 6" FROM CEILING

EXTERIOR DOORS

Invoice	Qty.	Description
2645 72,355 29Apr21	1	KITCHEN/BREAKFAST: INSTALL EXTERIOR 8' FRENCH DOORS IN LIEU OF STANDARD GARDEN DOOR
2645 72,363 29Apr21	1	GARAGE: INCREASED HEIGHT TO MAN DOOR FROM HOUSE TO GARAGE [32 X 94] TALL HEIGHT * WOOD FRAME - IF GRADE PERMITS [EACH]



CONSTRUCTION SUMMARY

Lot: 42
Model: 40.02 A VALLEYVIEW
Project/Phase: Pine Valley Forevergreen / 1

FIREPLACE

Invoice	Qty.	Description
2645 72,620 29Apr21	1	GREAT ROOM: UPGRADE MAIN FLOOR LINEAR 1 SIDED FIREPLACE - JADE SERIES 42" LINEAR DIRECT VENT GAS FIREPLACE IN LIEU OF STANDARD BOTTOM OF GLASS APPROX. 12" A.F.F. + ADD VENT GRILL APPROX. 6" FROM CEILING

FORMING

Invoice	Qty.	Description
2620 72,193 26Mar21	1	BASEMENT: 9 FOOT BASEMENT CEILING HEIGHT IN LIEU OF STANDARD 8 FOOT CEILING



CONSTRUCTION SUMMARY

Lot: 42
Model: 40.02 A VALLEYVIEW
Project/Phase: Pine Valley Forevergreen / 1

FRAMING

Invoice	Qty.	Description
2620 72,388 26Mar21	1	MASTER BEDROOM: OPT. 10 FOOT TRAY CEILING AS PER PLAN
2645 72,690 29Apr21	1	DELETE KITCHEN BULKHEAD, IF POSSIBLE, SITE APPROVAL REQUIRED
2645 72,671 29Apr21	1	MASTER ENSUITE: SHOWER BENCH COMPLETE WITH STANDARD TILE AND MATCHING MARBLE JAMB COLOUR SEAT TOP
2645 72,631 29Apr21	1	MASTER ENSUITE: SHOWER NICHE [SHAMPOO SHELF] - COMPLETE WITH MATCHING MARBLE JAMBS ON 4 SIDES, STANDARD TILE, APPROX. 12 X 18 INSTALLED VERTICALLY - SEE PLAN FOR LOCATION
2645 29Apr21 NoCat	1	FRONT EXTERIOR: EXTERIOR LED SOFFIT POT LIGHT - EACH - INSTALL IN UPPER SOFFIT - SEE PLAN / ATTACHED ELEVATION FOR LOCATION
2645 29Apr21 NoCat	1	KITCHEN/BREAKFAST: INSTALL EXTERIOR 8' FRENCH DOORS IN LIEU OF STANDARD GARDEN DOOR
2645 29Apr21 NoCat	1	KITCHEN/BREAKFAST: INSTALL EXTERIOR 8' FRENCH DOORS IN LIEU OF STANDARD GARDEN DOOR
2645 29Apr21 NoCat	1	GREAT ROOM: MODEL OPTIONS 40.02 - OPT. COFFERED CEILING - AS PER PLAN
2645 29Apr21 ** NoCat	1	DELETE KITCHEN BULKHEAD, IF POSSIBLE, SITE APPROVAL REQUIRED
2645 29Apr21 NoCat	1	DELETE KITCHEN BULKHEAD, IF POSSIBLE, SITE APPROVAL REQUIRED
2645 29Apr21 ** NoCat	1	DELETE KITCHEN BULKHEAD, IF POSSIBLE, SITE APPROVAL REQUIRED
2645 29Apr21 NoCat	1	THRU OUT 2ND FLOOR: INCREASE HEIGHT OF DOOR TO 8FT SECOND FLOOR - PER DOOR
2645 29Apr21 NoCat	1	GREAT ROOM: UPGRADE MAIN FLOOR LINEAR 1 SIDED FIREPLACE - JADE SERIES 42" LINEAR DIRECT VENT GAS FIREPLACE IN LIEU OF STANDARD BOTTOM OF GLASS APPROX. 12" A.F.F. + ADD VENT GRILL APPROX. 6" FROM CEILING



CONSTRUCTION SUMMARY

Lot: 42
Model: 40.02 A VALLEYVIEW
Project/Phase: Pine Valley Forevergreen / 1

FRAMING

Invoice	Qty.	Description
2645 29Apr21 NoCat	1	REAR EXTERIOR: EXTERIOR LED SOFFIT POT LIGHT - EACH - INSTALL IN UPPER SOFFIT - SEE PLAN / ATTACHED ELEVATION FOR LOCATION

HVAC

Invoice	Qty.	Description
2645 72,224 29Apr21	1	KITCHEN: GAS LINE ROUGH-IN ONLY - MAIN FLOOR FOR STOVE - SEE PLAN FOR APPROX. LOCATION FINAL LOCATION, ORIENTATION, AND CONNECTION IS TO BE COMPLETED BY A LICENSED GAS FITTER AND ARRANGED BY THE HOME OWNER AFTER CLOSING
2645 72,690 29Apr21 **	1	DELETE KITCHEN BULKHEAD, IF POSSIBLE, SITE APPROVAL REQUIRED
2645 29Apr21 NoCat	1	DELETE KITCHEN BULKHEAD, IF POSSIBLE, SITE APPROVAL REQUIRED
2645 29Apr21 ** NoCat	1	DELETE KITCHEN BULKHEAD, IF POSSIBLE, SITE APPROVAL REQUIRED
2645 29Apr21 ** NoCat	1	DELETE KITCHEN BULKHEAD, IF POSSIBLE, SITE APPROVAL REQUIRED
2645 29Apr21 NoCat	1	GREAT ROOM: UPGRADE MAIN FLOOR LINEAR 1 SIDED FIREPLACE - JADE SERIES 42" LINEAR DIRECT VENT GAS FIREPLACE IN LIEU OF STANDARD BOTTOM OF GLASS APPROX. 12" A.F.F. + ADD VENT GRILL APPROX. 6" FROM CEILING

INTERIOR TRIM /MOULDINGS

Invoice	Qty.	Description
2620 26Mar21 ** NoCat	4	BASEMENT WINDOWS - UPGRADE BASEMENT WINDOW SIZE TO 30 " X 24" - 8" FRAME

INTERIOR TRIM AND DOORS

Invoice	Qty.	Description
2645 72,644 29Apr21	18	THRU OUT 2ND FLOOR: INCREASE HEIGHT OF DOOR TO 8FT SECOND FLOOR - PER DOOR



CONSTRUCTION SUMMARY

Lot: 42
Model: 40.02 A VALLEYVIEW
Project/Phase: Pine Valley Forevergreen / 1

INTERIOR TRIM AND DOORS

Invoice	Qty.	Description
2620 26Mar21 NoCat	1	FYI - BASEMENT: 9 FOOT BASEMENT CEILING HEIGHT IN LIEU OF STANDARD 8 FOOT CEILING
2645 29Apr21 NoCat	1	GARAGE: INCREASED HEIGHT TO MAN DOOR FROM HOUSE TO GARAGE [32 X 94] TALL HEIGHT * WOOD FRAME - IF GRADE PERMITS [EACH]
2645 29Apr21 NoCat	1	GREAT ROOM: UPGRADE MAIN FLOOR LINEAR 1 SIDED FIREPLACE - JADE SERIES 42" LINEAR DIRECT VENT GAS FIREPLACE IN LIEU OF STANDARD BOTTOM OF GLASS APPROX. 12" A.F.F. + ADD VENT GRILL APPROX. 6" FROM CEILING

KITCHEN AND BATH CABINETRY

Invoice	Qty.	Description
2645 72,690 29Apr21 **	1	DELETE KITCHEN BULKHEAD, IF POSSIBLE, SITE APPROVAL REQUIRED
2645 156,655 29Apr21	1	KITCHEN: INSTALL MINI STACKED UPPER CABINETS WITH CROWN MOULDING
2645 29Apr21 ** NoCat	1	DELETE KITCHEN BULKHEAD, IF POSSIBLE, SITE APPROVAL REQUIRED
2645 29Apr21 ** NoCat	1	DELETE KITCHEN BULKHEAD, IF POSSIBLE, SITE APPROVAL REQUIRED
2645 29Apr21 NoCat	1	DELETE KITCHEN BULKHEAD, IF POSSIBLE, SITE APPROVAL REQUIRED
2645 29Apr21 NoCat	1	KITCHEN: INSTALL LED LIGHT BUNDLE INCLUDING CABINETRY VALANCE LED STRIP LIGHT AND ACCESSORY + NOTCHED CUSTOM ENGINEERED ROUTING TO EACH UPPER CABINET INTENDED FOR LED CHANNELS

MASONRY

Invoice	Qty.	Description
2645 29Apr21 NoCat	1	KITCHEN/BREAKFAST: INSTALL EXTERIOR 8' FRENCH DOORS IN LIEU OF STANDARD GARDEN DOOR
2645 29Apr21 NoCat	1	GARAGE: INCREASED HEIGHT TO MAN DOOR FROM HOUSE TO GARAGE [32 X 94] TALL HEIGHT * WOOD FRAME - IF GRADE PERMITS [EACH]



CONSTRUCTION SUMMARY

Lot: 42
Model: 40.02 A VALLEYVIEW
Project/Phase: Pine Valley Forevergreen / 1

NETWORK AND WIRING

Invoice	Qty.	Description
2645 72,259 29Apr21	1	GREAT ROOM: CONDUIT PIPE - FOR WALL MOUNT TV - INSTALL ABOVE FIREPLACE LOCATION, THRU BASEMENT, TERMINATE AT CABLE LOCATION

PAINT

Invoice	Qty.	Description
2620 26Mar21 NoCat	1	MASTER BEDROOM: OPT. 10 FOOT TRAY CEILING AS PER PLAN
2620 26Mar21 NoCat	1	FYI - BASEMENT: 9 FOOT BASEMENT CEILING HEIGHT IN LIEU OF STANDARD 8 FOOT CEILING
2645 29Apr21 NoCat	1	KITCHEN/BREAKFAST: INSTALL EXTERIOR 8' FRENCH DOORS IN LIEU OF STANDARD GARDEN DOOR
2645 29Apr21 NoCat	1	GREAT ROOM: MODEL OPTIONS 40.02 - OPT. COFFERED CEILING - AS PER PLAN
2645 29Apr21 NoCat	1	GREAT ROOM: MODEL OPTIONS 40.02 - OPT. WAFFLE CEILING, BEAM DETAIL AS PER PLAN (6 BOXES) OPTION # 1 - CTR-B07
2645 29Apr21 NoCat	1	DINING ROOM: INSTALL WAFFLE CEILING - 4 BOXES - SEE PLAN
2645 29Apr21 NoCat	1	THRU OUT 2ND FLOOR: INCREASE HEIGHT OF DOOR TO 8FT SECOND FLOOR - PER DOOR
2645 29Apr21 NoCat	1	GARAGE: INCREASED HEIGHT TO MAN DOOR FROM HOUSE TO GARAGE [32 X 94] TALL HEIGHT * WOOD FRAME - IF GRADE PERMITS [EACH]
2645 29Apr21 NoCat	1	GREAT ROOM: UPGRADE MAIN FLOOR LINEAR 1 SIDED FIREPLACE - JADE SERIES 42" LINEAR DIRECT VENT GAS FIREPLACE IN LIEU OF STANDARD BOTTOM OF GLASS APPROX. 12" A.F.F. + ADD VENT GRILL APPROX. 6" FROM CEILING



CONSTRUCTION SUMMARY

Lot: 42

Model: 40.02 A VALLEYVIEW

Project/Phase: Pine Valley Forevergreen / 1

PAINT

Invoice	Qty.	Description
2645 72,690 29Apr21 **	1	DELETE KITCHEN BULKHEAD, IF POSSIBLE, SITE APPROVAL REQUIRED



CONSTRUCTION SUMMARY

Lot: 42
Model: 40.02 A VALLEYVIEW
Project/Phase: Pine Valley Forevergreen / 1

PLUMBING

Invoice	Qty.	Description
2620 26Mar21 NoCat	1	FYI - BASEMENT: 9 FOOT BASEMENT CEILING HEIGHT IN LIEU OF STANDARD 8 FOOT CEILING
2645 72,346 29Apr21	1	KITCHEN: INSTALL COMPLETE POT FILLER ON WALL AT STOVE LOCATION - MOEN MODERN POT FILLER - MATTE BLACK
2645 29Apr21 NoCat	1	FYI - DELETE KITCHEN BULKHEAD, IF POSSIBLE, SITE APPROVAL REQUIRED
2645 75,845 29Apr21	2	MASTER ENSUITE: UPGRADE VANITY FAUCET - MOEN DOUX SINGLE LEVER - MATTE BLACK
2645 75,845 29Apr21	1	MASTER ENSUITE: UPGRADE TUB FAUCET - MOEN DOUX FREE STANDING TUB FILLER - MATTE BLACK
2645 75,841 29Apr21	1	MASTER ENSUITE: UPGRADE SHOWER FAUCET - MOEN DOUX VERTICAL SPA WITH 4 BODY SPRAYS - MATTE BLACK

WINDOWS AND DOORS

Invoice	Qty.	Description
2645 29Apr21 NoCat	1	KITCHEN/BREAKFAST: INSTALL EXTERIOR 8' FRENCH DOORS IN LIEU OF STANDARD GARDEN DOOR

SCHEDULE 'F'




PV-42
 MARCH 5 2021
 PV-42 *att*
 April 21, 2021

see attach

The Valleyview 40' SERIES

→ Elevation A • 3,145 sq.ft.
 Elevation B • 3,170 sq.ft.

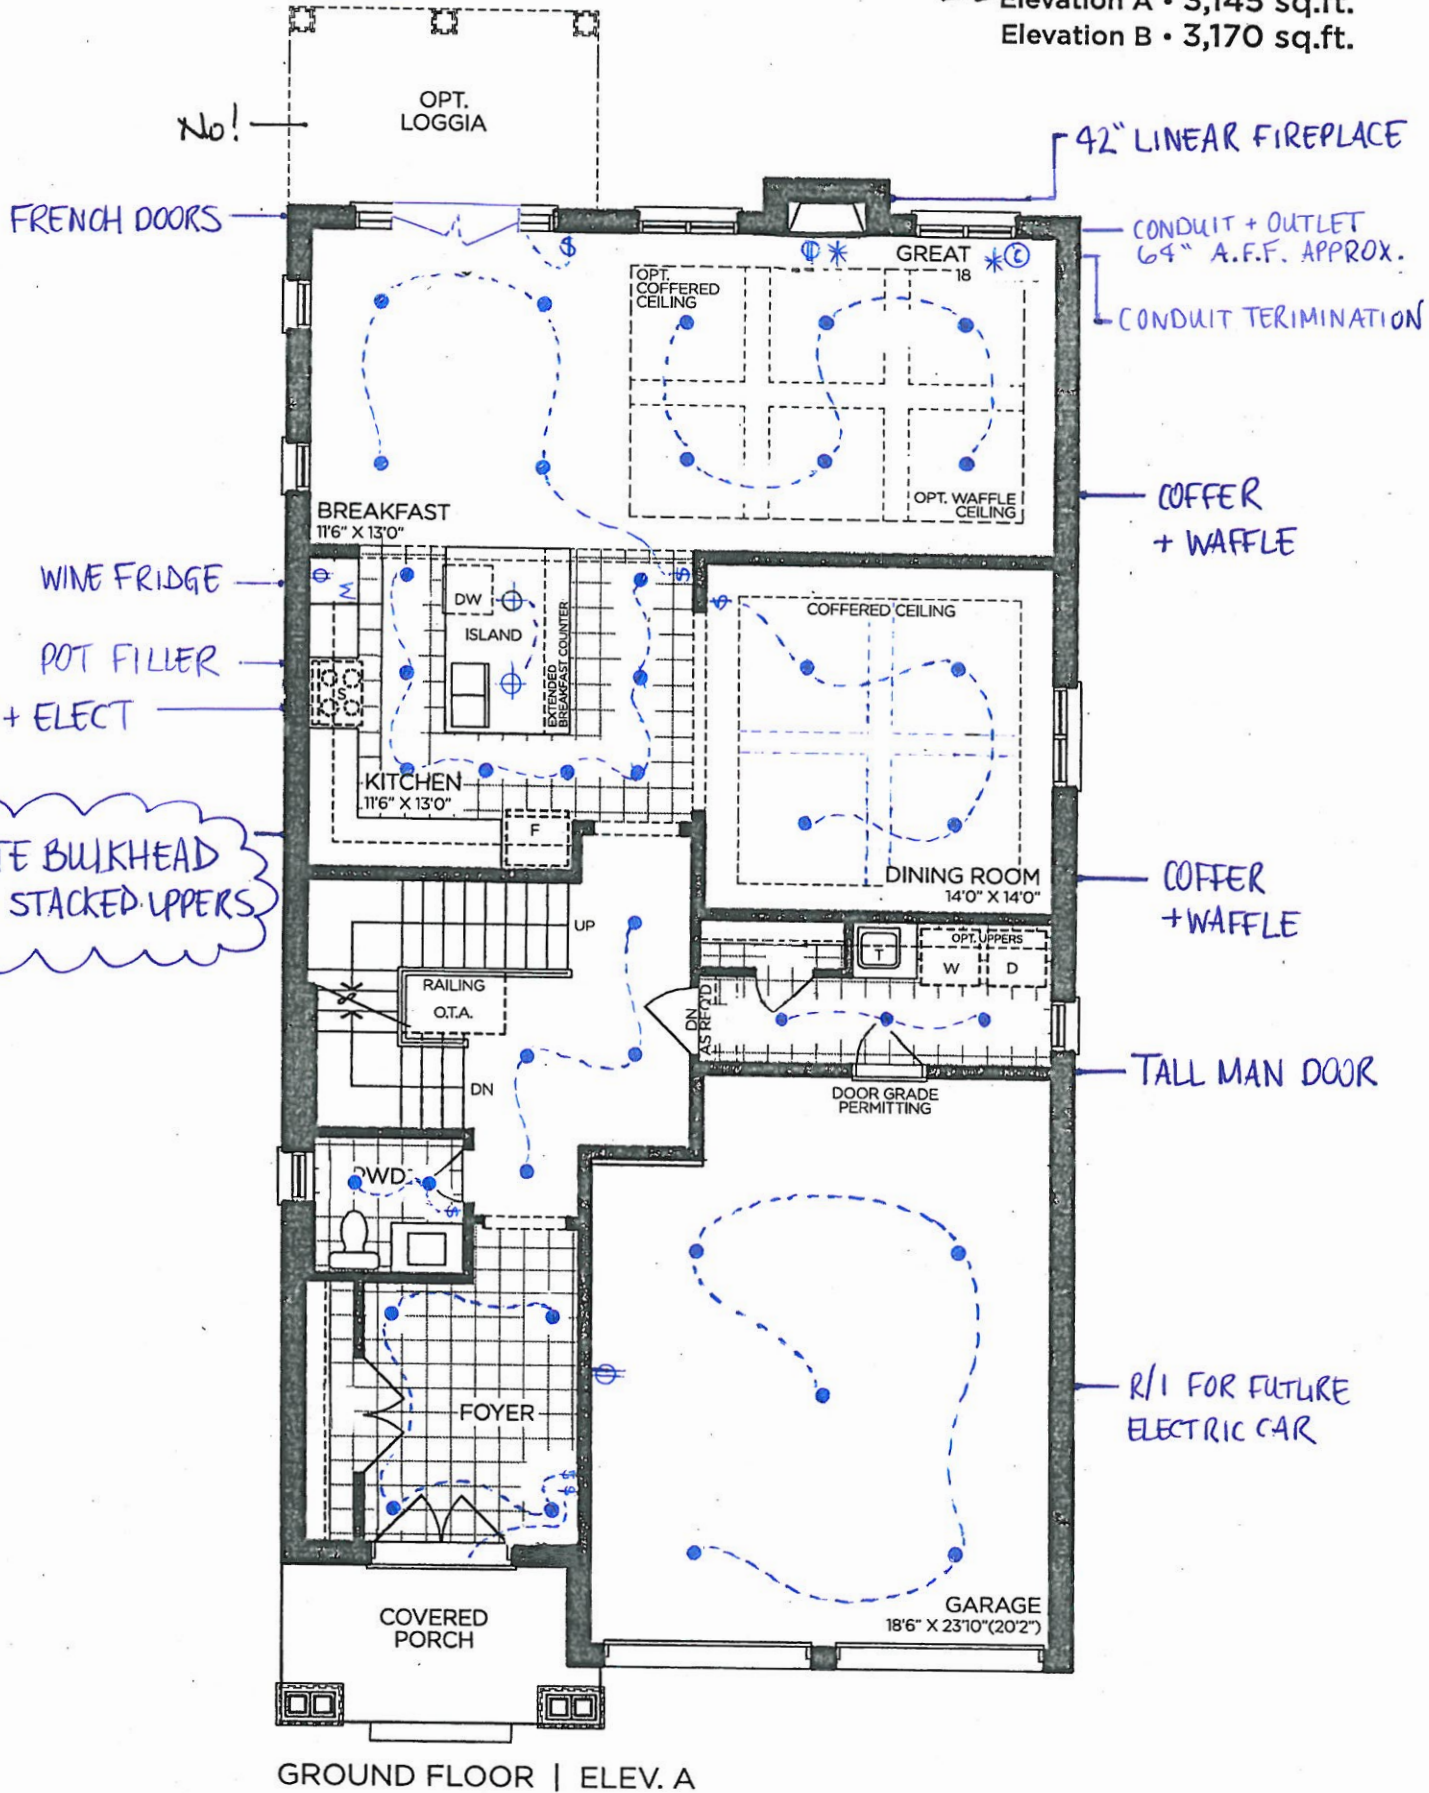

VENDOR
 PURCHASER
 PURCHASER

GOLDPARK
 WORTH MORE™

Prices, figures, illustrations, sizes, features and finishes are subject to change without notice. Areas and dimensions are approximate and actual usable floor space may vary from the stated area. Layout may be reverse of the unit purchased. E. & O.E. 4002

SCHEDULE 'F'

PV-42
March 5, 2021
PV-42 *attach*
April 21, 2021

see attach.



The Valleyview
40' SERIES


Elevation A • 3,145 sq.ft.
Elevation B • 3,170 sq.ft.

8' DOORS
THRU OUT

SHOWER BENCH

upper
soffit

TRAY YES!

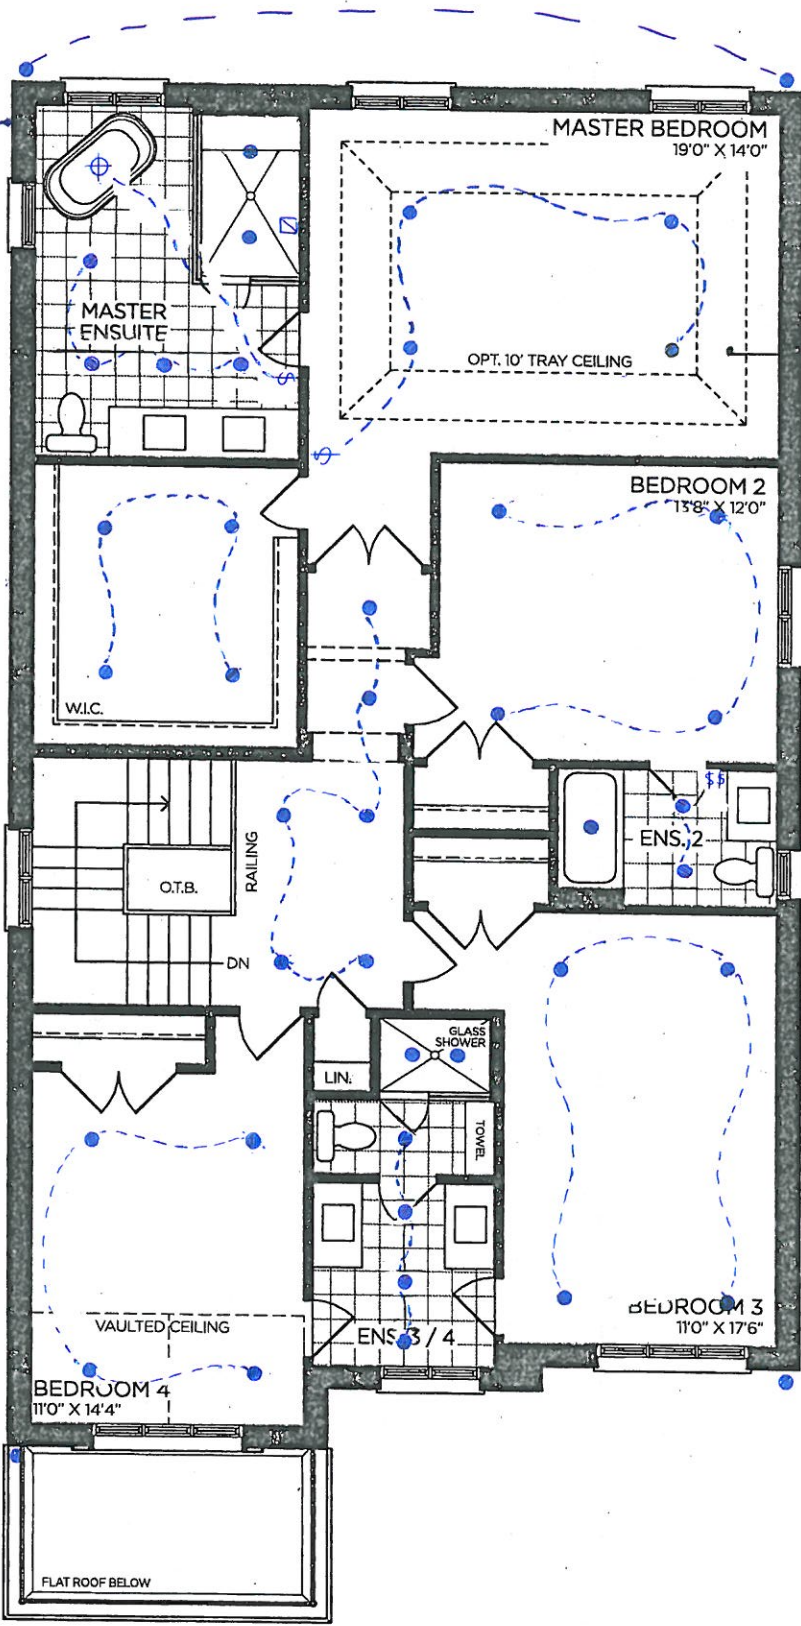

SECOND FLOOR | ELEV. A

VENDOR

PURCHASER

PURCHASER

GOLDPARK
WORTH MORE™


Prices, figures, illustrations, sizes, features and finishes are subject to change without notice. Areas and dimensions are approximate and actual usable floor space may vary from the stated area. Layout may be reverse of the unit purchased. E. & O.E. 4002

SCHEDULE 'F'



PV-42
March 5 2021
see attach.
PV-42
April 21, 2021

The
Valleyview
40' SERIES
→ Elevation A • 3,145 sq.ft.
Elevation B • 3,170 sq.ft.

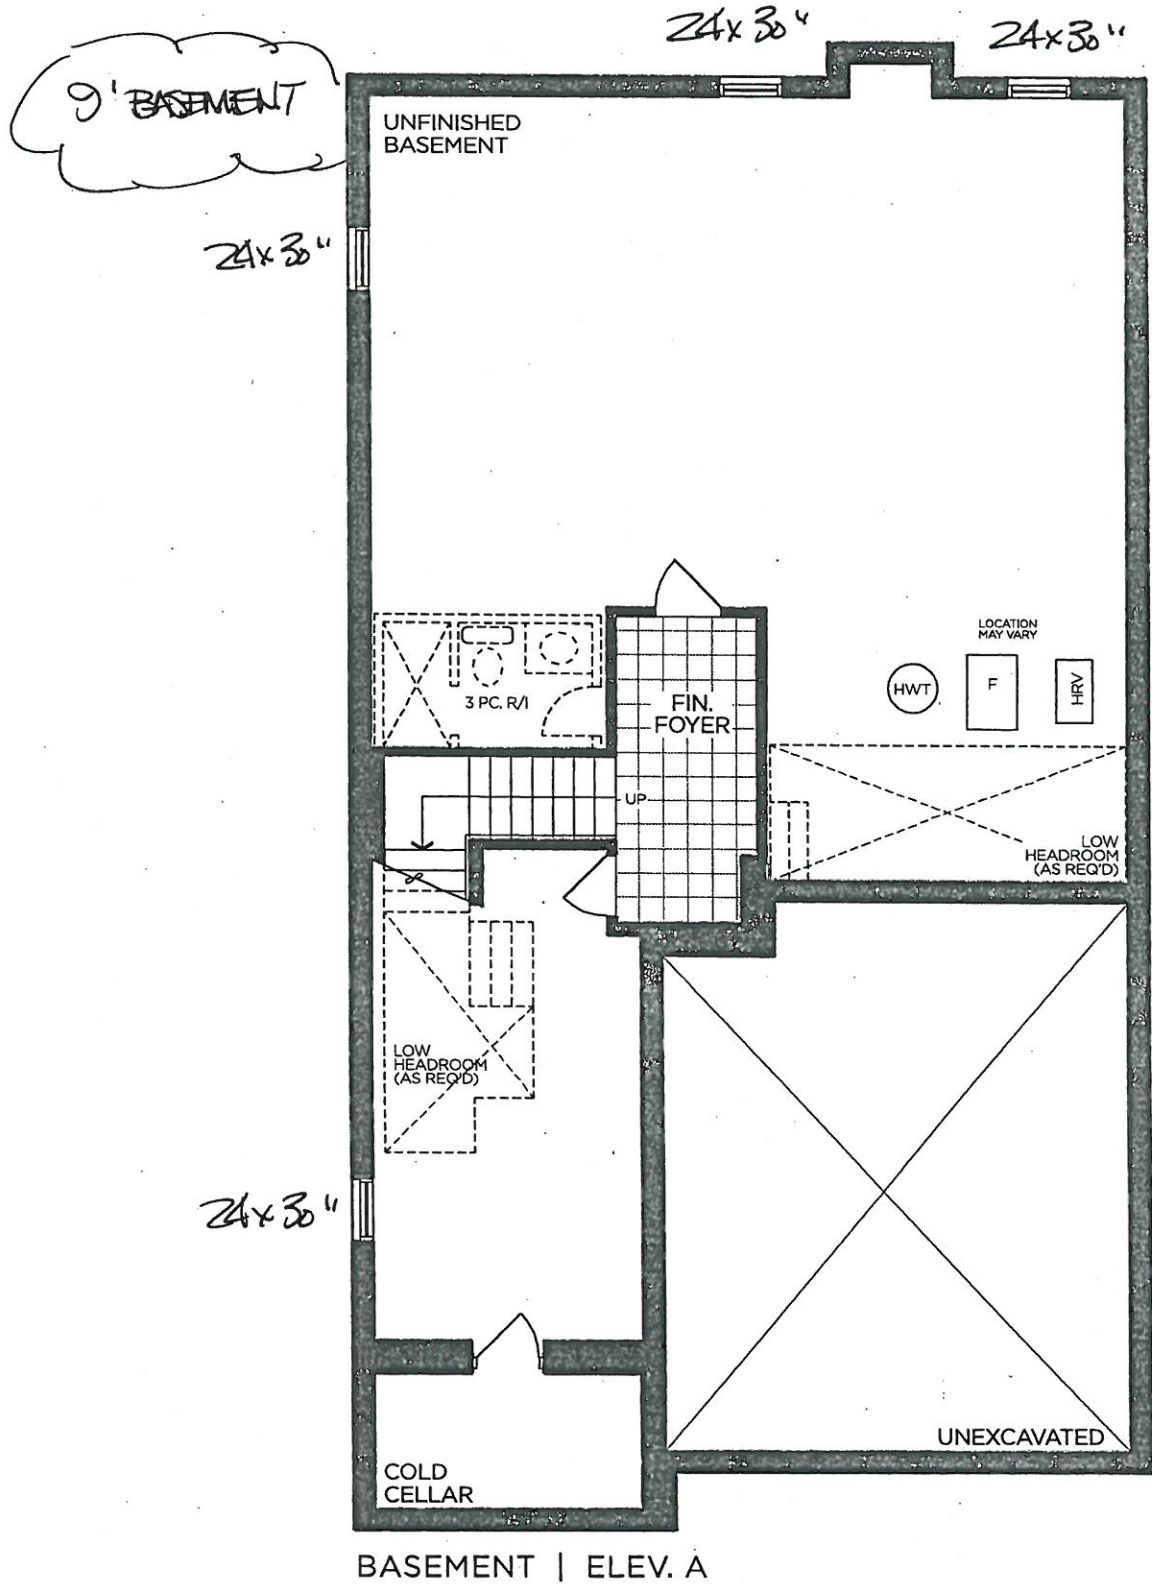

VENDOR

PURCHASER

PURCHASER

GOLDPARK
WORTH MORE™

Prices, figures, illustrations, sizes, features and finishes are subject to change without notice. Areas and dimensions are approximate and actual usable floor space may vary from the stated area. Layout may be reverse of the unit purchased. E. & O.E. 4002



PINE VALLEY

FOREVER GREEN



← SOFFIT at
CORNERS

LOT NUMBER: 42
UNIT NAME: VALLEYVIEW
ELEVATION: A (REV)
UNIT NUMBER: 4002



Lot# PV-42

Room: Exterior

Signature:

Date: Apr. 21, 2021

Signature:

GOLDPARK
WORTH MORE




PINE VALLEY
FOREVERGREEN

PLUMBING UPGRADES

MOEN - DOUX

Single Handle Lav Faucet

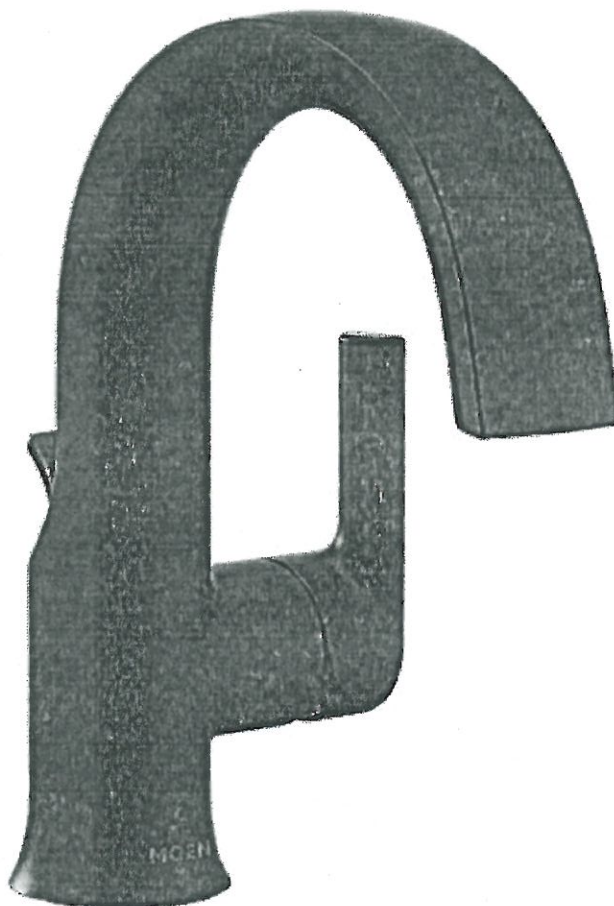

- ☐ CHROME
- ☐ BRUSHED NICKEL (BN)
- ☒ MATTE BLACK (BN)


MODEL: S6910

Lot# PV-42	Date: Apr. 21, 2021	Room: Master Ensuite x 2
Signature:		
Signature:		

PLUMBING UPGRADES

MOEN - DOUX

ExactTemp 3/4" Thermostatic Vertical Spa with Body Sprays

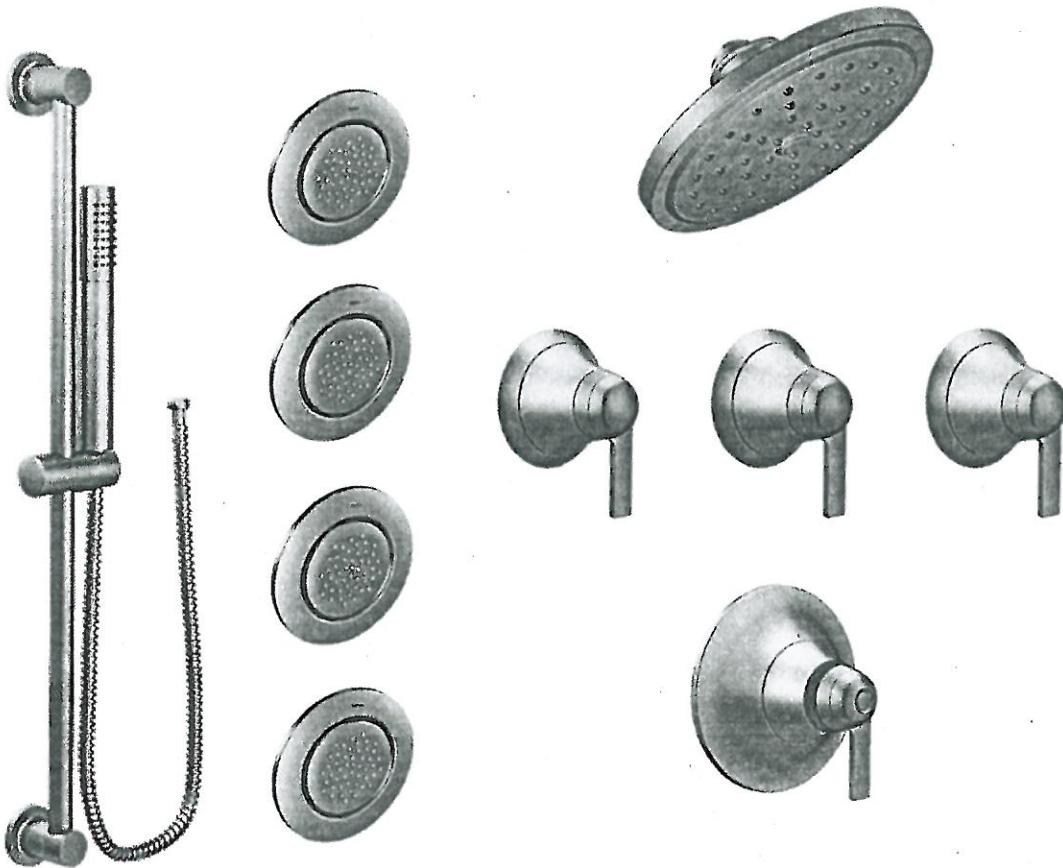

*from ceiling

- ☐ CHROME
☐ BRUSHED NICKEL (BN)
☒ MATTE BLACK (BN)

MODEL: TS3101 / S176EP / 123815 / S3600 (x3) / S3371 / TS3102 (x3) / 3887EP / A725 / S1300 (x4) / TS1322 (x4) / 226651

Lot# *PV-42*

Date: *Apr. 21, 2021*

Room: *Master Ensuite*

Signature: *[Signature]*

Signature: *[Signature]*




PINE VALLEY
FOREVERGREEN

PLUMBING UPGRADES

MOEN - DOUX

Free-Standing Tub Filler

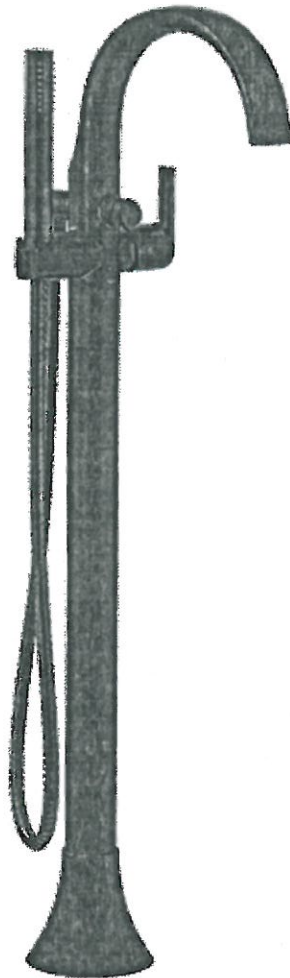

- ☐ CHROME
☐ BRUSHED NICKEL (BN)
☒ MATTE BLACK (BN)

MODEL: S3105 / TS50100

Lot# PV-42

Date: Apr. 21, 2021

Room: Master Ensuite

Signature:

[Handwritten signature]

Signature:

[Handwritten signature]





PINE VALLEY
FOREVERGREEN


FIREPLACE UPGRADES

Majestic Jade Series - 42"


Linear Direct Vent Gas Fireplace

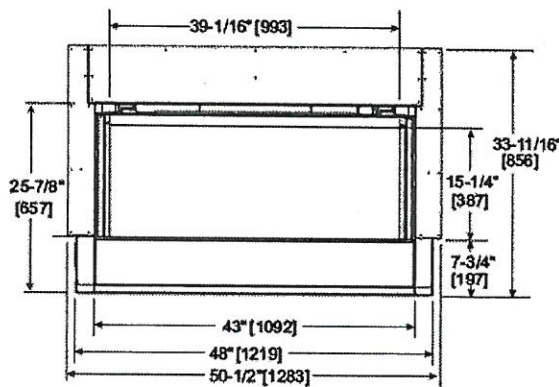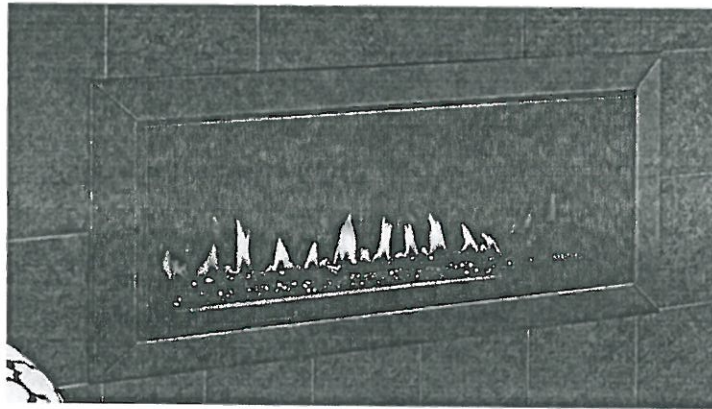


Front

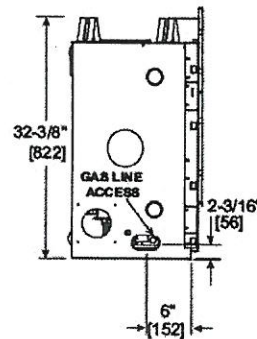

Left

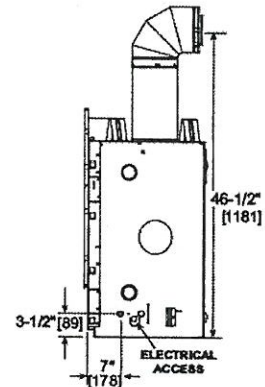

Right

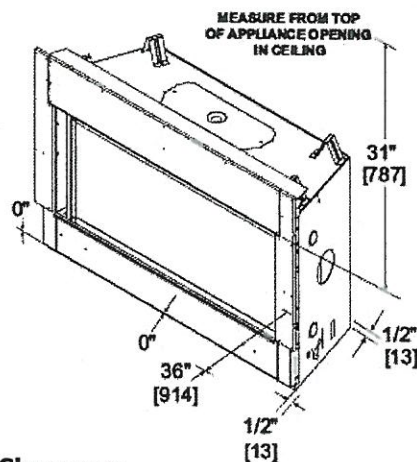

Clearance

Lot# PV-42

Room: Great Room

Signature:

Date: Apr. 21, 2021

Signature:

GOLDPARK
WORTH MORE


SCHEDULE 'F'

PINE VALLEY
FOREVERGREEN

PV-42 *see attach*
MAR 4 5 2021
PV-42
April 21, 2021

The Valleyview 40' SERIES

Elevation A • 3,145 sq.ft.
Elevation B • 3,170 sq.ft.

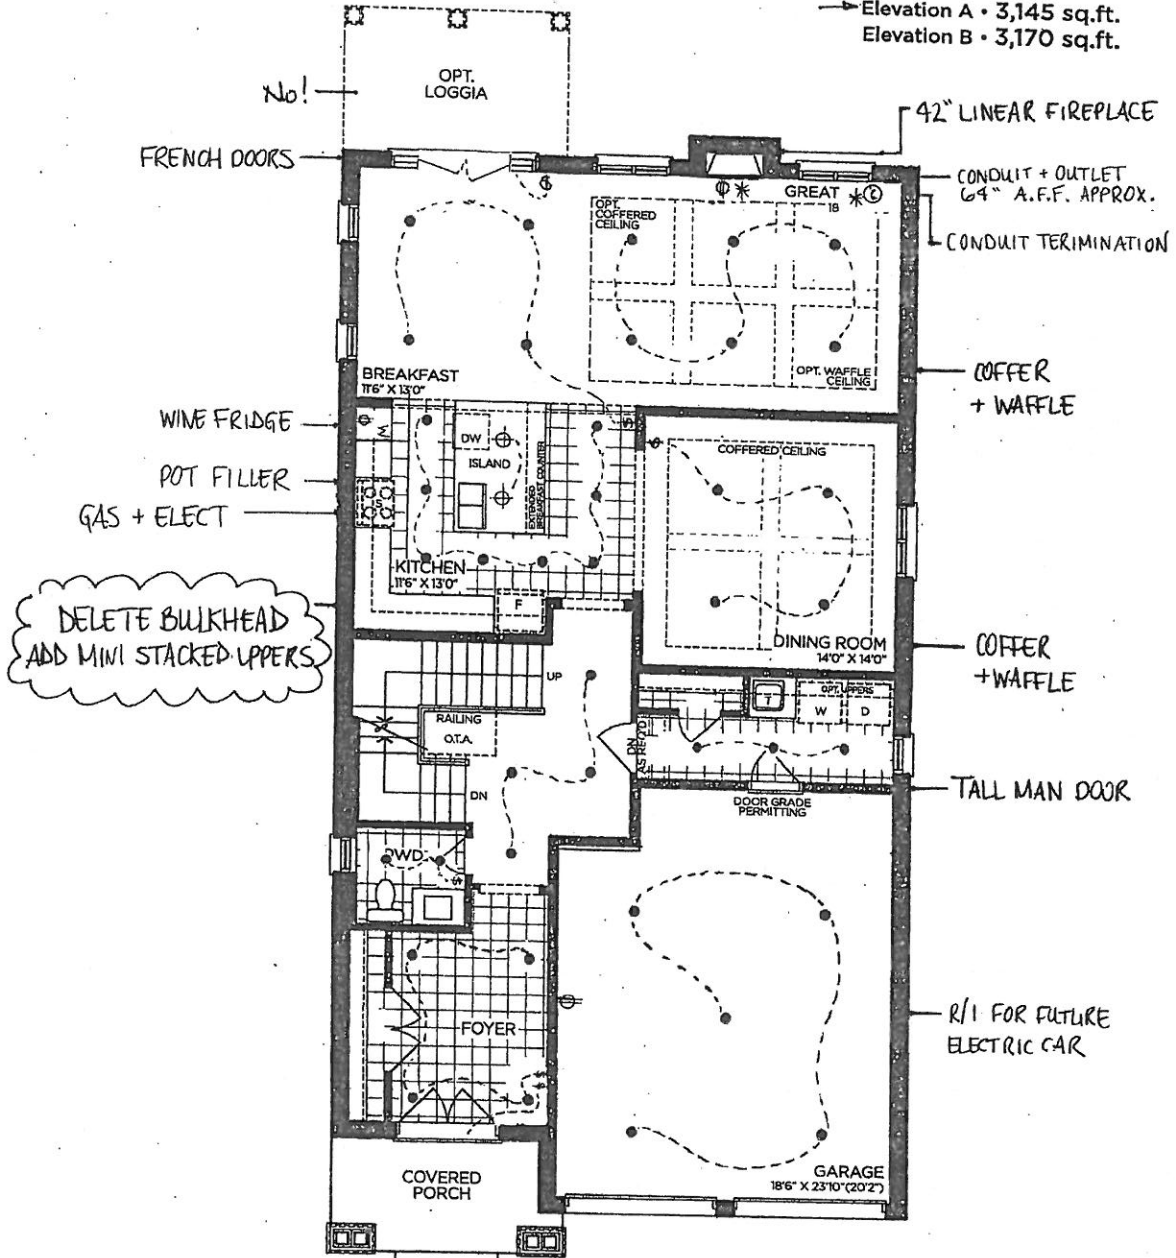

GROUND FLOOR | ELEV. A

VENDOR

PURCHASER

PURCHASER

GOLDPARK
WORTH MORE™

Prices, figures, illustrations, sizes, features and finishes are subject to change without notice. Areas and dimensions are approximate and actual usable floor space may vary from the stated area. Layout may be reverse of the unit purchased. E. & O.E. 4002

SCHEDULE 'F'

PV-42

MARCH 5 2021

PV-42

April 21, 2021

see attach.

PINE VALLEY

8' DOORS
THRU OUT

The Valleyview


40' SERIES

Elevation A • 3,145 sq.ft.
Elevation B • 3,170 sq.ft.

SHOWER BENCH

UPPER
SOFFIT

TRAY YES!

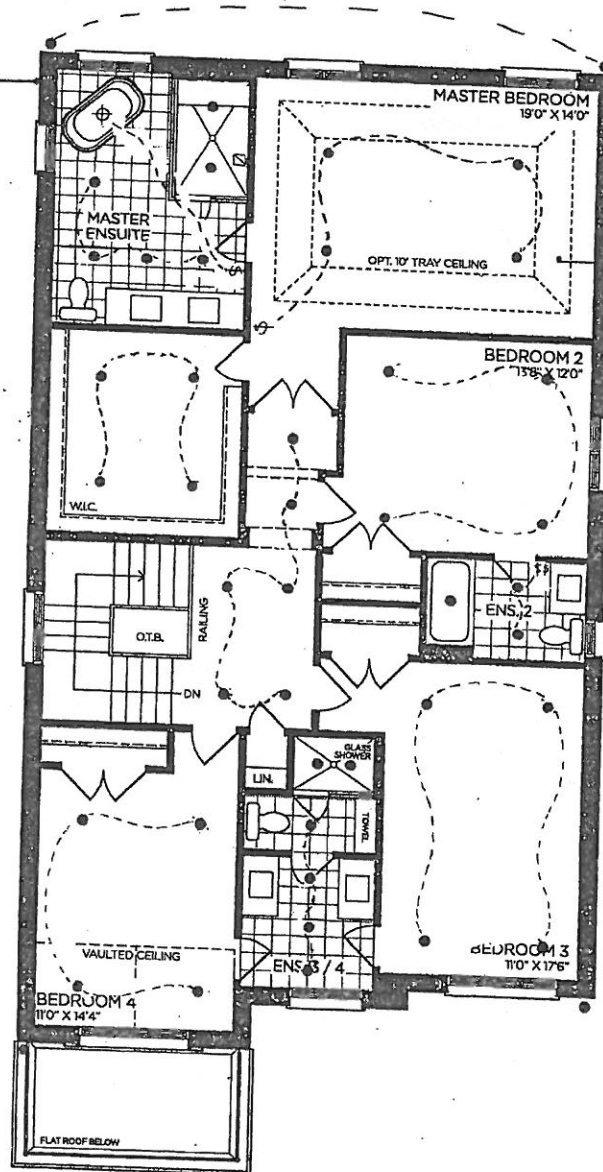

SECOND FLOOR | ELEV. A

VENDOR

PURCHASER

PURCHASER

GOLDPARK
WORTH MORE™


Prices, figures, illustrations, sizes, features and finishes are subject to change without notice. Areas and dimensions are approximate and actual usable floor space may vary from the stated area. Layout may be reverse of the unit purchased. E. & O.E. 4002

SCHEDULE 'F'



PV-42
MARCH 5 2021
PV-42
April 21, 2021
see attach.

The
Valleyview
40' SERIES
→ Elevation A • 3,145 sq.ft.
Elevation B • 3,170 sq.ft.

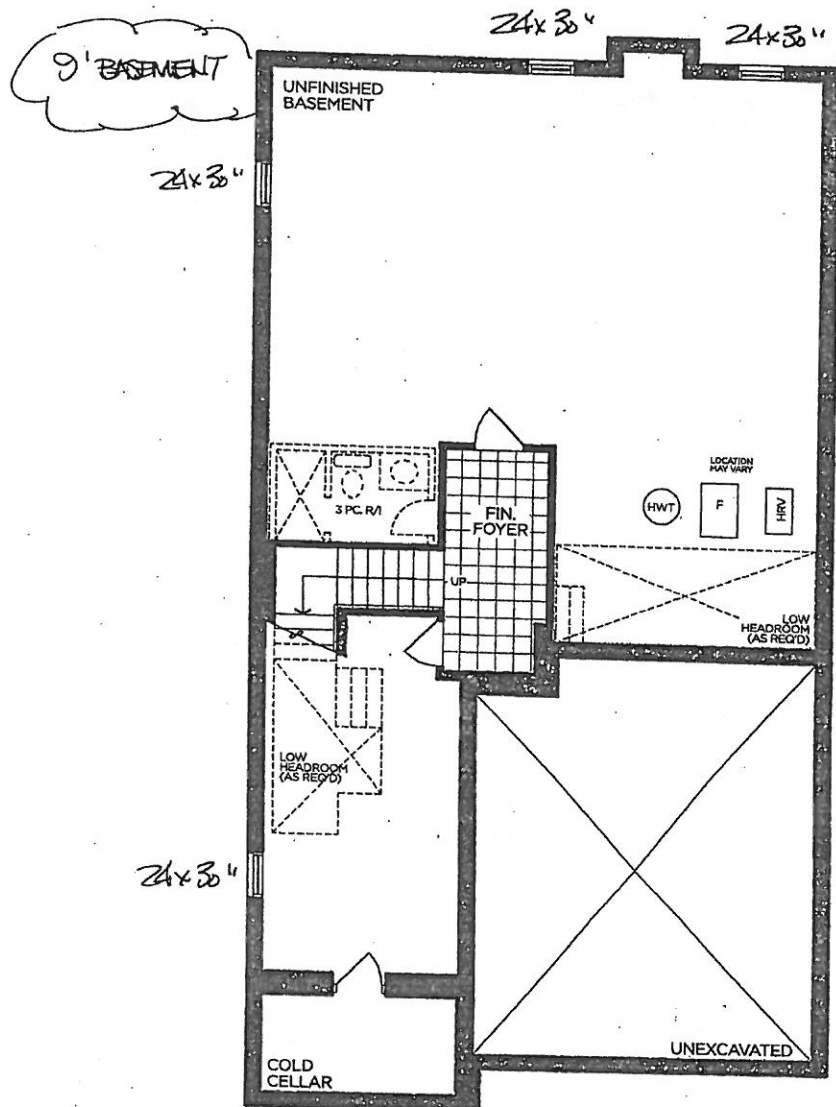


BASEMENT | ELEV. A



VENDOR _____
PURCHASER *[Signature]* _____
PURCHASER *[Signature]* _____

GOLDPARK
WORTH MORE™


Prices, figures, illustrations, sizes, features and finishes are subject to change without notice. Areas and dimensions are approximate and actual usable floor space may vary from the stated area. Layout may be reverse of the unit purchased. E. & OE. 4002

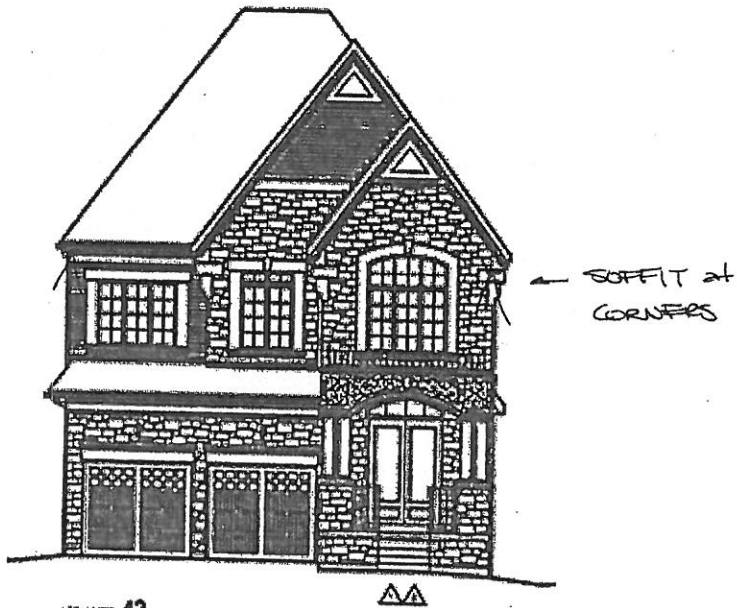

LOT NAME: 42
 ALT NAME: VALLEYVIEW
 ELEVATION: A (REV)
 AT VALUE: 4002

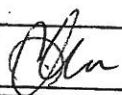
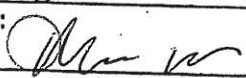
Lot# PV-42	
Room: Exterior	Signature: 
Date: Apr. 21, 2021	Signature: 

MOEN - DOUX
Single Handle Lav Faucet

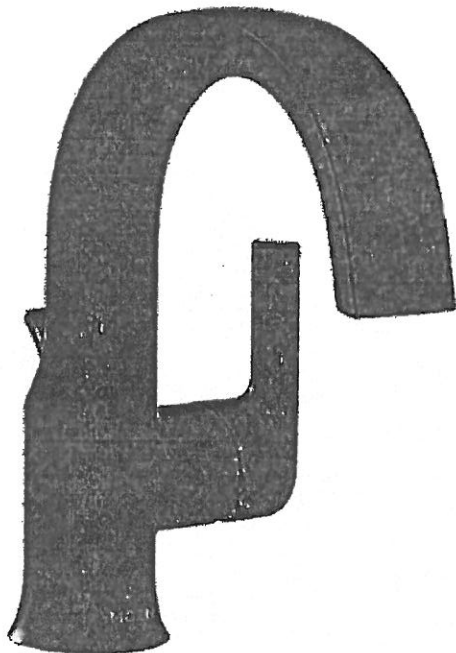


- ☐ CHROME
- ☐ BRUSHED NICKEL (BN)
- ☒ MATTE BLACK (BN)

MODEL: S6910

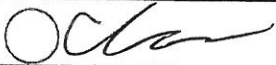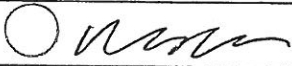Lot# PV-42	Date: Apr. 21, 2021	Room: Master Ensuite x 2
Signature: 		
Signature: 		

MOEN - DOUX
Free-Standing Tub Filler

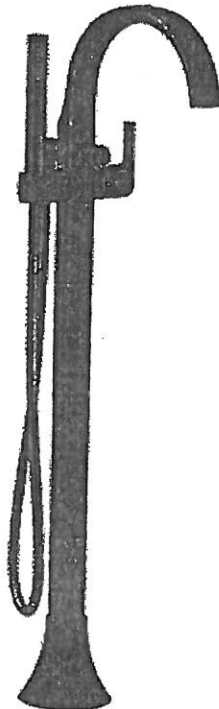

- ☐ CHROME
- ☐ BRUSHED NICKEL (BN)
- ☒ MATTE BLACK (BN)

MODEL: S3105 / TS50100


Lot# <i>PR-42</i>	Date: <i>Apr. 21, 2021</i>	Room: <i>Master Ensuite</i>
Signature: <i>[Signature]</i>		
Signature: <i>[Signature]</i>		

PLUMBING UPGRADES



MOEN - DOUX

ExactTemp 3/4" Thermostatic Vertical Spa with Body Sprays

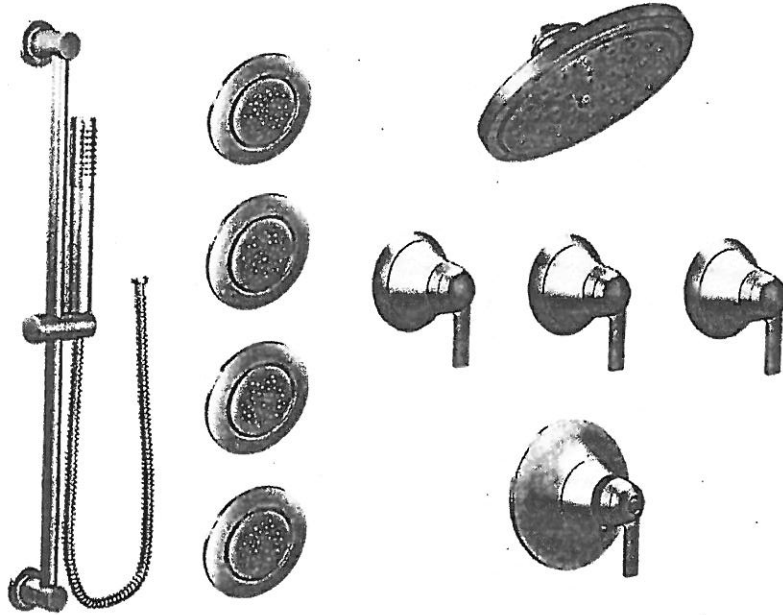

*from ceiling

- ☐ CHROME
☐ BRUSHED NICKEL (BN)
☒ MATTE BLACK (BN)



MODEL: TS3101 / S176EP / 123815 / S3600 (x3) / S3371 / TS3102 (x3) / 3887EP / A725 / S1300 (x4) / TS1322 (x4) / 226651


Lot# PV-42	Date: Apr. 21, 2021	Room: Master Ensuite
Signature:		
Signature:		

GOLDPARK
WORTH MORE

Majestic Jade Series - 42"

Linear Direct Vent Gas Fireplace

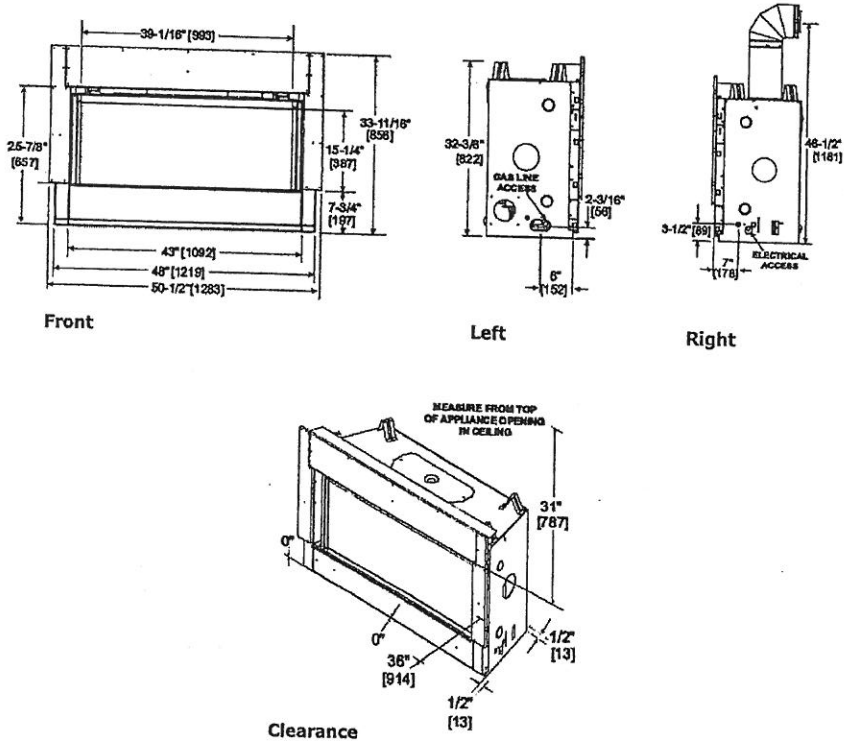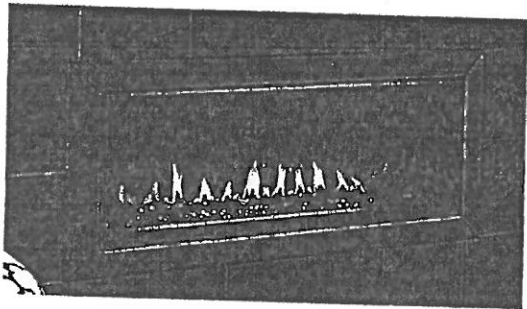

Lot# PV- 42	
Room: Great Room	Signature: 
Date: Apr. 21, 2021	Signature: 