



CONSTRUCTION SUMMARY

Lot: 82
Model: 50.04 B BEAUMONT
Project/Phase: Pine Valley Forevergreen / 1

BASEMENT WINDOWS

Invoice	Qty.	Description
2624 72,351 10Mar21	5	BASEMENT WINDOWS - UPGRADE BASEMENT WINDOW SIZE TO 30 " X 24" - 8" FRAME

CERAMIC

Invoice	Qty.	Description
2649 30Apr21 NoCat	1	MASTER ENSUITE + ENSUITE 2 + ENSUITE 3 + ENSUITE 4: SHOWER NICHE [SHAMPOO SHELF] - COMPLETE WITH MATCHING MARBLE JAMBS ON 4 SIDES, STANDARD TILE, APPROX. 12 X 18 INSTALLED VERTICALLY - SEE PLAN FOR LOCATION
2649 30Apr21 NoCat	1	**CUSTOM LAYOUT** MASTER ENSUITE: MOVE STANDARD VANITY APPROX. TWO FEET TOWARDS FREE STANDING TUB; DELETE NIB WALLS AND DOOR TO WATER CLOSET; RELOCATE TOILET TO WALL BACKING ONTO WIC; ADD COMPLETE BIDET BESIDE REVISED TOILET LOCATION... ...REVERSE DOOR SWING INTO MASTER ENSUITE TO ACCOMMODATE REVISION - SEE PLAN BASED ON STANDARD FINISHES
2649 30Apr21 NoCat	1	MASTER ENSUITE: INSTALL ELECTRIC FLOOR HEATING - INCLUDES THERMOSTAT

CONCRETE AND DRAIN

Invoice	Qty.	Description
2624 101,930 10Mar21	1	BACK FLOW PREVENTER VALVE

CROWN MOULDING

Invoice	Qty.	Description
2649 30Apr21 NoCat	1	MAIN HALL: MODEL OPTIONS 50.04 - FOYER - OPT. COFFERED CEILING, INCLUDING CIRCULAR COFFERED AS PER PLAN



CONSTRUCTION SUMMARY

Lot: 82
Model: 50.04 B BEAUMONT
Project/Phase: Pine Valley Forevergreen / 1

DRYWALL

Invoice	Qty.	Description
2624 72,351 10Mar21 **	5	BASEMENT WINDOWS - UPGRADE BASEMENT WINDOW SIZE TO 30 " X 24" - 8" FRAME
2649 101,930 30Apr21	1	**CUSTOM LAYOUT** GREAT ROOM: DELETE STANDARD FIREPLACE - INTERIOR WALL TO BE DRYWALLED, PAINTED AND STANDARD TRIM
2649 101,930 30Apr21	1	MASTER BEDROOM: INSTALL INSULATION FOR SOUND IN BETWEEN WALLS BACKING ONTO OTB AND UPPER HALLWAY
2649 72,567 30Apr21	2	MAIN HALL: MODEL OPTIONS 50.04 - FOYER - OPT. COFFERED CEILING, INCLUDING CIRCULAR COFFERED AS PER PLAN
2649 30Apr21 NoCat	1	MASTER ENSUITE + ENSUITE 2 + ENSUITE 3 + ENSUITE 4: SHOWER NICHE [SHAMPOO SHELF] - COMPLETE WITH MATCHING MARBLE JAMBS ON 4 SIDES, STANDARD TILE, APPROX. 12 X 18 INSTALLED VERTICALLY - SEE PLAN FOR LOCATION
2649 30Apr21 NoCat	1	**CUSTOM LAYOUT** MAIN HALL @ KITCHEN/BREAKFAST: EXTEND WALL FROM NICHE APPROX. 18-24" - TO BE APPROX. IN LINE AND/OR EQUAL TO WALL ACROSS AT BREAKFAST / GREAT ROOM - (AS PER MODEL HOME 92) - SEE PLAN
2649 30Apr21 NoCat	1	MAIN HALL: ACROSS FROM DINING ROOM - INSTALL A STANDARD SINGLE DOOR CLOSET (AS PER MODEL HOME 92) - SEE PLAN
2649 30Apr21 NoCat	1	LIBRARY: DELETE TWO STANDARD TRIMMED OPENINGS INTO DINING ROOM - INSTALL FULL HEIGHT WALLS
2649 30Apr21 NoCat	1	**CUSTOM LAYOUT** MUD ROOM: RELOCATE MAN DOOR AS PER PLAN - DELETE PARTIAL STANDARD UPPER AND BASE CABINETS TO ACCOMMODATE REVISION - INSTALL STANDARD UPPER AND BASE CABINETS TO ACCOMMODATE LAUNDRY TUB ONLY
2649 30Apr21 NoCat	1	**CUSTOM LAYOUT** MASTER ENSUITE: MOVE STANDARD VANITY APPROX. TWO FEET TOWARDS FREE STANDING TUB; DELETE NIB WALLS AND DOOR TO WATER CLOSET; RELOCATE TOILET TO WALL BACKING ONTO WIC; ADD COMPLETE BIDET BESIDE REVISED TOILET LOCATION... ...REVERSE DOOR SWING INTO MASTER ENSUITE TO ACCOMMODATE REVISION - SEE PLAN BASED ON STANDARD FINISHES
2649 30Apr21 NoCat	1	**CUSTOM LAYOUT** MAIN HALL @ KITCHEN/BREAKFAST: EXTEND WALL FROM NICHE APPROX. 18-24" - TO BE APPROX. IN LINE AND/OR EQUAL TO WALL ACROSS AT BREAKFAST / GREAT ROOM - (AS PER MODEL HOME 92) - SEE PLAN
2649 30Apr21 NoCat	1	KITCHEN: INSTALL COFFERED CEILING WITH COVE + ROPE LIGHT AND SWITCH (AS PER MODEL HOME 92) BEADBOARD AS SHOWN IN MODEL HOME NOT INCLUDED
2649 30Apr21 NoCat	1	**CUSTOM LAYOUT** DINING ROOM/SERVERY/KITCHEN: INSTALL FULL WALL IN LIEU OF TRIMMED OPENING BETWEEN SERVERY AND DINING ROOM - ENLARGE TRIMMED OPENING BETWEEN SERVERY AND KITCHEN - AS WIDE AS POSSIBLE



CONSTRUCTION SUMMARY

Lot: 82

Model: 50.04 B BEAUMONT

Project/Phase: Pine Valley Forevergreen / 1



CONSTRUCTION SUMMARY

Lot: 82
Model: 50.04 B BEAUMONT
Project/Phase: Pine Valley Forevergreen / 1

ELECTRICAL

Invoice	Qty.	Description
2624 72,351 10Mar21 **	5	BASEMENT WINDOWS - UPGRADE BASEMENT WINDOW SIZE TO 30 " X 24" - 8" FRAME
2649 72,292 30Apr21	1	FRONT EXTERIOR: ADDITIONAL EXTERIOR COACH LIGHT ON SAME SWITCH (BUILDERS STANDARD FIXTURE) - SEE PLAN ONE STANDARD, ONE ADDITIONAL
2649 72,307 30Apr21	1	DINING ROOM: RELOCATE STANDARD CEILING MOUNT FIXTURE APPROX. TWO FEET TOWARDS MAIN HALL - SEE PLAN
2649 72,268 30Apr21	2	GARAGE: INTERIOR WALL OUTLET: 110V WALL INTERIOR RECEPTACLE ON EXISTING CIRCUIT
2649 72,273 30Apr21	1	KITCHEN: 110V WALL RECEPTACLE ON SEPARATE CIRCUIT - GAS FIRED APPLIANCE - FOR AUX. EQUIPMENT - NOT A STOVE PLUG
2649 72,306 30Apr21	1	KITCHEN: RELOCATE FRIDGE FROM STANDARD LOCATION - APPROX. "NEW" LOCATION AS PER ATTACHED DRAWINGS
2649 72,269 30Apr21	1	KITCHEN: INTERIOR WALL OUTLET: 110V WALL INTERIOR RECEPTACLE ON SEPARATE CIRCUIT FOR FRIDGE/FREEZER
2649 72,289 30Apr21	3	SERVERY: 4" E/S LED INTERIOR POT LIGHT - GROUND FLOOR - EACH - INCLUDES ONE SWITCH - SEE PLAN INCLUDED IN APS - DELETE STANDARD CEILING LIGHT FIXTURE
2649 72,289 30Apr21	3	MAIN HALL: 4" E/S LED INTERIOR POT LIGHT - GROUND FLOOR - EACH - SEE PLAN INCLUDED IN APS - DELETE STANDARD CEILING LIGHT FIXTURE(S)
2649 72,307 30Apr21	1	KITCHEN: RELOCATE STANDARD CEILING MOUNT FIXTURE - APPROX. CENTRE ON CEILING ABOVE KITCHEN ISLAND
2649 72,301 30Apr21	1	LAUNDRY ROOM: ADDITIONAL 50CFM BATHROOM EXHAUST FAN COMPLETE WITH SWITCH
2649 72,279 30Apr21	1	MASTER ENSUITE: ADD SHOWER POT LIGHT: 6" RECESSED SHOWER POT LIGHT, SAME SWITCH AS STANDARD POT LIGHT
2649 72,307 30Apr21	1	MASTER ENSUITE: RELOCATE STANDARD RECESSED SHOWER POT LIGHT - SEE PLAN



CONSTRUCTION SUMMARY

Lot: 82
Model: 50.04 B BEAUMONT
Project/Phase: Pine Valley Forevergreen / 1

ELECTRICAL

Invoice	Qty.	Description
2649 72,272 30Apr21	1	KITCHEN: 110V WALL RECEPTACLE ON SEPARATE CIRCUIT - FOR MICROWAVE - MICROWAVE NOT INCLUDED
2649 101,930 30Apr21	1	MASTER ENSUITE: INSTALL ELECTRIC FLOOR HEATING - INCLUDES THERMOSTAT
2649 72,269 30Apr21	1	GREAT ROOM: INTERIOR WALL OUTLET: 110V WALL INTERIOR RECEPTACLE ON SEPARATE CIRCUIT
2649 72,269 30Apr21	1	LIBRARY: INTERIOR WALL OUTLET: 110V WALL INTERIOR RECEPTACLE ON SEPARATE CIRCUIT
2649 101,930 30Apr21	1	DINING ROOM: INSTALL COVE LIGHTING IN STANDARD COFFERED CEILING - SWITCH + ROPE LIGHT + COVE + REFLECTOR
2649 30Apr21 NoCat	1	**CUSTOM LAYOUT** GREAT ROOM: DELETE STANDARD FIREPLACE - INTERIOR WALL TO BE DRYWALLED, PAINTED AND STANDARD TRIM
2649 30Apr21 NoCat	1	**CUSTOM LAYOUT** MAIN HALL @ KITCHEN/BREAKFAST: EXTEND WALL FROM NICHE APPROX. 18-24" - TO BE APPROX. IN LINE AND/OR EQUAL TO WALL ACROSS AT BREAKFAST / GREAT ROOM - (AS PER MODEL HOME 92) - SEE PLAN
2649 30Apr21 NoCat	1	MAIN HALL: ACROSS FROM DINING ROOM - INSTALL A STANDARD SINGLE DOOR CLOSET (AS PER MODEL HOME 92) - SEE PLAN
2649 30Apr21 NoCat	1	LIBRARY: DELETE TWO STANDARD TRIMMED OPENINGS INTO DINING ROOM - INSTALL FULL HEIGHT WALLS
2649 30Apr21 NoCat	1	**CUSTOM LAYOUT** MUD ROOM: RELOCATE MAN DOOR AS PER PLAN - DELETE PARTIAL STANDARD UPPER AND BASE CABINETS TO ACCOMMODATE REVISION - INSTALL STANDARD UPPER AND BASE CABINETS TO ACCOMMODATE LAUNDRY TUB ONLY
2649 30Apr21 NoCat	1	**CUSTOM LAYOUT** MASTER ENSUITE: MOVE STANDARD VANITY APPROX. TWO FEET TOWARDS FREE STANDING TUB; DELETE NIB WALLS AND DOOR TO WATER CLOSET; RELOCATE TOILET TO WALL BACKING ONTO WIC; ADD COMPLETE BIDET BESIDE REVISED TOILET LOCATION... ...REVERSE DOOR SWING INTO MASTER ENSUITE TO ACCOMMODATE REVISION - SEE PLAN BASED ON STANDARD FINISHES
2649 30Apr21 NoCat	1	**CUSTOM LAYOUT** MAIN HALL @ KITCHEN/BREAKFAST: EXTEND WALL FROM NICHE APPROX. 18-24" - TO BE APPROX. IN LINE AND/OR EQUAL TO WALL ACROSS AT BREAKFAST / GREAT ROOM - (AS PER MODEL HOME 92) - SEE PLAN
2649 30Apr21 NoCat	1	KITCHEN: INSTALL COFFERED CEILING WITH COVE + ROPE LIGHT AND SWITCH (AS PER MODEL HOME 92) BEAD BOARD AS SHOWN IN MODEL HOME NOT INCLUDED



CONSTRUCTION SUMMARY

Lot: 82
Model: 50.04 B BEAUMONT
Project/Phase: Pine Valley Forevergreen / 1

ELECTRICAL

Invoice	Qty.	Description
2649 30Apr21 NoCat	1	MAIN HALL: MODEL OPTIONS 50.04 - FOYER - OPT. COFFERED CEILING, INCLUDING CIRCULAR COFFERED AS PER PLAN
2649 30Apr21 NoCat	1	**CUSTOM LAYOUT** DINING ROOM/SERVERY/KITCHEN: INSTALL FULL WALL IN LIEU OF TRIMMED OPENING BETWEEN SERVERY AND DINING ROOM - ENLARGE TRIMMED OPENING BETWEEN SERVERY AND KITCHEN - AS WIDE AS POSSIBLE

EXTERIOR COLOURS

Invoice	Qty.	Description
2624 10Mar21 NoCat	1	EXTERIOR COLOURS PACKAGE: BR5

FIREPLACE

Invoice	Qty.	Description
2649 30Apr21 NoCat	1	**CUSTOM LAYOUT** GREAT ROOM: DELETE STANDARD FIREPLACE - INTERIOR WALL TO BE DRYWALLED, PAINTED AND STANDARD TRIM

FORMING

Invoice	Qty.	Description
2624 72,560 10Mar21	1	MODEL OPTIONS 50.04 - KITCHEN REAR - OPT. COVERED LOGGIA AS PER PLAN
2649 101,930 30Apr21	-1	*** DELETE MODEL OPTIONS 50.04 - KITCHEN REAR - OPT. COVERED LOGGIA AS PER PLAN *** FROM INVOICE #2624



CONSTRUCTION SUMMARY

Lot: 82
Model: 50.04 B BEAUMONT
Project/Phase: Pine Valley Forevergreen / 1

FRAMING

Invoice	Qty.	Description
2649 72,631 30Apr21	4	MASTER ENSUITE + ENSUITE 2 + ENSUITE 3 + ENSUITE 4: SHOWER NICHE [SHAMPOO SHELF] - COMPLETE WITH MATCHING MARBLE JAMBS ON 4 SIDES, STANDARD TILE, APPROX. 12 X 18 INSTALLED VERTICALLY - SEE PLAN FOR LOCATION
2649 101,930 30Apr21	1	**CUSTOM LAYOUT** MAIN HALL @ KITCHEN/BREAKFAST: EXTEND WALL FROM NICHE APPROX. 18-24" - TO BE APPROX. IN LINE AND/OR EQUAL TO WALL ACROSS AT BREAKFAST / GREAT ROOM - (AS PER MODEL HOME 92) - SEE PLAN
2649 101,930 30Apr21	1	LIBRARY: DELETE TWO STANDARD TRIMMED OPENINGS INTO DINING ROOM - INSTALL FULL HEIGHT WALLS
2649 101,930 30Apr21	1	**CUSTOM LAYOUT** MUD ROOM: RELOCATE MAN DOOR AS PER PLAN - DELETE PARTIAL STANDARD UPPER AND BASE CABINETS TO ACCOMMODATE REVISION - INSTALL STANDARD UPPER AND BASE CABINETS TO ACCOMMODATE LAUNDRY TUB ONLY
2649 101,930 30Apr21	1	KITCHEN: INSTALL COFFERED CEILING WITH COVE + ROPE LIGHT AND SWITCH (AS PER MODEL HOME 92) DOESN'T INCLUDE BEAD-BOARD ON CEILING
2649 101,930 30Apr21	1	**CUSTOM LAYOUT** DINING ROOM/SERVERY/KITCHEN: INSTALL FULL WALL IN LIEU OF TRIMMED OPENING BETWEEN SERVERY AND DINING ROOM - ENLARGE TRIMMED OPENING BETWEEN SERVERY AND KITCHEN - AS WIDE AS POSSIBLE
2649 30Apr21 NoCat	1	FRONT EXTERIOR: ADDITIONAL EXTERIOR COACH LIGHT ON SAME SWITCH (BUILDERS STANDARD FIXTURE) - SEE PLAN
2649 30Apr21 NoCat	1	**CUSTOM LAYOUT** GREAT ROOM: DELETE STANDARD FIREPLACE - INTERIOR WALL TO BE DRYWALLED, PAINTED AND STANDARD TRIM
2649 30Apr21 NoCat	1	**CUSTOM LAYOUT** MASTER ENSUITE: MOVE STANDARD VANITY APPROX. TWO FEET TOWARDS FREE STANDING TUB; DELETE NIB WALLS AND DOOR TO WATER CLOSET; RELOCATE TOILET TO WALL BACKING ONTO WIC; ADD COMPLETE BIDET BESIDE REVISED TOILET LOCATION... ...REVERSE DOOR SWING INTO MASTER ENSUITE TO ACCOMMODATE REVISION - SEE PLAN BASED ON STANDARD FINISHES
2649 30Apr21 NoCat	1	MAIN HALL: MODEL OPTIONS 50.04 - FOYER - OPT. COFFERED CEILING, INCLUDING CIRCULAR COFFERED AS PER PLAN

HARDWOOD

Invoice	Qty.	Description
2649 30Apr21 NoCat	1	MAIN HALL: ACROSS FROM DINING ROOM - INSTALL A STANDARD SINGLE DOOR CLOSET (AS PER MODEL HOME 92) - SEE PLAN
2649 30Apr21 NoCat	1	**CUSTOM LAYOUT** MAIN HALL @ KITCHEN/BREAKFAST: EXTEND WALL FROM NICHE APPROX. 18-24" - TO BE APPROX. IN LINE AND/OR EQUAL TO WALL ACROSS AT BREAKFAST / GREAT ROOM - (AS PER MODEL HOME 92) - SEE PLAN



CONSTRUCTION SUMMARY

Lot: 82
Model: 50.04 B BEAUMONT
Project/Phase: Pine Valley Forevergreen / 1

HVAC

Invoice	Qty.	Description
2649 72,224 30Apr21	1	KITCHEN: GAS LINE ROUGH-IN - MAIN FLOOR FOR APPLIANCE - SEE PLAN FOR APPROX. LOCATION FINAL LOCATION, ORIENTATION, AND CONNECTION IS TO BE COMPLETED BY A LICENSED GAS FITTER AND ARRANGED BY THE HOME OWNER AFTER CLOSING
2649 72,217 30Apr21	1	KITCHEN: UPGRADE TO 8" DUCT (EXTERIOR WALL) IN LIEU OF STANDARD OFFERING
2649 72,221 30Apr21	1	BASEMENT: INCREASE MAIN GAS LINE
2649 30Apr21 NoCat	1	**CUSTOM LAYOUT** GREAT ROOM: DELETE STANDARD FIREPLACE - INTERIOR WALL TO BE DRYWALLED, PAINTED AND STANDARD TRIM

INTERIOR TRIM /MOULDINGS

Invoice	Qty.	Description
2624 72,351 10Mar21 **	5	BASEMENT WINDOWS - UPGRADE BASEMENT WINDOW SIZE TO 30 " X 24" - 8" FRAME

INTERIOR TRIM AND DOORS

Invoice	Qty.	Description
2649 101,930 30Apr21	1	MAIN HALL: ACROSS FROM DINING ROOM - INSTALL A STANDARD SINGLE DOOR CLOSET (AS PER MODEL HOME 92) - SEE PLAN



CONSTRUCTION SUMMARY

Lot: 82
Model: 50.04 B BEAUMONT
Project/Phase: Pine Valley Forevergreen / 1

INTERIOR TRIM AND DOORS

Invoice	Qty.	Description
2649 30Apr21 NoCat	1	**CUSTOM LAYOUT** GREAT ROOM: DELETE STANDARD FIREPLACE - INTERIOR WALL TO BE DRYWALLED, PAINTED AND STANDARD TRIM
2649 30Apr21 NoCat	1	**CUSTOM LAYOUT** MAIN HALL @ KITCHEN/BREAKFAST: EXTEND WALL FROM NICHE APPROX. 18-24" - TO BE APPROX. IN LINE AND/OR EQUAL TO WALL ACROSS AT BREAKFAST / GREAT ROOM - (AS PER MODEL HOME 92) - SEE PLAN
2649 30Apr21 NoCat	1	MAIN HALL: ACROSS FROM DINING ROOM - INSTALL A STANDARD SINGLE DOOR CLOSET (AS PER MODEL HOME 92) - SEE PLAN
2649 30Apr21 NoCat	1	LIBRARY: DELETE TWO STANDARD TRIMMED OPENINGS INTO DINING ROOM - INSTALL FULL HEIGHT WALLS
2649 30Apr21 NoCat	1	**CUSTOM LAYOUT** MASTER ENSUITE: MOVE STANDARD VANITY APPROX. TWO FEET TOWARDS FREE STANDING TUB; DELETE NIB WALLS AND DOOR TO WATER CLOSET; RELOCATE TOILET TO WALL BACKING ONTO WIC; ADD COMPLETE BIDET BESIDE REVISED TOILET LOCATION... ...REVERSE DOOR SWING INTO MASTER ENSUITE TO ACCOMMODATE REVISION - SEE PLAN BASED ON STANDARD FINISHES
2649 30Apr21 NoCat	1	**CUSTOM LAYOUT** MAIN HALL @ KITCHEN/BREAKFAST: EXTEND WALL FROM NICHE APPROX. 18-24" - TO BE APPROX. IN LINE AND/OR EQUAL TO WALL ACROSS AT BREAKFAST / GREAT ROOM - (AS PER MODEL HOME 92) - SEE PLAN
2649 30Apr21 NoCat	1	**CUSTOM LAYOUT** DINING ROOM/SERVERY/KITCHEN: INSTALL FULL WALL IN LIEU OF TRIMMED OPENING BETWEEN SERVERY AND DINING ROOM - ENLARGE TRIMMED OPENING BETWEEN SERVERY AND KITCHEN - AS WIDE AS POSSIBLE

KITCHEN AND BATH CABINETRY

Invoice	Qty.	Description
2649 30Apr21 NoCat	1	**CUSTOM LAYOUT** MUD ROOM: RELOCATE MAN DOOR AS PER PLAN - DELETE PARTIAL STANDARD UPPER AND BASE CABINETS TO ACCOMMODATE REVISION - INSTALL STANDARD UPPER AND BASE CABINETS TO ACCOMMODATE LAUNDRY TUB ONLY
2649 30Apr21 NoCat	1	**CUSTOM LAYOUT** MASTER ENSUITE: MOVE STANDARD VANITY APPROX. TWO FEET TOWARDS FREE STANDING TUB; DELETE NIB WALLS AND DOOR TO WATER CLOSET; RELOCATE TOILET TO WALL BACKING ONTO WIC; ADD COMPLETE BIDET BESIDE REVISED TOILET LOCATION... ...REVERSE DOOR SWING INTO MASTER ENSUITE TO ACCOMMODATE REVISION - SEE PLAN BASED ON STANDARD FINISHES

MASONRY

Invoice	Qty.	Description
2649 30Apr21 NoCat	1	FRONT EXTERIOR: ADDITIONAL EXTERIOR COACH LIGHT ON SAME SWITCH (BUILDERS STANDARD FIXTURE) - SEE PLAN One Standard + One Additional
2649 30Apr21 NoCat	1	**CUSTOM LAYOUT** MUD ROOM: RELOCATE MAN DOOR AS PER PLAN - DELETE PARTIAL STANDARD UPPER AND BASE CABINETS TO ACCOMMODATE REVISION - INSTALL STANDARD UPPER AND BASE CABINETS TO ACCOMMODATE LAUNDRY TUB ONLY



CONSTRUCTION SUMMARY

Lot: 82
Model: 50.04 B BEAUMONT
Project/Phase: Pine Valley Forevergreen / 1

NETWORK AND WIRING

Invoice	Qty.	Description
2649 72,258 30Apr21	1	LIBRARY: ADDITIONAL CAT6 ETHERNET OUTLET - EACH - SEE PLAN
2649 72,258 30Apr21	1	BEDROOM 5: ADDITIONAL CAT6 ETHERNET OUTLET - EACH - SEE PLAN
2649 72,260 30Apr21	1	CONDUIT PIPE - FROM ATTIC TO BASEMENT - BY ELECTRICAL PANEL IN BASEMENT TO APPROX. CENTRE IN ATTIC

PAINT

Invoice	Qty.	Description
2649 30Apr21 NoCat	1	**CUSTOM LAYOUT** GREAT ROOM: DELETE STANDARD FIREPLACE - INTERIOR WALL TO BE DRYWALLED, PAINTED AND STANDARD TRIM
2649 30Apr21 NoCat	1	**CUSTOM LAYOUT** MAIN HALL @ KITCHEN/BREAKFAST: EXTEND WALL FROM NICHE APPROX. 18-24" - TO BE APPROX. IN LINE AND/OR EQUAL TO WALL ACROSS AT BREAKFAST / GREAT ROOM - (AS PER MODEL HOME 92) - SEE PLAN
2649 30Apr21 NoCat	1	MAIN HALL: ACROSS FROM DINING ROOM - INSTALL A STANDARD SINGLE DOOR CLOSET (AS PER MODEL HOME 92) - SEE PLAN
2649 30Apr21 NoCat	1	LIBRARY: DELETE TWO STANDARD TRIMMED OPENINGS INTO DINING ROOM - INSTALL FULL HEIGHT WALLS
2649 30Apr21 NoCat	1	**CUSTOM LAYOUT** MASTER ENSUITE: MOVE STANDARD VANITY APPROX. TWO FEET TOWARDS FREE STANDING TUB; DELETE NIB WALLS AND DOOR TO WATER CLOSET; RELOCATE TOILET TO WALL BACKING ONTO WIC; ADD COMPLETE BIDET BESIDE REVISED TOILET LOCATION... ...REVERSE DOOR SWING INTO MASTER ENSUITE TO ACCOMMODATE REVISION - SEE PLAN BASED ON STANDARD FINISHES
2649 30Apr21 NoCat	1	**CUSTOM LAYOUT** MAIN HALL @ KITCHEN/BREAKFAST: EXTEND WALL FROM NICHE APPROX. 18-24" - TO BE APPROX. IN LINE AND/OR EQUAL TO WALL ACROSS AT BREAKFAST / GREAT ROOM - (AS PER MODEL HOME 92) - SEE PLAN
2649 30Apr21 NoCat	1	KITCHEN: INSTALL COFFERED CEILING WITH COVE + ROPE LIGHT AND SWITCH (AS PER MODEL HOME 92) BEAD BOARD AS SHOWN IN MODEL HOME NOT INCLUDED
2649 30Apr21 NoCat	1	MAIN HALL: MODEL OPTIONS 50.04 - FOYER - OPT. COFFERED CEILING, INCLUDING CIRCULAR COFFERED AS PER PLAN
2649 30Apr21 NoCat	1	**CUSTOM LAYOUT** DINING ROOM/SERVERY/KITCHEN: INSTALL FULL WALL IN LIEU OF TRIMMED OPENING BETWEEN SERVERY AND DINING ROOM - ENLARGE TRIMMED OPENING BETWEEN SERVERY AND KITCHEN - AS WIDE AS POSSIBLE



CONSTRUCTION SUMMARY

Lot: 82
Model: 50.04 B BEAUMONT
Project/Phase: Pine Valley Forevergreen / 1

PLUMBING

Invoice	Qty.	Description
2649 72,332 30Apr21	1	KITCHEN: ROUGH-IN 1/4" COLD WATER LINE TO FRIDGE
2649 101,930 30Apr21	1	**CUSTOM LAYOUT** MASTER ENSUITE: MOVE STANDARD VANITY APPROX. TWO FEET TOWARDS FREE STANDING TUB; DELETE NIB WALLS AND DOOR TO WATER CLOSET; RELOCATE TOILET TO WALL BACKING ONTO WIC; ADD COMPLETE BIDET BESIDE REVISED TOILET LOCATION... ...REVERSE DOOR SWING INTO MASTER ENSUITE TO ACCOMMODATE REVISION - SEE PLAN BASED ON STANDARD FINISHES
2649 75,845 30Apr21	1	MASTER ENSUITE: UPGRADE SHOWER FAUCET TO MOEN 90 DEGREE VERTICAL SPA WITH 4 BODY JETS - CHROME
2649 75,845 30Apr21	2	MASTER ENSUITE: INSTALL UPGRADE VANITY FAUCET TO MOEN VIA SINGLE HOLE / HANDLE - CHROME
2649 72,347 30Apr21	1	MASTER ENSUITE: 3/4" WATER SUPPLY LINE TO ENSUITE SHOWER IN LIEU OF STANDARD
2649 30Apr21 NoCat	1	**CUSTOM LAYOUT** MUD ROOM: RELOCATE MAN DOOR AS PER PLAN - DELETE PARTIAL STANDARD UPPER AND BASE CABINETS TO ACCOMMODATE REVISION - INSTALL STANDARD UPPER AND BASE CABINETS TO ACCOMMODATE LAUNDRY TUB ONLY



CONSTRUCTION SUMMARY

Lot: 82
Model: 50.04 B BEAUMONT
Project/Phase: Pine Valley Forevergreen / 1

WINDOWS AND DOORS

Invoice	Qty.	Description
2649 30Apr21 NoCat	1	**CUSTOM LAYOUT** MUD ROOM: RELOCATE MAN DOOR AS PER PLAN - DELETE PARTIAL STANDARD UPPER AND BASE CABINETS TO ACCOMMODATE REVISION - INSTALL STANDARD UPPER AND BASE CABINETS TO ACCOMMODATE LAUNDRY TUB ONLY

SCHEDULE 'F'



PV-82. attached
March 5 2021

PV-82 ~~attach~~
April 28, 2021

The Beaumont 50' SERIES

Elevation A • 4,170 sq.ft.
4,315 sq.ft. Opt. Elevator

→ Elevation B • 4,165 sq.ft.
4,315 sq.ft. Opt. Elevator

Elevation C • 4,250 sq.ft.
4,400 sq.ft. Opt. Elevator

REVISED
April 28, 2021

~~YES!~~
DELETED!

COFFERED CEILING
w/ COVE LIGHTING

GAS + ELECT.
8" DUCT

WIDEN OPENING
TO APPROX. 36"


DELETE OPENING
ADD FULL WALL

EXTEND WALL

COFFER w/ COVE LIGHTING

DELETE OPENINGS
ADD FULL WALL

ONE STANDARD +
ONE ADDITIONAL

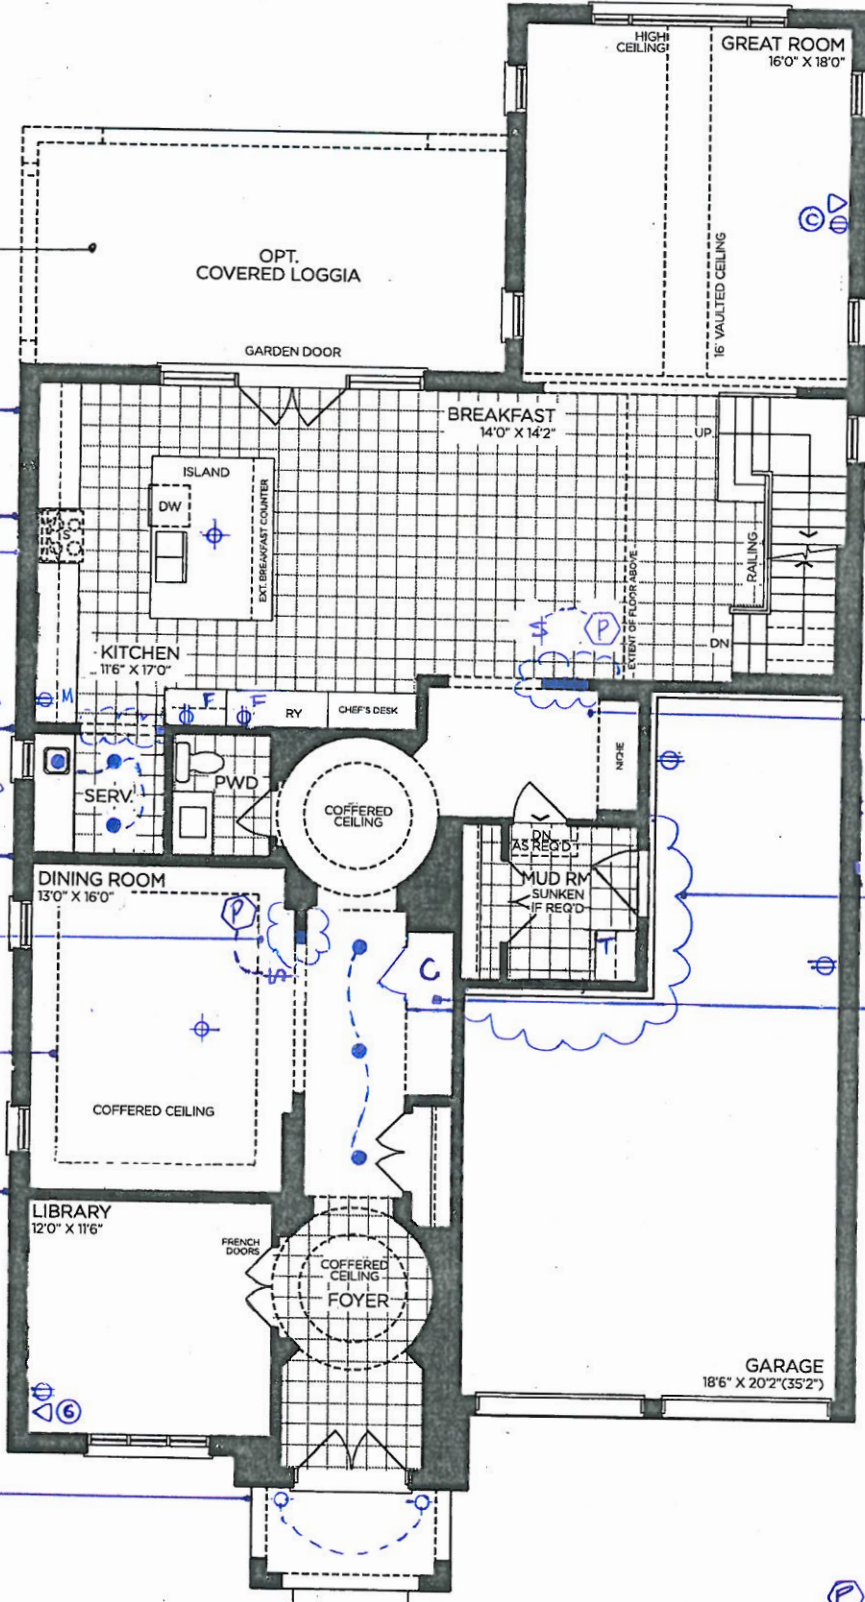

GROUND FLOOR | ELEV. A

P-COVE LIGHTING
(ROPE)

VENDOR	
PURCHASER	
PURCHASER	

GOLDPARK
WORTH MORE™

Prices, figures, illustrations, sizes, features and finishes are subject to change without notice. Areas and dimensions are approximate and actual usable floor space may vary from the stated area. Layout may be reverse of the unit purchased. E. & O.E. 5004



SCHEDULE 'F'
attached
PV-82
MARCH 5 2021

PV-82 attached
April 28, 2021

The Beaumont


50' SERIES

Elevation A • 4,170 sq.ft.
4,315 sq.ft. Opt. Elevator

→ Elevation B • 4,165 sq.ft.
4,315 sq.ft. Opt. Elevator

Elevation C • 4,250 sq.ft.
4,400 sq.ft. Opt. Elevator

REVISED LAYOUT

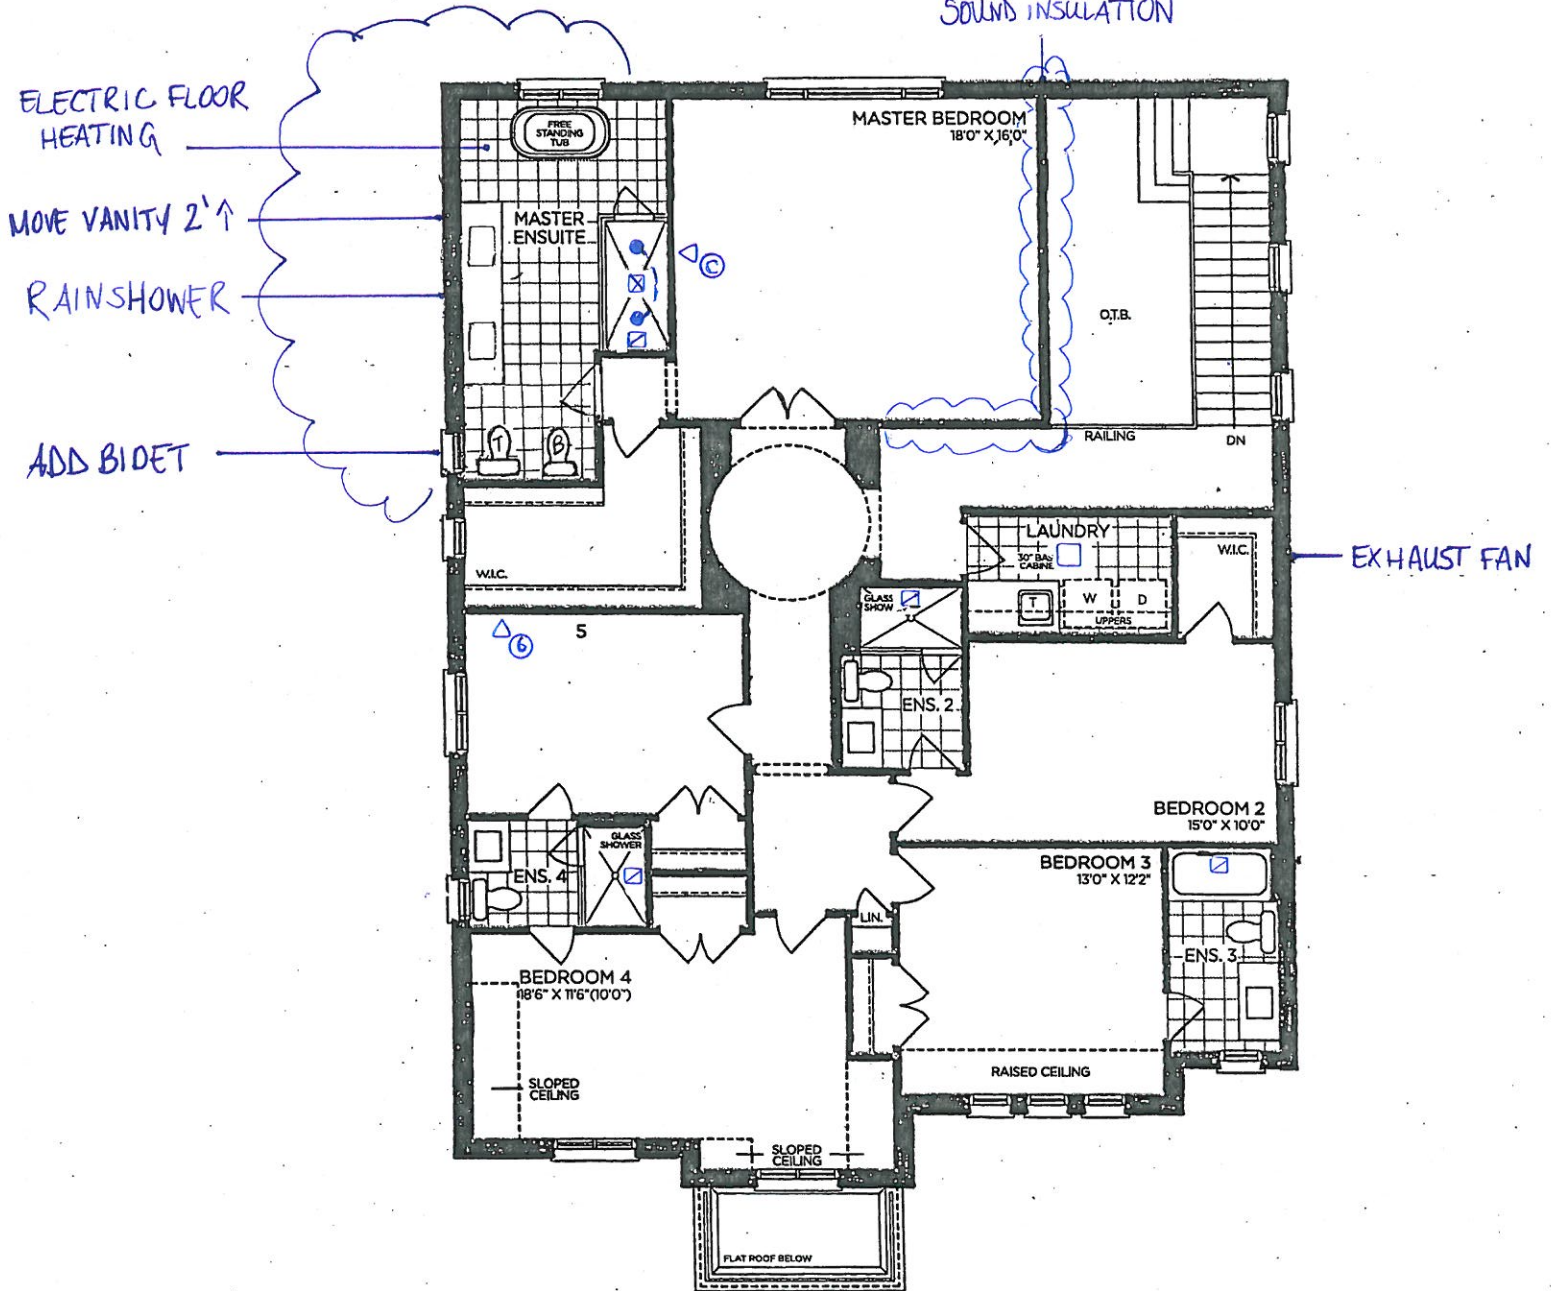

OPT. SECOND FLOOR | ELEV. A
5 BEDROOM

VENDOR	
PURCHASER	
PURCHASER	

GOLDPARK
WORTH MORE™

Prices, figures, illustrations, sizes, features and finishes are subject to change without notice. Areas and dimensions are approximate and actual usable floor space may vary from the stated area. Layout may be reverse of the unit purchased. E. & O.E. 5004



PV-82
March 5 2021
PV-82
April 28, 2021

SCHEDULE 'F'

attached

The Beaumont

50' SERIES

Elevation A • 4,170 sq.ft.


4,315 sq.ft. Opt. Elevator

→ Elevation B • 4,165 sq.ft.


4,315 sq.ft. Opt. Elevator

Elevation C • 4,250 sq.ft.


4,400 sq.ft. Opt. Elevator

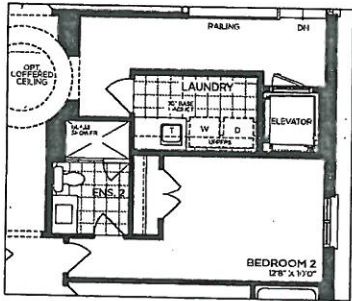


OPT. PART. SECOND FLOOR | ELEV. A
(ELEVATOR)

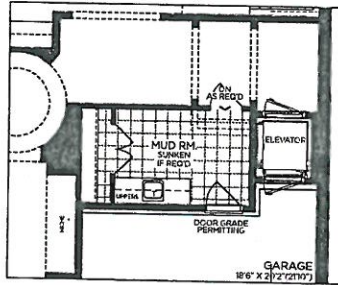


OPT. GROUND FLOOR | ELEV. A
(ELEVATOR)

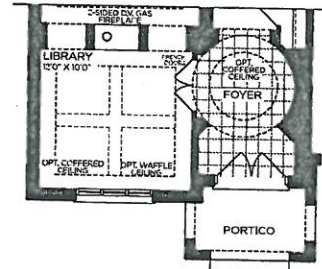


PART. OPT. LIBRARY GROUND FLOOR
ELEV. A, B & C

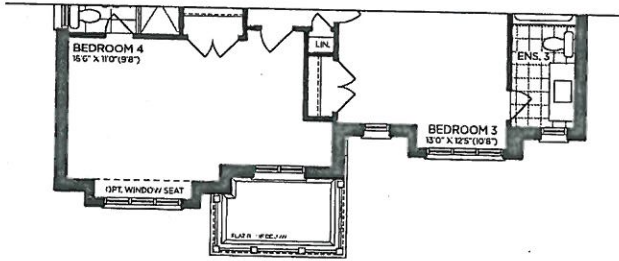


→ PART. OPT. SECOND FLOOR | ELEV. B
5 BEDROOM

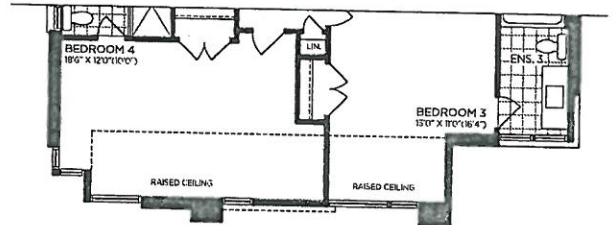


PART. OPT. SECOND FLOOR | ELEV. C
5 BEDROOM

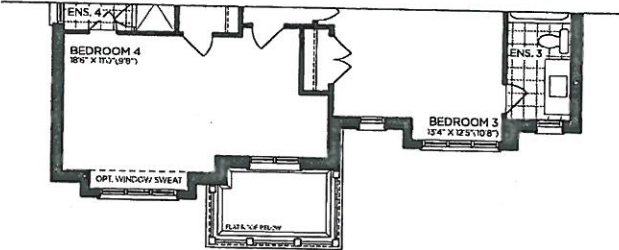


→ PART. SECOND FLOOR | ELEV. B

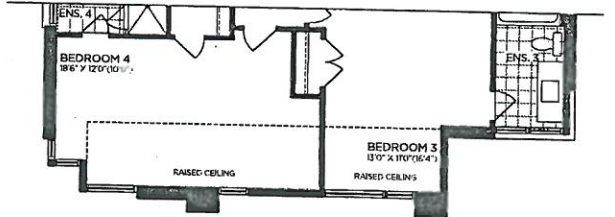


PART. SECOND FLOOR | ELEV. C

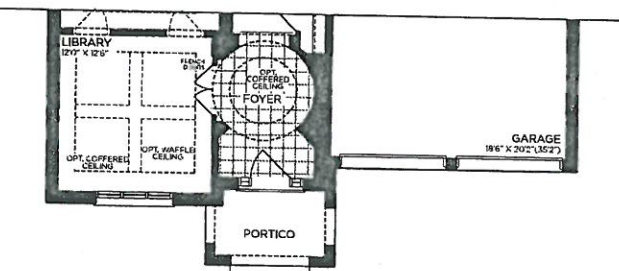


→ PART. GROUND FLOOR | ELEV. B

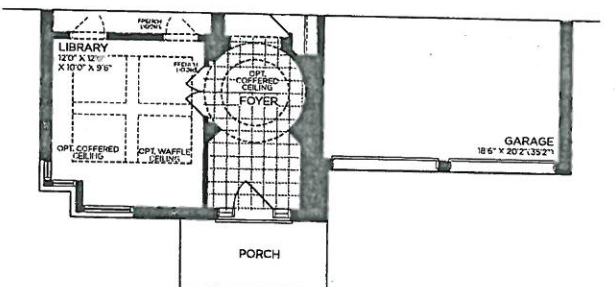


PART. GROUND FLOOR | ELEV. C

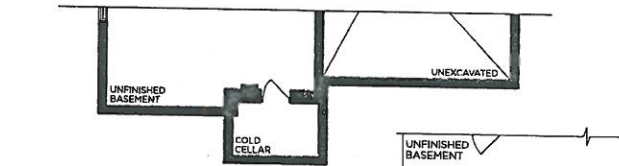

→ PART. BASEMENT | ELEV. B

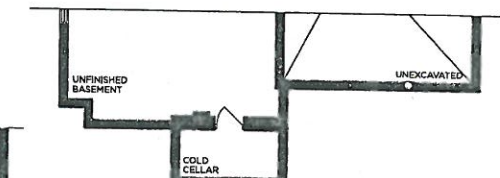

PART. BASEMENT | ELEV. C

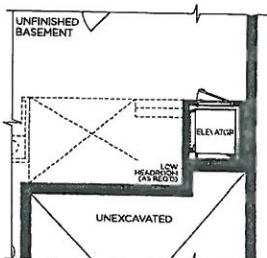

OPT. BASEMENT | ELEV. A
(ELEVATOR)

VENDOR

PURCHASER

PURCHASER

GOLDPARK
WORTH MORE™

Prices, figures, illustrations, sizes, features and finishes are subject to change without notice. Areas and dimensions are approximate and actual usable floor space may vary from the stated area. Layout may be reverse of the unit purchased. E. & O.E. 5004



SCHEDULE 'F'

PV-82 attached
March 5 2021

PV-82 ~~attach~~
April 28, 2021

The Beaumont


50' SERIES

Elevation A • 4,170 sq.ft.
4,315 sq.ft. Opt. Elevator

→ Elevation B • 4,165 sq.ft.
4,315 sq.ft. Opt. Elevator

Elevation C • 4,250 sq.ft.
4,400 sq.ft. Opt. Elevator

24x30"

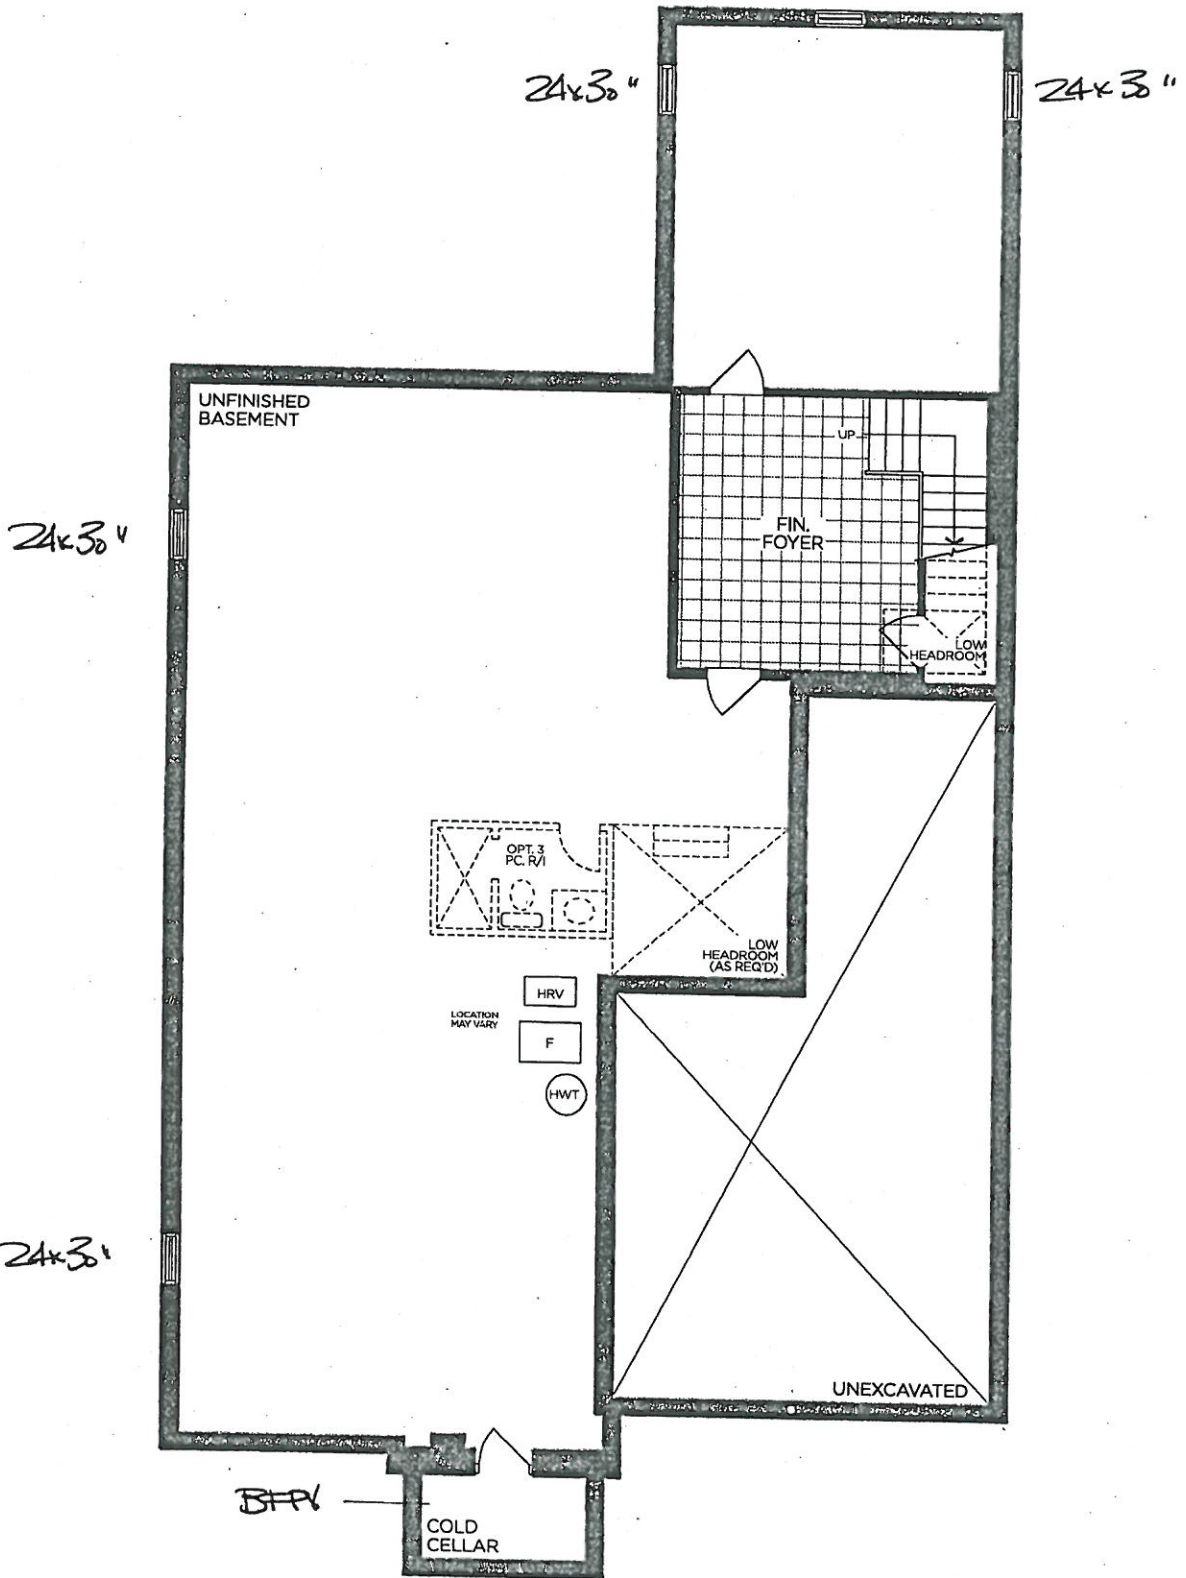

BASEMENT | ELEV. A

VENDOR

PURCHASER

PURCHASER



GOLDPARK
WORTH MORE™

Prices, figures, illustrations, sizes, features and finishes are subject to change without notice. Areas and dimensions are approximate and actual usable floor space may vary from the stated area. Layout may be reverse of the unit purchased. E. & O.E. 5004

PLUMBING UPGRADES

MOEN - VIA


Single-Handle Lav Faucet with Lift Rod Drain

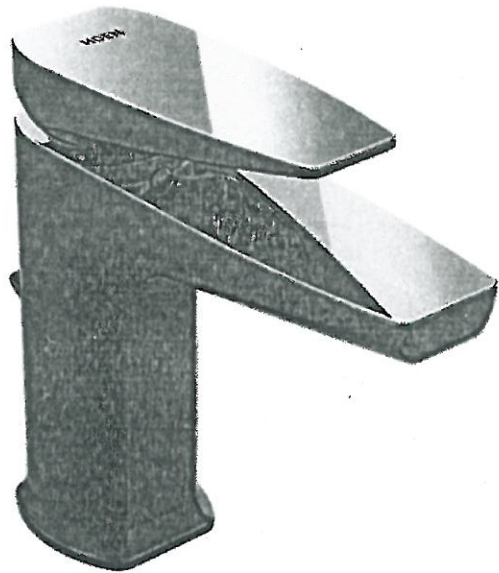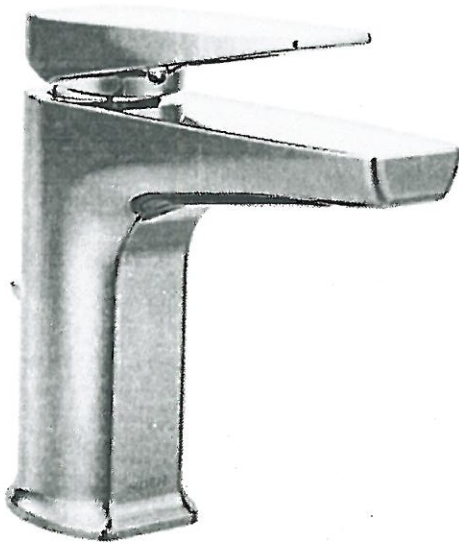

☒ CHROME

☐ BLACK / CHROME (BLC)


MODEL: S8000

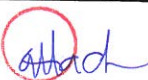Lot# PV-82	Date: Apr. 28, 2021	Room: Master Ensuite x2
Signature: 		
Signature:		

PLUMBING UPGRADES

MOEN - 90 DEGREE

Exact Temp 3/4" Thermostatic Vertical Spray Spa with 4 Body Sprays

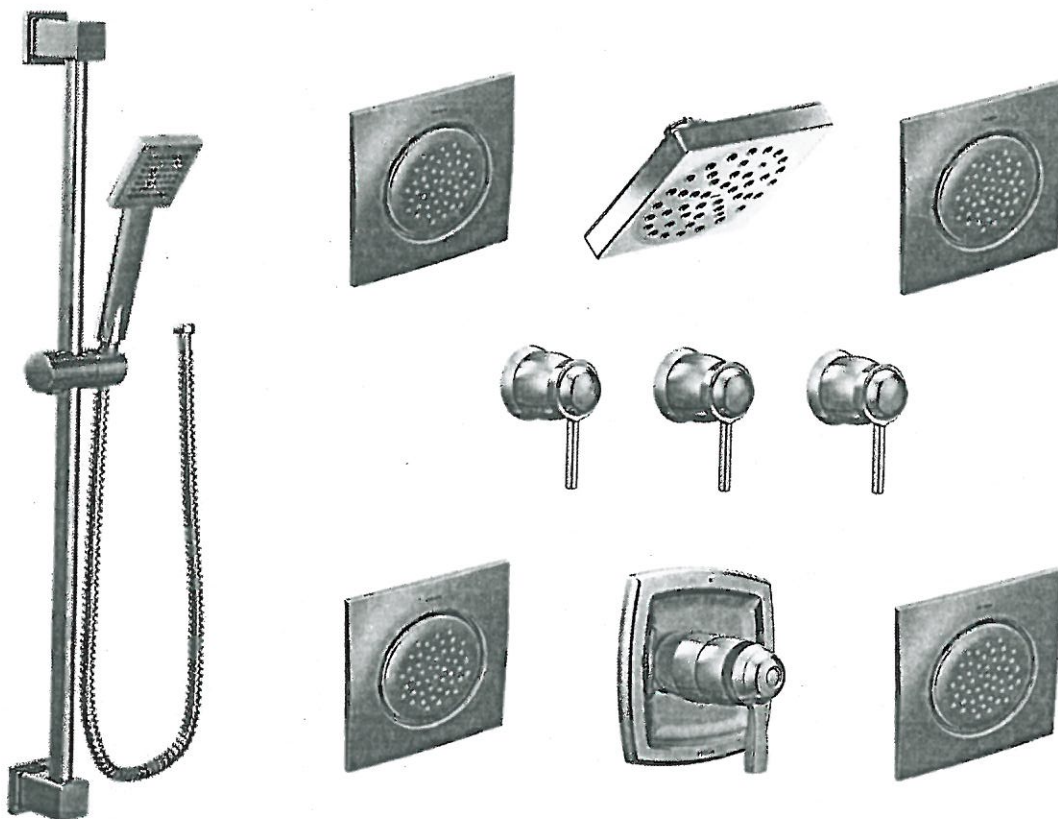


☒ CHROME

☐ BRUSHED NICKEL (BN)

*from ceiling

MODEL: TS3100 / S6340EP / S133 / S3600 (x3) / S3371 / TS3300 (x3) / S3879EP / A721 / S1300 (x4) / TS1320 (x4) / 226651

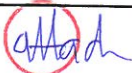Lot# PV- 82	Date: Apr. 28, 2021	Room: Master Ensuite
Signature: 		
Signature:		


SCHEDULE 'F'



PV-82. attached
March 5 2021
PV-82 ~~FILE~~
April 28, 2021

The Beaumont 50' SERIES

Elevation A • 4,170 sq.ft.
4,315 sq.ft. Opt. Elevator
→ Elevation B • 4,165 sq.ft.
4,315 sq.ft. Opt. Elevator
Elevation C • 4,250 sq.ft.
4,400 sq.ft. Opt. Elevator

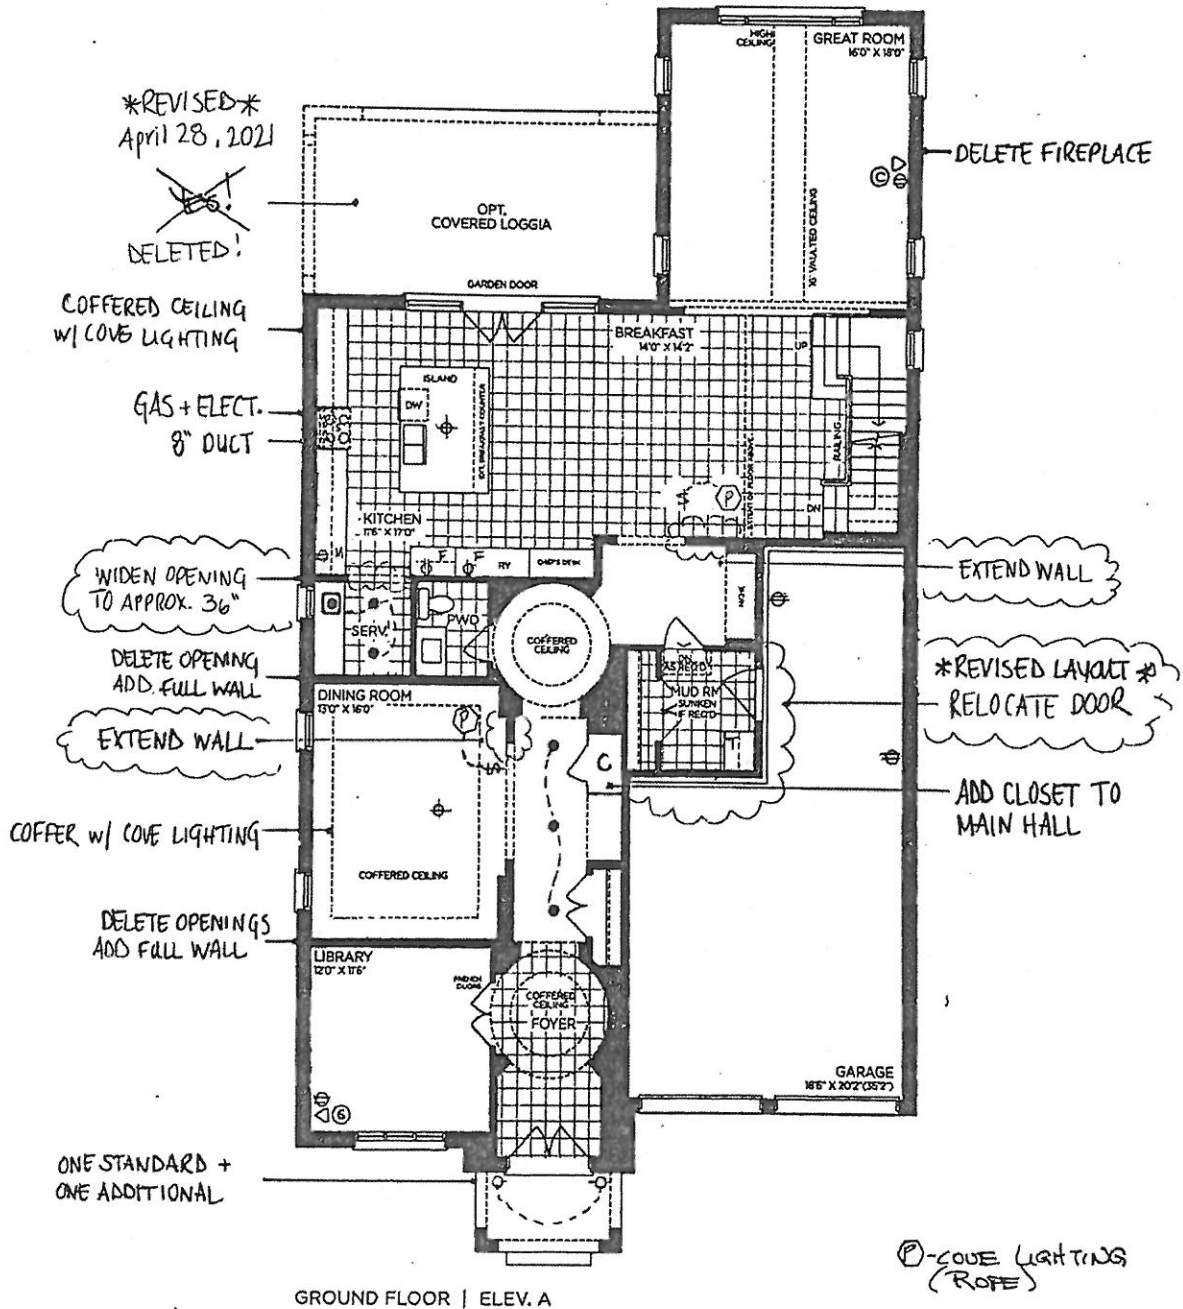

GROUND FLOOR | ELEV. A

VENDOR	
PURCHASER	
PURCHASER	

GOLDPARK
WORTH MORE™


Prices, figures, illustrations, sizes, features and finishes are subject to change without notice. Areas and dimensions are approximate and actual usable floor space may vary from the stated area. Layout may be reverse of the unit purchased. E. & Q.E. 5004



SCHEDULE 'F'
attached
PV-82
March 5 2021
PV-82
April 28, 2021

The Beaumont 50' SERIES

Elevation A • 4,170 sq.ft.
4,315 sq.ft. Opt. Elevator
Elevation B • 4,165 sq.ft.
4,315 sq.ft. Opt. Elevator
Elevation C • 4,250 sq.ft.
4,400 sq.ft. Opt. Elevator

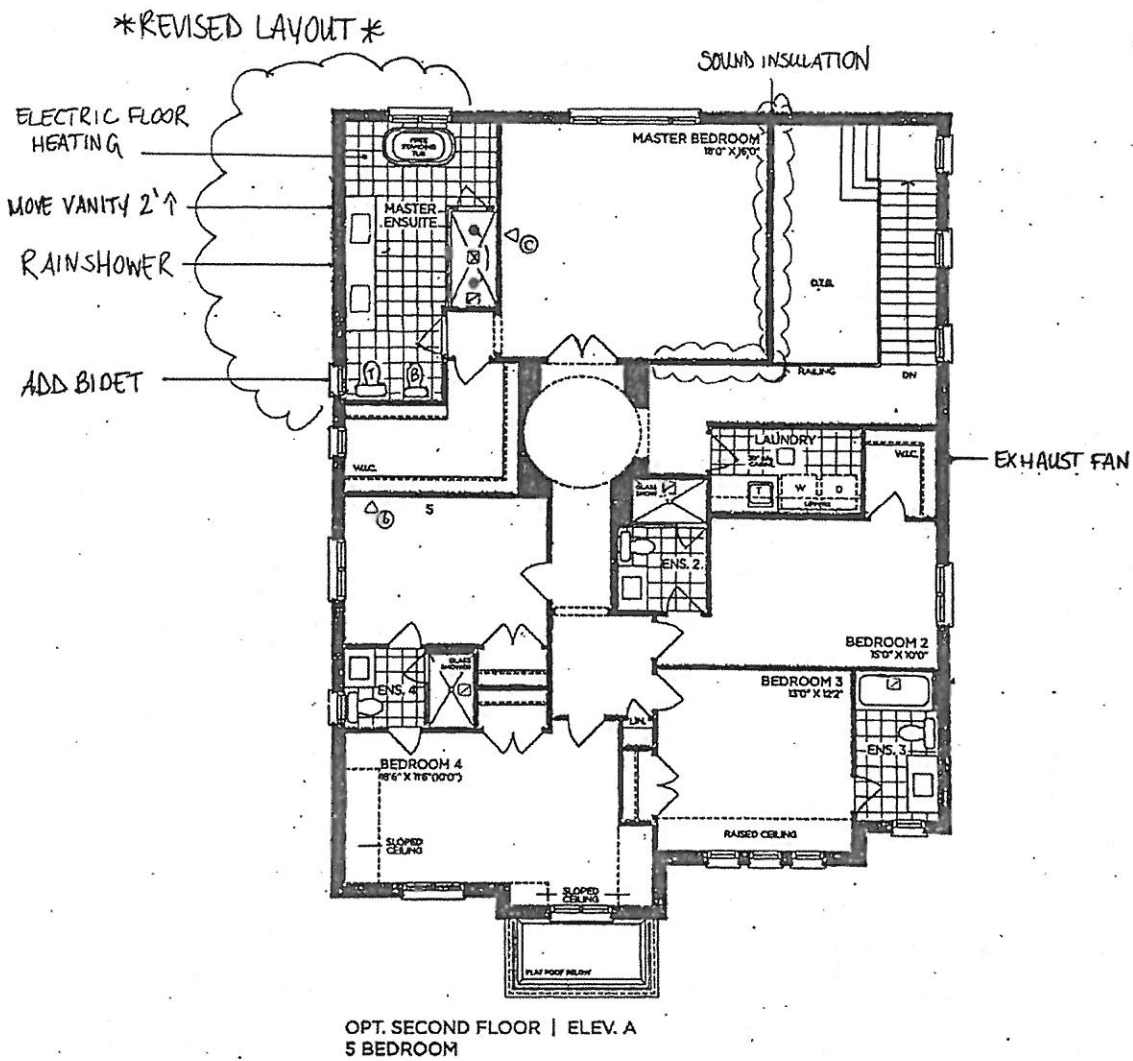

VENDOR
PURCHASER
PURCHASER

GOLDPARK
WORTH MORE™


Prices, figures, illustrations, sizes, features and finishes are subject to change without notice. Areas and dimensions are approximate and actual usable floor space may vary from the stated area. Layout may be reverse of the unit purchased. E & O.E. 5004




SCHEDULE 'F'
attached
PV-82
March 5, 2021
PV-82
April 28, 2021

The Beaumont 50' SERIES


Elevation A • 4,170 sq.ft.
4,315 sq.ft. Opt. Elevator
→ Elevation B • 4,165 sq.ft.
4,315 sq.ft. Opt. Elevator
Elevation C • 4,250 sq.ft.
4,400 sq.ft. Opt. Elevator

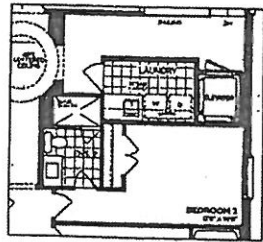


OPT. PART. SECOND FLOOR | ELEV. A
(ELEVATOR)

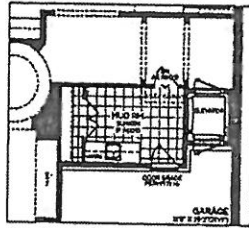


OPT. GROUND FLOOR | ELEV. A
(ELEVATOR)

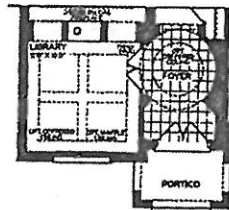


PART. OPT. LIBRARY GROUND FLOOR
ELEV. A, B & C

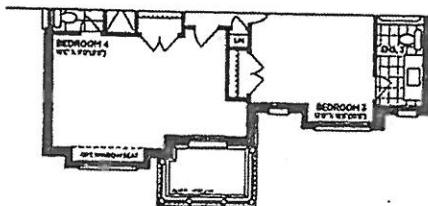


→ PART. OPT. SECOND FLOOR | ELEV. B
5 BEDROOM

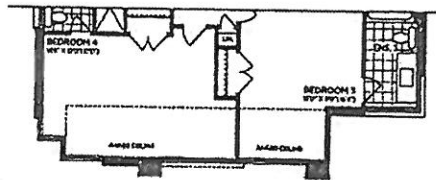


PART. OPT. SECOND FLOOR | ELEV. C
5 BEDROOM

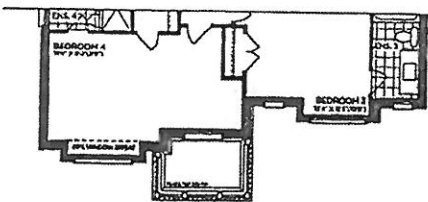


→ PART. SECOND FLOOR | ELEV. B

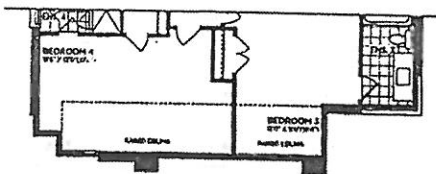


PART. SECOND FLOOR | ELEV. C

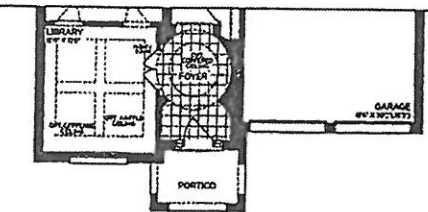


→ PART. GROUND FLOOR | ELEV. B

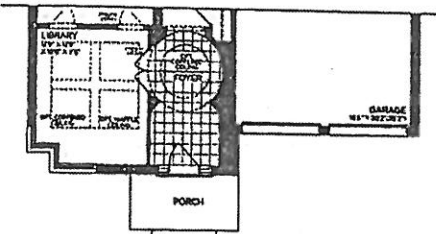


PART. GROUND FLOOR | ELEV. C

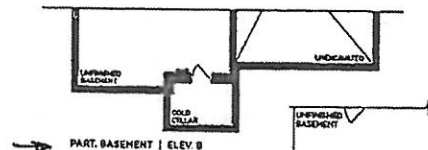

→ PART. BASEMENT | ELEV. B

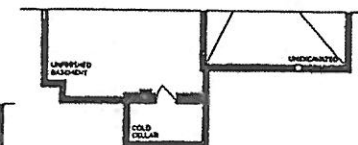

PART. BASEMENT | ELEV. C

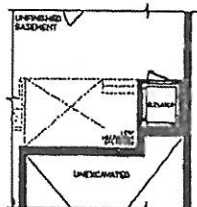

OPT. BASEMENT | ELEV. A
(ELEVATOR)

VENDOR
PURCHASER
PURCHASER

GOLDPARK
WORTH MORE™

Prices, figures, illustrations, sizes, features and finishes are subject to change without notice. Areas and dimensions are approximate and actual usable floor space may vary from the stated area. Layout may be reverse of the unit purchased. E. & O.E. 5004

SCHEDULE 'F'




PV-82 attached
March 5 2021

PV-82
April 28, 2021

The Beaumont 50' SERIES

Elevation A • 4,170 sq.ft.
4,315 sq.ft. Opt. Elevator
→ Elevation B • 4,165 sq.ft.
4,315 sq.ft. Opt. Elevator
Elevation C • 4,250 sq.ft.
4,400 sq.ft. Opt. Elevator

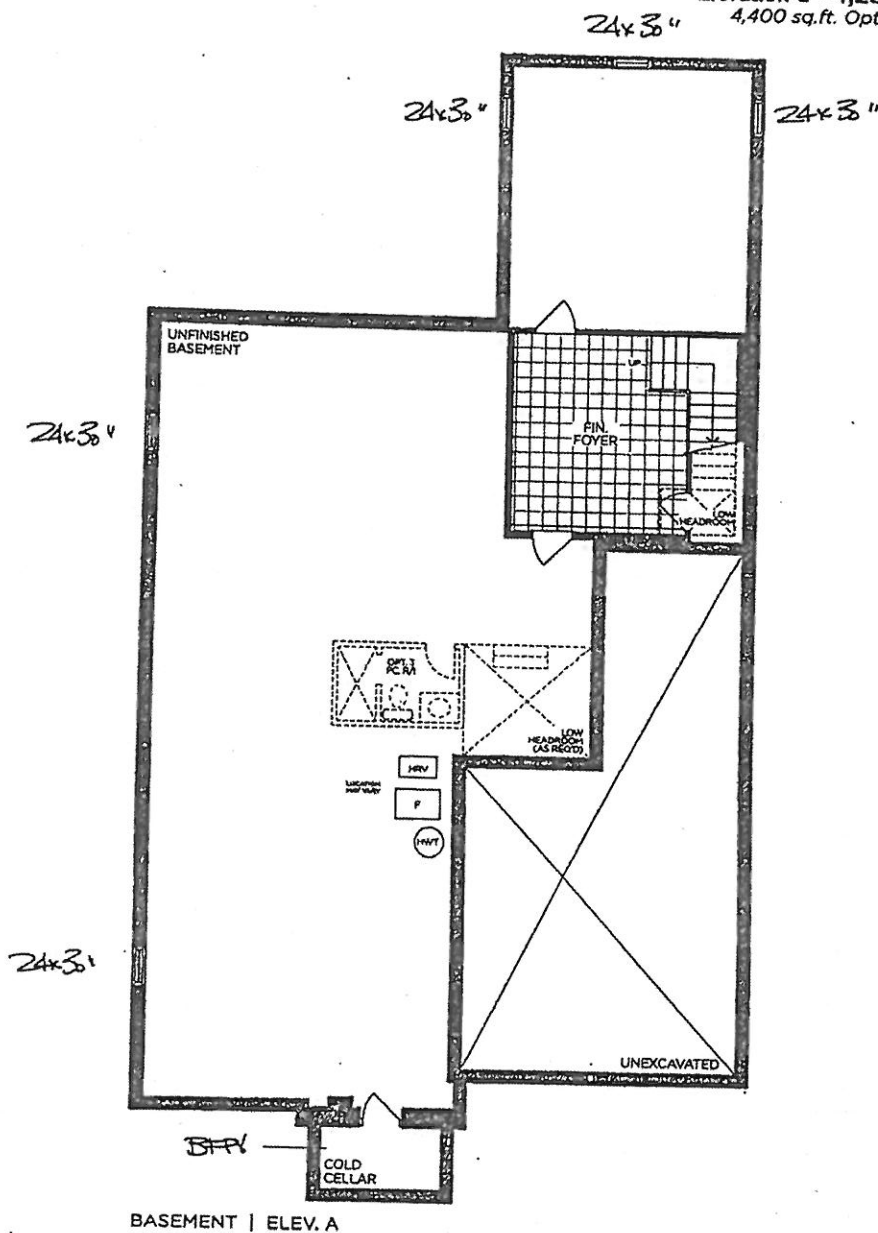

BASEMENT | ELEV. A

VENDOR	
PURCHASER	
PURCHASER	

GOLDPARK
WORTH MORE™


Prices, figures, illustrations, sizes, features and finishes are subject to change without notice. Areas and dimensions are approximate and actual usable floor space may vary from the stated area. Layout may be reverse of the unit purchased. E. & O.E. 5004

PLUMBING UPGRADES



MOEN - VIA


Single-Handle Lav Faucet with Lift Rod Drain

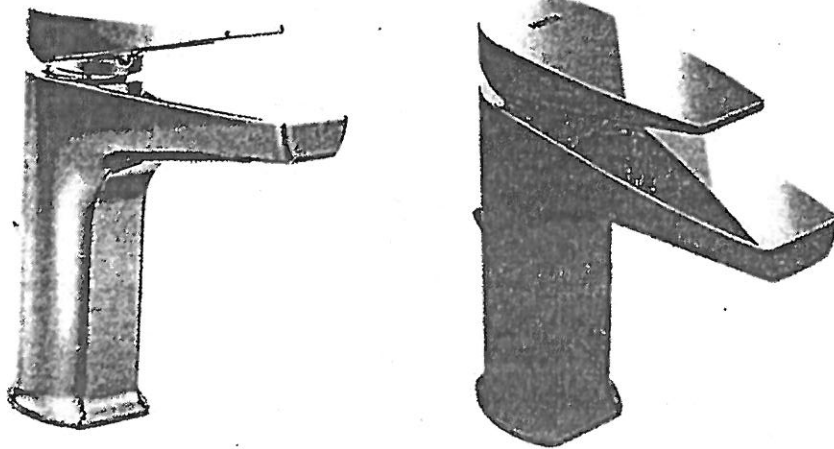

☒ CHROME

☐ BLACK / CHROME (BLC)

MODEL: S8000

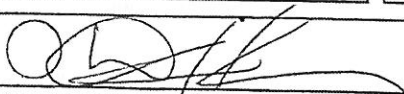Lot# PV-82	Date: Apr. 28, 2021	Room: Master Ensuite x2
Signature: 		
Signature:		


GOLDPARK
WORTH MORE

PLUMBING UPGRADES



MOEN - 90 DEGREE

Exact Temp 3/4" Thermostatic Vertical Spray Spa with 4 Body Sprays

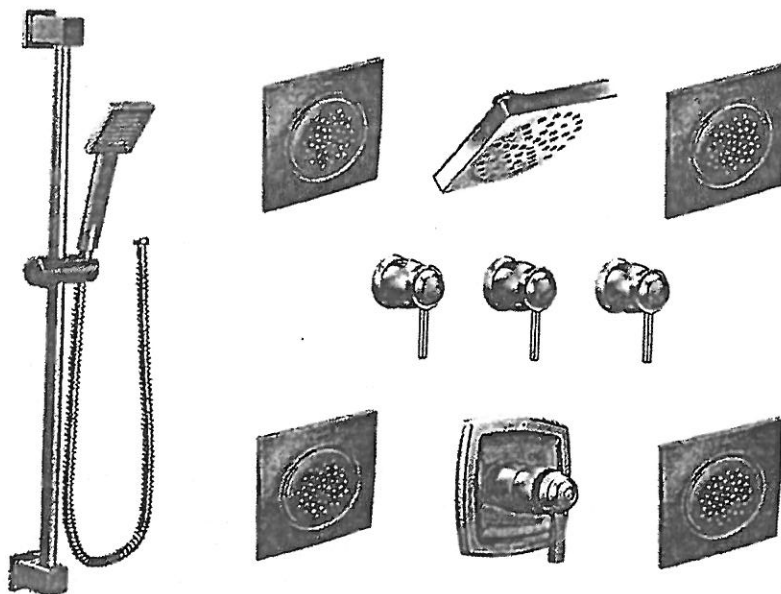

☒ CHROME

☐ BRUSHED NICKEL (BN)

*from ceiling

MODEL: TS3100 / S6340EP / S133 / S3600 (x3) / S3371 / TS3300 (x3) / S3879EP / A721 / S1300 (x4) / TS1320 (x4) / 226651

Lot# PV- 82	Date: Apr. 28, 2021	Room: Master Ensuite
Signature:		
Signature:		

GOLDPARK
WORTH HOPE

SCHEDULE 'F'



PV-82
MAY 5 2021

The Beaumont

50' SERIES

Elevation A • 4,170 sq.ft.


4,315 sq.ft. Opt. Elevator

→ Elevation B • 4,165 sq.ft.

4,315 sq.ft. Opt. Elevator

Elevation C • 4,250 sq.ft.

4,400 sq.ft. Opt. Elevator

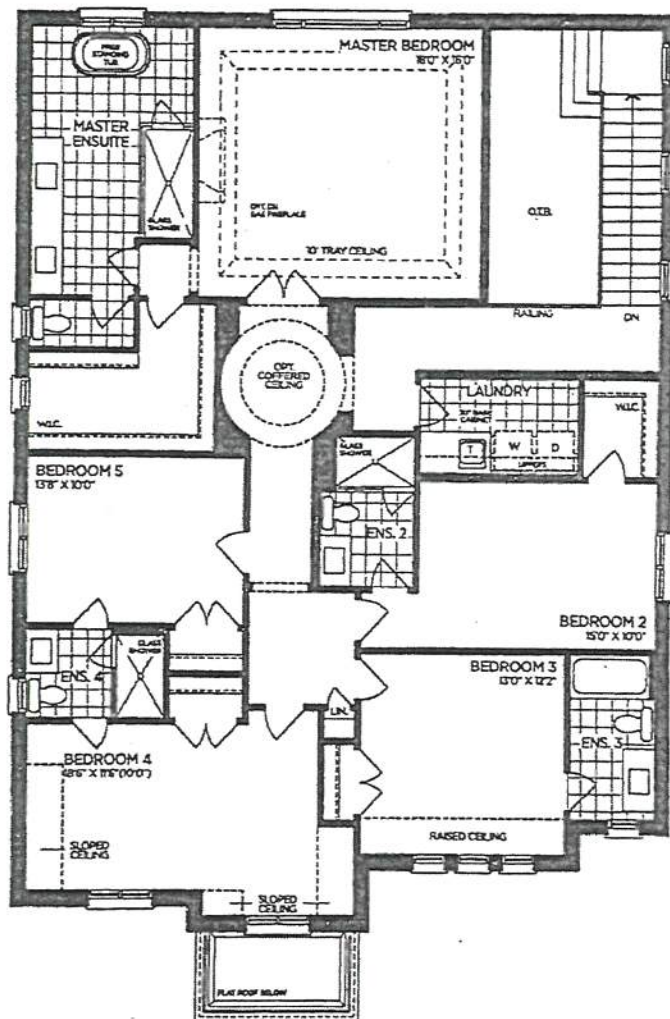

OPT. SECOND FLOOR | ELEV. A
5 BEDROOM

VENDOR

PURCHASER

PURCHASER

GOLDPARK
WORTH MORE™

Prices, figures, illustrations, sizes, features and finishes are subject to change without notice. Areas and dimensions are approximate and actual usable floor space may vary from the stated area. Layout may be reverse of the unit purchased. E. & O.E. 5004

SCHEDULE 'F'




PV-82
March 5 2021

The Beaumont 50' SERIES


Elevation A • 4,170 sq.ft.
4,315 sq.ft. Opt. Elevator

→ Elevation B • 4,165 sq.ft.
4,315 sq.ft. Opt. Elevator


Elevation C • 4,250 sq.ft.
4,400 sq.ft. Opt. Elevator

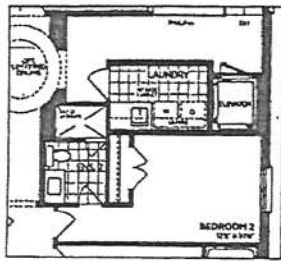


OPT. PART. SECOND FLOOR | ELEV. A
(ELEVATOR)

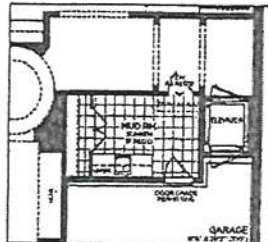


OPT. GROUND FLOOR | ELEV. A
(ELEVATOR)

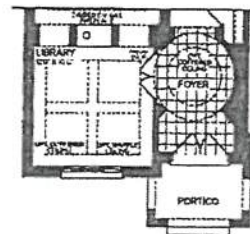


PART. OPT. LIBRARY GROUND FLOOR
ELEV. A, B & C

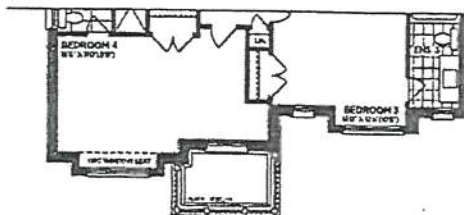


* → PART. OPT. SECOND FLOOR | ELEV. B
5 BEDROOM

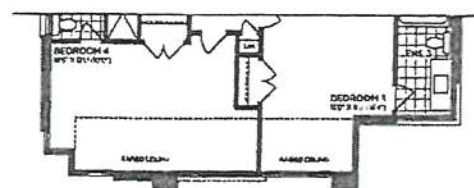


PART. OPT. SECOND FLOOR | ELEV. C
5 BEDROOM

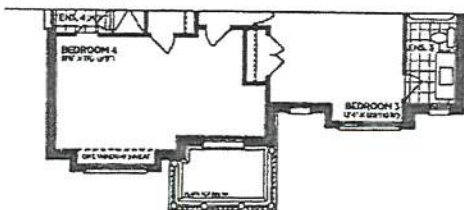


* → PART. SECOND FLOOR | ELEV. B

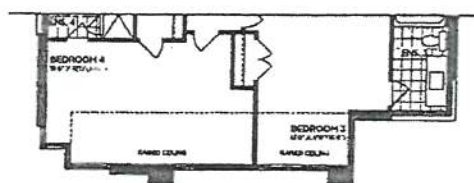


PART. SECOND FLOOR | ELEV. C

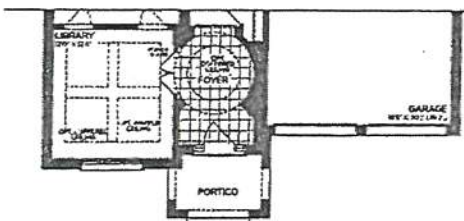


* → PART. GROUND FLOOR | ELEV. B

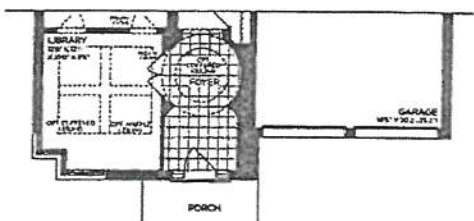


PART. GROUND FLOOR | ELEV. C

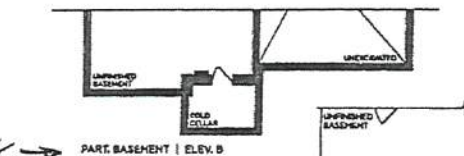

* → PART. BASEMENT | ELEV. B

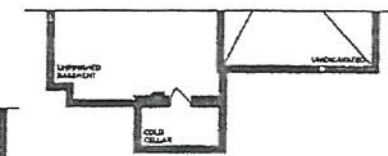

PART. BASEMENT | ELEV. C

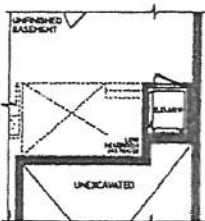

OPT. BASEMENT | ELEV. A
(ELEVATOR)

VENDOR

PURCHASER

PURCHASER

[Signature]

GOLDPARK
WORTH MORE™

Prices, figures, illustrations, sizes, features and finishes are subject to change without notice. Areas and dimensions are approximate and actual usable floor space may vary from the stated area. Layout may be reverse of the unit purchased. E. & O.E. 5004


SCHEDULE 'F'



PV-82
March 5 2021

The
Beaumont
50' SERIES

Elevation A • 4,170 sq.ft.
4,315 sq.ft. Opt. Elevator
→ Elevation B • 4,165 sq.ft.
4,315 sq.ft. Opt. Elevator
Elevation C • 4,250 sq.ft.
4,400 sq.ft. Opt. Elevator

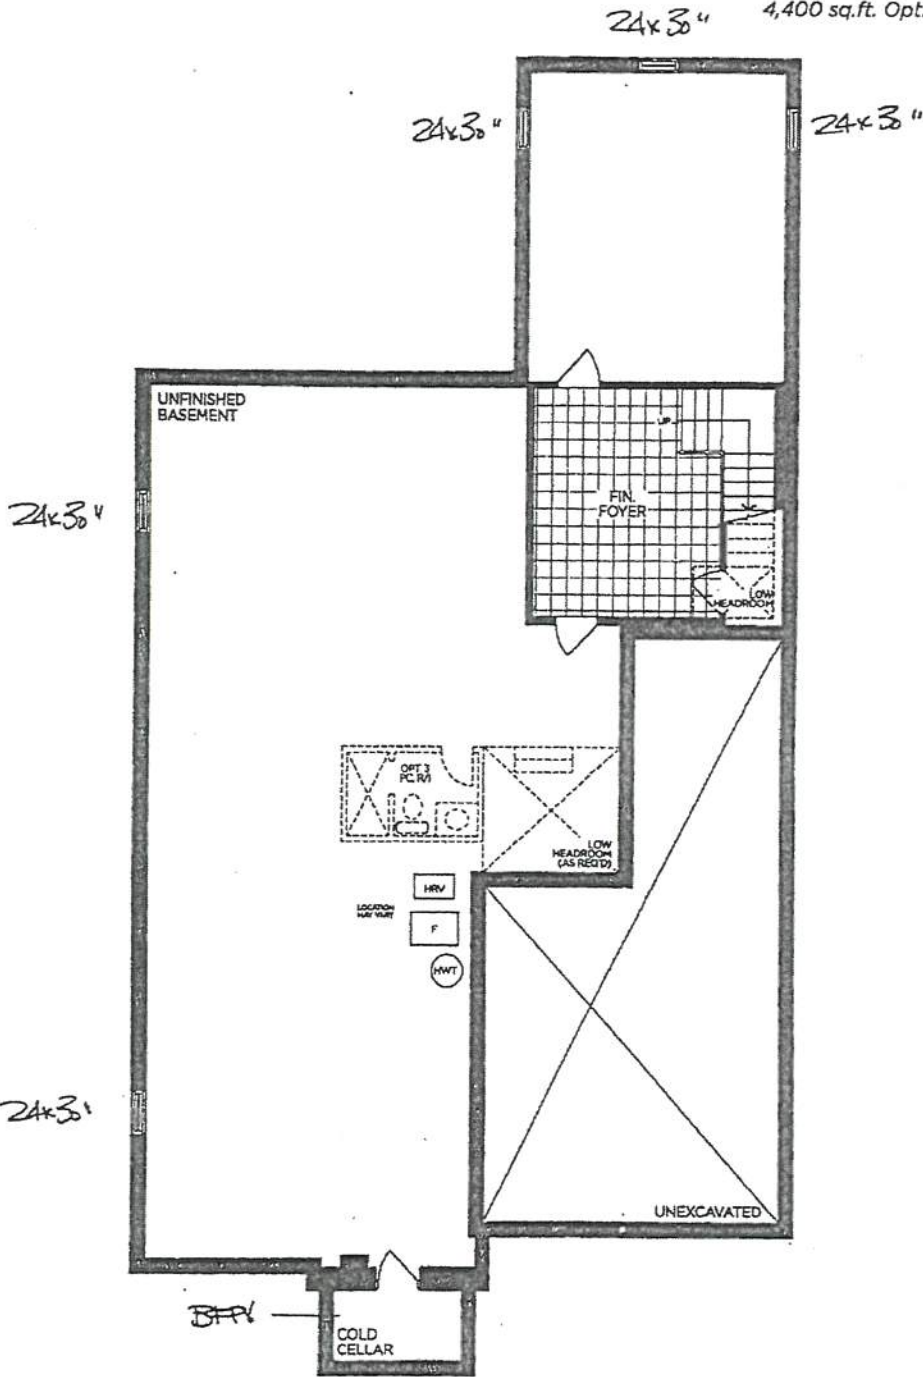

BASEMENT | ELEV. A

VENDOR
PURCHASER
PURCHASER

GOLDPARK
WORTH MORE™

Prices, figures, illustrations, sizes, features and finishes are subject to change without notice. Areas and dimensions are approximate and actual usable floor space may vary from the stated area. Layout may be reverse of the unit purchased. E. & O.E. 5004