



CONSTRUCTION SUMMARY

Lot: 19
Model: 40.01 B SUMMERDALE
Project/Phase: Pine Valley Forevergreen / 1

APPLIANCES

Invoice	Qty.	Description
2725 72,217 04May21 **	1	KITCHEN - UPGRADE TO 8" DUCT (EXTERIOR WALL) IN LIEU OF STANDARD OFFERING

BASEMENT WINDOWS

Invoice	Qty.	Description
2725 72,351 04May21	3	BASEMENT WINDOWS - UPGRADE BASEMENT WINDOW SIZE TO 30 " X 24" - 8" FRAME

CERAMIC

Invoice	Qty.	Description
2725 04May21 NoCat	1	MASTER ENSUITE / MAIN BATH / ENSUITE 2: SHOWER NICHE [SHAMPOO SHELF] - COMPLETE WITH MATCHING MARBLE JAMBS ON 4 SIDES, STANDARD TILE, APPROX. 12 X 18 INSTALLED VERTICALLY

CONCRETE AND DRAIN

Invoice	Qty.	Description
2725 04May21 NoCat	1	BACK-FLOW PREVENTER VALVE

DRYWALL

Invoice	Qty.	Description
2725 72,690 04May21 **	1	DELETE KITCHEN BULKHEAD, IF POSSIBLE, SITE APPROVAL REQUIRED WILL BE A GAP APPROX.12"H TO CEILING IF NO ADDITIONAL CABINETRY IS PURCHASED
2725 04May21 NoCat	1	MASTER ENSUITE / MAIN BATH / ENSUITE 2: SHOWER NICHE [SHAMPOO SHELF] - COMPLETE WITH MATCHING MARBLE JAMBS ON 4 SIDES, STANDARD TILE, APPROX. 12 X 18 INSTALLED VERTICALLY
2725 04May21 NoCat	1	**CUSTOM LAYOUT** MASTER ENSUITE: DELETE WATER CLOSET AND ADJUST VANITY/WIC WALL TO BE STRAIGHT (NOT JOGGED). ADD FULL HEIGHT NIBB WALL BETWEEN VANITY/TOILET. CONTINUE CLOSET ROD/SHELF - SEE PLAN FOR LOCATION INCLUDED IN APS BASED ON STANDARD FINISHES



CONSTRUCTION SUMMARY

Lot: 19
Model: 40.01 B SUMMERDALE
Project/Phase: Pine Valley Forevergreen / 1

ELECTRICAL

Invoice	Qty.	Description
2725 72,351 04May21 **	3	BASEMENT WINDOWS - UPGRADE BASEMENT WINDOW SIZE TO 30 " X 24" - 8" FRAME
2725 72,292 04May21	1	FRONT PORCH: ADDITIONAL EXTERIOR COACH LIGHT ON SAME SWITCH (BUILDERS STANDARD FIXTURE) - LOCATE OPPOSITE SIDE OF DOOR AS STANDARD - SAME HEIGHT AND SWITCH AS STANDARD
2725 72,281 04May21	1	FAMILY ROOM: INTERIOR WALL OUTLET: ADDITIONAL 110V WALL INTERIOR RECEPTACLE ON EXISTING CIRCUIT FOR WALL MOUNTED TV - LOCATE ABOVE FIREPLACE, APPROX 64" A.F.F.
2725 72,281 04May21	1	FAMILY ROOM: INTERIOR WALL OUTLET: ADDITIONAL 110V WALL INTERIOR RECEPTACLE ON EXISTING CIRCUIT FOR WALL MOUNTED TV - LOCATE APPROX 48" A.F.F. SEE PLAN FOR LOCATION
2725 72,292 04May21	1	REAR GARDEN DOOR: ADDITIONAL EXTERIOR COACH LIGHT ON SAME SWITCH (BUILDERS STANDARD FIXTURE) - LOCATE OPPOSITE SIDE AS STANDARD, SAME HEIGHT AND SWITCH AS STANDARD
2725 72,273 04May21	1	KITCHEN: 110V WALL RECEPTACLE ON SEPARATE CIRCUIT - GAS FIRED APPLIANCE - FOR AUX. EQUIPMENT - NOT A STOVE PLUG
2725 72,272 04May21	1	KITCHEN: 110V WALL RECEPTACLE ON SEPARATE CIRCUIT - FOR MICROWAVE - MICROWAVE NOT INCLUDED SEE PLAN FOR LOCATION
2725 72,272 04May21	1	KITCHEN: 110V WALL RECEPTACLE ON SEPARATE CIRCUIT - FOR BEVERAGE FRIDGE - APPLIANCE NOT INCLUDED
2725 72,307 04May21	1	KITCHEN: FIXTURE: RELOCATE STANDARD CEILING MOUNT FIXTURE TO APPROX CENTER ABOVE ISLAND
2725 72,307 04May21	1	UPPER HALL ABOVE STAIRS: FIXTURE: RELOCATE STANDARD CEILING MOUNT FIXTURE - TO APPROX CENTER AT "OTB"
2725 72,307 04May21	1	MASTER BEDROOM: FIXTURE: RELOCATE STANDARD CEILING MOUNT FIXTURE TO APPROX CENTER ABOVE TUB
2725 72,289 04May21	6	MAIN HALL: 4" E/S LED INTERIOR POT LIGHT - GROUND FLOOR - EACH - IN LIEU OF STANDARD LIGHTS - INCLUDE INCLUDED IN APS
2725 04May21 NoCat	1	KITCHEN: INSTALL VAC PAN UNDER KITCHEN SINK



CONSTRUCTION SUMMARY

Lot: 19
Model: 40.01 B SUMMERDALE
Project/Phase: Pine Valley Forevergreen / 1

ELECTRICAL

Invoice	Qty.	Description
2725 04May21 NoCat	1	**CUSTOM LAYOUT** MASTER ENSUITE: DELETE WATER CLOSET AND ADJUST VANITY/WIC WALL TO BE STRAIGHT (NOT JOGGED). ADD FULL HEIGHT NIBB WALL BETWEEN VANITY/TOILET. CONTINUE CLOSET ROD/SHELF - SEE PLAN FOR LOCATION INCLUDED IN APS BASED ON STANDARD FINSIHES

FRAMING

Invoice	Qty.	Description
2725 72,631 04May21	3	MASTER ENSUITE / MAIN BATH / ENSUITE 2: SHOWER NICHE [SHAMPOO SHELF] - COMPLETE WITH MATCHING MARBLE JAMBS ON 4 SIDES, STANDARD TILE, APPROX. 12 X 18 INSTALLED VERTICALLY
2725 04May21 NoCat	1	**CUSTOM LAYOUT** MASTER ENSUITE: DELETE WATER CLOSET AND ADJUST VANITY/WIC WALL TO BE STRAIGHT (NOT JOGGED). ADD FULL HEIGHT NIBB WALL BETWEEN VANITY/TOILET. CONTINUE CLOSET ROD/SHELF - SEE PLAN FOR LOCATION INCLUDED IN APS BASED ON STANDARD FINISHES
2725 72,690 04May21	1	DELETE KITCHEN BULKHEAD, IF POSSIBLE, SITE APPROVAL REQUIRED WILL BE A GAP APPROX.12"H TO CEILING IF NO ADDITIONAL CABINETRY IS PURCHASED
2725 04May21 NoCat	1	FRONT PORCH: ADDITIONAL EXTERIOR COACH LIGHT ON SAME SWITCH (BUILDERS STANDARD FIXTURE) - LOCATE OPPOSITE SIDE OF DOOR AS STANDARD - SAME HEIGHT AND SWITCH AS STANDARD
2725 04May21 NoCat	1	REAR GARDEN DOOR: ADDITIONAL EXTERIOR COACH LIGHT ON SAME SWITCH (BUILDERS STANDARD FIXTURE) - LOCATE OPPOSITE SIDE AS STANDARD, SAME HEIGHT AND SWITCH AS STANDARD

HVAC

Invoice	Qty.	Description
2725 72,224 04May21	1	KITCHEN: GAS LINE ROUGH-IN - MAIN FLOOR FOR GAS APPLIANCE - SEE PLAN FOR APPROXIMATE LOCATION. FINAL LOCATION/ORIENTATION IS TO BE COMPLETED BY A LICENSED GAS FITTER AND ARRANGED BY HOME OWNER AFTER CLOSING
2725 72,217 04May21	1	KITCHEN - UPGRADE TO 8" DUCT (EXTERIOR WALL) IN LIEU OF STANDARD OFFERING
2725 72,690 04May21 **	1	DELETE KITCHEN BULKHEAD, IF POSSIBLE, SITE APPROVAL REQUIRED WILL BE A GAP APPROX.12"H TO CEILING IF NO ADDITIONAL CABINETRY IS PURCHASED
2725 04May21 NoCat	1	KITCHEN: INSTALL VAC PAN UNDER KITCHEN SINK



CONSTRUCTION SUMMARY

Lot: 19
Model: 40.01 B SUMMERDALE
Project/Phase: Pine Valley Forevergreen / 1

INTERIOR TRIM AND DOORS

Invoice	Qty.	Description
2725 04May21 NoCat	1	**CUSTOM LAYOUT** MASTER ENSUITE: DELETE WATER CLOSET AND ADJUST VANITY/WIC WALL TO BE STRAIGHT (NOT JOGGED). ADD FULL HEIGHT NIBB WALL BETWEEN VANITY/TOILET. CONTINUE CLOSET ROD/SHELF - SEE PLAN FOR LOCATION INCLUDED IN APS BASED ON STANDARD FINISHES

KITCHEN AND BATH CABINETRY

Invoice	Qty.	Description
2725 72,217 04May21 **	1	KITCHEN - UPGRADE TO 8" DUCT (EXTERIOR WALL) IN LIEU OF STANDARD OFFERING
2725 72,690 04May21 **	1	DELETE KITCHEN BULKHEAD, IF POSSIBLE, SITE APPROVAL REQUIRED WILL BE A GAP APPROX.12"H TO CEILING IF NO ADDITIONAL CABINETRY IS PURCHASED
2725 04May21 NoCat	1	FYI - KITCHEN - UPGRADE TO 8" DUCT (EXTERIOR WALL) IN LIEU OF STANDARD OFFERING
2725 04May21 NoCat	1	FYI - KITCHEN: INSTALL VAC PAN UNDER KITCHEN SINK
2725 04May21 NoCat	1	**CUSTOM LAYOUT** MASTER ENSUITE: DELETE WATER CLOSET AND ADJUST VANITY/WIC WALL TO BE STRAIGHT (NOT JOGGED). ADD FULL HEIGHT NIBB WALL BETWEEN VANITY/TOILET. CONTINUE CLOSET ROD/SHELF - SEE PLAN FOR LOCATION INCLUDED IN APS BASED ON STANDARD FINISHES

MASONRY

Invoice	Qty.	Description
2725 04May21 NoCat	1	FRONT PORCH: ADDITIONAL EXTERIOR COACH LIGHT ON SAME SWITCH (BUILDERS STANDARD FIXTURE) - LOCATE OPPOSITE SIDE OF DOOR AS STANDARD - SAME HEIGHT AND SWITCH AS STANDARD
2725 04May21 NoCat	1	REAR GARDEN DOOR: ADDITIONAL EXTERIOR COACH LIGHT ON SAME SWITCH (BUILDERS STANDARD FIXTURE) - LOCATE OPPOSITE SIDE AS STANDARD, SAME HEIGHT AND SWITCH AS STANDARD



CONSTRUCTION SUMMARY

Lot: 19
Model: 40.01 B SUMMERDALE
Project/Phase: Pine Valley Forevergreen / 1

NETWORK AND WIRING

Invoice	Qty.	Description
2725 72,256 04May21	1	FAMILY ROOM: ADDITIONAL RG6 HIGH SPEED TV / INTERNET OUTLETS - LOCATE APPROX 48" A.F.F. SEE PLAN FOR LOCATION
2725 72,258 04May21	3	BEDROOM 2 / BEDROOM 3 / BEDROOM 4: ADDITIONAL CAT6 ETHERNET OUTLET - EACH SEE PLAN FOR LOCATION
2725 72,264 04May21	2	MASTER BEDROOM + LAUNDRY ROOM: ROUGH - IN FOR EXTRA SECURITY KEY PAD
2725 72,261 04May21	1	KITCHEN: INSTALL VAC PAN UNDER KITCHEN SINK

PAINT

Invoice	Qty.	Description
2725 04May21 NoCat	1	**CUSTOM LAYOUT** MASTER ENSUITE: DELETE WATER CLOSET AND ADJUST VANITY/WIC WALL TO BE STRAIGHT (NOT JOGGED). ADD FULL HEIGHT NIBB WALL BETWEEN VANITY/TOILET. CONTINUE CLOSET ROD/SHELF - SEE PLAN FOR LOCATION INCLUDED IN APS BASED ON STANDARD FINISHES
2725 72,690 04May21 **	1	DELETE KITCHEN BULKHEAD, IF POSSIBLE, SITE APPROVAL REQUIRED WILL BE A GAP APPROX.12"H TO CEILING IF NO ADDITIONAL CABINETRY IS PURCHASED



CONSTRUCTION SUMMARY

Lot: 19
Model: 40.01 B SUMMERDALE
Project/Phase: Pine Valley Forevergreen / 1

PLUMBING

Invoice	Qty.	Description
2725 72,332 04May21	1	KITCHEN: ROUGH-IN 1/4" COLD WATER LINE TO FRIDGE
2725 04May21 NoCat	1	ENSUITE 2: MOEN 'ALIGN' RAIN SHOWER + HAND SHOWER/SLIDE BAR - CHROME
2725 04May21 NoCat	1	MASTER ENSUITE: MOEN 'FLARA' RAIN SHOWER + HAND SHOWER/SLIDE BAR
2725 04May21 NoCat	2	MASTER ENSUITE: MOEN 'FLARA' 2 HANDLE, HIGH ARC LAV FAUCET
2725 04May21 NoCat	1	MAIN BATH: MOEN 90* SHOWER + TOE TESTER -CHROME
2725 04May21 NoCat	1	**NOTE** MASTER ENSUITE / MAIN BATH / ENSUITE 2: RAISE ALL SHOWER HEADS TO APPROX 7'-0" A.F.F. IN LIEU OF STANDARD HEIGHT

WINDOWS AND DOORS

Invoice	Qty.	Description
2725 72,351 04May21 **	3	BASEMENT WINDOWS - UPGRADE BASEMENT WINDOW SIZE TO 30 " X 24" - 8" FRAME



SCHEDULE 'F'

PV-19. *attach*
April 30 2021

The Summerdale

40' SERIES

Elevation A • 2,895 sq.ft.


→ Elevation B • 2,880 sq.ft.

NO BULKHEAD
IN KITCHEN

GAS+ELECT
8"DUCT

MICRO

BEV FRIDGE

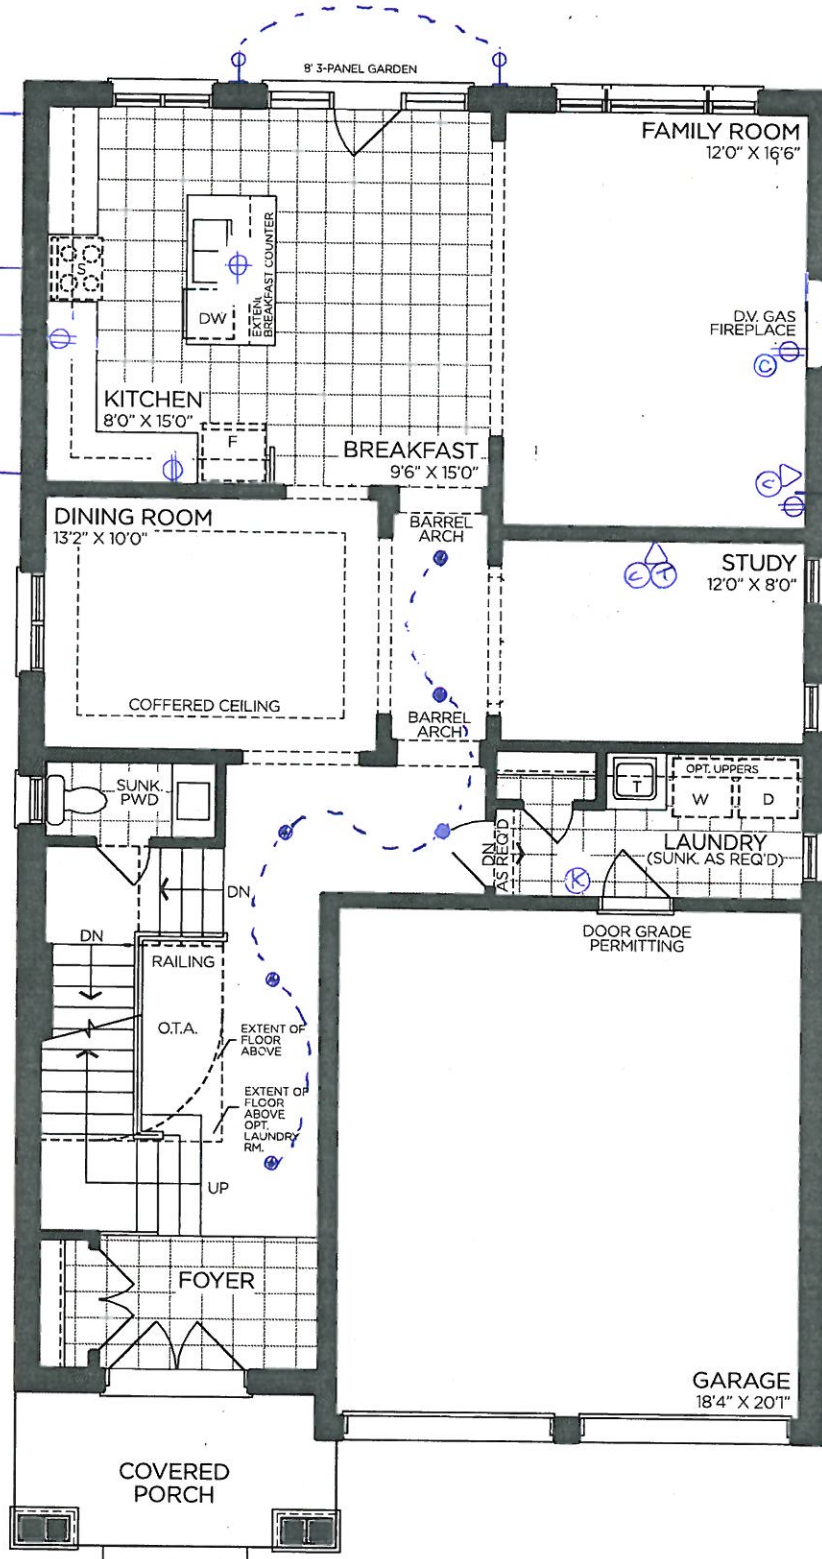

GROUND FLOOR | ELEV. A

VENDOR

PURCHASER

PURCHASER

GOLDPARK
WORTH MORE™

Prices, figures, illustrations, sizes, features and finishes are subject to change without notice. Areas and dimensions are approximate and actual usable floor space may vary from the stated area. Layout may be reverse of the unit purchased. E. & O.E. 4001



SCHEDULE 'F'


PV-19 ~~attach~~
APRIL 30 2021

The Summerdale

40' SERIES

Elevation A • 2,895 sq.ft.

→ Elevation B • 2,880 sq.ft.

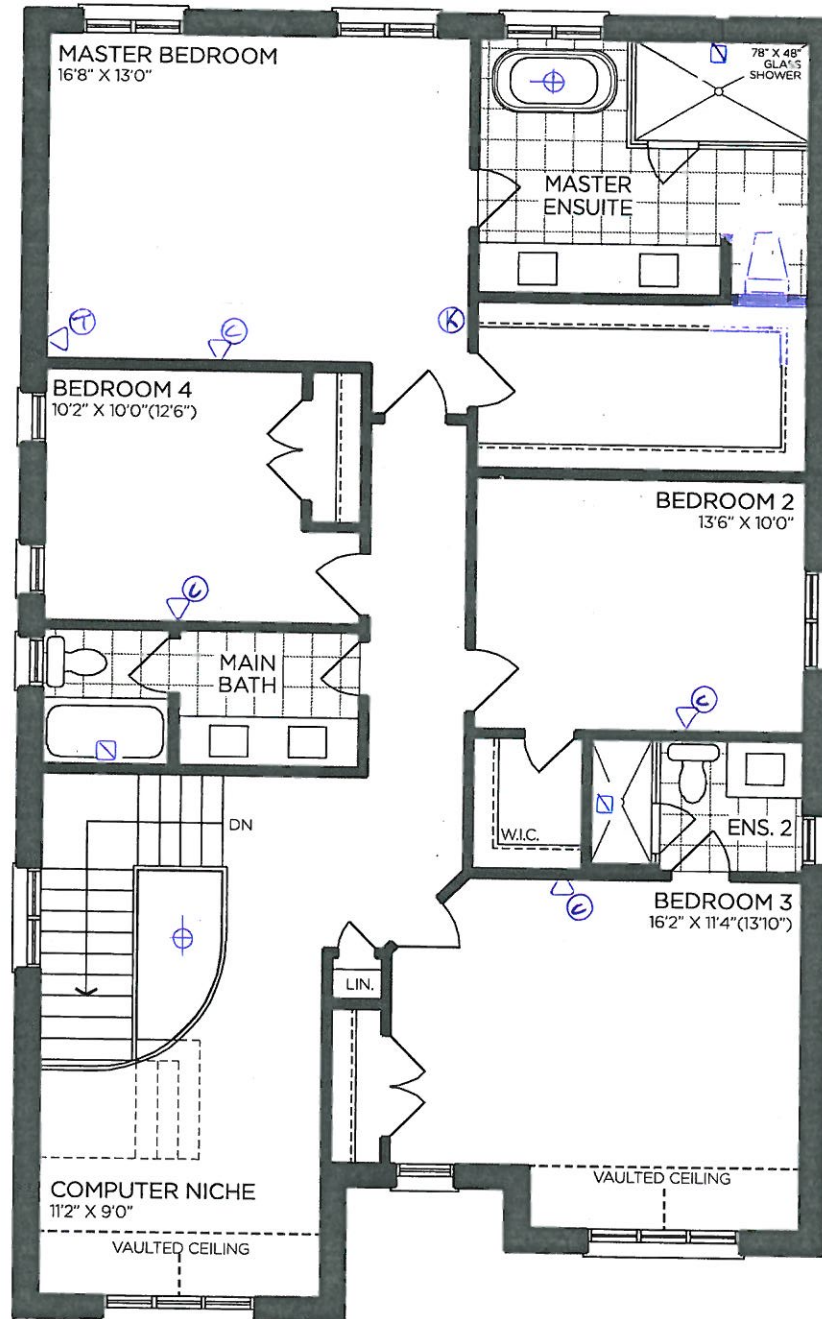

SECOND FLOOR | ELEV. A

VENDOR

PURCHASER

PURCHASER

GOLDPARK
WORTH MORE™

Prices, figures, illustrations, sizes, features and finishes are subject to change without notice. Areas and dimensions are approximate and actual usable floor space may vary from the stated area. Layout may be reverse of the unit purchased. E. & O.E. 4001



74-19
APRIL 30 2021


SCHEDULE 'F'

The Summerdale


40' SERIES

Elevation A • 2,895 sq.ft.


→ Elevation B • 2,880 sq.ft.

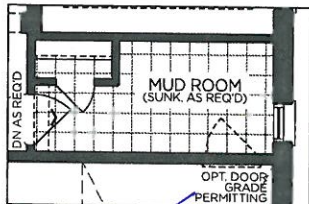


PART. GROUND FLOOR
MUDROOM FOR OPT.
SECOND FLOOR LAUNDRY

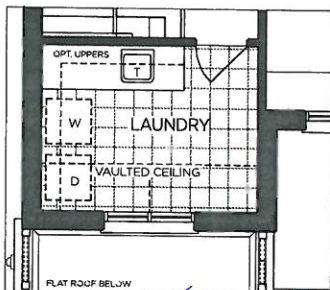


PART. SECOND FLOOR
W/ OPT. LAUNDRY
ELEV. B

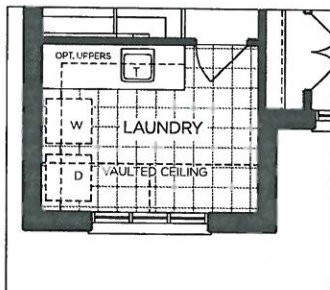


PART. SECOND FLOOR
W/ OPT. LAUNDRY
ELEV. A

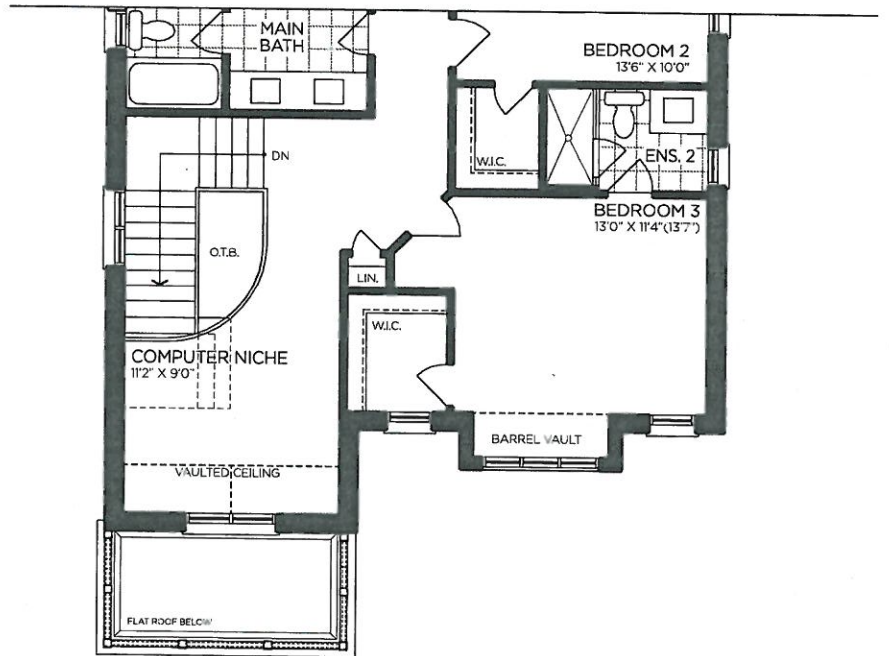

→ PART. SECOND FLOOR | ELEV. B

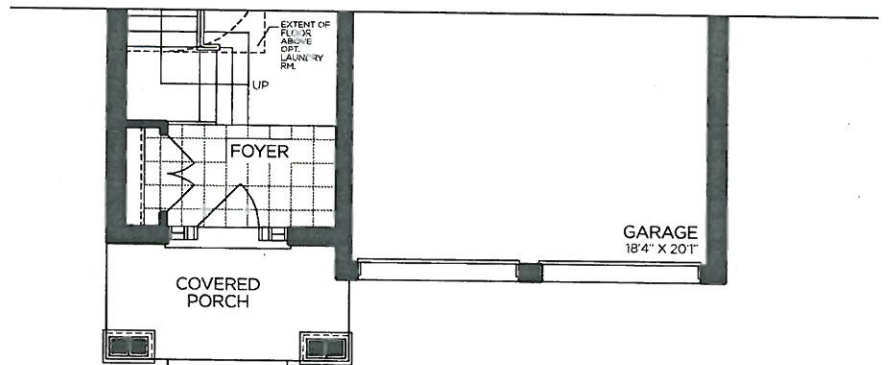

→ PART. GROUND FLOOR | ELEV. B

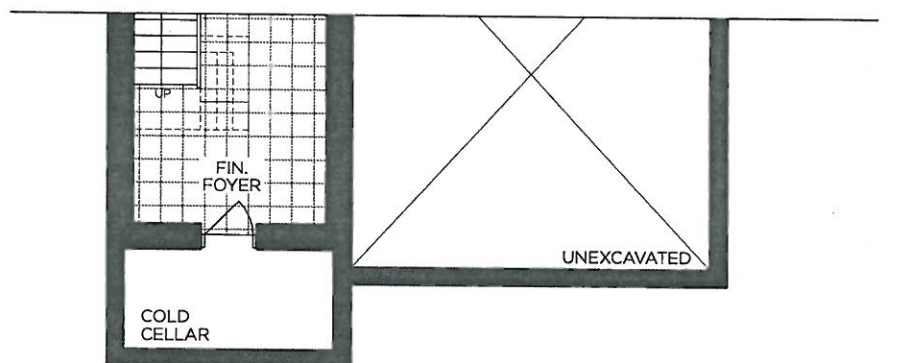

→ PART. BASEMENT | ELEV. B

VENDOR

PURCHASER

PURCHASER

GOLDPARK
WORTH MORE™

Prices, figures, illustrations, sizes, features and finishes are subject to change without notice. Areas and dimensions are approximate and actual usable floor space may vary from the stated area. Layout may be reverse of the unit purchased. E. & O.E. 4001



SCHEDULE 'F'

FV-19
April 30, 2021


attach

The Summerdale

40' SERIES

Elevation A • 2,895 sq.ft.

→ Elevation B • 2,880 sq.ft.

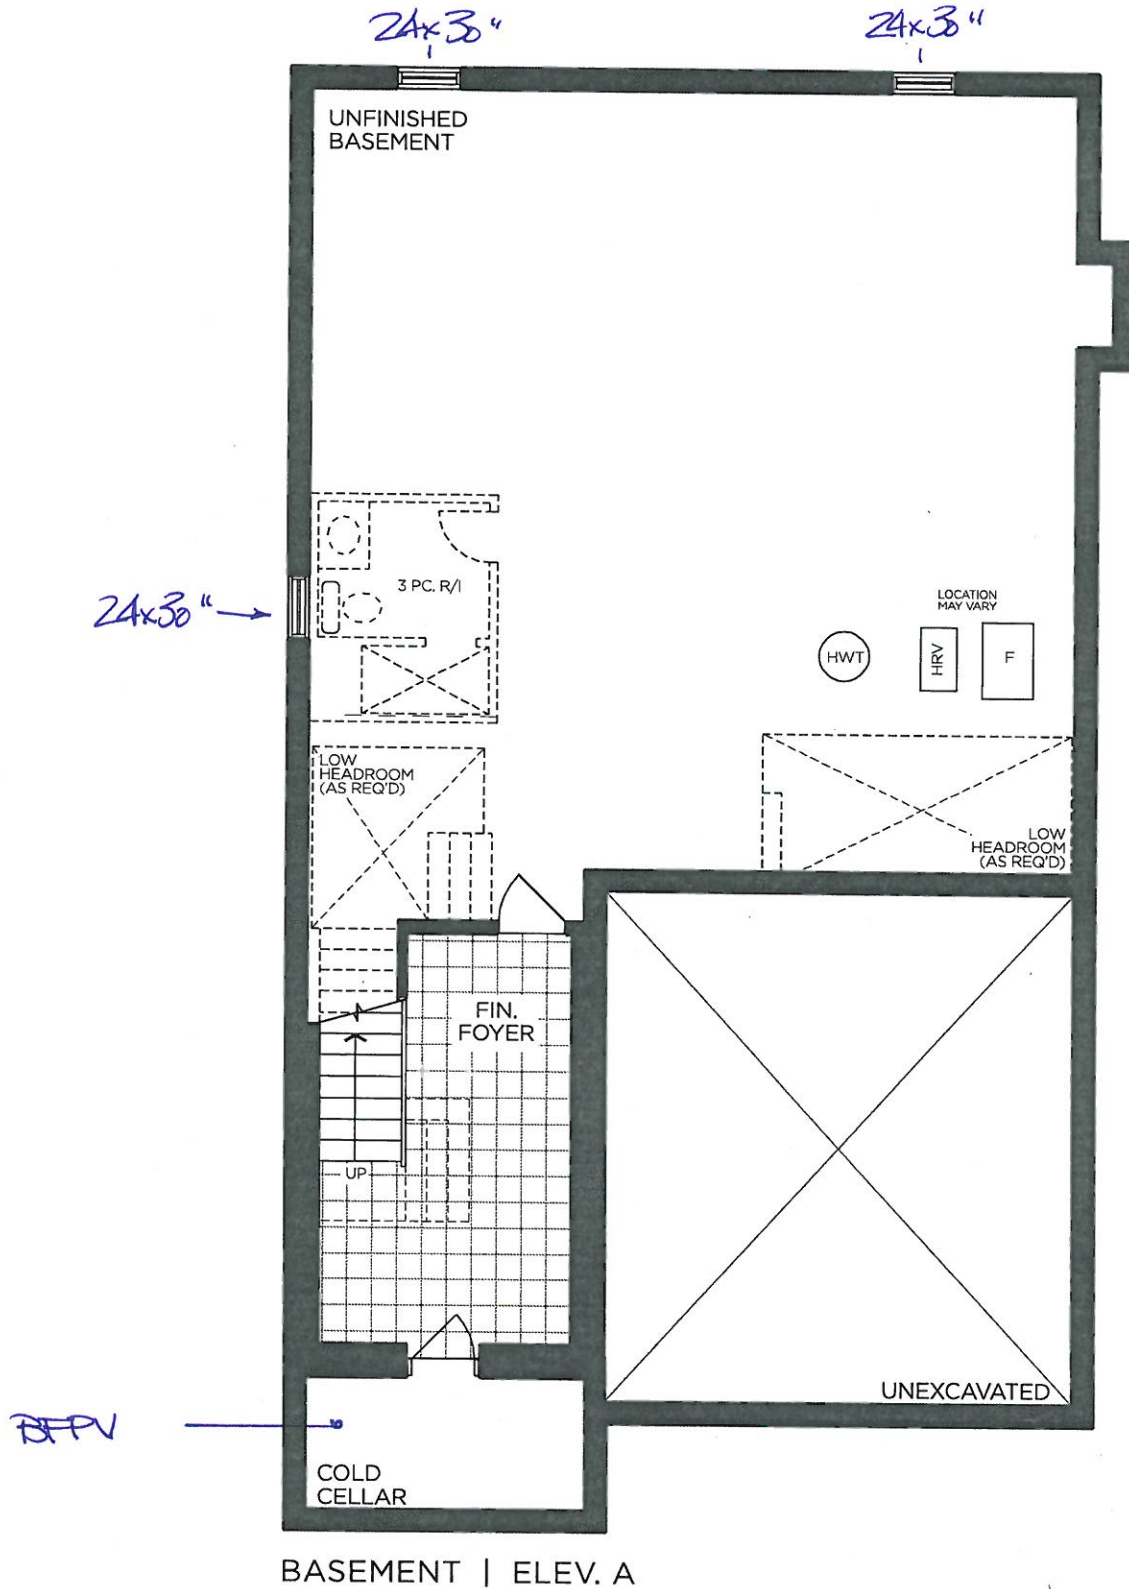

VENDOR

PURCHASER

PURCHASER

GOLDPARK
WORTH MORE™

Prices, figures, illustrations, sizes, features and finishes are subject to change without notice. Areas and dimensions are approximate and actual usable floor space may vary from the stated area. Layout may be reverse of the unit purchased. E. & O.E. 4001




PINE VALLEY
FOREVERGREEN

PLUMBING UPGRADES

MOEN - FLARA

Two-Handle High Arc Lav Faucet

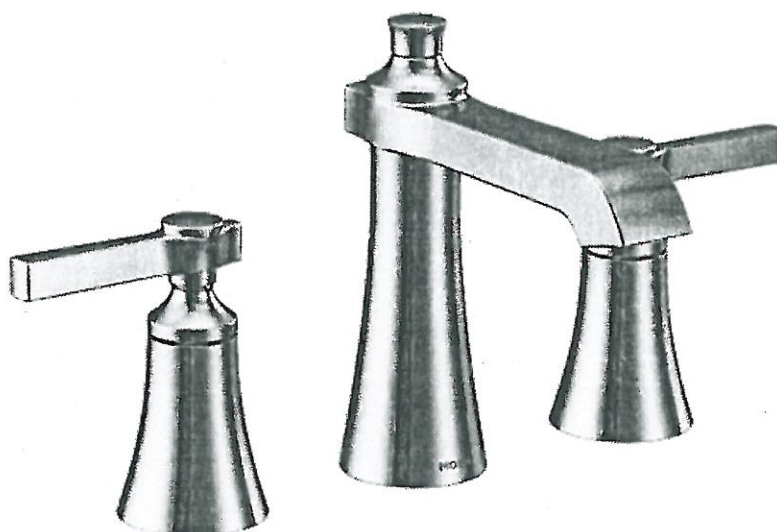

CHROME



BRUSHED NICKEL (BN)



POLISHED NICKEL (NL)



BRUSHED GOLD (BG)

MODEL: TS6984 / 69000

Lot#

PV-19

Date:

April 30, 2021

Room:

Master Ensuite x2

Signature:

Atadok

Signature:




PINE VALLEY

FOREVERGREEN

PLUMBING UPGRADES

MOEN - FLARA

Posi-Temp SHOWER ONLY* Slide Bar with Hand Shower

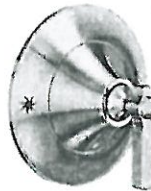

☒ CHROME

☐ BRUSHED NICKEL (BN)

*from WALL

MODEL: TS2912EP / 62320 / UTS4911 / U361CI / 3668EP / A725

Lot# PV-19	Date: Apr. 30, 2021	Room: Master Ensuite
Signature: 		
Signature:		




PINE VALLEY
FOREVERGREEN

PLUMBING UPGRADES

MOEN - ALIGN

Posi-Temp SHOWER ONLY* with 3 Function Transfer Valve/Trim and Slide Bar with Handshower

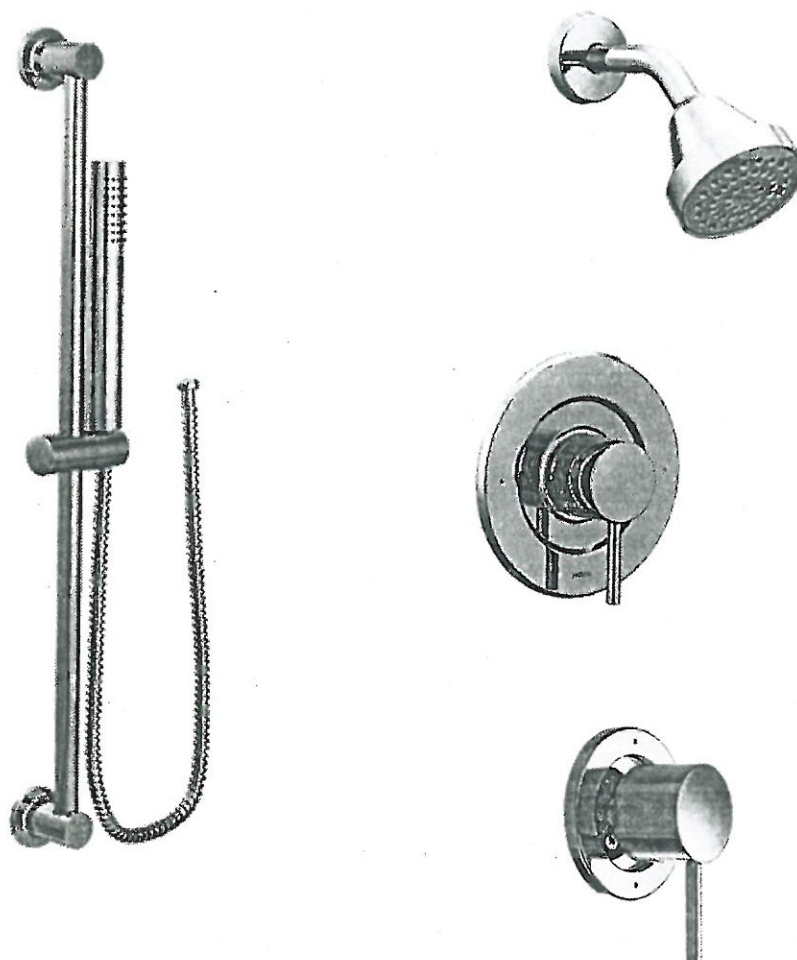

☒ CHROME

☐ BRUSHED NICKEL (BN)

☐ BRUSHED GOLD (BG)

☐ MATTE BLACK (BL)

from WALL

MODEL: T2192EP / U361CI / UT4191 / 62320 / 3887EP / A725

Lot# PV-19

Date: Apr. 30, 2021

Room: Ensuite 2

Signature:

attach

Signature:




PINE VALLEY

FOREVERGREEN

PLUMBING UPGRADES

MOEN - 90 DEGREE

Posi-Temp Tub/Shower Faucet with 3 Function Transfer Valve/Trim & Slide Bar
with Hand Shower

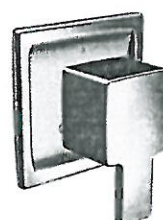

☒ CHROME

☐ BRUSHED NICKEL (BN)

* from WALL

MODEL: TS2713EP / U361CI / UTS4172 / 62320 / S3879EP / A721

Lot# PV-19

Date: Apr. 30, 2021

Room: Main Bath

Signature: attah

Signature:



PV-13.
APRIL 30 2021

SCHEDULE 'F'

The Summerdale

40' SERIES

Elevation A • 2,895 sq.ft.


→ Elevation B • 2,880 sq.ft.

NO BULKHEADS
IN KITCHEN

GAS + ELECT
84" JECT

MICRO

BEV FRIDGE

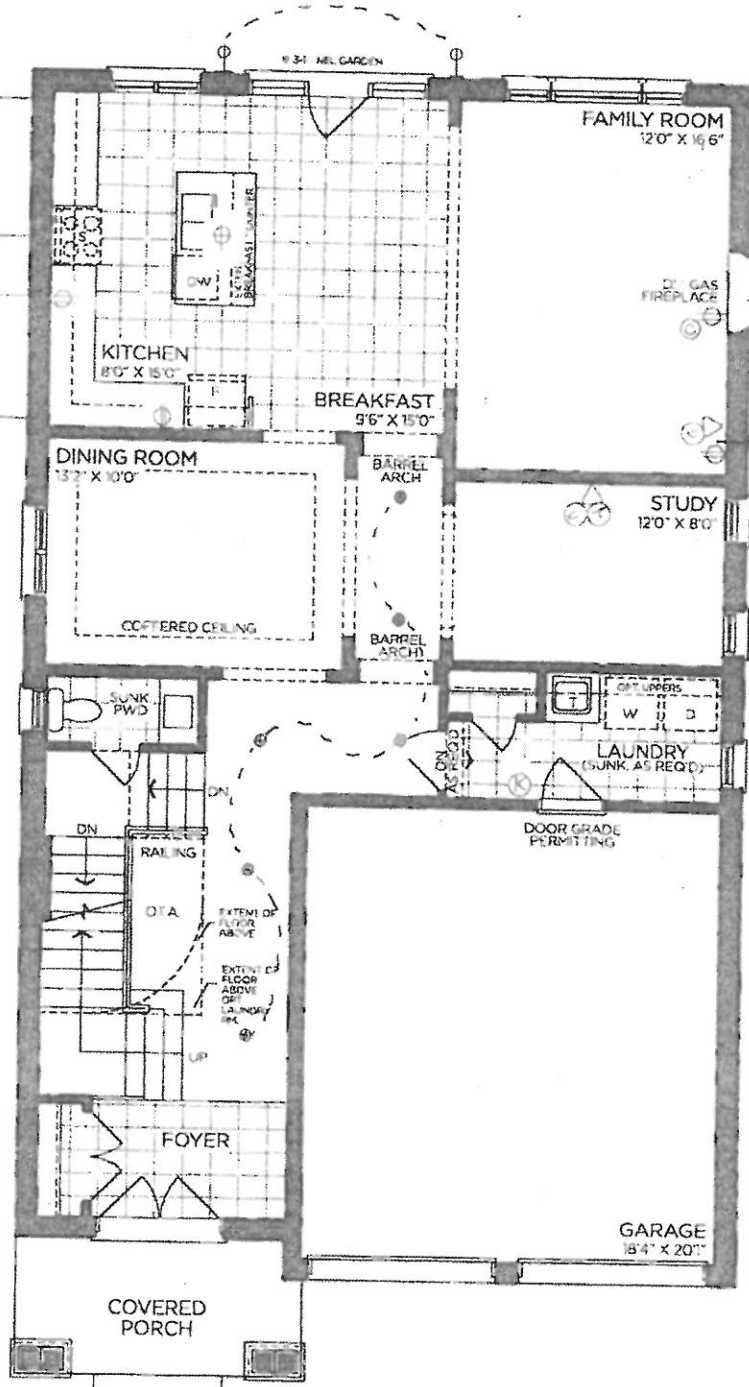

GROUND FLOOR | ELEV. A

VENDOR

PURCHASER

PURCHASER

GOLDPARK
WORTH MORE™

Prices, figures, illustrations, sizes, features and finishes are subject to change without notice. Areas and dimensions are approximate and actual usable floor space may vary from the stated area. Layout may be reverse of the unit purchased. E & O.E. 4001




SCHEDULE 'F'

PV-19
APRIL 30 2021

The Summerdale

40' SERIES

Elevation A • 2,895 sq.ft.
→ Elevation B • 2,880 sq.ft.

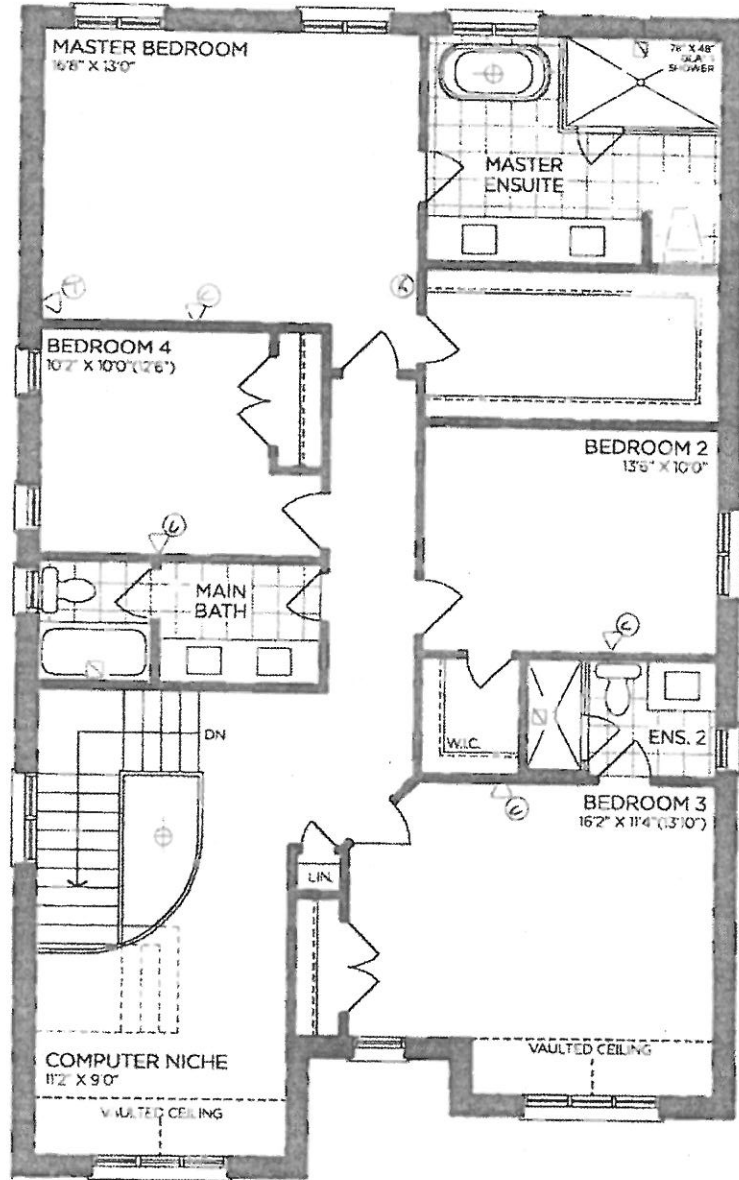

SECOND FLOOR | ELEV. A

VENDOR

PURCHASER

PURCHASER

GOLD PARK
WORTH MORE™

Prices, figures, illustrations, sizes, features and finishes are subject to change without notice. Areas and dimensions are approximate and actual usable floor space may vary from the stated area. Layout may be reverse of the unit purchased. E. & O.E. 4001




PI-19
APRIL 30 2021

SCHEDULE 'F'


The Summerdale

40' SERIES


Elevation A • 2,895 sq.ft.
→ Elevation B • 2,880 sq.ft.

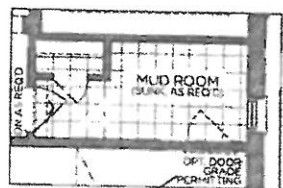


PART. GROUND FLOOR
MUDROOM FOR OPT.
SECOND FLOOR LAUNDRY

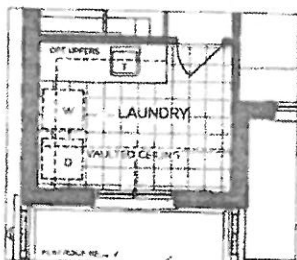


PART. SECOND FLOOR
W/ OPT. LAUNDRY
ELEV. B

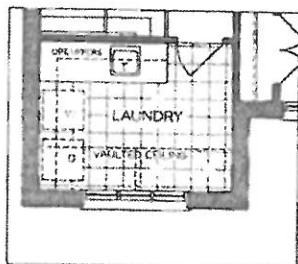


PART. SECOND FLOOR
W/ OPT. LAUNDRY
ELEV. A

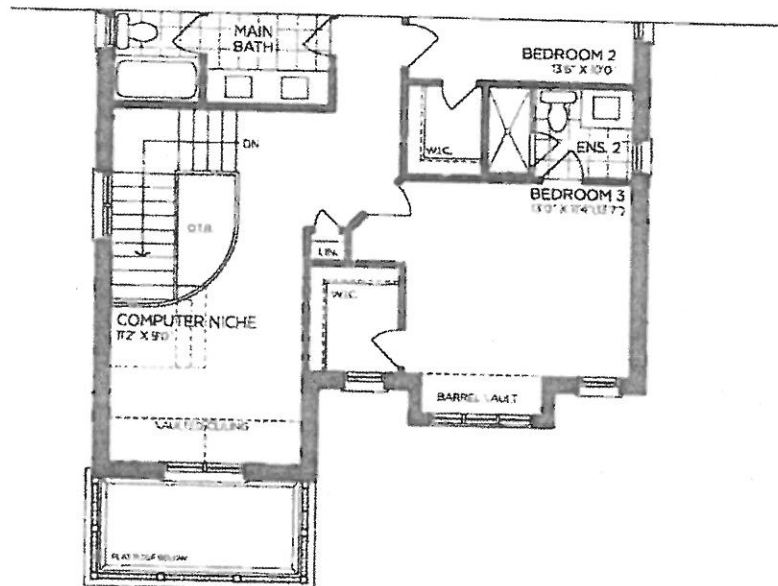

→ PART. SECOND FLOOR | ELEV. B

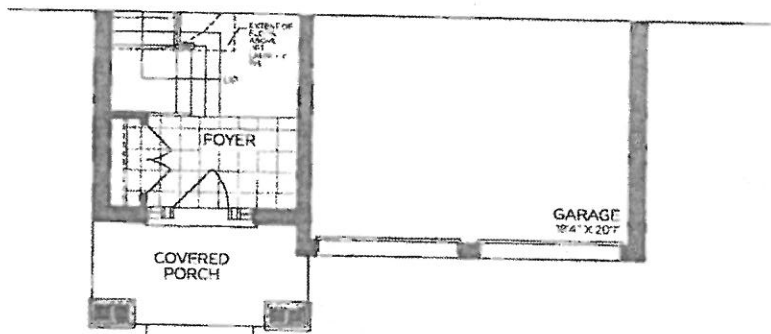

→ PART. GROUND FLOOR | ELEV. B

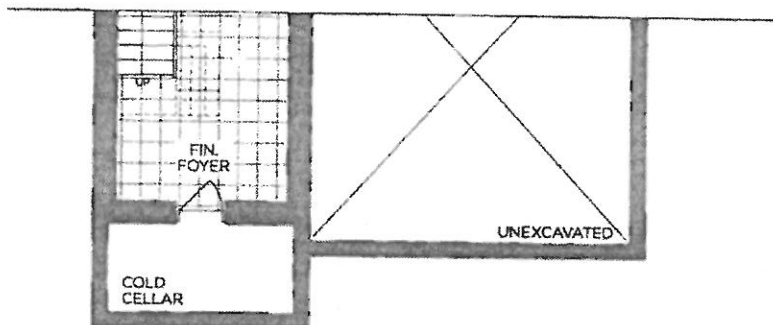

→ PART. BASEMENT | ELEV. B

VENDOR
PURCHASER
PURCHASER

GOLDPARK
WORTH MORE™

Prices, figures, illustrations, sizes, features and finishes are subject to change without notice. Areas and dimensions are approximate and actual usable floor space may vary from the stated area. Layout may be reverse of the unit purchased. E. & O.E. 4001



SCHEDULE 'F'


PV-19
APRIL 30, 2021

14

The Summerdale

40' SERIES

Elevation A • 2,895 sq.ft.
→ Elevation B • 2,880 sq.ft.

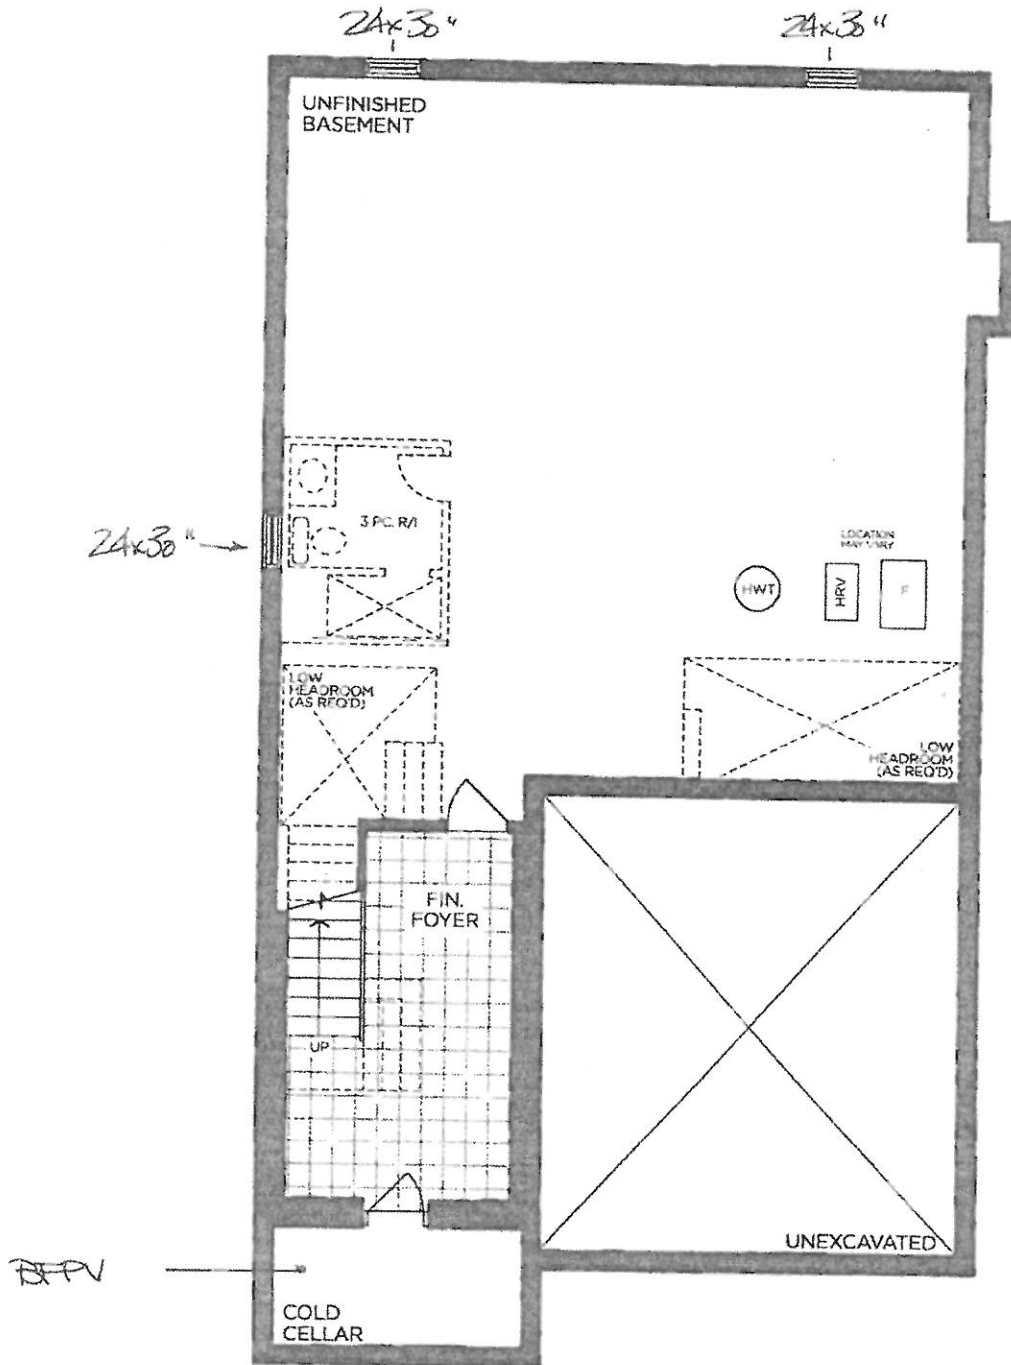

BASEMENT | ELEV. A

VENDOR

PURCHASER

PURCHASER


GOLDPARK
WORTH MORE™

Prices, figures, illustrations, sizes, features and finishes are subject to change without notice. Areas and dimensions are approximate and actual usable floor space may vary from the stated area. Layout may be reverse of the unit purchased. E. & O.E. 4001

PLUMBING UPGRADES



MOEN - FLARA
Two-Handle High Arc Lav Faucet

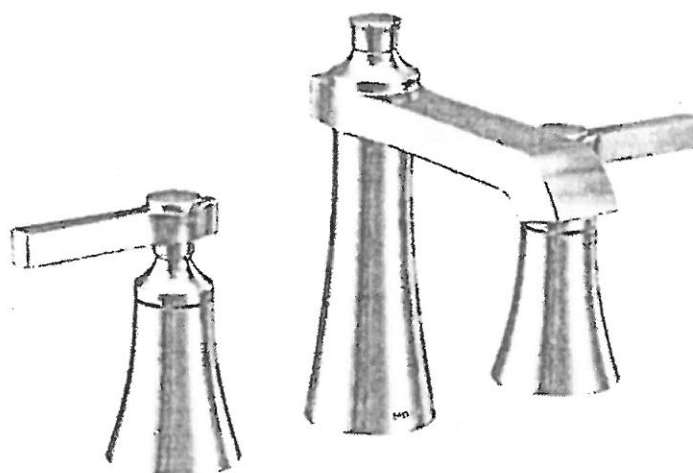

- ☒ CHROME
- ☐ BRUSHED NICKEL (BN)
- ☐ POLISHED NICKEL (NL)
- ☐ BRUSHED GOLD (BG)

MODEL: TS6984 / 69000


Lot# PV-19	Date: April 30, 2021	Room: Master Ensuite x2
Signature: <i>[Signature]</i>		
Signature:		

PLUMBING UPGRADES



MOEN - FLARA

Posi-Temp SHOWER ONLY* Slide Bar with Hand Shower

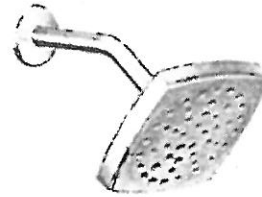


☒ CHROME

☐ BRUSHED NICKEL (BN)

*from WALL

MODEL: TS2912EP / 62320 / UTS4911 / U361CI / 3668EP / A725

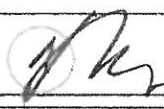Lot# PV-19	Date: Apr. 30, 2021	Room: Master Ensuite
Signature: 		
Signature:		





PINE VALLEY
FOREVERGREEN

PLUMBING UPGRADES

MOEN - ALIGN

Posi-Temp SHOWER ONLY* with 3 Function Transfer Valve/Trim and Slide Bar
with Handshower

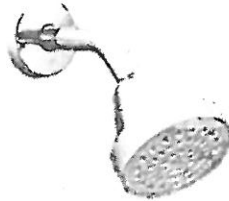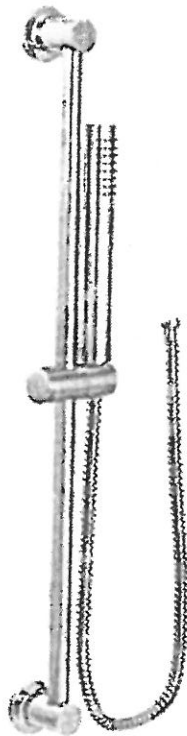

☒ CHROME

☐ BRUSHED NICKEL (BN)

☐ BRUSHED GOLD (BG)

☐ MATTE BLACK (BL)

from WALL

MODEL: T2192EP / U361CI / UT4191 / 62320 / 3887EP / A725

Lot# PV-19

Date: Apr 30, 2021

Room: Ensuite 2

Signature:

Signature:



GOLDPARK
WORTH HOUSING

PLUMBING UPGRADES



MOEN - 90 DEGREE

Posi-Temp Tub/Shower Faucet with 3 Function Transfer Valve/Trim & Slide Bar
with Hand Shower

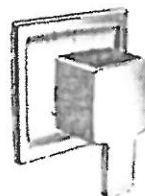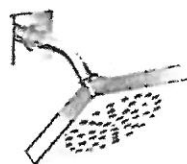

☒ CHROME

☐ BRUSHED NICKEL (BN)

* from WALL

MODEL: TS2713EP / U361CI / UTS4172 / 62320 / S3879EP / A721

Lot# PV-19	Date: Apr. 30, 2021	Room: Main Bath
Signature: 		
Signature:		



CONSTRUCTION SUMMARY

Lot: 19
Model: 40.01 B SUMMERDALE
Project/Phase: Pine Valley Forevergreen / 1

NETWORK AND WIRING

Invoice	Qty.	Description
2725 72,256 04May21	1	FAMILY ROOM: ADDITIONAL RG6 HIGH SPEED TV / INTERNET OUTLETS - LOCATE APPROX 48" A.F.F. SEE PLAN FOR LOCATION
2725 72,258 04May21	3	BEDROOM 2 / BEDROOM 3 / BEDROOM 4: ADDITIONAL CAT6 ETHERNET OUTLET - EACH SEE PLAN FOR LOCATION
2725 72,264 04May21	2	MASTER BEDROOM + LAUNDRY ROOM: ROUGH - IN FOR EXTRA SECURITY KEY PAD
2725 72,261 04May21	1	KITCHEN: INSTALL VAC PAN UNDER KITCHEN SINK

PAINT

Invoice	Qty.	Description
2725 04May21 NoCat	1	**CUSTOM LAYOUT** MASTER ENSUITE: DELETE WATER CLOSET AND ADJUST VANITY/WIC WALL TO BE STRAIGHT (NOT JOGGED). ADD FULL HEIGHT NIBB WALL BETWEEN VANITY/TOILET. CONTINUE CLOSET ROD/SHELF - SEE PLAN FOR LOCATION INCLUDED IN APS BASED ON STANDARD FINISHES
2725 72,690 04May21 **	1	DELETE KITCHEN BULKHEAD, IF POSSIBLE, SITE APPROVAL REQUIRED WILL BE A GAP APPROX.12"H TO CEILING IF NO ADDITIONAL CABINETRY IS PURCHASED



CONSTRUCTION SUMMARY

Lot: 19
Model: 40.01 B SUMMERDALE
Project/Phase: Pine Valley Forevergreen / 1

PLUMBING

Invoice	Qty.	Description
2725 72,332 04May21	1	KITCHEN: ROUGH-IN 1/4" COLD WATER LINE TO FRIDGE
2725 04May21 NoCat	1	ENSUITE 2: MOEN 'ALIGN' RAIN SHOWER + HAND SHOWER/SLIDE BAR - CHROME
2725 04May21 NoCat	1	MASTER ENSUITE: MOEN 'FLARA' RAIN SHOWER + HAND SHOWER/SLIDE BAR
2725 04May21 NoCat	2	MASTER ENSUITE: MOEN 'FLARA' 2 HANDLE, HIGH ARC LAV FAUCET
2725 04May21 NoCat	1	MAIN BATH: MOEN 90* SHOWER + TOE TESTER -CHROME
2725 04May21 NoCat	1	**NOTE** MASTER ENSUITE / MAIN BATH / ENSUITE 2: RAISE ALL SHOWER HEADS TO APPROX 7'-0" A.F.F. IN LIEU OF STANDARD HEIGHT

WINDOWS AND DOORS

Invoice	Qty.	Description
2725 72,351 04May21 **	3	BASEMENT WINDOWS - UPGRADE BASEMENT WINDOW SIZE TO 30 " X 24" - 8" FRAME