




ROSSHAVEN CRESCENT



ROSSHAVEN CRESCENT

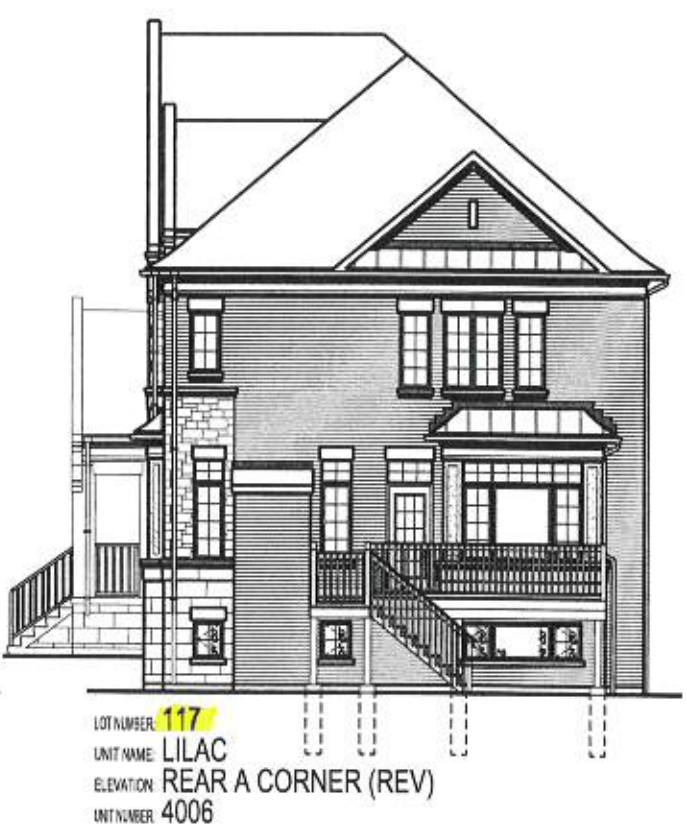

W/S 117, 118, 123

It is the builder's complete responsibility to ensure that all plans submitted for approval fully comply with the Architectural Guidelines and all applicable regulations and requirements including zoning provisions and any provisions in the subdivision agreement. The Control Architect is not responsible in any way for examining or approving site (lotting) plans or working drawings with respect to any zoning or building code or permit matter or that any house can be properly built or located on its lot.

This is to certify that these plans comply with the applicable Architectural Design Guidelines approved by the City of VAUGHAN.

ARCHITECTURAL REVIEW & APPROVAL
MAR 10 2020
John G. Williams Limited, Architect

LEGEND:

- 1 BRICK STONE VENEER ON SIDES OF STAIRS (POURED OR BRICK LOGS PRECAST)
- 2 DROP OR RAISE BANDING BY AMOUNT INDICATED
- 3 ADD BANDING AND/OR TRIM AS INDICATED
- 4 ADDED CAMBERED HEADERS
- 5 8'-0" X 8'-0" GARAGE DOORS
- 6 DROPPED OR RAISED SOFT AS INDICATED
- 7 ADJUSTED ROOF OVERHANG AS INDICATED ON ROOF PLAN
- 8 PROVIDE GUARD RAIL CONSTRUCTION NOTE 11
- 9 FOYER SUNKEN AS INDICATED
- 10 LIGHT FIXTURE RELOCATED AS INDICATED

HUNT
DESIGN ASSOCIATES INC.
www.hunt-design.ca

GOLDPARK HOMES - 217020
PINE VALLEY, VAUGHAN ONT.

8966 Woodbine Ave, Markham, ON L3R 0J7 • T 905.737.5133 • F 905.737.7326 • 2018/09/11 • OF • 217020WSS01

LOTS 117, 118, 123

PAGE XX