



CONSTRUCTION SUMMARY

Lot: 154
Model: 40.00 A BRIARWOOD
Project/Phase: Pine Valley Forevergreen / 1

APPLIANCES

Invoice	Qty.	Description
2453 72,218 24Sep20 **	1	KITCHEN - UPGRADE TO 8" DUCT (INTERIOR WALL) IN LIEU OF STANDARD OFFERING
2453 24Sep20 NoCat	1	SUBZERO . WOLF APPLIANCE PACKAGE: 36" FRIDGE/FREEZER #IT-36CI 30" GAS RANGE #GR304 24" DISHWASHER #DW2450WS 30" SIRIUS CHIMNEY HOOD #SU5430X INCLUDED IN APS
2474 25Nov20 NoCat	1	**DELETE** APPLIANCE PACKAGE (FROM ORDER PE.2453) PURCHASER AMENDED APS TO DELETE APPLIANCE PACKAGE AND ADD BONUS DOLLAR PACKAGE
2572 03Feb21 NoCat	1	APPLIANCE SPECIFICATIONS PROVIDED BY PURCHASER - SIGNED COPY

BASEMENT WINDOWS

Invoice	Qty.	Description
2453 72,351 24Sep20	4	BASEMENT WINDOWS - UPGRADE BASEMENT WINDOW SIZE TO 30 " X 24" - 8" FRAME

CERAMIC

Invoice	Qty.	Description
2571 49 18Mar21	1	MASTER ENSUITE - ALT. GROUND FLOOR: TILE, WALL, LEVEL 3 - 12x24" LAID IN HORIZTONAL, STACKED PATTERN
2571 35 18Mar21	1	LAUNDRY - ALT. GROUND FLOOR: TILE, FLOOR , LEVEL 3 - 12x24" LAID IN STRAIGHT, STACKED PATTERN. SEE PLAN FOR TILE DIRECTION
2571 35 18Mar21	1	SHARED BATH - ALT. GROUND FLOOR: TILE, FLOOR , LEVEL 3 - 12x24" LAID IN STRAIGHT, STACKED PATTERN. SEE PLAN FOR TILE DIRECTION
2571 49 18Mar21	1	SHARED BATH - ALT. GROUND FLOOR: TILE, WALL, LEVEL 3 - 12x24" LAID IN HORIZONTAL, STACKED PATTERN
2571 35 18Mar21	1	MASTER ENSUITE - ALT. GROUND FLOOR: TILE, FLOOR , LEVEL 3 - 12x24" LAID IN STRAIGHT, STACKED PATTERN. SEE PLAN FOR TILE DIRECTION
2571 18Mar21 NoCat	1	FYI - KITCHEN: VINTAGE SERIES, 5" WHITE OAK, NSS ENGINEERED HARDWOOD, 3/4" THK, WIREBRUSH TEXTURE, UV OIL FINISH - LEVEL 3 DO NOT SUPPLY/INSTALL CERAMIC IN KITCHEN (CREDIT)



CONSTRUCTION SUMMARY

Lot: 154
Model: 40.00 A BRIARWOOD
Project/Phase: Pine Valley Forevergreen / 1

DRYWALL

Invoice	Qty.	Description
2453 24Sep20 NoCat	1	GREAT ROOM / MASTER BEDROOM: INSTALL SOUND DAMPENING INSULATION IN WALL BETWEEN GREAT ROOM AND MASTER BEDROOM INCLUDED IN APS
2453 24Sep20 NoCat	1	**CUSTOM REQUEST** ADD SOUND DAMPENING INSULATION IN WALL BETWEEN KITCHEN/HALL AND MASTER ENSUITE/LAUNDRY
2453 72,351 24Sep20 **	4	BASEMENT WINDOWS - UPGRADE BASEMENT WINDOW SIZE TO 30 " X 24" - 8" FRAME
2453 72,690 24Sep20 **	1	DELETE KITCHEN BULKHEAD, IF POSSIBLE, SITE APPROVAL REQUIRED
2453 72,373 24Sep20	1	MASTER BEDROOM: MODEL OPTIONS 40.00 - MASTER BEDROOM - OPT. 11 FOOT TRAY CEILING - **SQUARE TRAY** (NOT ANGLED)
2453 24Sep20 NoCat	1	FRONT FOYER: DELETE CLOSET INCLUDED IN APS
2474 25Nov20 NoCat	1	*****NOTE***** DELETE KITCHEN BULKHEAD, IF POSSIBLE, SITE APPROVAL REQUIRED VENTILATION WILL BE EXPOSED ABOVE UPPER CABINETS *UNLESS ADDITIONAL KITCHEN CABINETRY IS PURCHASED AT COLOUR APPOINTMENT* EITHER EXTENDED FURRING PANEL OR STACKED UPPERS MUST BE PURCHASED TO CONCEAL VENTILATION
2474 25Nov20 NoCat	1	**CLARIFICATION NOTE** DELETE FRONT FOYER CLOSET ENTIRELY, EXTEND RAILING AT LANDING

ELECTRICAL

Invoice	Qty.	Description
2453 72,351 24Sep20 **	4	BASEMENT WINDOWS - UPGRADE BASEMENT WINDOW SIZE TO 30 " X 24" - 8" FRAME
2453 72,268 24Sep20	1	GREAT ROOM: INTERIOR WALL OUTLET: 110V WALL INTERIOR RECEPTACLE ON EXISTING CIRCUIT - LOCATE ABOVE FIREPLACE, APPROX 66" A.F.F.
2453 72,289 24Sep20	6	KITCHEN: 4" E/S LED INTERIOR POT LIGHT - GROUND FLOOR - EACH - INCLUDES 1 SWITCH INCLUDED IN APS
2453 72,289 24Sep20	2	KITCHEN: 4" E/S LED INTERIOR POT LIGHT - GROUND FLOOR - EACH - LOCATE APPROX CENTERED ABOVE ISLAND - USE STANDARD SWITCH
2453 72,289 24Sep20	4	MAIN HALL: 4" E/S LED INTERIOR POT LIGHT - GROUND FLOOR - EACH IN LIEU OF STANDARD LIGHTS, USE STANDARD SWITCH
2453 72,289 24Sep20	2	FOYER: 4" E/S LED INTERIOR POT LIGHT - GROUND FLOOR - EACH - IN LIEU OF STANDARD CEILING LIGHT - SEE PLAN FOR LOCATION USE STANDARD SWITCH
2474 72,291 25Nov20	2	FRONT: EXTERIOR LED SOFFIT POT LIGHT - EACH LOCATE APPROX CENTERED ABOVE EACH GARAGE DOOR - IN LIEU OF STANDARD COACH LIGHT. USE STANDARD SWITCH
2474 72,290 25Nov20	8	GREAT ROOM: 4" E/S LED INTERIOR POT LIGHT (INSULATED CEILING) - SECOND FLOOR - EACH IN LIEU OF STANDARD LIGHT - USE STANDARD SWITCH
2474 72,290 25Nov20	4	BREAKFAST ROOM: 4" E/S LED INTERIOR POT LIGHT (INSULATED CEILING) - SECOND FLOOR - EACH - SEE PLAN FOR LOCATION IN ADDITION TO STANDARD CEILING LIGHT
2474 72,278 25Nov20	1	BREAKFAST: ADDITIONAL INTERIOR SWITCH FOR POTLIGHTS
2474 72,290 25Nov20	4	FORMAL ROOM: 4" E/S LED INTERIOR POT LIGHT (INSULATED CEILING) - SECOND FLOOR - EACH IN ADDITION TO STANDARD LIGHT SEE PLAN FOR LOCATION
2474 72,278 25Nov20	1	FORMAL ROOM: ADDITIONAL INTERIOR SWITCH FOR POTLIGHTS
2474 72,289 25Nov20	1	STAIR LANDING (AT POWDER ROOM) 4" E/S LED INTERIOR POT LIGHT - GROUND FLOOR - EACH ON SAME SWITCH AS HALL POTLIGHTS

ELECTRICAL

Invoice	Qty.	Description
2474 72,307 25Nov20	1	MAIN HALL AT STAIRS: RELOCATE STANDARD CEILING MOUNT FIXTURE - CENTER TO ROOM (GARAGE WALL/EXTERIOR WALL)- SEE PLAN FOR LOCATION
2474 72,289 25Nov20	2	MASTER BEDROOM: 4" E/S LED INTERIOR POT LIGHT - GROUND FLOOR - EACH - ADD 2 POTLIGHTS BETWEEN DOOR/CLOSET - SAME SWITCH AS STANDARD LIGHT IN LIEU OF STANDARD LIGHT
2474 72,290 25Nov20	1	UPPER HALL: 4" E/S LED INTERIOR POT LIGHT (INSULATED CEILING) - SECOND FLOOR - EACH IN LIEU OF STANDARD CEILING LIGHT
2474 25Nov20 NoCat	1	*NOTE* POTLIGHTS IN KITCHEN TO BE IN LIEU OF STANDARD LIGHTS
2474 72,288 25Nov20	2	FOYER: ROUGH-IN FOR ADDITIONAL WALL SCONCE (1) CAPPED OUTLET ON EXISTING SWITCH - FIXTURE NOT INCLUDED LOCATE APPROX 67" A.F.F.
2474 72,278 25Nov20	1	FOYER: ADDITIONAL INTERIOR SWITCH FOR WALL SCONCES
2474 72,273 25Nov20	1	KITCHEN: 110V WALL RECEPTACLE ON SEPARATE CIRCUIT - GAS FIRED APPLIANCE - FOR AUX. EQUIPMENT - NOT A STOVE PLUG FOR COOKTOP
2474 72,272 25Nov20	1	KITCHEN: 110V WALL RECEPTACLE ON SEPARATE CIRCUIT - FOR MICROWAVE - MICROWAVE NOT INCLUDED
2474 72,282 25Nov20	1	KITCHEN: ADDITIONAL 220V RECEPTACLE ON A SEPARATE CIRCUIT - FOR BUILT-IN WALL OVEN - APPLIANCE NOT INCLUDED - DOES NOT INCLUDE BREAKER THAT IS TO BE INSTALLED BY LICENSED ELECTRICIAN AND ARRANGED BY HOMEOWNER AFTER CLOSING SEE PLAN FOR LOCATION
2571 18Mar21 NoCat	1	**NOTE** STANDARD KITCHEN WILL NOT COORDINATE WITH APPLIANCE SPECS PROVIDED STANDARD CABINETRY MAY HAVE ELECTRICAL CUT INTO BACKS OF CABINETS PURCHASER INTENDS TO REPLACE KITCHEN CABINETRY AFTER CLOSING

EXTERIOR COLOURS

Invoice	Qty.	Description
2453 24Sep20 NoCat	1	EXTERIOR BRICK PACKAGE BR2

FIREPLACE

Invoice	Qty.	Description
2453	1	GREAT ROOM: FIREPLACE FAN KIT
24Sep20 NoCat		

FORM - FORMING

Invoice	Qty.	Description
2453	4	BASEMENT WINDOWS - UPGRADE BASEMENT WINDOW SIZE TO 30 " X 24" - 8" FRAME
72,351		
24Sep20 **		

FORMING

Invoice	Qty.	Description
2453	1	PINE VALLEY MODEL 40.00 BRIARWOOD ELEV A OR B - 9 FOOT BASEMENT CEILING HEIGHT IN LIEU OF STANDARD 8 FOOT CEILING.
72,191		
24Sep20		

FRAMING

Invoice	Qty.	Description
2453	1	FRONT FOYER: DELETE CLOSET
24Sep20 NoCat		INCLUDED IN APS
2453	1	2ND FLOOR LOFT - INSTALL RAILING IN LIEU OF HALF WALL
24Sep20 NoCat		INCLUDED IN APS
2453	1	DELETE KITCHEN BULKHEAD, IF POSSIBLE, SITE APPROVAL REQUIRED
72,690		
24Sep20		
2474	1	*****NOTE***** DELETE KITCHEN BULKHEAD, IF POSSIBLE, SITE APPROVAL REQUIRED VENTILATION WILL BE EXPOSED ABOVE UPPER CABINETS *UNLESS ADDITIONAL KITCHEN CABINETRY IS PURCHASED AT COLOUR APPOINTMENT* EITHER EXTENDED FURRING PANEL OR STACKED UPPERS MUST BE PURCHASED TO CONCEAL VENTILATION
72,690		
25Nov20		
2474	1	**CLARIFICATION NOTE** DELETE FRONT FOYER CLOSET ENTIRELY, EXTEND RAILING AT LANDING
25Nov20 NoCat		

GLASS AND MIRROR

Invoice	Qty.	Description
2571	1	THRU OUT: DO NOT SUPPLY/INSTALL MIRRORS
18Mar21 NoCat		
2571	2	MASTER ENSUITE + SHARED BATH: UPGRADE SHOWER DOOR HARDWARE TO MT6X6 CHROME
18Mar21 NoCat		

GRANITE MARBLE QUARTZ

Invoice	Qty.	Description
2571 18Mar21 NoCat	1	MASTER ENSUITE: UPGRADE 6 QUARTZ COUNTER
2571 18Mar21 NoCat	1	SHARED ENSUITE: UPGRADED 6 QUARTZ COUNTER
2571 101,930 18Mar21	1	LAUNDRY: UPGRADE QUARTZ COUNTERTOP - LEVEL 4 NOT ABOVE MACHINES, CABINET ONLY

HARDWOOD

Invoice	Qty.	Description
2571 101,930 18Mar21	1	FOYER: VINTAGE SERIES, 5" WHITE OAK, NSS ENGINEERED HARDWOOD, 3/4" THK, WIREBRUSH TEXTURE, UV OIL FINISH - LEVEL 3
2571 101,930 18Mar21	1	KITCHEN: VINTAGE SERIES, 5" WHITE OAK, NSS ENGINEERED HARDWOOD, 3/4" THK, WIREBRUSH TEXTURE, UV OIL FINISH - LEVEL 3
2571 101,930 18Mar21	1	THRU OUT STANDARD AREAS: FORMAL ROOM/MAIN HALL, GREAT ROOM, MASTER BEDROOM, BEDROOM 3, BEDROOM 4, MEDIA ROOM/LOFT - VINTAGE SERIES, 5" WHITE OAK, NSS ENGINEERED HARDWOOD, 3/4" THK, WIREBRUSH TEXTURE, UV OIL FINISH - LEVEL 3

HVAC

Invoice	Qty.	Description
2453 72,218 24Sep20	1	KITCHEN - UPGRADE TO 8" DUCT (INTERIOR WALL) IN LIEU OF STANDARD OFFERING
2453 72,690 24Sep20 **	1	DELETE KITCHEN BULKHEAD, IF POSSIBLE, SITE APPROVAL REQUIRED
2474 72,224 25Nov20	1	KITCHEN: GAS LINE ROUGH-IN - MAIN FLOOR FOR GAS COOKTOP - SEE PLAN FOR LOCATION

INTERIOR DOORS AND TRIM

Invoice	Qty.	Description
2453 72,645 24Sep20	9	THRU OUT: ADDITIONAL FOR SAFE & SOUND (SOLID CORE) NOT INCLUDING CLOSETS

INTERIOR TRIM /MOULDINGS

Invoice	Qty.	Description
2453 72,351 24Sep20 **	4	BASEMENT WINDOWS - UPGRADE BASEMENT WINDOW SIZE TO 30 " X 24" - 8" FRAME

INTERIOR TRIM AND DOORS

Invoice	Qty.	Description
2474 25Nov20 NoCat	1	**CLARIFICATION NOTE** DELETE FRONT FOYER CLOSET ENTIRELY, EXTEND RAILING AT LANDING
2571 155,926 18Mar21	1	THRU OUT: ADD FOR HINGES 3X3 SQUARE FLAT TIP THROUGHOUT - BLACK UPGRADE
2571 153,776 18Mar21	1	THRU OUT; HALIFAX LEVER, IRON BLACK INTERIOR DOOR HARDWARE UPGRADE
2571 153,180 18Mar21	1	THRU OUT: UPGRADE 3 1/2" WEST END CASING, 6 1/2" BASE BASEBOARD UPGRADE
2571 155,350 18Mar21	1	THRU OUT: UPGRADE INTERIOR DOORS TO LINCOLN PARK, UPGRADE

KITCHEN AND BATH CABINETRY

Invoice	Qty.	Description
2453 72,218 24Sep20 **	1	KITCHEN - UPGRADE TO 8" DUCT (INTERIOR WALL) IN LIEU OF STANDARD OFFERING
2453 72,690 24Sep20 **	1	DELETE KITCHEN BULKHEAD, IF POSSIBLE, SITE APPROVAL REQUIRED
2474 25Nov20 NoCat	1	*****NOTE***** DELETE KITCHEN BULKHEAD, IF POSSIBLE, SITE APPROVAL REQUIRED VENTILATION WILL BE EXPOSED ABOVE UPPER CABINETS *UNLESS ADDITIONAL KITCHEN CABINETRY IS PURCHASED AT COLOUR APPOINTMENT* EITHER EXTENDED FURRING PANEL OR STACKED UPPERS MUST BE PURCHASED TO CONCEAL VENTILATION
2571 101,930 18Mar21	1	THRU OUT: SEE CABINETRY SCHEDULE
2571 18Mar21 NoCat	1	**NOTE** STANDARD KITCHEN WILL NOT COORDINATE WITH APPLIANCE SPECS PROVIDED STANDARD CABINETRY MAY HAVE ELECTRICAL CUT INTO BACKS OF CABINETS PURCHASER INTENDS TO REPLACE KITCHEN CABINETRY AFTER CLOSING

MASONRY

Invoice	Qty.	Description
2474 25Nov20 NoCat	2	FRONT: EXTERIOR LED SOFFIT POT LIGHT - EACH LOCATE APPROX CENTERED ABOVE EACH GARAGE DOOR - IN LIEU OF STANDARD COACH LIGHT. USE STANDARD SWITCH

NETWORK AND WIRING

Invoice	Qty.	Description
2453 72,264 24Sep20	1	LAUNDRY ROOM: ROUGH - IN FOR EXTRA SECURITY KEY PAD
2474 72,256 25Nov20	2	BEDROOM 3 + BEDROOM 4: ADDITIONAL RG6 HIGH SPEED TV / INTERNET OUTLETS - SEE PLAN FOR LOCATION
2474 72,260 25Nov20	1	CONDUIT PIPE - FROM ATTIC TO BASEMENT - FROM NEAR ELECTRICAL PANEL IN BASEMENT TO APPROX CENTER OF ATTIC
2474 25Nov20 NoCat	3	GREAT ROOM AND FORMAL ROOM: ADD SPEAKER WIRING TO GREAT ROOM (2) AND FORMAL ROOM (1) SEE PLAN FOR LOCATION

PAINT

Invoice	Qty.	Description
2474 25Nov20 NoCat	1	*****NOTE***** DELETE KITCHEN BULKHEAD, IF POSSIBLE, SITE APPROVAL REQUIRED VENTILATION WILL BE EXPOSED ABOVE UPPER CABINETS *UNLESS ADDITIONAL KITCHEN CABINETRY IS PURCHASED AT COLOUR APPOINTMENT* EITHER EXTENDED FURRING PANEL OR STACKED UPPERS MUST BE PURCHASED TO CONCEAL VENTILATION
2474 25Nov20 NoCat	1	**CLARIFICATION NOTE** DELETE FRONT FOYER CLOSET ENTIRELY, EXTEND RAILING AT LANDING

PAINTING

Invoice	Qty.	Description
2453 72,351 24Sep20 **	4	BASEMENT WINDOWS - UPGRADE BASEMENT WINDOW SIZE TO 30 " X 24" - 8" FRAME
2453 72,690 24Sep20 **	1	DELETE KITCHEN BULKHEAD, IF POSSIBLE, SITE APPROVAL REQUIRED

PANL - FRAMING

Invoice	Qty.	Description
2453 72,351 24Sep20 **	4	BASEMENT WINDOWS - UPGRADE BASEMENT WINDOW SIZE TO 30 " X 24" - 8" FRAME
2453 72,690 24Sep20 **	1	DELETE KITCHEN BULKHEAD, IF POSSIBLE, SITE APPROVAL REQUIRED

PLUMBING

Invoice	Qty.	Description
2453 72,332 24Sep20	1	KITCHEN; ROUGH-IN 1/4" COLD WATER LINE TO FRIDGE
2453 72,617 24Sep20	1	MASTER ENSUITE: MIROLIN STRADE PRE-FORMED SHOWER BASE (60X 36) IN LIEU OF A STANDARD TUB (BASE ONLY)
2453 72,616 24Sep20	1	SHARED BATHROOM: MIROLIN STRADE PRE-FORMED SHOWER BASE (30X 60) IN LIEU OF A STANDARD TUB (BASE ONLY)

PLUMBING FIXTURES

Invoice	Qty.	Description
2571 101,930 18Mar21	1	LAUNDRY: UPGRADE MOEN 'STO' SINGLE HANDLE PULLOUT FAUCET - CHROME SEE ATTACHED
2571 101,930 18Mar21	1	LAUNDRY: UPGRADE BLANCO QUATRUS R15 UNDERMOUNT LAUNDRY SINK - STAINLESS SEE ATTACHED

ROUGH CARPENTRY

Invoice	Qty.	Description
2453 72,351 24Sep20 **	4	BASEMENT WINDOWS - UPGRADE BASEMENT WINDOW SIZE TO 30 " X 24" - 8" FRAME

STAIRS AND RAILINGS

Invoice	Qty.	Description
2453 24Sep20 NoCat	1	2ND FLOOR LOFT - INSTALL RAILING IN LIEU OF HALF WALL INCLUDED IN APS
2474 25Nov20 NoCat	1	**CLARIFICATION NOTE** DELETE FRONT FOYER CLOSET ENTIRELY, EXTEND RAILING AT LANDING



CONSTRUCTION SUMMARY

Lot: 154
Model: 40.00 A BRIARWOOD
Project/Phase: Pine Valley Forevergreen / 1

TRIM AND DOORS

Invoice	Qty.	Description
2571 101,930 18Mar21	2	MASTER BEDROOM + MASTER WALK-IN CLOSET: ADD PRIVACY LOCK. SEE FLOORPLAN FOR LOCATION

WINDOWS - BASEMENT

Invoice	Qty.	Description
2453 72,351 24Sep20 **	4	BASEMENT WINDOWS - UPGRADE BASEMENT WINDOW SIZE TO 30 " X 24" - 8" FRAME

WINDOWS AND DOORS

Invoice	Qty.	Description
2453 24Sep20 NoCat	1	GREAT ROOM: 96" GARDEN DOOR ASSEMBLY
2453 24Sep20 NoCat	1	THRU OUT: BLACK INTERIOR WINDOWS
2474 25Nov20 NoCat	-1	**DELETE** BLACK INTERIOR WINDOWS (from pe.2453)

Purchasers: Harmeet S Kuner & Sandesh Kuner

Property: 154 of Plan -

Telephone Res. / Bus: / (647) 527-7948

Project: Pine Valley Forevergreen - Phase 1

Decor Advisor: Angela Phim

Model and Elevation: 40.00 A BRIARWOOD

Layout Changes: Yes No

Sketch Attached: Yes No

Exterior Colour Scheme:

1. Cabinetry

Table with 4 columns: Room, Style and Colour, Counter, Hardware. Rows include Kitchen / Breakfast, Laundry Room, Powder Room, Master Ensuite Bathroom, Second Ensuite Bathroom (If Applicable), and Shared Ensuite.

Comment

2. Floor Tile

Table with 2 columns: Room, Selection. Rows include Entrance Vestibule, Main Hall, Kitchen / Breakfast, Laundry Room, Powder Room, Master Ensuite Bathroom, Second Ensuite Bathroom (If Applicable), Lower Landing (If Applicable), and Shared Ensuite.

Comment

3. Wall Tile

Table with 4 columns: Room, Selection, Listello/Inserts, Describe. Rows include Master Ensuite Bathroom (Tub Deck, Shower Stall, Bathroom Walls), Second Ensuite Bathroom (If Applicable), Shared Ensuite, and Kitchen Backsplash.

Comment

Handwritten signature/initials inside a circle.

Purchasers:
Harmeet S Kuner & Sandesh Kuner
Telephone Res. / Bus:
/ (647) 527-7948
Decor Advisor:
Angela Phim

Property:
154 of Plan -
Project:
Pine Valley Forevergreen - Phase 1
Model and Elevation:
40.00 A BRIARWOOD

4. Plumbing Fixtures

Second Ensuite

Powder Room

Master Ensuite Bathroom

Other Room - Specify

Other Washroom

Comment

See Extras

5. Hardwood Flooring

	Type and Stain		Type and Stain
Main Hall		Upper Landing	
Kitchen / Breakfast	*3/4x5" wht oak wirebrush 'Atlantis'	Upper Hall	
Living Room		Master Bedroom	
Dining Room		Bedroom #2	
Family Room		Bedroom #3	
Den/Library		Bedroom #4	
Entrance Vestibule	*3/4x5" wht oak wirebrush 'Atlantis'	Bedroom #5	
Lower Landing (If Applicable)		Other Room - Specify thru-out standard areas	*3/4x5" wht oak wirebrush 'Atlantis'
Comment			

6. Carpeting

	Upgrade	Description
Ground Floor	☐	
Second Floor	☐	
	☐	

Upgrade Underpad

Type
Area

Carpet on Stairs

Capped
Runner - *Upgrade

Comment

7. Fireplace

	Living Room			Family Room			Other Room - Specify			Great Room
	Purchased	As Per Plan	N/A	Purchased	As Per Plan	N/A	Purchased	As Per Plan	N/A	
	☐	☐	☒	☐	☐	☒	☐	☒	☐	
Fireplace Type										Standard Gas
Mantle Type										Mediterranean
Colour / Stain										Arctic White
Surround										n/a
Hearth										None
Comment 										

Purchasers: Harmeet S Kuner & Sandesh Kuner

Property: 154 of Plan -

Telephone Res. / Bus: / (647) 527-7948

Project: Pine Valley Forevergreen - Phase 1

Decor Advisor: Angela Phim

Model and Elevation: 40.00 A BRIARWOOD

8. Trim Carpentry

Interior Doors *Lincoln Park Front Door Glass Inserts Standard Door Handles Halifax Blk + hinge
Interior Trim *Board 2
Comment

9. Plaster Mouldings and Medallions

Standard Throughout ☐ Yes ☐ No ☒ N/A

Entrance Vestibule			Kitchen/Breakfast		
Main Hall			Den/Library		
Living Room			Lower Landing		
Dining Room			Other Room - Specify		
Family Room					

Comment

10. Railings and Spindles

Railing Package Standard 2
Railing Colour *Hopscotch
Stringer / Riser *Hopscotch
Spindle Colour *Hopscotch
Treads *Hopscotch
Oak Stairs ☒ Yes ☐ No ☐ N/A
Comment

11. Wall Paint / Ceilings

Throughout Finished Areas Cool White
Trim Paint White
Smooth Ceilings
Ground Floor ☒
Second Floor ☒
Note

Comment

Scheduled Closing Date: May 31, 2021

Purchasers: Harmeet S Kuner & Sandesh Kuner

Property: 154 of Plan -

Telephone Res. / Bus: / (647) 527-7948

Project: Pine Valley Forevergreen - Phase 1

Decor Advisor: Angela Phim

Model and Elevation: 40.00 A BRIARWOOD

12. Electrical

Hood Fan ☐ White ☐ Stainless ☒ N/A

Above Kitchen Cabinet Light ☐ Yes ☒ No

Below Kitchen Cabinet Light ☐ Yes ☒ No

Standard Appliances ☐

Over The Range Microwave ☐

Chimney Style Fan ☐

Comment

13. Heating and Air Conditioning

Air Conditioning

Gas Provisions Stove

Gas Provisions Dryer

Gas Provisions Barbecue


Comment

14. Additional Comments


15. Disclaimers and Notes

- Colours of all materials are as close as possible to builder's selection, but not necessarily identical due to variances in manufacturing.
- Any extras listed above are null and void unless accompanied by a separate invoice/amendment. Said invoice must be paid in full.
- The Purchaser acknowledges that after Interior Colour Selection form is signed and dated, no further changes will be permitted other than re-selection due to unavailability. Purchaser's Initials
- The Purchaser acknowledges reading and accepting the "Gold Park Homes Decor Centre Disclaimers" form. This document contains other miscellaneous disclaimers.

This Interior Colour Selection is final and approved by:

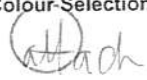Signature: 

Date: March 17, 2021

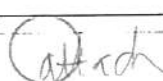

PV - 154 Cabinetry Schedule


ROOM	DESCRIPTION	PRICE	QTY	TOTAL
KITCHEN	RETURN TRIP FOR HARDWOOD		1	\$ \$
MASTER ENSUITE	UPGRADE FROM SERIES 2 TO SERIES 6 - MANHATTAN ANDAMAN INCLUDING LINEN INTERIORS AND ANTHRACITE COLOURED METAL DRAWER BOXES		1	\$
	CONVERT STD BANK OF DRAWERS WITH 3/4" EXT WHITE DRAWERS TO WHITE PUSH TO OPEN FULL EXT		1	\$
	ADD TOUCH LATCH HARDWARE		1	\$ \$
LOFT BATH	UPGRADE FROM SERIES 2 TO SERIES 6 - MANHATTAN ANDAMAN INCLUDING LINEN INTERIORS AND ANTHRACITE COLOURED METAL DRAWER BOXES		1	\$
	CONVERT STD TOP DRAWER TO PUSH TO OPEN WHITE FULL-EXT		1	\$
	ADD TOUCH LATCH HARDWARE		1	\$ \$
CABINETRY TOTAL:				\$

HANDLE PLACEMENT: AT INSTALLERS DISCRETION

LOT #: PV-154

DATE: March 17, 2021

SIGNATURE: 

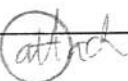SIGNATURE: 

GOLD PARK
WORTH MORE

REVISED:
12/18/2020 15:24

PV-154. H P
 SEPT 11 2020
 PV-154 H P
 NOV. 24 2020
 PV-154 attach
 March 17, 2021
 PV-154 attached
 May 11, 2021
 (S) = SPEAKER WIRING.

THIS PLAN SHOWS
THE OPTIONAL GROUND FLOOR

// = SOUND INSULATION.
in wall

96" GARDEN
DOOR ASSEMBLY

HARDWOOD
IN
KITCHEN/BREAKFAST

OVEN +
MICRO

GAS + ELECT

~~BLACK WATERS
THRU OUT~~
 NO!
 NOV. 16 2020


CENTER
LIGHT to
walls.

RAILING

DELETE
CLOSET

67"
AFF

HARDWOOD

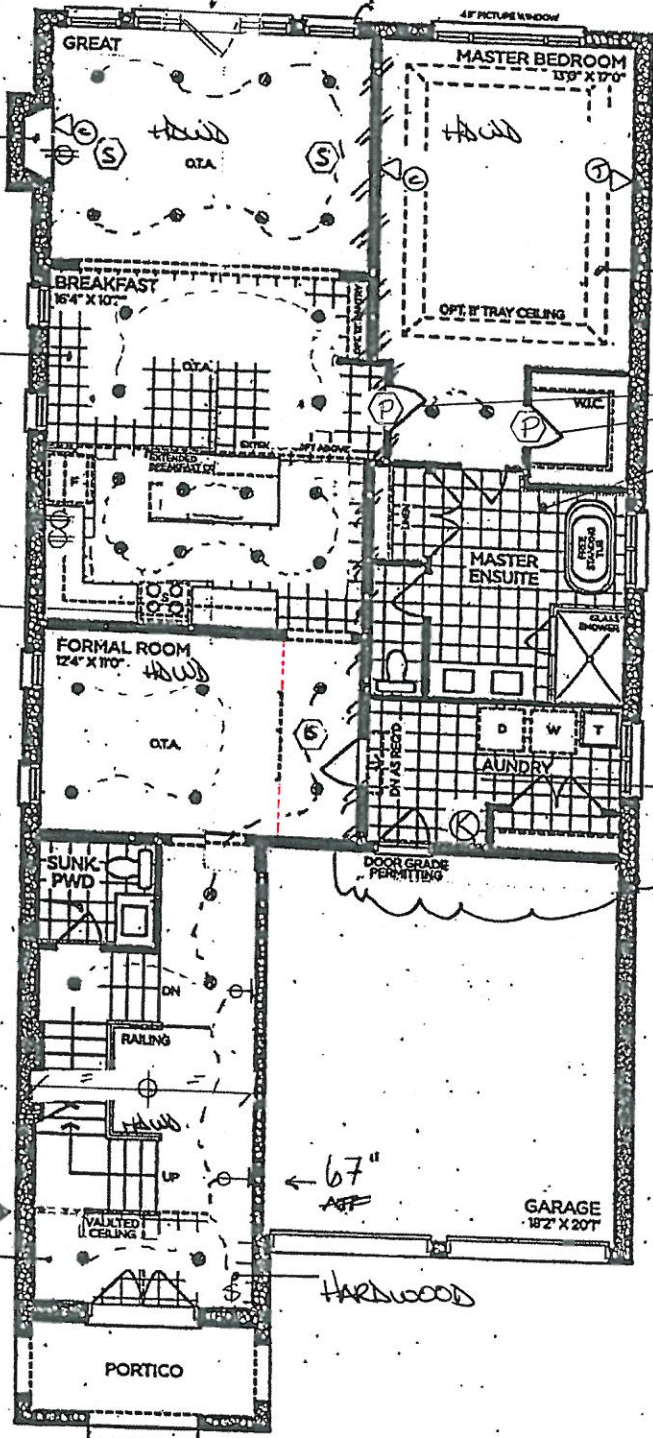

GROUND FLOOR | ELEV. A - ELEV. A.
~~ELEV. B.~~

VENDOR

PURCHASER

PURCHASER

GOLDPARK
WORTH MOR

Prices, figures, illustrations, sizes, features and finishes are subject to change with
 notice. Areas and dimensions are approximate and actual usable floor space may v
 from the stated area. Layout may be reverse of the unit purchased. E. & O.E. 40

SCHEDULE 'F'



PV-154 *Am* *de*
SEPT 11 2020

PV-154 *Am* *de*
Nov 24 2020

PV-154 *attach*
March 17, 2021

The Briarwood 40' SERIES


→ Elevation A • 2,870 sq.ft.
✗ Elevation B • 2,860 sq.ft.

PV-154
REVISED *attached*
May 11, 2021

SQUARE-OFF RAILING

RAILING NOT
1/2 wall

Acrylic shower
BASE

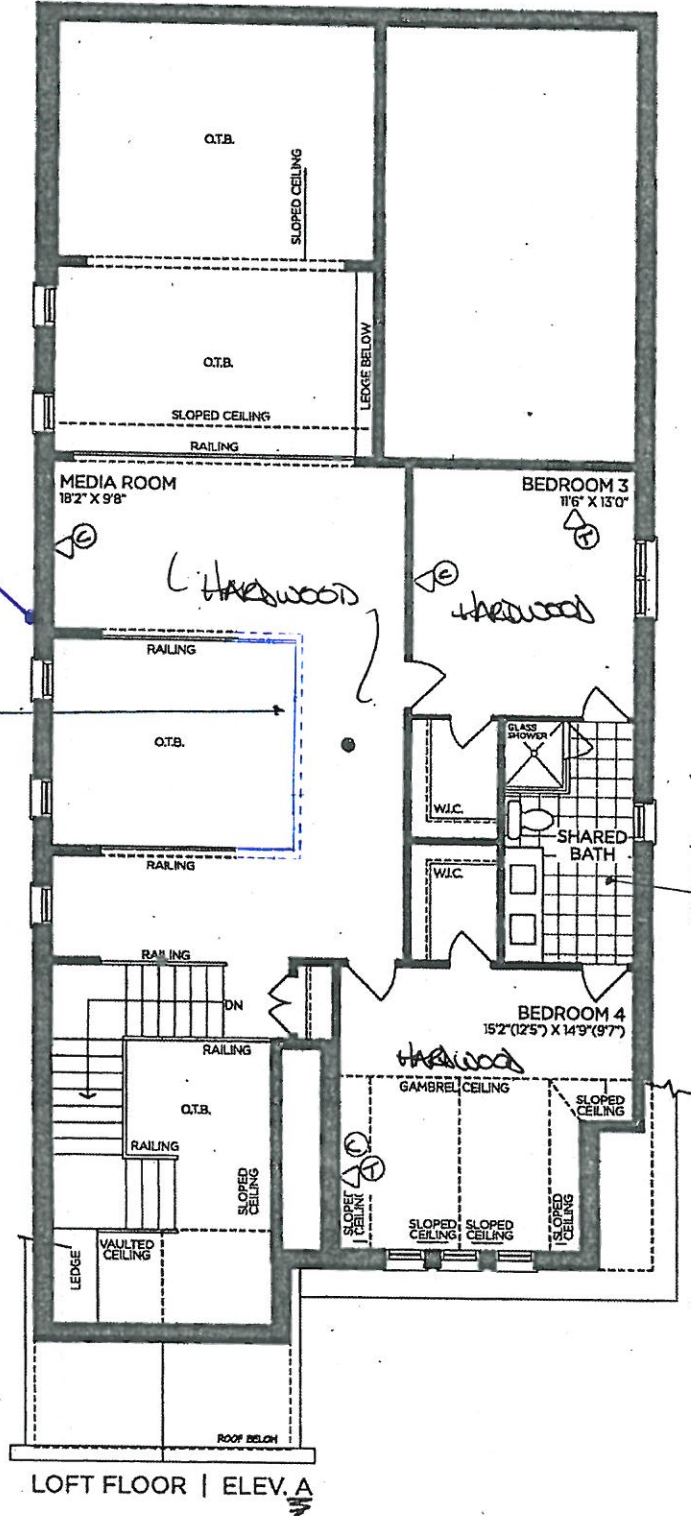

VENDOR
PURCHASER
PURCHASER

GOLDPARK
WORTH MORE™

Prices, figures, illustrations, sizes, features and finishes are subject to change without notice. Areas and dimensions are approximate and actual usable floor space may vary from the stated area. Layout may be reverse of the unit purchased. E. & O.E. 4000

SCHEDULE 'F'




PV-154 *attached*
May 11, 2021

PV-154 *OK* *OP*
~~SEPT 11 2020~~
PV-154 *OK* *OP*
Nov. 24 2020
PV-154 *attach*
March 17, 2021

The Briarwood
40' SERIES

→ Elevation A • 2,870 sq.ft.
→ ~~X~~ Elevation B • 2,860 sq.ft.

9' BASEMENT

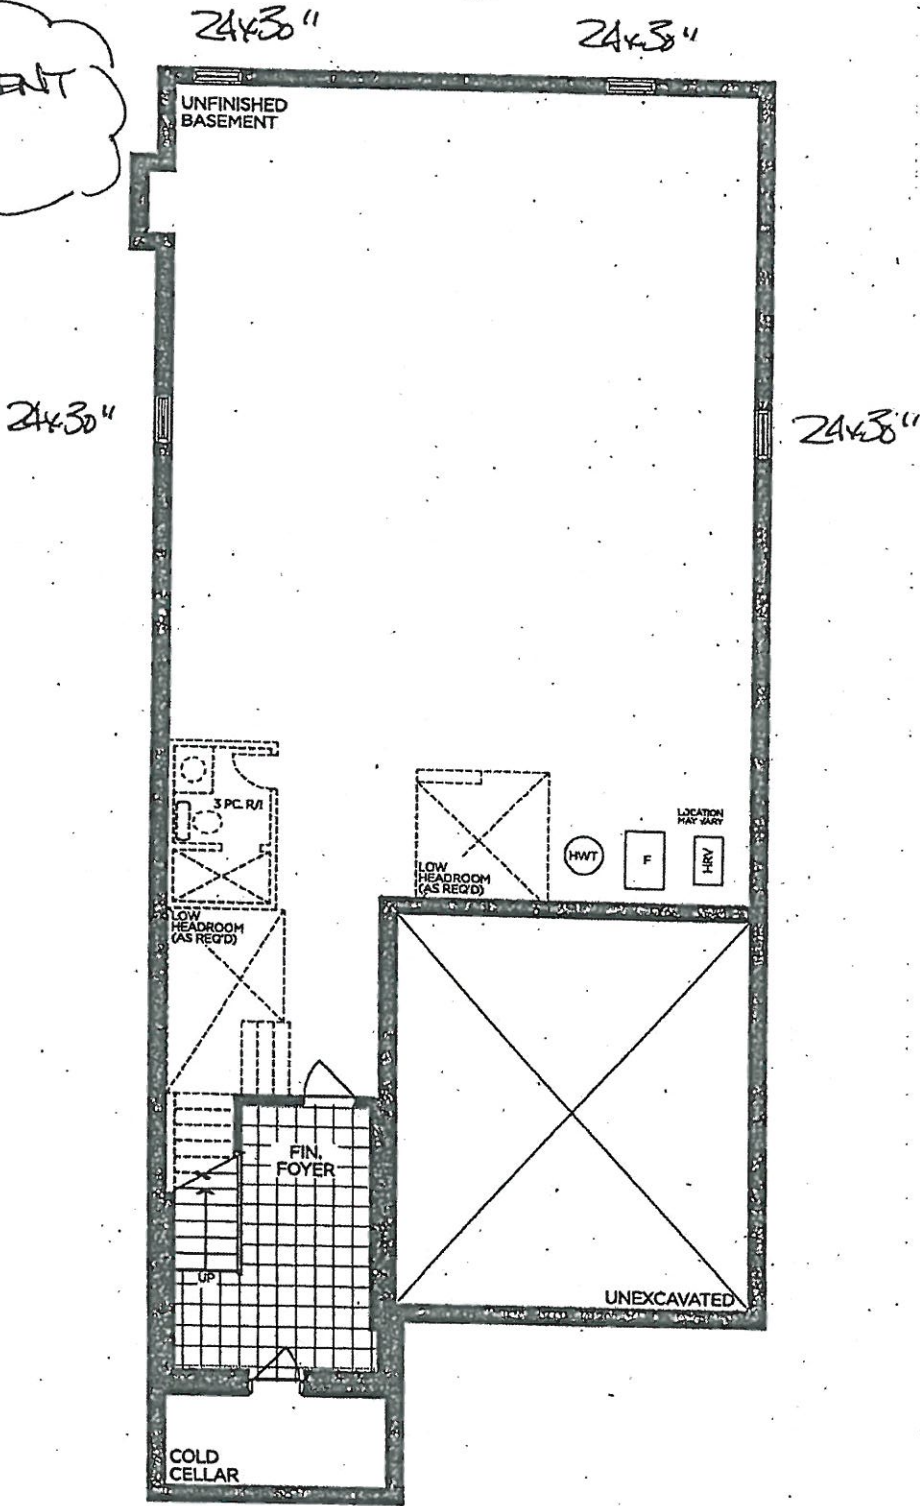

VENDOR


PURCHASER

PURCHASER

GOLDPARK
WORTH MORE™

Prices, figures, illustrations, sizes, features and finishes are subject to change without notice. Areas and dimensions are approximate and actual usable floor space may vary from the stated area. Layout may be reverse of the unit purchased. E. & O.E. 4000

PV-154
 NOV. 24 2020 *PH*
 PV-154
 March 17, 2021 *attach*
 PV-154
 May 11, 2021 *PH*
 (S) = SPEAKER WIRING

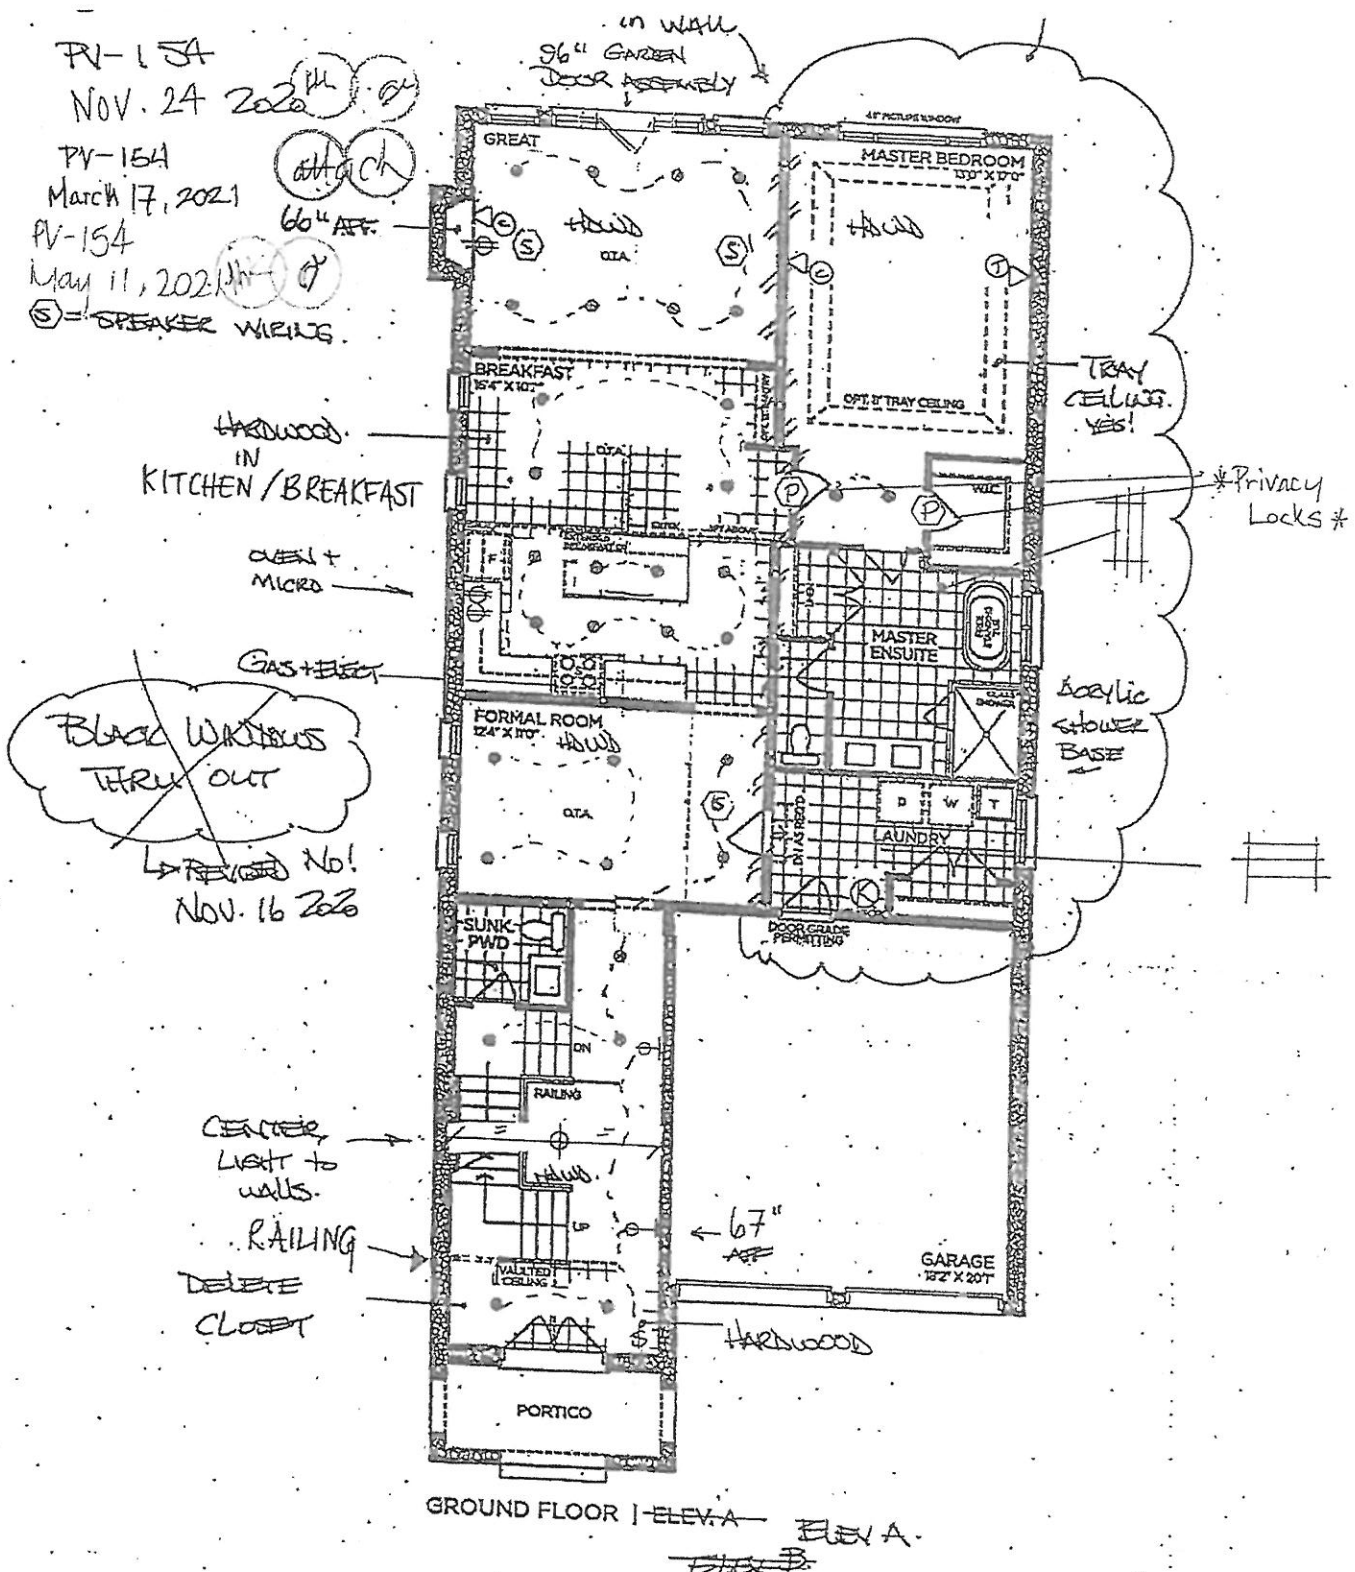

VENDOR
 PURCHASER
 PURCHASER

GOLDPARK
 WORTH MOR

Prices, figures, illustrations, sizes, features and finishes are subject to change with notice. Areas and dimensions are approximate and actual usable floor space may vary from the stated area. Layout may be reverse of the unit purchased. E. & O.E. 40


March 17, 2021

PV-154
REVISED
May 11, 2021

HWK
OK

SQUARE-OFF RAILING

Railings not
1/2 wall

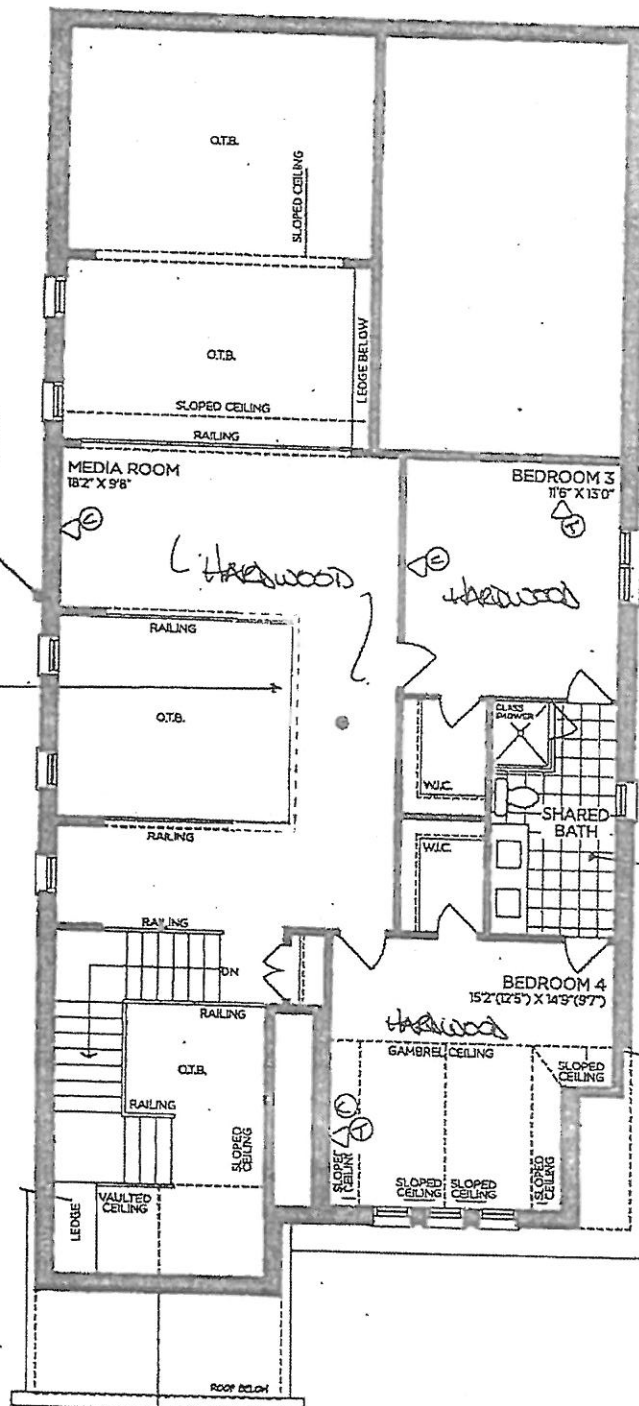

Acrylic shower
BASE


LOFT FLOOR | ELEV. A

VENDOR	
PURCHASER	
PURCHASER	

GOLDPARK
WORTH MORE

Prices, figures, illustrations, sizes, features and finishes are subject to change without notice. Areas and dimensions are approximate and actual usable floor space may vary from the stated area. Layout may be reverse of the unit purchased. E. & O.E. 4000

9' BASEMENT

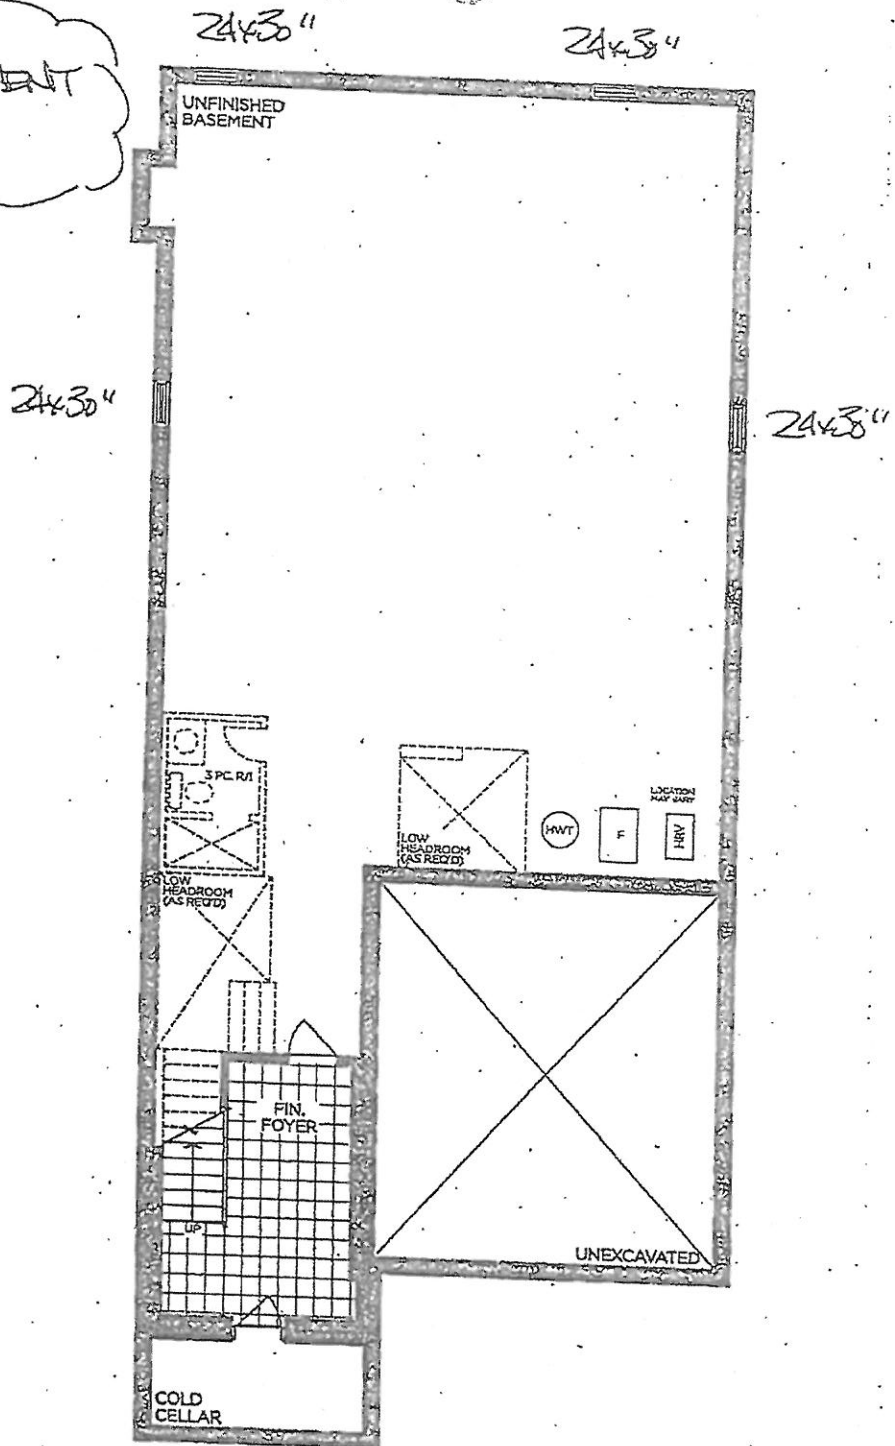

BASEMENT | ELEV. A & B

VENDOR

PURCHASER

PURCHASER

GOLDPARK
WORTH MORE™


Prices, figures, illustrations, sizes, features and finishes are subject to change without notice. Areas and dimensions are approximate and actual useable floor space may vary from the stated area. Layout may be reverse of the unit purchased. E. & O.E. 4000

**GOLDPARK HOMES
PINE VALLEY
VAUGHAN, ONTARIO
MODEL: (4000 OPT.) BRIARWOOD**


SITE STANDARD: WHITE 3/4" EXTENSION
SOFT-CLOSE DRAWERS & STANDARD SLAM DOOR HINGES
TO VANITIES

ONE TOP DRAWER WHERE POSSIBLE THROUGHOUT EACH
VANITY, ONE BANK OF DRAWERS WHERE POSSIBLE
THROUGHOUT EACH MASTER ENSUITE VANITY

PV-154
March 17, 2021
[Signature]

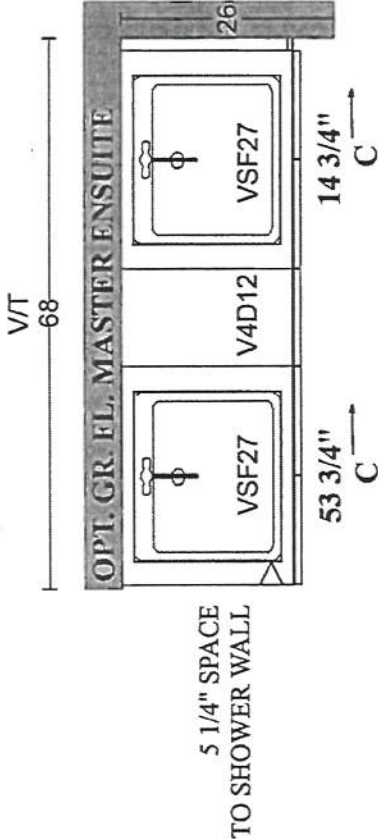

AKOWALCHUK

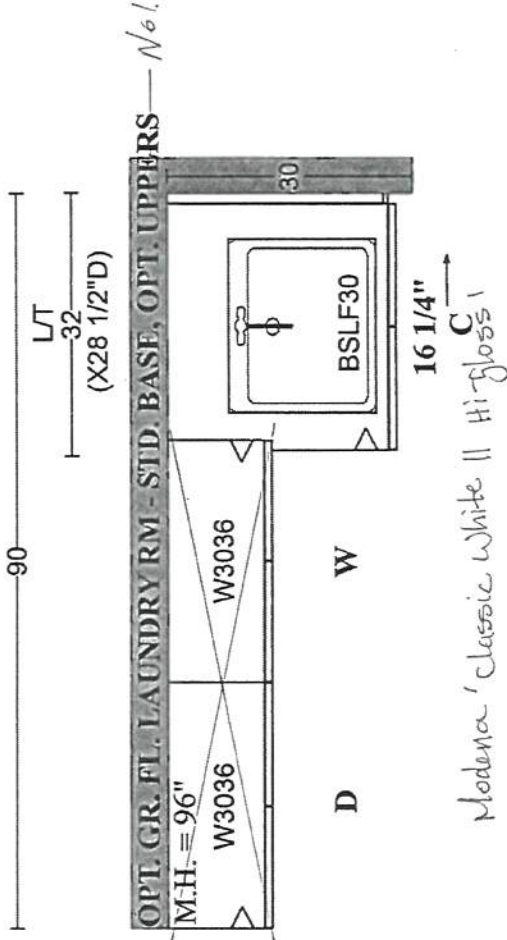

PLAN VIEW

PV-154
March 17, 2021.





all good

**GOLDPARK HOMES
PINE VALLEY
VAUGHAN, ONTARIO
MODEL: (4000) BRIARWOOD**

SITE STANDARD: WHITE 3/4" EXTENSION
SOFT-CLOSE DRAWERS & STANDARD SLAM DOOR HINGES
TO VANITIES


ONE TOP DRAWER WHERE POSSIBLE THROUGHOUT EACH
VANITY, ONE BANK OF DRAWERS WHERE POSSIBLE
THROUGHOUT EACH MASTER ENSUITE VANITY

Modena 'Classic White II Hi-gloss'

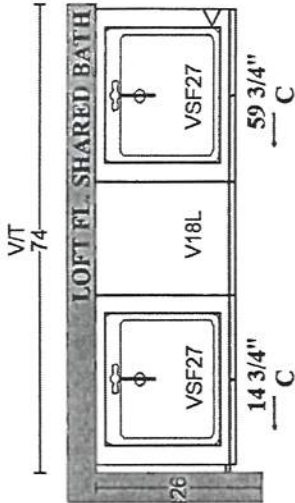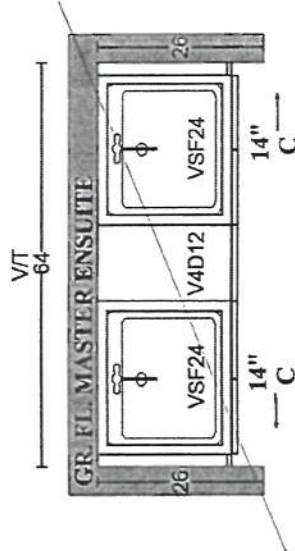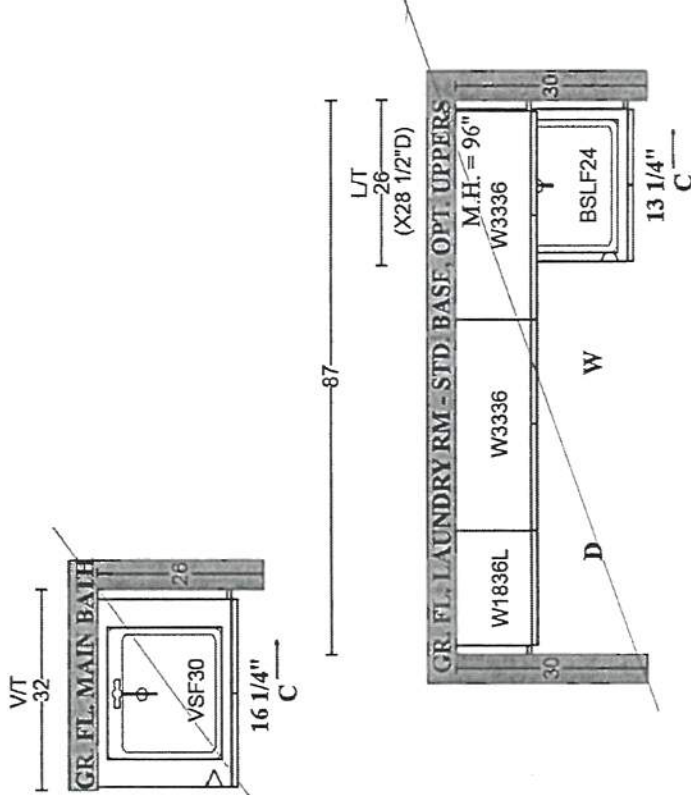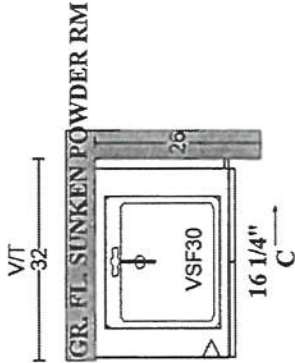

ANSWER

STONE COUNTERTOP EDGE PROFILES

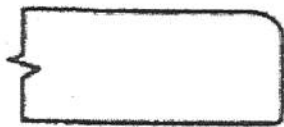

STANDARD 2CM EASED EDGE

LOCATION:

THRU-OUT



UPGRADE 3CM EASED EDGE


LOCATION:



UPGRADE 4CM MITRED EDGE



LOCATION:

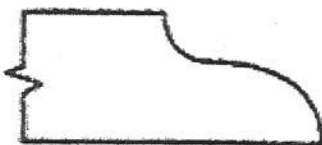

UPGRADE 2CM OGEE EDGE

LOCATION:

LOT #:

PV-154

DATE:

March 17, 2021

SIGNATURE: 

SIGNATURE: 

STANDARD HARDWARE / KNOBS



☐ K002-02




☒ K002-03
→ Powder Room
→ Laundry Room



☐ K002-04



☐ K002-06

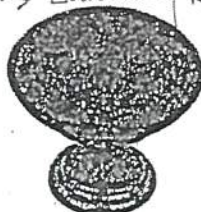

☐ K002-05



☐ K002-14



☐ K024-03

☐ *NO HARDWARE

LOT # PV-154

DATE: March 17, 2021

SIGNATURE:

attark


SIGNATURE:

attark

UPGRADE LAUNDRY SINK



BLANCO - QUATRUS R15 LAUNDRY
Stainless Steel - Dual-Mount
25" x 22" x 12"

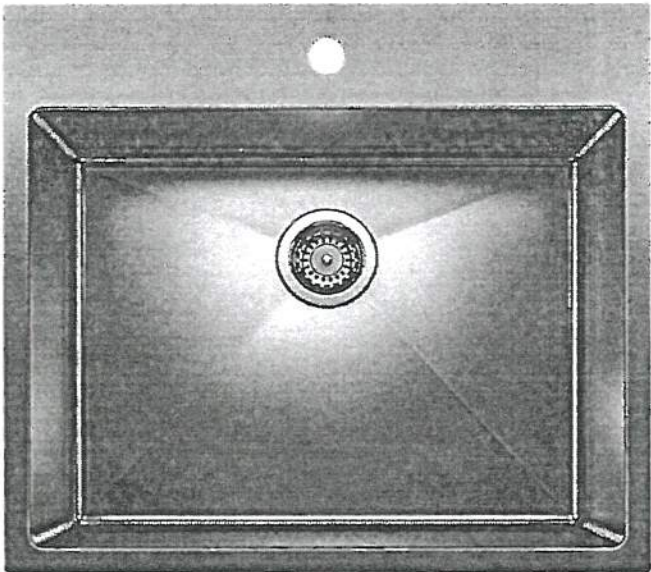

Stainless Steel

MODEL 401802 Stainless Steel

Lot# PV-154

Room: Laundry

Signature: <i>attach</i>

Date: March 17, 2021

Signature: <i>attach</i>




PINE VALLEY

FOREVERGREEN

UPGRADE KITCHEN FAUCET

MOEN - STO

One-Handle Pulldown Kitchen Faucet

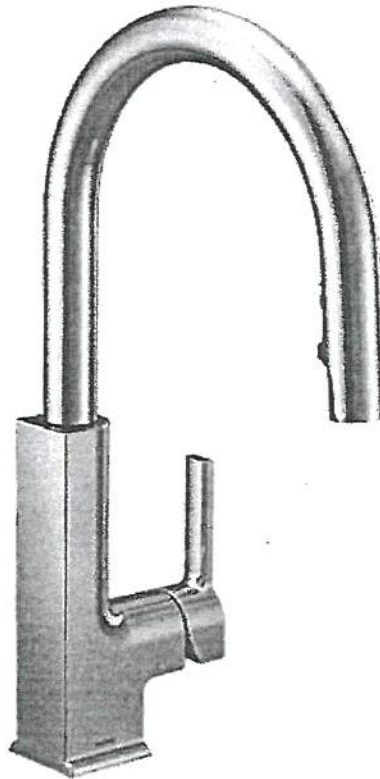

- ☒ CHROME
☐ MATTE BLACK (BL)
☐ STAINLESS (SRS)
☐ BRUSHED GOLD (BG)
☐ MATTE BLACK / CHROME (BLC)

MODEL: S72308 Chrome / S72308BL Matte Black / S72308SRS Stainless / S72308BG Brushed Gold / S72308BLC Matte Black + Chrome

Lot# PV-154

Date: March 17, 2021

Room: Laundry Room

Signature:

attach

Signature:

attach

GOLDPARK
WORTH MORE




PINE VALLEY
FOREVERGREEN

UPGRADE SHOWER HARDWARE

MT6X6

Shower Door Handle

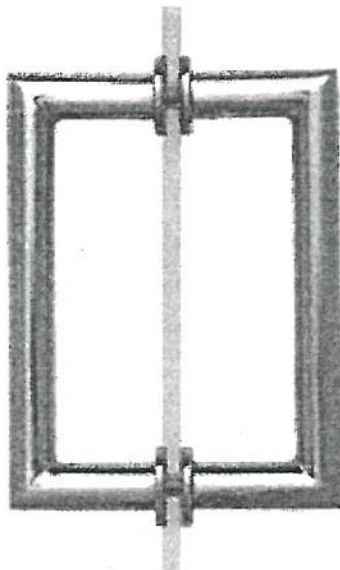

MT6X6
Shower Door Handle

6" x 6" back-to-back
3/4" dia. tube
Cut and mitred corners with
washers
(Also available single sided)

☒ CHROME

☐ MATTE BLACK

☐ BRUSHED GOLD

Lot#

PV-154

Date:

March 17, 2021

Room:

Master Ensuite + Shared Ensuite

Signature:


atlach

Signature:


atlach

GOLDPARK
WORTH MORE

BATHROOM ACCESSORIES

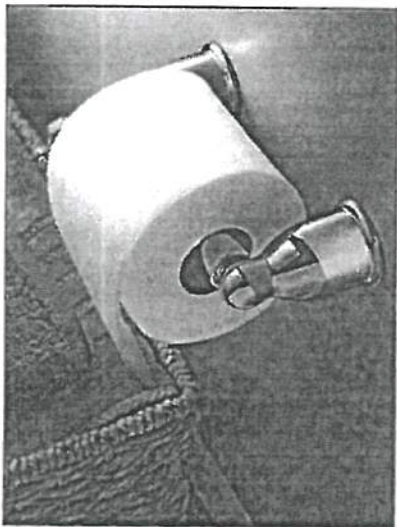

Tissue Holder
Mason - Chrome

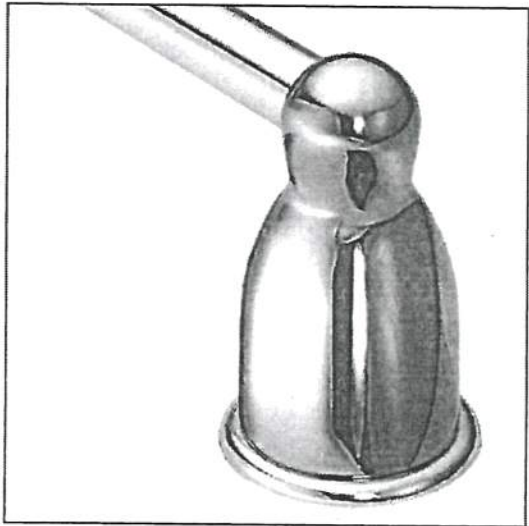

Towel Bar
Mason - Chrome

Please select one of the following:

- ☐ INSTALL STANDARD BATHROOM ACCESSORIES THRU OUT
(tissue holder + towel bar) **location as per vendors discretion**
- ☒ ***DO NOT*** INSTALL STANDARD BATHROOM ACCESSORIES
THRU OUT **tissue holder + towel bar will not be provided**

LOT #
PV-154

DATE:
March 17 , 2021

SIGNATURE: *attach*

SIGNATURE: *attach*

Layout Changes: ☐ Yes ☒ No

Sketch Attached: ☒ Yes ☐ No

Exterior Colour Scheme:

1. Cabinetry

	Style and Colour	Counter	Hardware
Kitchen / Breakfast	Modena'ClassicWhiteHiGloss'	Granite: Arctic White	attach
Laundry Room	Modena'ClassicWhiteHiGloss'	*Quartz: 'Vivid White'	attach
Powder Room	Modena'ClassicWhiteHiGloss'	Quartz: Nordic Loft	attach
Master Ensuite Bathroom	Manhattan 'Andaman'	*Quartz: 'Eternal Noir polished'	attach
Second Ensuite Bathroom (If Applicable)	n/a	n/a	n/a
Shared Ensuite	Manhattan 'Andaman'	*Quartz: 'Eternal Noir polished'	attach
Comment			

2. Floor Tile

	Selection
Entrance Vestibule	*see hardwood
Main Hall	
Kitchen / Breakfast	*see hardwood
Laundry Room	*12x24" Carrara X 'White' polished
Powder Room	12x12" Lily 'White'
Master Ensuite Bathroom	*12x24" Carrara X 'White' polished
Second Ensuite Bathroom (If Applicable)	n/a
Lower Landing (If Applicable)	12x12" Lily 'White' (basement foyer)
Shared Ensuite	*12x24" Carrara X 'White' polished
Comment	

3. Wall Tile

	Selection	Listello/Inserts	Describe
Master Ensuite Bathroom		☐ Yes ☒ No	
Tub Deck		☐ Yes ☒ No	
Shower Stall	*12x24" Carrara X 'White' Polished	☐ Yes ☒ No	
Bathroom Walls		☐ Yes ☒ No	
Second Ensuite Bathroom (If Applicable)	n/a	☐ Yes ☒ No	
Shared Ensuite	*12x24" Carrara X 'White' Polished	☐ Yes ☒ No	
Kitchen Backsplash	☐ Yes ☒ No	Backsplash Behind Fridge	
Comment			

4. Plumbing Fixtures

Master Ensuite Bathroom	Second Ensuite	Powder Room
Comment	Other Room - Specify	Other Washroom
See Extras		

5. Hardwood Flooring

	Type and Stain		Type and Stain
Main Hall		Upper Landing	
Kitchen / Breakfast	*3/4x5" wht oak wirebrush 'Atlantis'	Upper Hall	
Living Room		Master Bedroom	
Dining Room		Bedroom #2	
Family Room		Bedroom #3	
Den/Library		Bedroom #4	
Entrance Vestibule	*3/4x5" wht oak wirebrush 'Atlantis'	Bedroom #5	
Lower Landing (If Applicable)		Other Room - Specify	*3/4x5" wht oak wirebrush 'Atlantis'
		thru-out standard areas	
Comment			

6. Carpeting

	Upgrade	Description
Ground Floor	☐	
Second Floor	☐	

Upgrade Underpad	Type	Area

Carpet on Stairs	Capped	Runner - *Upgrade

Comment

7. Fireplace

	Living Room			Family Room			Other Room - Specify			Great Room
	Purchased	As Per Plan	N/A	Purchased	As Per Plan	N/A	Purchased	As Per Plan	N/A	
Fireplace Type	☐	☐	☒	☐	☐	☒	☐	☒	☐	
Mantle Type							Standard Gas			
Colour / Stain							Mediterranean			
Surround							Arctic White			
Hearth							n/a			
							None			
Comment										

He

8. Trim Carpentry

Interior Doors	*Lincoln Park	Front Door Glass Inserts	Standard	Door Handles	Halifax Blk + hinge
Interior Trim	*Board 2				
Comment					

9. Plaster Mouldings and Medallions

Standard Throughout ☐ Yes ☐ No ☒ N/A

Entrance Vestibule		Kitchen/Breakfast		
Main Hall		Den/Library		
Living Room		Lower Landing		
Dining Room		Other Room - Specify		
Family Room				
Comment				

10. Railings and Spindles

Railing Package	Standard 2	Spindle Colour	*Hopscotch
Railing Colour	*Hopscotch	Treads	*Hopscotch
Stringer / Riser	*Hopscotch	Oak Stairs	☒ Yes ☐ No ☐ N/A
Comment			

11. Wall Paint / Ceilings

Throughout Finished Areas	Cool White
Trim Paint	White
Smooth Ceilings	
Ground Floor	☒
Second Floor	☒
Note	
Comment	

12. Electrical

Hood Fan ☐ White ☐ Stainless ☒ N/A

Above Kitchen Cabinet Light ☐ Yes ☒ No

Below Kitchen Cabinet Light ☐ Yes ☒ No

Standard Appliances ☐

Over The Range Microwave ☐

Chimney Style Fan ☐

Comment

13. Heating and Air Conditioning

Air Conditioning no

Gas Provisions Stove yes

Gas Provisions Dryer no

Gas Provisions Barbecue Standard


Comment

14. Additional Comments

15. Disclaimers and Notes

- 1) Colours of all materials are as close as possible to builder's selection, but not necessarily identical due to variances in manufacturing.
- 2) Any extras listed above are null and void unless accompanied by a separate invoice/amendment. Said invoice must be paid in full.
- 3) The Purchaser acknowledges that after Interior Colour Selection form is signed and dated, no further changes will be permitted other than re-selection due to unavailability. Purchaser's Initials
- 4) The Purchaser acknowledges reading and accepting the "Gold Park Homes Decor Centre Disclaimers" form. This document contains other miscellaneous disclaimers.

This Interior Colour Selection is final and approved by:

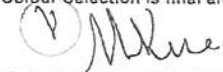Signature:  Date: March 17, 2021



PV - 154 Cabinetry Schedule

ROOM	DESCRIPTION	PRICE	QTY	TOTAL
KITCHEN	RETURN TRIP FOR HARDWOOD		1	\$ \$
MASTER ENSUITE	UPGRADE FROM SERIES 2 TO SERIES 6 - MANHATTAN ANDAMAN INCLUDING LINEN INTERIORS AND ANTHRACITE COLOURED METAL DRAWER BOXES		1	\$
	CONVERT STD BANK OF DRAWERS WITH 3/4" EXT WHITE DRAWERS TO WHITE PUSH TO OPEN FULL EXT		1	\$
	ADD TOUCH LATCH HARDWARE		1	\$ \$
LOFT BATH	UPGRADE FROM SERIES 2 TO SERIES 6 - MANHATTAN ANDAMAN INCLUDING LINEN INTERIORS AND ANTHRACITE COLOURED METAL DRAWER BOXES		1	\$
	CONVERT STD TOP DRAWER TO PUSH TO OPEN WHITE FULL-EXT		1	\$
	ADD TOUCH LATCH HARDWARE		1	\$ \$
CABINETRY TOTAL:				\$

HANDLE PLACEMENT: AT INSTALLERS DISCRETION

LOT #: PV-154

DATE: March 17, 2021

SIGNATURE: 

SIGNATURE: 

GOLD

REVISED:
12/18/2019 11:24

PV-15A.
SEPT 11 2020

PV-15A
NOV. 24 2020

PV-15A
March 17, 2021

THIS PLAN SHOWS
THE OPTIONAL GROUND FLOOR

// = SOUND INSULATION
in wall

96" GARDEN
DOOR ASSEMBLY

66" AFF.

(S) = SPEAKER WIRING

hardwood
IN
KITCHEN/BREAKFAST

OVEN +
MICRO

GAS + ELECT


BLACK WAINSCOTS
TIE IN OUT

NO!
NOV. 16 2020

CENTER
LIGHT to
walls.

RAILING

DELETE
CLOSET

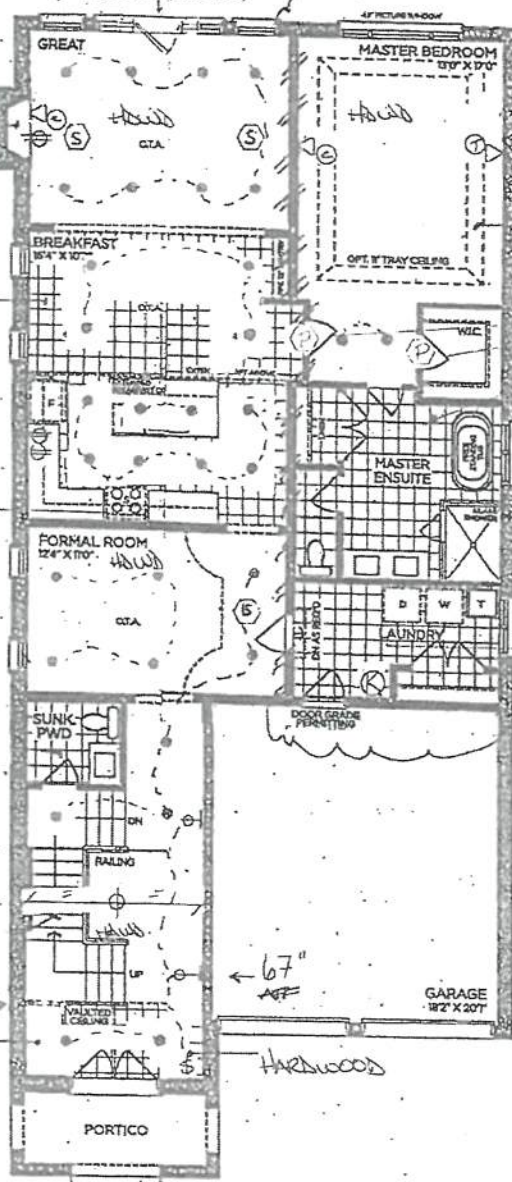

GROUND FLOOR | ELEV. A — ELEV. A.
~~ELEV. B.~~

VENDOR
PURCHASER
PURCHASER

GOLDPARK
WORTH MOR

Prices, figures, illustrations, sizes, features and finishes are subject to change with notice. Areas and dimensions are approximate and actual usable floor space may vary from the stated area. Layout may be reverse of the unit purchased. E. & O.E. 40

SCHEDULE 'F'




PV-154 *HL* *OK*
SEPT 11 2020
PV-154
NOV 24 2020 *HL* *OK*
PV-154 *HL* *OK*
March 17, 2021

The Briarwood

40' SERIES

→ Elevation A • 2,870 sq.ft.
✗ Elevation B • 2,860 sq.ft.

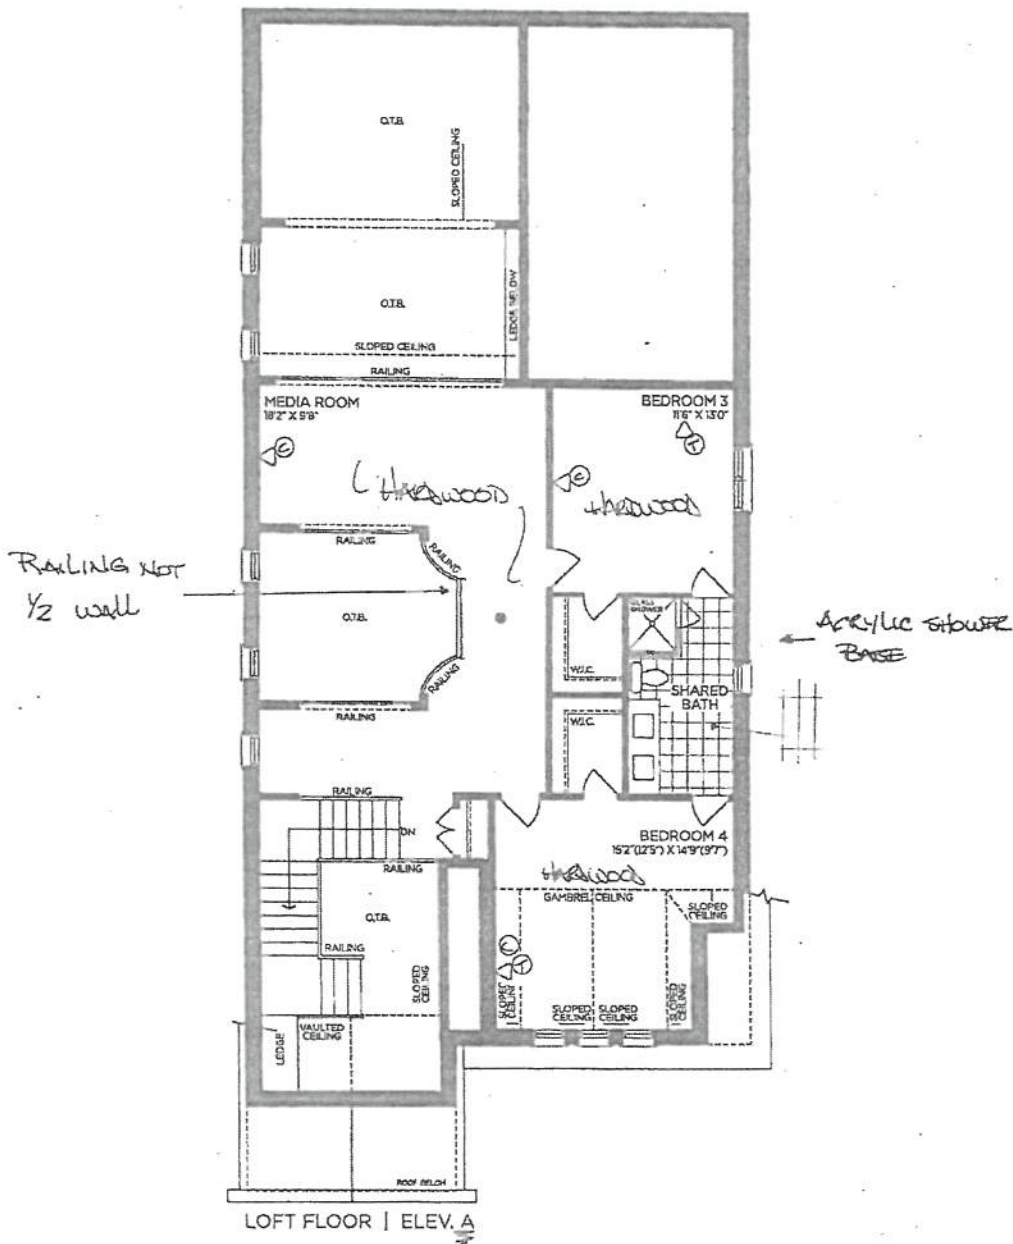

VENDOR

PURCHASER

PURCHASER

GOLDPARK
WORTH MORE™

Prices, figures, illustrations, sizes, features and finishes are subject to change without notice. Areas and dimensions are approximate and actual usable floor space may vary from the stated area. Layout may be reverse of the unit purchased. E. & C.E. 4000

SCHEDULE 'F'



PV-154 (PVC) (OP)
SEPT 11 2020
PV-154 (PVC) (OP)
Nov. 24 2020
PV-154 (PVC) (OP)
March 17, 2021

The Briarwood

40' SERIES

→ Elevation A • 2,870 sq.ft.
✱ Elevation B • 2,860 sq.ft.


9' BASEMENT

24x30"

24x30"

24x30"

24x30"

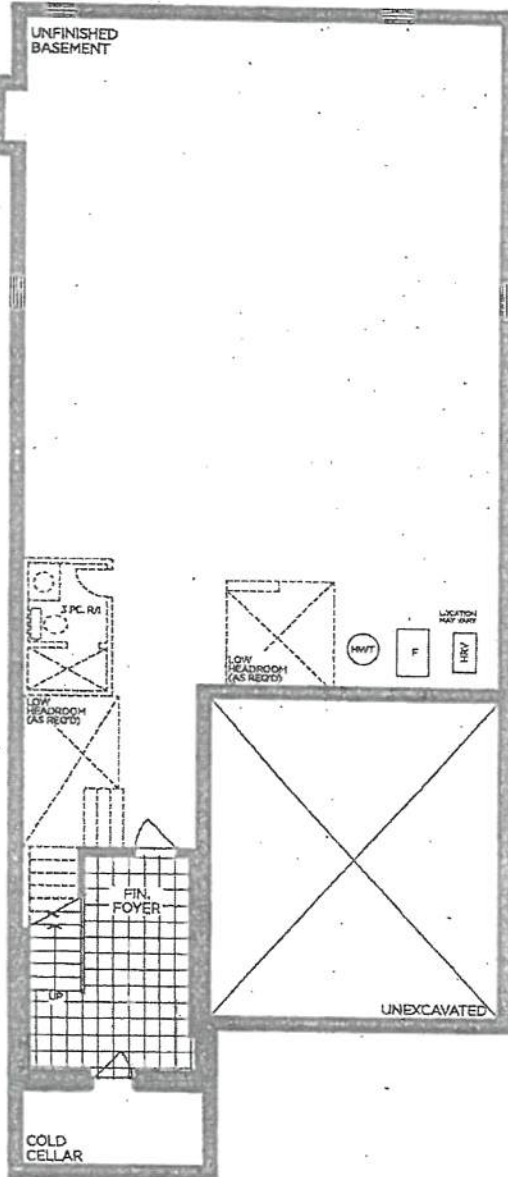

BASEMENT | ELEV. A & B

VENDOR
PURCHASER
PURCHASER

GOLDPARK
WORTH MORE



Prices, figures, illustrations, sizes, features and finishes are subject to change without notice. Areas and dimensions are approximate and actual usable floor space may vary from the stated area. Layout may be reverse of the unit purchased. E. & O.E. 4000

GOLDPARK HOMES
PINE VALLEY
VAUGHAN, ONTARIO
MODEL: (4000 OPT.) BRIARWOOD

SITE STANDARD: WHITE 3/4" EXTENSION
SOFT-CLOSE DRAWERS & STANDARD SLAM DOOR HINGES
TO VANITIES

ONE TOP DRAWER WHERE POSSIBLE THROUGHOUT EACH
VANITY, ONE BANK OF DRAWERS WHERE POSSIBLE
THROUGHOUT EACH MASTER ENSUITE VANITY

PV-1544
March 17, 2024
Me *De*

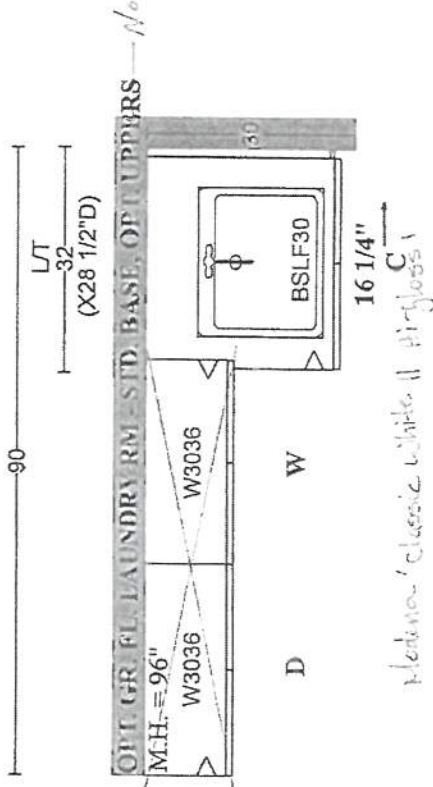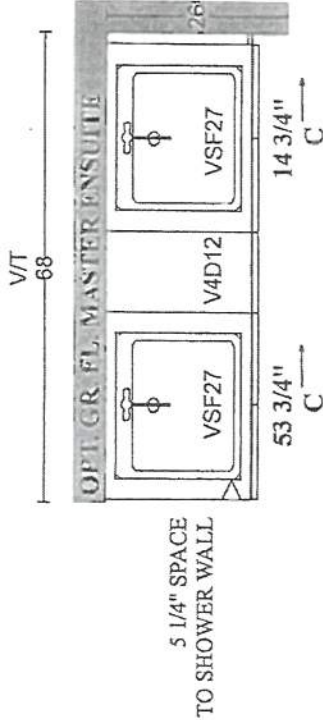

PLAN VIEW

P1-154
March 17, 2011





He
OK

GOLDPARK HOMES
PINE VALLEY
VAUGHAN, ONTARIO
MODEL: (4000) BRIARWOOD

SITE STANDARD: WHITE 3/4" EXTENSION
SOFT-CLOSE DRAWERS & STANDARD SLAM DOOR HINGES
TO VANITIES

ONE TOP DRAWER WHERE POSSIBLE THROUGHOUT EACH
VANTY. ONE BANK OF DRAWERS WHERE POSSIBLE
THROUGHOUT EACH MASTER ENSUITE VANITY

Modena, classic white 11 ft. glass

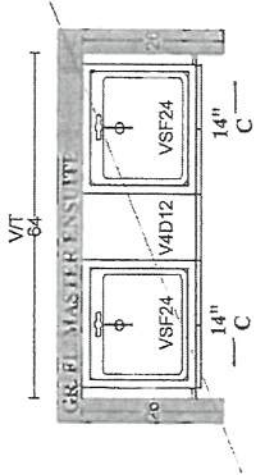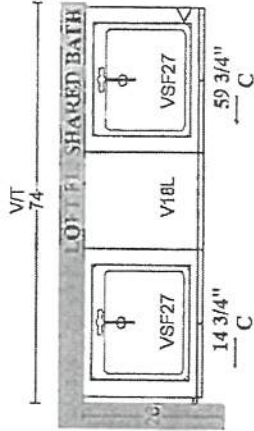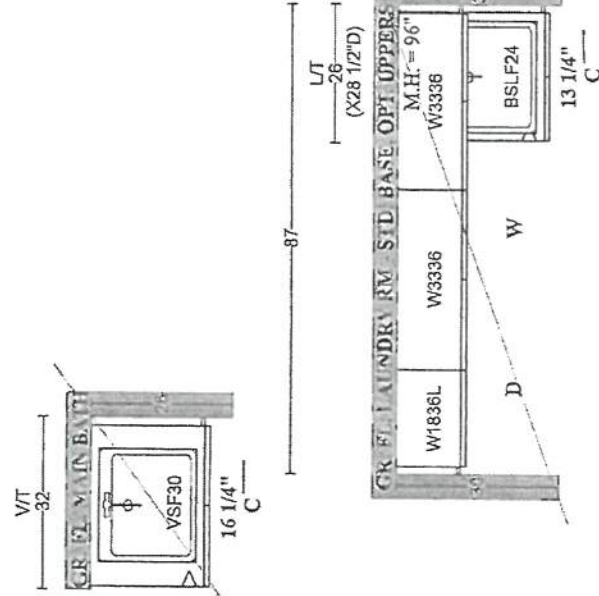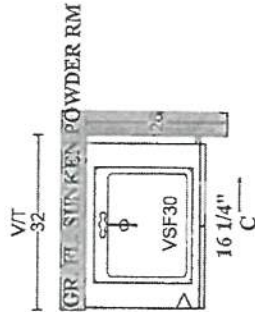

ANTHONY



PLAN VIEW

STONE COUNTERTOP EDGE PROFILES



STANDARD 2CM EASED EDGE

LOCATION:

TURBO-OUT



UPGRADE 3CM EASED EDGE

LOCATION:



UPGRADE 4CM MITRED EDGE



LOCATION:



UPGRADE 2CM OGEE EDGE

LOCATION:

LOT #: PY-1511

DATE: March 17, 2021

SIGNATURE:

M. Kline

SIGNATURE:

[Signature]

STANDARD HARDWARE / KNOBS



☐ K002-02



☒ K002-03
→ Powder Room
→ Laundry Room



☐ K002-04



☐ K002-06



☐ K002-05



☐ K002-14



☐ K024-03

☐ *NO HARDWARE

LOT # 11-1511

DATE: March 17, 2021


SIGNATURE:

[Signature]

SIGNATURE:

[Signature]

BLANCO - QUATRUS R15 LAUNDRY
Stainless Steel - Dual-Mount
25" x 22" x 12"

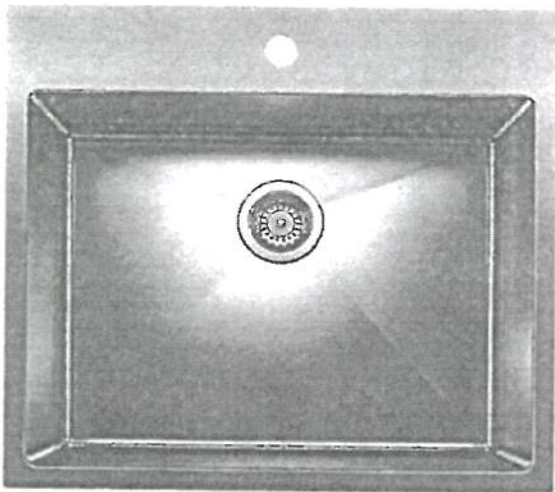

Stainless Steel


MODEL 401802 Stainless Steel

Lot# PY-1044	
Room: Laundry	Signature:  Mike
Date: March 17, 2021	Signature:  [unclear]

GOLDPARK
WORTH MORE



MOEN - STO

One-Handle Pulldown Kitchen Faucet

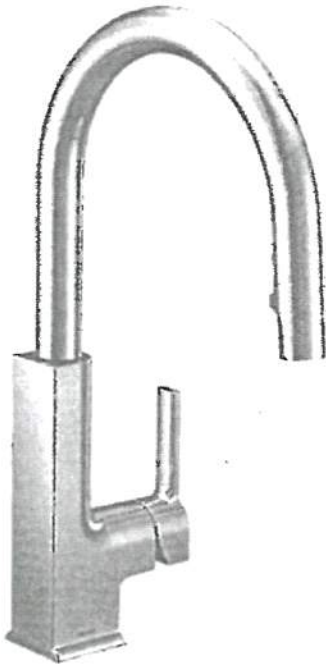

- ☒ CHROME
- ☐ MATTE BLACK (BL)
- ☐ STAINLESS (SRS)
- ☐ BRUSHED GOLD (BG)
- ☐ MATTE BLACK / CHROME (BLC)


MODEL: S72308 Chrome / S72308BL Matte Black / S72308SRS Stainless / S72308BG Brushed Gold / S72308BLC Matte Black + Chrome

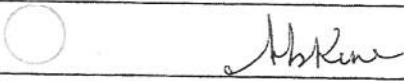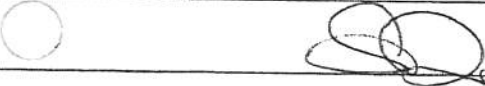Lot# PV-154	Date: March 17, 2021	Room: Laundry Room
Signature: 		
Signature: 		

GOLDPARK
WORTH ADOPT

MT6X6

Shower Door Handle

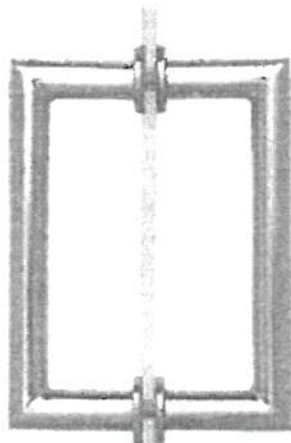


MT6X6
Shower Door Handle


6" x 6" back-to-back
 3/4" dia. tube
 Cut and mitred corners with
 washers
 (Also available single sided)

- ☒ CHROME
☐ MATTE BLACK
☐ BRUSHED GOLD

Lot# PV-154	Date: March 17, 2021	Room: Master Ensuite + Shared Ensuite
Signature:  Mike		
Signature:  		

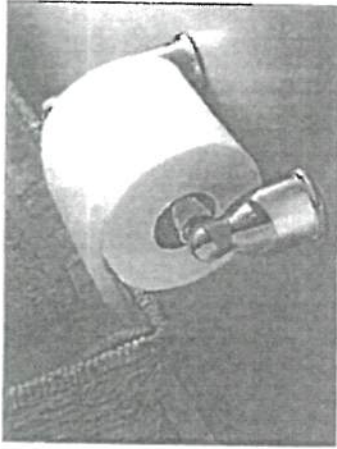

Tissue Holder
Mason - Chrome

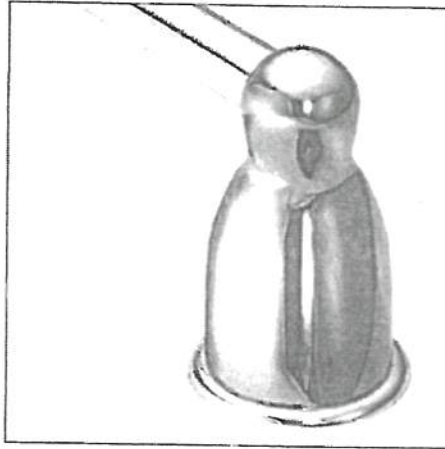

Towel Bar
Mason - Chrome

Please select one of the following:

- ☐ INSTALL STANDARD BATHROOM ACCESSORIES THRU OUT
(tissue holder + towel bar) **location as per vendors discretion**
- ☒ ***DO NOT*** INSTALL STANDARD BATHROOM ACCESSORIES
THRU OUT **tissue holder + towel bar will not be provided**

LOT # PV-154

DATE: March 17, 2021

SIGNATURE:



M. Kline

SIGNATURE:



[Signature]