



CONSTRUCTION SUMMARY

Lot: 27  
Model: 42.03 A FORESTCREST  
Project/Phase: Pine Valley Forevergreen / 1

APPLIANCES

| Invoice                      | Qty. | Description                                     |
|------------------------------|------|-------------------------------------------------|
| 2767<br><br>21May21<br>NoCat | 1    | APPLIANCE SPECIFICATIONS ATTACHED - SIGNED COPY |

BASEMENT WINDOWS

| Invoice                   | Qty. | Description                                                              |
|---------------------------|------|--------------------------------------------------------------------------|
| 2638<br>72,351<br>17Mar21 | 4    | BASEMENT WINDOWS - UPGRADE BASEMENT WINDOW SIZE TO 30 " X 24" - 8" FRAME |

CERAMIC

| Invoice               | Qty. | Description                                                                                              |
|-----------------------|------|----------------------------------------------------------------------------------------------------------|
| 2721<br>49<br>23Apr21 | 1    | MASTER ENSUITE: TILE, SHOWER WALL - LEVEL 3 - 12x24" LAID IN HORIZONTAL STACKED PATTERN                  |
| 2721<br>45<br>23Apr21 | 1    | MASTER ENSUITE: TILE, FLOOR - LEVEL 3 - 12x24" LAID IN STRAIGHT STACKED PATTERN - SEE PLAN FOR DIRECTION |
| 2721<br>45<br>23Apr21 | 1    | MASTER ENSUITE: TILE, SHOWER FLOOR - LEVEL 4 - HERRINGBONE MOSAIC                                        |
| 2721<br>36<br>23Apr21 | 1    | ENSUITE 2: TILE, FLOOR - LEVEL 4 - 12x24" LAID IN STRAIGHT STACKED PATTERN - SEE PLAN FOR DIRECTION      |

CONCRETE AND DRAIN

| Invoice                    | Qty. | Description               |
|----------------------------|------|---------------------------|
| 2638<br>101,930<br>17Mar21 | 1    | BACK FLOW PREVENTER VALVE |

DRYWALL

| Invoice                         | Qty. | Description                                                                      |
|---------------------------------|------|----------------------------------------------------------------------------------|
| 2638<br>72,351<br>17Mar21<br>** | 4    | BASEMENT WINDOWS - UPGRADE BASEMENT WINDOW SIZE TO 30 " X 24" - 8" FRAME         |
| 2658<br>72,438<br>25Mar21       | 1    | GREAT ROOM: MODEL OPTIONS 40.06 - GREAT ROOM - OPT. COFFERED CEILING AS PER PLAN |



CONSTRUCTION SUMMARY

Lot: 27  
Model: 42.03 A FORESTCREST  
Project/Phase: Pine Valley Forevergreen / 1

ELECTRICAL

| Invoice                         | Qty. | Description                                                                                                                                                                                                                                   |
|---------------------------------|------|-----------------------------------------------------------------------------------------------------------------------------------------------------------------------------------------------------------------------------------------------|
| 2638<br>72,351<br>17Mar21<br>** | 4    | BASEMENT WINDOWS - UPGRADE BASEMENT WINDOW SIZE TO 30 " X 24" - 8" FRAME                                                                                                                                                                      |
| 2658<br>72,281<br>25Mar21       | 1    | GREAT ROOM: INTERIOR WALL OUTLET: ADDITIONAL 110V WALL INTERIOR RECEPTACLE ON EXISTING CIRCUIT FOR WALL MOUNTED TV - APPROX 64" A.F.F. ABOVE FIREPLACE                                                                                        |
| 2658<br>72,273<br>25Mar21       | 1    | KITCHEN: 110V WALL RECEPTACLE ON SEPARATE CIRCUIT - GAS FIRED APPLIANCE - FOR AUX. EQUIPMENT - NOT A STOVE PLUG                                                                                                                               |
| 2658<br>72,307<br>25Mar21       | 1    | KITCHEN: RELOCATE STANDARD CEILING MOUNT FIXTURE TO CENTRE ON CEILING ABOVE ISLAND                                                                                                                                                            |
| 2658<br>72,289<br>25Mar21       | 6    | KITCHEN: 4" E/S LED INTERIOR POT LIGHT - GROUND FLOOR<br><br>INCLUDED IN APS                                                                                                                                                                  |
| 2721<br>72,282<br>23Apr21       | 1    | KITCHEN: ADDITIONAL 220V RECEPTACLE ON A SEPARATE CIRCUIT - FOR BUILT-IN WALL OVEN - APPLIANCE NOT INCLUDED - DOES NOT INCLUDE BREAKER THAT IS TO BE INSTALLED BY LICENSED ELECTRICIAN AND ARRANGED BY HOMEOWNER AFTER CLOSING FOR WALL OVENS |
| 2721<br><br>23Apr21<br>NoCat    | 1    | FYI - KITCHEN: FULL HEIGHT SLAB BACKSPLASH - LEVEL 4 QUARTZ                                                                                                                                                                                   |

FORMING

| Invoice                   | Qty. | Description                                                                                                     |
|---------------------------|------|-----------------------------------------------------------------------------------------------------------------|
| 2638<br>72,208<br>17Mar21 | 1    | PINE VALLEY MODEL 42.03 FORESTCREST ELEV A - 9 FOOT BASEMENT CEILING HEIGHT IN LIEU OF STANDARD 8 FOOT CEILING. |

FRAMING

| Invoice                      | Qty. | Description                                                                                                                                                                                                                       |
|------------------------------|------|-----------------------------------------------------------------------------------------------------------------------------------------------------------------------------------------------------------------------------------|
| 2658<br><br>25Mar21<br>NoCat | 1    | GREAT ROOM: MODEL OPTIONS 40.06 - GREAT ROOM - OPT. COFFERED CEILING AS PER PLAN                                                                                                                                                  |
| 2721<br><br>23Apr21<br>NoCat | 1    | ***REVISED LAYOUT*** CHANGED TO 5 BEDROOM OPTION + ENSUITE 2 WITH TUB (INCLUDES STANDARD FINISHES)<br><br>APS AMENDMENT - 5 BEDROOM PLAN, INCLUDES REDUCED SIZED MASTER W.I.C. WITH ENSUITE 2 BATH<br>(SAME LAYOUT AS 4 BED PLAN) |



CONSTRUCTION SUMMARY

Lot: 27  
Model: 42.03 A FORESTCREST  
Project/Phase: Pine Valley Forevergreen / 1

GLASS AND MIRROR

| Invoice                      | Qty. | Description                                                                               |
|------------------------------|------|-------------------------------------------------------------------------------------------|
| 2721<br><br>23Apr21<br>NoCat | 4    | MASTER ENSUITE / ENSUITE 3 / ENSUITE 4 / ENSUITE 5: UPGRADE SHOWER DOOR HARDWARE - CHROME |

GRANITE MARBLE QUARTZ

| Invoice                      | Qty. | Description                                    |
|------------------------------|------|------------------------------------------------|
| 2721<br><br>23Apr21<br>NoCat | 1    | ENSUITE 2: UPGRADE QUARTZ COUNTERTOP - LEVEL 2 |
| 2721<br><br>23Apr21<br>NoCat | 1    | ENSUITE 4: UPGRADE QUARTZ COUNTERTOP - LEVEL 5 |
| 2721<br><br>23Apr21<br>NoCat | 1    | ENSUITE 5: UPGRADE QUARTZ COUNTERTOP - LEVEL 2 |
| 2721<br><br>23Apr21<br>NoCat | 1    | KITCHEN: COOKTOP CUT OUT                       |

HARDWOOD

| Invoice                  | Qty. | Description                                                                                                                                                                                                                                                   |
|--------------------------|------|---------------------------------------------------------------------------------------------------------------------------------------------------------------------------------------------------------------------------------------------------------------|
| 2721<br>7<br><br>23Apr21 | 1    | THRU OUT STANDARD AREAS: MAIN HALL/LIVING ROOM, GREAT ROOM, DINING ROOM, STUDY, UPPER HALL, MASTER BEDROOM, BEDROOM 2, BEDROOM 3, BEDROOM 4, BEDROOM 5 - VINTAGE SERIES, 5" WHITE OAK,NSS ENGINEERED HARDWOOD, 3/4" THK,SCULPTED TEXTURE, UVF FINISH- LEVEL 4 |

HVAC

| Invoice                   | Qty. | Description                                                      |
|---------------------------|------|------------------------------------------------------------------|
| 2658<br>72,224<br>25Mar21 | 1    | KITCHEN: GAS LINE ROUGH-IN - MAIN FLOOR FOR APPLIANCE - SEE PLAN |

INTERIOR TRIM /MOULDINGS

| Invoice                         | Qty. | Description                                                              |
|---------------------------------|------|--------------------------------------------------------------------------|
| 2638<br>72,351<br>17Mar21<br>** | 4    | BASEMENT WINDOWS - UPGRADE BASEMENT WINDOW SIZE TO 30 " X 24" - 8" FRAME |



CONSTRUCTION SUMMARY

Lot: 27  
Model: 42.03 A FORESTCREST  
Project/Phase: Pine Valley Forevergreen / 1

KITCHEN AND BATH CABINETRY

| Invoice                      | Qty. | Description                                           |
|------------------------------|------|-------------------------------------------------------|
| 2721<br>101,930<br>23Apr21   | 1    | KITCHEN: UPGRADE QUARTZ COUNTERTOP - LEVEL 4          |
| 2721<br><br>23Apr21<br>NoCat | 1    | THRU OUT: SEE ATTACHED CABINETRY SCHEDULE             |
| 2721<br><br>23Apr21<br>NoCat | 1    | KITCHEN: FULL HEIGHT SLAB BACKSPLASH - LEVEL 4 QUARTZ |

PAINT

| Invoice                      | Qty. | Description                                                                      |
|------------------------------|------|----------------------------------------------------------------------------------|
| 2658<br><br>25Mar21<br>NoCat | 1    | GREAT ROOM: MODEL OPTIONS 40.06 - GREAT ROOM - OPT. COFFERED CEILING AS PER PLAN |

STAIR AND RAILINGS

| Invoice                    | Qty. | Description                                                                                                                                                                    |
|----------------------------|------|--------------------------------------------------------------------------------------------------------------------------------------------------------------------------------|
| 2721<br>100,238<br>23Apr21 | 2    | MAIN STAIRS: 2ND FLOOR TO BASEMENT - STAIN STAIRS AND LANDINGS<br><br>WILL NOT MATCH HARDWOOD IN COLOUR, SPECIES, OR TEXTURE                                                   |
| 2721<br>93,800<br>23Apr21  | 2    | MAIN STAIRS - 2ND FLOOR TO BASEMENT: UPGRADE - EURONLINE (ALL PLAIN) PICKET, 3" HALF-ROUND W/V-GROOVE HANDRAIL, 3 1/2" ALL SQUARE POST WITH PYRAMID TOP POST CAP - PACKAGE A-2 |



CONSTRUCTION SUMMARY

Lot: 27


Model: 42.03 A FORESTCREST

Project/Phase: Pine Valley Forevergreen / 1

WINDOWS - BASEMENT

| Invoice                         | Qty. | Description                                                              |
|---------------------------------|------|--------------------------------------------------------------------------|
| 2638<br>72,351<br>17Mar21<br>** | 4    | BASEMENT WINDOWS - UPGRADE BASEMENT WINDOW SIZE TO 30 " X 24" - 8" FRAME |

PV - 27 ~~attached~~  
May 4, 2021

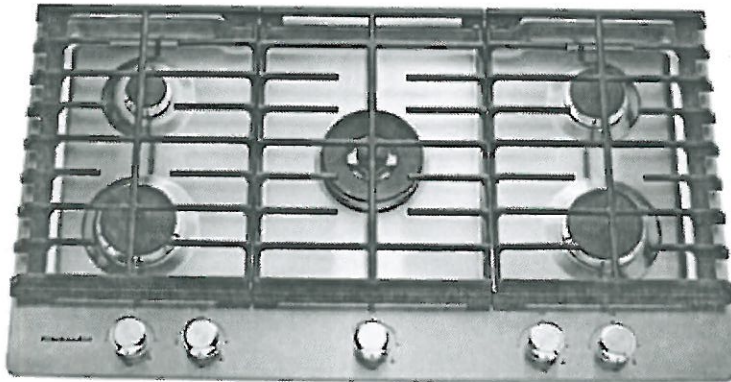

## KITCHENAID 36" 5- BURNER GAS COOKTOP – STAINLESS STEEL

**\$ 1,649.00**

**SKU: KCGS556ES**

**VSN: KCGS556ESS**

### Dimensions

Width: 36" (91.4 cm) Height: 3.62" (9.2 cm) Depth: 21" (53.3 cm)

Experience the convenient technology this cooktop from KitchenAid offers. Even-Heat™ technology uses a diffuser plate to allow for more control of the cooktop, making it ideal for melting chocolate or simmering sauce. With a professional dual-ring burner and electronic ignition, this cooktop makes it simple to whip up countless masterpieces. What's more, its CookShield finish helps protect against spills and stains while making the cooktop easy to wipe clean without the use of harsh chemicals.

**KitchenAid**


### Key Features:

- Even-Heat Technology
- Professional Dual-Ring Burner
- CookShield Finish
- Electronic Ignition

PV-27 attached  
 May 4, 2021


## Product Dimensions

### KCGS550ESS and KCGS950ESS Models

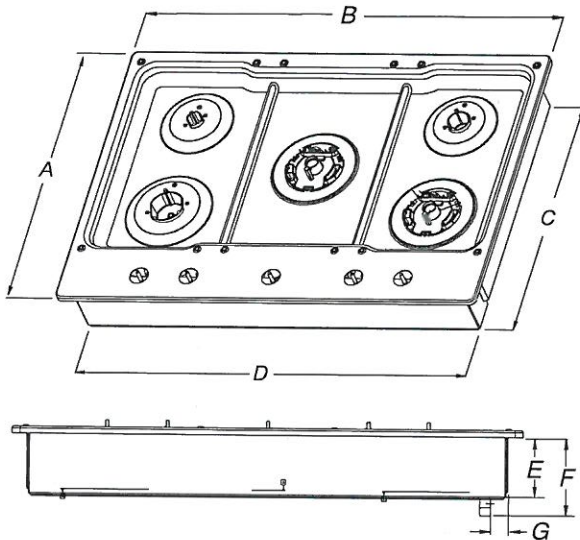


- |                                               |                                               |
|-----------------------------------------------|-----------------------------------------------|
| A. 21" (53.3 cm)                              | E. 3 <sup>5</sup> / <sub>8</sub> " (9.2 cm)   |
| B. 30" (76.2 cm)                              | F. 4 <sup>9</sup> / <sub>16</sub> " (11.6 cm) |
| C. 19 <sup>3</sup> / <sub>8</sub> " (49.2 cm) | G. 1 <sup>3</sup> / <sub>8</sub> " (3.4 cm)   |
| D. 28 <sup>3</sup> / <sub>8</sub> " (72.1 cm) |                                               |

### KCGS556ESS and KCGS956ESS Models

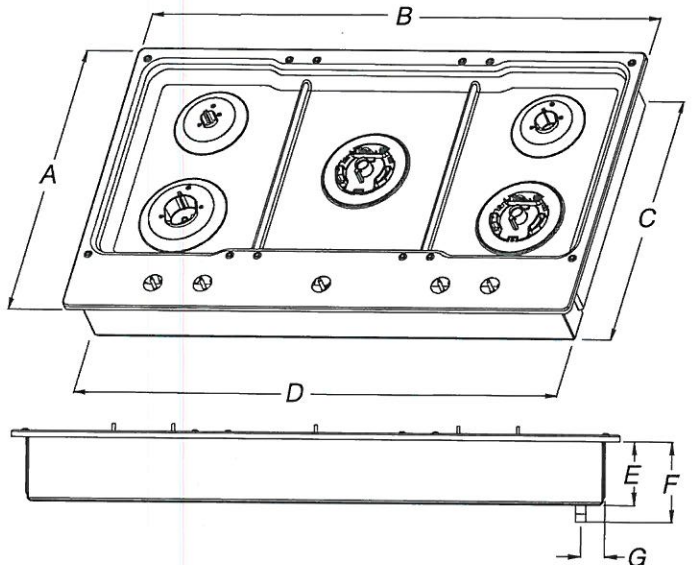


- |                                               |                                               |
|-----------------------------------------------|-----------------------------------------------|
| A. 21" (53.3 cm)                              | E. 3 <sup>5</sup> / <sub>8</sub> " (9.2 cm)   |
| B. 36 <sup>1</sup> / <sub>4</sub> " (92.0 cm) | F. 4 <sup>9</sup> / <sub>16</sub> " (11.6 cm) |
| C. 19 <sup>3</sup> / <sub>8</sub> " (49.2 cm) | G. 1 <sup>7</sup> / <sub>16</sub> " (3.6 cm)  |
| D. 34 <sup>3</sup> / <sub>8</sub> " (88.1 cm) |                                               |

### All Other 30" (76.2 cm) Models

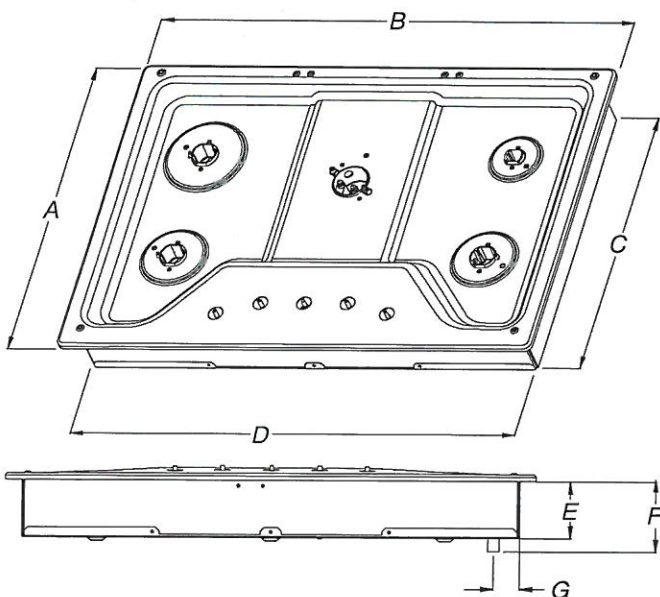

- |                                               |                                              |
|-----------------------------------------------|----------------------------------------------|
| A. 21" (53.3 cm)                              | E. 3 <sup>3</sup> / <sub>8</sub> " (8.6 cm)  |
| B. 30" (76.2 cm)                              | F. 4 <sup>1</sup> / <sub>8</sub> " (10.5 cm) |
| C. 18 <sup>7</sup> / <sub>8</sub> " (48.0 cm) | G. 1 <sup>1</sup> / <sub>2</sub> " (3.8 cm)  |
| D. 28 <sup>3</sup> / <sub>8</sub> " (72.1 cm) |                                              |


### All Other 36" (91.4 cm) Models

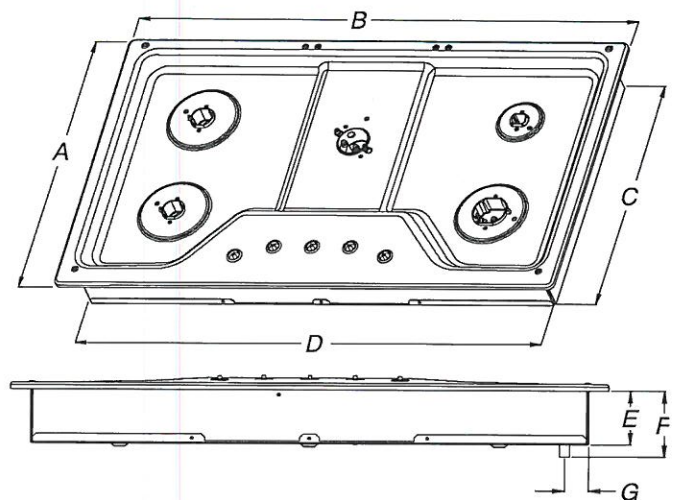

- |                                               |                                              |
|-----------------------------------------------|----------------------------------------------|
| A. 21" (53.3 cm)                              | E. 3 <sup>3</sup> / <sub>8</sub> " (8.6 cm)  |
| B. 36" (91.4 cm)                              | F. 4 <sup>1</sup> / <sub>8</sub> " (10.5 cm) |
| C. 18 <sup>7</sup> / <sub>8</sub> " (48.0 cm) | G. 1 <sup>1</sup> / <sub>2</sub> " (3.8 cm)  |
| D. 33 <sup>3</sup> / <sub>4</sub> " (85.7 cm) |                                              |

PV-27 **attached**  
May 4, 2021

## Cutout Dimensions - Top View

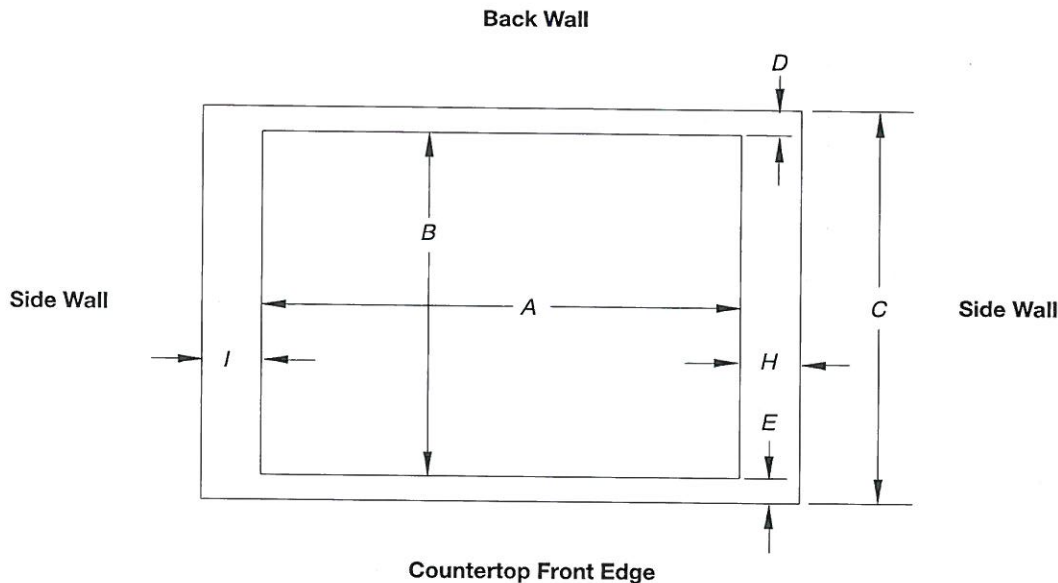

| Cutout (Product Opening) Dimensions                      |                                  |                                  |                                  |                                 |                                  |                                |
|----------------------------------------------------------|----------------------------------|----------------------------------|----------------------------------|---------------------------------|----------------------------------|--------------------------------|
| 30" (76.2 cm) Models                                     |                                  |                                  |                                  |                                 |                                  |                                |
| Models                                                   | A                                |                                  |                                  | B                               |                                  |                                |
|                                                          | Min                              | Recommended                      | Max                              | Min                             | Recommended                      | Max                            |
| KCGS550 and KCGS950<br>All Other 30" (76.2 cm)<br>Models | 28½" (72.4 cm)<br>28½" (72.4 cm) | 28¾" (73.4 cm)<br>28¾" (73.4 cm) | 29⅝" (74.3 cm)<br>29⅝" (74.3 cm) | 19½" (49.5 cm)<br>19" (48.3 cm) | 19⅜" (50.2 cm)<br>19½" (49.5 cm) | 20" (50.8 cm)<br>20" (50.8 cm) |
| 36" (91.4 cm) Models                                     |                                  |                                  |                                  |                                 |                                  |                                |
| KCGS556 and KCGS956<br>All Other 36" (91.4 cm)<br>Models | 34⅞" (88.4 cm)<br>33⅞" (86.0 cm) | 35⅞" (89.4 cm)<br>34⅞" (87.0 cm) | 35⅞" (90.3 cm)<br>35¼" (89.5 cm) | 19½" (49.5 cm)<br>19" (48.3 cm) | 19⅜" (50.2 cm)<br>19½" (49.5 cm) | 20" (50.8 cm)<br>20" (50.8 cm) |

| Side Walls (Combustible Surfaces)             |                                                                                                                   |
|-----------------------------------------------|-------------------------------------------------------------------------------------------------------------------|
| Models                                        | H and I                                                                                                           |
| KCGS5 and KCGS9                               | H and I added together must be at least 48" (122.0 cm), with each side individually being at least 8" (20.3 cm).  |
| KCGS350, KCGS356, MGC9536, WCG97US0, WCG97US6 | H and I added together must be at least 48" (122.0 cm), with each side individually being at least 12" (30.5 cm). |
| All Other Models                              | Both have to be 8" (20.3 cm) or more.                                                                             |

| Back Wall and Countertop Front Dimensions |               |              |              |
|-------------------------------------------|---------------|--------------|--------------|
| Models                                    | C             | D            | E            |
| KCGS550 and KCGS950                       | 25" (63.5 cm) | 2⅞" (7.3 cm) | 2¾" (6.9 cm) |
| All Other Models                          |               |              | 3⅞" (7.9 cm) |

**NOTES:** After making the countertop cutout, some installations may require notching down the base cabinet side walls to clear the cooktop base. To avoid this modification, use a base cabinet with sidewalls wider than the cutout.

If cabinet has a drawer, a 4" (10.2 cm) depth clearance from the countertop to the top of the drawer (or other obstruction) in base cabinet is required. The drawer depth may need to be shortened to avoid interfering with the regulator.


**IMPORTANT:** If a built-in wall oven is to be installed below this cooktop, the grounded outlet and gas supply piping must be located in an adjacent cabinet. If installing a range hood or microwave hood combination above the cooking surface, follow the range hood or microwave hood combination installation instructions for dimensional clearances above the cooktop surface.

This cooktop and its gas and electrical supply sources must be installed before the undercounter built-in wall oven is installed.


PV-27 ~~attached~~  
May 4, 2021

## Cabinet Clearances

Side View

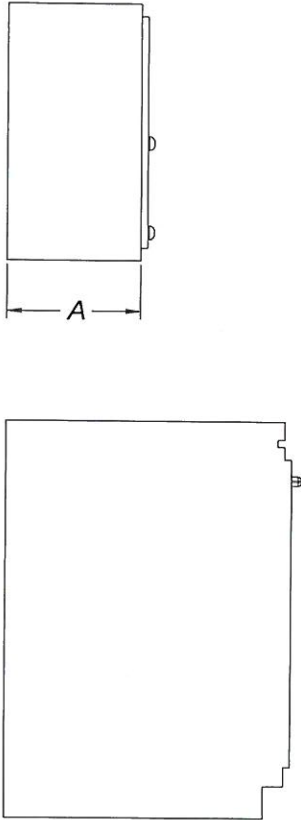

Front View

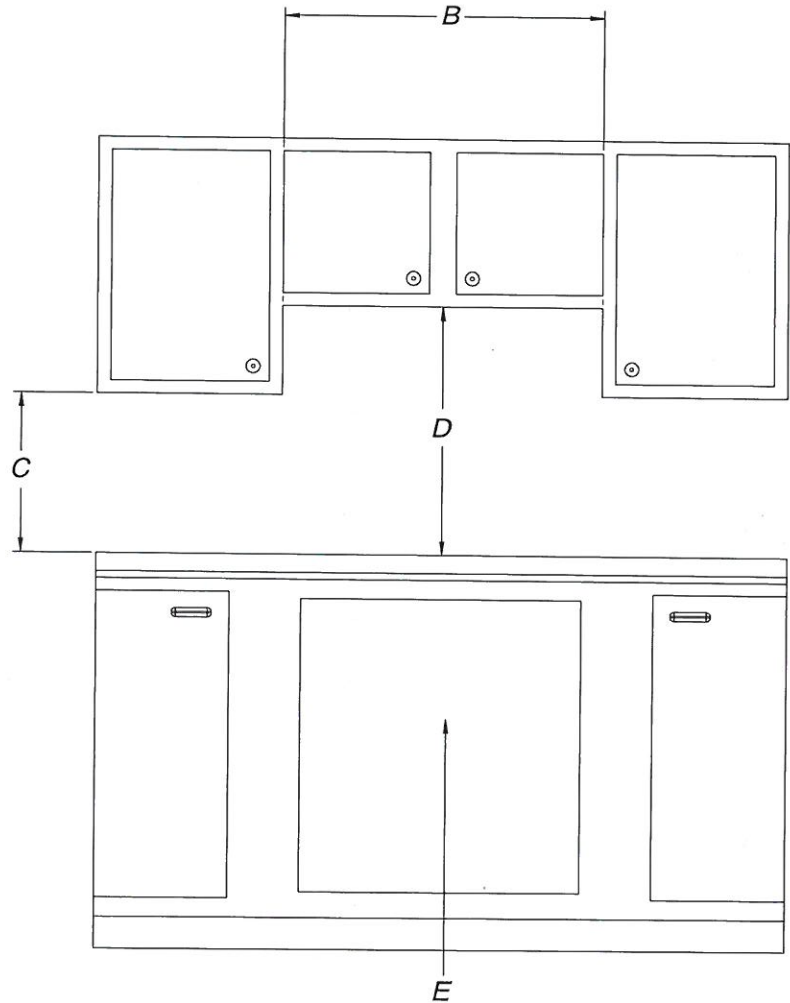

- A. 13" (33.0 cm) recommended upper cabinet depth.
- B. 30" (76.2 cm) for 30" models; 36" (91.4 cm) for 36" models.
- C. 18" (45.7 cm) minimum clearance from upper cabinet to countertop within minimum horizontal clearances to cooktop.
- D. 30" (76.2 cm) minimum clearance between top of cooktop platform and bottom of uncovered wood or metal cabinet.  
24" [61 cm] minimum clearance if bottom of wood or metal cabinet is covered by not less than 1/4" [0.6 cm] flame retardant millboard covered with not less than No. 28 MSG sheet steel, 0.015" [0.04 cm] stainless steel, or 0.024" [0.06 cm] aluminum or 0.020" [0.05 cm] copper.
- E. Gas line opening - Wall: anywhere 5" (12.7 cm) below underside of countertop. Cabinet floor: anywhere within 6" (15.2 cm) of rear wall is recommended.


PV-27 **attached**  
May 4, 2021

- Electrical supply junction box should be located 3" (7.6 cm) maximum below the support surface when the oven is installed in a wall cabinet. A 1" (2.5 cm) minimum diameter hole should have been drilled in the left rear corner of the support surface to pass the appliance cable through to the junction box.
- Oven support surface must be solid, level and flush with bottom of cabinet cutout. Floor must be able to support a total weight (microwave and built-in oven) of 208 lbs (95 kg) for 27" (68.6 cm) models or 249 lbs (113 kg) for 30" (76.2 cm) models.

**IMPORTANT:** To avoid damage to your cabinets, check with your builder or cabinet supplier to make sure that the materials used will not discolor, delaminate or sustain other damage. This oven has been designed in accordance with the requirements of UL and CSA International and complies with the maximum allowable wood cabinet temperatures of 194°F (90°C).

### Product Dimensions

#### 27" and 30" (68.6 cm and 76.2 cm) Ovens

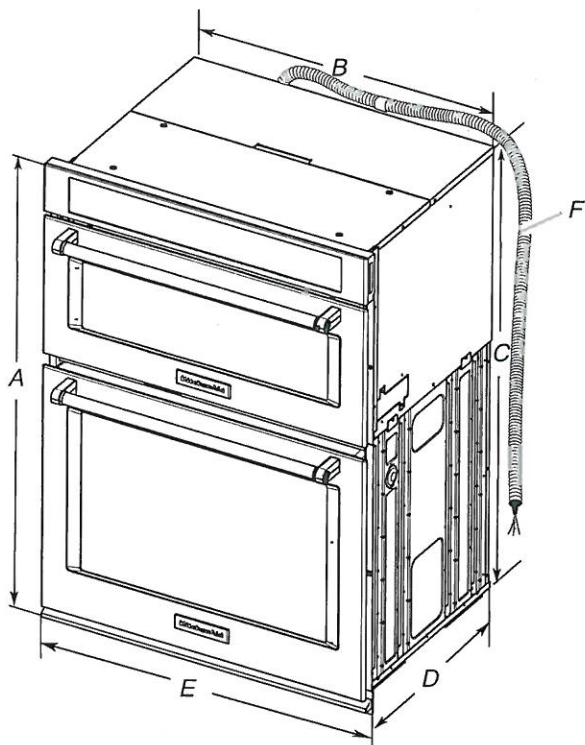

##### 27" (68.6 cm) models


- A. 42 $\frac{5}{16}$ " (108.0 cm) overall height
- B. 25 $\frac{7}{16}$ " (64.6 cm) recessed width
- C. 41" (104.1 cm) recessed height
- D. 23 $\frac{1}{4}$ " (59.1 cm) max. recessed depth
- E. 27" (68.6 cm) overall width
- F. 48" (121.9 cm) flexible conduit length measured from the conduit clamp located at the rear of the oven. Do not remove the conduit clamp.

##### 30" (76.2 cm) models

- A. 42 $\frac{5}{16}$ " (108.0 cm) overall height
- B. 28 $\frac{7}{16}$ " (72.2 cm) recessed width
- C. 41" (104.1 cm) recessed height
- D. 23 $\frac{1}{4}$ " (59.1 cm) max. recessed depth
- E. 30" (76.2 cm) overall width
- F. 48" (121.9 cm) flexible conduit length measured from the conduit clamp located at the rear of the oven. Do not remove the conduit clamp.

### Cabinet Dimensions

#### 27" and 30" (68.6 cm and 76.2 cm) Ovens

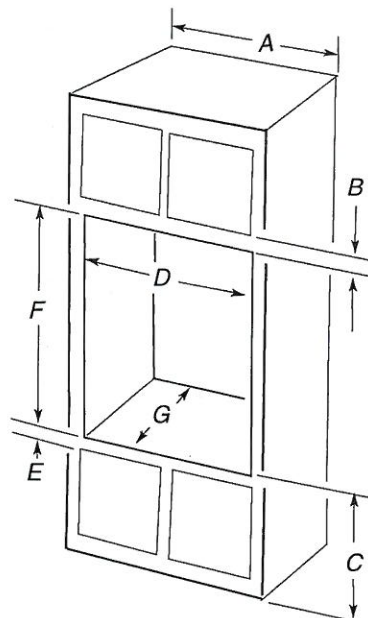

##### 27" (68.6 cm) models

- A. 27" (68.6 cm) min. cabinet width
- B. 1" (2.5 cm) top of cutout to bottom of upper cabinet door
- C. 19 $\frac{1}{4}$ " (48.9 cm) bottom of cutout to floor is recommended. 4"-19 $\frac{1}{4}$ " (10.2-48.9 cm) bottom of cutout to floor is acceptable.
- D. 25 $\frac{1}{2}$ " (64.8 cm) cutout width
- E. 1 $\frac{1}{2}$ " (3.8 cm) min. bottom of cutout to top of cabinet door
- F. 41 $\frac{5}{16}$ " (105 cm)\* recommended cutout height
- G. 24" (60.7 cm) cutout depth

##### 30" (76.2 cm) models

- A. 30" (76.2 cm) min. cabinet width
- B. 1" (2.5 cm) top of cutout to bottom of upper cabinet door
- C. 19 $\frac{1}{4}$ " (48.9 cm) bottom of cutout to floor is recommended. 4"-19 $\frac{1}{4}$ " (10.2-48.9 cm) bottom of cutout to floor is acceptable.
- D. 28 $\frac{1}{2}$ " (72.4 cm) cutout width
- E. 1 $\frac{1}{2}$ " (3.8 cm) min. bottom of cutout to top of cabinet door
- F. 41 $\frac{5}{16}$ " (105 cm)\* recommended cutout height
- G. 24" (60.7 cm) cutout depth

**\*NOTE:** The cutout height can be between 41" and 41 $\frac{1}{2}$ " (104.1 cm and 105.6 cm) for microwave/oven combination.

### Electrical Requirements

If codes permit and a separate ground wire is used, it is recommended that a qualified electrical installer determine that the ground path and wire gauge are in accordance with local codes.

Check with a qualified electrical installer if you are not sure the oven is properly grounded.

This oven must be connected to a grounded metal, permanent wiring system.


Be sure that the electrical connection and wire size are adequate and in conformance with the National Electrical Code, ANSI/NFPA 70-latest edition or CSA Standards C22.1-94, Canadian Electrical Code, Part 1 and C22.2 No. O-M91-latest edition, and all local codes and ordinances.

A copy of the above code standards can be obtained from:

National Fire Protection Association  
1 Batterymarch Park  
Quincy, MA 02169-7471

CSA International  
8501 East Pleasant Valley Road  
Cleveland, OH 44131-5575

PV-27    
May 1, 2021

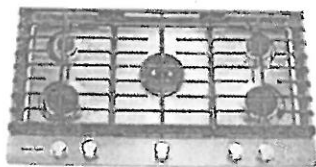

**KITCHENAID 36" 5- BURNER GAS COOKTOP  
– STAINLESS STEEL**

**\$ 1,649.00**

SKU: KCG6556T-5

VSN: ACG6556LSS

**Dimensions**

Width: 36" (91.4 cm) Height: 3.62" (9.2 cm) Depth: 21" (53.3 cm)

Experience the convenient technology this cooktop from KitchenAid offers. Even-Heat™ technology uses a diffuser plate to allow for more control of the cooktop, making it ideal for melting chocolate or simmering sauce. With a professional dual-ring burner and electronic ignition, this cooktop makes it simple to whip up countless masterpieces. What's more, the CookShield finish helps protect against spills and stains while making the cooktop easy to wipe clean without the use of harsh chemicals.

**KitchenAid**

**Key Features:**

- Even Heat Technology
- Professional Dual-Ring Burner
- CookShield Finish
- Electronic Ignition


Kitchenaid: 36" 5-Burner Gas Cooktop

PP-27 ~~(X)~~ (S)  
May 4, 2011

Width: 36" (91.4 cm) Height: 3.62" (9.2 cm) Depth: 21" (53.3 cm)


Product Dimensions

KCGS550ESS and KCGS950ESS Models

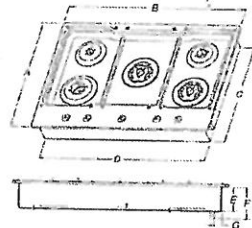

- |                      |                     |
|----------------------|---------------------|
| A. 21" (53.3 cm)     | E. 3 1/2" (8.9 cm)  |
| B. 30" (76.2 cm)     | F. 4 1/2" (11.5 cm) |
| C. 19 1/2" (49.5 cm) | G. 2 1/4" (5.7 cm)  |
| D. 28 1/2" (72.6 cm) |                     |


KCGS550ESS and KCGS950ESS Models

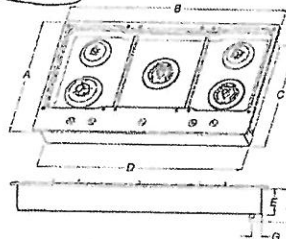

- |                      |                     |
|----------------------|---------------------|
| A. 21" (53.3 cm)     | F. 3 1/2" (8.9 cm)  |
| B. 36" (91.4 cm)     | G. 4 1/2" (11.5 cm) |
| C. 19 1/2" (49.5 cm) |                     |
| D. 34 1/2" (88.0 cm) |                     |


\* ← This one is correct

All Other 30" (76.2 cm) Models

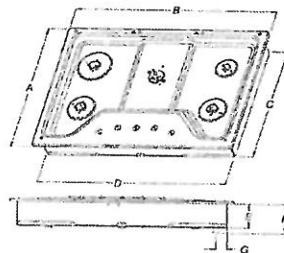


- |                      |                     |
|----------------------|---------------------|
| A. 21" (53.3 cm)     | F. 3 1/2" (8.9 cm)  |
| B. 30" (76.2 cm)     | G. 4 1/2" (11.5 cm) |
| C. 19 1/2" (49.5 cm) |                     |
| D. 28 1/2" (72.6 cm) |                     |

All Other 36" (91.4 cm) Models

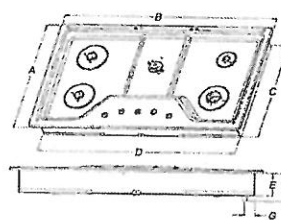


- |                      |                     |
|----------------------|---------------------|
| A. 21" (53.3 cm)     | F. 3 1/2" (8.9 cm)  |
| B. 36" (91.4 cm)     | G. 4 1/2" (11.5 cm) |
| C. 19 1/2" (49.5 cm) |                     |
| D. 34 1/2" (88.0 cm) |                     |

Kitchenaid: 36" 5-Burner Gas COOKTOP  
 PV-1+  Width 36" (91.4cm) Height: 3.62" (9.2cm) Depth: 21" (53.3cm)  
 May 4, 2011

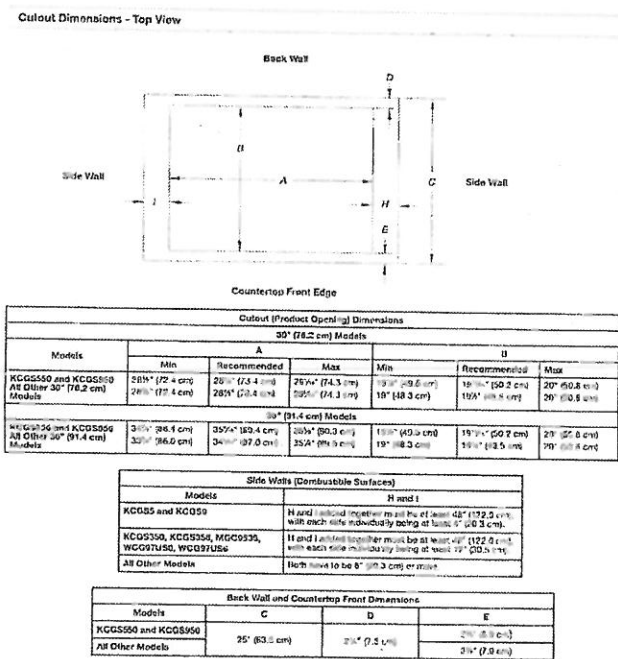

NOTES: After making the countertop cutout, some installations may require notching down the base cabinet side walls to clear the cooktop base. To avoid this modification, use a base cabinet with side walls wider than the cutout.  
 If cabinet has a drawer, a 4" (10.2 cm) depth clearance from the countertop to the top of the drawer for other obstruction in base cabinet is required. The drawer depth may need to be shortened to avoid interfering with the regulator.  
 IMPORTANT: If a built-in wall oven is to be installed below the cooktop, the grounded outlet and gas supply piping must be located in an adjacent cabinet. If installing a range hood or microwave hood combination above the cooking surface, follow the range hood or microwave hood combination manufacturer's instructions for dimensional clearances above the cooktop surface.  
 The cooktop and its gas and electrical supply sources must be installed before the under-cabinet built-in wall oven is installed.

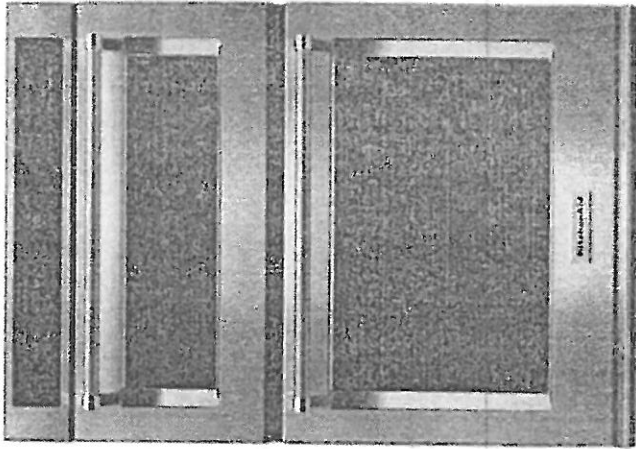

**KITCHENAID 30" COMBINATION WALL  
OVEN WITH EVEN-HEAT™ TRUE  
CONVECTION - KOCE500ESS**

**\$ 4,899.00**

SKU: KOCE500S

VSN: KOCE500ESS

**Dimensions**

Width: 30" (76.2 cm) Height: 42.5" (108.0 cm) Depth: 26.88" (68.3 cm)

Serve chef-quality meals to your family and friends thanks to this KitchenAid 30" combination wall oven. With an extra-large conventional oven and microwave, you'll have all the room you need to create a true feast. The Even-Heat™ true convection system ensures your oven is heated to, and remains at, the perfect temperature. Use the EasyConvect™ conversion feature to be certain your food is heated through just right


PV-27  
May 4, 1971

KitchenAid 30" Combination Wall Oven  
SKU : KOCE 500S  
USN : KOCE 500ES  
Width: 30"(76.2cm) Height: 42.5"(108cm) Depth: 26.88"(68.3cm)

Cabinet Clearances

Side View

Front View

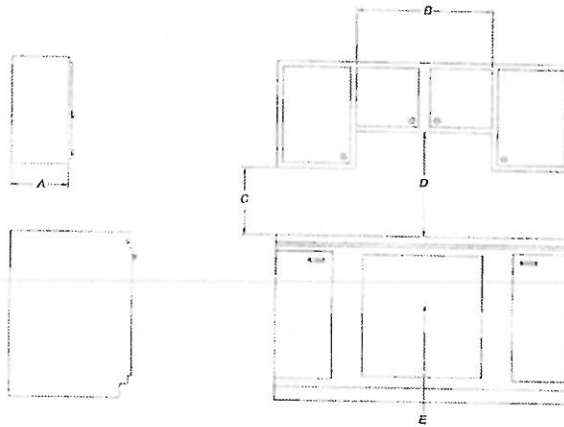

- A 17" (43.0 cm) maximum depth of upper cabinet depth
- B 26" (66.0 cm) maximum height, 30" (76.2 cm) for 30" models
- C 18" (45.7 cm) maximum clearance from upper cabinet to back of oven with minimum horizontal clearance to backstop
- D 30" (76.2 cm) minimum clearance between top of countertop and bottom of uncovered wall or metal cabinet
- E 24" (61.0 cm) minimum clearance if bottom of wall or metal cabinet is covered by not less than 1/2" (12.7 mm) layer of material covered with not less than 1/2" (12.7 mm) layer of material

PV-27 30" 30"  
Way 4, 2011

Kitchenaid 30" Combination wall oven  
SKU: KOCE500S  
VSN: KOCE500ESS

width: 30" (76.2 cm) Height: 42.5" (108.0 cm) Depth: 26.88" (68.3 cm)


Electrical supply junction box should be located 3" (7.6 cm) maximum below the cabinet floor when the oven is installed in a wall cabinet. A 1/2" (1.3 cm) hole should have been drilled in the left rear corner of the support surface to pass the appliance cable through in the junction box.

Oven support surface must be solid, level and flush with bottom of cabinet cutout. Floor must be able to support a total weight (microwave and built-in oven) of 163 lbs (73.5 kg) for 27" (68.6 cm) models, or 219 lbs (99.1 kg) for 30" (76.2 cm) models.

IMPORTANT: To avoid damage to your cabinets, check with your builder or cabinet dealer to make sure that the materials used will not discolor, flange or stain other materials. This oven has been designed in accordance with the requirements of UL and CSA International and complies with the maximum allowable wood cabinet temperature of 155°F (68°C).

#### Product Dimensions


27" and 30" (68.6 cm and 76.2 cm) Ovens

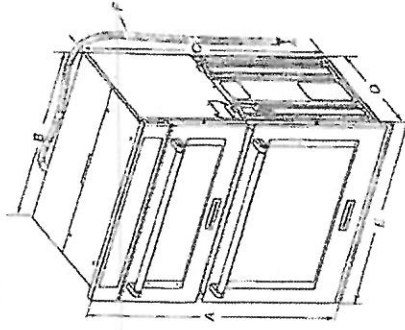

27" (68.6 cm) models  
A 42 1/2" (108.0 cm) overall height  
B 25 1/2" (64.8 cm) recessed height  
C 41" (104.1 cm) max recessed height  
D 23 1/2" (59.1 cm) max depth  
E 23 1/2" (59.1 cm) max depth  
F 23 1/2" (59.1 cm) max depth  
G 23 1/2" (59.1 cm) max depth  
H 23 1/2" (59.1 cm) max depth

#### Cabinet Dimensions

27" and 30" (68.6 cm and 76.2 cm) Ovens

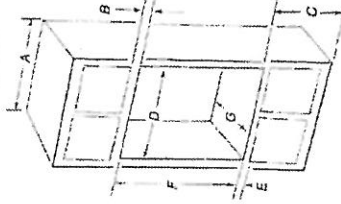

27" (68.6 cm) models  
A 27" (68.6 cm) min cabinet width  
B 5 1/2" (14.0 cm) min cabinet depth  
C 19 1/2" (49.5 cm) min cabinet depth  
D 1 1/2" (3.8 cm) min cabinet depth  
E 1 1/2" (3.8 cm) min cabinet depth  
F 1 1/2" (3.8 cm) min cabinet depth  
G 2 1/2" (6.4 cm) min cabinet depth  
H 2 1/2" (6.4 cm) min cabinet depth

\*NOTE: The cutout height can be between 41" and 41 1/2" (104.1 cm and 105.5 cm) for microwave/oven combination.

#### Electrical Requirements

If codes permit and a separate ground wire is used, it is recommended that a qualified electrical installer determine that the ground path and wire gauge are in accordance with local codes.

Check with a qualified electrical installer if you are not sure the oven is properly grounded.

This oven must be connected to a grounded metal, permanent wiring system.

Be sure that the electrical connection and wire size are adequate.

Check for compliance with the National Electrical Code, ANSI/NFPA 70-1999, Canadian Electrical Code, Part I, and CEC 2002, 2003, 2004, 2005, and all local codes and ordinances.

A copy of the above code standards can be obtained from:  
National Fire Protection Association  
1 Batterymarch Park  
Quincy, MA 02269-7471  
CSA International  
2501 East Pleasant Valley Road  
Cleveland, OH 44131-5575

PV - 27 Cabinetry Schedule

| ROOM             | DESCRIPTION                                                                  | PRICE | QTY | TOTAL |
|------------------|------------------------------------------------------------------------------|-------|-----|-------|
| KITCHEN          | ADD POTS AND PANS DRAWER BELOW COOKTOP                                       |       | 1   |       |
|                  | CONVERT STANDARD CABINETRY TO TALL DEEP BUILT IN OVEN UNIT WITH DRAWER BELOW |       | 1   |       |
|                  | RELOCATE STD BANK OF 4 DRAWERS TO ISLAND (N/C)                               |       | 1   |       |
|                  | ADJUST CABINETRY FOR 36" COOKTOP (N/C)                                       |       | 1   |       |
|                  | LEAVE 42" SPACE IN UPPER CABINETS ABOVE COOKTOP (N/C)                        |       | 1   |       |
| CABINETRY TOTAL: |                                                                              |       |     |       |

\*\*\*HANDLE PLACEMENT: AT INSTALLERS DISCRETION\*\*\*

LOT #:  
27

DATE:  
April 21 2021

SIGNATURE:  


SIGNATURE:  



PV-27  
April 21, 2021

Aloua 'storm Grey Oak'

OPEN +  
drawers below.

GOLDPARK HOMES  
PINE VALLEY  
VAUGHAN, ONTARIO  
MODEL: (4203) FORESTCREST

SITE STANDARD: WHITE 3/4" EXTENSION  
SOFT-CLOSE DRAWERS & SOFT-CLOSE  
HINGES TO KITCHEN AREA  
10" CEILING - 12"H COFFERED CEILING -  
M.H. = 102" + 3/4"H TEMPORARY  
MOLDING + 5 1/4"H FURRING RAIL  
+ LARGE CORNICE MOLDING TO  
UNDERSIDE OF BOX

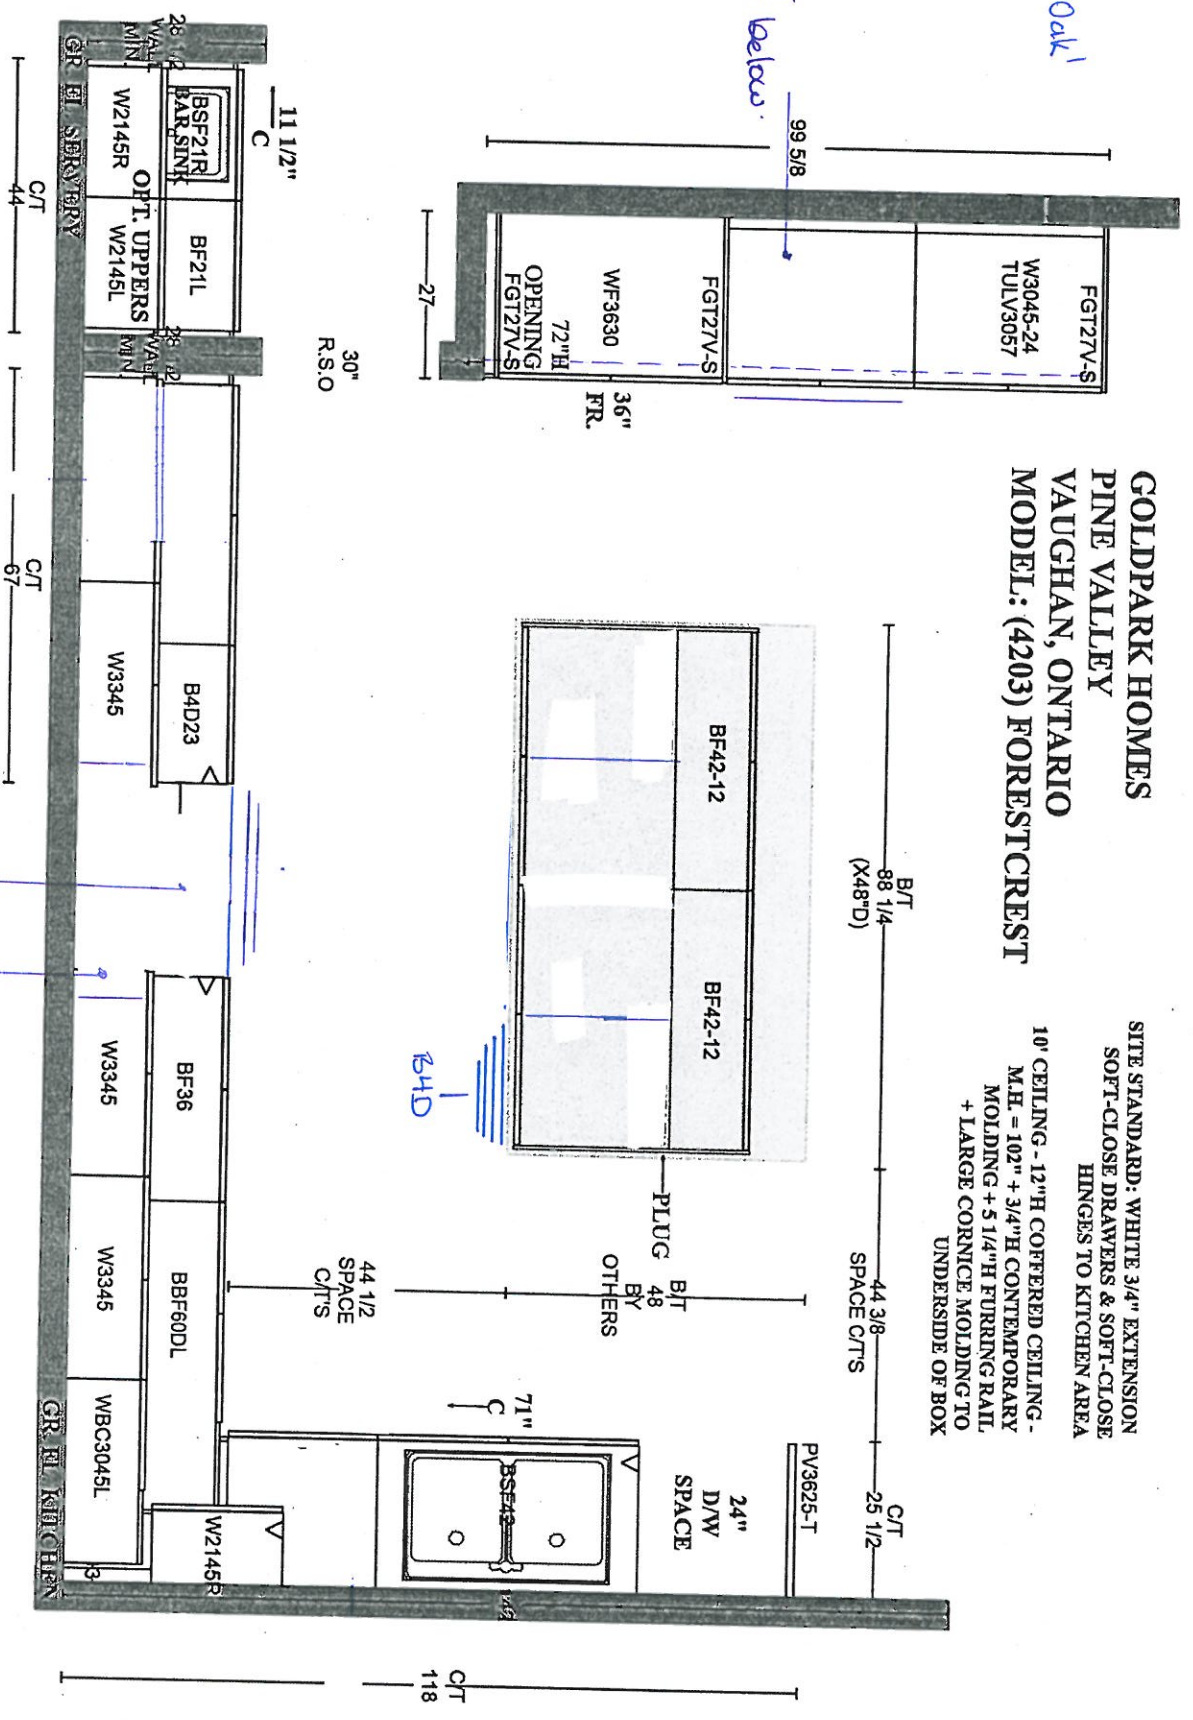

PLAN VIEW




PV-27  
April 21, 2021

AB

GOLDPARK HOMES  
PINE VALLEY  
VAUGHAN, ONTARIO  
MODEL: (4203 OPT.) FORESTCREST

SITE STANDARD: WHITE 3/4" EXTENSION  
SOFT-CLOSE DRAWERS & STANDARD SLAM DOOR HINGES  
TO VANITIES

ONE TOP DRAWER WHERE POSSIBLE THROUGHOUT EACH  
VANITY, ONE BANK OF DRAWERS WHERE POSSIBLE  
THROUGHOUT EACH MASTER ENSUITE

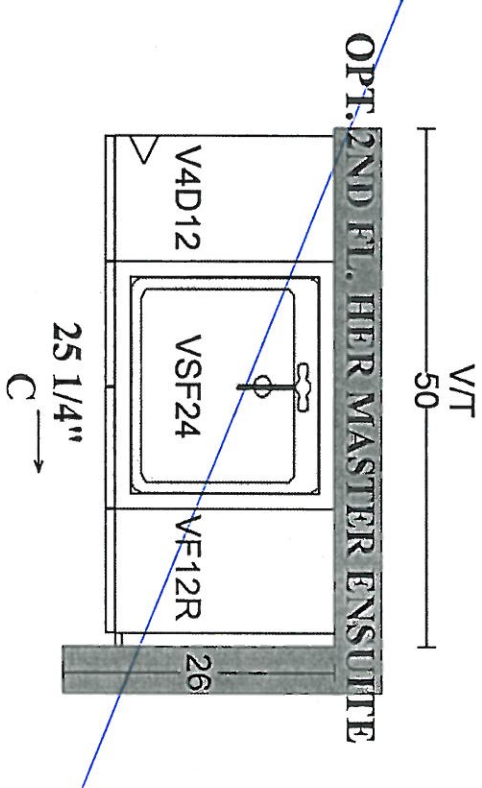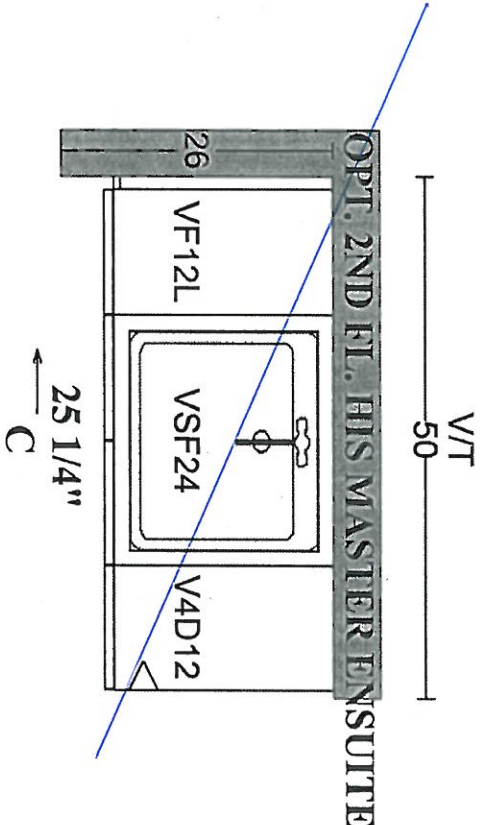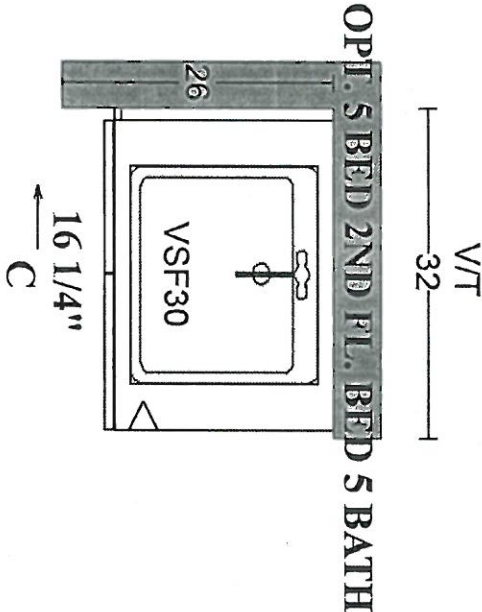

PLAN VIEW

Scheduled Closing Date: Thursday, August 26, 2021

Purchasers: NARINDER, KAUR DULAY & GURMEL, SINGH Property: 27 of Plan -

Telephone Res. / Bus: / Project: Pine Valley Forevergreen - Phase 1

Decor Advisor: Angela Phim Model and Elevation: 42.03 A FORESTCREST

Layout Changes: Yes No Sketch Attached: Yes No Exterior Colour Scheme:

1. Cabinetry

|                                         | Style and Colour       | Counter                  | Hardware |
|-----------------------------------------|------------------------|--------------------------|----------|
| Kitchen / Breakfast                     | Alban 'Storm Grey Oak' | *Quartz: 'Pearl Jasmine' | attach   |
| Laundry Room                            | Bowery 'Ello'          | P-Lam 'White'            | attach   |
| Powder Room                             | Alban 'Storm Grey Oak' | Quartz: 'Nordic Loft'    | attach   |
| Mud Room                                | Alban 'Storm Grey Oak' | P-Lam: 'White'           | attach   |
| Master Ensuite Bathroom                 | Alban 'Storm Grey Oak' | Quartz: 'Nordic Loft'    | attach   |
| Second Ensuite Bathroom (If Applicable) | Tribeca 'Bianca'       | *Quartz: 'Raven'         | attach   |
| Ensuite 3                               | Alban 'Storm Grey Oak' | Quartz: 'Nordic Loft'    | attach   |

Comment

Ensuite 4 Cab: \*Wexford 'Classic White' + \*Quartz: 'Empira Black' / Ensuite 5 Cab: Alban 'Storm Grey Oak' + \*Quartz: 'Raven'

2. Floor Tile

|                                         | Selection                               |
|-----------------------------------------|-----------------------------------------|
| Entrance Vestibule                      | 13x13" Costa 'White'                    |
| Main Hall                               | n/a                                     |
| Kitchen / Breakfast                     | *see hardwood                           |
| Laundry Room                            | 13x13" Costa 'White'                    |
| Powder Room                             | 13x13" Costa 'White'                    |
| Mud Room                                | 13x13" Costa 'White'                    |
| Master Ensuite Bathroom                 | *12x24" Eterna 'Imperial Grey' polished |
| Second Ensuite Bathroom (If Applicable) | *12x24" Reve 'Nuit'                     |
| Lower Landing (If Applicable)           | 13x13" Costa 'White' (basement foyer)   |
| Ensuite 3                               | 13x13" Costa 'White'                    |

Comment

Ensuite 4: 13x13" Camebridge 'White' / Ensuite 5: 13x13" New Reeds / Master Ensuite Shower Floor: \*Eterna 'Imperial Grey' Herringbone / Thru-out shower floors: 2x2" standard 'white'

3. Wall Tile

|                                         | Selection                                                     | Listello/Inserts                                              | Describe |
|-----------------------------------------|---------------------------------------------------------------|---------------------------------------------------------------|----------|
| Ensuite 4                               | 8x10" Weave 'White'                                           | <input type="radio"/> Yes <input checked="" type="radio"/> No |          |
| Master Ensuite Bathroom                 |                                                               |                                                               |          |
| Tub Deck                                |                                                               | <input type="radio"/> Yes <input checked="" type="radio"/> No |          |
| Shower Stall                            | *12x24"Eterna 'ImperialGrey' pol                              | <input type="radio"/> Yes <input checked="" type="radio"/> No |          |
| Bathroom Walls                          |                                                               | <input type="radio"/> Yes <input checked="" type="radio"/> No |          |
| Second Ensuite Bathroom (If Applicable) | 8x10" Uniwall 'White'                                         | <input type="radio"/> Yes <input checked="" type="radio"/> No |          |
| Ensuite 3                               | 8x10" Weave 'White'                                           | <input type="radio"/> Yes <input checked="" type="radio"/> No |          |
| Kitchen Backsplash                      | <input checked="" type="radio"/> Yes <input type="radio"/> No | Backsplash Behind Fridge                                      |          |
| Comment                                 | same as Counter.                                              |                                                               |          |

Ensuite 5: 8x10" Weave 'Tender Grey'

Handwritten initials and stamps.

Purchasers: NARINDER, KAUR DULAY & GURMEL, SINGH Property: 27 of Plan -

Telephone Res. / Bus: /

Project: Pine Valley Forevergreen - Phase 1

Decor Advisor: Angela Phim

Model and Elevation: 42.03 A FORESTCREST

### 4. Plumbing Fixtures

|                         |                      |                      |                      |                      |
|-------------------------|----------------------|----------------------|----------------------|----------------------|
| <input type="text"/>    | Second Ensuite       | <input type="text"/> | Powder Room          | <input type="text"/> |
| Master Ensuite Bathroom | <input type="text"/> | Other Room - Specify | <input type="text"/> | Other Washroom       |
|                         |                      | <input type="text"/> |                      |                      |

Comment

\*see attached plumbing upgrades

### 5. Hardwood Flooring

|                                  | Type and Stain                 |                                                 | Type and Stain                 |
|----------------------------------|--------------------------------|-------------------------------------------------|--------------------------------|
| Main Hall                        | <input type="text"/>           | Upper Landing                                   | <input type="text"/>           |
| Kitchen / Breakfast              | *5x3/4" WhtOak,Sculpted,Apollo | Upper Hall                                      | <input type="text"/>           |
| Living Room                      | <input type="text"/>           | Master Bedroom                                  | <input type="text"/>           |
| Dining Room                      | <input type="text"/>           | Bedroom #2                                      | <input type="text"/>           |
| Family Room                      | <input type="text"/>           | Bedroom #3                                      | <input type="text"/>           |
| Den/Library                      | <input type="text"/>           | Bedroom #4                                      | <input type="text"/>           |
| Entrance Vestibule               | <input type="text"/>           | Bedroom #5                                      | <input type="text"/>           |
| Lower Landing<br>(If Applicable) | <input type="text"/>           | Other Room - Specify<br>thru-out standard areas | *5x3/4" WhtOak,Sculpted,Apollo |

Comment

### 6. Carpeting

|                      | Upgrade                  | Description          |
|----------------------|--------------------------|----------------------|
| Ground Floor         | <input type="checkbox"/> | <input type="text"/> |
| Second Floor         | <input type="checkbox"/> | <input type="text"/> |
| <input type="text"/> | <input type="checkbox"/> | <input type="text"/> |

|                  |                      |                      |
|------------------|----------------------|----------------------|
| Upgrade Underpad | Type                 | Area                 |
|                  | <input type="text"/> | <input type="text"/> |
| Carpet on Stairs | Capped               | Runner - *Upgrade    |
|                  | <input type="text"/> | <input type="text"/> |

Comment

### 7. Fireplace

|                | Living Room           |                       |                       | Family Room           |                       |                       | Other Room - Specify  |                                  |                       |
|----------------|-----------------------|-----------------------|-----------------------|-----------------------|-----------------------|-----------------------|-----------------------|----------------------------------|-----------------------|
|                | Purchased             | As Per Plan           | N/A                   | Purchased             | As Per Plan           | N/A                   | Purchased             | As Per Plan                      | N/A                   |
| Fireplace Type | <input type="radio"/> | <input type="radio"/> | <input type="radio"/> | <input type="radio"/> | <input type="radio"/> | <input type="radio"/> | <input type="radio"/> | <input checked="" type="radio"/> | <input type="radio"/> |
| Mantle Type    | <input type="text"/>  | <input type="text"/>  | <input type="text"/>  | <input type="text"/>  | <input type="text"/>  | <input type="text"/>  | <input type="text"/>  | <input type="text"/>             | <input type="text"/>  |
| Colour / Stain | <input type="text"/>  | <input type="text"/>  | <input type="text"/>  | <input type="text"/>  | <input type="text"/>  | <input type="text"/>  | <input type="text"/>  | <input type="text"/>             | <input type="text"/>  |
| Surround       | <input type="text"/>  | <input type="text"/>  | <input type="text"/>  | <input type="text"/>  | <input type="text"/>  | <input type="text"/>  | <input type="text"/>  | <input type="text"/>             | <input type="text"/>  |
| Hearth         | <input type="text"/>  | <input type="text"/>  | <input type="text"/>  | <input type="text"/>  | <input type="text"/>  | <input type="text"/>  | <input type="text"/>  | <input type="text"/>             | <input type="text"/>  |

Comment

Scheduled Closing Date: Thursday, August 26, 2021

Purchasers: NARINDER, KAUR DULAY &amp; GURMEL, SINGH Property: 27 of Plan -

Telephone Res. / Bus: /

Project: Pine Valley Forevergreen - Phase 1

Decor Advisor: Angela Phim

Model and Elevation: 42.03 A FORESTCREST

## 8. Trim Carpentry

Interior Doors Carrara Front Door Glass Inserts std Door Handles

Interior Trim

Comment

## 9. Plaster Mouldings and Medallions

Standard Throughout ☐ Yes ☐ No ☐ N/A

Entrance Vestibule Kitchen/Breakfast

Main Hall Den/Library

Living Room Lower Landing

Dining Room Other Room - Specify

Family Room

Comment

## 10. Railings and Spindles

Railing Package \*A2 package

Railing Colour \*Mirage 'Hopscotch' Spindle Colour \*Black

Stringer / Riser \*Mirage 'Hopscotch' Treads \*Mirage 'Hopscotch'

Comment

Oak Stairs ☒ Yes ☐ No ☐ N/A

## 11. Wall Paint / Ceilings

Throughout Finished Areas Warm Grey

Trim Paint White

Smooth Ceilings

Ground Floor ☒Second Floor ☒

Note

Comment

Scheduled Closing Date: Thursday, August 26, 2021

Purchasers: NARINDER, KAUR DULAY & GURMEL, SINGH Property: 27 of Plan -

Telephone Res. / Bus: /

Project: Pine Valley Forevergreen - Phase 1

Decor Advisor: Angela Phim

Model and Elevation: 42.03 A FORESTCREST

### 12. Electrical

Hood Fan ☐ White ☐ Stainless ☒ N/A

Above Kitchen Cabinet Light ☐ Yes ☒ No

Below Kitchen Cabinet Light ☐ Yes ☒ No

Standard Appliances ☐

Over The Range Microwave ☐

Chimney Style Fan ☒

Comment

### 13. Heating and Air Conditioning

Air Conditioning

Gas Provisions Stove

Gas Provisions Dryer

Gas Provisions Barbecue

Comment

### 14. Additional Comments

### 15. Disclaimers and Notes

- 1) Colours of all materials are as close as possible to builder's selection, but not necessarily identical due to variances in manufacturing.
- 2) Any extras listed above are null and void unless accompanied by a separate invoice/amendment. Said invoice must be paid in full.
- 3) The Purchaser acknowledges that after Interior Colour Selection form is signed and dated, no further changes will be permitted other than re-selection due to unavailability. \_\_\_\_\_ Purchaser's Initials
- 4) The Purchaser acknowledges reading and accepting the "Gold Park Homes Decor Centre Disclaimers" form. This document contains other miscellaneous disclaimers.

This Interior Colour Selection is final and approved by:

Signature:  Date: \_\_\_\_\_



SCHEDULE 'F'

PV-27 ~~attached~~

March 16, 2021

PV-27

March 23, 2021

# The Forestcrest 42' SERIES

→ Elevation A • 3,800 sq.ft.  
Elevation B • 3,785 sq.ft.  
Elevation C • 3,800 sq.ft.

~~A~~

PV-27

April 21, 2021


~~g~~

COFFER

APPROX  
64" A.F.F.

NO!

GAS +  
ELECT

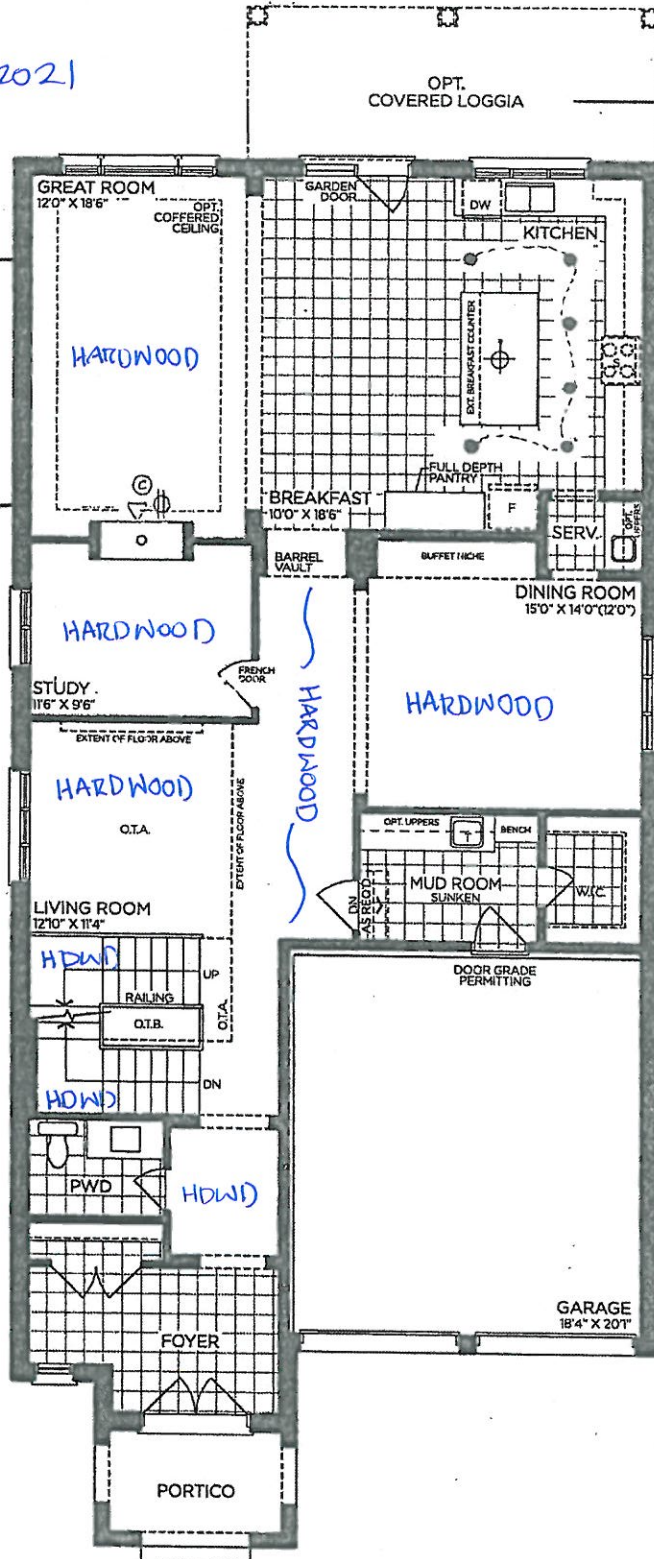

GROUND FLOOR | ELEV. A

VENDOR

PURCHASER

PURCHASER

## GOLDPARK

WORTH MORE™

Prices, figures, illustrations, sizes, features and finishes are subject to change without notice. Areas and dimensions are approximate and actual usable floor space may vary from the stated area. Layout may be reverse of the unit purchased. E. & O.E. 4203



SCHEDULE 'F'

PV-27 ~~attached~~  
March 16, 2021


PV-27 ○ ○  
March 23, 2021

PV-27  
April 21, 2021

# The Forestcrest

## 42' SERIES

→ Elevation A • 3,800 sq.ft.  
Elevation B • 3,785 sq.ft.  
Elevation C • 3,800 sq.ft.

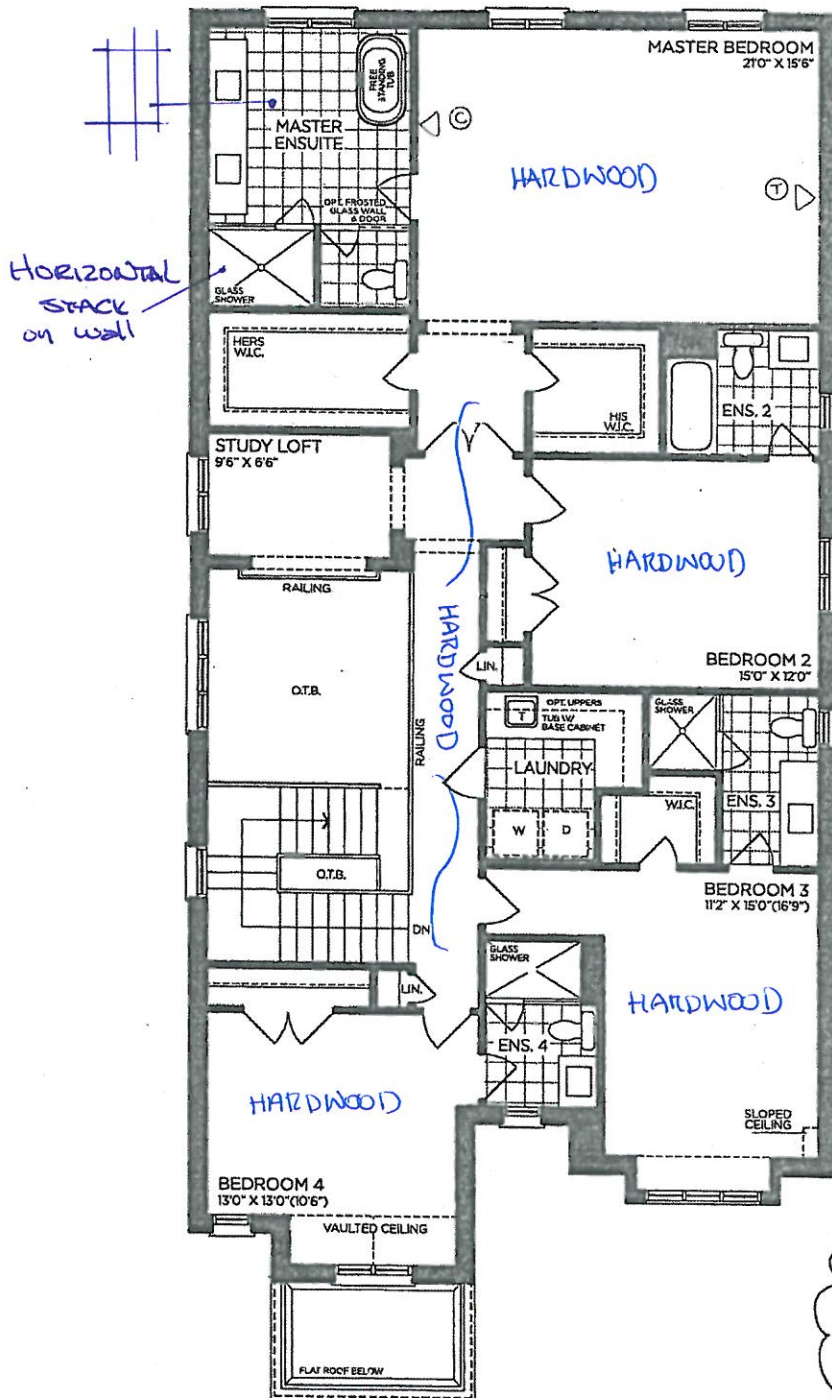

SECOND FLOOR | ELEV. A

SEE 5 BDRM  
option to  
Ensuite

NO PHONES IN  
BEDROOM 2, 3, 4, 5

|           |                      |
|-----------|----------------------|
| VENDOR    | <input type="text"/> |
| PURCHASER | <input type="text"/> |
| PURCHASER | <input type="text"/> |

## GOLDPARK

WORTH MORE™

Prices, figures, illustrations, sizes, features and finishes are subject to change without notice. Areas and dimensions are approximate and actual usable floor space may vary from the stated area. Layout may be reverse of the unit purchased. E. & O.E. 4203

SCHEDULE 'F'



PV-27  

March 16, 2021

PV-27  

March 23, 2021

PV-27  
April 21, 2021

24" x 30"


24" x 30"

# The Forestcrest

## 42' SERIES

➔ Elevation A • 3,800 sq.ft.  
Elevation B • 3,785 sq.ft.  
Elevation C • 3,800 sq.ft.

9' BASEMENT

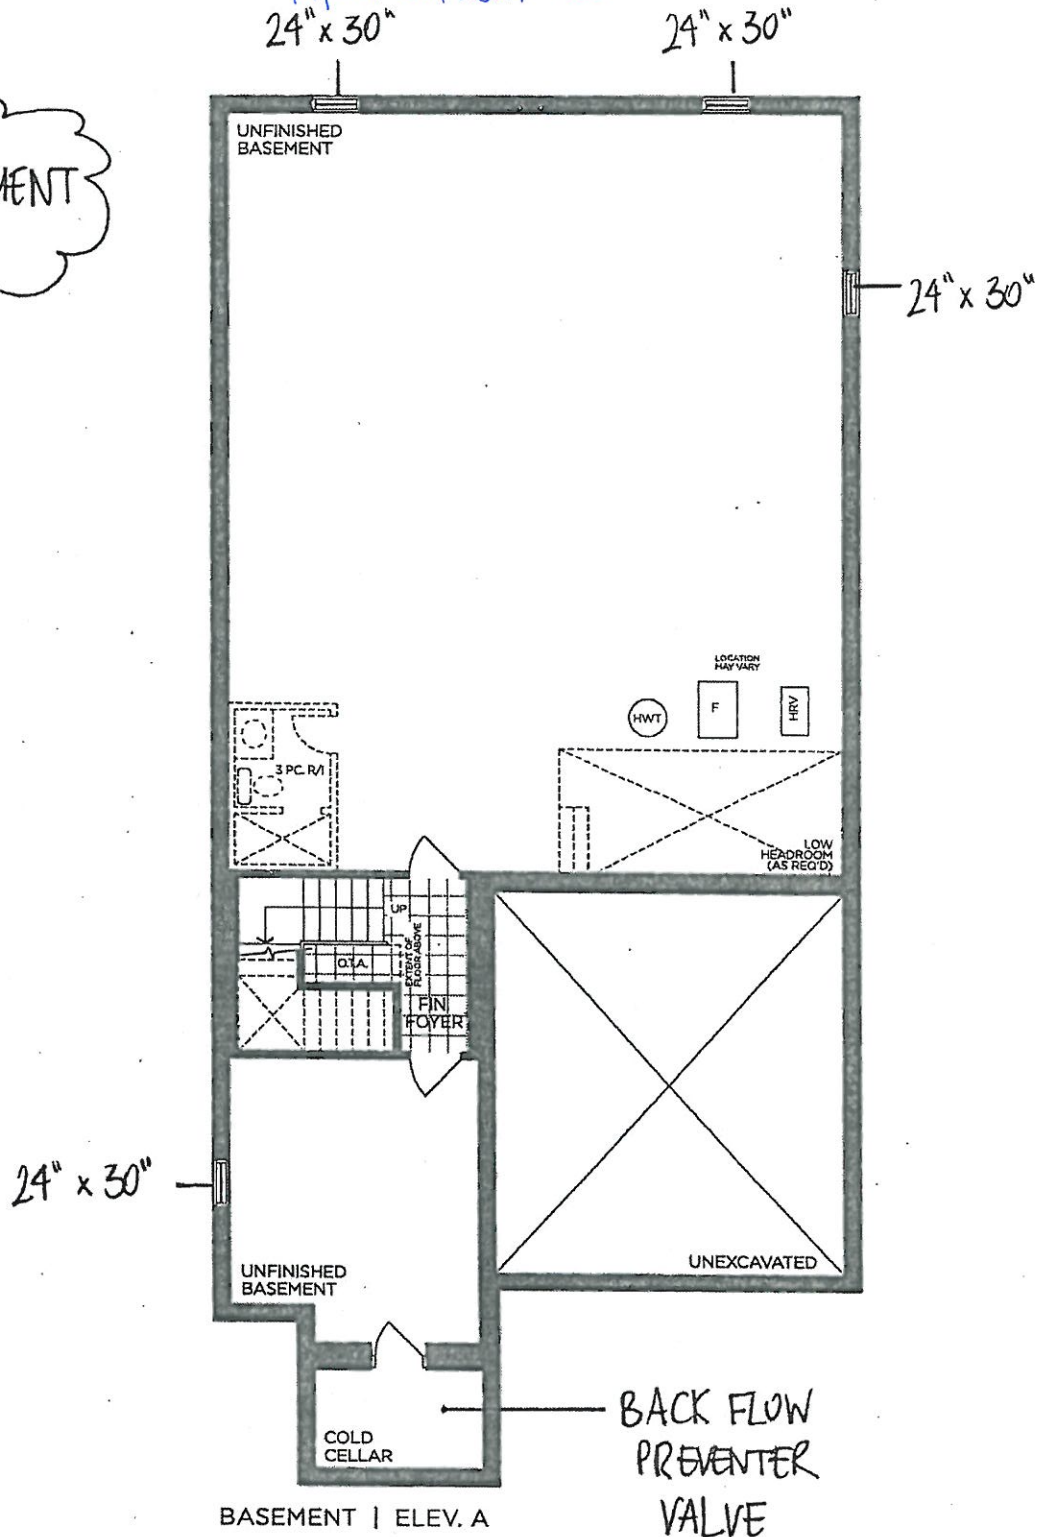

VENDOR

PURCHASER

PURCHASER

**GOLDPARK**  
WORTH MORE™

Prices, figures, illustrations, sizes, features and finishes are subject to change without notice. Areas and dimensions are approximate and actual usable floor space may vary from the stated area. Layout may be reverse of the unit purchased. E. & O.E. 4203




SCHEDULE 'F'  
PV-27 ~~attached~~  
March 16, 2021  
PV-27 ○ ○  
March 23, 2021


# The Forestcrest 42' SERIES

Elevation A • 3,800 sq.ft.  
Elevation B • 3,785 sq.ft.  
Elevation C • 3,800 sq.ft.


NO PHONES IN  
BEDROOM 2,3,4,5

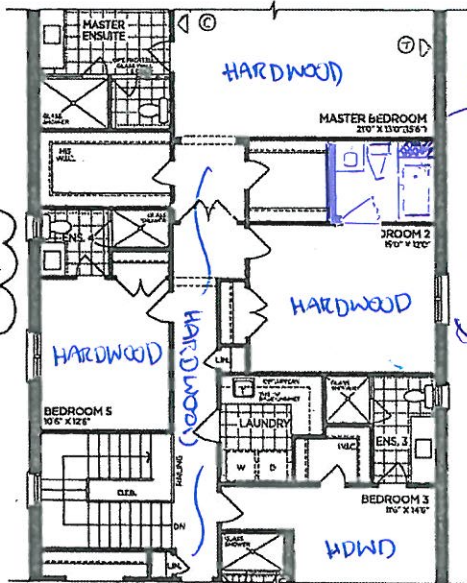


OPT. PART. SECOND FLOOR | ELEV. A  
5 BEDROOM

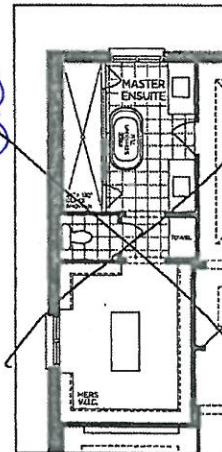


OPT. PART. SECOND FLOOR  
MASTER ENSUITE

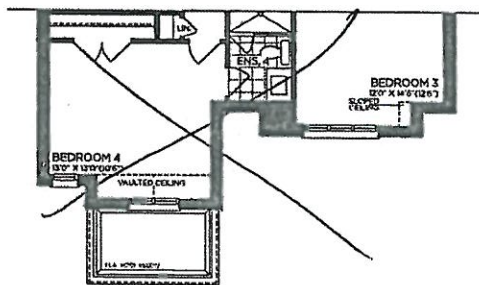


PART. SECOND FLOOR | ELEV. B

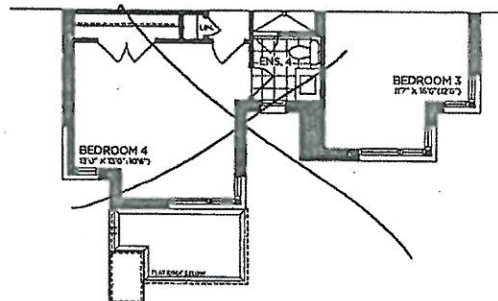


PART. SECOND FLOOR | ELEV. C

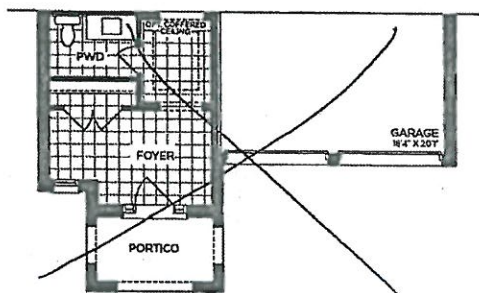


PART. GROUND FLOOR | ELEV. B

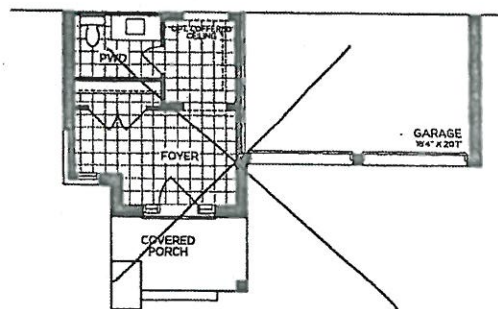

PART. GROUND FLOOR | ELEV. C

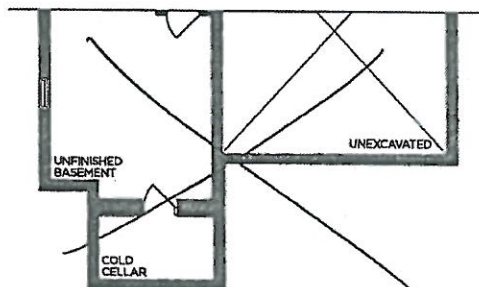

PART. BASEMENT | ELEV. B

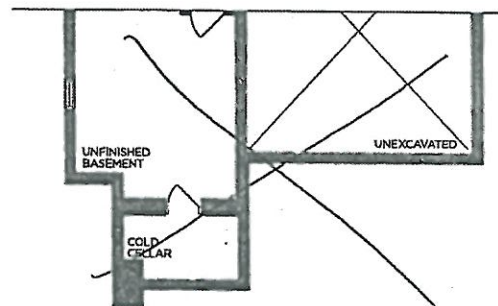


PART. BASEMENT | ELEV. C



VENDOR   
PURCHASER   
PURCHASER

**GOLDPARK**  
WORTH MORE™

Prices, figures, illustrations, sizes, features and finishes are subject to change without notice. Areas and dimensions are approximate and actual usable floor space may vary from the stated area. Layout may be reverse of the unit purchased. E. & O.E. 4203

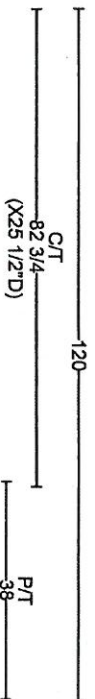

P/T  
38  
(X19\"/>




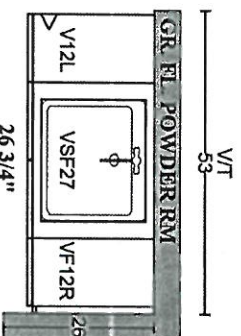
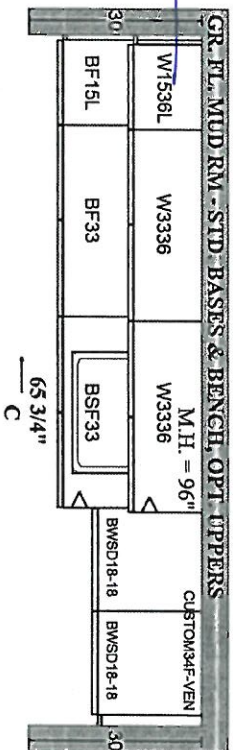


PV-27  
April 21, 2021

Handwritten initials and signature in red circles.

GOLDPARK HOMES  
PINE VALLEY  
VAUGHAN, ONTARIO  
MODEL: (4203) FORESTCREST

SITE STANDARD: WHITE 3/4" EXTENSION  
SOFT-CLOSE DRAWERS & STANDARD SLAM DOOR HINGES  
TO VANITIES  
  
ONE TOP DRAWER WHERE POSSIBLE THROUGHOUT EACH  
VANITY, ONE BANK OF DRAWERS WHERE POSSIBLE  
THROUGHOUT EACH MASTER ENSUITE VANITY

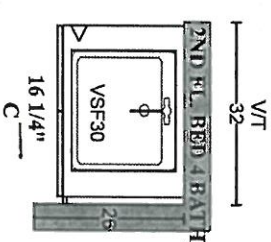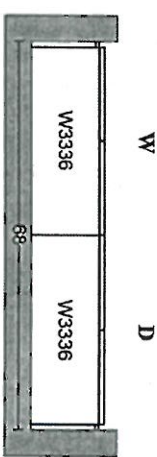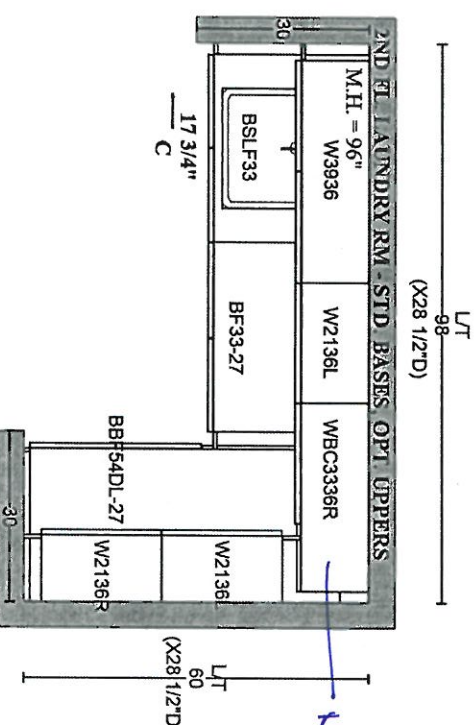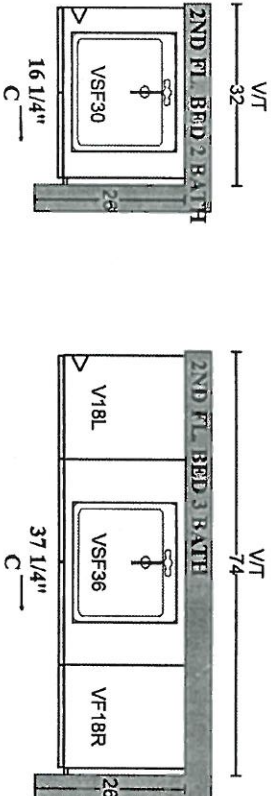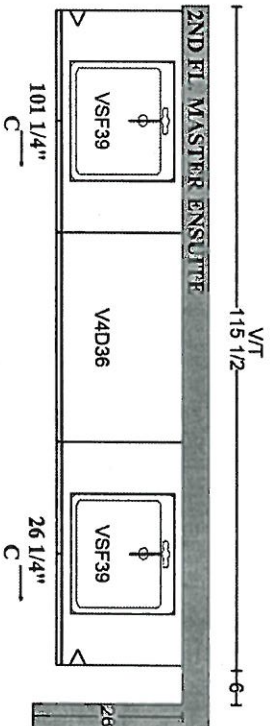




PINE VALLEY  
FOREVERGREEN

## UPGRADE SHOWER HARDWARE

MT6X6

Shower Door Handle

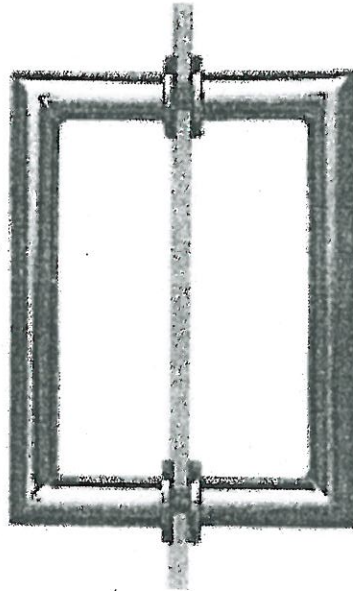

MT6X6  
Shower Door Handle

6" x 6" back-to-back  
3/4" dia. tube  
Cut and mitred corners with  
washers  
(Also available single sided)

- ☒ CHROME  
☐ MATTE BLACK  
☐ BRUSHED GOLD

|                                                                                                |                               |                                         |
|------------------------------------------------------------------------------------------------|-------------------------------|-----------------------------------------|
| Lot#<br><b>27</b>                                                                              | Date:<br><b>APRIL 21 2021</b> | Room:<br><b>MASTER / ENS 3 / 4 / 5.</b> |
| Signature:  |                               |                                         |
| Signature:  |                               |                                         |



PINE VALLEY  
FOREVERGREEN

STONE COUNTERTOP EDGE PROFILES



STANDARD 2CM EASED EDGE

LOCATION:

TRU OUT




UPGRADE 3CM EASED EDGE


LOCATION:



UPGRADE 4CM MITRED EDGE

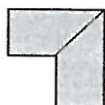

LOCATION:

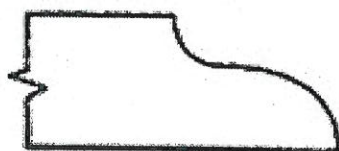

UPGRADE 2CM OGEE EDGE

LOCATION:

LOT #:

27

DATE:

April 21, 2021

SIGNATURE:

SIGNATURE:

STANDARD HARDWARE / HANDLES



☐ H001-02



☐ H001-03



☐ H001-04



☐ H009-03



☐ H009-09




☐ H011-03



☐ H011-05



☐ H011-06

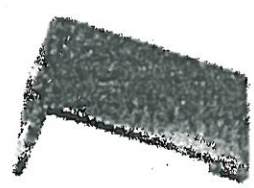

☐ H033-01



☒ H039-03  
*THRU OUT*

☐ \*NO HARDWARE

LOT # *27*

DATE: *April 21, 2021*

SIGNATURE: *[Signature]*

SIGNATURE: *[Signature]*



Project:

Lot:

Purchaser(s): Narinder and Gurnel Dula

Standard Hood Fan Deletion

We acknowledge that the builder's standard hood fan will not be installed.  
Do not supply, install and/or credit. We will install our own hood fan after closing.

Signature: 

Signature: 

Date: April 21, 2021