



CONSTRUCTION SUMMARY

Lot: 17
Model: 40.02 B VALLEYVIEW
Project/Phase: Pine Valley Forevergreen / 1

CROWN MOULDING

Invoice	Qty.	Description
2735 72,396 26May21	1	GREAT ROOM: MODEL OPTIONS 40.02 - GREAT ROOM - OPT. WAFFLE CEILING, BEAM DETAIL AS PER PLAN (6 BOXES) OPTION # 2 - CTR-B59/B60

DRYWALL

Invoice	Qty.	Description
2735 72,403 26May21	1	MASTER BEDROOM: MODEL OPTIONS 40.02.B - MASTER BEDROOM - OPT. 10 FOOT TRAY CEILING AS PER PLAN
2735 72,385 26May21	1	GREAT ROOM: MODEL OPTIONS 40.02 - GREAT ROOM - OPT. COFFERED CEILING - AS PER PLAN

ELECTRICAL

Invoice	Qty.	Description
2735 72,273 26May21	1	KITCHEN: 110V WALL RECEPTACLE ON SEPARATE CIRCUIT - GAS FIRED APPLIANCE - FOR AUX. EQUIPMENT - NOT A STOVE PLUG INCLUDED IN APS
2735 72,289 26May21	6	GREAT ROOM: 4" E/S LED INTERIOR POT LIGHT - GROUND FLOOR - EACH - INCLUDES ONE SWITCH INCLUDED IN APS
2735 72,281 26May21	1	GREAT ROOM: INTERIOR WALL OUTLET: ADDITIONAL 110V WALL INTERIOR RECEPTACLE ON EXISTING CIRCUIT FOR WALL MOUNTED TV - APPROX. 64" A.F.F. - SEE PLAN FOR LOCATION
2735 72,272 26May21	1	KITCHEN: 110V WALL RECEPTACLE ON SEPARATE CIRCUIT - FOR MICROWAVE - MICROWAVE NOT INCLUDED - SEE PLAN FOR LOCATION
2735 72,307 26May21	1	UPPER HALL: FIXTURE: RELOCATE STANDARD CEILING MOUNT FIXTURE - APPROX. CENTRE ON CEILING AT OTB
2735 72,281 26May21	1	MASTER BEDROOM: INTERIOR WALL OUTLET: ADDITIONAL 110V WALL INTERIOR RECEPTACLE ON EXISTING CIRCUIT FOR WALL MOUNTED TV - APPROX. 60" A.F.F. - SEE PLAN
2735 72,307 26May21	1	KITCHEN: FIXTURE: RELOCATE STANDARD CEILING MOUNT FIXTURE - APPROX. CENTRE ON CEILING ABOVE KITCHEN ISLAND - SEE PLAN
2735 72,280 26May21	2	KITCHEN: CEILING OUTLET: INSTALL ADDITIONAL CAPPED CEILING MOUNT FIXTURE ON EXISTING SWITCH - APPROX. CENTRE ON CEILING ABOVE KITCHEN ISLAND - SEE PLAN
2735 26May21 NoCat	1	PINE VALLEY MODEL 40.02 VALLEYVIEW ELEV B - 9 FOOT BASEMENT CEILING HEIGHT IN LIEU OF STANDARD 8 FOOT CEILING



CONSTRUCTION SUMMARY

Lot: 17
Model: 40.02 B VALLEYVIEW
Project/Phase: Pine Valley Forevergreen / 1

FORMING

Invoice	Qty.	Description
2735 72,194 26May21	1	PINE VALLEY MODEL 40.02 VALLEYVIEW ELEV B - 9 FOOT BASEMENT CEILING HEIGHT IN LIEU OF STANDARD 8 FOOT CEILING INCLUDED IN APS

FRAMING

Invoice	Qty.	Description
2735 26May21 NoCat	1	MASTER BEDROOM: MODEL OPTIONS 40.02.B - MASTER BEDROOM - OPT. 10 FOOT TRAY CEILING AS PER PLAN
2735 26May21 NoCat	1	GREAT ROOM: MODEL OPTIONS 40.02 - GREAT ROOM - OPT. COFFERED CEILING - AS PER PLAN

HVAC

Invoice	Qty.	Description
2735 72,224 26May21	1	KITCHEN: GAS LINE ROUGH-IN - MAIN FLOOR FOR APPLIANCE - SEE PLAN FOR APPROX. LOCATION. FINAL LOCATION, ORIENTATION, AND CONNECTION IS TO BE COMPLETED BY A LICENSED GAS FITTER AND ARRANGED BY THE HOME OWNER AFTER CLOSING INCLUDED IN APS
2735 26May21 NoCat	1	PINE VALLEY MODEL 40.02 VALLEYVIEW ELEV B - 9 FOOT BASEMENT CEILING HEIGHT IN LIEU OF STANDARD 8 FOOT CEILING

PAINT

Invoice	Qty.	Description
2735 26May21 NoCat	1	MASTER BEDROOM: MODEL OPTIONS 40.02.B - MASTER BEDROOM - OPT. 10 FOOT TRAY CEILING AS PER PLAN
2735 26May21 NoCat	1	GREAT ROOM: MODEL OPTIONS 40.02 - GREAT ROOM - OPT. WAFFLE CEILING, BEAM DETAIL AS PER PLAN (6 BOXES) OPTION # 2 - CTR-B59/B60
2735 26May21 NoCat	1	GREAT ROOM: MODEL OPTIONS 40.02 - GREAT ROOM - OPT. COFFERED CEILING - AS PER PLAN

PLUMBING

Invoice	Qty.	Description
2735 72,332 26May21	1	KITCHEN: ROUGH-IN 1/4" COLD WATER LINE TO FRIDGE INCLUDED IN APS
2735 26May21 NoCat	1	PINE VALLEY MODEL 40.02 VALLEYVIEW ELEV B - 9 FOOT BASEMENT CEILING HEIGHT IN LIEU OF STANDARD 8 FOOT CEILING



CONSTRUCTION SUMMARY

Lot: 17

Model: 40.02 B VALLEYVIEW

Project/Phase: Pine Valley Forevergreen / 1

WINDOWS AND DOORS

Invoice	Qty.	Description
2735	1	PINE VALLEY MODEL 40.02 VALLEYVIEW ELEV B - 9 FOOT BASEMENT CEILING HEIGHT IN LIEU OF STANDARD 8 FOOT CEILING
26May21 NoCat		




SCHEDULE 'F'

PV-17 ~~attach~~
May 20, 2021

The Valleyview

40' SERIES

Elevation A • 3,145 sq.ft.
Elevation B • 3,170 sq.ft.

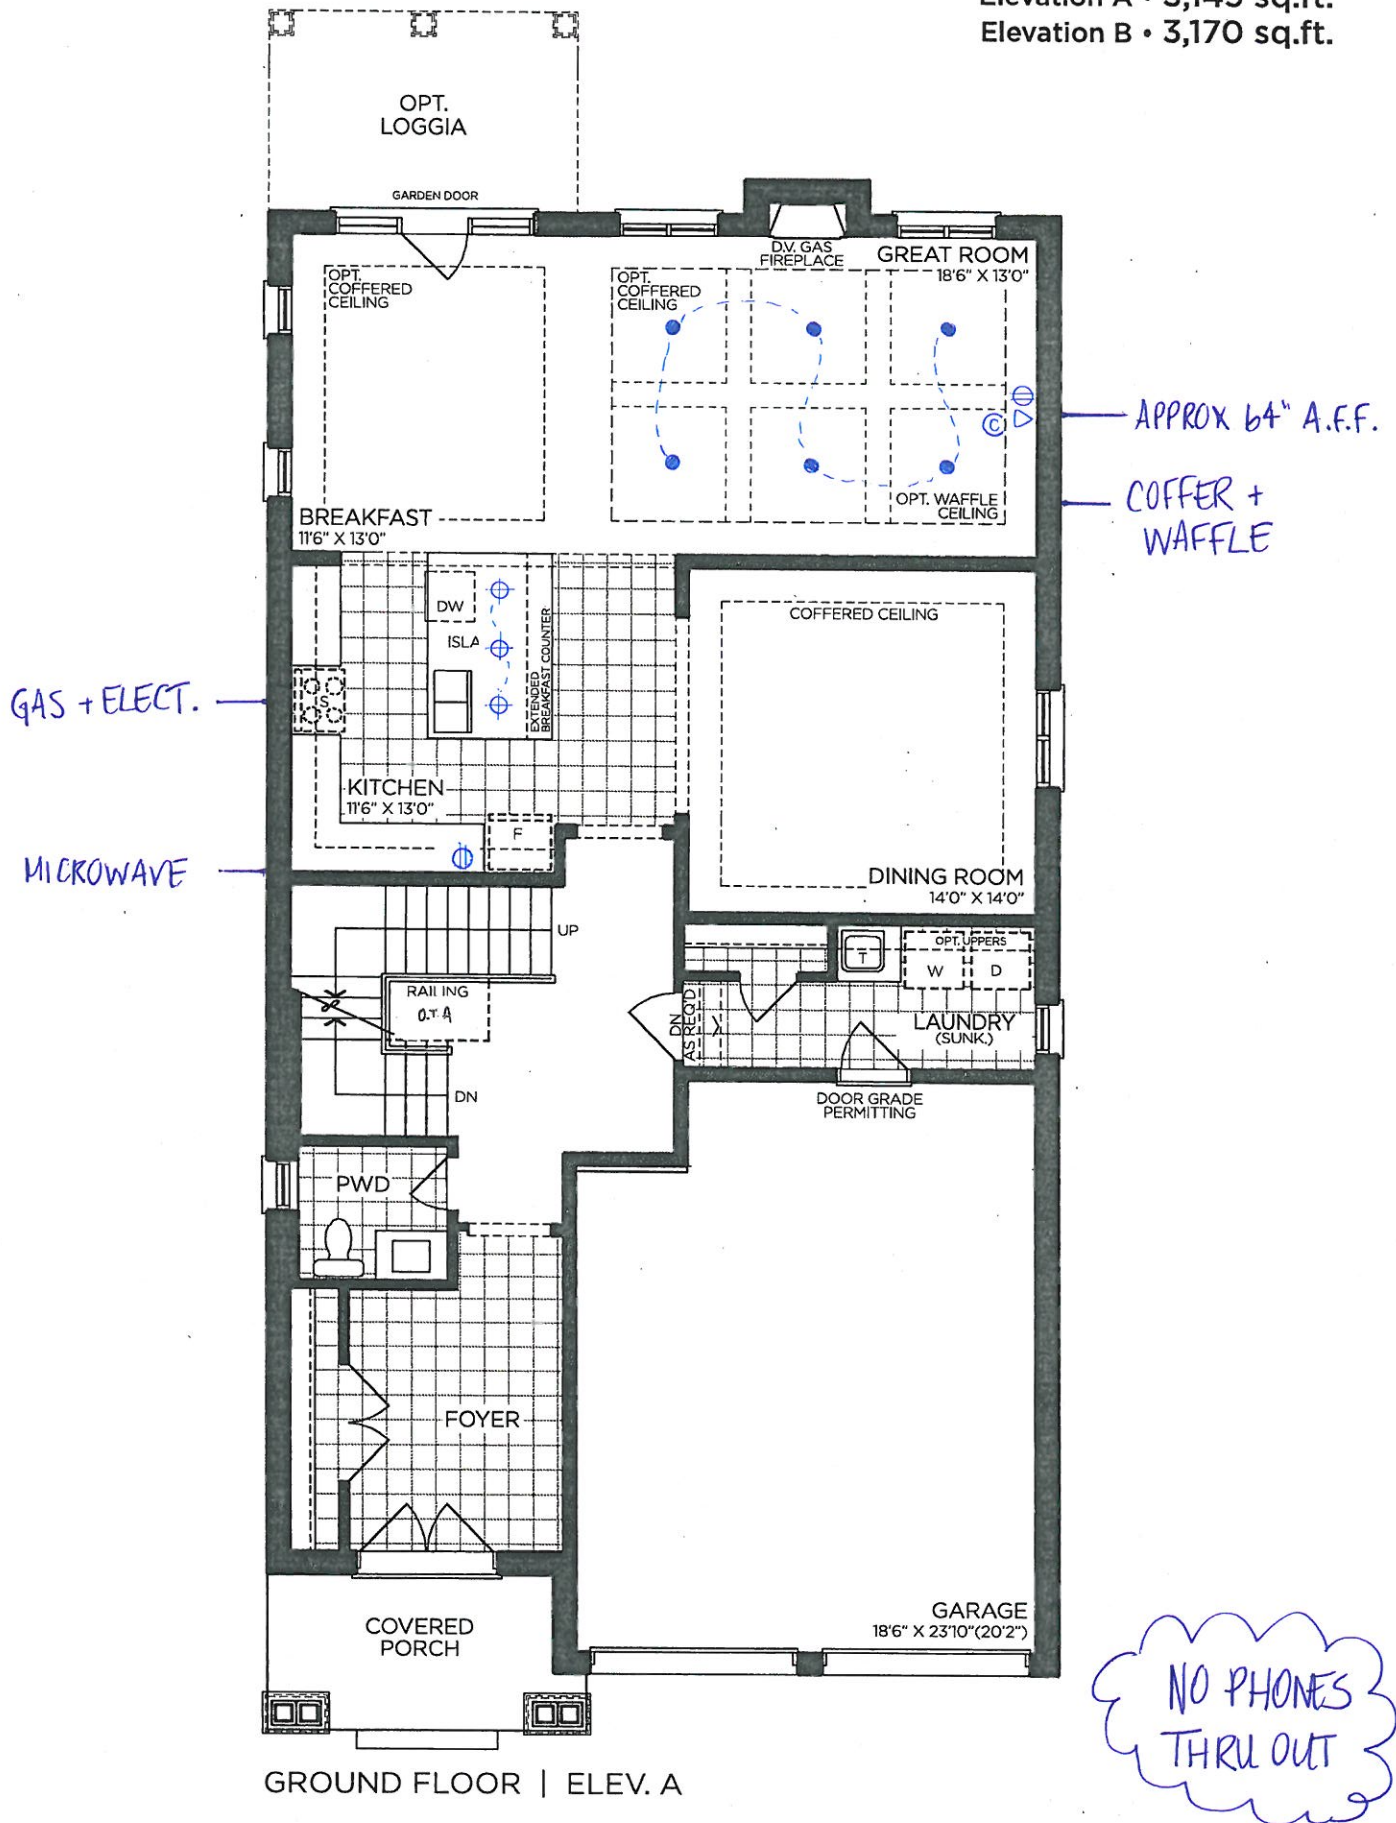

VENDOR

PURCHASER

PURCHASER

GOLDPARK
WORTH MORE™

Prices, figures, illustrations, sizes, features and finishes are subject to change without notice. Areas and dimensions are approximate and actual usable floor space may vary from the stated area. Layout may be reverse of the unit purchased. E. & O.E. 4002




SCHEDULE 'F'

PV-17 ~~attach~~
May 20, 2021

The Valleyview

40' SERIES

Elevation A • 3,145 sq.ft.
Elevation B • 3,170 sq.ft.

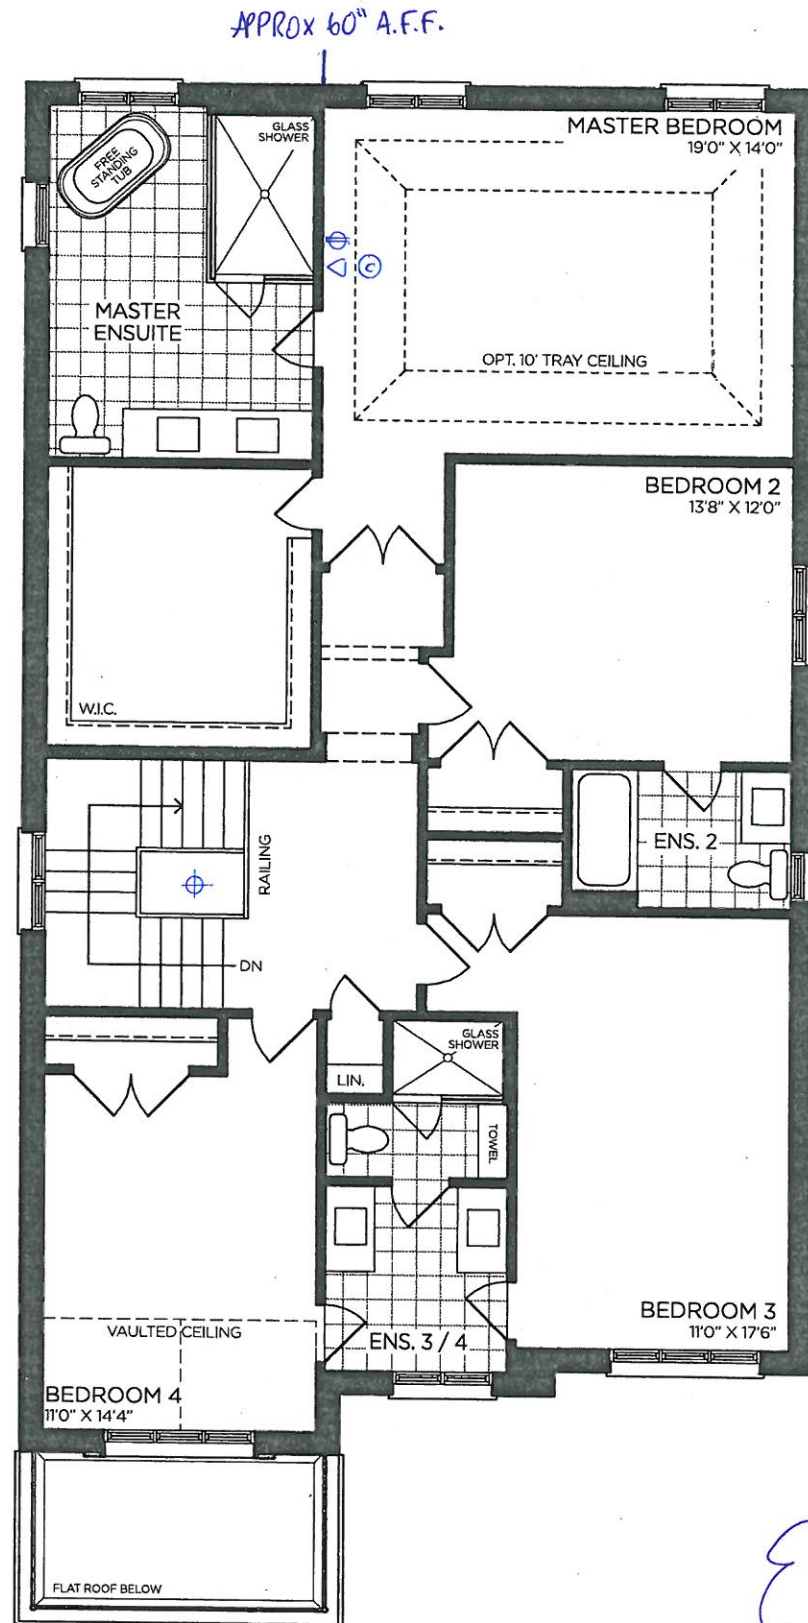

SECOND FLOOR | ELEV. A

NO PHONES
THRU OUT

VENDOR

PURCHASER

PURCHASER

GOLDPARK
WORTH MORE™

Prices, figures, illustrations, sizes, features and finishes are subject to change without notice. Areas and dimensions are approximate and actual usable floor space may vary from the stated area. Layout may be reverse of the unit purchased. E. & O.E. 4002






SCHEDULE 'F'

PV-17 ~~attach~~
May 20, 2021


The Valleyview

40' SERIES


Elevation A • 3,145 sq.ft.
Elevation B • 3,170 sq.ft.

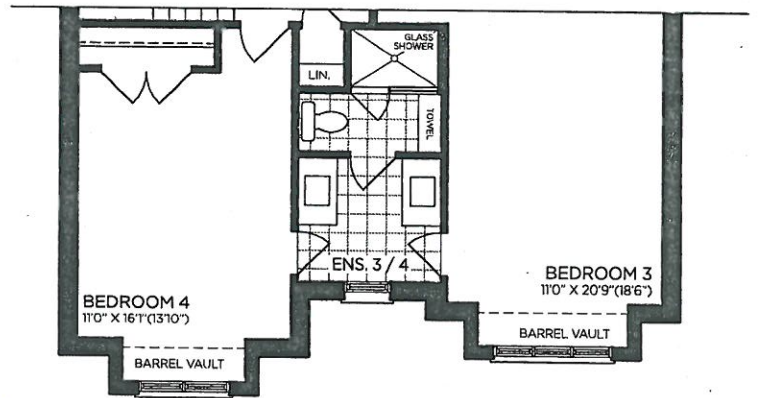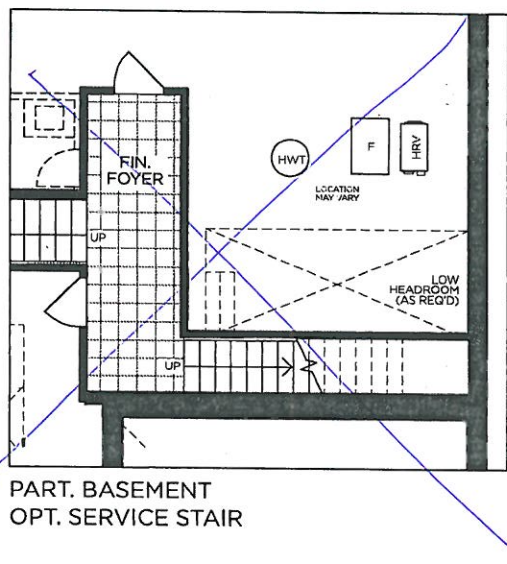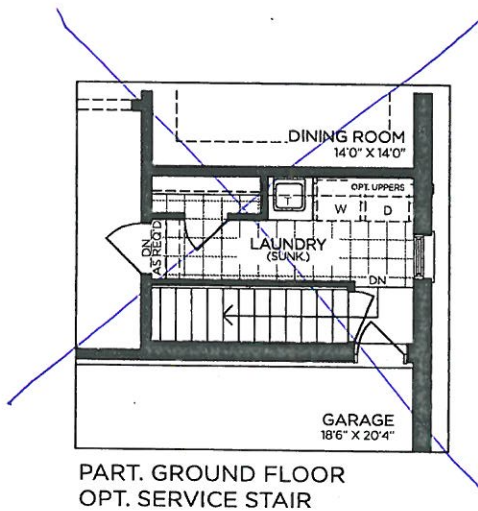

→ PART. SECOND FLOOR | ELEV. B

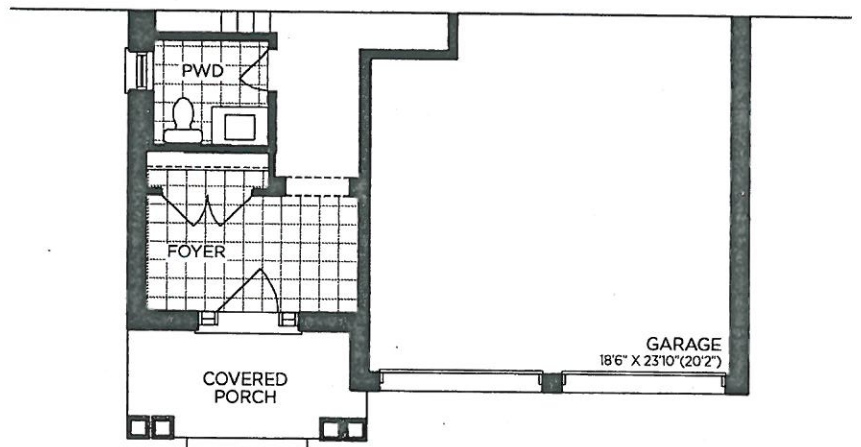

→ PART. GROUND FLOOR | ELEV. B

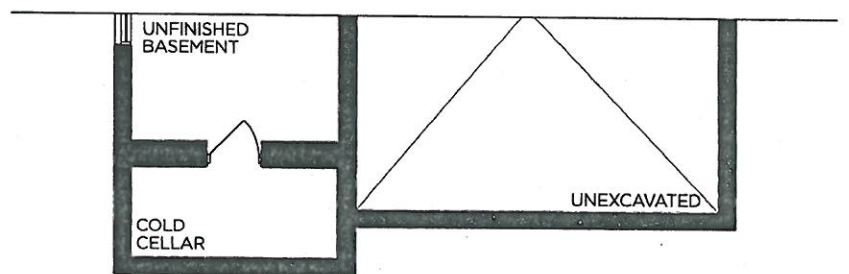

→ PART. BASEMENT | ELEV. B

VENDOR
PURCHASER
PURCHASER

GOLDPARK
WORTH MORE™

Prices, figures, illustrations, sizes, features and finishes are subject to change without notice. Areas and dimensions are approximate and actual usable floor space may vary from the stated area. Layout may be reverse of the unit purchased. E. & O.E. 4002



SCHEDULE 'F'


PV-17 *Catback*
May 20, 2021

The Valleyview

40' SERIES

Elevation A • 3,145 sq.ft.
Elevation B • 3,170 sq.ft.

9' BASEMENT

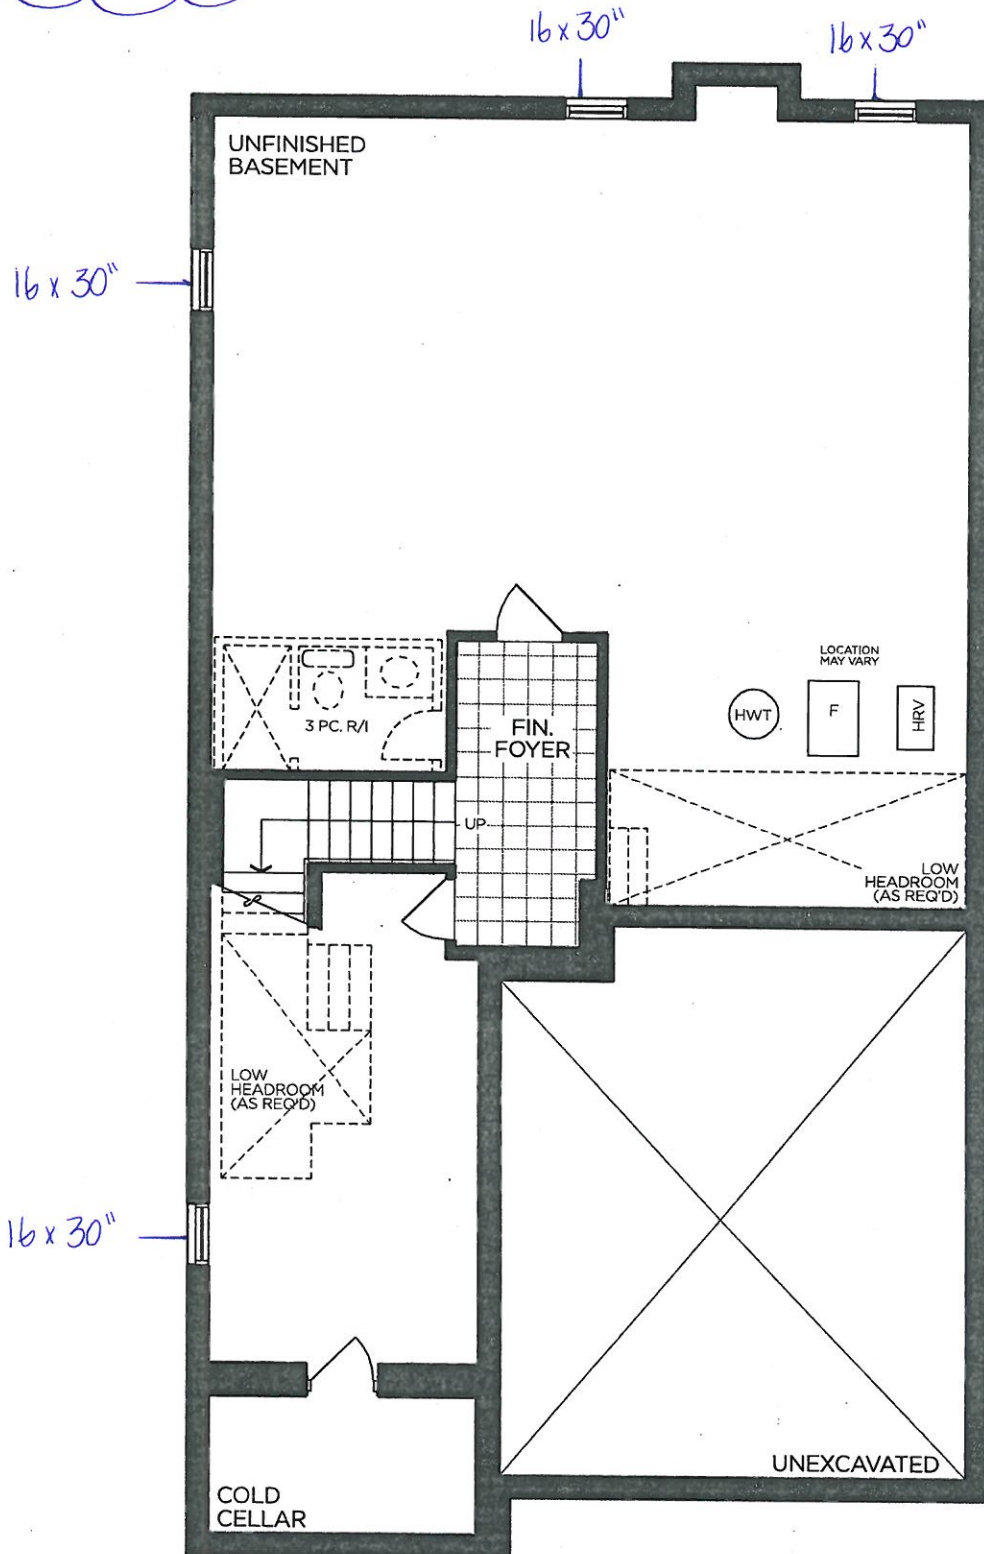

BASEMENT | ELEV. A

VENDOR

PURCHASER

PURCHASER

GOLDPARK
WORTH MORE™

Prices, figures, illustrations, sizes, features and finishes are subject to change without notice. Areas and dimensions are approximate and actual usable floor space may vary from the stated area. Layout may be reverse of the unit purchased. E. & O.E. 4002




PV-17
May 20, 2021
SCHEDULE 'F'

The Valleyview

40' SERIES

Elevation A • 3,145 sq.ft.
Elevation B • 3,170 sq.ft.

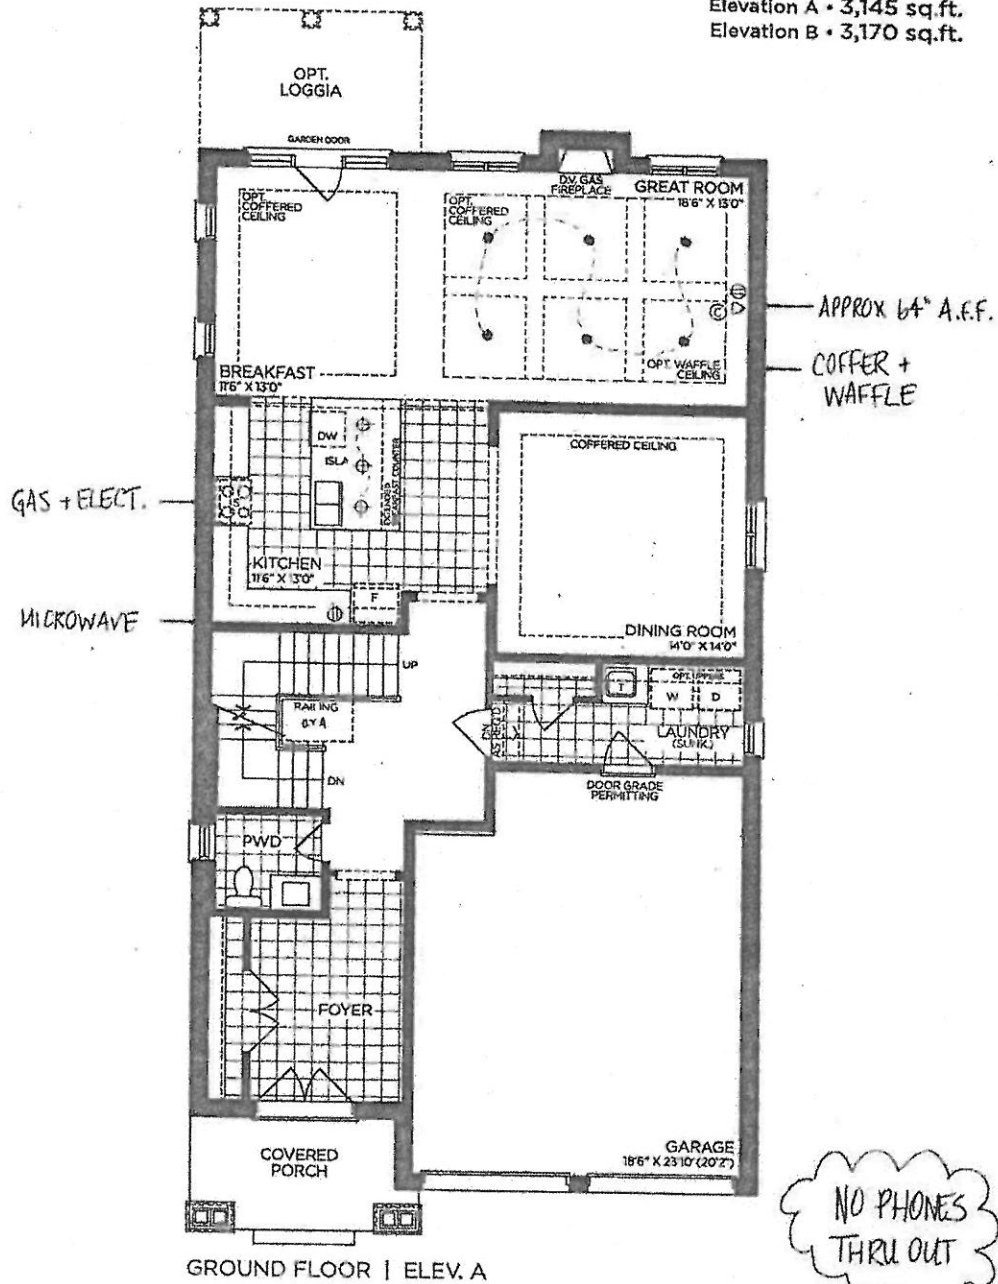

VENDOR

PURCHASER

PURCHASER


GOLDPARK
WORTH MORE

Prices, figures, illustrations, sizes, features and finishes are subject to change without notice. Areas and dimensions are approximate and actual usable floor space may vary from the stated area. Layout may be reverse of the unit purchased. E & O.E. 4002



SCHEDULE 'F'
PV-17
May 20, 2021

The
Valleyview
40' SERIES
Elevation A • 3,145 sq.ft.
Elevation B • 3,170 sq.ft.

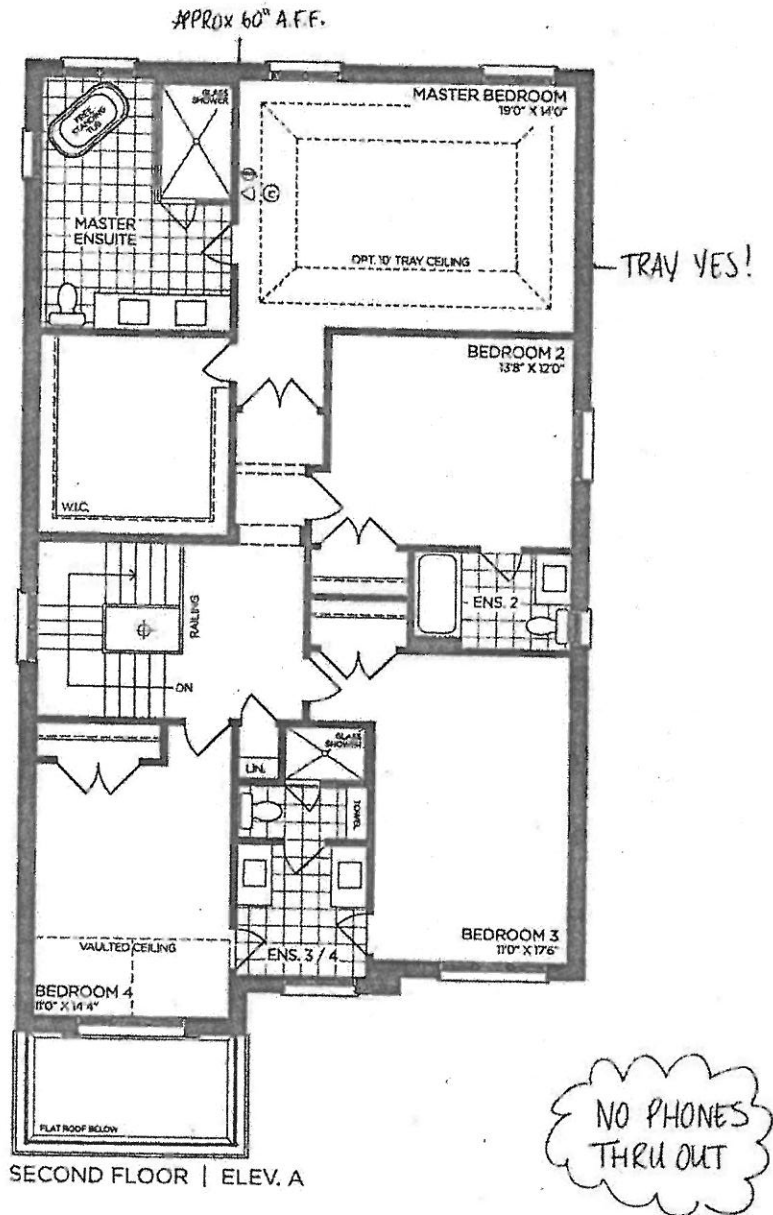

VENDOR

PURCHASER

PURCHASER






GOLDPARK
WORTH MORE™

Prices, figures, illustrations, sizes, features and finishes are subject to change without notice. Areas and dimensions are approximate and actual usable floor space may vary from the stated area. Layout may be reverse of the unit purchased. E. & O.E. 4002



SCHEDULE 'F'
PV-17
May 20, 2021

The
Valleyview
40' SERIES
Elevation A • 3,145 sq.ft.
Elevation B • 3,170 sq.ft.

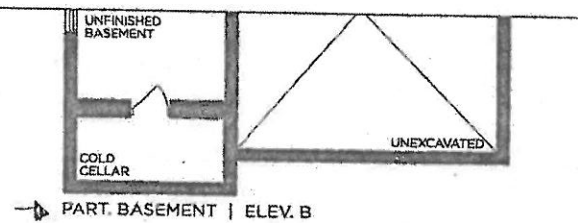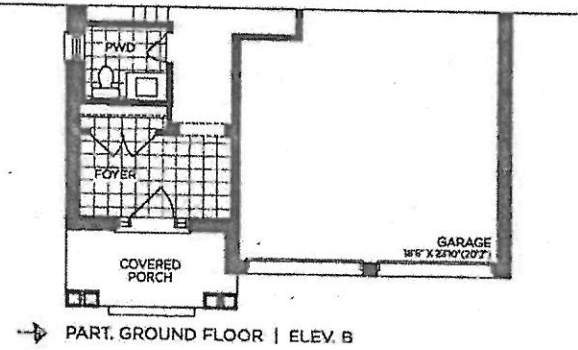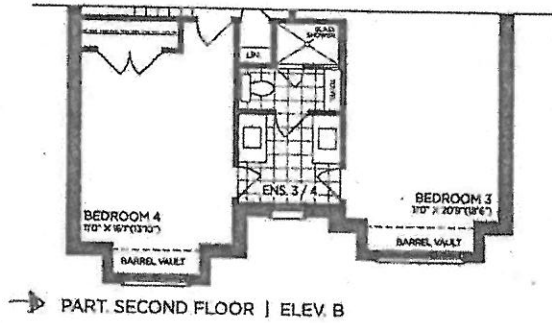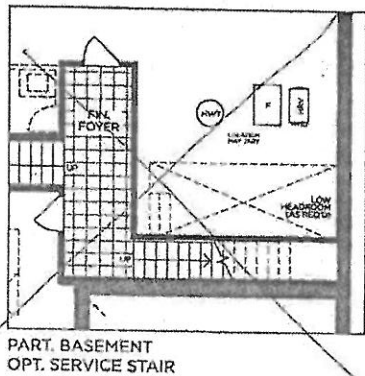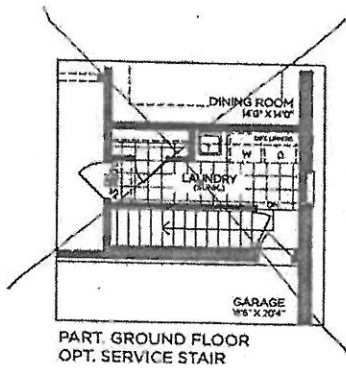

VENDOR
PURCHASER
PURCHASER

GOLDPARK
WORTH MORE


Prices, figures, illustrations, sizes, features and finishes are subject to change without notice. Areas and dimensions are approximate and actual usable floor space may vary from the stated area. Layout may be reverse of the unit purchased. E & O.E. 4002



9' BASEMENT

SCHEDULE 'F'
PV-17
May 20, 2021

The
Valleyview
40' SERIES
Elevation A • 3,145 sq.ft.
Elevation B • 3,170 sq.ft.

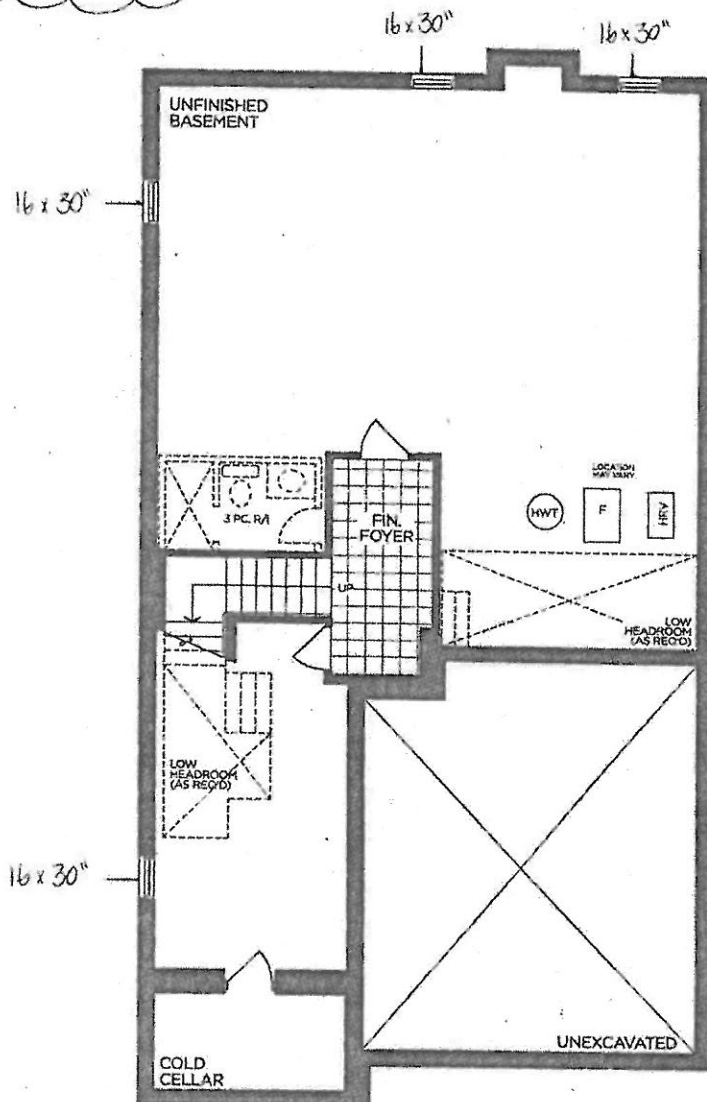

BASEMENT | ELEV. A

VENDOR

PURCHASER

PURCHASER

GOLDPARK
WORTH MORE™

Prices, figures, illustrations, sizes, features and finishes are subject to change without notice. Areas and dimensions are approximate and actual usable floor space may vary from the stated area. Layout may be reverse of the unit purchased. E & O.E. 4002