



CONSTRUCTION SUMMARY

Lot: 15
Model: 40.06 A LILAC
Project/Phase: Pine Valley Forevergreen / 1

CERAMIC

Invoice	Qty.	Description
2319 41 12Jan21	1	FOYER: TILE, FLOOR , LEVEL 9 - FRONT FOYER - 30X60" POLISHED - SEE PLAN FOR TILE DIRECTION
2319 41 12Jan21	1	POWDER ROOM: TILE, FLOOR , LEVEL 9 - POWDER ROOM - 30X60" POLISHED - SEE PLAN FOR TILE DIRECTION
2319 41 12Jan21	1	MUD ROOM: TILE, FLOOR , LEVEL 9 - MUD ROOM -30X60" POLISHED - SEE PLAN FOR TILE DIRECTION
2319 41 12Jan21	1	BASEMENT FOYER: TILE, FLOOR , LEVEL 9 - BSMT FOYER - 30X60" POLISHED - SEE PLAN FOR TILE DIRECTION
2319 37 12Jan21	1	MASTER ENSUITE: TILE, FLOOR , LEVEL 5 - MASTER ENSUITE - 12X24" POLISHED - SEE PLAN FOR TILE DIRECTION
2319 51 12Jan21	1	MASTER ENSUITE: TILE, WALL, LEVEL 5 - MASTER ENSUITE - 12X24" POLISHED - HORIZONTAL STACKED PATTERN
2319 43 12Jan21	1	MASTER ENSUITE: TILE, SHOWER FLOOR, LEVEL 2 - 2" HEX
2318 12Jan21 NoCat	1	ENSUITE 2: UPGRADE FROM TUB TO STANDING SHOWER, COMPLETE WITH TILE BASE, POTLIGHT IN CEILING AND FRAMELESS GLASS SHOWER ENCLOSURE.
2318 12Jan21 NoCat	1	.MASTER BEDROOM: SHOWER BENCH COMPLETE WITH STANDARD TILE AND MATCHING MARBLE JAMB COLOUR SEAT TOP.
2362 06May21 NoCat	1	TILE RESELECTION - SEE ATTACHED UPDATED COLOUR CHART FOR "NEW" SELECTIONS.

CONCRETE AND DRAIN

Invoice	Qty.	Description
2284 24Jul20 NoCat	1	.BACK-FLOW PREVENTER VALVE



CONSTRUCTION SUMMARY

Lot: 15
Model: 40.06 A LILAC
Project/Phase: Pine Valley Forevergreen / 1

CROWN MOULDING

Invoice	Qty.	Description
2318 12Jan21 NoCat	1	.GREAT ROOM - OPT. COFFERED CEILING AS PER PLAN.
2318 12Jan21 NoCat	1	.MASTER BEDROOM - OPT. 10 FOOT TRAY CEILING AS PER PLAN.
2318 12Jan21 NoCat	1	.GREAT ROOM - OPT. WAFFLE CEILING, BEAM DETAIL AS PER PLAN (9 BOXES) OPTION # 1 CTR-B07.
2318 12Jan21 NoCat	1	.LIBRARY - OPT. LIBRARY COFFERED CEILING AS PER PLAN. LIBRARY - OPT.



CONSTRUCTION SUMMARY

Lot: 15
Model: 40.06 A LILAC
Project/Phase: Pine Valley Forevergreen / 1

DRYWALL

Invoice	Qty.	Description
2318 12Jan21 NoCat	1	.DELETE KITCHEN BULKHEAD, IF POSSIBLE, SITE APPROVAL REQUIRED.
2318 12Jan21 NoCat	1	.GREAT ROOM - OPT. COFFERED CEILING AS PER PLAN.
2318 12Jan21 NoCat	1	.MASTER BEDROOM - OPT. 10 FOOT TRAY CEILING AS PER PLAN.
2318 12Jan21 NoCat	1	.GREAT ROOM - OPT. WAFFLE CEILING, BEAM DETAIL AS PER PLAN (9 BOXES) OPTION # 1 CTR-B07.
2318 12Jan21 NoCat	1	.LIBRARY - OPT. LIBRARY COFFERED CEILING AS PER PLAN. LIBRARY - OPT.
2318 12Jan21 NoCat	1	.MASTER BEDROOM - DRESSING ROOM: SUN TUNNEL EXTENSION, 6 FOOT RIGID TUNNEL EXTENSION [2TR 6 FOOT] - UP TO 6 FOOT MAX.
2318 12Jan21 NoCat	7	.MAIN FLOOR: UPGRADE DOORS TO 9' SOLID-CORE INTERIOR DOORS.
2318 12Jan21 NoCat	18	.2ND FLOOR: INCREASED HEIGHT OF 8' - & UPGRADE DOORS TO "SOLID- CORE" DOORS.
2318 72,385 12Jan21	0	MODEL OPTIONS 40.02 - GREAT ROOM - OPT. COFFERED CEILING - AS PER PLAN
2318 72,437 12Jan21	1	MODEL OPTIONS 40.06 - GREAT ROOM - OPT. WAFFLE CEILING, BEAM DETAIL AS PER PLAN (9 BOXES) OPTION # 1 CTR-B07
2318 72,637 12Jan21 **	1	SUN TUNNEL EXTENSION, 6 FOOT RIGID TUNNEL EXTENSION [2TR 6 FOOT] - UP TO 6 FOOT MAX.



CONSTRUCTION SUMMARY

Lot: 15
Model: 40.06 A LILAC
Project/Phase: Pine Valley Forevergreen / 1

ELECTRICAL

Invoice	Qty.	Description
2319 12Jan21 NoCat	1	KITCHEN: FULL HEIGHT BACK SPLASH - LEVEL 4 QUARTZ FYI - Full height quartz backsplash throughout kitchen
2318 72,248 12Jan21 **	1	APRILAIRE 600 WHOLE HOUSE STEAM HUMIDIFIER (UP TO 4,000 SQ.FT.) - COMPLETE WITH HI VOLTAGE WIRING, 240V DOUBLE BREAKER 20 AMP, SHUT OFF VALVE
2318 72,289 12Jan21	6	GREAT ROOM: 4" E/S LED INTERIOR POT LIGHT - GROUND FLOOR - EACH - INCLUDES 1 SWITCH .
2318 12Jan21 NoCat	1	.GREAT ROOM: INTERIOR WALL OUTLET: ADDITIONAL 110V WALL INTERIOR RECEPTACLE ON EXISTING CIRCUIT FOR WALL MOUNTED TV - LOCATE APPROX. 66" A.F.F. ABOVE FIREPLACE.
2318 12Jan21 NoCat	1	.GREAT ROOM: FIREPLACE - ADD HEAT ACTIVATED FAN.
2318 12Jan21 NoCat	1	ENSUITE 2: UPGRADE FROM TUB TO STANDING SHOWER, COMPLETE WITH TILE BASE, POTLIGHT IN CEILING AND FRAMELESS GLASS SHOWER ENCLOSURE.
2318 72,637 12Jan21 **	1	SUN TUNNEL EXTENSION, 6 FOOT RIGID TUNNEL EXTENSION [2TR 6 FOOT] - UP TO 6 FOOT MAX.

EXTERIOR COLOURS

Invoice	Qty.	Description
2318 12Jan21 NoCat	1	EXTERIOR COLOUR PACKAGE # BR.1



CONSTRUCTION SUMMARY

Lot: 15
Model: 40.06 A LILAC
Project/Phase: Pine Valley Forevergreen / 1

FORMING

Invoice	Qty.	Description
2284 24Jul20 NoCat	1	.BASEMENT WINDOWS - UPGRADE BASEMENT WINDOW SIZE TO 30 " X 24" - 8" FRAME
2284 24Jul20 NoCat	1	PINE VALLEY MODEL 40.06 LILAC ELEV A - 9 FOOT BASEMENT CEILING HEIGHT IN LIEU OF STANDARD 8 FOOT CEILING.
2284 24Jul20 NoCat	1	DELETE - EGRESS BASEMENT WINDOW 47 " X 35" - 8" FRAME
2318 12Jan21 NoCat	1	.BASEMENT WINDOWS - UPGRADE BASEMENT WINDOW SIZE TO 30 " X 24" - 8" FRAME.
2318 12Jan21 NoCat	1	.MASTER BEDROOM - DRESSING ROOM: SUN TUNNEL EXTENSION, 6 FOOT RIGID TUNNEL EXTENSION [2TR 6 FOOT] - UP TO 6 FOOT MAX.



CONSTRUCTION SUMMARY

Lot: 15
Model: 40.06 A LILAC
Project/Phase: Pine Valley Forevergreen / 1

FRAMING

Invoice	Qty.	Description
2284 24Jul20 NoCat	1	.PINE VALLEY MODEL 40.06 LILAC ELEV A - 9 FOOT BASEMENT CEILING HEIGHT IN LIEU OF STANDARD 8 FOOT CEILING.
2318 72,644 12Jan21	18	.2ND FLOOR: INCREASED HEIGHT OF 8' - & UPGRADE DOORS TO "SOLID- CORE" DOORS.
2318 72,690 12Jan21	1	DELETE KITCHEN BULKHEAD, IF POSSIBLE, SITE APPROVAL REQUIRED.
2318 12Jan21 NoCat	1	.GREAT ROOM - OPT. COFFERED CEILING AS PER PLAN.
2318 72,439 12Jan21	1	.MASTER BEDROOM - OPT. 10 FOOT TRAY CEILING AS PER PLAN.
2318 12Jan21 NoCat	1	.GREAT ROOM - OPT. WAFFLE CEILING, BEAM DETAIL AS PER PLAN (9 BOXES) OPTION # 1 CTR-B07.
2318 12Jan21 NoCat	1	.LIBRARY - OPT. LIBRARY COFFERED CEILING AS PER PLAN. LIBRARY - OPT.
2318 12Jan21 NoCat	1	.MASTER BEDROOM - DRESSING ROOM: SUN TUNNEL EXTENSION, 6 FOOT RIGID TUNNEL EXTENSION [2TR 6 FOOT] - UP TO 6 FOOT MAX.
2318 12Jan21 NoCat	7	.MAIN FLOOR: UPGRADE DOORS TO 9' SOLID-CORE INTERIOR DOORS.
2318 12Jan21 NoCat	1	.MASTER BEDROOM: SHOWER BENCH COMPLETE WITH STANDARD TILE AND MATCHING MARBLE JAMB COLOUR SEAT TOP.
2318 12Jan21 NoCat	1	ENSUITE 2: UPGRADE FROM TUB TO STANDING SHOWER, COMPLETE WITH TILE BASE, POTLIGHT IN CEILING AND FRAMELESS GLASS SHOWER ENCLOSURE.
2318 72,637 12Jan21	1	SUN TUNNEL EXTENSION, 6 FOOT RIGID TUNNEL EXTENSION [2TR 6 FOOT] - UP TO 6 FOOT MAX.



CONSTRUCTION SUMMARY

Lot: 15
Model: 40.06 A LILAC
Project/Phase: Pine Valley Forevergreen / 1

GARAGE DOORS

Invoice	Qty.	Description
2318 12Jan21 NoCat	2	.GARAGE DOOR OPENER (CHAMBERLAIN BELT DRIVE) - WITH 1 REMOTE - PRICE IS PER DOOR.
2318 12Jan21 NoCat	1	GARAGE: WIRELESS KEYPAD GARAGE DOOR ENTRY 877LM.

GLASS AND MIRROR

Invoice	Qty.	Description
2319 12Jan21 NoCat	1	MASTER ENSUITE: UPGRADE SHOWER DOOR HARDWARE TO LP6X6 CHROME
2319 12Jan21 NoCat	2	ENSUITE 2 + SHARED ENSUITE 3/4: UPGRADE SHOWER DOOR HARDWARE TO MT6X6 CHROME
2318 12Jan21 NoCat	1	ENSUITE 2: UPGRADE FROM TUB TO STANDING SHOWER, COMPLETE WITH TILE BASE, POTLIGHT IN CEILING AND FRAMELESS GLASS SHOWER ENCLOSURE.

GRANITE MARBLE QUARTZ

Invoice	Qty.	Description
2319 12Jan21 NoCat	1	KITCHEN: UPGRADE 4 QUARTZ COUNTER TOP
2319 12Jan21 NoCat	1	KITCHEN: FULL HEIGHT BACK SPLASH - LEVEL 4 QUARTZ
2319 12Jan21 NoCat	1	POWDER ROOM: UPGRADE 4 QUARTZ COUNTER TOP
2319 12Jan21 NoCat	1	MASTER ENSUITE: UPGRADE 6 QUARTZ COUNTER TOP
2776 26May21 NoCat	1	KITCHEN: COUNTER TOP RE-SELECTION REFERENCE ATTACHED UPDATED COLOUR CHART FOR C.TOP RE-SELECT



CONSTRUCTION SUMMARY

Lot: 15
Model: 40.06 A LILAC
Project/Phase: Pine Valley Forevergreen / 1

HARDWOOD

Invoice	Qty.	Description
2319 4 12Jan21	1	THRU OUT- ALL STANDARD AREAS:MAIN HALL/ GREAT ROOM/ LIBRARY/ DINING ROOM/ UPPER HALL/ MASTER BEDROOM/ BEDROOM 2/ BEDROOM 3/ BEDROOM 4: LEVEL 3 - VINTAGE SERIES, 5" WHITE OAK, NSS ENGINEERED HARDWOOD, 3/4" THK, WIREBRUSH TEXTURE, UV OIL FINISH - CORNER
2319 4 12Jan21	1	KITCHEN/BREAKFAST: VINTAGE SERIES, 5" WHITE OAK, NSS ENGINEERED HARDWOOD, 3/4" THK, WIREBRUSH TEXTURE, UV OIL FINISH - CORNER, KITCHEN/ BREAKFAST - LEVEL 3

HVAC

Invoice	Qty.	Description
2318 72,321 12Jan21	1	.GREAT ROOM: FIREPLACE - ADD HEAT ACTIVATED FAN.
2318 72,241 12Jan21	1	4.0 TON AC - WITH LOW VOLTAGE WIRING & WALL BRACKETS (13ACX)
2318 72,248 12Jan21	1	APRILAIRE 600 WHOLE HOUSE STEAM HUMIDIFIER (UP TO 4,000 SQ.FT.) - COMPLETE WITH HI VOLTAGE WIRING, 240V DOUBLE BREAKER 20 AMP, SHUT OFF VALVE
2318 12Jan21 NoCat	1	.DELETE KITCHEN BULKHEAD, IF POSSIBLE, SITE APPROVAL REQUIRED.
2318 72,637 12Jan21 **	1	SUN TUNNEL EXTENSION, 6 FOOT RIGID TUNNEL EXTENSION [2TR 6 FOOT] - UP TO 6 FOOT MAX.



CONSTRUCTION SUMMARY

Lot: 15
Model: 40.06 A LILAC
Project/Phase: Pine Valley Forevergreen / 1

INTERIOR TRIM AND DOORS

Invoice	Qty.	Description
2319 153,798 12Jan21	1	HALIFAX LEVER, IRON BLACK INTERIOR DOOR HARDWARE UPGRADE
2319 155,876 12Jan21	1	ADD FOR HINGES 3X3 SQUARE FLAT TIP THROUGHOUT UPGRADE
2318 12Jan21 NoCat	18	.2ND FLOOR: INCREASED HEIGHT OF 8' - & UPGRADE DOORS TO "SOLID- CORE" DOORS.
2318 12Jan21 NoCat	1	.DELETE KITCHEN BULKHEAD, IF POSSIBLE, SITE APPROVAL REQUIRED.
2318 12Jan21 NoCat	1	.GREAT ROOM - OPT. COFFERED CEILING AS PER PLAN.
2318 12Jan21 NoCat	1	.MASTER BEDROOM - OPT. 10 FOOT TRAY CEILING AS PER PLAN.
2318 12Jan21 NoCat	1	ENSUITE 2: UPGRADE FROM TUB TO STANDING SHOWER, COMPLETE WITH TILE BASE, POTLIGHT IN CEILING AND FRAMELESS GLASS SHOWER ENCLOSURE.
2318 12Jan21 NoCat	1	.GREAT ROOM - OPT. WAFFLE CEILING, BEAM DETAIL AS PER PLAN (9 BOXES) OPTION # 1 CTR-B07.
2318 12Jan21 NoCat	1	.LIBRARY - OPT. LIBRARY COFFERED CEILING AS PER PLAN. LIBRARY - OPT.
2318 12Jan21 NoCat	1	.MASTER BEDROOM - DRESSING ROOM: SUN TUNNEL EXTENSION, 6 FOOT RIGID TUNNEL EXTENSION [2TR 6 FOOT] - UP TO 6 FOOT MAX.
2318 12Jan21 NoCat	7	.MAIN FLOOR: UPGRADE DOORS TO 9' SOLID-CORE INTERIOR DOORS.



CONSTRUCTION SUMMARY

Lot: 15
Model: 40.06 A LILAC
Project/Phase: Pine Valley Forevergreen / 1

KITCHEN AND BATH CABINETRY

Invoice	Qty.	Description
2319 12Jan21 NoCat	1	THRU OUT: SEE ATTACHED CABINETRY SCHEDULE
2319 12Jan21 NoCat	1	KITCHEN: FULL HEIGHT BACK SPLASH - LEVEL 4 QUARTZ FYI - Full height Quartz kitchen backsplash throughout

NETWORK AND WIRING

Invoice	Qty.	Description
2318 72,259 12Jan21	1	GREAT ROOM: CONDUIT PIPE - FOR WALL MOUNT TV - LOCATE APPROX. 66" A.F.F. ABOVE FIREPLACE, TERMINATING AT CABLE LOCATION.
2318 12Jan21 NoCat	1	**NOTE** THRU OUT: DO *NOT* INSTALL STANDARD TELEPHONE
2318 12Jan21 NoCat	2	.GREAT ROOM & MASTER BEDROOM: ADDITIONAL CAT6 ETHERNET OUTLET - EACH SEE PLAN FOR LOCATION.
2318 12Jan21 NoCat	1	.CONDUIT PIPE - FROM ATTIC TO BASEMENT - FROM APPROX CENTER OF ATTIC TO ELECTRICAL PANEL IN BASEMENT



CONSTRUCTION SUMMARY

Lot: 15
Model: 40.06 A LILAC
Project/Phase: Pine Valley Forevergreen / 1

PAINT

Invoice	Qty.	Description
2319 12Jan21 NoCat	2	MAIN STAIRS: STAIN STAIRS AND LANDINGS STAIRS AND LANDINGS WILL NOT MATCH HARDWOOD FLOORS IN COLOUR/TEXTURE/SPECIES
2318 12Jan21 NoCat	1	.GREAT ROOM - OPT. COFFERED CEILING AS PER PLAN.
2318 12Jan21 NoCat	1	.MASTER BEDROOM - OPT. 10 FOOT TRAY CEILING AS PER PLAN.
2318 12Jan21 NoCat	1	.GREAT ROOM - OPT. WAFFLE CEILING, BEAM DETAIL AS PER PLAN (9 BOXES) OPTION # 1 CTR-B07.
2318 12Jan21 NoCat	1	.LIBRARY - OPT. LIBRARY COFFERED CEILING AS PER PLAN. LIBRARY - OPT.
2318 12Jan21 NoCat	7	.MAIN FLOOR: UPGRADE DOORS TO 9’ SOLID-CORE INTERIOR DOORS.
2318 12Jan21 NoCat	18	.2ND FLOOR: INCREASED HEIGHT OF 8’ - & UPGRADE DOORS TO "SOLID- CORE" DOORS.
2318 72,637 12Jan21 **	1	SUN TUNNEL EXTENSION, 6 FOOT RIGID TUNNEL EXTENSION [2TR 6 FOOT] - UP TO 6 FOOT MAX.



CONSTRUCTION SUMMARY

Lot: 15
Model: 40.06 A LILAC
Project/Phase: Pine Valley Forevergreen / 1

PLUMBING

Invoice	Qty.	Description
2284 24Jul20 NoCat	1	.BACK-FLOW PREVENTER VALVE
2319 12Jan21 NoCat	1	MASTER ENSUITE: MOEN 'ARRIS' DECK MOUNTED TUB FILLER + HAND SHOWER - CHROME
2319 12Jan21 NoCat	2	MASTER ENSUITE: MOEN 'ARRIS' 8" cc LAV FAUCET - CHROME
2319 12Jan21 NoCat	1	KITCHEN: BLANCO QUATRUS R15 U SUPER SINGLE - STAINLESS BOTTOM GRID NOT INCLUDED
2318 72,248 12Jan21 **	1	APRILAIRE 600 WHOLE HOUSE STEAM HUMIDIFIER (UP TO 4,000 SQ.FT.) - COMPLETE WITH HI VOLTAGE WIRING, 240V DOUBLE BREAKER 20 AMP, SHUT OFF VALVE
2318 12Jan21 NoCat	1	ENSUITE 2: UPGRADE FROM TUB TO STANDING SHOWER, COMPLETE WITH TILE BASE, POTLIGHT IN CEILING AND FRAMELESS GLASS SHOWER ENCLOSURE.
2318 12Jan21 NoCat	1	.MASTER ENSUITE: UPGRADE TO MOEN 'ARRIS' POSI-TEMP 3-FUNCTION RAIN SHOWER (from ceiling) + HAND SHOWER WITH SLIDE BAR - CHROME #TS2200EP/3372/TS23005/62320/3887EP/A725.
2318 12Jan21 NoCat	1	.KITCHEN: ROUGH-IN 1/4" COLD WATER LINE TO FRIDGE.
2318 72,637 12Jan21 **	1	SUN TUNNEL EXTENSION, 6 FOOT RIGID TUNNEL EXTENSION [2TR 6 FOOT] - UP TO 6 FOOT MAX.
2318 12Jan21 NoCat	1	ENSUITE 2: UPGRADE FROM TUB TO STANDING SHOWER, COMPLETE WITH TILE BASE, POTLIGHT IN CEILING AND FRAMELESS GLASS SHOWER ENCLOSURE.
2318 12Jan21 NoCat	1	.MASTER ENSUITE: UPGRADE TO MOEN 'ARRIS' POSI-TEMP 3-FUNCTION RAIN SHOWER (from ceiling) + HAND SHOWER WITH SLIDE BAR - CHROME #TS2200EP/3372/TS23005/62320/3887EP/A725.



CONSTRUCTION SUMMARY

Lot: 15
Model: 40.06 A LILAC
Project/Phase: Pine Valley Forevergreen / 1

WINDOWS AND DOORS

Invoice	Qty.	Description
2318 12Jan21 NoCat	1	.MASTER BEDROOM - DRESSING ROOM: SUN TUNNEL EXTENSION, 6 FOOT RIGID TUNNEL EXTENSION [2TR 6 FOOT] - UP TO 6 FOOT MAX.
2284 24Jul20 NoCat	1	.BASEMENT WINDOWS - UPGRADE BASEMENT WINDOW SIZE TO 30 " X 24" - 8" FRAME
2318 12Jan21 NoCat	1	**DELETE** BASEMENT WINDOWS - EGRESS BASEMENT WINDOW 47 " X 35" - 8" FRAME.

*** NOTE: This is not an approved document. Document must be locked ***

Scheduled Closing Date: Tuesday, February 23, 2021

Purchaser: Wahhab Seddiqi

Property: 15 of Plan -

Telephone Res. / Bus: / (416) 356-9456

Project: Pine Valley Forevergreen - Phase 1

Decor Advisor: Yolande Somerville

Model and Elevation: 40.06 A LILAC

Layout Changes: ☐ Yes ☒ NoSketch Attached: ☒ Yes ☐ NoExterior Colour Scheme:

1. Cabinetry

	Style and Colour	Counter	Hardware
Kitchen / Breakfast	Alban oak Storm grey	*Quartz: Pearl-Jasmine- Quartz: Blanco Orion	h03903
Laundry Room	Alban oak Storm grey	P-Lam: Standard White	h03903
Powder Room	*Manhattan walnut storm grey	*Quartz: Vanilla Noir	k00205
Master Ensuite Bathroom	*Willis Oyster	*Quartz: Eterna Marquina	k00205
Second Ensuite Bathroom (If Applicable)	Fabro Ello	Quartz: Ice Snow	k00205
Shared Bath	Fabro Ello	Quartz: Ice Snow	k00205

Comment

REVISED

PV - 15
May 7, 2021

see email

REVISED

PV - 15
May 26, 2021

see email

2. Floor Tile

	Selection
Entrance Vestibule	*30x60" Marmorea polished 'Bianco Statuario'
Main Hall	
Kitchen / Breakfast	see hardwood
Laundry Room	13X13" Sempre 'White'
Powder Room	*30x60" Marmorea polished 'Bianco Statuario'
Mud Room	*30x60" Marmorea polished 'Bianco Statuario'
Master Ensuite Bathroom	*12x24" Marmorea polished 'Port Laurent' 12x24" Eterna 'Nero Marquina' polished
Second Ensuite Bathroom (If Applicable)	13x13" Sempre 'White'
Lower Landing (If Applicable)	*30x60" Marmorea polished 'Bianco Statuario'
Shared Bath	13x13" Sempre 'White'

Comment

Master Ensuite Shower Floor: ~~2" Ont Hex 'mt black'~~ // Shared bath + Ensuite 2 shower floor: std 2x2" white

↳ Ontario 2" Hex "Black" Glossy

3. Wall Tile

	Selection	Listello/Inserts	Describe
Master Ensuite Bathroom		<input type="radio"/> Yes <input checked="" type="radio"/> No	
Tub Deck		<input type="radio"/> Yes <input checked="" type="radio"/> No	
Shower Stall	*12x24" marmora pol 'Port Laurent'	<input type="radio"/> Yes <input checked="" type="radio"/> No	
Bathroom Walls	12x24" Eterna 'Nero Marquina' polished	<input type="radio"/> Yes <input checked="" type="radio"/> No	
Second Ensuite Bathroom (If Applicable)	8x10" Weave 'White'	<input type="radio"/> Yes <input checked="" type="radio"/> No	
Shared Bath	8x10" Weave 'White'	<input type="radio"/> Yes <input checked="" type="radio"/> No	
Kitchen Backsplash	<input checked="" type="radio"/> Yes <input type="radio"/> No	Backsplash Behind Fridge	
Comment	*slab FHBS, same as counter		

WS

Jan. 7, 2021

Scheduled Closing Date: Tuesday, February 23, 2021

Purchaser: Wahhab Seddigi

Property: 15 of Plan -

Telephone Res. / Bus: / (416) 356-9456

Project: Pine Valley Forevergreen - Phase 1

Decor Advisor: Yolande Somerville

Model and Elevation: 40.06 A LILAC

4. Plumbing Fixtures

Master Ensuite Bathroom Second Ensuite Powder Room
Other Room - Specify Other Washroom

Comment

Standard except kitchen + master ensuite

5. Hardwood Flooring

	Type and Stain		Type and Stain
Main Hall	<input type="text"/>	Upper Landing	<input type="text"/>
Kitchen / Breakfast	*3/4x5" wht oak wirebrush 'Baroque'	Upper Hall	<input type="text"/>
Living Room	<input type="text"/>	Master Bedroom	<input type="text"/>
Dining Room	<input type="text"/>	Bedroom #2	<input type="text"/>
Family Room	<input type="text"/>	Bedroom #3	<input type="text"/>
Den/Library	<input type="text"/>	Bedroom #4	<input type="text"/>
Entrance Vestibule	<input type="text"/>	Bedroom #5	<input type="text"/>
Lower Landing (If Applicable)	<input type="text"/>	Other Room - Specify	<input type="text"/>
		thru out standard areas	*3/4x5" wht oak wirebrush 'Baroque'

Comment

*Vintage 3/4x5" wht oak wirebrush 'Baroque'

6. Carpeting

	Upgrade	Description
Ground Floor	<input type="checkbox"/>	<input type="text"/>
Second Floor	<input type="checkbox"/>	<input type="text"/>
<input type="text"/>	<input type="checkbox"/>	<input type="text"/>

	Type	Area
Upgrade Underpad	<input type="text"/>	<input type="text"/>
	Capped	Runner - *Upgrade
Carpet on Stairs	<input type="text"/>	<input type="text"/>

Comment

7. Fireplace

	Living Room			Family Room			Other Room - Specify		
	Purchased	As Per Plan	N/A	Purchased	As Per Plan	N/A	Purchased	As Per Plan	N/A
Fireplace Type	<input type="radio"/>	<input type="radio"/>	<input checked="" type="radio"/>	<input type="radio"/>	<input checked="" type="radio"/>	<input type="radio"/>	<input type="radio"/>	<input type="radio"/>	<input checked="" type="radio"/>
Mantle Type	<input type="text"/>	<input type="text"/>	<input type="text"/>	Standard Gas	<input type="text"/>	<input type="text"/>	<input type="text"/>	<input type="text"/>	<input type="text"/>
Colour / Stain	<input type="text"/>	<input type="text"/>	<input type="text"/>	Mediterranean	<input type="text"/>	<input type="text"/>	<input type="text"/>	<input type="text"/>	<input type="text"/>
Surround	<input type="text"/>	<input type="text"/>	<input type="text"/>	Arctic White	<input type="text"/>	<input type="text"/>	<input type="text"/>	<input type="text"/>	<input type="text"/>
Hearth	<input type="text"/>	<input type="text"/>	<input type="text"/>	n/a	<input type="text"/>	<input type="text"/>	<input type="text"/>	<input type="text"/>	<input type="text"/>
	<input type="text"/>	<input type="text"/>	<input type="text"/>	none	<input type="text"/>	<input type="text"/>	<input type="text"/>	<input type="text"/>	<input type="text"/>

Comment

WS

Jan 7, 2021

ape email

May 26, 2021

email May 7, 2021

Scheduled Closing Date: Tuesday, February 23, 2021

Purchaser: Wahhab Seddiqi

Property: 15 of Plan -

Telephone Res. / Bus: / (416) 356-9456

Project: Pine Valley Forevergreen - Phase 1

Decor Advisor: Yolande Somerville

Model and Elevation: 40.06 A LILAC

8. Trim Carpentry

Interior Doors Front Door Glass Inserts Door Handles

Interior Trim

Comment

9. Plaster Mouldings and Medallions

Standard Throughout ☐ Yes ☐ No ☒ N/A

Entrance Vestibule	<input type="text"/>	<input type="text"/>	Kitchen/Breakfast	<input type="text"/>	<input type="text"/>
Main Hall	<input type="text"/>	<input type="text"/>	Den/Library	<input type="text"/>	<input type="text"/>
Living Room	<input type="text"/>	<input type="text"/>	Lower Landing	<input type="text"/>	<input type="text"/>
Dining Room	<input type="text"/>	<input type="text"/>	Other Room - Specify	<input type="text"/>	<input type="text"/>
Family Room	<input type="text"/>	<input type="text"/>			

Comment

10. Railings and Spindles

Railing Package

Railing Colour

Stringer / Riser

Spindle Colour

Treads

Oak Stairs ☒ Yes ☐ No ☐ N/A

Comment

11. Wall Paint / Ceilings

Throughout Finished Areas

Trim Paint

Smooth Ceilings

Ground Floor ☒

Second Floor ☒

Note

Comment

W/S Jan. 7, 2021

see email May 26, 2021

see email May 7, 2021

Purchaser: Wahhab Seddiqi

Property: 15 of Plan -

Telephone Res. / Bus: / (416) 356-9456

Project: Pine Valley Forevergreen - Phase 1

Decor Advisor: Yolande Somerville

Model and Elevation: 40.06 A LILAC

12. Electrical

Hood Fan ☐ White ☐ Stainless ☒ N/A

Above Kitchen Cabinet Light ☐ Yes ☒ No

Standard Appliances ☐

Below Kitchen Cabinet Light ☐ Yes ☒ No

Over The Range Microwave ☐

Chimney Style Fan ☒

Comment

13. Heating and Air Conditioning

Air Conditioning

Gas Provisions Stove

Gas Provisions Dryer

Gas Provisions Barbecue

Comment

14. Additional Comments

15. Disclaimers and Notes

- 1) Colours of all materials are as close as possible to builder's selection, but not necessarily identical due to variances in manufacturing.
- 2) Any extras listed above are null and void unless accompanied by a separate invoice/amendment. Said invoice must be paid in full.
- 3) The Purchaser acknowledges that after Interior Colour Selection form is signed and dated, no further changes will be permitted other than re-selection due to unavailability. _____ Purchaser's Initials
- 4) The Purchaser acknowledges reading and accepting the "Gold Park Homes Decor Centre Disclaimers" form. This document contains other miscellaneous disclaimers.

This Interior Colour Selection is final and approved by:

Signature: W.S.

Date: January 7, 2021

Yolande Somerville

From: wahhab seddiqi <wahhab.seddiqi@gmail.com>
Sent: Wednesday, May 26, 2021 1:15 PM
To: Yolande Somerville
Subject: Re: PV- 15 Kitchen Countertop Reselection

Hey,

I will go with selection #1 please.

On Tue, May 25, 2021 at 1:47 PM Yolande Somerville <YSomerville@goldparkhomes.com> wrote:

Hi Wahhab,

Hope you are doing well

We have just received word that the countertop you've selected for your Kitchen is unavailable and a reselection is required. Please see photo attached of a replacement option we have put together for you with your original selections for the room.

We selected a few options. Please let us know which ones you reselect and if you are okay to proceed with the replacement.

Thank you,


Goldpark Homes Design Studio

55 Siltan Road, Unit 3

Woodbridge, ON

L4L 7Z8

This email has been scanned for spam and viruses by Proofpoint Essentials. Click [here](#) to report this email as spam.

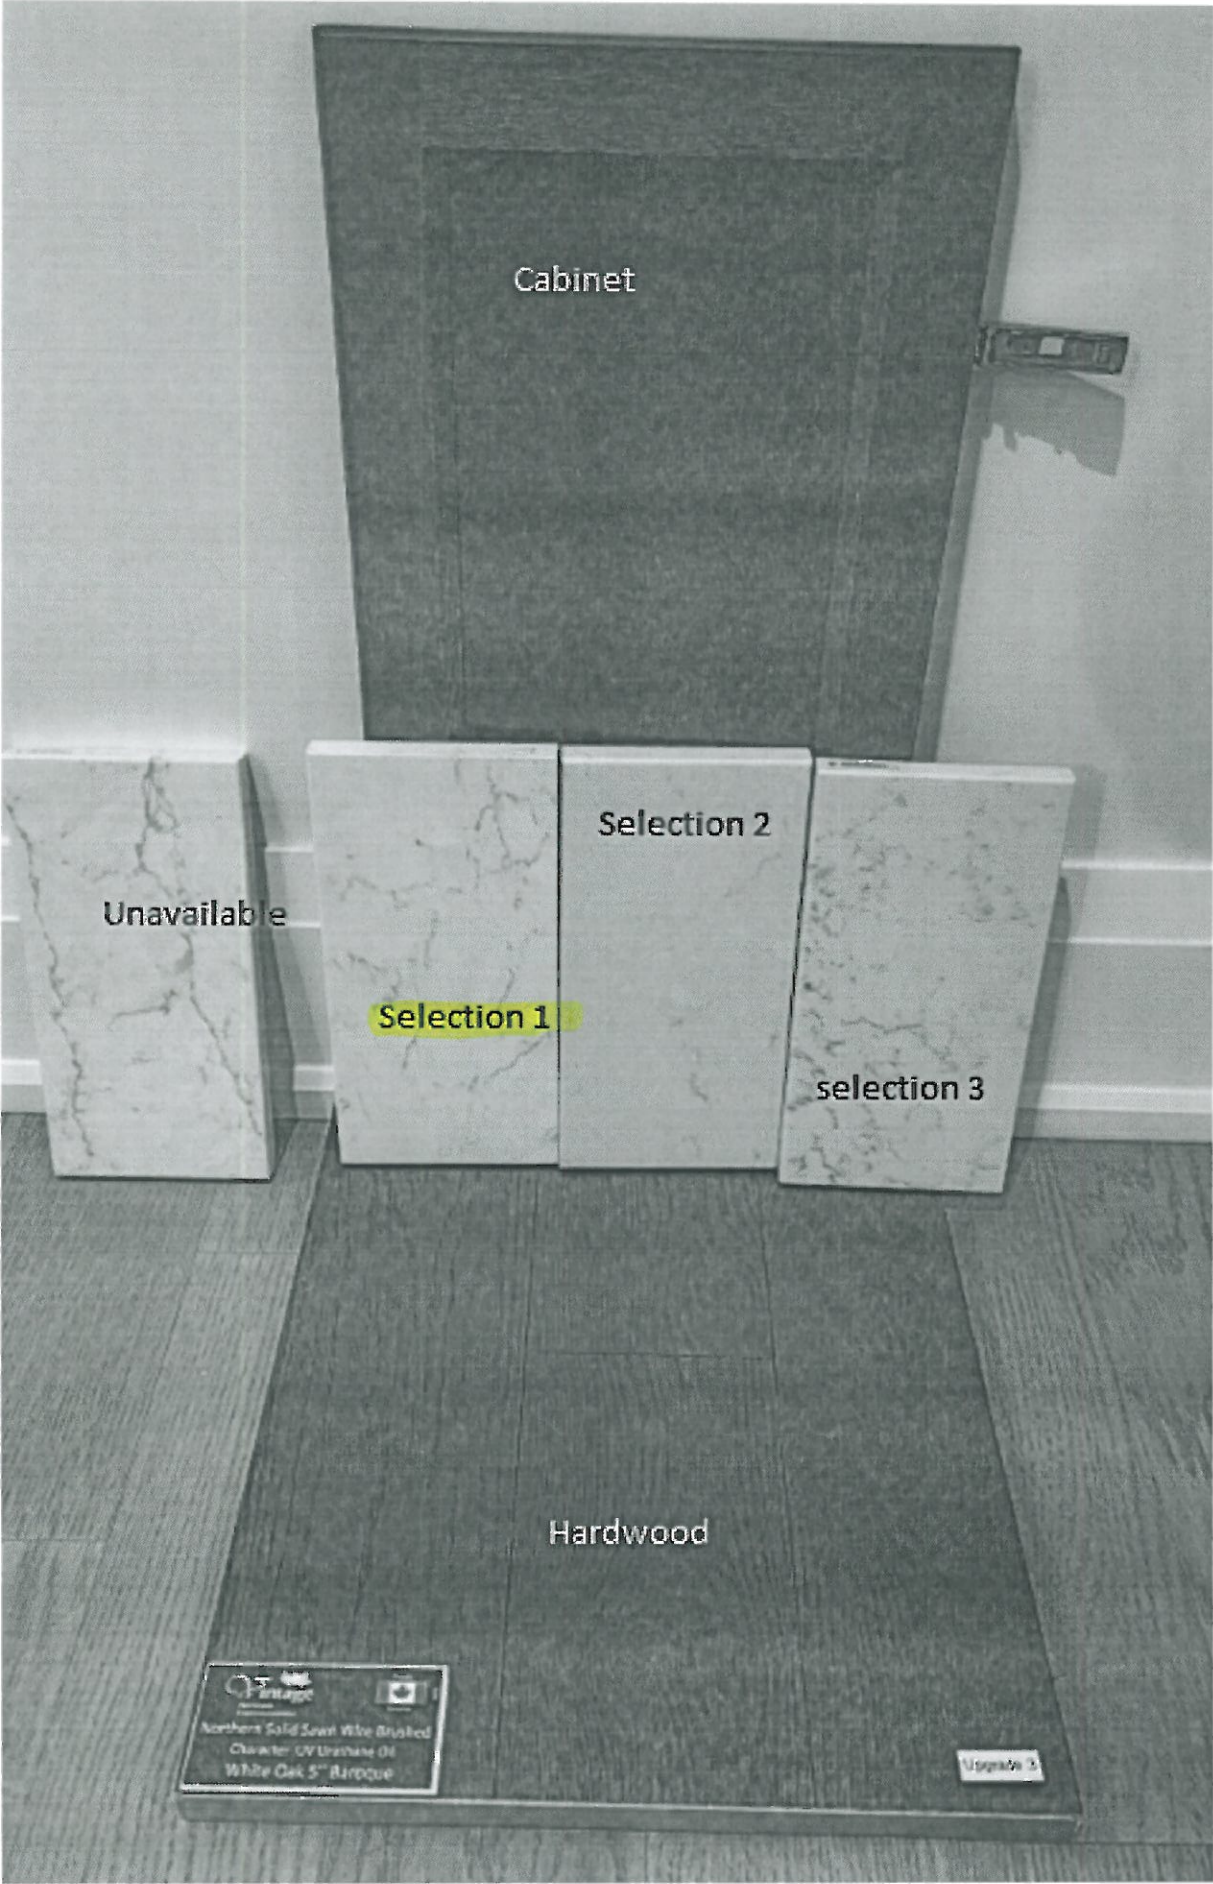

Cabinet

Unavailable

Selection 1

Selection 2

selection 3

Hardwood

Upgrade
Northern Solid Sawn Wide Plank
Character: UV Urethane Oil
White Oak 5" Plaque

Upgrade 3

Yolande Somerville

From: wahhab seddiqui <wahhab.seddiqui@gmail.com>
Sent: May 6, 2021 2:55 PM
To: Yolande Somerville
Subject: Re: PV-15 Tile Reselection - Urgent Response Required

Yes, please proceed.

On Thu, May 6, 2021 at 2:45 PM Yolande Somerville <YSomerville@goldparkhomes.com> wrote:

Hi Wahhab,

We've just received word that your tiles selected for your Master Ensuite are unavailable and a reselection is required. Please see details below and a photo attached of the replacement tile.

MASTER ENSUITE (see attached – replacement tile is VERY similar to original selection)

Original Selection:

Floor + Wall Tile – 12x24" Marmorea 'Port Laurent' polished

Shower Floor Tile – Ontario "Black" *matte*

Option 1:

Floor + Wall Tile – Eterna 'Nero Marquina' polished

Shower Floor Tile – Ontario "Black" *polished*

Please let us know as soon as you can if you are okay to proceed with the replacement option for the Master Ensuite tile, and the polished finish on the shower floor versus the matte finish.

Thank you,

GPH Design Studio Team

This email has been scanned for spam and viruses by Proofpoint Essentials. Click [here](#) to report this email as spam.

SCHEDULE 'F'



PV-15
April 9 2020

PV-15
May 5 2020

PV-15
Jan 7, 2021

See attached

WS

WS

The Lilac 40' SERIES


Elevation A • 3,425 sq.ft.
Elevation B • 3,385 sq.ft.

No PHONE
TREN OUT

Hardwood
COFFER +
WAFFLE

9' DOORS
ON MAIN
FLOOR

COFFER

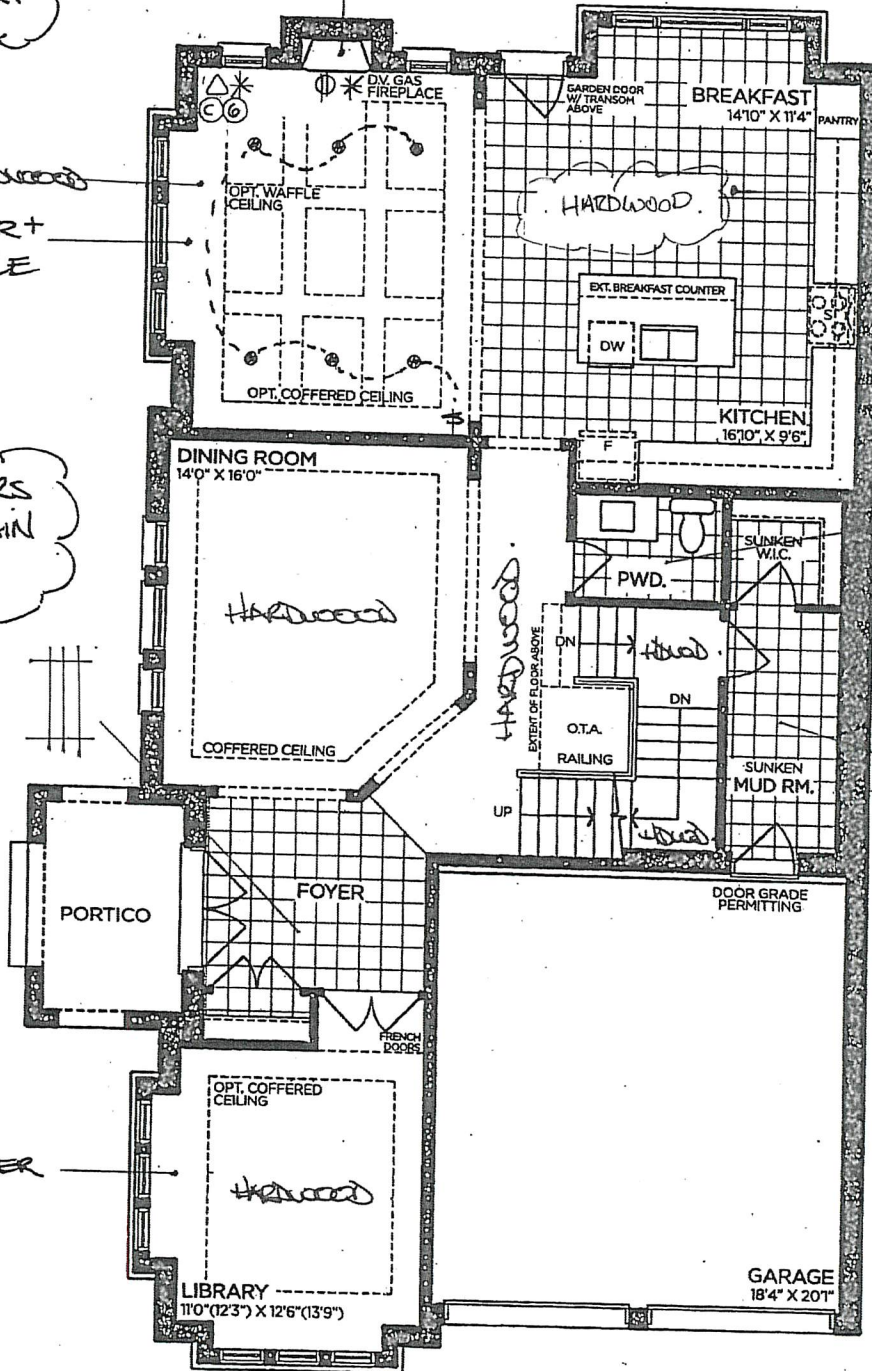

GROUND FLOOR | ELEV. A

VENDOR

PURCHASER

PURCHASER

GOLDPARK
WORTH MORE™

Prices, figures, illustrations, sizes, features and finishes are subject to change without notice. Areas and dimensions are approximate and actual usable floor space may vary from the stated area. Layout may be reverse of the unit purchased. E. & O.E. 4006

SCHEDULE 'F'



PV-15. *see attached*

April 9, 2020

PV-15

MAY 5, 2020 *WS*

PV-15


Jan 7, 2021 *W.S*

The Lilac

40' SERIES

→ Elevation A • 3,425 sq.ft.
Elevation B • 3,385 sq.ft.

8' DOORS
ON 2ND
FLOOR

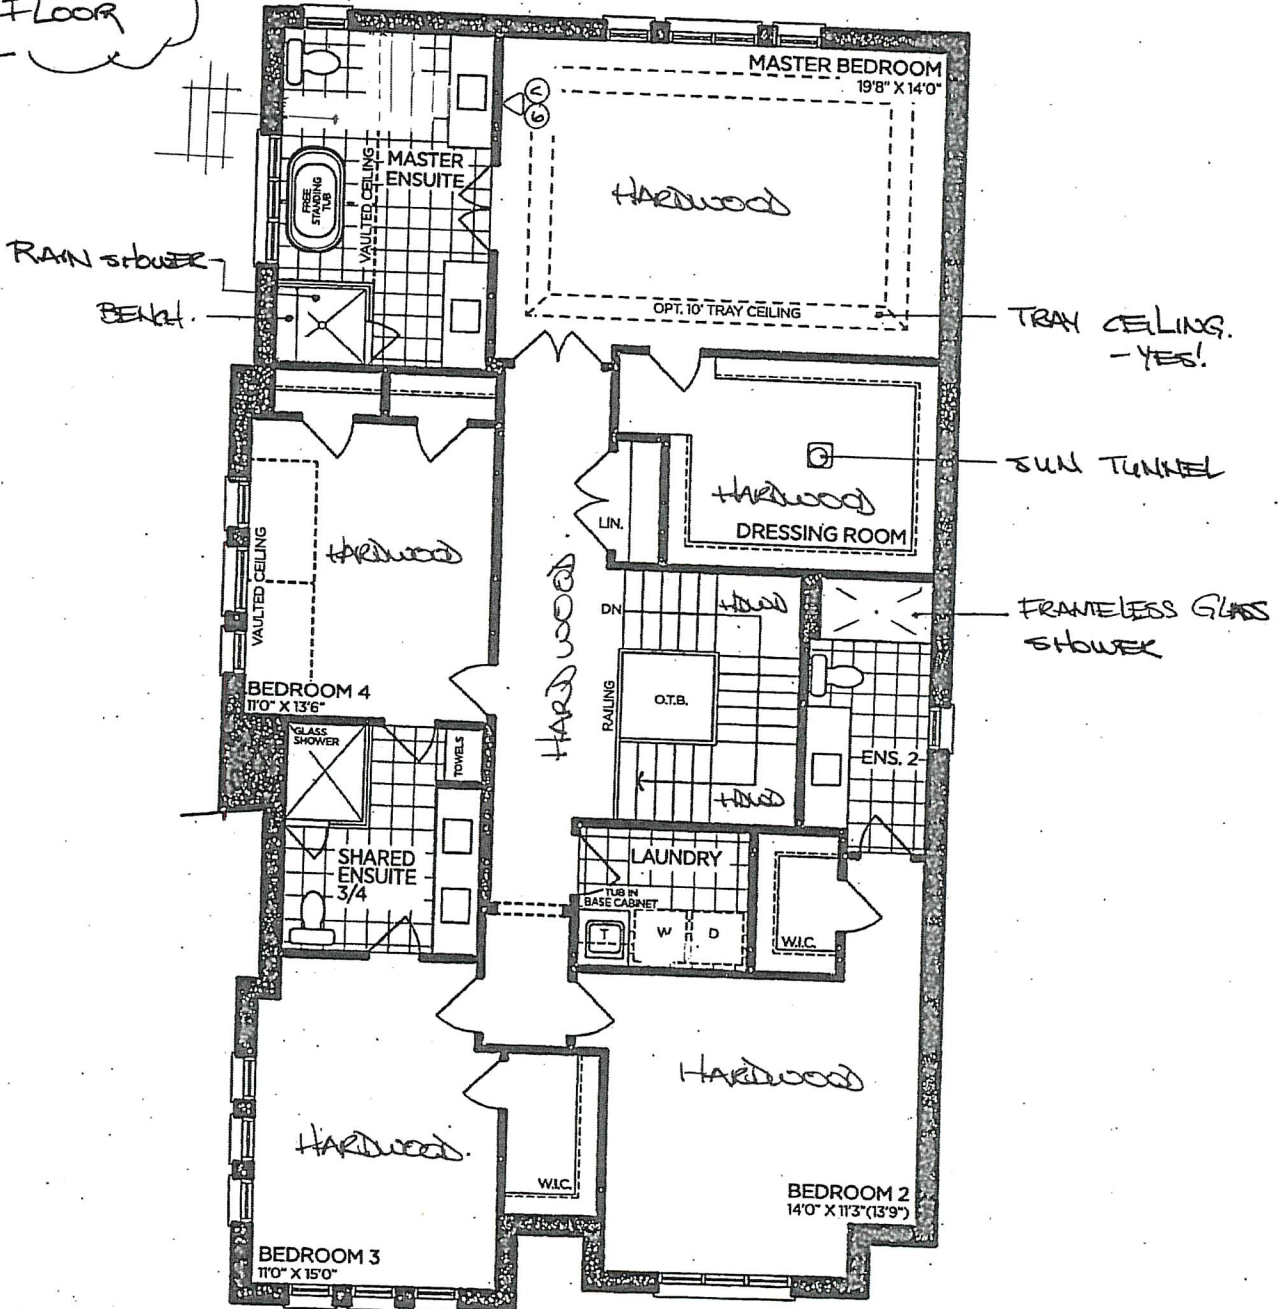

SECOND FLOOR | ELEV. A

VENDOR

PURCHASER

PURCHASER

GOLDPARK
WORTH MORE™

Prices, figures, illustrations, sizes, features and finishes are subject to change without notice. Areas and dimensions are approximate and actual usable floor space may vary from the stated area. Layout may be reverse of the unit purchased. E. & O.E. 4006

SCHEDULE 'F'




PV-15 ^{see attached}
APRIL 9 2020

PV-15
MAY 5. 2020 (WS)
PV-15
Jan 7 2021 (WS)

The
Lilac
40' SERIES

→ Elevation A • 3,425 sq.ft.
Elevation B • 3,385 sq.ft.

24x30"
~~35x47~~

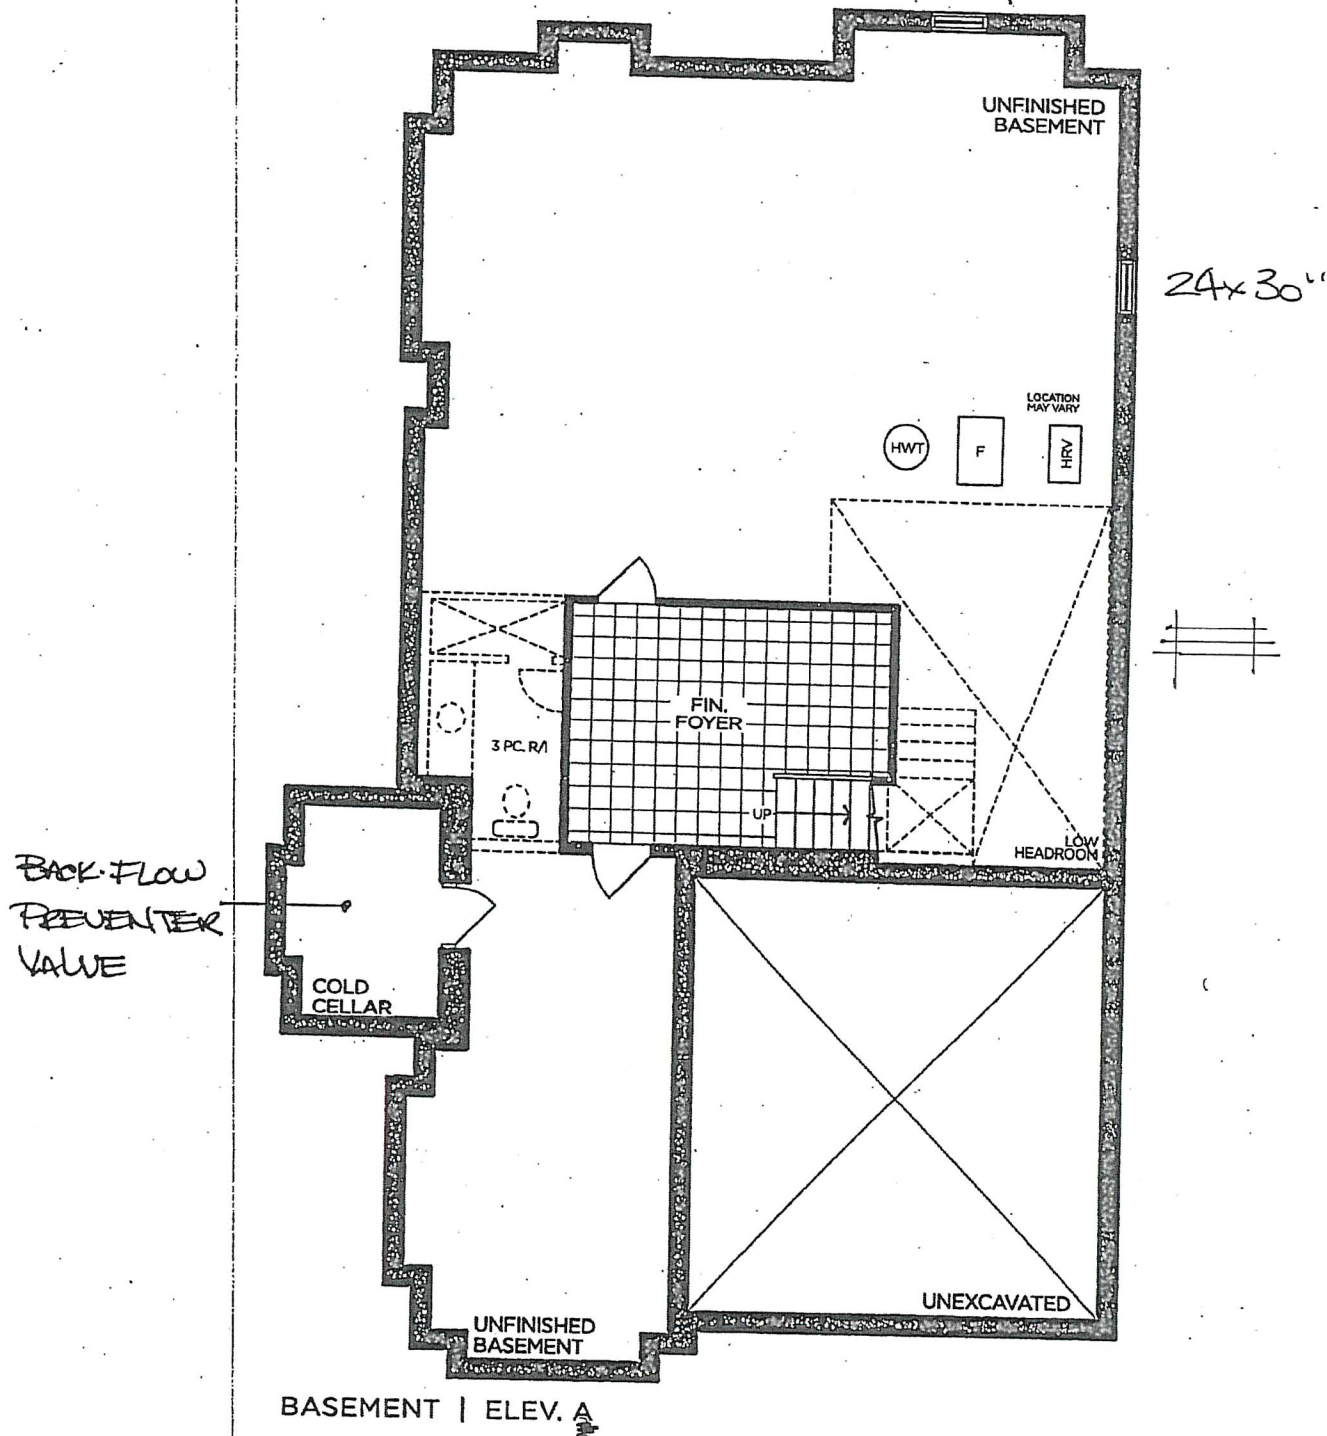

VENDOR	
PURCHASER	
PURCHASER	


GOLDPARK
WORTH MORE™

Prices, figures, illustrations, sizes, features and finishes are subject to change without notice. Areas and dimensions are approximate and actual usable floor space may vary from the stated area. Layout may be reverse of the unit purchased. E. & O.E. 4006

W.S

TV-15
Jan 7, 2021

ALBAI CAR
'STORM GREY'
H089-03.

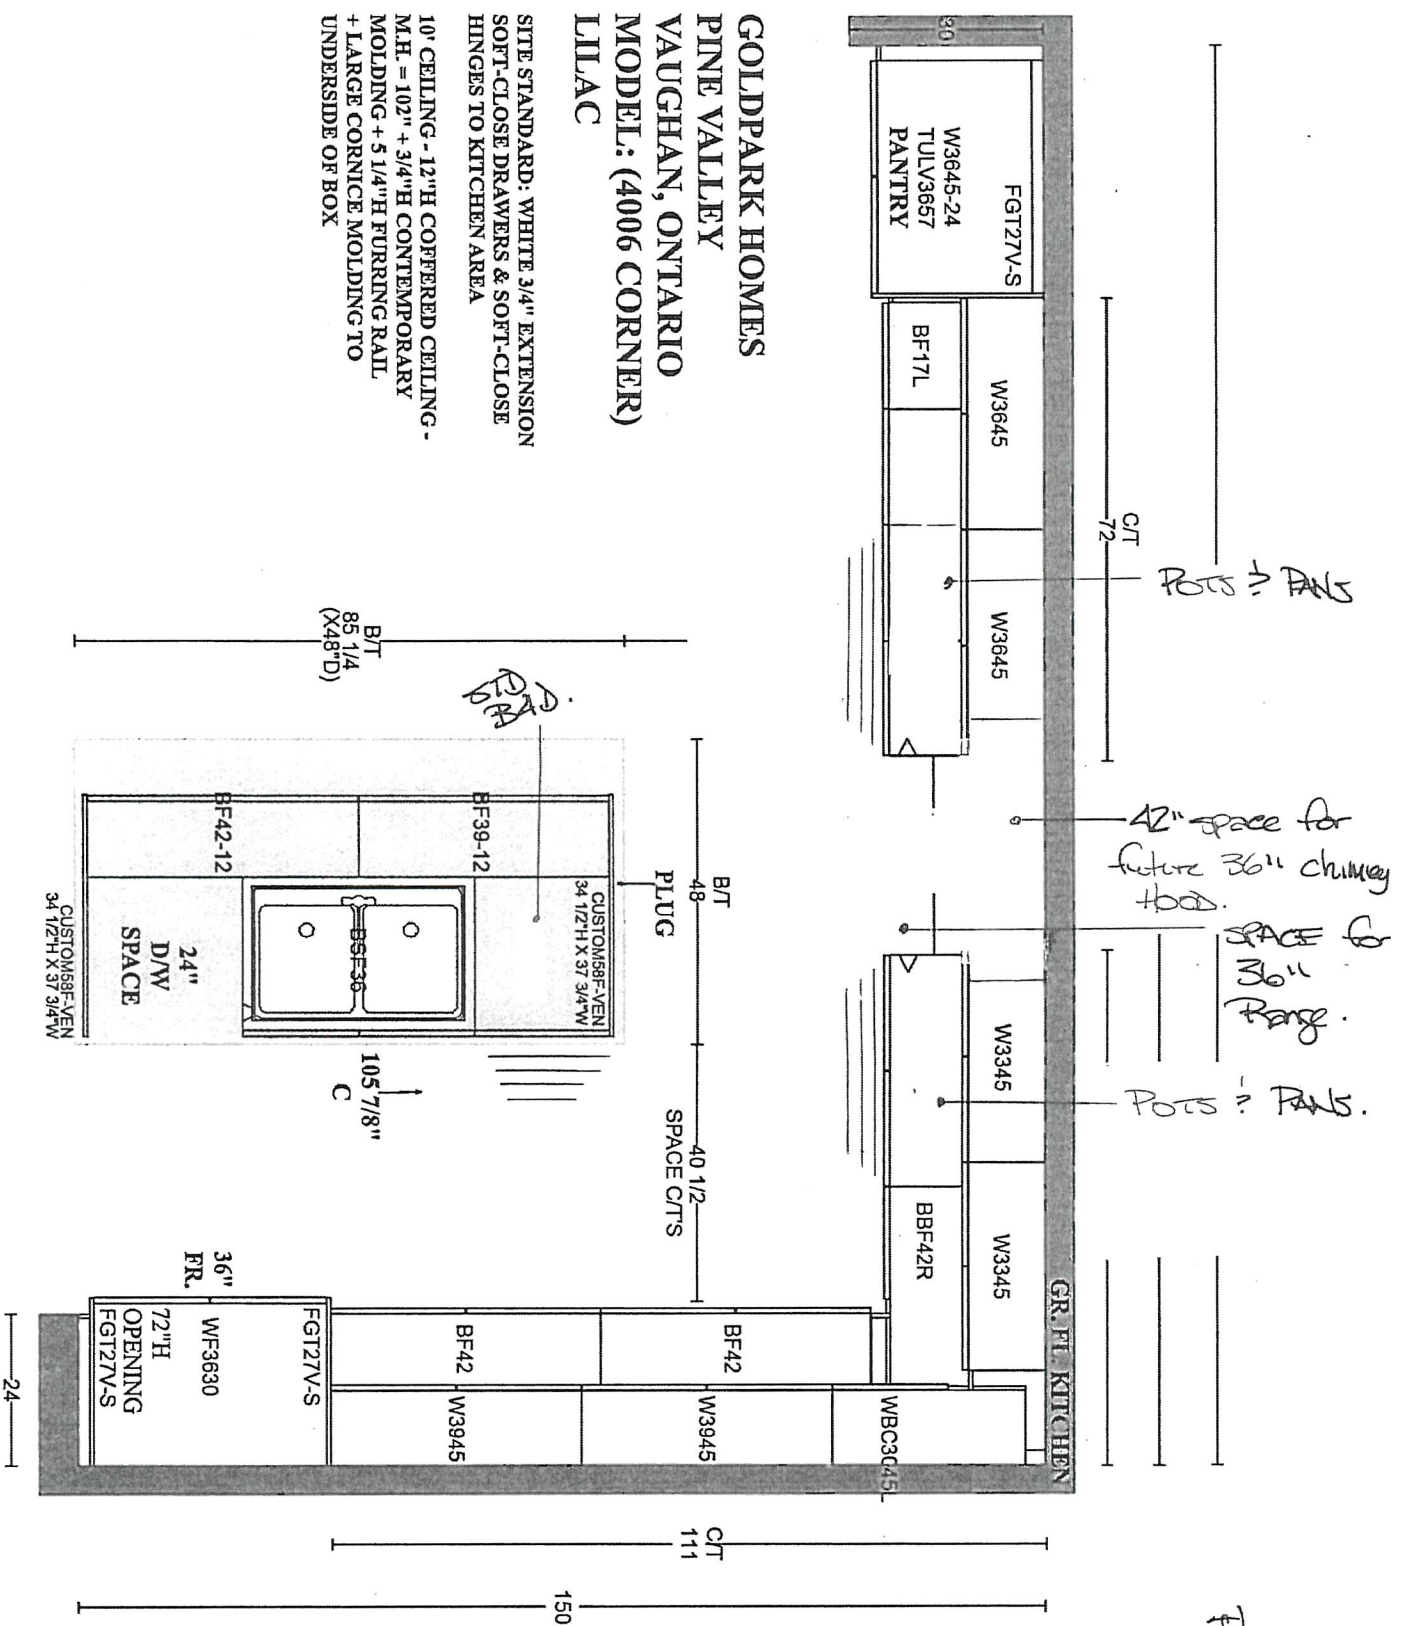

GOLDPARK HOMES
PINE VALLEY
VAUGHAN, ONTARIO
MODEL: (4006 CORNER)
LILAC

SITE STANDARD: WHITE 3/4" EXTENSION
SOFT-CLOSE DRAWERS & SOFT-CLOSE
HINGES TO KITCHEN AREA
10' CEILING - 12"H COFFERED CEILING -
M.H. = 102" + 3/4"H CONTEMPORARY
MOLDING + 5 1/4"H FLURRING RAIL
+ LARGE CORNICE MOLDING TO
UNDERSIDE OF BOX

PN-15
Jan. 7, 2021





Mantel unit
Screen Grey
K002-05.

Willis cabinet
K002-05.

GOLDPARK HOMES
PINE VALLEY
VAUGHAN, ONTARIO
MODEL: (4006 CORNER) LILAC

SITE STANDARD: WHITE 3/4" EXTENSION
SOFT-CLOSE DRAWERS & STANDARD SLAM DOOR HINGES
TO VANITIES

ONE TOP DRAWER WHERE POSSIBLE THROUGHOUT EACH
VANITY, ONE BANK OF DRAWERS WHERE POSSIBLE
THROUGHOUT EACH MASTER ENSUITE VANITY

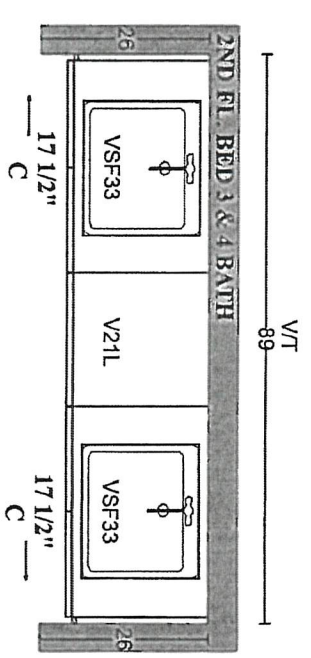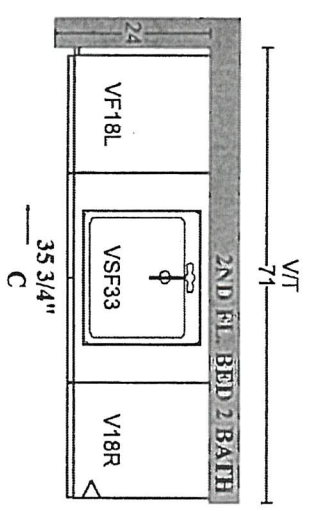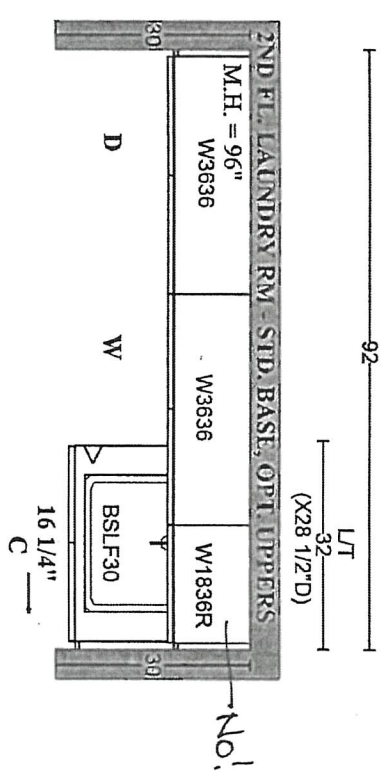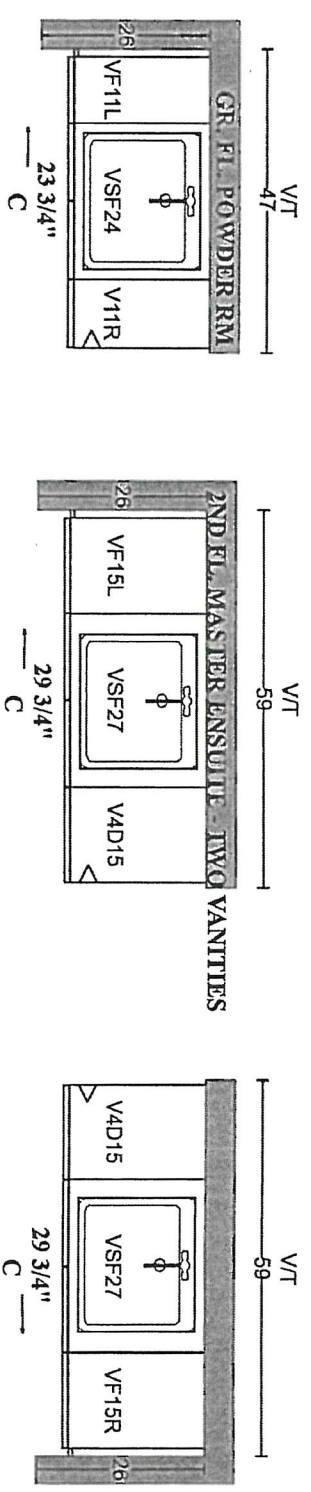



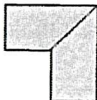




Alberca
Screen Grey
K002-05.

FABRO ELLO
K002-05

FABRO ELLO
K002-05.

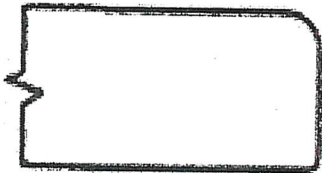STONE COUNTERTOP EDGE PROFILES

	 STANDARD 2CM EASED EDGE	LOCATION: THRU OUT
	UPGRADE 3CM EASED EDGE	LOCATION:
	 UPGRADE 4CM MITRED EDGE	LOCATION:
	UPGRADE 2CM OGEE EDGE	LOCATION:

LOT #: PV-15	DATE: Jan 7, 2021
SIGNATURE: 	
SIGNATURE:	


STANDARD HARDWARE / HANDLES



☐ H001-02



☐ H001-03

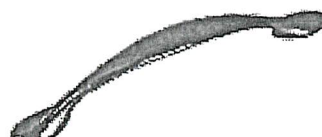


☐ H001-04



☐ H009-03



☐ H009-09

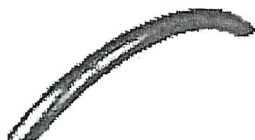


☐ H011-03



☐ H011-05



☐ H011-06

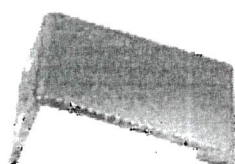

☐ H033-01



☒ H039-03

→ Kitchen
→ Laundry Room

☐ *NO HARDWARE

LOT # PV-15

DATE: Jan 7, 2021

SIGNATURE:

W.S

SIGNATURE:

STANDARD HARDWARE / KNOBS

☐

K002-02

☐


K002-03

☐

K002-04

☐

K002-06

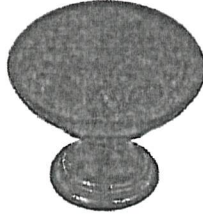☒

K002-05

→ Powder Room
→ Master Ensuite
→ Ensuite 2
→ Ensuite 3/4

☐

K002-14

☐

K024-03

☐

*NO HARDWARE

LOT # PV-15

DATE: Jan 7, 2021

SIGNATURE:



W.S.

SIGNATURE:

UPGRADE KITCHEN SINK



BLANCO - QUATRUS R15 U SUPER SINGLE
Stainless Steel - Undermount
32" x 18" x 9"

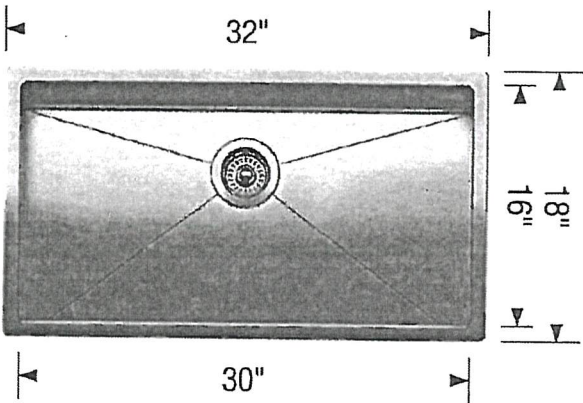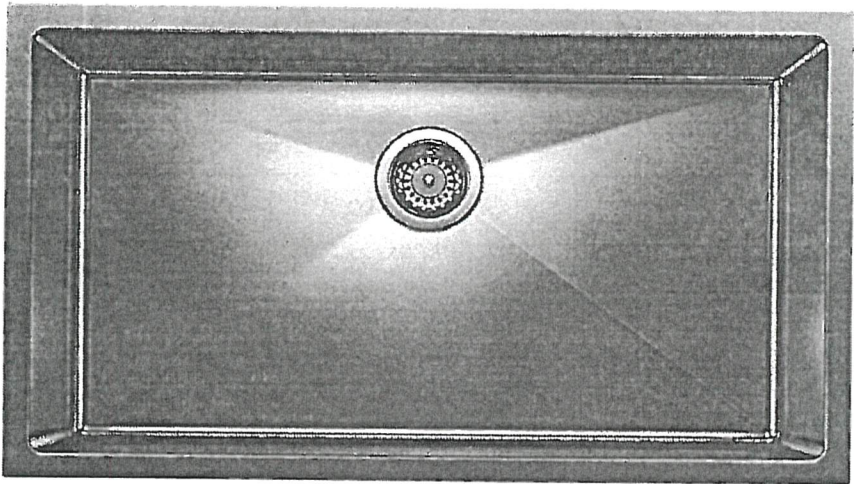

Stainless Steel

MODEL 401518 Stainless Steel

Lot# PR-15

Room: Kitchen

Signature: W.S.


Date: Jan 7, 2021

Signature:

UPGRADE SHOWER HARDWARE



LP6X6
Shower Door Handle

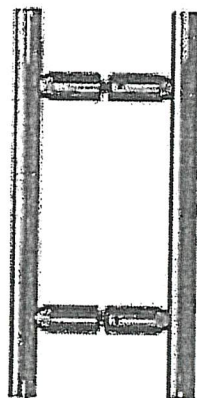

LP6X6
Shower Door Handle
10" Overall back-to-back
6" hole spacing
3/4" dia. tube
(Also available single sided)

- ☒ CHROME
☐ MATTE BLACK


Lot# PV-15	Date: Jan 7, 2021	Room: Master Ensuite
Signature: W.S.		
Signature:		



UPGRADE SHOWER HARDWARE

MT6X6


Shower Door Handle

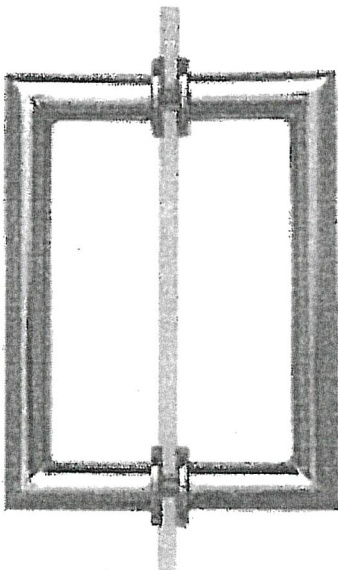

MT6X6
Shower Door Handle

6" x 6" back-to-back
3/4" dia. tube
Cut and mitred corners with
washers
(Also available single sided)

- ☒ CHROME
☐ MATTE BLACK
☐ BRUSHED GOLD

Lot# PV-15	Date: Jan 7, 2021	Room: Ensuite 2, Ensuite 3/4
Signature: 		
Signature:		



PINE VALLEY
FOREVERGREEN

PLUMBING UPGRADES

MOEN - ARRIS

Two-Handle Adjustable Widespread Lav Faucet with Drain Assembly



☒ CHROME

☐ BRUSHED NICKEL (BN)

☐ MATTE BLACK (BL)

MODEL: TS43002 Lav Faucet / 69000 Valve

Lot# PV-15

Date: Jan. 7 2021

Room: Master Ensuite

Signature: WS

Signature:

GOLDPARK
WORTH MORE




PINE VALLEY
FOREVERGREEN

PLUMBING UPGRADES

MOEN - ARRIS

Two-Handle Roman Tub Faucet with Hand Shower

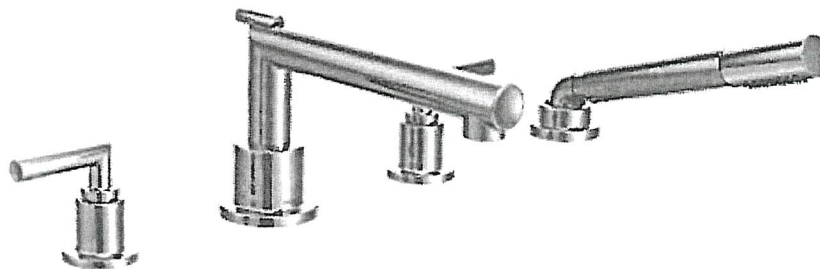

☒ CHROME

☐ BRUSHED NICKEL (BN)

☐ MATTE BLACK (BL)

MODEL: TS93004 Tub Faucet / 9796 Valve / T90331 + 140680 Tub Drain Half Kit

Lot# PV -15	Date: Jan. 7 2021	Room: Master Ensuite
----------------	----------------------	-------------------------


Signature:

Signature:

BATHROOM ACCESSORIES



Tissue Holder
Mason - Chrome

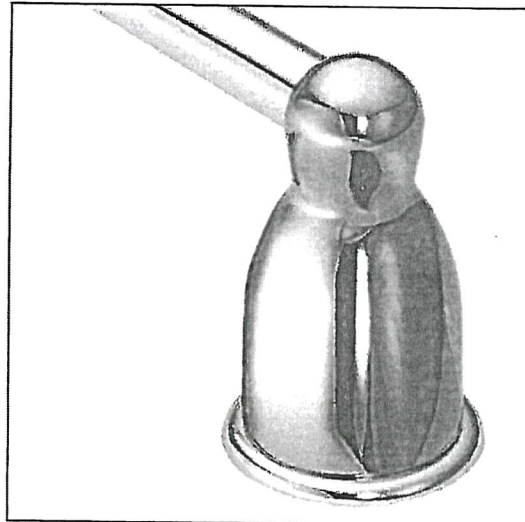

Towel Bar
Mason - Chrome

Please select one of the following:

☒ **INSTALL STANDARD BATHROOM ACCESSORIES THRU OUT**
(tissue holder + towel bar) **location as per vendors discretion**

☐ ***DO NOT* INSTALL STANDARD BATHROOM ACCESSORIES**
THRU OUT **tissue holder + towel bar will not be provided**

LOT # PV-15

DATE: Jan 7, 2021

SIGNATURE:

WS

SIGNATURE:



Project: Pine Valley

Lot: 15

Purchaser(s): Nahhab Seddigi

Standard Hood Fan Deletion

We acknowledge that the builder's standard hood fan will not be installed.
Do not supply, install and/or credit. We will install our own hood fan after closing.

Signature: _____

WS

A handwritten signature in dark ink, appearing to be "Nahhab Seddigi", written over a horizontal line.

Signature: _____

Date: January 7, 2021