



CONSTRUCTION SUMMARY

Lot: 12
Model: 50.03 B OAKGROVE
Project/Phase: Pine Valley Forevergreen / 1

APPLIANCES

Invoice	Qty.	Description
2551	1	STANDARD APPLIANCE OPENINGS
29Jan21 NoCat		

BASEMENT WINDOWS

Invoice	Qty.	Description
2470 72,675 06Oct20	4	BASEMENT WINDOWS - UPGRADE BASEMENT WINDOW SIZE TO 30 " X 24" - 10" FRAME (PINEVALLEY 50 FOOT LOTS ONLY)

CERAMIC

Invoice	Qty.	Description
2551	1	KITCHEN / BREAKFAST / SERVERY - VINTAGE SERIES, 6 1/2" WHITE OAK, NSS ENGINEERED HARDWOOD, 3/4" THK, SCULPTED TEXTURE, UVF FINISH - LEVEL 6
29Jan21 NoCat		DO NOT SUPPLY/INSTALL - CREDIT
2812	1	*TILE RE-SELECTION* - SEE ATTACHED COLOUR CHART FOR UPDATE.
14Jun21 NoCat		

CONCRETE AND DRAIN

Invoice	Qty.	Description
2470	1	BACK-FLOW PREVENTER VALVE
06Oct20 NoCat		

DRYWALL

Invoice	Qty.	Description
2470	1	GREAT ROOM / BREAKFAST ROOM: UPGRADE EXTERIOR DOORS TO 96" DOOR ASSEMBLY
06Oct20 NoCat		
2551	1	**CUSTOM LAYOUT** MAIN STAIRS: DELETE ARCH/RAILING AT STAIR LANDING NEAR LAUNDRY ROOM - MAKE FULL WALL
29Jan21 NoCat		



CONSTRUCTION SUMMARY

Lot: 12
Model: 50.03 B OAKGROVE
Project/Phase: Pine Valley Forevergreen / 1

ELECTRICAL

Invoice	Qty.	Description
2470 72,281 06Oct20	1	GREAT ROOM: INTERIOR WALL OUTLET: ADDITIONAL 110V WALL INTERIOR RECEPTACLE ON EXISTING CIRCUIT FOR WALL MOUNTED TV - LOCATE APPROX 66" A.F.F. ABOVE FIREPLACE
2470 72,289 06Oct20	6	KITCHEN: 4" E/S LED INTERIOR POT LIGHT - GROUND FLOOR - EACH INCLUDED IN APS
2470 06Oct20 NoCat	1	UPGRADE MAIN FLOOR LINEAR 1 SIDED FIREPLACE - JADE SERIES 42" LINEAR DIRECT VENT GAS FIREPLACE, INCLUDES ELECTRICAL NOT INCLUSIVE OF MANTEL SURROUND - **BOTTOM OF VIEWING AREA TO BE APPROX 12" A.F.F.** INCLUDES MATCHING VENT GRILL DIRECTLY ABOVE, APPROX 24" FROM CEILING
2536 12Jan21 NoCat	1	.***CREDIT*** FROM ORDER PE.2470 - UPGRADE MAIN FLOOR LINEAR 1 SIDED FIREPLACE - JADE SERIES 42" LINEAR DIRECT VENT GAS FIREPLACE, INCLUDES ELECTRICAL NOT INCLUSIVE OF MANTEL SURROUND INSTALL STANDARD FIREPLACE

FIREPLACE

Invoice	Qty.	Description
2470 72,315 06Oct20	1	UPGRADE MAIN FLOOR LINEAR 1 SIDED FIREPLACE - JADE SERIES 42" LINEAR DIRECT VENT GAS FIREPLACE, INCLUDES ELECTRICAL NOT INCLUSIVE OF MANTEL SURROUND - **BOTTOM OF VIEWING AREA TO BE APPROX 12" A.F.F.** INCLUDES MATCHING VENT GRILL DIRECTLY ABOVE, APPROX 24" FROM CEILING
2536 72,315 12Jan21	-1	.***CREDIT*** FROM ORDER PE.2470 - UPGRADE MAIN FLOOR LINEAR 1 SIDED FIREPLACE - JADE SERIES 42" LINEAR DIRECT VENT GAS FIREPLACE, INCLUDES ELECTRICAL NOT INCLUSIVE OF MANTEL SURROUND INSTALL STANDARD FIREPLACE

FRAMING

Invoice	Qty.	Description
2470 06Oct20 NoCat	1	GREAT ROOM / BREAKFAST ROOM: UPGRADE EXTERIOR DOORS TO 96" DOOR ASSEMBLY
2551 29Jan21 NoCat	1	**CUSTOM LAYOUT** MAIN STAIRS: DELETE ARCH/RAILING AT STAIR LANDING NEAR LAUNDRY ROOM - MAKE FULL WALL

GLASS AND MIRROR

Invoice	Qty.	Description
2551 101,930 29Jan21	1	*NOTE: DO NOT INSTALL MIRRORS THRU-OUT*



CONSTRUCTION SUMMARY

Lot: 12
Model: 50.03 B OAKGROVE
Project/Phase: Pine Valley Forevergreen / 1

HARDWOOD

Invoice	Qty.	Description
2551 101,930 29Jan21	1	THRU-OUT STANDARD AREAS: LIVING ROOM/ MAIN HALL/ DINING ROOM/ GREAT ROOM/ UPPER HALL/ STUDY/ MASTER BEDROOM/ BEDROOM 2/ BEDROOM 3/ BEDROOM 4 - VINTAGE SERIES, 6 1/2" WHITE OAK, NNS ENGINEERED HARDWOOD, 3/4" THK, SCULPTED TEXTURE, UVF FINISH - LEVEL 6
2551 9 29Jan21	1	KITCHEN / BREAKFAST / SERVERY - VINTAGE SERIES, 6 1/2" WHITE OAK, NSS ENGINEERED HARDWOOD, 3/4" THK, SCULPTED TEXTURE, UVF FINISH - LEVEL 6

HVAC

Invoice	Qty.	Description
2470 06Oct20 NoCat	1	UPGRADE MAIN FLOOR LINEAR 1 SIDED FIREPLACE - JADE SERIES 42" LINEAR DIRECT VENT GAS FIREPLACE, INCLUDES ELECTRICAL NOT INCLUSIVE OF MANTEL SURROUND - **BOTTOM OF VIEWING AREA TO BE APPROX 12" A.F.F.** INCLUDES MATCHING VENT GRILL DIRECTLY ABOVE, APPROX 24" FROM CEILING
2536 12Jan21 NoCat	1	.***CREDIT*** FROM ORDER PE.2470 - UPGRADE MAIN FLOOR LINEAR 1 SIDED FIREPLACE - JADE SERIES 42" LINEAR DIRECT VENT GAS FIREPLACE, INCLUDES ELECTRICAL NOT INCLUSIVE OF MANTEL SURROUND INSTALL STANDARD FIREPLACE

INTERIOR TRIM AND DOORS

Invoice	Qty.	Description
2470 06Oct20 NoCat	1	GREAT ROOM / BREAKFAST ROOM: UPGRADE EXTERIOR DOORS TO 96" DOOR ASSEMBLY
2551 100,443 29Jan21	1	THRU OUT: UPGRADE 3 1/2" STEP BEVEL, 7 1/4" BASE BOARD - UPGRADE
2551 29Jan21 NoCat	1	**CUSTOM LAYOUT** MAIN STAIRS: DELETE ARCH/RAILING AT STAIR LANDING NEAR LAUNDRY ROOM - MAKE FULL WALL

KITCHEN AND BATH CABINETRY

Invoice	Qty.	Description
2551 29Jan21 NoCat	1	THRU OUT: SEE ATTACHED CABINETRY SCHEDULE
2551 29Jan21 NoCat	1	STANDARD APPLIANCE OPENINGS

MISC.

Invoice	Qty.	Description
2536 12Jan21 NoCat	1	ADMIN FEE TO RE-OPEN FILE



CONSTRUCTION SUMMARY

Lot: 12
Model: 50.03 B OAKGROVE
Project/Phase: Pine Valley Forevergreen / 1

NETWORK AND WIRING

Invoice	Qty.	Description
2470 72,259 06Oct20	1	GREAT ROOM: CONDUIT PIPE - FOR WALL MOUNT TV - LOCATE APPROX.66" A.F.F. ABOVE FIREPLACE, THRU BASEMENT AND TERMINATING AT CABLE - SEE PLAN FOR LOCATION

PAINT

Invoice	Qty.	Description
2470 06Oct20 NoCat	1	GREAT ROOM / BREAKFAST ROOM: UPGRADE EXTERIOR DOORS TO 96" DOOR ASSEMBLY
2551 29Jan21 NoCat	1	**CUSTOM LAYOUT** MAIN STAIRS: DELETE ARCH/RAILING AT STAIR LANDING NEAR LAUNDRY ROOM - MAKE FULL WALL

PLUMBING

Invoice	Qty.	Description
2470 72,332 06Oct20	1	KITCHEN: ROUGH-IN 1/4" COLD WATER LINE TO FRIDGE
2470 72,346 06Oct20	1	KITCHEN: ROUGH-IN FOR KITCHEN POT FILLER (FIXTURE NOT INCLUDED)
2470 06Oct20 NoCat	1	BACK-FLOW PREVENTER VALVE

STAIR AND RAILINGS

Invoice	Qty.	Description
2551 94,095 29Jan21	2	MAIN STAIRS: UPGRADE - EUROLINE CONTEMPORARY, 3" RECTANGULAR HANDRAIL, 3 1/2" ALL SQUARE POST WITH SQUARE STYLE W/BAND POST CAP - PACKAGE F

STAIRS AND RAILINGS

Invoice	Qty.	Description
2551 101,930 29Jan21	2	MAIN STAIRS: 2ND FLOOR TO BASEMENT - STAIN STAIRS AND LANDINGS STAIR STAIN TO COMPLIMENT HARDWOOD FLOORS. WILL NOT MATCH IN COLOUR/ SPECIES/ TEXTURE

WINDOWS AND DOORS

Invoice	Qty.	Description
2470 06Oct20 NoCat	1	GREAT ROOM / BREAKFAST ROOM: UPGRADE EXTERIOR DOORS TO 96" DOOR ASSEMBLY

*** NOTE: This is not an approved document. Document must be locked ***

Scheduled Closing Date: Thursday, May 13, 2021

Purchasers: SAHIN YALBIRDAK & CAGLA YALBIRDAK

Property: 12 of Plan -

Telephone Res. / Bus: / (416) 319-8799

Project: Pine Valley Forevergreen - Phase 1

Decor Advisor: Yolande Somerville

Model and Elevation: 50.03 B OAKGROVE

Layout Changes: ☐ Yes ☒ No

Sketch Attached: ☒ Yes ☐ No

Exterior Colour Scheme:

1. Cabinetry

	Style and Colour	Counter	Hardware
Kitchen / Breakfast	Chesapeake 'Classic White'	Granite: Arctic White	attach
Laundry Room	Chesapeake 'Classic White'	P-Lam: White	attach
Powder Room	Chesapeake 'Classic White'	Quartz: Ice Snow	attach
Mud Room	Chesapeake 'Classic White'	P-Lam: White	attach
Master Ensuite Bathroom	Chesapeake 'Classic White'	Quartz: Ice Snow	attach
Second Ensuite Bathroom (If Applicable)	Chesapeake 'Classic White'	Quartz: Ice Snow	attach
Shared Ensuite	Chesapeake 'Classic White'	Quartz: Ice Snow	attach

Comment

REVISED

June 14, 2021

see email

2. Floor Tile

	Selection
Entrance Vestibule	13x13" Sempre 'White'
Main Hall	n/a
Kitchen / Breakfast	*see hardwood
Laundry Room	13x13" Costa 'White'
Powder Room	13x13" Sempre 'White'
Mud Room	13x13" Sempre 'White'
Master Ensuite Bathroom	13x13" Sempre 'White'
Second Ensuite Bathroom (If Applicable)	13x13" Sempre 'White'
Lower Landing (If Applicable)	13x13" Costa 'White'
Shared Ensuite	13x13" Sempre 'White'

13x13" Altezza Carrara

Comment

Shower Floor thru out: std 2x2" white

3. Wall Tile

	Selection	Listello/Inserts	Describe
Master Ensuite Bathroom		<input type="radio"/> Yes <input checked="" type="radio"/> No	
Tub Deck		<input type="radio"/> Yes <input checked="" type="radio"/> No	
Shower Stall	8x10" Uniwall 'White'	<input type="radio"/> Yes <input checked="" type="radio"/> No	
Bathroom Walls		<input type="radio"/> Yes <input checked="" type="radio"/> No	
Second Ensuite Bathroom (If Applicable)	8x10" Weave 'White'	<input type="radio"/> Yes <input checked="" type="radio"/> No	
Shared Ensuite	8x10" Uniwall 'Tender Grey'	<input type="radio"/> Yes <input checked="" type="radio"/> No	
Kitchen Backsplash	<input type="radio"/> Yes <input checked="" type="radio"/> No	Backsplash Behind Fridge	

Comment

24 *54*

Scheduled Closing Date: Thursday, May 13, 2021

Purchasers: SAHIN YALBIRDAK & CAGLA YALBIRDAK

Property: 12 of Plan -

Telephone Res. / Bus: / (416) 319-8799

Project: Pine Valley Forevergreen - Phase 1

Decor Advisor: Yolande Somerville

Model and Elevation: 50.03 B OAKGROVE

4. Plumbing Fixtures

Master Ensuite Bathroom Second Ensuite Powder Room
Other Room - Specify Other Washroom

Comment

Standard thru out

5. Hardwood Flooring

	Type and Stain		Type and Stain
Main Hall	<input type="text"/>	Upper Landing	<input type="text"/>
Kitchen / Breakfast	*3/4x6-1/2" sculpted 'Nautilus'	Upper Hall	<input type="text"/>
Living Room	<input type="text"/>	Master Bedroom	<input type="text"/>
Dining Room	<input type="text"/>	Bedroom #2	<input type="text"/>
Family Room	<input type="text"/>	Bedroom #3	<input type="text"/>
Den/Library	<input type="text"/>	Bedroom #4	<input type="text"/>
Entrance Vestibule	<input type="text"/>	Bedroom #5	<input type="text"/>
Lower Landing (If Applicable)	<input type="text"/>	Other Room - Specify	<input type="text"/>
		*Thruout standard area	*3/4x6-1/2" sculpted 'Nautilus'

Comment

Vintage White oak 3/4x6-1/2" sculpted 'Nautilus'

6. Carpeting

	Upgrade	Description
Ground Floor	<input type="checkbox"/>	<input type="text"/>
Second Floor	<input type="checkbox"/>	<input type="text"/>
<input type="text"/>	<input type="checkbox"/>	<input type="text"/>

	Type	Area
Upgrade Underpad	<input type="text"/>	<input type="text"/>
	Capped	Runner - *Upgrade
Carpet on Stairs	<input type="text"/>	<input type="text"/>

Comment

7. Fireplace

	Living Room			Family Room			Other Room - Specify		
	Purchased	As Per Plan	N/A	Purchased	As Per Plan	N/A	Purchased	As Per Plan	N/A
Fireplace Type	<input type="radio"/>	<input type="radio"/>	<input checked="" type="radio"/>	<input type="radio"/>	<input checked="" type="radio"/>	<input type="radio"/>	<input type="radio"/>	<input type="radio"/>	<input checked="" type="radio"/>
Mantle Type	<input type="text"/>	<input type="text"/>	<input type="text"/>	<input type="text"/>	<input type="text"/>	<input type="text"/>	<input type="text"/>	<input type="text"/>	<input type="text"/>
Colour / Stain	<input type="text"/>	<input type="text"/>	<input type="text"/>	<input type="text"/>	<input type="text"/>	<input type="text"/>	<input type="text"/>	<input type="text"/>	<input type="text"/>
Surround	<input type="text"/>	<input type="text"/>	<input type="text"/>	<input type="text"/>	<input type="text"/>	<input type="text"/>	<input type="text"/>	<input type="text"/>	<input type="text"/>
Hearth	<input type="text"/>	<input type="text"/>	<input type="text"/>	<input type="text"/>	<input type="text"/>	<input type="text"/>	<input type="text"/>	<input type="text"/>	<input type="text"/>

Comment

04

54

June 14, 2021

see email

Scheduled Closing Date: Thursday, May 13, 2021

Purchasers: SAHIN YALBIRDAK & CAGLA YALBIRDAK Property: 12 of Plan -
 Telephone Res. / Bus: / (416) 319-8799 Project: Pine Valley Forevergreen - Phase 1
 Decor Advisor: Yolande Somerville Model and Elevation: 50.03 B OAKGROVE

8. Trim Carpentry

Interior Doors Front Door Glass Inserts Door Handles
 Interior Trim
 Comment

9. Plaster Mouldings and Medallions

Standard Throughout ☐ Yes ☐ No ☒ N/A

Entrance Vestibule	<input type="text"/>	<input type="text"/>	Kitchen/Breakfast	<input type="text"/>	<input type="text"/>
Main Hall	<input type="text"/>	<input type="text"/>	Den/Library	<input type="text"/>	<input type="text"/>
Living Room	<input type="text"/>	<input type="text"/>	Lower Landing	<input type="text"/>	<input type="text"/>
Dining Room	<input type="text"/>	<input type="text"/>	Other Room - Specify	<input type="text"/>	<input type="text"/>
Family Room	<input type="text"/>	<input type="text"/>			

Comment

10. Railings and Spindles

Railing Package
 Railing Colour Spindle Colour
 Stringer / Riser Treads

Comment

Oak Stairs ☒ Yes ☐ No ☐ N/A

11. Wall Paint / Ceilings

Throughout Finished Areas

Trim Paint

Smooth Ceilings

Ground Floor ☒

Second Floor ☒

Note

Comment

June 14, 2021

see email

C.Y. 54

Scheduled Closing Date: Thursday, May 13, 2021

Purchasers: SAHIN YALBIRDAK & CAGLA YALBIRDAK

Property: 12 of Plan -

Telephone Res. / Bus: / (416) 319-8799

Project: Pine Valley Forevergreen - Phase 1

Decor Advisor: Yolande Somerville

Model and Elevation: 50.03 B OAKGROVE

12. Electrical

Hood Fan ☐ White ☒ Stainless ☐ N/A

Above Kitchen Cabinet Light ☐ Yes ☒ No

Below Kitchen Cabinet Light ☐ Yes ☒ No

Standard Appliances ☒

Over The Range Microwave ☐

Chimney Style Fan ☒

Comment

13. Heating and Air Conditioning

Air Conditioning

Gas Provisions Stove

Gas Provisions Dryer

Gas Provisions Barbecue

Comment

14. Additional Comments


15. Disclaimers and Notes

- 1) Colours of all materials are as close as possible to builder's selection, but not necessarily identical due to variances in manufacturing.
- 2) Any extras listed above are null and void unless accompanied by a separate invoice/amendment. Said invoice must be paid in full.
- 3) The Purchaser acknowledges that after Interior Colour Selection form is signed and dated, no further changes will be permitted other than re-selection due to unavailability. _____ Purchaser's Initials
- 4) The Purchaser acknowledges reading and accepting the "Gold Park Homes Decor Centre Disclaimers" form. This document contains other miscellaneous disclaimers.

This Interior Colour Selection is final and approved by:

Signature:  Date: Jan 28, 2021



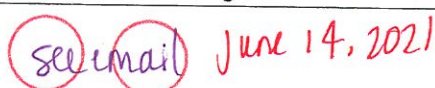



PV-12 Cabinetry Schedule

ROOM	DESCRIPTION	PRICE	QTY	TOTAL
KITCHEN	RETURN TRIP FOR HARDWOOD FLOOR IN KITCHEN			\$
	STANDARD APPLIANCE OPENINGS			\$
	NOTE: ELECTRICAL WILL NOT MATCH STANDARD CABINETRY LAYOUT, MAY HAVE ELECTRICAL CUT INTO BACK OF STANDARD CABINETRY		1	\$
CABINETRY TOTAL:				\$

LOT #: PV-12

DATE: Jan. 28, 2021

SIGNATURE:

SIGNATURE:



SCHEDULE 'F'


PV-12
Oct 2 2020

PV-12 *see attached*
Dec. 22, 2020

PV-12 *SY Qy*
Jan 28, 2021

The Oakgrove 50' SERIES

Elevation A • 3,920 sq.ft.
→ Elevation B • 3,905 sq.ft.
Elevation C • 3,915 sq.ft.

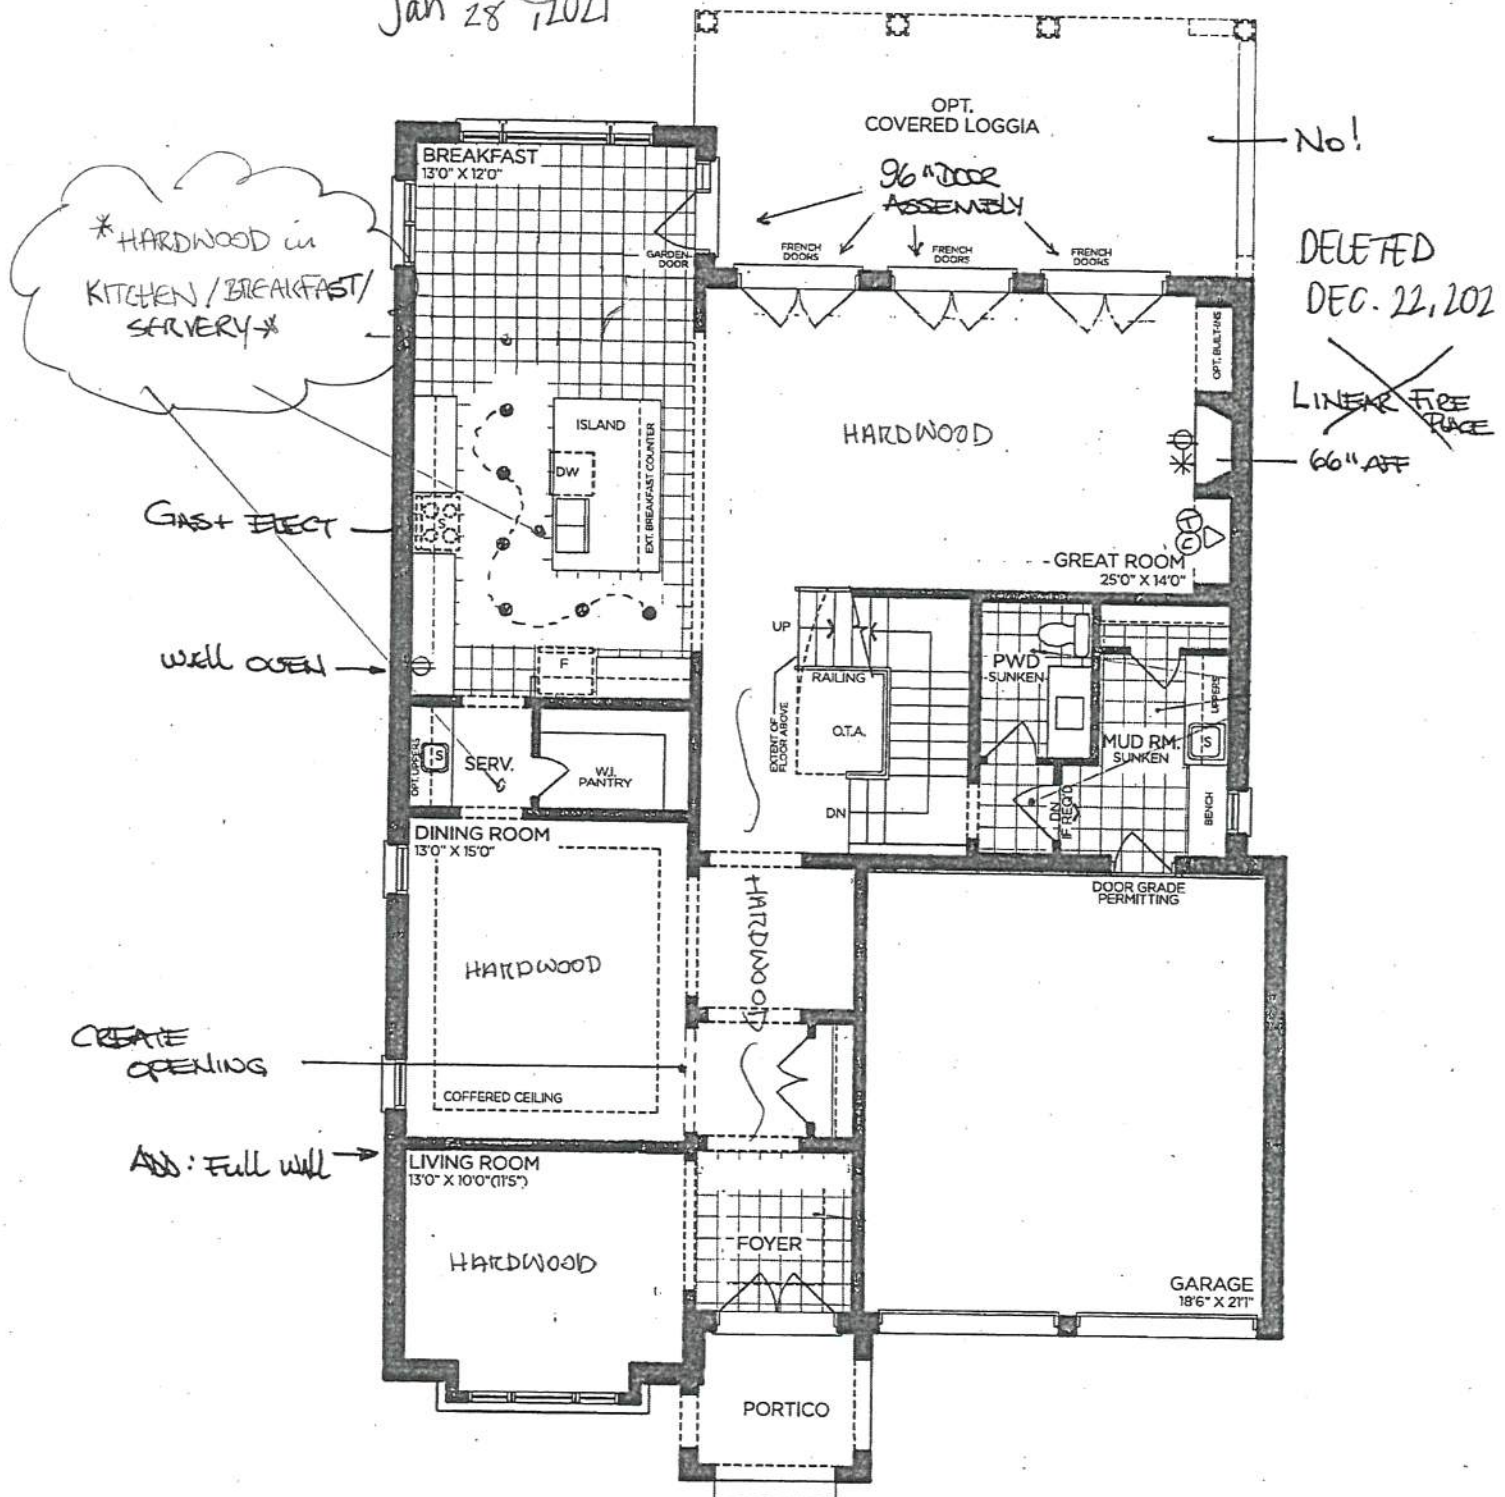

GROUND FLOOR | ELEV. A

VENDOR

PURCHASER

PURCHASER

GOLDPARK
WORTH MORE™

Prices, figures, illustrations, sizes, features and finishes are subject to change without notice. Areas and dimensions are approximate and actual usable floor space may vary from the stated area. Layout may be reverse of the unit purchased. E. & O.E. 5003

SCHEDULE 'F'



PV-12
OCT 2 2020

PV-12 *see attached*

Dec. 22, 2020


PV-12 *SY CH*
Jan 28, 2021

The Oakgrove 50' SERIES

Elevation A • 3,920 sq.ft.

→ Elevation B • 3,905 sq.ft.

Elevation C • 3,915 sq.ft.

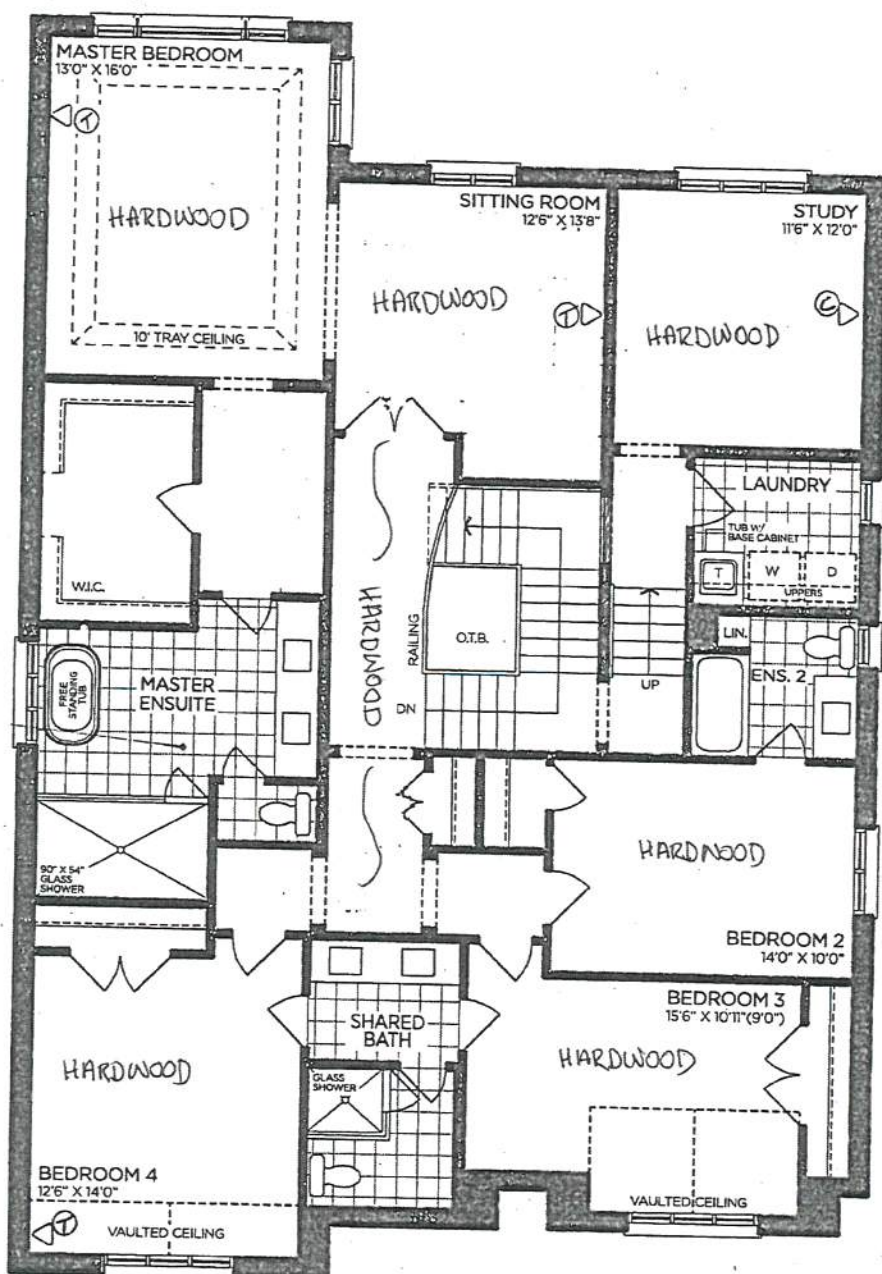

SECOND FLOOR | ELEV. A

VENDOR	
PURCHASER	
PURCHASER	

GOLDPARK
WORTH MORE™

Prices, figures, illustrations, sizes, features and finishes are subject to change without notice. Areas and dimensions are approximate and actual usable floor space may vary from the stated area. Layout may be reverse of the unit purchased. E. & O.E. 5003

SCHEDULE 'F'




PV-12
OCT 2 2020 54 C4

PV-12 54 C4
Dec. 22, 2020

PV-12 54 C4
Jan 28, 2021

The Oakgrove 50' SERIES

Elevation A • 3,920 sq.ft.
Elevation B • 3,905 sq.ft.
Elevation C • 3,915 sq.ft.

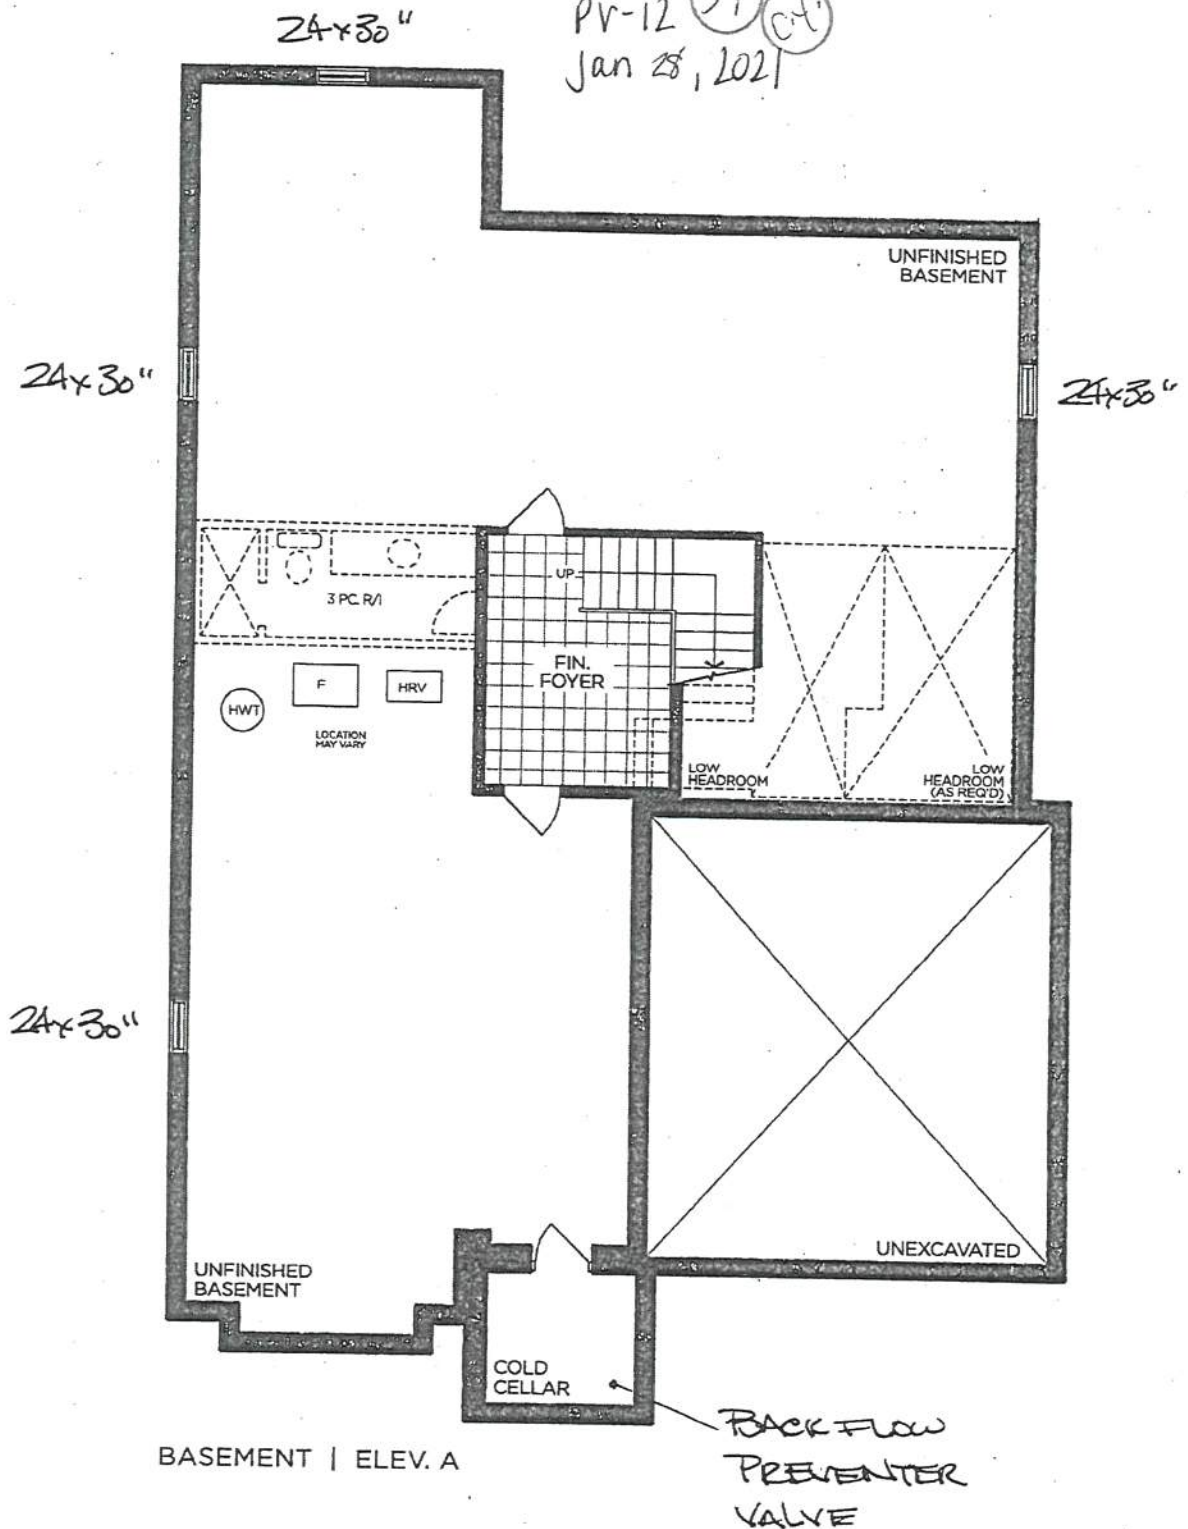

VENDOR

PURCHASER

PURCHASER

GOLDPARK
WORTH MORE™

Prices, figures, illustrations, sizes, features and finishes are subject to change without notice. Areas and dimensions are approximate and actual usable floor space may vary from the stated area. Layout may be reverse of the unit purchased. E. & O.E. 5003

SCHEDULE 'F'




PV-12
Oct 2 2020 (SY) (CA)

PV-12 ~~see attached~~
Dec. 22, 2020


PV-12 (SY) (CA)
Jan 28, 2021

The Oakgrove 50' SERIES


Elevation A • 3,920 sq.ft.
→ Elevation B • 3,905 sq.ft.
Elevation C • 3,915 sq.ft.

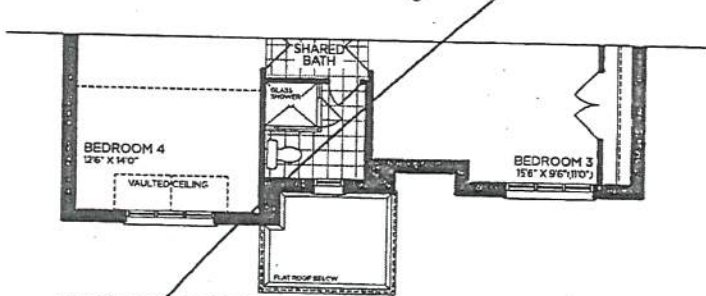


PART. OPT. SECOND FLOOR | ELEV. B
5 BEDROOM

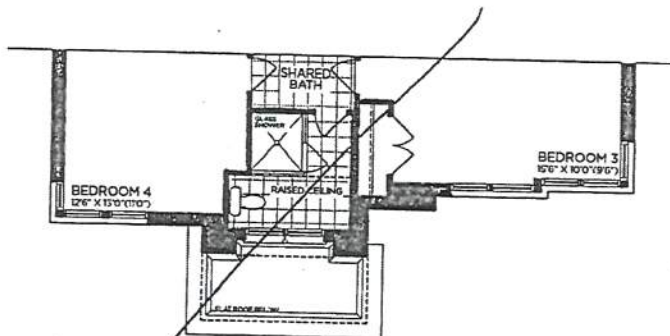


PART. OPT. SECOND FLOOR | ELEV. C
5 BEDROOM

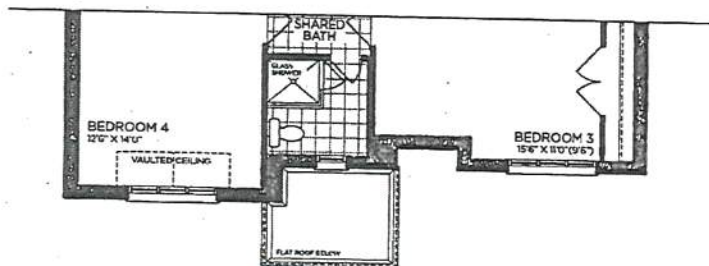


→ PART. SECOND FLOOR | ELEV. B

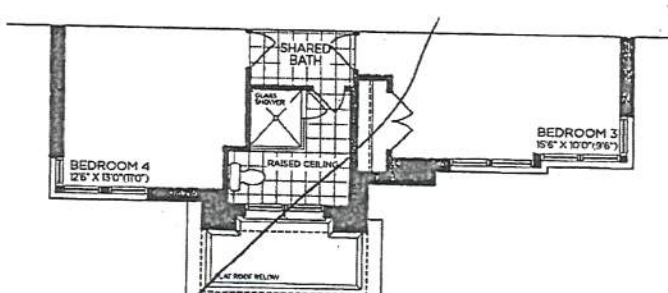


PART. SECOND FLOOR | ELEV. C

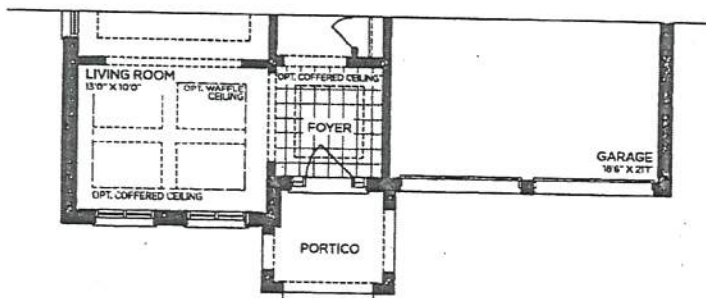


→ PART. GROUND FLOOR | ELEV. B

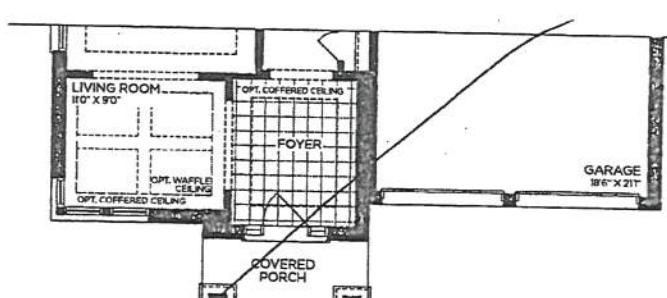

PART. GROUND FLOOR | ELEV. C

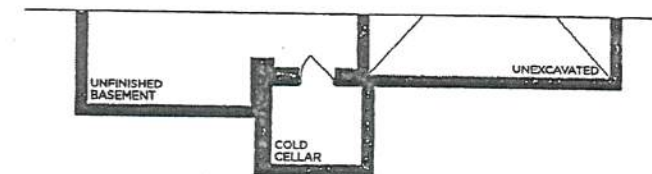

→ PART. BASEMENT | ELEV. B

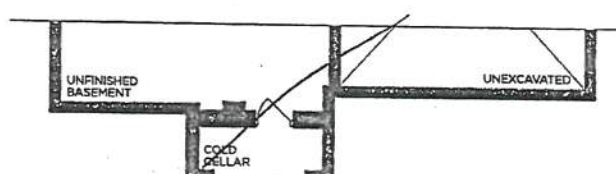

PART. BASEMENT | ELEV. C

VENDOR
PURCHASER
PURCHASER

GOLDPARK
WORTH MORE™

Prices, figures, illustrations, sizes, features and finishes are subject to change without notice. Areas and dimensions are approximate and actual usable floor space may vary from the stated area. Layout may be reverse of the unit purchased. E. & O.E. 5003



54

- * Standard Layout
- * Standard Appliance Openings

10' CEILING - 12"H COFFERED CEILING -
M.H. = 102" + 3/4"H TEMPORARY
MOLDING + 5 1/4"H FURRING RAIL
+ LARGE CORNICE MOLDING TO
UNDERSIDE OF BOX

K002-03

Return trip for hardwood.

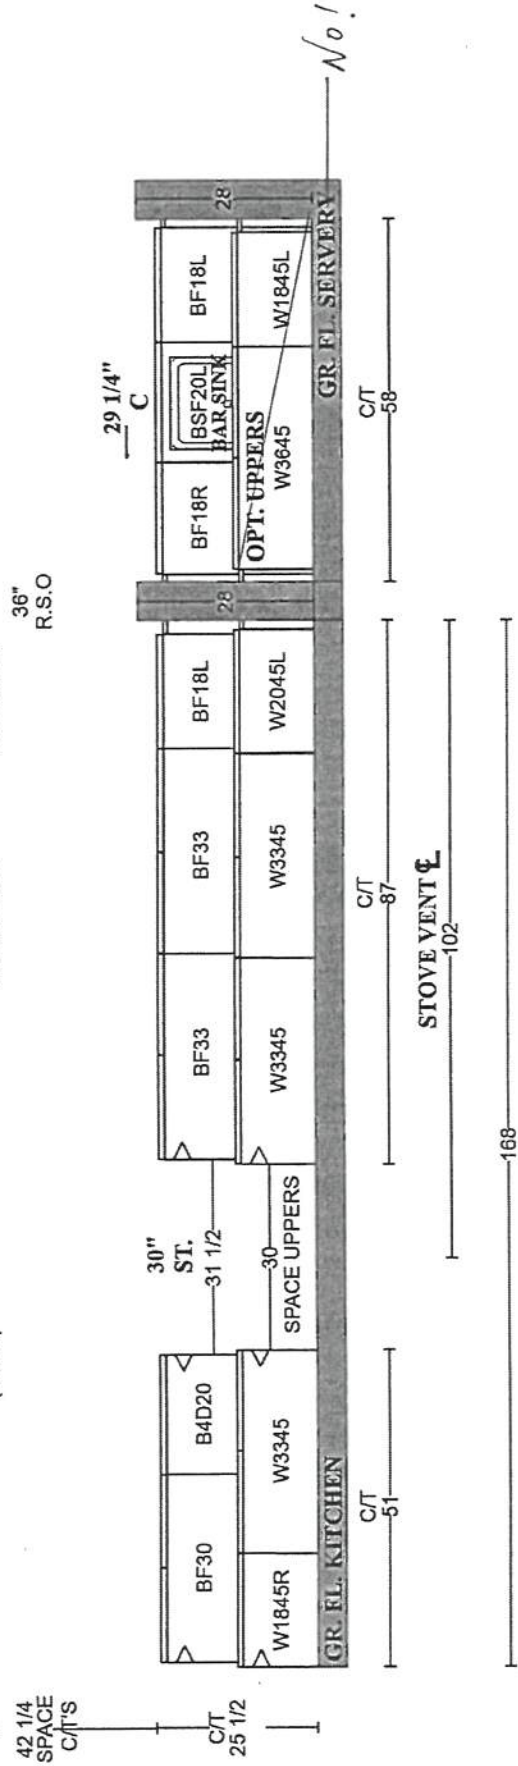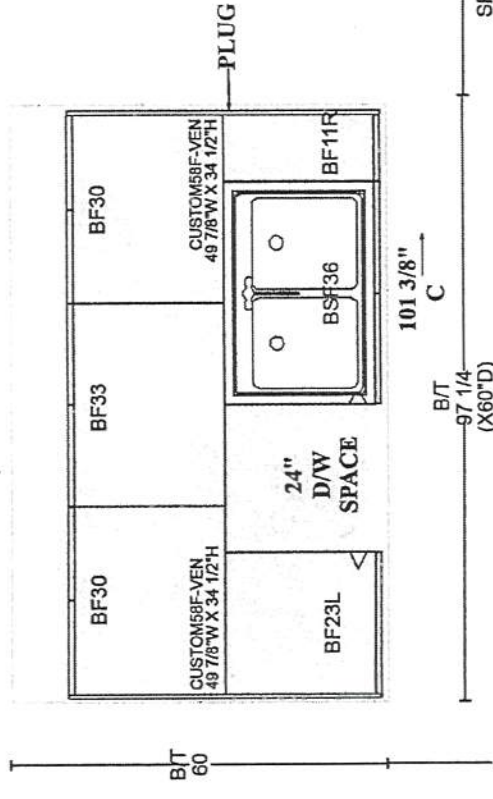

PLAN VIEW

PN-12

Jan 28, 2021

GOLDPARK HOMES
PINE VALLEY
VAUGHAN, ONTARIO
MODEL: (5003) OAKGROVE

SITE STANDARD: WHITE 3/4" EXTENSION
SOFT-CLOSE DRAWERS & STANDARD SLAM DOOR HINGES
TO VANITIES






ONE TOP DRAWER WHERE POSSIBLE THROUGHOUT EACH
VANITY, ONE BANK OF DRAWERS WHERE POSSIBLE
THROUGHOUT EACH MASTER ENSUITE VANITY

(CJ)

(SY)

chesapeake 'Classic White'
K002-05


chesapeake 'Classic White'
K002-05

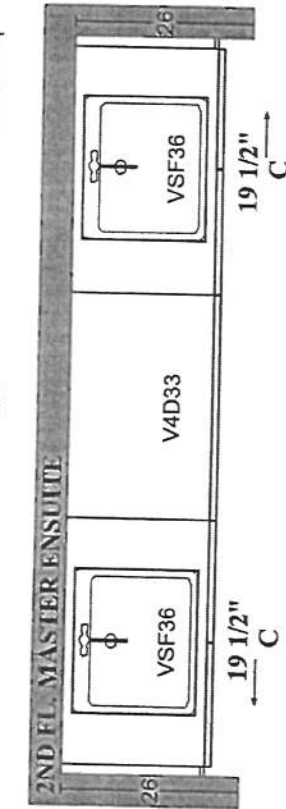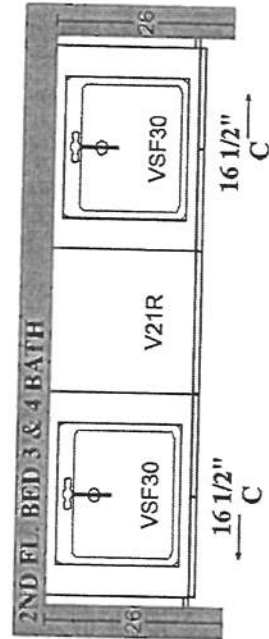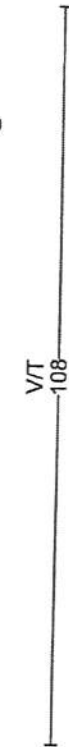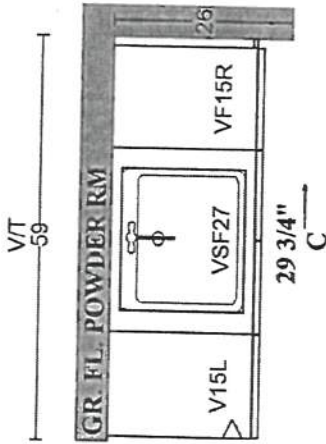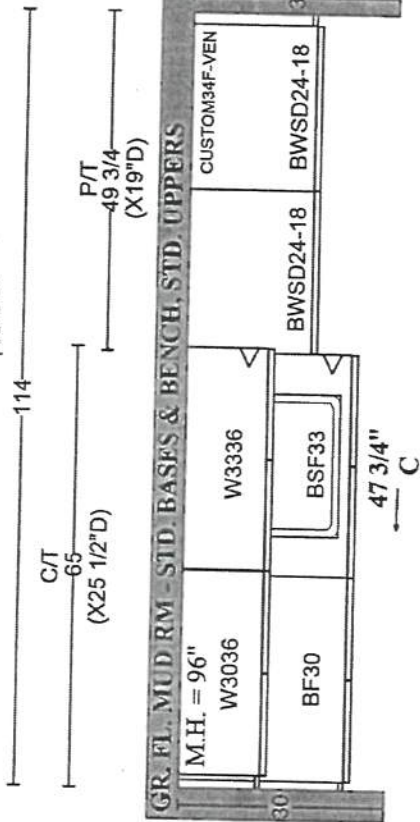

chesapeake 'Classic White'
K002-05

chesapeake 'Classic White'
No hardware

chesapeake 'Classic White'
No hardware

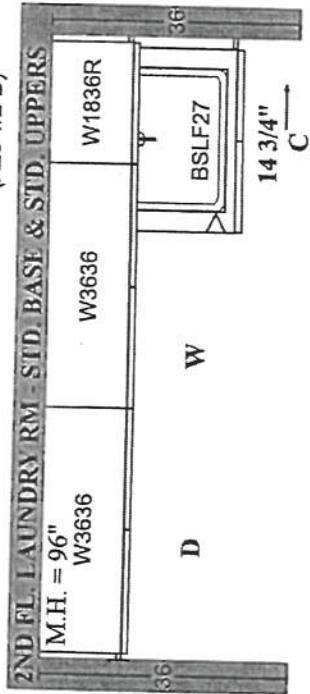

chesapeake 'Classic White'
K002-05

PLAN VIEW

STONE COUNTERTOP EDGE PROFILES



STANDARD 2CM EASED EDGE


LOCATION:

THRU OUT




UPGRADE 3CM EASED EDGE


LOCATION:

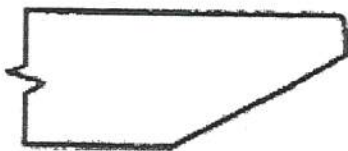

UPGRADE 4CM MITRED EDGE

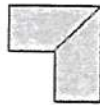

LOCATION:

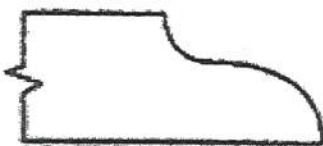



UPGRADE 2CM OGEE EDGE

LOCATION:

LOT #: PV-12

DATE: Jan 28 12021

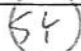SIGNATURE: 

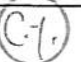SIGNATURE: 

STANDARD HARDWARE / KNOBS



☐ K002-02



☒ K002-03
→ Kitchen



☐ K002-04



☐ K002-06



☒ K002-05

→ Mud Room
→ Powder Room
→ Ensuite 2
→ Laundry Room



☐ K002-14



☐ K024-03

☒ *NO HARDWARE

→ Master Ensuite
→ Shared Ensuite

LOT # PV-12

DATE: Jan 28, 2021

SIGNATURE:

SV

SIGNATURE:


C.Y.

STANDARD SHOWER HARDWARE



SDK106

Shower Door Knob

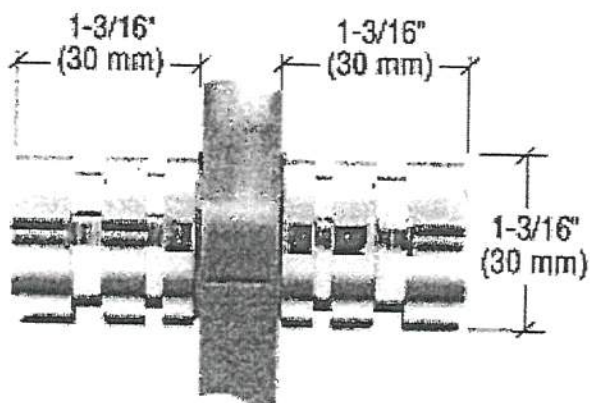

SDK106
Shower Door Knob

1-3/16" dia.
Contemporary Style
(Also available single sided)


CHROME

Lot# PV-12	Date: Jan 28, 2021	Room: Master Ensuite, Shared Ensuite
Signature:		
Signature:		

BATHROOM ACCESSORIES



Tissue Holder
Mason - Chrome

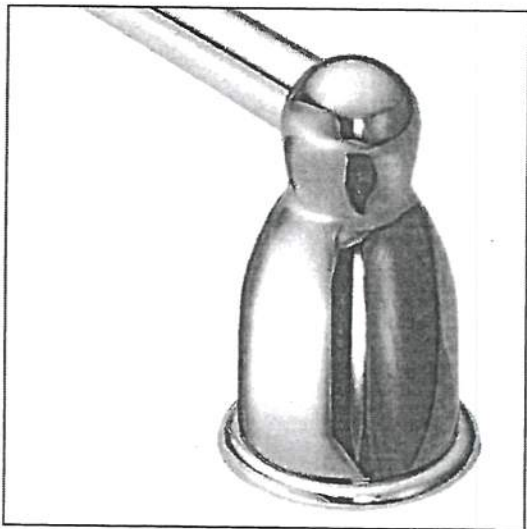

Towel Bar
Mason - Chrome

Please select one of the following:

- ☐ INSTALL STANDARD BATHROOM ACCESSORIES THRU OUT
(tissue holder + towel bar) **location as per vendors discretion**
- ☒ ***DO NOT*** INSTALL STANDARD BATHROOM ACCESSORIES
THRU OUT **tissue holder + towel bar will not be provided**

LOT # PV-12

DATE: Jan 28, 2021

SIGNATURE:

SY

SIGNATURE:

CW