



CONSTRUCTION SUMMARY

Lot: 19
Model: 40.01 B SUMMERDALE
Project/Phase: Pine Valley Forevergreen / 1

APPLIANCES

Invoice	Qty.	Description
2725 72,217 04May21 **	1	KITCHEN - UPGRADE TO 8" DUCT (EXTERIOR WALL) IN LIEU OF STANDARD OFFERING

BASEMENT WINDOWS

Invoice	Qty.	Description
2725 72,351 04May21	3	BASEMENT WINDOWS - UPGRADE BASEMENT WINDOW SIZE TO 30 " X 24" - 8" FRAME

CERAMIC

Invoice	Qty.	Description
2725 04May21 NoCat	1	MASTER ENSUITE / MAIN BATH / ENSUITE 2: SHOWER NICHE [SHAMPOO SHELF] - COMPLETE WITH MATCHING MARBLE JAMBS ON 4 SIDES, STANDARD TILE, APPROX. 12 X 18 INSTALLED VERTICALLY
2780 32 24Jun21	1	POWDER ROOM: TILE, FLOOR - LEVEL 4 - 12x24" LAID IN STRAIGHT STACKED PATTERN - SEE PLAN FOR DIRECTION
2780 35 24Jun21	1	MASTER ENSUITE: TILE, FLOOR - LEVEL 3 - 12x24" LAID IN STRAIGHT STACKED PATTERN - SEE PLAN FOR DIRECTION
2780 49 24Jun21	1	MASTER ENSUITE: TILE, WALL, LEVEL 2 - 8x24" LAID IN STRAIGHT HORIZONTAL PATTERN
2780 36 24Jun21	1	ENSUITE 2: TILE, FLOOR , LEVEL 4 - 12X24" LAID IN STRAIGHT, STACKED PATTERN. SEE PLAN FOR TILE DIRECTION
2780 32 24Jun21	1	MAIN BATH: TILE, FLOOR , LEVEL 1 - 8X8" LAID IN STRAIGHT, STACKED PATTERN.
2780 24Jun21 NoCat	1	KITCHEN/BREAKFAST: VINTAGE SERIES, 5" WHITE OAK, NSS ENGINEERED HARDWOOD, 3/4" THK, SCULPTED TEXTURE, UVF FINISH - LEVEL 4 KITCHEN/BREAKFAST: DO NOT SUPPLY / INSTALL CERAMIC - CREDIT
2780 24Jun21 NoCat	1	FOYER: VINTAGE SERIES, 5" WHITE OAK, NSS ENGINEERED HARDWOOD, 3/4" THK, SCULPTED TEXTURE, UVF FINISH - LEVEL 4 FOYER: DO NOT SUPPLY / INSTALL CERAMIC - CREDIT

CONCRETE AND DRAIN

Invoice	Qty.	Description
2725 04May21 NoCat	1	BACK-FLOW PREVENTER VALVE



CONSTRUCTION SUMMARY

Lot: 19
Model: 40.01 B SUMMERDALE
Project/Phase: Pine Valley Forevergreen / 1

DRYWALL

Invoice	Qty.	Description
2725 72,351 04May21 **	3	BASEMENT WINDOWS - UPGRADE BASEMENT WINDOW SIZE TO 30 " X 24" - 8" FRAME
2725 72,690 04May21 **	1	DELETE KITCHEN BULKHEAD, IF POSSIBLE, SITE APPROVAL REQUIRED WILL BE A GAP APPROX.12"H TO CEILING IF NO ADDITIONAL CABINETRY IS PURCHASED
2725 04May21 NoCat	1	MASTER ENSUITE / MAIN BATH / ENSUITE 2: SHOWER NICHE [SHAMPOO SHELF] - COMPLETE WITH MATCHING MARBLE JAMBS ON 4 SIDES, STANDARD TILE, APPROX. 12 X 18 INSTALLED VERTICALLY
2725 04May21 NoCat	1	**CUSTOM LAYOUT** MASTER ENSUITE: DELETE WATER CLOSET AND ADJUST VANITY/WIC WALL TO BE STRAIGHT (NOT JOGGED). ADD FULL HEIGHT NIBB WALL BETWEEN VANITY/TOILET. CONTINUE CLOSET ROD/SHELF - SEE PLAN FOR LOCATION INCLUDED IN APS BASED ON STANDARD FINISHES

ELECTRICAL

Invoice	Qty.	Description
2725 72,351 04May21 **	3	BASEMENT WINDOWS - UPGRADE BASEMENT WINDOW SIZE TO 30 " X 24" - 8" FRAME
2725 72,292 04May21	1	FRONT PORCH: ADDITIONAL EXTERIOR COACH LIGHT ON SAME SWITCH (BUILDERS STANDARD FIXTURE) - LOCATE OPPOSITE SIDE OF DOOR AS STANDARD - SAME HEIGHT AND SWITCH AS STANDARD
2725 72,281 04May21	1	FAMILY ROOM: INTERIOR WALL OUTLET: ADDITIONAL 110V WALL INTERIOR RECEPTACLE ON EXISTING CIRCUIT FOR WALL MOUNTED TV - LOCATE ABOVE FIREPLACE, APPROX 64" A.F.F.
2725 72,281 04May21	1	FAMILY ROOM: INTERIOR WALL OUTLET: ADDITIONAL 110V WALL INTERIOR RECEPTACLE ON EXISTING CIRCUIT FOR WALL MOUNTED TV - LOCATE APPROX 48" A.F.F. SEE PLAN FOR LOCATION
2725 72,292 04May21	1	REAR GARDEN DOOR: ADDITIONAL EXTERIOR COACH LIGHT ON SAME SWITCH (BUILDERS STANDARD FIXTURE) - LOCATE OPPOSITE SIDE AS STANDARD, SAME HEIGHT AND SWITCH AS STANDARD
2725 72,273 04May21	1	KITCHEN: 110V WALL RECEPTACLE ON SEPARATE CIRCUIT - GAS FIRED APPLIANCE - FOR AUX. EQUIPMENT - NOT A STOVE PLUG
2725 72,272 04May21	1	KITCHEN: 110V WALL RECEPTACLE ON SEPARATE CIRCUIT - FOR MICROWAVE - MICROWAVE NOT INCLUDED SEE PLAN FOR LOCATION
2725 72,272 04May21	1	KITCHEN: 110V WALL RECEPTACLE ON SEPARATE CIRCUIT - FOR BEVERAGE FRIDGE - APPLIANCE NOT INCLUDED
2725 72,307 04May21	1	KITCHEN: FIXTURE: RELOCATE STANDARD CEILING MOUNT FIXTURE TO APPROX CENTER ABOVE ISLAND
2725 72,307 04May21	1	UPPER HALL ABOVE STAIRS: FIXTURE: RELOCATE STANDARD CEILING MOUNT FIXTURE - TO APPROX CENTER AT "OTB"
2725 72,307 04May21	1	MASTER BEDROOM: FIXTURE: RELOCATE STANDARD CEILING MOUNT FIXTURE TO APPROX CENTER ABOVE TUB
2725 72,289 04May21	6	MAIN HALL: 4" E/S LED INTERIOR POT LIGHT - GROUND FLOOR - EACH - IN LIEU OF STANDARD LIGHTS - INCLUDE INCLUDED IN APS
2725 04May21 NoCat	1	KITCHEN: INSTALL VAC PAN UNDER KITCHEN SINK



CONSTRUCTION SUMMARY

Lot: 19
Model: 40.01 B SUMMERDALE
Project/Phase: Pine Valley Forevergreen / 1

ELECTRICAL

Invoice	Qty.	Description
2725 04May21 NoCat	1	**CUSTOM LAYOUT** MASTER ENSUITE: DELETE WATER CLOSET AND ADJUST VANITY/WIC WALL TO BE STRAIGHT (NOT JOGGED). ADD FULL HEIGHT NIBB WALL BETWEEN VANITY/TOILET. CONTINUE CLOSET ROD/SHELF - SEE PLAN FOR LOCATION INCLUDED IN APS BASED ON STANDARD FINISHES

FRAMING

Invoice	Qty.	Description
2725 72,631 04May21	3	MASTER ENSUITE / MAIN BATH / ENSUITE 2: SHOWER NICHE [SHAMPOO SHELF] - COMPLETE WITH MATCHING MARBLE JAMBS ON 4 SIDES, STANDARD TILE, APPROX. 12 X 18 INSTALLED VERTICALLY
2725 04May21 NoCat	1	**CUSTOM LAYOUT** MASTER ENSUITE: DELETE WATER CLOSET AND ADJUST VANITY/WIC WALL TO BE STRAIGHT (NOT JOGGED). ADD FULL HEIGHT NIBB WALL BETWEEN VANITY/TOILET. CONTINUE CLOSET ROD/SHELF - SEE PLAN FOR LOCATION INCLUDED IN APS BASED ON STANDARD FINISHES
2725 72,690 04May21	1	DELETE KITCHEN BULKHEAD, IF POSSIBLE, SITE APPROVAL REQUIRED WILL BE A GAP APPROX.12"H TO CEILING IF NO ADDITIONAL CABINETRY IS PURCHASED
2725 04May21 NoCat	1	FRONT PORCH: ADDITIONAL EXTERIOR COACH LIGHT ON SAME SWITCH (BUILDERS STANDARD FIXTURE) - LOCATE OPPOSITE SIDE OF DOOR AS STANDARD - SAME HEIGHT AND SWITCH AS STANDARD
2725 04May21 NoCat	1	REAR GARDEN DOOR: ADDITIONAL EXTERIOR COACH LIGHT ON SAME SWITCH (BUILDERS STANDARD FIXTURE) - LOCATE OPPOSITE SIDE AS STANDARD, SAME HEIGHT AND SWITCH AS STANDARD

GLASS AND MIRROR

Invoice	Qty.	Description
2780 24Jun21 NoCat	2	MASTER ENSUITE + ENSUITE 2: UPGRADE SHOWER DOOR HANDLE - CHROME
2780 101,930 24Jun21	1	NOTE: ***THRU-OUT DO NOT INSTALL MIRRORS***

GRANITE MARBLE QUARTZ

Invoice	Qty.	Description
2780 24Jun21 NoCat	1	MASTER ENSUITE: UPGRADE QUARTZ COUNTERTOP - LEVEL 2



CONSTRUCTION SUMMARY

Lot: 19
Model: 40.01 B SUMMERDALE
Project/Phase: Pine Valley Forevergreen / 1

HARDWOOD

Invoice	Qty.	Description
2780 7 24Jun21	1	KITCHEN/BREAKFAST: VINTAGE SERIES, 5" WHITE OAK, NSS ENGINEERED HARDWOOD, 3/4" THK, SCULPTED TEXTURE, UVF FINISH - LEVEL 4
2780 7 24Jun21	1	THRU OUT STANDARD AREAS: MAIN HALL, GREAT ROOM, DINING ROOM, STUDY, UPPER HALL / COMPUTER NICHE, MASTER BEDROOM, BEDROOM 2, BEDROOM 3, BEDROOM 4 - VINTAGE SERIES, 5" WHITE OAK, NSS ENGINEERED HARDWOOD, 3/4" THK, SCULPTED TEXTURE, UVF FINISH - LEVEL 4
2780 7 24Jun21	1	FOYER: VINTAGE SERIES, 5" WHITE OAK, NSS ENGINEERED HARDWOOD, 3/4" THK, SCULPTED TEXTURE, UVF FINISH - LEVEL 4

HVAC

Invoice	Qty.	Description
2725 72,224 04May21	1	KITCHEN: GAS LINE ROUGH-IN - MAIN FLOOR FOR GAS APPLIANCE - SEE PLAN FOR APPROXIMATE LOCATION. FINAL LOCATION/ORIENTATION IS TO BE COMPLETED BY A LICENSED GAS FITTER AND ARRANGED BY HOME OWNER AFTER CLOSING
2725 72,217 04May21	1	KITCHEN - UPGRADE TO 8" DUCT (EXTERIOR WALL) IN LIEU OF STANDARD OFFERING
2725 72,690 04May21 **	1	DELETE KITCHEN BULKHEAD, IF POSSIBLE, SITE APPROVAL REQUIRED WILL BE A GAP APPROX.12"H TO CEILING IF NO ADDITIONAL CABINETRY IS PURCHASED
2725 04May21 NoCat	1	KITCHEN: INSTALL VAC PAN UNDER KITCHEN SINK

INTERIOR TRIM AND DOORS

Invoice	Qty.	Description
2725 04May21 NoCat	1	**CUSTOM LAYOUT** MASTER ENSUITE: DELETE WATER CLOSET AND ADJUST VANITY/WIC WALL TO BE STRAIGHT (NOT JOGGED). ADD FULL HEIGHT NIBB WALL BETWEEN VANITY/TOILET. CONTINUE CLOSET ROD/SHELF - SEE PLAN FOR LOCATION INCLUDED IN APS BASED ON STANDARD FINISHES

KITCHEN AND BATH CABINETRY

Invoice	Qty.	Description
2725 72,217 04May21 **	1	KITCHEN - UPGRADE TO 8" DUCT (EXTERIOR WALL) IN LIEU OF STANDARD OFFERING
2725 72,690 04May21 **	1	DELETE KITCHEN BULKHEAD, IF POSSIBLE, SITE APPROVAL REQUIRED WILL BE A GAP APPROX.12"H TO CEILING IF NO ADDITIONAL CABINETRY IS PURCHASED
2725 04May21 NoCat	1	FYI - KITCHEN - UPGRADE TO 8" DUCT (EXTERIOR WALL) IN LIEU OF STANDARD OFFERING
2725 04May21 NoCat	1	FYI - KITCHEN: INSTALL VAC PAN UNDER KITCHEN SINK
2725 04May21 NoCat	1	**CUSTOM LAYOUT** MASTER ENSUITE: DELETE WATER CLOSET AND ADJUST VANITY/WIC WALL TO BE STRAIGHT (NOT JOGGED). ADD FULL HEIGHT NIBB WALL BETWEEN VANITY/TOILET. CONTINUE CLOSET ROD/SHELF - SEE PLAN FOR LOCATION INCLUDED IN APS BASED ON STANDARD FINISHES
2780 24Jun21 NoCat	1	THRU OUT: SEE ATTACHED CABINETRY SCHEDULE

MASONRY

Invoice	Qty.	Description
2725 04May21 NoCat	1	FRONT PORCH: ADDITIONAL EXTERIOR COACH LIGHT ON SAME SWITCH (BUILDERS STANDARD FIXTURE) - LOCATE OPPOSITE SIDE OF DOOR AS STANDARD - SAME HEIGHT AND SWITCH AS STANDARD
2725 04May21 NoCat	1	REAR GARDEN DOOR: ADDITIONAL EXTERIOR COACH LIGHT ON SAME SWITCH (BUILDERS STANDARD FIXTURE) - LOCATE OPPOSITE SIDE AS STANDARD, SAME HEIGHT AND SWITCH AS STANDARD



CONSTRUCTION SUMMARY

Lot: 19
Model: 40.01 B SUMMERDALE
Project/Phase: Pine Valley Forevergreen / 1

NETWORK AND WIRING

Invoice	Qty.	Description
2725 72,256 04May21	1	FAMILY ROOM: ADDITIONAL RG6 HIGH SPEED TV / INTERNET OUTLETS - LOCATE APPROX 48" A.F.F. SEE PLAN FOR LOCATION
2725 72,258 04May21	3	BEDROOM 2 / BEDROOM 3 / BEDROOM 4: ADDITIONAL CAT6 ETHERNET OUTLET - EACH SEE PLAN FOR LOCATION
2725 72,264 04May21	2	MASTER BEDROOM + LAUNDRY ROOM: ROUGH - IN FOR EXTRA SECURITY KEY PAD
2725 72,261 04May21	1	KITCHEN: INSTALL VAC PAN UNDER KITCHEN SINK

PAINT

Invoice	Qty.	Description
2725 04May21 NoCat	1	**CUSTOM LAYOUT** MASTER ENSUITE: DELETE WATER CLOSET AND ADJUST VANITY/WIC WALL TO BE STRAIGHT (NOT JOGGED). ADD FULL HEIGHT NIBB WALL BETWEEN VANITY/TOILET. CONTINUE CLOSET ROD/SHELF - SEE PLAN FOR LOCATION INCLUDED IN APS BASED ON STANDARD FINISHES
2780 24Jun21 NoCat	2	MAIN STAIRS - 2ND FLOOR TO BASEMENT: STAIN STAIRS AND LANDINGS WILL NOT MATCH HARDWOOD IN COLOUR, SPECIES AND TEXTURE



CONSTRUCTION SUMMARY

Lot: 19
Model: 40.01 B SUMMERDALE
Project/Phase: Pine Valley Forevergreen / 1

PLUMBING

Invoice	Qty.	Description
2725 72,332 04May21	1	KITCHEN: ROUGH-IN 1/4" COLD WATER LINE TO FRIDGE
2725 04May21 NoCat	1	ENSUITE 2: MOEN 'ALIGN' RAIN SHOWER + HAND SHOWER/SLIDE BAR - CHROME
2725 04May21 NoCat	1	MASTER ENSUITE: MOEN 'FLARA' RAIN SHOWER + HAND SHOWER/SLIDE BAR
2725 04May21 NoCat	2	MASTER ENSUITE: MOEN 'FLARA' 2 HANDLE, HIGH ARC LAV FAUCET
2725 04May21 NoCat	1	MAIN BATH: MOEN 90* SHOWER + TOE TESTER -CHROME
2725 04May21 NoCat	1	**NOTE** MASTER ENSUITE / MAIN BATH / ENSUITE 2: RAISE ALL SHOWER HEADS TO APPROX 7'-0" A.F.F. IN LIEU OF STANDARD HEIGHT

WINDOWS AND DOORS

Invoice	Qty.	Description
2725 72,351 04May21 **	3	BASEMENT WINDOWS - UPGRADE BASEMENT WINDOW SIZE TO 30 " X 24" - 8" FRAME


PV - 19 Cabinetry Schedule

ROOM	DESCRIPTION	PRICE	QTY	TOTAL
KITCHEN	RETURN TRIP FOR HARDWOOD		1	
MASTER ENSUITE	UPGRADE FROM SERIES 2 TO SERIES 3 - CHELSEA HI GLOSS GREY		1	
CABINETRY TOTAL:				

NOTE: NO HARDWARE / NO HOLES THRU OUT - PURCHASER IS RESPONSIBLE FOR THE INSTALLATION OF THEIR HARDWARE AFTER CLOSING AT THEIR OWN EXPENSE AND WARRANTY

LOT #: PV-19

DATE: June 21, 2021

SIGNATURE:  * see attach. *

SIGNATURE:

Project: Pine Valley Lot 19

Purchaser: Marianna Mackey

Purchaser: _____

It is highly recommended that purchasers provide their appliance specifications at the time of their structural and/or colours appointment to determine if any custom sizing of cabinets is required. If appliance specifications are not received by the time of their final appointment we will proceed with the following:


Standard Appliance Openings

1. Range approx. 31-1/2"
2. Fridge approx. 36" x 72"
3. Dishwasher approx. 24"

We accept and acknowledge that the builder will leave standard openings as per above "Standard Appliance Opening".

We understand to accommodate upgraded appliances, all appliance specifications must be provided at the time of our structural and/or colours appointment. Failure to complete the above-mentioned, may result in the need to revert to the "Standard Appliance Openings".

Should changes be required, a cost of \$500.00 to reopen your file is required and may result in a delay in construction of your home. As a result, we may be forced to extend the closing of your transaction. At no fault of our own, we reserve our right to hold you responsible for this delayed closing; which may include extra administration fees and interest upon balance due on closing.

LOT #: <u>PV-19</u>	DATE: <u>June 21, 2021</u>
SIGNATURE:  * see attach *	
SIGNATURE: _____	

7V-19


June 21, 2021

* ~~Set~~ attach. *

* standard kitchen *

* Standard Appliance Openings *

→ Hardwood in Kitchen.

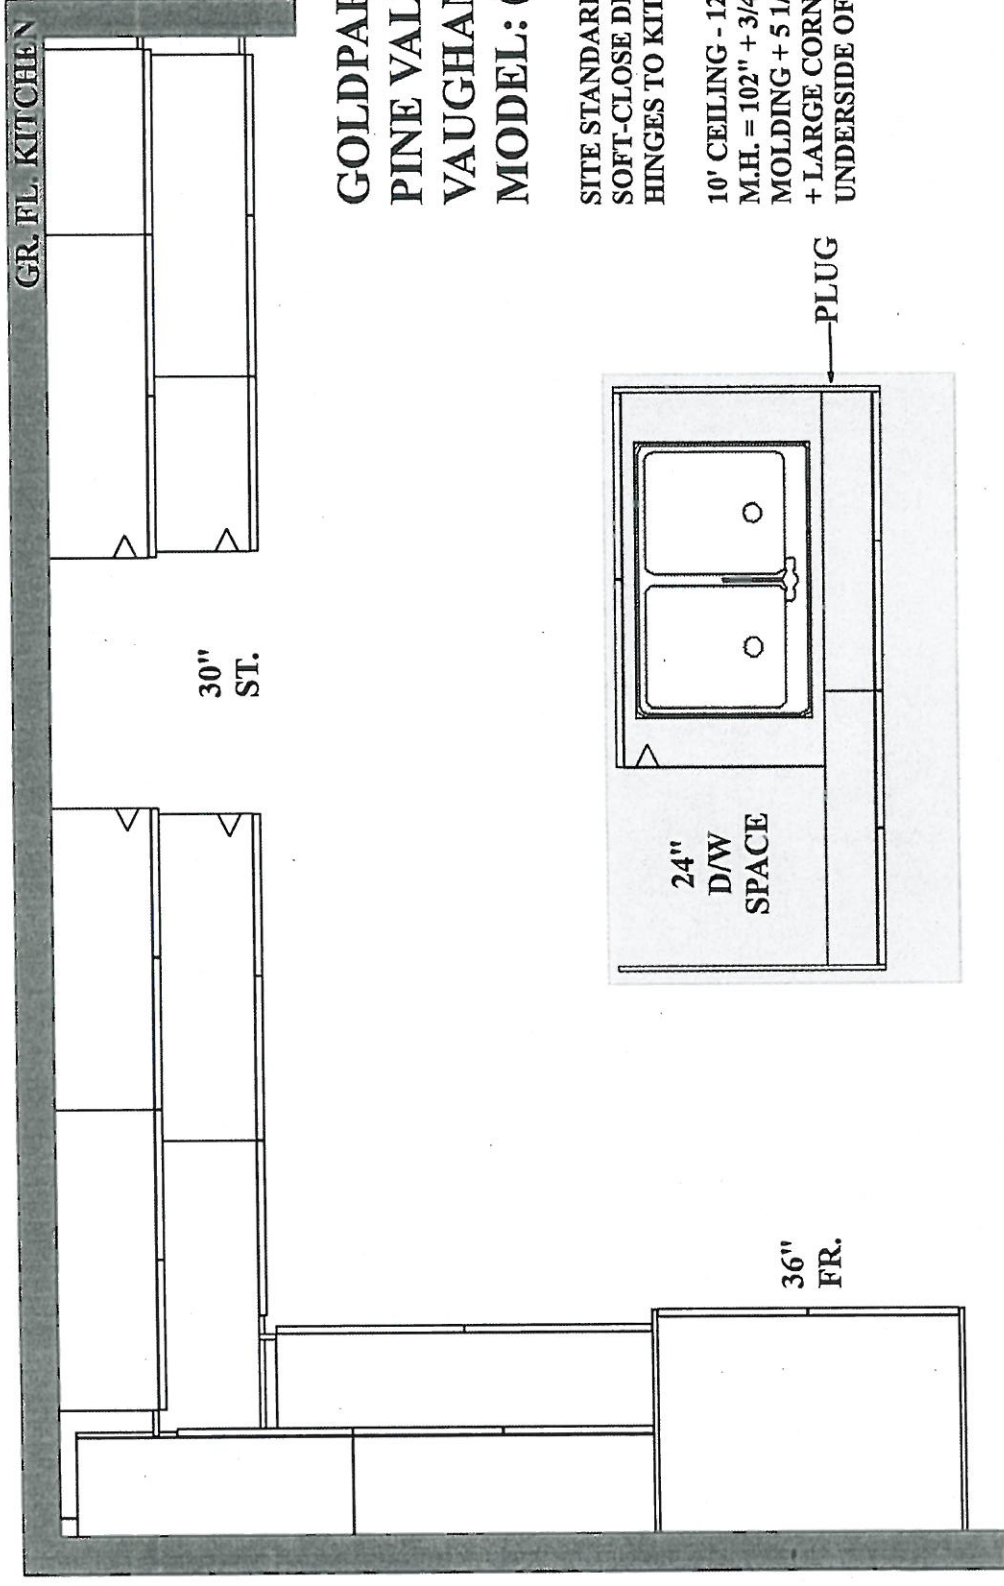

**GOLDPARK HOMES
PINE VALLEY
VAUGHAN, ONTARIO
MODEL: (4001) SUMMERDALE**

SITE STANDARD: WHITE 3/4" EXTENSION
SOFT-CLOSE DRAWERS & SOFT-CLOSE
HINGES TO KITCHEN AREA

10' CEILING - 12"H COFFERED CEILING -
M.H. = 102" + 3/4"H CONTEMPORARY
MOLDING + 5 1/4"H FURRING RAIL
+ LARGE CORNICE MOLDING TO
UNDERSIDE OF BOX





PLAN VIEW

PV-19
June 21, 2021
See attach.


GOLDPARK HOMES
PINE VALLEY
VAUGHAN, ONTARIO
MODEL: (4001) SUMMERDALE

SITE STANDARD: WHITE 3/4" EXTENSION
SOFT-CLOSE DRAWERS & STANDARD SLAM DOOR HINGES
TO VANITIES


ONE TOP DRAWER WHERE POSSIBLE THROUGHOUT EACH
VANITY, ONE BANK OF DRAWERS WHERE POSSIBLE
THROUGHOUT EACH MASTER ENSUITE VANITY

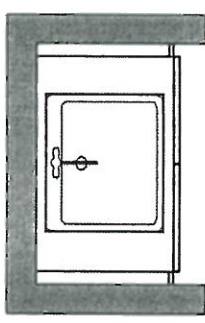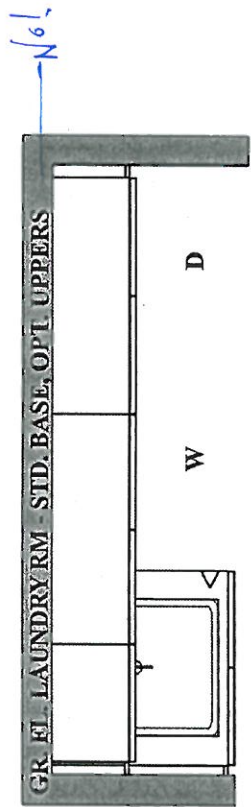


GR. FL. SUNKEN
POWDER RM

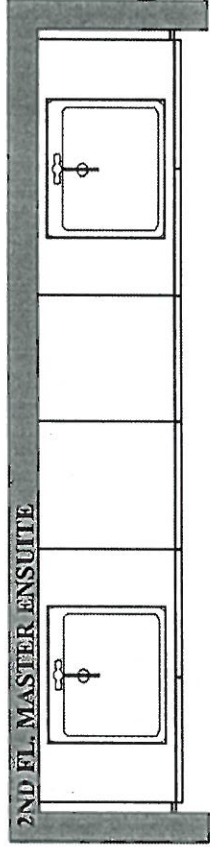

2ND FL. MASTER ENSUITE

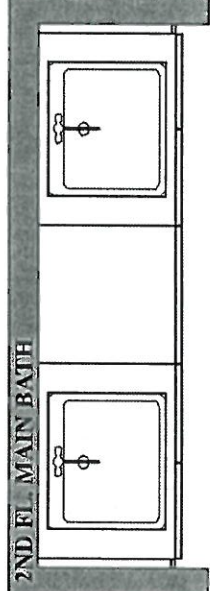

2ND FL. MAIN BATH

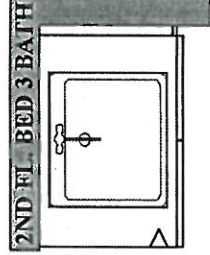

2ND FL. BED 3 BATH



Purchaser: MARIANNA MACKEY

Property: 19 of Plan -

Telephone Res. / Bus: /

Project: Pine Valley Forevergreen - Phase 1

Decor Advisor: Amanda Ceresino

Model and Elevation: 40.01 B SUMMERDALE

Layout Changes: ☒ Yes ☐ No

Sketch Attached: ☒ Yes ☐ No

Exterior Colour Scheme:

1. Cabinetry

	Style and Colour	Counter	Hardware
Kitchen / Breakfast	Chesapeake 'Classic White'	Granite: 'Arctic White'	attachd
Laundry Room	Bowery 'Fabro'	P-Lam 'White'	attachd
Powder Room	Bowery 'Fabro'	Quartz: 'Nordic Loft'	attachd
Main Bath	Bowery 'Fabro'	Quartz: 'Ice Snow'	attachd
Master Ensuite Bathroom	*Chelsea PET Hi-Gloss'Grey'	*Quartz: 'Misty Carrara'	attachd
Second Ensuite Bathroom (If Applicable)	Bowery 'Ello'	Quartz: 'Ice Snow'	attachd
<input type="text"/>	<input type="text"/>	<input type="text"/>	<input type="text"/>

Comment

2. Floor Tile

	Selection
Entrance Vestibule	*see hardwood
Main Hall	n/a
Kitchen / Breakfast	*see hardwood
Laundry Room	13x13" Serpentine 'Grey'
Powder Room	*12x24" Reve 'Fumee'
Main Bath	*8x8 Marakesh 'Anthracite' matte
Master Ensuite Bathroom	*12x24" Carrara X 'White' matte
Second Ensuite Bathroom (If Applicable)	*12x24" Reve 'Neige'
Lower Landing (If Applicable)	13x13" Serpentine 'Grey' (basement foyer)
<input type="text"/>	<input type="text"/>

Comment

Thru-out Shower Floor: 2x2" Standard 'White'

3. Wall Tile

	Selection	Listello/Inserts	Describe
	<input type="text"/>	<input type="radio"/> Yes <input checked="" type="radio"/> No	<input type="text"/>
Master Ensuite Bathroom			
Tub Deck	<input type="text"/>	<input type="radio"/> Yes <input checked="" type="radio"/> No	<input type="text"/>
Shower Stall	*8x24" Laguna Wave 'White'	<input type="radio"/> Yes <input checked="" type="radio"/> No	<input type="text"/>
Bathroom Walls	<input type="text"/>	<input type="radio"/> Yes <input checked="" type="radio"/> No	<input type="text"/>
Second Ensuite Bathroom (If Applicable)	8x10" Weave 'Tender Grey'	<input type="radio"/> Yes <input checked="" type="radio"/> No	<input type="text"/>
Main Bath	8x10" Weave 'White'	<input type="radio"/> Yes <input checked="" type="radio"/> No	<input type="text"/>
Kitchen Backsplash	<input type="radio"/> Yes <input checked="" type="radio"/> No	Backsplash Behind Fridge	<input type="text"/>
<input type="text"/>	<input type="text"/>		

Comment

*see attach *

Purchaser: MARIANNA MACKEY

Property: 19 of Plan -

Telephone Res. / Bus: /

Project: Pine Valley Forevergreen - Phase 1

Decor Advisor: Amanda Ceresino

Model and Elevation: 40.01 B SUMMERDALE

4. Plumbing Fixtures

Master Ensuite Bathroom Second Ensuite Powder Room
Other Room - Specify Other Washroom

Comment

5. Hardwood Flooring

	Type and Stain		Type and Stain
Main Hall	<input type="text"/>	Upper Landing	<input type="text"/>
Kitchen / Breakfast	*3/4x5" white oak sculpted 'Athena'	Upper Hall	<input type="text"/>
Living Room	<input type="text"/>	Master Bedroom	<input type="text"/>
Dining Room	<input type="text"/>	Bedroom #2	<input type="text"/>
Family Room	<input type="text"/>	Bedroom #3	<input type="text"/>
Den/Library	<input type="text"/>	Bedroom #4	<input type="text"/>
Entrance Vestibule	*3/4x5" white oak sculpted 'Athena'	Bedroom #5	<input type="text"/>
Lower Landing (If Applicable)	<input type="text"/>	Other Room - Specify thru out standard areas	*3/4x5" white oak sculpted 'Athena'

Comment

6. Carpeting

	Upgrade	Description
Ground Floor	<input type="checkbox"/>	<input type="text"/>
Second Floor	<input type="checkbox"/>	<input type="text"/>
<input type="text"/>	<input type="checkbox"/>	<input type="text"/>

	Type	Area
Upgrade Underpad	<input type="text"/>	<input type="text"/>
	Capped	Runner - *Upgrade
Carpet on Stairs	<input type="text"/>	<input type="text"/>

Comment

7. Fireplace

	Living Room			Family Room			Other Room - Specify		
	Purchased	As Per Plan	N/A	Purchased	As Per Plan	N/A	Purchased	As Per Plan	N/A
Fireplace Type	<input type="radio"/>	<input type="radio"/>	<input type="radio"/>	<input type="radio"/>	<input checked="" type="radio"/>	<input type="radio"/>	<input type="radio"/>	<input type="radio"/>	<input type="radio"/>
Mantle Type	<input type="text"/>			Gas			<input type="text"/>		
Colour / Stain	<input type="text"/>			Mediterranean			<input type="text"/>		
Surround	<input type="text"/>			Arctic White			<input type="text"/>		
Hearth	<input type="text"/>			n/a			<input type="text"/>		
	<input type="text"/>			n/a			<input type="text"/>		

Comment

*See attach. *

Purchaser: MARIANNA MACKEY

Property: 19 of Plan -

Telephone Res. / Bus: /

Project: Pine Valley Forevergreen - Phase 1

Decor Advisor: Amanda Ceresino

Model and Elevation: 40.01 B SUMMERDALE

8. Trim Carpentry

Interior Doors Front Door Glass Inserts Door Handles

Interior Trim

Comment

9. Plaster Mouldings and Medallions

Standard Throughout ☐ Yes ☐ No ☐ N/A

Entrance Vestibule Kitchen/Breakfast

Main Hall Den/Library

Living Room Lower Landing

Dining Room Other Room - Specify

Family Room

Comment

10. Railings and Spindles

Railing Package

Railing Colour

Stringer / Riser

Spindle Colour

Treads

Oak Stairs ☒ Yes ☐ No ☐ N/A

Comment

11. Wall Paint / Ceilings

Throughout Finished Areas

Trim Paint

Smooth Ceilings

Ground Floor ☒

Second Floor ☒

Note

Comment

see attach.

Purchaser: MARIANNA MACKEY

Property: 19 of Plan -

Telephone Res. / Bus: /

Project: Pine Valley Forevergreen - Phase 1

Decor Advisor: Amanda Ceresino

Model and Elevation: 40.01 B SUMMERDALE

12. Electrical

Hood Fan ☐ White ☐ Stainless ☒ N/A

Above Kitchen Cabinet Light ☐ Yes ☒ No

Below Kitchen Cabinet Light ☐ Yes ☒ No

Standard Appliances ☐

Over The Range Microwave ☐

Chimney Style Fan ☐

Comment

13. Heating and Air Conditioning

Air Conditioning

Gas Provisions Stove

Gas Provisions Dryer

Gas Provisions Barbecue

Comment

14. Additional Comments

15. Disclaimers and Notes

- Colours of all materials are as close as possible to builder's selection, but not necessarily identical due to variances in manufacturing.
- Any extras listed above are null and void unless accompanied by a separate invoice/amendment. Said invoice must be paid in full.
- The Purchaser acknowledges that after Interior Colour Selection form is signed and dated, no further changes will be permitted other than re-selection due to unavailability. ☒ Purchaser's Initials
- The Purchaser acknowledges reading and accepting the "Gold Park Homes Decor Centre Disclaimers" form. This document contains other miscellaneous disclaimers.

This Interior Colour Selection is final and approved by:

Signature: ☒ *see attach.* Date: June 21, 2021



PV-19. attach
April 30 2021

SCHEDULE 'F'

PV-19
June 21, 2021


see attach.

The Summerdale

40' SERIES

Elevation A • 2,895 sq.ft.

Elevation B • 2,880 sq.ft.

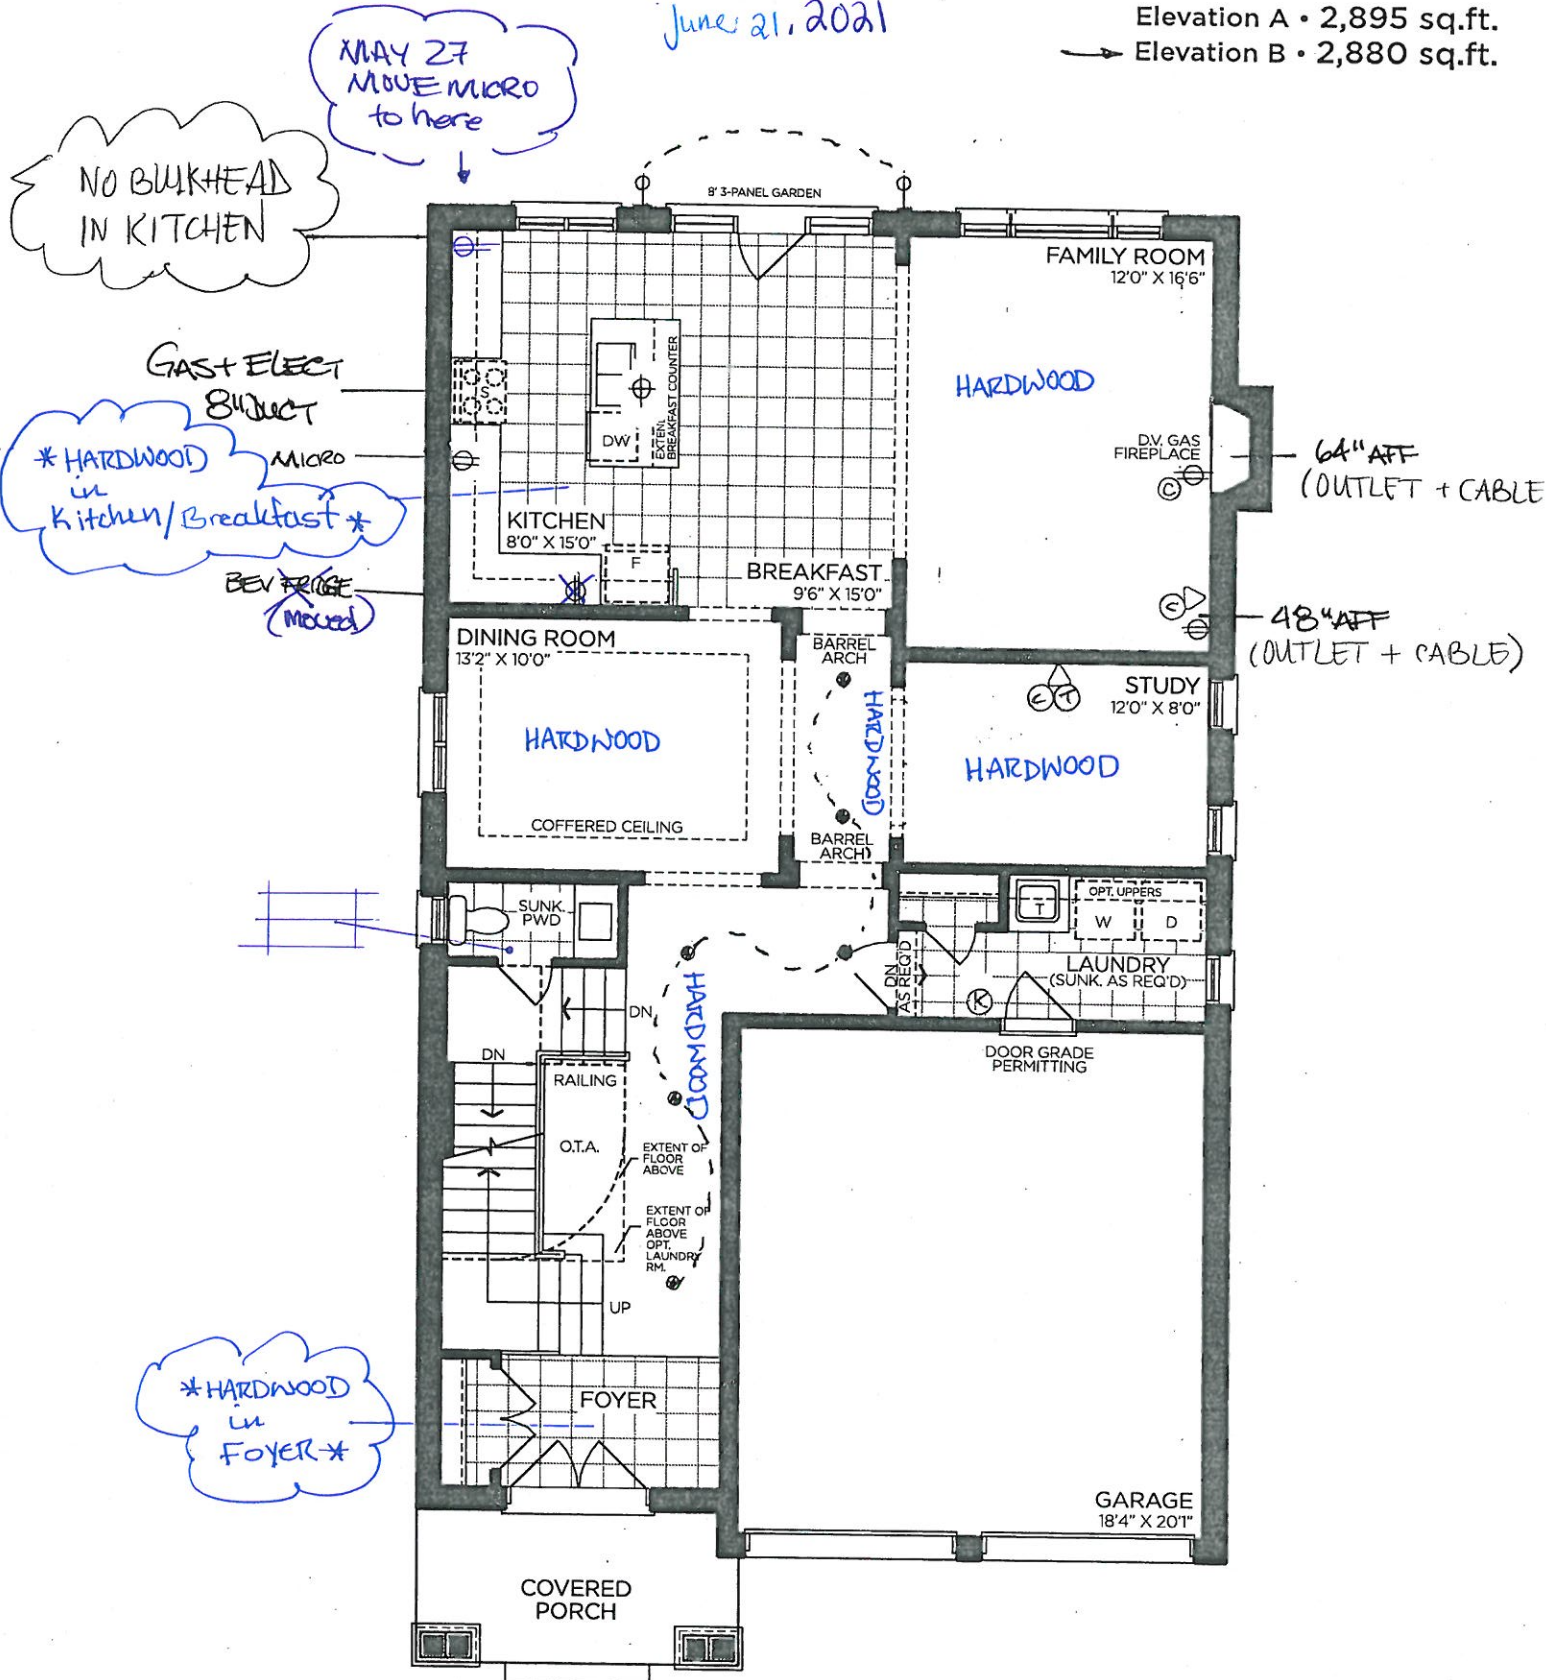

GROUND FLOOR | ELEV. A

VENDOR

PURCHASER

PURCHASER

GOLDPARK
WORTH MORE™

Prices, figures, illustrations, sizes, features and finishes are subject to change without notice. Areas and dimensions are approximate and actual usable floor space may vary from the stated area. Layout may be reverse of the unit purchased. E. & O.E. 4001



SCHEDULE 'F'

PV-19 attach
APRIL 30 2021


PV-19 * attach *
June 21, 2021

The Summerdale

40' SERIES

Elevation A • 2,895 sq.ft.

→ Elevation B • 2,880 sq.ft.

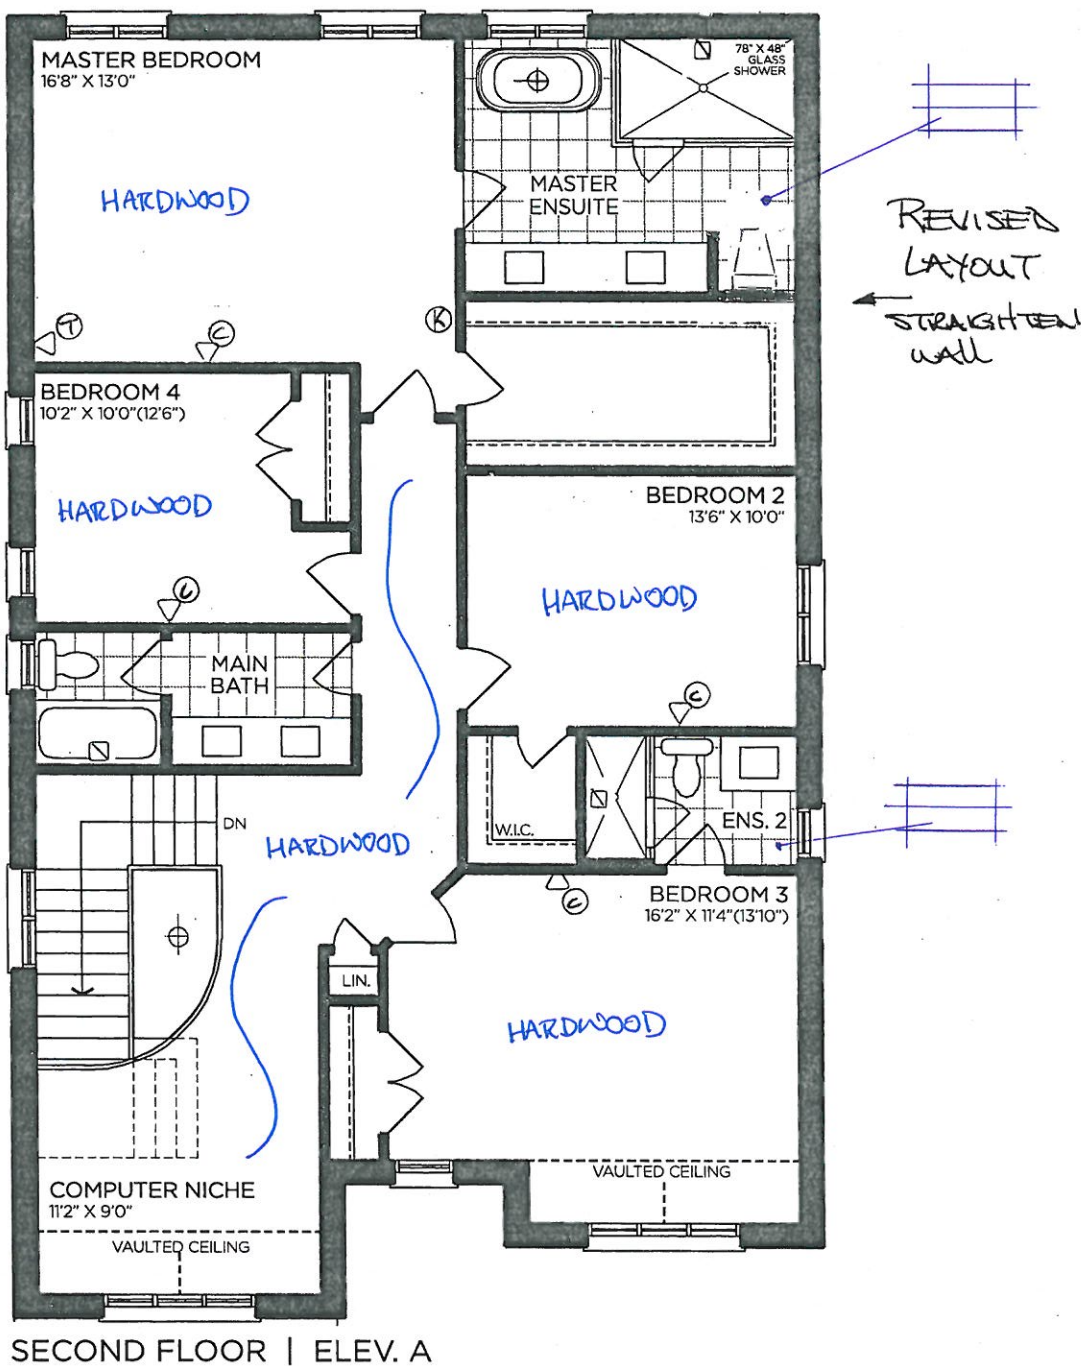

VENDOR

PURCHASER

PURCHASER

GOLDPARK
WORTH MORE™

Prices, figures, illustrations, sizes, features and finishes are subject to change without notice. Areas and dimensions are approximate and actual usable floor space may vary from the stated area. Layout may be reverse of the unit purchased. E. & O.E. 4001



PV-19
APRIL 30 2021

SCHEDULE 'F'

PV-19
June 21, 2021


See attach.

The Summerdale


40' SERIES

Elevation A • 2,895 sq.ft.


→ Elevation B • 2,880 sq.ft.

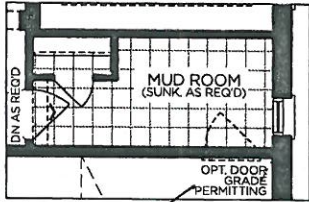


PART. GROUND FLOOR
MUDROOM FOR OPT.
SECOND FLOOR LAUNDRY

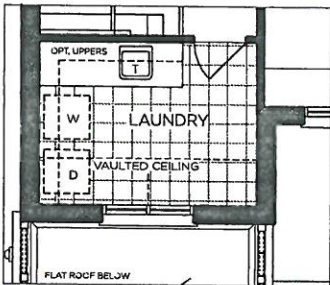


PART. SECOND FLOOR
W/ OPT. LAUNDRY
ELEV. B

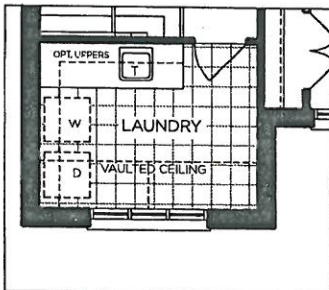


PART. SECOND FLOOR
W/ OPT. LAUNDRY
ELEV. A

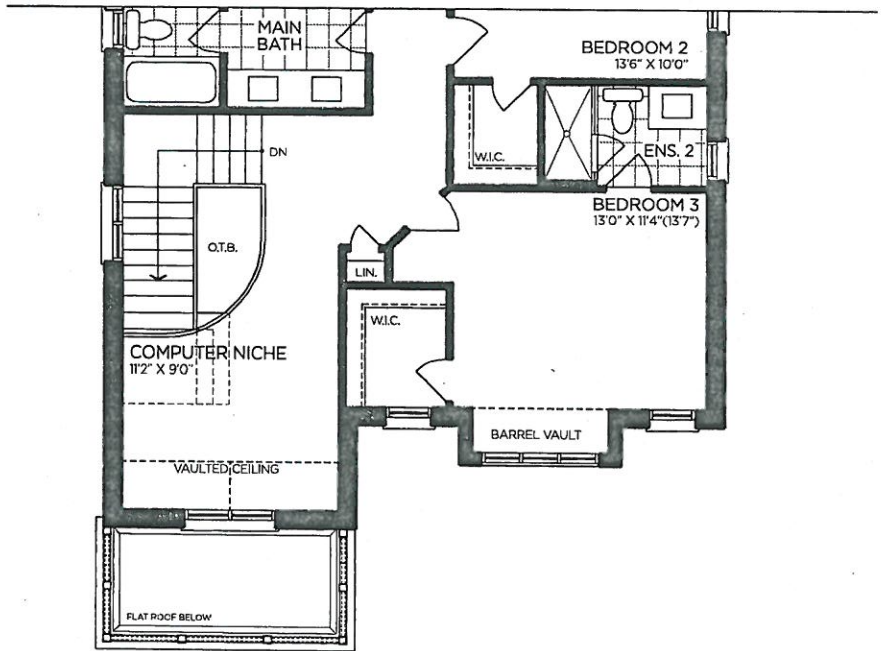

→ PART. SECOND FLOOR | ELEV. B

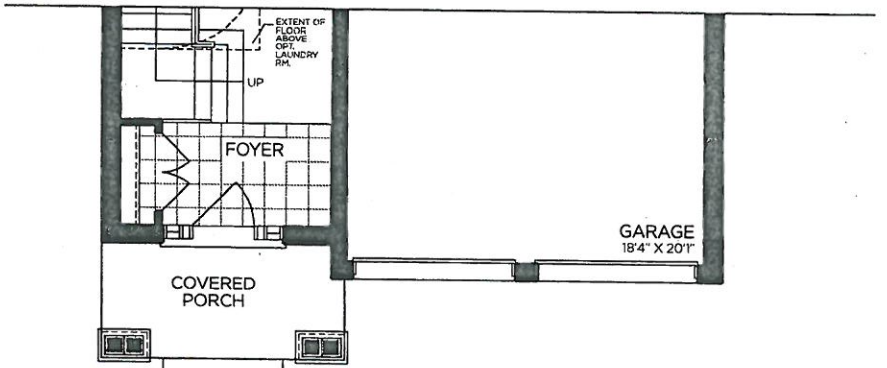

→ PART. GROUND FLOOR | ELEV. B

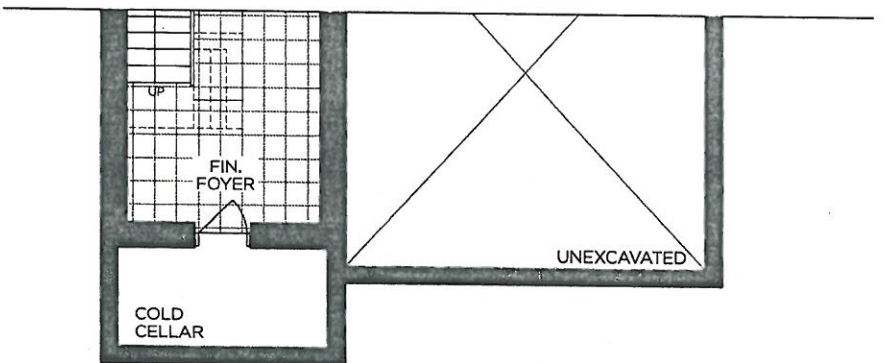

→ PART. BASEMENT | ELEV. B

VENDOR

PURCHASER

PURCHASER

GOLDPARK

WORTH MORE™

Prices, figures, illustrations, sizes, features and finishes are subject to change without notice. Areas and dimensions are approximate and actual usable floor space may vary from the stated area. Layout may be reverse of the unit purchased. E. & O.E. 4001



SCHEDULE 'F'

PV-19
April 30, 2021

attach

PV-19
June 21, 2021


*See
attach.*

The Summerdale

40' SERIES

Elevation A • 2,895 sq.ft.

→ Elevation B • 2,880 sq.ft.

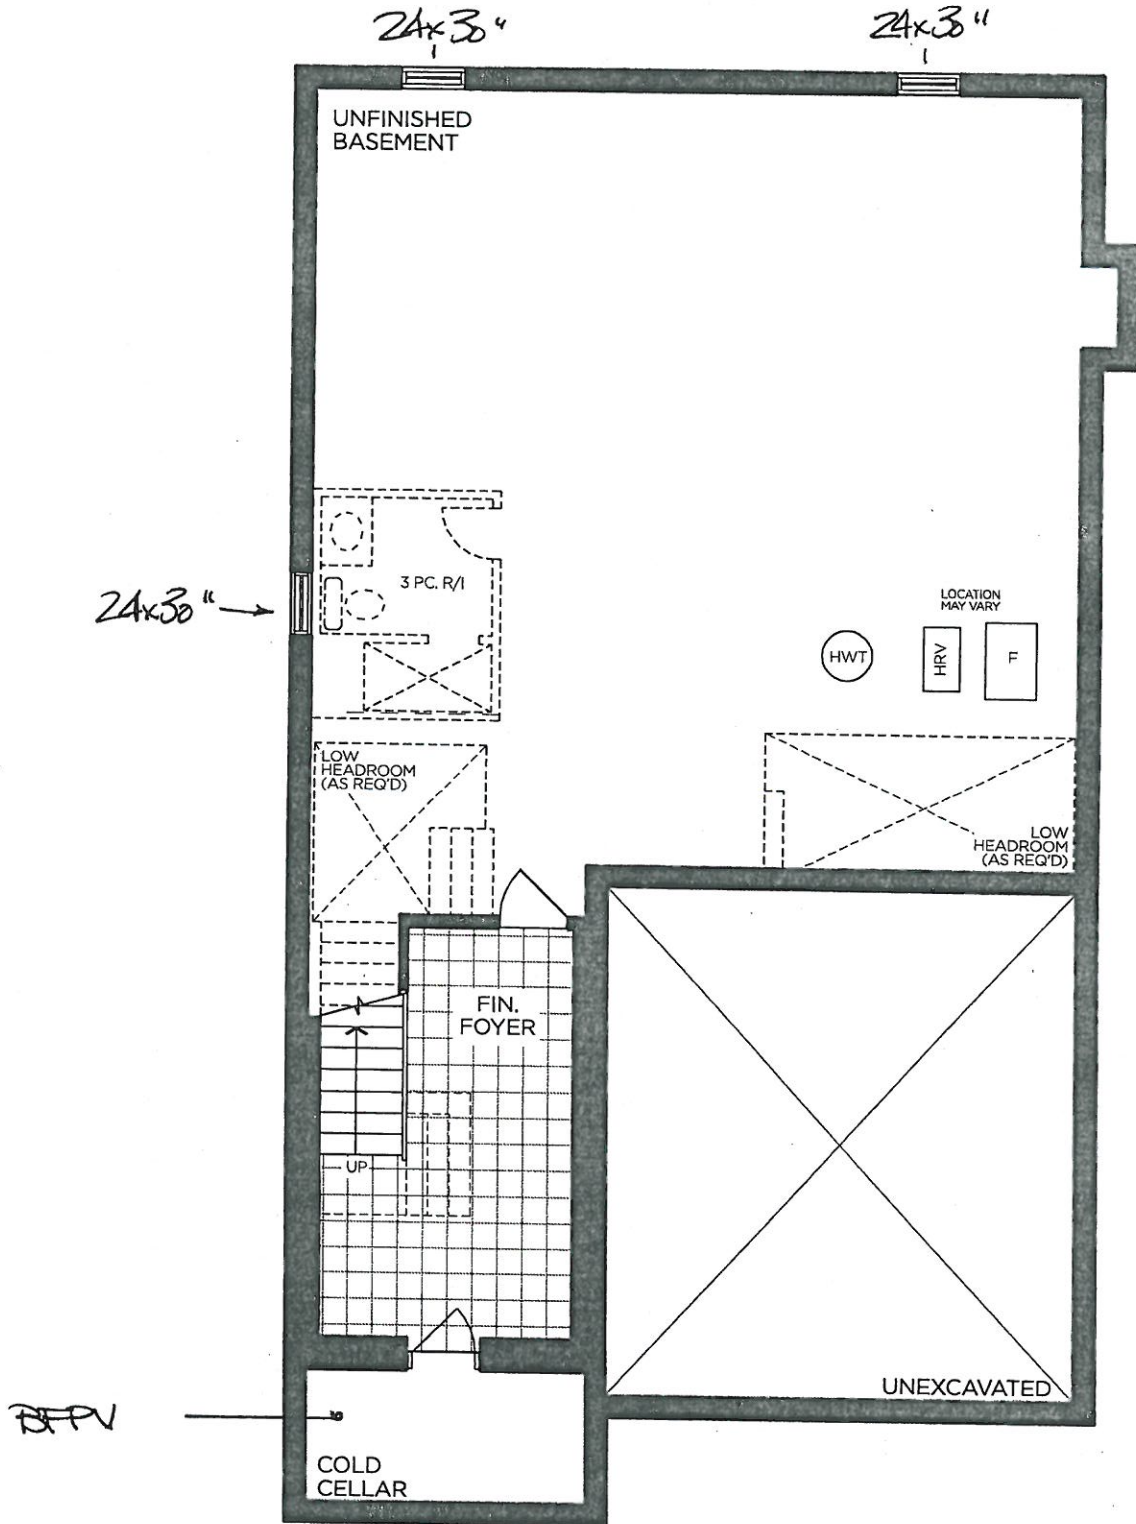

BASEMENT | ELEV. A

VENDOR

PURCHASER

PURCHASER

GOLDPARK
WORTH MORE™

Prices, figures, illustrations, sizes, features and finishes are subject to change without notice. Areas and dimensions are approximate and actual usable floor space may vary from the stated area. Layout may be reverse of the unit purchased. E. & O.E. 4001



PINE VALLEY
FOREVERGREEN

STONE COUNTERTOP EDGE PROFILES



STANDARD 2CM EASED EDGE



LOCATION:

THRU OUT




UPGRADE 3CM EASED EDGE


LOCATION:



UPGRADE 4CM MITRED EDGE

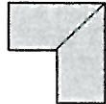

LOCATION:

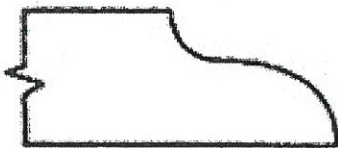

UPGRADE 2CM OGEE EDGE

LOCATION:

LOT #: PV-19

DATE: June 21, 2021

SIGNATURE: *see attach.*

SIGNATURE:



STANDARD HARDWARE / KNOBS



☐ K002-02



☐ K002-03



☐ K002-04



☐ K002-06



☒ K002-05
→ Kitchen



☐ K008-14



☐ K024-03

☒ *NO HARDWARE
→ *thru-out*

☐ TOUCH-LATCH

*DISCLAIMER: NO HARDWARE OR HOLES THRU-OUT: HOMEOWNER IS RESPONSIBLE FOR THE INSTALLATION OF THEIR OWN HARDWARE AFTER CLOSING AT THEIR OWN EXPENSE AND WARRANTY.

LOT # PV-19

DATE: June 21, 2021

SIGNATURE:  * see attach. *

SIGNATURE:




PINE VALLEY
FOREVERGREEN

UPGRADE SHOWER HARDWARE

MT6X6

Shower Door Handle

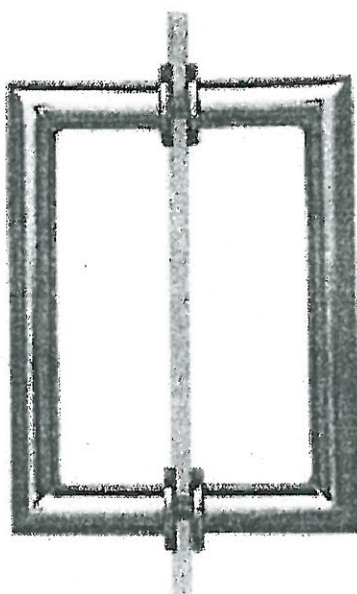

MT6X6
Shower Door Handle

6" x 6" back-to-back
3/4" dia. tube
Cut and mitred corners with
washers


☒ CHROME

☐ MATTE BLACK

Lot#
PV-19

Date:
June 21, 2021

Room: Master Ensuite + Ensuite 2


Signature:  * see attach. *

Signature:




PINE VALLEY
FOREVERGREEN

BATHROOM ACCESSORIES

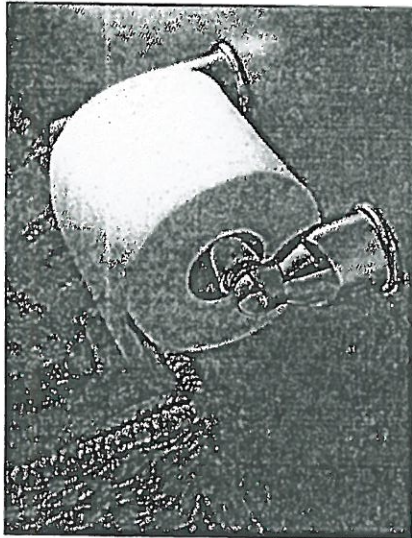

Tissue Holder
Mason - Chrome

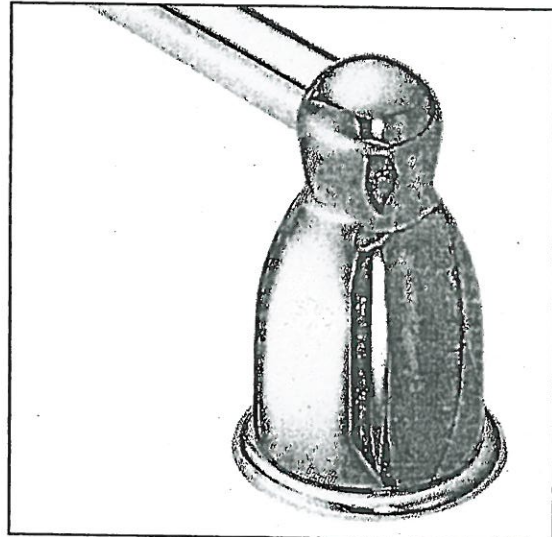

Towel Bar
Mason - Chrome

Please select one of the following:

- ☐ INSTALL STANDARD BATHROOM ACCESSORIES THRU OUT
(tissue holder + towel bar) **location as per vendors discretion**
- ☒ ***DO NOT*** INSTALL STANDARD BATHROOM ACCESSORIES
THRU OUT **tissue holder + towel bar will not be provided**

LOT #

PV-19

DATE:

June 21, 2021

SIGNATURE:



**see attach. **

SIGNATURE:



PV - 19 Cabinetry Schedule

ITEM	DESCRIPTION	QTY	UNIT	PRICE
ETCHER	REFURB TRIP FOR HARDWARE	1		
MAJOR ENROUTE	UPGRADE FROM SERIES 1 TO SERIES 2 - CHILDERN IN BLOOM CITY	1		
CABINETS TOTAL:				

"NOTE: NO HARDWARE / NO HOLES THRU OUT - PURCHASER IS RESPONSIBLE FOR THE INSTALLATION OF THEIR HARDWARE AFTER CLOSING AT THEIR OWN EXPENSE AND WARRANTY"

LOT# PV-19	DATE June 21, 2021
SIGNATURE <i>[Signature]</i>	
SIGNATURE	

GOLD

SALES



Project: Pine Valley Lot 19

Purchaser: Marianna Mackay

Purchaser: _____

It is highly recommended that purchasers provide their appliance specifications at the time of their structural and/or colours appointment to determine if any custom sizing of cabinets is required. If appliance specifications are not received by the time of their final appointment we will proceed with the following:


Standard Appliance Openings

1. Range approx. 31-1/2"
2. Fridge approx. 36" x 72"
3. Dishwasher approx. 24"

We accept and acknowledge that the builder will leave standard openings as per above "Standard Appliance Opening".


We understand to accommodate upgraded appliances, all appliance specifications must be provided at the time of our structural and/or colours appointment. Failure to complete the above-mentioned, may result in the need to revert to the "Standard Appliance Openings".

Should changes be required, a cost of \$500.00 to reopen your file is required and may result in a delay in construction of your home. As a result, we may be forced to extend the closing of your transaction. At no fault of our own, we reserve our right to hold you responsible for this delayed closing, which may include extra administration fees and interest upon balance due on closing.

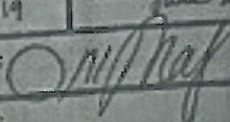LOT #: PY-19	DATE: June 21, 2021
SIGNATURE: 	
SIGNATURE: _____	

GOLDPARK
WATER & POWER

N-19
 June 31, 2021
 * standard kitchen *
 * standard appliance openings *
 -> Hardwood in Kitchen.

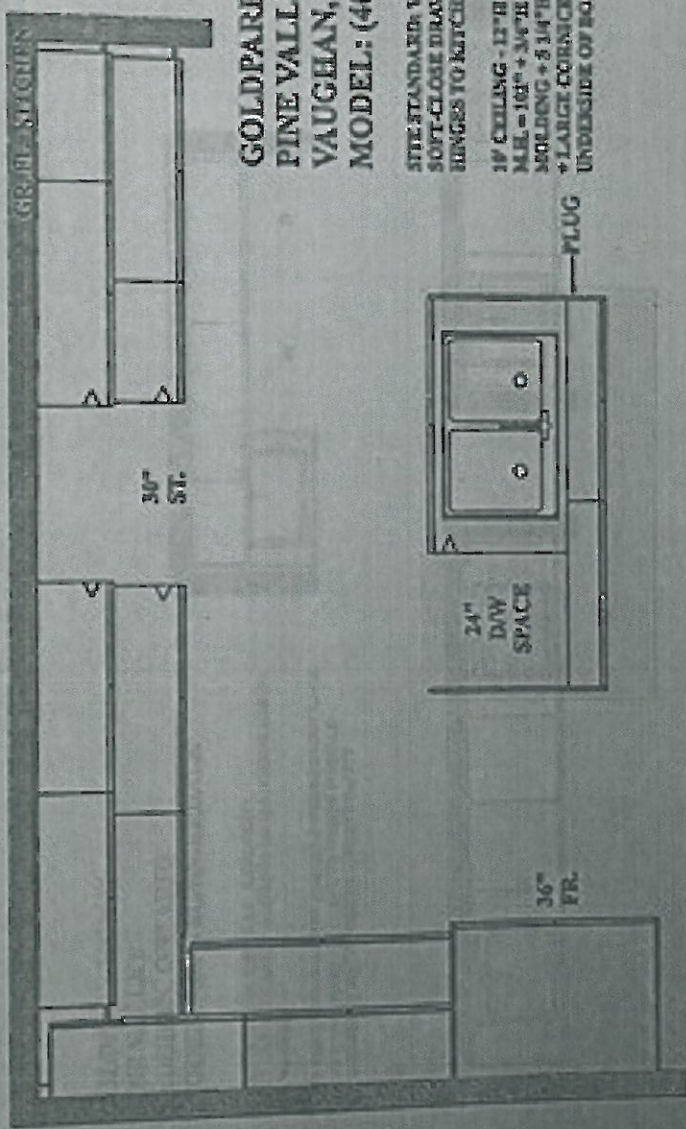

GOLDPARK HOMES
PINE VALLEY
VAUGHAN, ONTARIO
MODEL: (400J) SUMMERDALE

SITE STANDARD: WHITE 3/4" EXTENSION
 SOFT-CLOSE DRAWERS & SOFT-CLOSE
 HINGES TO KITCHEN AREA


18" CEILING - 12" H COFFERED CEILING -
 M.E.L. = 10'6" + 3/4" H CONTINGUARY
 MOLDING + 3/4" H FLOORING BAIL
 + LARGE CORNER MOLDING TO
 UNDERSIDE OF ECK



PV-19
Handwritten signature
June 19, 2021

**GOLDPARK HOMES
 FINE VALLEY
 VAUGHAN, ONTARIO
 MODEL 2 (4001) SUMMERDALE**

WITH STANDARD WHITE 4" EXTENSION
 SOFT CLOSE DRAWERS & STANDARD SLAM PROOF HINGERS
 TO MASTER
 OVER TOP DRAWER WHILE POSSIBLE THROUGHOUT LACK
 VANITY ONE BASE OF DRAWERS WHILE POSSIBLE
 THROUGHOUT EACH MASTER ESSENTIAL VANITY

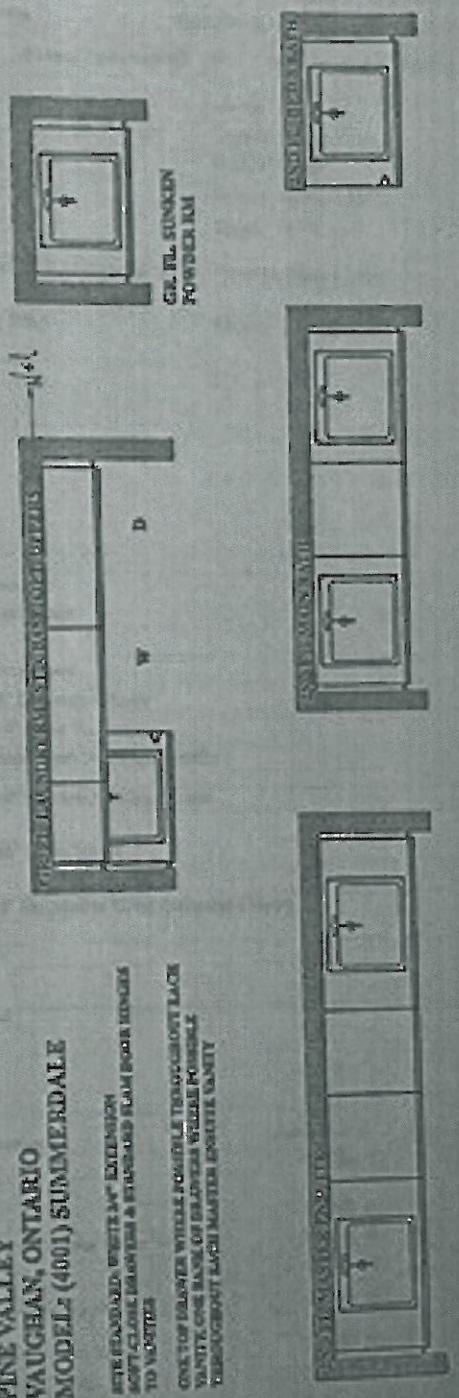

GOLDPARK

WORTH 40427

INTERIOR COLOUR SCHEME

*** NOTE: This is not an approved document. Document must be locked ***

Scheduled Closing Date: November 15, 2021

Purchaser: **MARIANNA MACKAY**

Property: 12 of Plan -

Telephone Res. / Bus: /

Project: Five Valley Forevergreen - Phase 1

Decor Advisor: **Amanda Corrado**

Model and Elevation: 40.01 B SUMMERDALE

Layout Changes: ☒ Yes ☐ No Sketch Attached: ☒ Yes ☐ No Exterior Colour Scheme: _____**1. Cabinetry**

	Style and Colour	Counter	Hardware
Kitchen / Breakfast	Chesapeake 'Classic White'	Granite 'Arctic White'	attached
Laundry Room	Bowery Fabro'	P-Lam 'White'	attached
Powder Room	Bowery Fabro'	Quartz 'Nordic Loft'	attached
Main Bath	Bowery Fabro'	Quartz 'Ice Snow'	attached
Master Ensuite Bathroom	'Chelsea PET H-Gloss Grey'	'Quartz Misty Canals'	attached
Second Ensuite Bathroom (if Applicable)	Bowery 'Elo'	Quartz 'Ice Snow'	attached

Comment

2. Floor Tile

	Selection
Entrance Vestibule	'see hardwood'
Main Hall	n/a
Kitchen / Breakfast	'see hardwood'
Laundry Room	'12x12' Serpentine Grey'
Powder Room	'12x24' Rave 'Fumed'
Main Bath	'6x6 Marquish 'Anthracite' matte
Master Ensuite Bathroom	'12x24' Canals X 'White' matte
Second Ensuite Bathroom (if Applicable)	'12x24' Rave 'Noir'
Lower Landing (if Applicable)	'12x12' Serpentine Grey' (basement foyer)

Comment

Repeat Shower Floor: 24" Standard 'White'

3. Wall Tile

	Selection	Label/Marker	Describe
Master Ensuite Bathroom		<input type="radio"/> Yes <input checked="" type="radio"/> No	
Tub Deck		<input type="radio"/> Yes <input checked="" type="radio"/> No	
Shower Stall	'12x24' Laguna Wave 'White'	<input type="radio"/> Yes <input checked="" type="radio"/> No	
Bathroom Walls		<input type="radio"/> Yes <input checked="" type="radio"/> No	
Second Ensuite Bathroom (if Applicable)	6x12' Wave 'Tender Grey'	<input type="radio"/> Yes <input checked="" type="radio"/> No	
Main Bath	6x12' Wave 'White'	<input type="radio"/> Yes <input checked="" type="radio"/> No	
Kitchen Backsplash	<input type="radio"/> Yes <input checked="" type="radio"/> No		Backsplash Behind Fridge

Comment

Page 1 of 4

Printed 2021-09-21 14:19:16

GOLDPARK
WORKS SHOP

INTERIOR COLOUR SCHEME

*** NOTE: This is not an approved document. Document must be locked ***

Scheduled Closing Date: November 15, 2021

Purchaser: **MARIANNA MACKEY**

Property: 10 of Plan -

Telephone Res. / Bus: /

Project: Pine Valley Forevergreen - Phase 1

Decor Advisor: **Ananda Ceresino**

Model and Elevation: 40.01 B SUMMERDALE

4. Plumbing Fixtures

Master Ensuite Bathroom ☐ Second Ensuite ☐ Powder Room ☐
Other Room - Specify ☐ Other Washroom ☐

Comment

5. Hardwood Flooring

	Type and Stain		Type and Stain
Main Hall		Upper Landing	
Kitchen / Breakfast	"3/4x5" white oak sculpted 'Athena'	Upper Hall	
Living Room		Master Bedroom	
Dining Room		Bedroom #2	
Family Room		Bedroom #3	
Den/Library		Bedroom #4	
Entrance Vestibule	"3/4x5" white oak sculpted 'Athena'	Bedroom #5	
Lower Landing (if Applicable)		Other Rooms - Specify this out standard areas	"3/4x5" white oak sculpted 'Athena'

Comment

6. Carpeting

	Upgrade	Description
Ground Floor	<input type="checkbox"/>	
Second Floor	<input type="checkbox"/>	
	<input type="checkbox"/>	

Upgrade Underpad

Carpet on Stairs

Comment

7. Fireplace

	Living Room	Family Room	Other Rooms - Specify						
	Purchased	As Per Plan	N/A	Purchased	As Per Plan	N/A	Purchased	As Per Plan	N/A
Fireplace Type	<input type="radio"/>	<input type="radio"/>	<input type="radio"/>	<input type="radio"/>	<input type="radio"/>	<input type="radio"/>	<input type="radio"/>	<input type="radio"/>	<input type="radio"/>
Mantle Type									
Colour / Stain									
Surround									
Hearth									

Comment

GOLDPARK
WITH MORE

INTERIOR COLOUR SCHEME

*** NOTE: This is not an approved document. Document must be locked ***

Scheduled Closing Date: November 15, 2021

Purchaser: MARIANNA MACKEY

Property: 19 of Plan -

Telephone Res. / Bus: /

Project: Pine Valley Forevergreen - Phase 1

Decor Advisor: Amanda Corrado

Model and Elevation: 40.01 B SUMMERDALE

8. Trim Carpentry

Interior Doors Carrara Front Door Glass Inserts std Door Handles standard

Interior Trim Standard

Comment

9. Plaster Mouldings and Medallions

Standard Throughout ☐ Yes ☐ No ☐ N/A

Entrance Vestibule

Kitchen/Breakfast

Main Hall

Den/Library

Living Room

Lower Landing

Dining Room

Other Room - Specify

Family Room

Comment

10. Railings and Spindles

Railing Package Standard Package 2

Railing Colour Mirage Graphite

Stringer / Riser Mirage Graphite

Spindle Colour Mirage Graphite

Treads Mirage Graphite

Oak Stairs ☒ Yes ☐ No ☐ N/A

Comment

11. Wall Paint / Ceilings

Throughout Finished Areas Warm Grey

Trim Paint White

Smooth Ceilings

Ground Floor ☒

Second Floor ☒

Note

Comment

GOLDPARK
work area

INTERIOR COLOUR SCHEME

*** NOTE: This is not an approved document. Document must be locked ***

Scheduled Closing Date: November 15, 2021

Purchaser: **MARGANNA MACKAY**

Property: 18 of Plan -

Telephone Res. / Bldg: /

Project: Pine Valley Forevergreen - Phase 1

Decor Advisor: **Amelia Corrado**

Model and Elevation: 43.01 & SUMMERDALE

12. Electrical

Hood Fan ☐ White ☐ Stainless ☒ N/A

Above Kitchen Cabinet Light ☐ Yes ☒ No

Below Kitchen Cabinet Light ☐ Yes ☒ No

Standard Appliances ☐

Over The Range Microwave ☐

Chimney Style Fan ☐

Comment

13. Heating and Air Conditioning

Air Conditioning none

Gas Provisions Stove yes

Gas Provisions Dryer none

Gas Provisions Radiator add

Comment

14. Additional Comments

15. Declaration and Notes

- 1) I declare that the information provided in this document is true and correct to the best of my knowledge.
- 2) Any other information provided by the Purchaser or the Decor Advisor is not to be used for any other purpose.
- 3) The Purchaser acknowledges that the information provided in this document is not to be used for any other purpose.
- 4) The Purchaser acknowledges that the information provided in this document is not to be used for any other purpose.

Decor Advisor Signature: *Amelia Corrado*

Signature: *Marganna Mackay* Date: *Nov 15, 2021*

PINE VALLEY


SCHEDULE 'F'
PV-19. *atpoch*
April 30 2023

PV-19
June 21, 2023



The Summerdale 40' SERIES

Elevation A • 2,895 sq.ft.
Elevation B • 2,890 sq.ft.

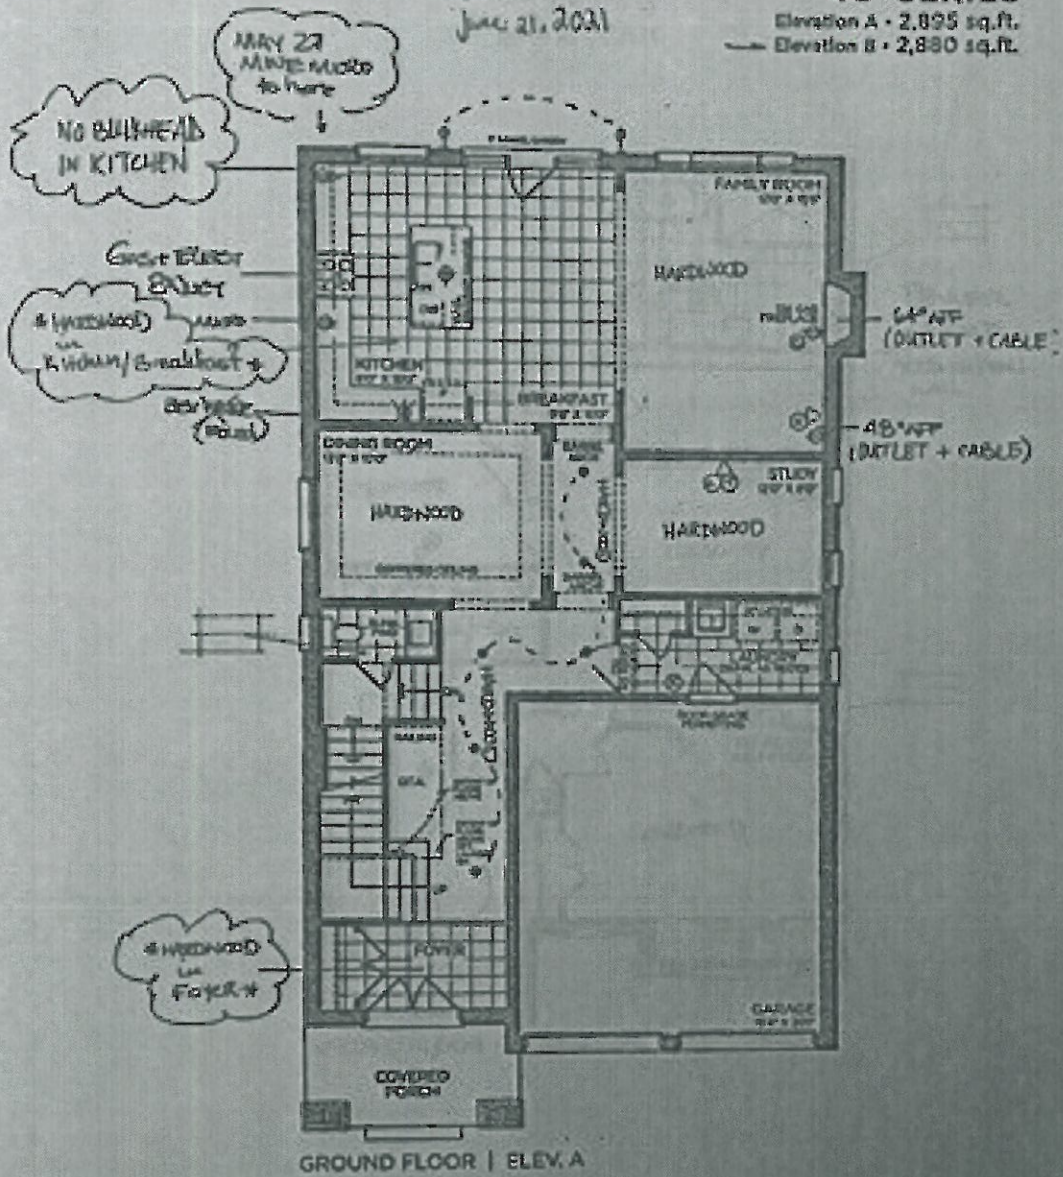

VENDOR
PURCHASER
PURCHASER

GOLDPARK
WOODS & SONS

Prices, features, materials, sizes, features and finishes are subject to change without notice. Sizes and dimensions are approximate and actual results may vary from the stated info. Typed from the source of the unit purchased. E & D 10/20



SCHEDULE 'P'

PN-19 *Added*
April 30, 2021


PN-19 ~~June 21, 2021~~

The Summerdale

40' SERIES

Elevation A - 2,895 sq.ft.

Elevation B - 2,880 sq.ft.

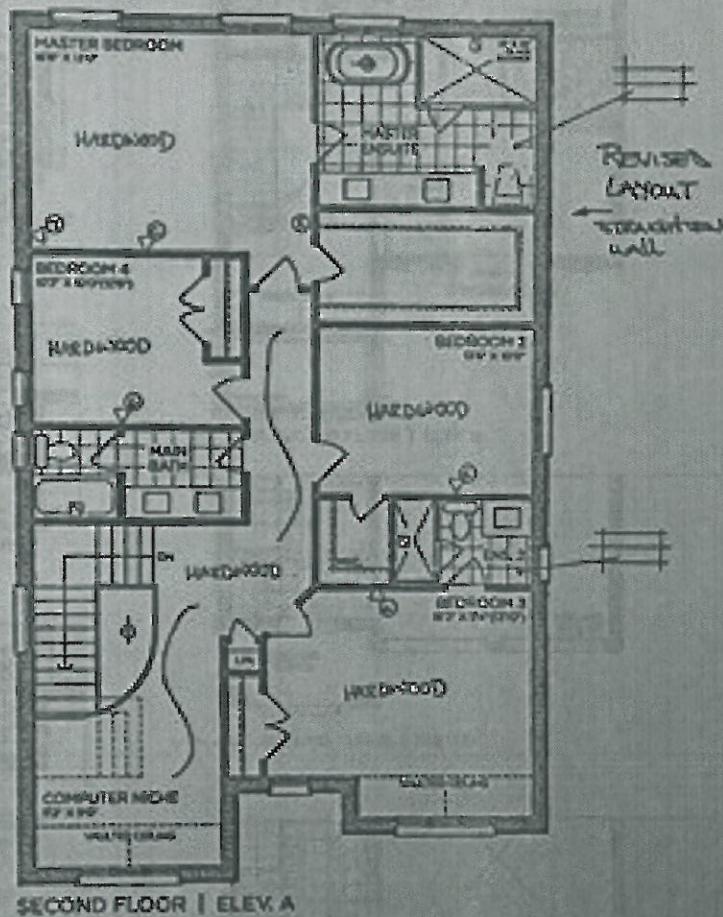

SECOND FLOOR | ELEV. A

VENDOR
PURCHASER
PURCHASER

GOLDPARK
WORTH 3047

Prices, features, illustrations, plans, fixtures and finishes are subject to change without notice. Areas and dimensions are approximate and actual inside floor space may vary from the stated area. Layout may be inverse of the one purchased. © 2021 GP




PN-19
April 30 22

SCHEDULE 'F'


PN-19
June 11, 2021

The Summerdale


40' SERIES
Elevation A - 2,895 sq.ft.
Elevation B - 2,880 sq.ft.

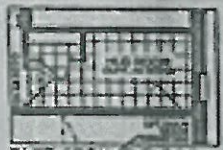


PART GROUND FLOOR
HYDRO ROOM FOR OPT.
SECOND FLOOR LAUNDRY

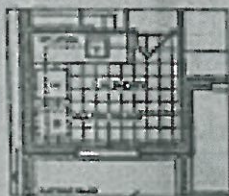


PART SECOND FLOOR
W/ OPT. LAUNDRY
ELEV. B

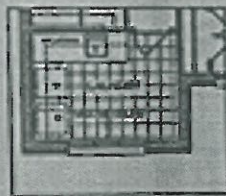


PART SECOND FLOOR
W/ OPT. LAUNDRY
ELEV. A

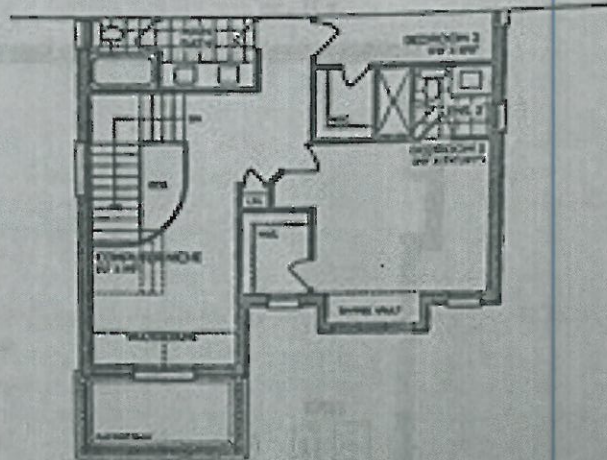

PART SECOND FLOOR | ELEV. B

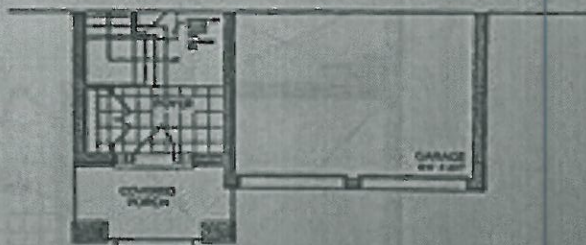

PART GROUND FLOOR | ELEV. B

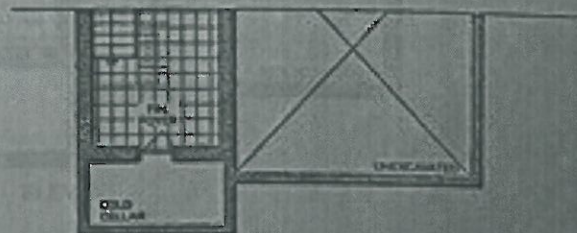

PART BASEMENT | ELEV. B

VENDOR
PURCHASER
PURCHASER

GOLDPARK
SERIES 4000

Prices, Plans, Dimensions, Area, Features and Details are subject to change without notice. Area and dimensions are approximate and actual results may vary. See the Goldpark Series 4000 for details of the unit purchased. © 2021, Goldpark




PV-19
April 30, 2022

SCHEDULE 'P'

PV-19
June 21, 2021

The
Summerdale
40' SERIES
Elevation A - 2,895 sq.ft.
→ Elevation B - 2,860 sq.ft.

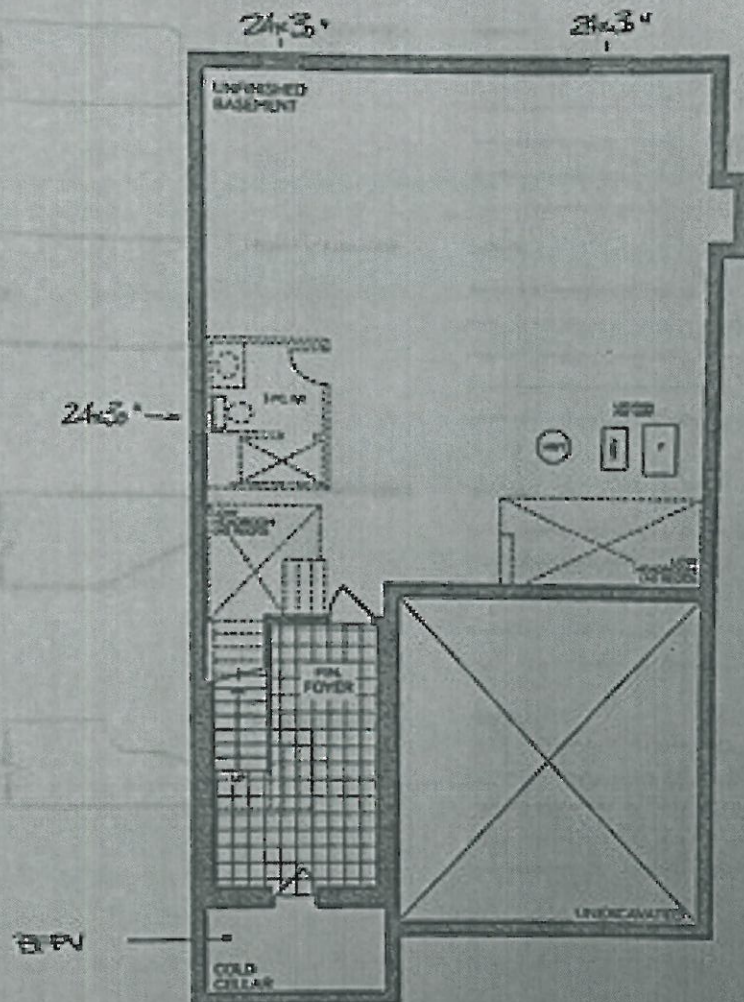

BASEMENT | ELEV. A


VENDOR
PURCHASER
PURCHASER

GOLDPARK
WEST 2000'

Prices, square footages, sizes, features and finishes are subject to change without notice. Actual and dimensions are approximate and actual may vary from the stated area. Legal may be required for the purchase of E. & O. AND



STONE COUNTERTOP EDGE PROFILES

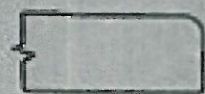

STANDARD 1/4" EASED EDGE



LOCATION

THRU OUT



UPGRADE 1/4" EASED EDGE

LOCATION



UPGRADE 1/4" MITERED EDGE



LOCATION



UPGRADE 1/4" OVER EDGE

LOCATION

LOT # PV-19

DATE June 21, 2021

SIGNATURE

SIGNATURE

GOLDPARK

STANDARD HARDWARE / KNOBS



☐ K002-02



☐ K002-03



☐ K002-04




☐ K002-06



☒ K002-05
→ kitchen



☐ K008-14

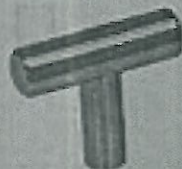

☐ K024-03

☒ *NO HARDWARE*
→ *thru-out*

☐ TOUCH-LATCH

*DISCLAIMER: NO-HARDWARE OR HOLE THRU-OUT. HOMEOWNER IS RESPONSIBLE FOR THE INSTALLATION OF THEIR OWN HARDWARE AFTER CLOSING AS THEIR OWN EXPENSE AND WARRANTY.

LOT # PV-19

DATE: June 21, 2021

SIGNATURE:

[Handwritten Signature]

SIGNATURE:


GOLD

UPGRADE SHOWER HARDWARE



MTE016

Shower Door Handle

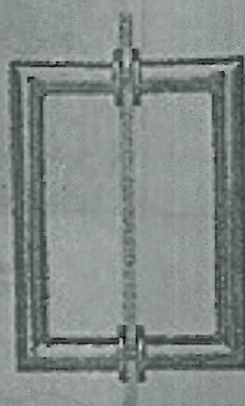

MTE016
Shower Door Handle

6" x 8" back-to-back
3/4" dia. tube

Cut and mitred corners with
washers

☒ CHROME

☐ MATTE BLACK

Lot#
PV-19

Date: June 28, 2021

Room: Master Ensuite + Ensuite 2

Signature:


Signature:

GOLDPARK

BATHROOM ACCESSORIES



Tissue Holder
Plastic - Chrome

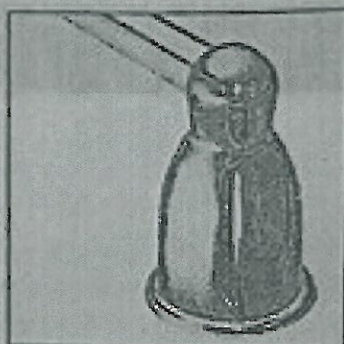

Towel Bar
Plastic - Chrome

Please select one of the following:

☐ INSTALL STANDARD BATHROOM ACCESSORIES THRU OUT
(tissue holder + towel bar) *location as per vendor's discretion*

☒ *DO NOT* INSTALL STANDARD BATHROOM ACCESSORIES
THRU OUT *tissue holder + towel bar will not be provided*

LOT #
PV-19

DATE:
July 21, 2023

SIGNATURE:

SIGNATURE:

GOLDPARK




PINE VALLEY
FOREVERGREEN

PLUMBING UPGRADES

MOEN - FLARA

Two-Handle High Arc Lav Faucet

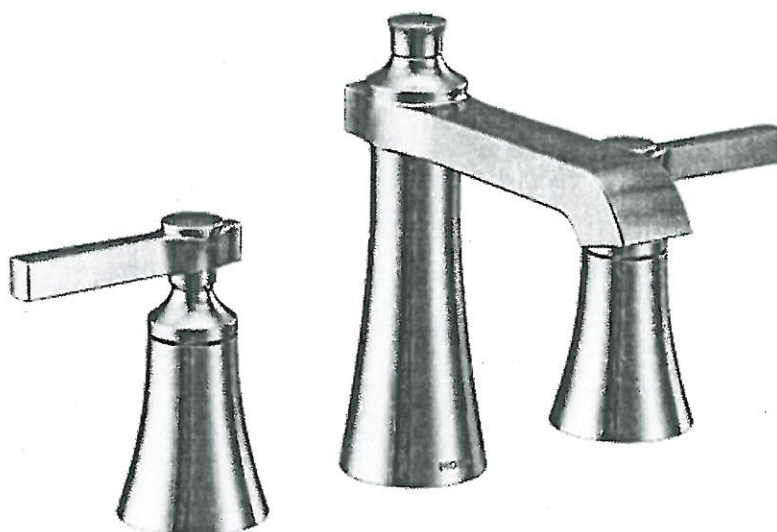

CHROME



BRUSHED NICKEL (BN)



POLISHED NICKEL (NL)



BRUSHED GOLD (BG)

MODEL: TS6984 / 69000

Lot#

PV-19

Date:

April 30, 2021

Room:

Master Ensuite x2

Signature:

Atadok

Signature:

PLUMBING UPGRADES

MOEN - FLARA

Posi-Temp SHOWER ONLY* Slide Bar with Hand Shower




☒ CHROME

☐ BRUSHED NICKEL (BN)

*from WALL

MODEL: TS2912EP / 62320 / UTS4911 / U361CI / 3668EP / A725

Lot# PV-19	Date: Apr. 30, 2021	Room: Master Ensuite
Signature: 		
Signature:		




PINE VALLEY
FOREVERGREEN

PLUMBING UPGRADES

MOEN - ALIGN

Posi-Temp SHOWER ONLY* with 3 Function Transfer Valve/Trim and Slide Bar with Handshower

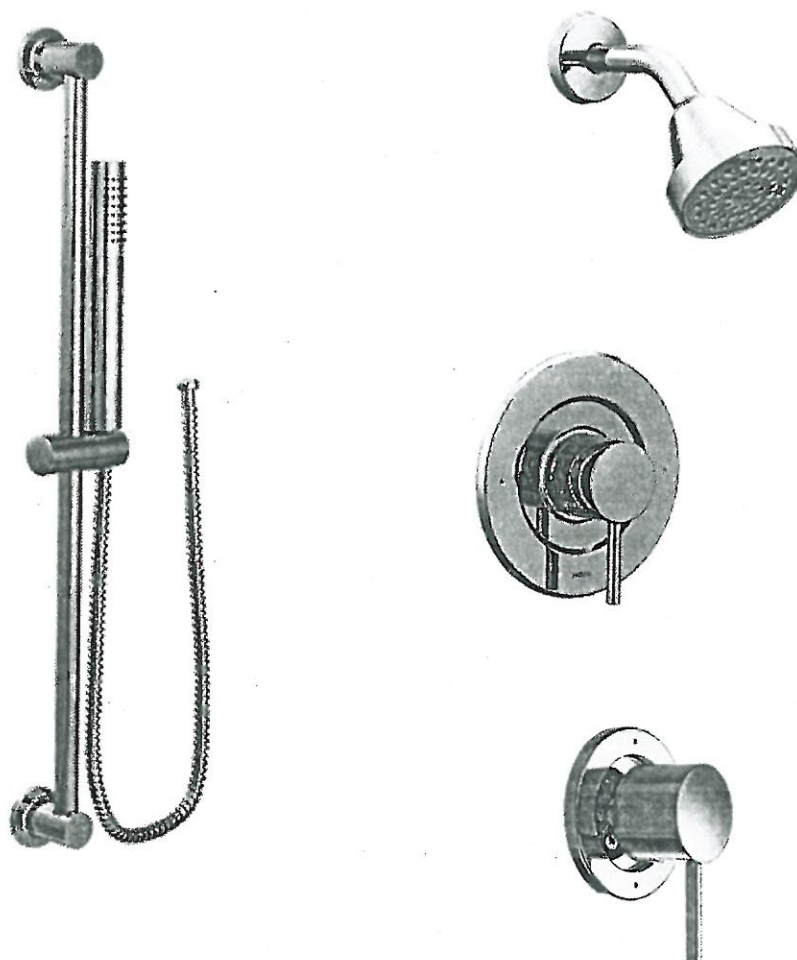

☒ CHROME

☐ BRUSHED NICKEL (BN)

☐ BRUSHED GOLD (BG)

☐ MATTE BLACK (BL)

from WALL

MODEL: T2192EP / U361CI / UT4191 / 62320 / 3887EP / A725

Lot# PV-19

Date: Apr. 30, 2021

Room: Ensuite 2

Signature:

attach

Signature:




PINE VALLEY

FOREVERGREEN

PLUMBING UPGRADES

MOEN - 90 DEGREE

Posi-Temp Tub/Shower Faucet with 3 Function Transfer Valve/Trim & Slide Bar
with Hand Shower

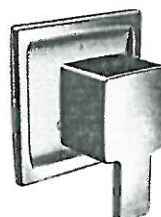

☒ CHROME

☐ BRUSHED NICKEL (BN)

* from WALL


MODEL: TS2713EP / U361CI / UTS4172 / 62320 / S3879EP / A721

Lot# PV-19	Date: Apr. 30, 2021	Room: Main Bath
Signature: <u>attah</u>		
Signature:		

PLUMBING UPGRADES



MOEN - FLARA
Two-Handle High Arc Lav Faucet

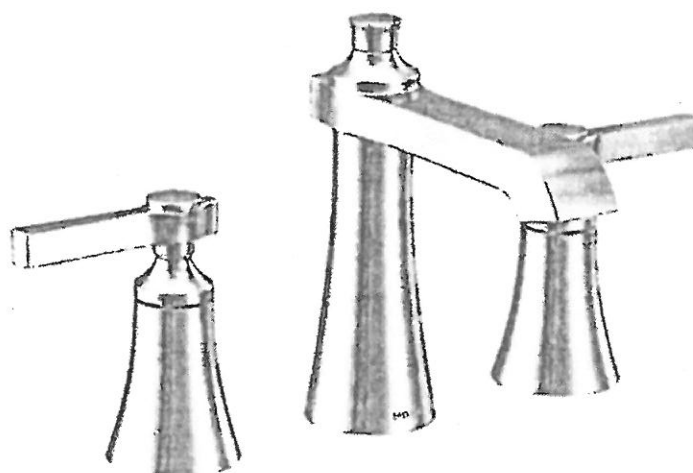

- ☒ CHROME
- ☐ BRUSHED NICKEL (BN)
- ☐ POLISHED NICKEL (NL)
- ☐ BRUSHED GOLD (BG)

MODEL: TS6984 / 69000


Lot# PV-19	Date: April 30, 2021	Room: Master Ensuite x2
Signature: <i>[Signature]</i>		
Signature:		

PLUMBING UPGRADES



MOEN - FLARA


Posi-Temp SHOWER ONLY* Slide Bar with Hand Shower

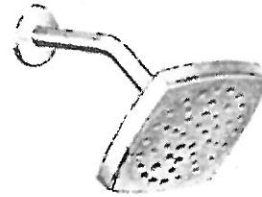

- ☒ CHROME
☐ BRUSHED NICKEL (BN)

*from WALL

MODEL: TS2912EP / 62320 / UTS4911 / U361CI / 3668EP / A725

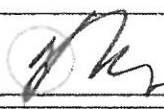Lot# PV-19	Date: Apr. 30, 2021	Room: Master Ensuite
Signature: 		
Signature:		





PINE VALLEY
FOREVERGREEN

PLUMBING UPGRADES

MOEN - ALIGN

Posi-Temp SHOWER ONLY* with 3 Function Transfer Valve/Trim and Slide Bar
with Handshower

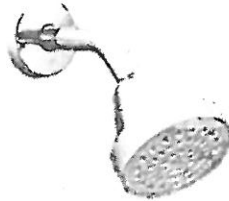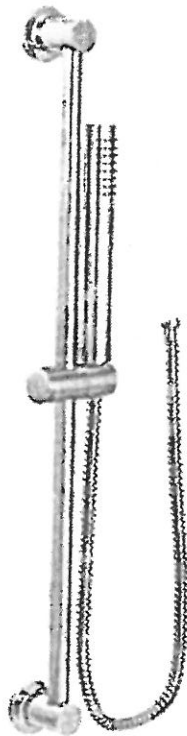

☒ CHROME


☐ BRUSHED NICKEL (BN)

☐ BRUSHED GOLD (BG)

☐ MATTE BLACK (BL)

from WALL

MODEL: T2192EP / U361CI / UT4191 / 62320 / 3887EP / A725

Lot# PV-19	Date: Apr 30, 2021	Room: Ensuite 2
Signature: 		
Signature:		


GOLDPARK
WORTH HOUSING

PLUMBING UPGRADES



MOEN - 90 DEGREE

Posi-Temp Tub/Shower Faucet with 3 Function Transfer Valve/Trim & Slide Bar
with Hand Shower

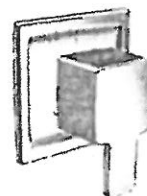


☒ CHROME

☐ BRUSHED NICKEL (BN)

* from WALL

MODEL: TS2713EP / U361CI / UTS4172 / 62320 / S3879EP / A721

Lot# PV-19	Date: Apr. 30, 2021	Room: Main Bath
Signature: 		
Signature:		