



CONSTRUCTION SUMMARY

Lot: 30
Model: 40.06 B LILAC
Project/Phase: Pine Valley Forevergreen / 1

BASEMENT WINDOWS

Invoice	Qty.	Description
2811 72,351 16Jun21 **	2	BASEMENT WINDOWS - UPGRADE BASEMENT WINDOW SIZE TO 30 " X 24" - 8" FRAME

CONCRETE AND DRAIN

Invoice	Qty.	Description
2811 16Jun21 NoCat	1	BACK FLOW PREVENTER VALVE

DRYWALL

Invoice	Qty.	Description
2811 72,351 16Jun21 **	2	BASEMENT WINDOWS - UPGRADE BASEMENT WINDOW SIZE TO 30 " X 24" - 8" FRAME

ELECTRICAL

Invoice	Qty.	Description
2811 72,351 16Jun21 **	2	BASEMENT WINDOWS - UPGRADE BASEMENT WINDOW SIZE TO 30 " X 24" - 8" FRAME

INTERIOR DOORS AND TRIM

Invoice	Qty.	Description
2825 72,644 19Jul21 **	18	INCREASE HEIGHT OF DOOR TO 8FT SECOND FLOOR - PER DOOR

PAINTING

Invoice	Qty.	Description
2825 72,644 19Jul21 **	18	INCREASE HEIGHT OF DOOR TO 8FT SECOND FLOOR - PER DOOR




SCHEDULE 'F'

PV-30
June 14, 2021

attached

The
Lilac
40' SERIES

➔ Elevation A • 3,425 sq.ft.
Elevation B • 3,385 sq.ft.

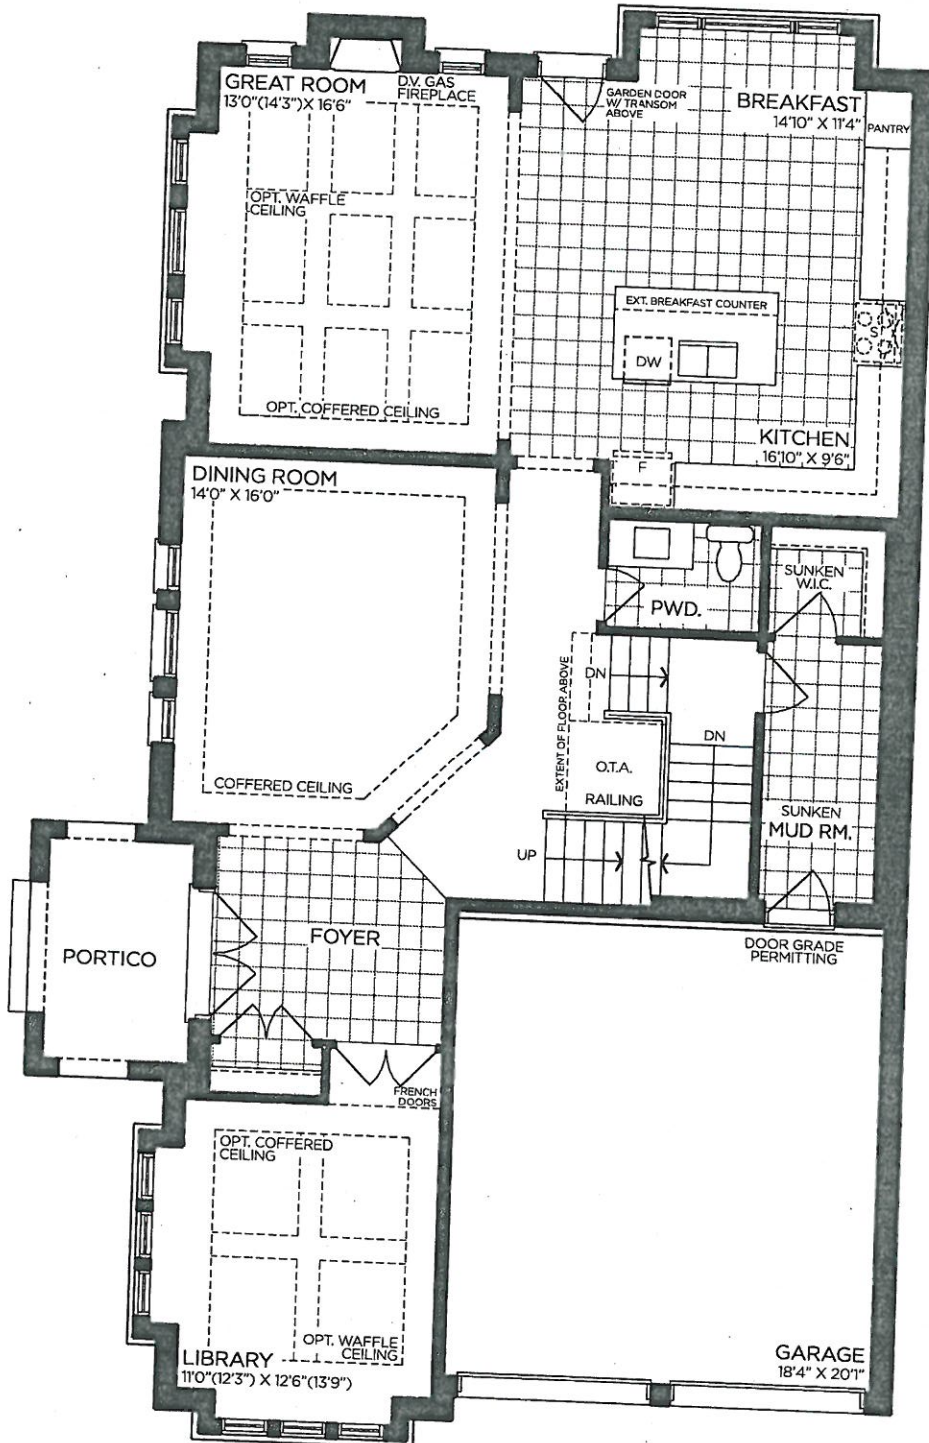

GROUND FLOOR | ELEV. A

VENDOR

PURCHASER

PURCHASER

GOLDPARK
WORTH MORE™

Prices, figures, illustrations, sizes, features and finishes are subject to change without notice. Areas and dimensions are approximate and actual usable floor space may vary from the stated area. Layout may be reverse of the unit purchased. E. & O.E. 4006




SCHEDULE 'F'

PV-30
June 14, 2021 *attached*

The Lilac

40' SERIES

➤ Elevation A • 3,425 sq.ft.
Elevation B • 3,385 sq.ft.

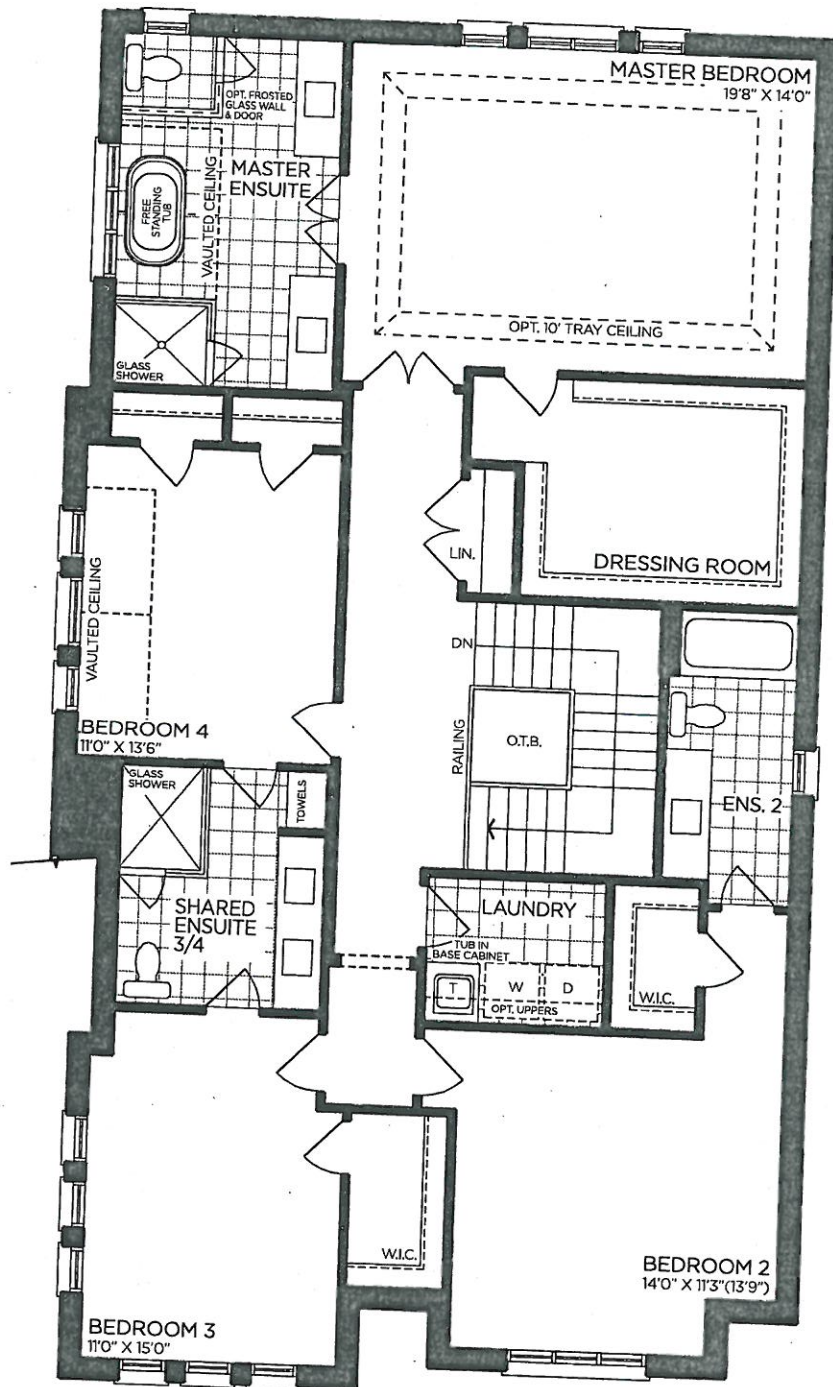

SECOND FLOOR | ELEV. A

VENDOR

PURCHASER

PURCHASER

GOLDPARK
WORTH MORE™

Prices, figures, illustrations, sizes, features and finishes are subject to change without notice. Areas and dimensions are approximate and actual usable floor space may vary from the stated area. Layout may be reverse of the unit purchased. E. & O.E. 4006

Prices, figures, illustrations, sizes, features and finishes are subject to change without notice. Areas and dimensions are approximate and actual usable floor space may vary from the stated area. Layout may be reverse of the unit purchased. E. & O.E. 4006



SCHEDULE 'F'


PV-30
June 14, 2021

KA

The Lilac

40' SERIES

→ Elevation A • 3,425 sq.ft.
Elevation B • 3,385 sq.ft.

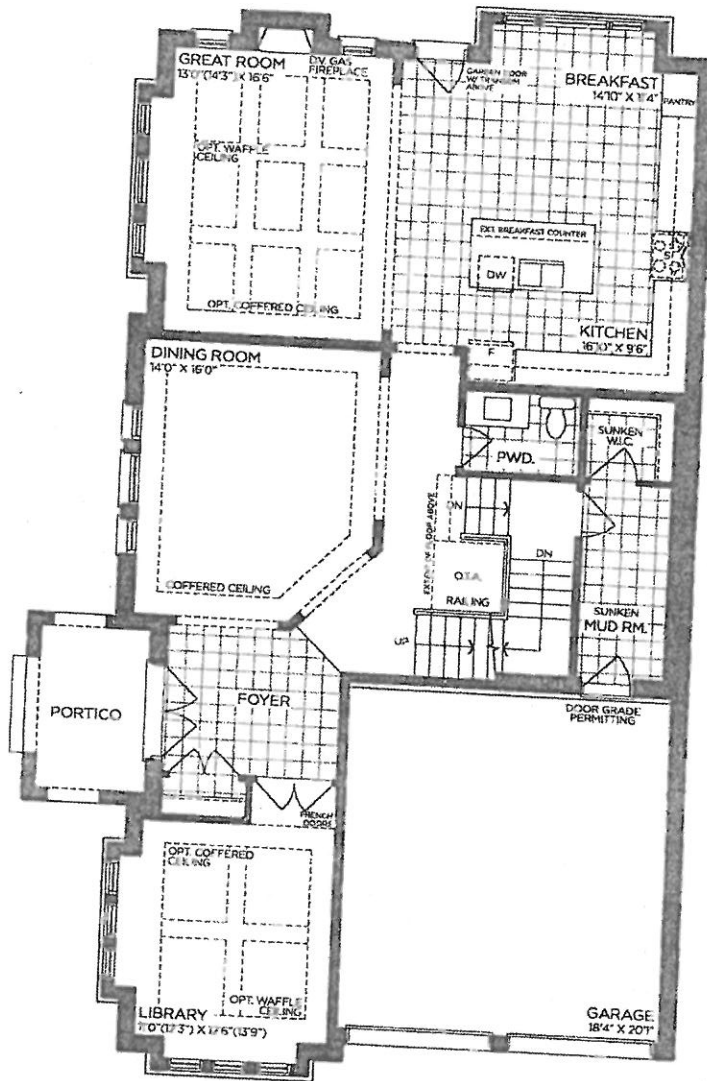

GROUND FLOOR | ELEV. A

VENDOR	
PURCHASER	RAF
PURCHASER	

GOLDPARK
WORTH MORE™

Prices, figures, illustrations, sizes, features and finishes are subject to change without notice. Areas and dimensions are approximate and actual usable floor space may vary from the stated area. Layout may be reverse of the unit purchased. E. & G.E. 4006




SCHEDULE 'F'

PV-30
June 14, 2021 *KA*

The Lilac

40' SERIES

Elevation A • 3,425 sq.ft.
Elevation B • 3,385 sq.ft.

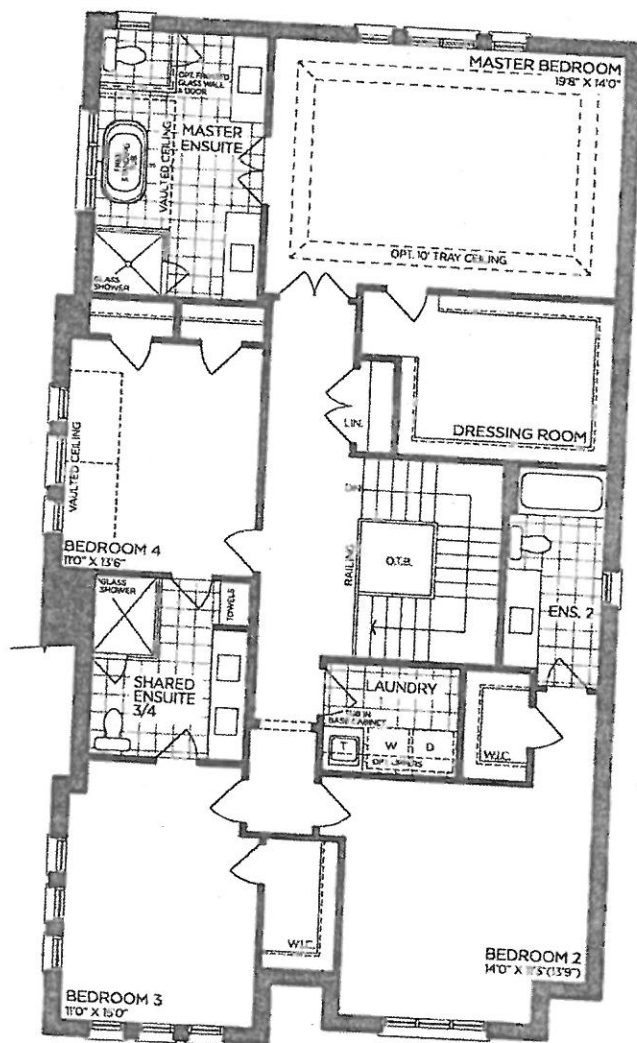

SECOND FLOOR | ELEV. A

VENDOR _____
PURCHASER *KA* _____
PURCHASER _____

GOLDPARK
WORTH MORE™

Prices, figures, illustrations, sizes, features and finishes are subject to change without notice. Areas and dimensions are approximate and actual usable floor space may vary from the stated area. Layout may be reverse of the unit purchased. E. & O.E. 4/0/06




SCHEDULE 'F'

PV-30
June 14, 2021

KA

The Lilac 40' SERIES

→ Elevation A • 3,425 sq.ft.
Elevation B • 3,385 sq.ft.

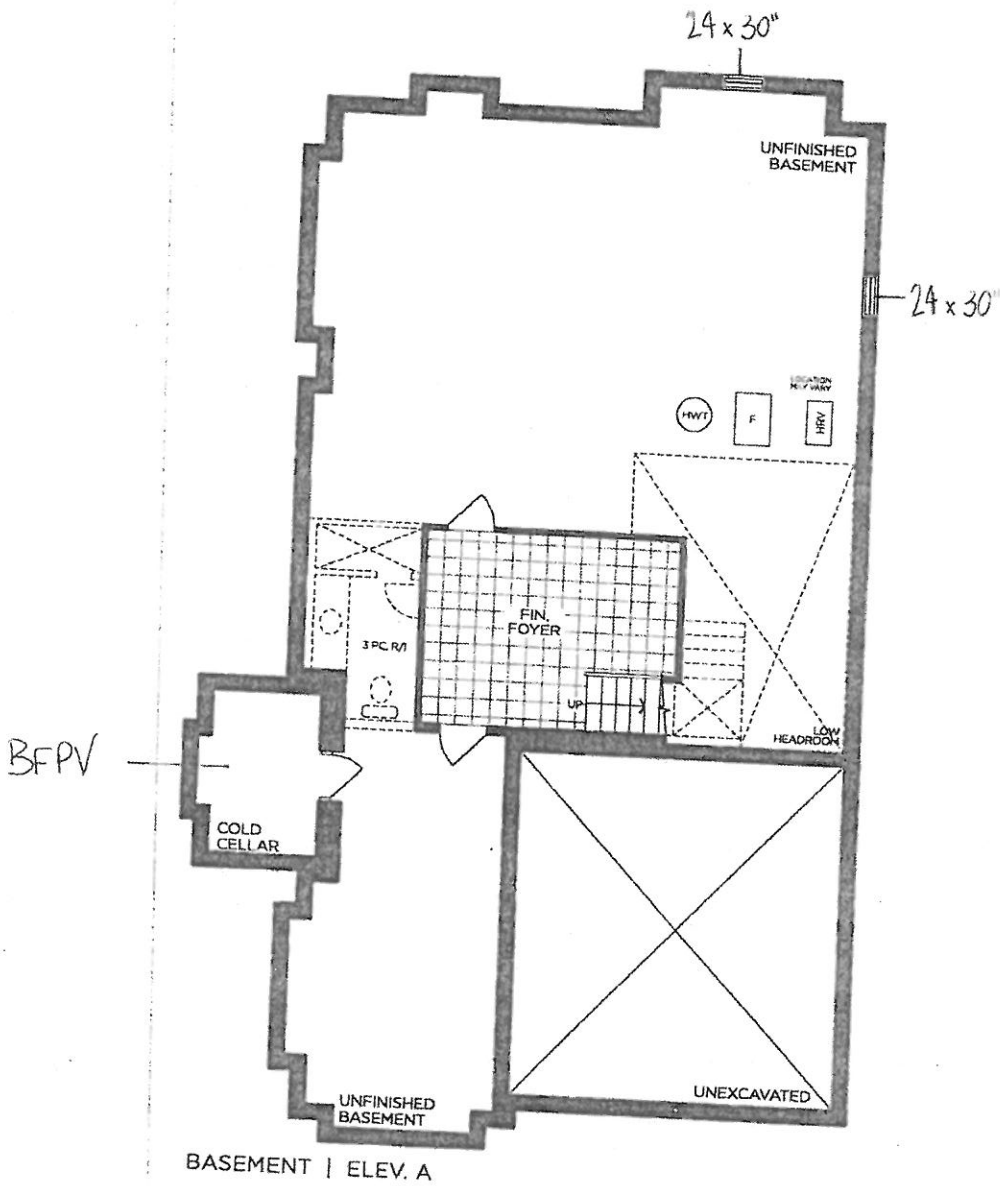

VENDOR _____
PURCHASER KA _____
PURCHASER _____

GOLDPARK
WORTH MORE™

Prices, figures, illustrations, sizes, features and finishes are subject to change without notice. Areas and dimensions are approximate and actual usable floor space may vary from the stated area. Layout may be reverse of the unit purchased. E. & O.E. 4006