



CONSTRUCTION SUMMARY

Lot: 25

Model: 42.02 A ROSEDALE OPT. LIBRARY

Project/Phase: Pine Valley Forevergreen / 1

APPLIANCES

Invoice	Qty.	Description
2848 72,217 26Jul21 **	1	KITCHEN - UPGRADE TO 8" DUCT (EXTERIOR WALL) IN LIEU OF STANDARD OFFERING

BASEMENT WINDOWS

Invoice	Qty.	Description
2716 72,351 06Jul21 **	3	BASEMENT WINDOWS - UPGRADE BASEMENT WINDOW SIZE TO 30 " X 24" - 8" FRAME

CENTRAL VAC AND WIRING

Invoice	Qty.	Description
2848 72,261 26Jul21 **	1	INSTALL VAC PAN UNDER KITCHEN SINK

DRYWALL

Invoice	Qty.	Description
2716 72,351 06Jul21 **	3	BASEMENT WINDOWS - UPGRADE BASEMENT WINDOW SIZE TO 30 " X 24" - 8" FRAME
2716 72,468 06Jul21 **	1	MODEL OPTIONS 42.02.A OR B - MASTER BEDROOM - OPT. 10 FOOT TRAY CEILING AS PER PLAN
2848 72,465 26Jul21	1	GREAT ROOM: MODEL OPTIONS 42.02 - GREAT ROOM - OPT. WAFFLE CEILING, BEAM DETAIL AS PER PLAN (9 BOXES) OPTION # 1 CTR-B07



CONSTRUCTION SUMMARY

Lot: 25

Model: 42.02 A ROSEDALE OPT. LIBRARY

Project/Phase: Pine Valley Forevergreen / 1

ELECTRICAL

Invoice	Qty.	Description
2716 72,351 06Jul21 **	3	BASEMENT WINDOWS - UPGRADE BASEMENT WINDOW SIZE TO 30 " X 24" - 8" FRAME
2848 72,292 26Jul21	1	FRONT EXTERIOR: ADDITIONAL EXTERIOR COACH LIGHT ON SAME SWITCH (BUILDERS STANDARD FIXTURE) - SEE PLAN FOR LOCATION
2848 72,281 26Jul21	1	GREAT ROOM: INTERIOR WALL OUTLET: ADDITIONAL 110V WALL INTERIOR RECEPTACLE ON EXISTING CIRCUIT FOR WALL MOUNTED TV - LOCATE ABOVE FIREPLACE, APPROX 66" A.F.F.
2848 72,289 26Jul21	6	GREAT ROOM: 4" E/S LED INTERIOR POT LIGHT - GROUND FLOOR - EACH - INCLUDES 1 SWITCH INCLUDED IN APS STANDARD CEILING LIGHT TO REMAIN
2848 72,289 26Jul21	2	GREAT ROOM: 4" E/S LED INTERIOR POT LIGHT - GROUND FLOOR - EACH SAME SWITCH AS OTHER POT LIGHTS
2848 72,273 26Jul21	1	KITCHEN: 110V WALL RECEPTACLE ON SEPARATE CIRCUIT - GAS FIRED APPLIANCE - FOR AUX. EQUIPMENT - NOT A STOVE PLUG APPLIANCE SPECS ARE FOR SIZING PURPOSES ONLY LOCATION MAY NEED TO BE ADJUSTED (BY OWN TECHNICIAN) BEFORE APPLIANCES ARE INSTALLED
2848 72,272 26Jul21	1	KITCHEN: 110V WALL RECEPTACLE ON SEPARATE CIRCUIT - FOR MICROWAVE - MICROWAVE NOT INCLUDED APPLIANCE SPECS ARE FOR SIZING PURPOSES ONLY LOCATION MAY NEED TO BE ADJUSTED (BY OWN TECHNICIAN) BEFORE APPLIANCES ARE INSTALLED
2848 72,307 26Jul21	1	KITCHEN: RELOCATE STANDARD CEILING MOUNT FIXTURE TO APPROX CENTER ABOVE ISLAND
2848 72,306 26Jul21	1	KITCHEN: RELOCATE FRIDGE FROM STANDARD LOCATION - APPROX. "NEW" LOCATION AS PER ATTACHED DRAWINGS
2848 72,272 26Jul21	1	KITCHEN: 110V WALL RECEPTACLE ON SEPARATE CIRCUIT - FOR BUILT-IN COFFEE MACHINE. APPLIANCE NOT INCLUDED APPLIANCE SPECS ARE FOR SIZING PURPOSES ONLY LOCATION MAY NEED TO BE ADJUSTED (BY OWN TECHNICIAN) BEFORE APPLIANCES ARE INSTALLED
2848 72,307 26Jul21	1	UPPER HALL: RELOCATE STANDARD CEILING MOUNT FIXTURE TO APPROX CENTER OF OTB - SEE PLAN FOR LOCATION
2848 72,281 26Jul21	1	MASTER BEDROOM: INTERIOR WALL OUTLET: ADDITIONAL 110V WALL INTERIOR RECEPTACLE ON EXISTING CIRCUIT FOR WALL MOUNTED TV - LOCATE APPROX 60" A.F.F.



CONSTRUCTION SUMMARY

Lot: 25

Model: 42.02 A ROSEDALE OPT. LIBRARY

Project/Phase: Pine Valley Forevergreen / 1

ELECTRICAL

Invoice	Qty.	Description
2848 72,274 26Jul21	1	GARAGE: 220V WALL RECEPTACLE ON SEPARATE CIRCUIT FOR ELECTRIC CAR
2848 72,285 26Jul21	1	MASTER ENSUITE/ ENSUITE 2/ ENSUITE 3/ ENSUITE 4: INTERIOR WALL OUTLET: ADDITIONAL INTERIOR GFI RECEPTACLE - LOCATE ON WALL BEHIND TOILET, APPROX 12" A.F.F.
2848 72,285 26Jul21	1	MASTER ENSUITE: IN ADDITION TO STANDARD, ADD INTERIOR WALL OUTLET: ADDITIONAL INTERIOR GFI RECEPTACLE - AT VANITY SEE PLAN FOR LOCATION

FORMING

Invoice	Qty.	Description
2716 72,205 06Jul21	1	PINE VALLEY MODEL 42.02 ROSEDALE ELEV A - 9 FOOT BASEMENT CEILING HEIGHT IN LIEU OF STANDARD 8 FOOT CEILING. INCLUDED IN APS
2716 06Jul21 ** NoCat	1	PINE VALLEY MODEL 42.02 ROSEDALE ELEV A - 9 FOOT BASEMENT CEILING HEIGHT IN LIEU OF STANDARD 8 FOOT CEILING.
2716 06Jul21 ** NoCat	1	PINE VALLEY MODEL 42.02 ROSEDALE ELEV A - 9 FOOT BASEMENT CEILING HEIGHT IN LIEU OF STANDARD 8 FOOT CEILING.
2716 06Jul21 ** NoCat	1	PINE VALLEY MODEL 42.02 ROSEDALE ELEV A - 9 FOOT BASEMENT CEILING HEIGHT IN LIEU OF STANDARD 8 FOOT CEILING.

FRAMING

Invoice	Qty.	Description
2848 72,690 26Jul21	1	KITCHEN: DELETE KITCHEN BULKHEAD, IF POSSIBLE, SITE APPROVAL REQUIRED UNLESS ADDITIONAL CABINETRY IS PURCHASED, THERE WILL BE A GAP ABOVE CABINETS
2848 72,631 26Jul21	1	MASTER ENSUITE: SHOWER NICHE [SHAMPOO SHELF] - COMPLETE WITH MATCHING MARBLE JAMBS ON 4 SIDES, STANDARD TILE, APPROX. 12 X 18 INSTALLED VERTICALLY - SEE PLAN FOR LOCATION



CONSTRUCTION SUMMARY

Lot: 25

Model: 42.02 A ROSEDALE OPT. LIBRARY

Project/Phase: Pine Valley Forevergreen / 1

HVAC

Invoice	Qty.	Description
2848 72,224 26Jul21	1	KITCHEN: GAS LINE ROUGH-IN - MAIN FLOOR FOR APPLIANCE - SEE PLAN FOR LOCATION APPLIANCE SPECS ARE FOR SIZING PURPOSES ONLY LOCATION MAY NEED TO BE ADJUSTED (BY OWN TECHNICIAN) BEFORE APPLIANCES ARE INSTALLED
2848 72,217 26Jul21	1	KITCHEN - UPGRADE TO 8" DUCT (EXTERIOR WALL) IN LIEU OF STANDARD OFFERING

KITCHEN AND BATH CABINETRY

Invoice	Qty.	Description
2848 72,217 26Jul21 **	1	KITCHEN - UPGRADE TO 8" DUCT (EXTERIOR WALL) IN LIEU OF STANDARD OFFERING
2848 72,261 26Jul21 **	1	INSTALL VAC PAN UNDER KITCHEN SINK

NETWORK AND WIRING

Invoice	Qty.	Description
2848 72,259 26Jul21	1	GREAT ROOM: CONDUIT PIPE - FOR WALL MOUNT TV - LOCATE ABOVE FIREPLACE, APPROX 66" A.F.F., TERMINATING IN BASEMENT, NEAR ELECTRICAL PANEL
2848 72,261 26Jul21	1	INSTALL VAC PAN UNDER KITCHEN SINK
2848 72,259 26Jul21	1	MASTER BEDROOM: CONDUIT PIPE - FOR WALL MOUNT TV - LOCATE APPROX 60" A.F.F. TERMINATING IN BASEMENT NEAR ELECTRICAL PANEL
2848 72,258 26Jul21	1	LIBRARY: ADDITIONAL CAT6 ETHERNET OUTLET - EACH SEE PLAN FOR LOCATION
2848 72,264 26Jul21	1	MUD ROOM: ROUGH - IN FOR EXTRA SECURITY KEY PAD SEE PLAN FOR LOCATION
2848 72,260 26Jul21	1	CONDUIT PIPE - FROM ATTIC TO BASEMENT - FROM APPROX CENTER OF ATTIC TO NEAR ELECTRICAL PANEL IN BASEMENT



CONSTRUCTION SUMMARY

Lot: 25

Model: 42.02 A ROSEDALE OPT. LIBRARY

Project/Phase: Pine Valley Forevergreen / 1

NETWORKING/WIRING

Invoice	Qty.	Description
2848 72,261 26Jul21 **	1	INSTALL VAC PAN UNDER KITCHEN SINK

PLUMBING

Invoice	Qty.	Description
2848 72,332 26Jul21	1	KITCHEN: ROUGH-IN 1/4" COLD WATER LINE TO FRIDGE

Prices, figures, illustrations, sizes, features and finishes are subject to change without notice. Areas and dimensions are approximate and actual usable floor space may vary from the stated area. Layout may be reverse of the unit purchased. E. & O.E. 4202

SCHEDULE 'F'

PV-25
July 19, 2021












28



The Rosedale

42' SERIES

Elevation A • 3,655 sq.ft.
Elevation B • 3,605 sq.ft.
Elevation C • 3,590 sq.ft.

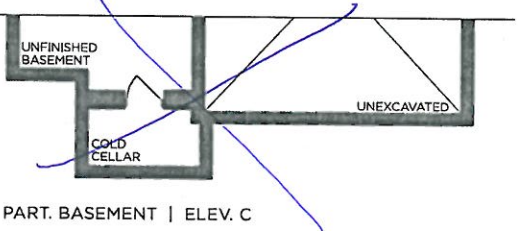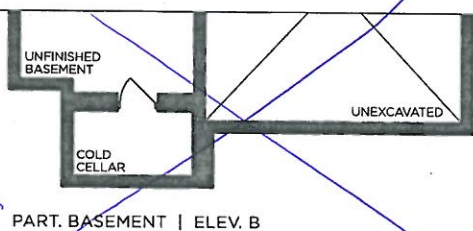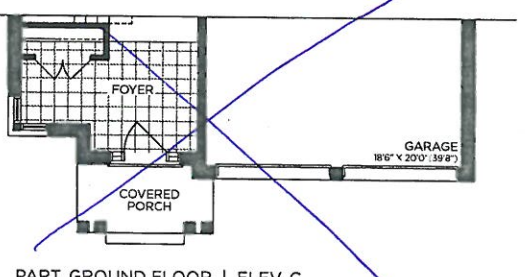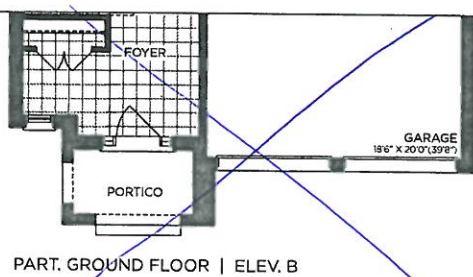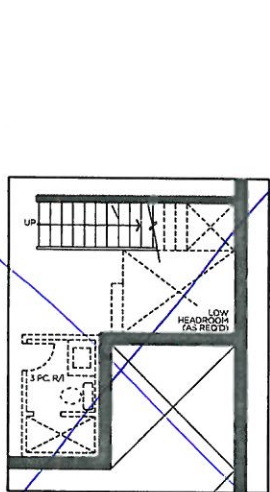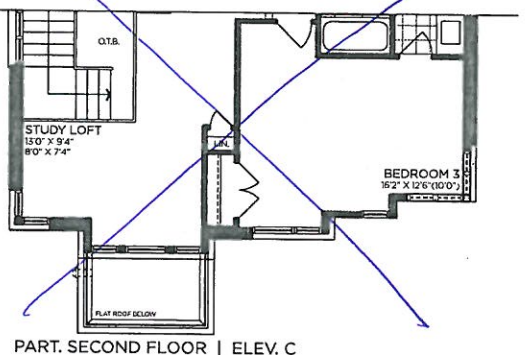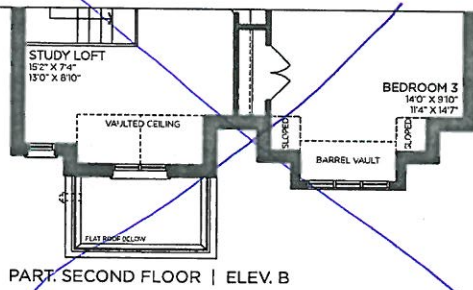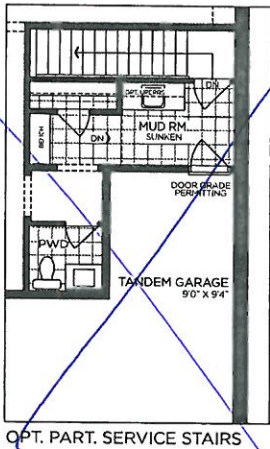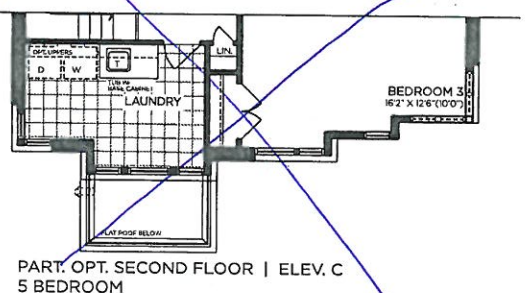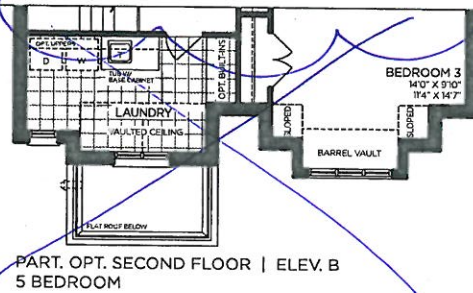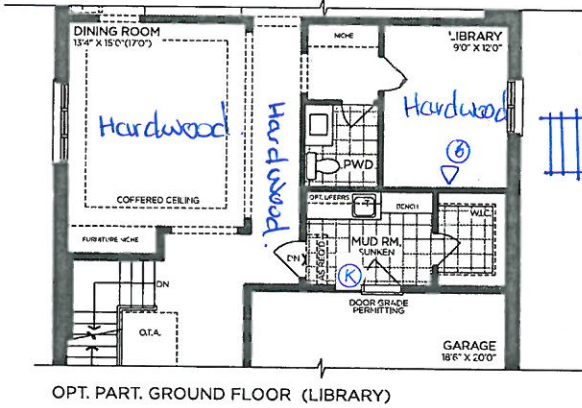

VENDOR

PURCHASER

PURCHASER

GOLDPARK
WORTH MORE™

Prices, figures, illustrations, sizes, features and finishes are subject to change without notice. Areas and dimensions are approximate and actual usable floor space may vary from the stated area. Layout may be reverse of the unit purchased. E. & O.E. 4202




SCHEDULE 'F'

PV-25
June 30, 2021 *attached*

PV-25
July 19, 2021 *2K*

The
Rosedale
42' SERIES

→ Elevation A • 3,655 sq.ft.
Elevation B • 3,605 sq.ft.
Elevation C • 3,590 sq.ft.

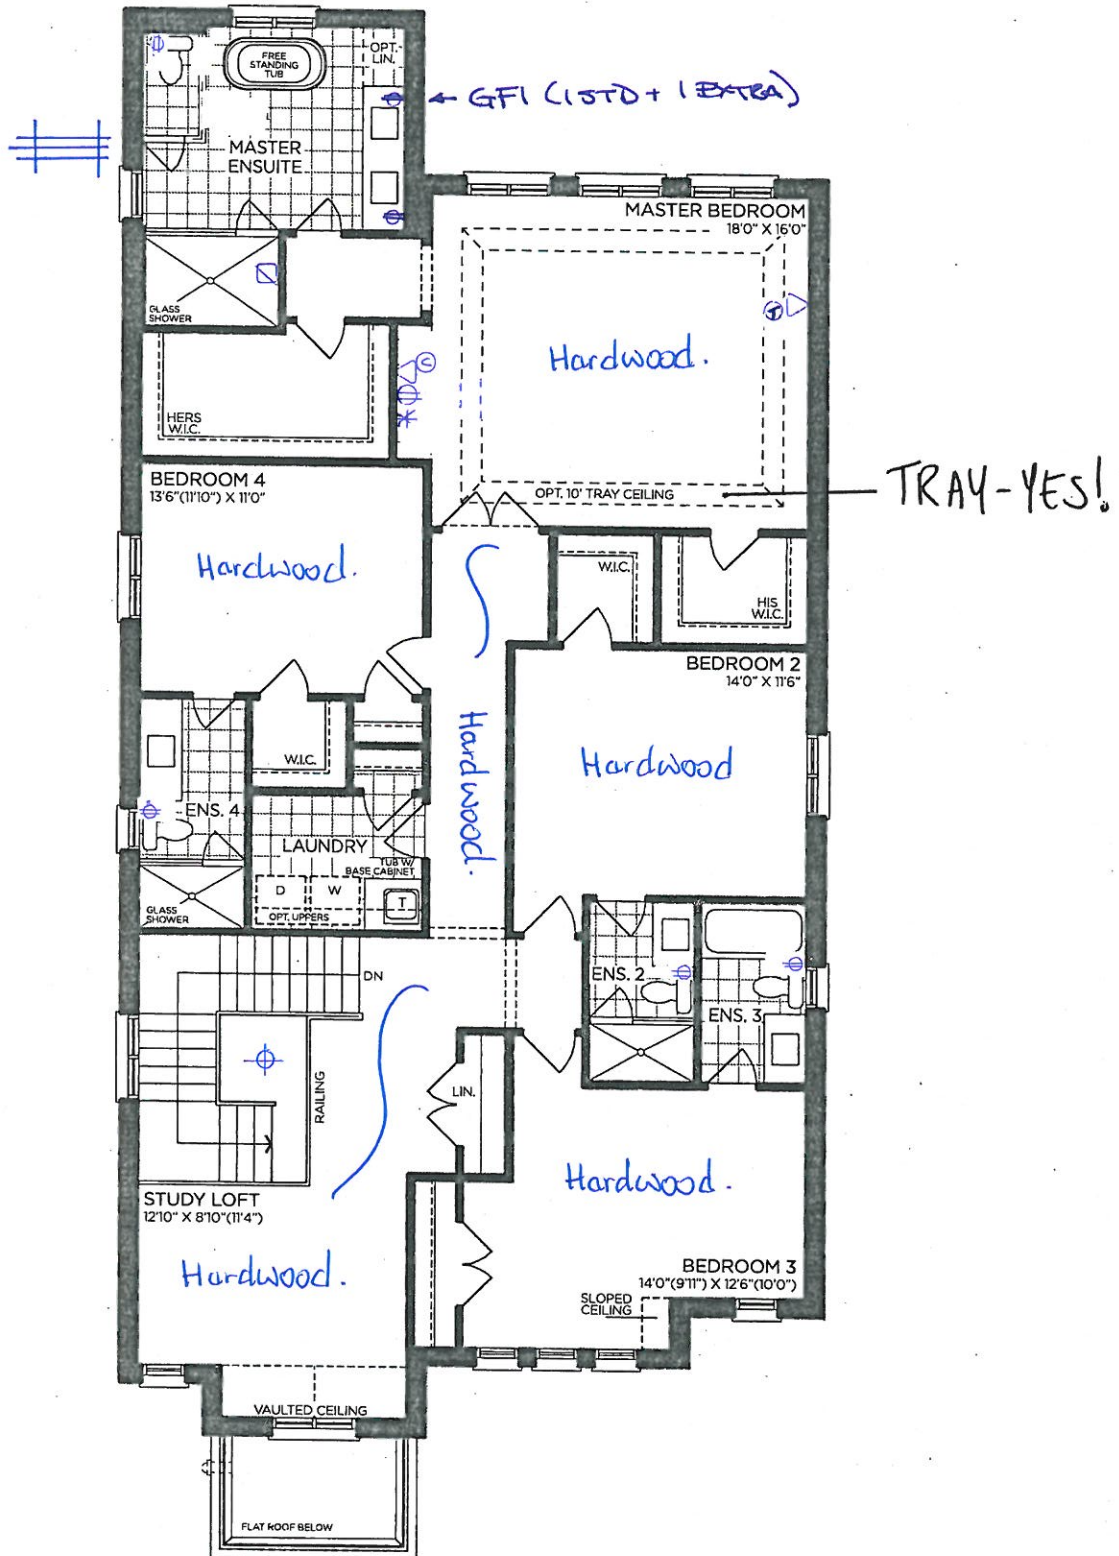

SECOND FLOOR | ELEV. A

VENDOR	
PURCHASER	
PURCHASER	

GOLDPARK
WORTH MORE™

Prices, figures, illustrations, sizes, features and finishes are subject to change without notice. Areas and dimensions are approximate and actual usable floor space may vary from the stated area. Layout may be reverse of the unit purchased. E. & O.E. 4202

SCHEDULE 'F'

PV-25
June 30, 2021 attached


PV-25 2K
July 19, 2021

The
Rosedale
42' SERIES

➤ Elevation A • 3,655 sq.ft.
Elevation B • 3,605 sq.ft.
Elevation C • 3,590 sq.ft.


PINE VALLEY
FOREVERGREEN

9' BASEMENT

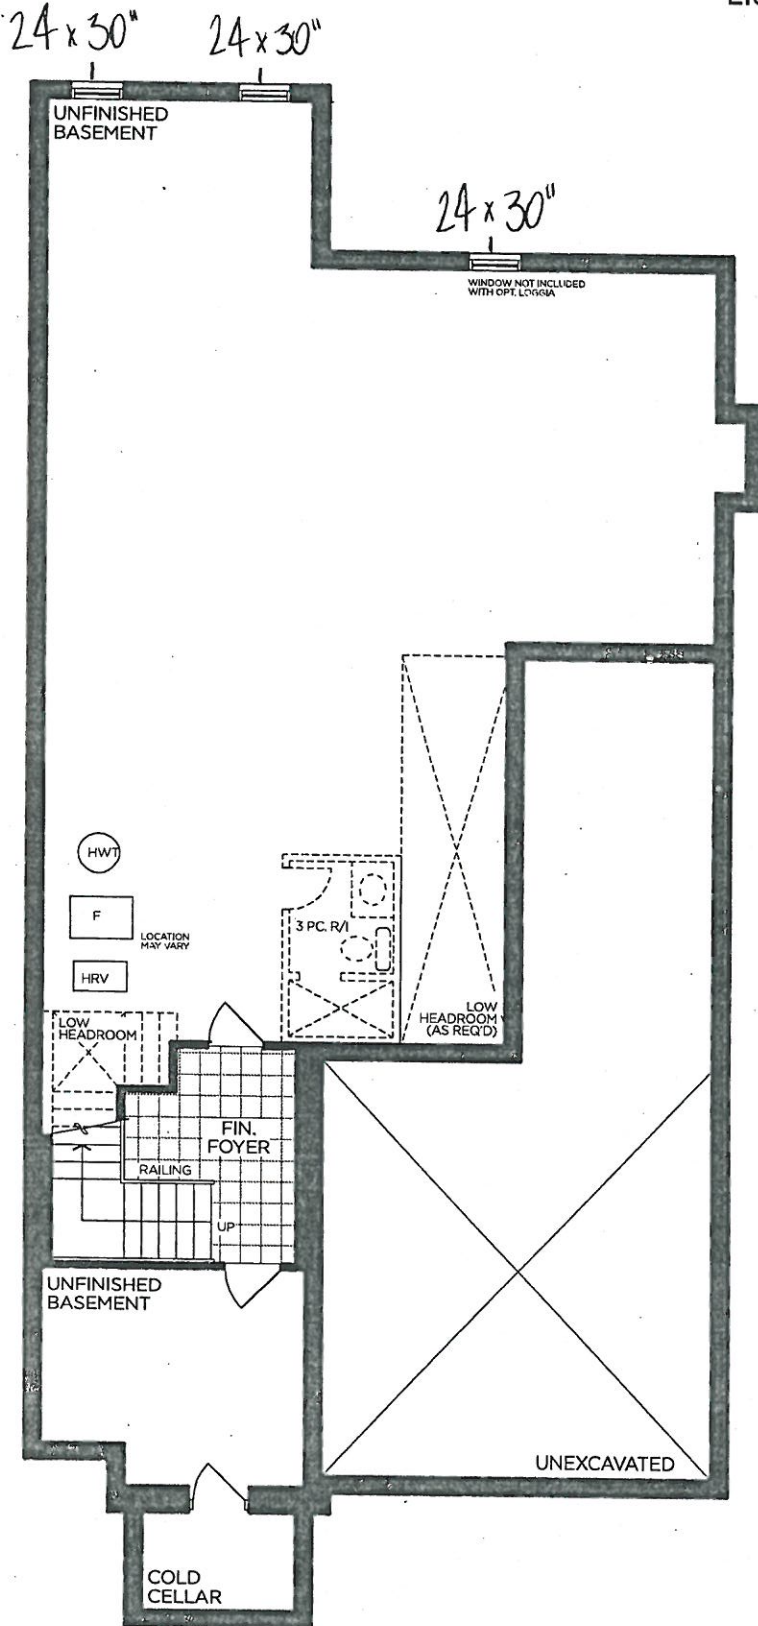

BASEMENT | ELEV. A

VENDOR	<input type="text"/>
PURCHASER	<input type="text"/>
PURCHASER	<input type="text"/>

GOLDPARK
WORTH MORE™

Prices, figures, illustrations, sizes, features and finishes are subject to change without notice. Areas and dimensions are approximate and actual usable floor space may vary from the stated area. Layout may be reverse of the unit purchased. E. & O.E. 4202