



CONSTRUCTION SUMMARY

Lot: 27
Model: 42.03 A FORESTCREST
Project/Phase: Pine Valley Forevergreen / 1

APPLIANCES

Invoice	Qty.	Description
2767 21May21 NoCat	1	APPLIANCE SPECIFICATIONS ATTACHED - SIGNED COPY

BASEMENT WINDOWS

Invoice	Qty.	Description
2638 72,351 17Mar21	4	BASEMENT WINDOWS - UPGRADE BASEMENT WINDOW SIZE TO 30 " X 24" - 8" FRAME

CERAMIC

Invoice	Qty.	Description
2721 49 23Apr21	1	MASTER ENSUITE: TILE, SHOWER WALL - LEVEL 3 - 12x24" LAID IN HORIZONTAL STACKED PATTERN
2721 45 23Apr21	1	MASTER ENSUITE: TILE, FLOOR - LEVEL 3 - 12x24" LAID IN STRAIGHT STACKED PATTERN - SEE PLAN FOR DIRECTION
2721 45 23Apr21	1	MASTER ENSUITE: TILE, SHOWER FLOOR - LEVEL 4 - HERRINGBONE MOSAIC
2721 36 23Apr21	1	ENSUITE 2: TILE, FLOOR - LEVEL 4 - 12x24" LAID IN STRAIGHT STACKED PATTERN - SEE PLAN FOR DIRECTION

CONCRETE AND DRAIN

Invoice	Qty.	Description
2638 101,930 17Mar21	1	BACK FLOW PREVENTER VALVE

DRYWALL

Invoice	Qty.	Description
2638 72,351 17Mar21 **	4	BASEMENT WINDOWS - UPGRADE BASEMENT WINDOW SIZE TO 30 " X 24" - 8" FRAME
2658 72,438 25Mar21	1	GREAT ROOM: MODEL OPTIONS 40.06 - GREAT ROOM - OPT. COFFERED CEILING AS PER PLAN



CONSTRUCTION SUMMARY

Lot: 27
Model: 42.03 A FORESTCREST
Project/Phase: Pine Valley Forevergreen / 1

ELECTRICAL

Invoice	Qty.	Description
2638 72,351 17Mar21 **	4	BASEMENT WINDOWS - UPGRADE BASEMENT WINDOW SIZE TO 30 " X 24" - 8" FRAME
2658 72,281 25Mar21	1	GREAT ROOM: INTERIOR WALL OUTLET: ADDITIONAL 110V WALL INTERIOR RECEPTACLE ON EXISTING CIRCUIT FOR WALL MOUNTED TV - APPROX 64" A.F.F. ABOVE FIREPLACE
2658 72,273 25Mar21	1	KITCHEN: 110V WALL RECEPTACLE ON SEPARATE CIRCUIT - GAS FIRED APPLIANCE - FOR AUX. EQUIPMENT - NOT A STOVE PLUG
2658 72,307 25Mar21	1	KITCHEN: RELOCATE STANDARD CEILING MOUNT FIXTURE TO CENTRE ON CEILING ABOVE ISLAND
2658 72,289 25Mar21	6	KITCHEN: 4" E/S LED INTERIOR POT LIGHT - GROUND FLOOR INCLUDED IN APS
2721 72,282 23Apr21	1	KITCHEN: ADDITIONAL 220V RECEPTACLE ON A SEPARATE CIRCUIT - FOR BUILT-IN WALL OVEN - APPLIANCE NOT INCLUDED - DOES NOT INCLUDE BREAKER THAT IS TO BE INSTALLED BY LICENSED ELECTRICIAN AND ARRANGED BY HOMEOWNER AFTER CLOSING FOR WALL OVENS
2721 23Apr21 NoCat	1	FYI - KITCHEN: FULL HEIGHT SLAB BACKSPLASH - LEVEL 4 QUARTZ

FORMING

Invoice	Qty.	Description
2638 72,208 17Mar21	1	PINE VALLEY MODEL 42.03 FORESTCREST ELEV A - 9 FOOT BASEMENT CEILING HEIGHT IN LIEU OF STANDARD 8 FOOT CEILING.

FRAMING

Invoice	Qty.	Description
2658 25Mar21 NoCat	1	GREAT ROOM: MODEL OPTIONS 40.06 - GREAT ROOM - OPT. COFFERED CEILING AS PER PLAN
2721 23Apr21 NoCat	1	***REVISED LAYOUT*** CHANGED TO 5 BEDROOM OPTION + ENSUITE 2 WITH TUB (INCLUDES STANDARD FINISHES) APS AMENDMENT - 5 BEDROOM PLAN, INCLUDES REDUCED SIZED MASTER W.I.C. WITH ENSUITE 2 BATH (SAME LAYOUT AS 4 BED PLAN)



CONSTRUCTION SUMMARY

Lot: 27
Model: 42.03 A FORESTCREST
Project/Phase: Pine Valley Forevergreen / 1

GLASS AND MIRROR

Invoice	Qty.	Description
2721 23Apr21 NoCat	4	MASTER ENSUITE / ENSUITE 3 / ENSUITE 4 / ENSUITE 5: UPGRADE SHOWER DOOR HARDWARE - CHROME

GRANITE MARBLE QUARTZ

Invoice	Qty.	Description
2721 23Apr21 NoCat	1	ENSUITE 2: UPGRADE QUARTZ COUNTERTOP - LEVEL 2
2721 23Apr21 NoCat	1	ENSUITE 4: UPGRADE QUARTZ COUNTERTOP - LEVEL 5
2721 23Apr21 NoCat	1	ENSUITE 5: UPGRADE QUARTZ COUNTERTOP - LEVEL 2
2721 23Apr21 NoCat	1	KITCHEN: COOKTOP CUT OUT

HARDWOOD

Invoice	Qty.	Description
2721 7 23Apr21	1	THRU OUT STANDARD AREAS: MAIN HALL/LIVING ROOM, GREAT ROOM, DINING ROOM, STUDY, UPPER HALL, MASTER BEDROOM, BEDROOM 2, BEDROOM 3, BEDROOM 4, BEDROOM 5 - VINTAGE SERIES, 5" WHITE OAK,NSS ENGINEERED HARDWOOD, 3/4" THK,SCULPTED TEXTURE, UVF FINISH- LEVEL 4

HVAC

Invoice	Qty.	Description
2658 72,224 25Mar21	1	KITCHEN: GAS LINE ROUGH-IN - MAIN FLOOR FOR APPLIANCE - SEE PLAN

INTERIOR TRIM /MOULDINGS

Invoice	Qty.	Description
2638 72,351 17Mar21 **	4	BASEMENT WINDOWS - UPGRADE BASEMENT WINDOW SIZE TO 30 " X 24" - 8" FRAME



CONSTRUCTION SUMMARY

Lot: 27
Model: 42.03 A FORESTCREST
Project/Phase: Pine Valley Forevergreen / 1

KITCHEN AND BATH CABINETRY

Invoice	Qty.	Description
2721 101,930 23Apr21	1	KITCHEN: UPGRADE QUARTZ COUNTERTOP - LEVEL 4
2721 23Apr21 NoCat	1	THRU OUT: SEE ATTACHED CABINETRY SCHEDULE
2721 23Apr21 NoCat	1	KITCHEN: FULL HEIGHT SLAB BACKSPLASH - LEVEL 4 QUARTZ

PAINT

Invoice	Qty.	Description
2658 25Mar21 NoCat	1	GREAT ROOM: MODEL OPTIONS 40.06 - GREAT ROOM - OPT. COFFERED CEILING AS PER PLAN

STAIR AND RAILINGS

Invoice	Qty.	Description
2721 100,238 23Apr21	2	MAIN STAIRS: 2ND FLOOR TO BASEMENT - STAIN STAIRS AND LANDINGS WILL NOT MATCH HARDWOOD IN COLOUR, SPECIES, OR TEXTURE
2721 93,800 23Apr21	2	MAIN STAIRS - 2ND FLOOR TO BASEMENT: UPGRADE - EURONLINE (ALL PLAIN) PICKET, 3" HALF-ROUND W/V-GROOVE HANDRAIL, 3 1/2" ALL SQUARE POST WITH PYRAMID TOP POST CAP - PACKAGE A-2



CONSTRUCTION SUMMARY

Lot: 27

Model: 42.03 A FORESTCREST

Project/Phase: Pine Valley Forevergreen / 1

WINDOWS - BASEMENT

Invoice	Qty.	Description
2638 72,351 17Mar21 **	4	BASEMENT WINDOWS - UPGRADE BASEMENT WINDOW SIZE TO 30 " X 24" - 8" FRAME

*** NOTE: This is not an approved document. Document must be locked ***

Scheduled Closing Date: Thursday, August 26, 2021

Purchasers: NARINDER, KAUR DULAY & GURMEL, SINGH Property: 27 of Plan -

Telephone Res. / Bus: /

Project: Pine Valley Forevergreen - Phase 1

Decor Advisor: Angela Phim

Model and Elevation: 42.03 A FORESTCREST

Layout Changes: ☐ Yes ☐ No

Sketch Attached: ☒ Yes ☐ No

Exterior Colour Scheme:

1. Cabinetry

	Style and Colour	Counter	Hardware
Kitchen / Breakfast	Alban 'Storm Grey Oak'	*Quartz: 'Pearl Jasmine'	attach
Laundry Room	Bowery 'Ello'	P-Lam 'White'	attach
Powder Room	Alban 'Storm Grey Oak'	Quartz: 'Nordic Loft'	attach
Mud Room	Alban 'Storm Grey Oak'	P-Lam: 'White'	attach
Master Ensuite Bathroom	Alban 'Storm Grey Oak'	Quartz: 'Nordic Loft'	attach
Second Ensuite Bathroom (If Applicable)	Tribeca 'Bianca'	*Quartz: 'Raven'	attach
Ensuite 3	Alban 'Storm Grey Oak'	Quartz: 'Nordic Loft'	attach

Comment

Ensuite 4 Cab: *Wexford 'Classic White' + *Quartz: 'Empira Black' / Ensuite 5 Cab: Alban 'Storm Grey Oak' + *Quartz: 'Raven'

REVISED
July 16, 2021
attached

2. Floor Tile

	Selection
Entrance Vestibule	13x13" Costa 'White'
Main Hall	n/a
Kitchen / Breakfast	*see hardwood 13x13" Costa "White"
Laundry Room	13x13" Costa 'White'
Powder Room	13x13" Costa 'White'
Mud Room	13x13" Costa 'White'
Master Ensuite Bathroom	*12x24" Eterna 'Imperial Grey' polished
Second Ensuite Bathroom (If Applicable)	*12x24" Reve 'Nuit'
Lower Landing (If Applicable)	13x13" Costa 'White' (basement foyer)
Ensuite 3	13x13" Costa 'White'

Comment

Ensuite 4: 13x13" Camebridge 'White' / Ensuite 5: 13x13" New Reeds / Master Ensuite Shower Floor: *Eterna 'Imperial Grey' Herringbone / Thru-out shower floors: 2x2" standard 'white'

↳ 'Taupe'

REVISED
June 4, 2021
see email

3. Wall Tile

	Selection	Listello/Inserts	Describe
Ensuite 4	8x10" Weave 'White'	☐ Yes ☒ No	
Master Ensuite Bathroom			
Tub Deck		☐ Yes ☒ No	
Shower Stall	*12x24" Eterna 'Imperial Grey' pol	☐ Yes ☒ No	
Bathroom Walls		☐ Yes ☒ No	
Second Ensuite Bathroom (If Applicable)	8x10" Uniwall 'White'	☐ Yes ☒ No	
Ensuite 3	8x10" Weave 'White'	☐ Yes ☒ No	
Kitchen Backsplash	☒ Yes ☐ No		Backsplash Behind Fridge

Comment

Ensuite 5: 8x10" Weave 'Tender Grey'

same as Counter.

A *JD*

Scheduled Closing Date: Thursday, August 26, 2021

Purchasers:

NARINDER, KAUR DULAY & GURMEL, SINGH Property: 27 of Plan -

Telephone Res. / Bus: /

Project: Pine Valley Forevergreen - Phase 1

Decor Advisor:

Angela Phim

Model and Elevation: 42.03 A FORESTCREST

4. Plumbing Fixtures

☐	Second Ensuite	☐	Powder Room	☐	
Master Ensuite Bathroom	☐	Other Room - Specify	☐	Other Washroom	☐

Comment

*see attached plumbing upgrades

REVISED
July 16, 2021

attached

5. Hardwood Flooring

	Type and Stain		Type and Stain
Main Hall		Upper Landing	
Kitchen / Breakfast	*5x3/4" WhtOak, Sculpted, Apollo*	Upper Hall	
Living Room	*delete - see file*	Master Bedroom	
Dining Room		Bedroom #2	
Family Room		Bedroom #3	
Den/Library		Bedroom #4	
Entrance Vestibule		Bedroom #5	
Lower Landing (If Applicable)		Other Room - Specify thru-out standard areas	*5x3/4" WhtOak, Sculpted, Apollo

Comment

6. Carpeting

	Upgrade	Description
Ground Floor	☐	
Second Floor	☐	
	☐	

Upgrade Underpad

Type

Area

Carpet on Stairs

Capped

Runner - *Upgrade

Comment

7. Fireplace

	Living Room			Family Room			Other Room - Specify			Great Room
	Purchased	As Per Plan	N/A	Purchased	As Per Plan	N/A	Purchased	As Per Plan	N/A	
Fireplace Type	☐	☐	☐	☐	☐	☐	☐	☒	☐	Standard Gas
Mantle Type										Mediterranean
Colour / Stain										Arctic White
Surround										n/a
Hearth										n/a

Comment

June 4, 2021

See email

D

GSD

Purchasers: NARINDER, KAUR DULAY & GURMEL, SINGH Property: 27 of Plan -

Telephone Res. / Bus: /

Project: Pine Valley Forevergreen - Phase 1

Decor Advisor: Angela Phim

Model and Elevation: 42.03 A FORESTCREST

8. Trim Carpentry

Interior Doors Front Door Glass Inserts Door Handles

Interior Trim

Comment

9. Plaster Mouldings and Medallions

Standard Throughout ☐ Yes ☐ No ☐ N/A

Entrance Vestibule			Kitchen/Breakfast		
Main Hall			Den/Library		
Living Room			Lower Landing		
Dining Room			Other Room - Specify		
Family Room					

Comment

10. Railings and Spindles

Railing Package

Railing Colour

Stringer / Riser

Spindle Colour

Treads

Oak Stairs ☒ Yes ☐ No ☐ N/A

Comment

11. Wall Paint / Ceilings

Throughout Finished Areas

Trim Paint

Smooth Ceilings

Ground Floor ☒

Second Floor ☒

Note

Comment

July 16, 2021
attached

June 4, 2021
see email

A. Goo

Scheduled Closing Date: Thursday, August 26, 2021

Purchasers:

NARINDER, KAUR DULAY & GURMEL, SINGH Property: 27 of Plan -

Telephone Res. / Bus: /

Project: Pine Valley Forevergreen - Phase 1

Decor Advisor:

Angela Phim

Model and Elevation: 42.03 A FORESTCREST

12. Electrical

Hood Fan ☐ White ☐ Stainless ☒ N/AAbove Kitchen Cabinet Light ☐ Yes ☒ NoStandard Appliances ☐Below Kitchen Cabinet Light ☐ Yes ☒ NoOver The Range Microwave ☐Chimney Style Fan ☒

Comment

13. Heating and Air Conditioning

Air Conditioning Gas Provisions Stove Gas Provisions Dryer Gas Provisions Barbecue

Comment

14. Additional Comments

15. Disclaimers and Notes

- 1) Colours of all materials are as close as possible to builder's selection, but not necessarily identical due to variances in manufacturing.
- 2) Any extras listed above are null and void unless accompanied by a separate invoice/amendment. Said invoice must be paid in full.
- 3) The Purchaser acknowledges that after Interior Colour Selection form is signed and dated, no further changes will be permitted other than re-selection due to unavailability. _____ Purchaser's Initials
- 4) The Purchaser acknowledges reading and accepting the "Gold Park Homes Decor Centre Disclaimers" form. This document contains other miscellaneous disclaimers.

This Interior Colour Selection is final and approved by:

Signature: Date: June 4, 2021

GOLDPARK

INTERIOR COLOUR SCHEME

NOTE: This is not an approved document. Document must be locked ***

Purchasers: NARINDER, KAUR DULAY & GURMEL, SINGH Scheduled Closing Date: Thursday, August 26, 2021

Telephone Res. / Bus: / Project: Price Valley Foreargreen - Phase 1

Decor Advisor: Angela Phim Model and Elevation: 42.03 A FORESTCREST

Layout Changes: ☐ Yes ☒ No Sketch Attached: ☒ Yes ☐ No Exterior Colour Scheme: _____

1. Cabinetry	Style and Colour	Counter	Hardware
Kitchen / Breakfast	Alban Storm Grey Oak	Quartz Pearl Jasmint	attach
Laundry Room	Bowery Elm	P-Lam White	attach
Powder Room	Alban Storm Grey Oak	Quartz Nordic Left	attach
Mud Room	Alban Storm Grey Oak	P-Lam White	attach
Master Ensuite Bathroom	Alban Storm Grey Oak	Quartz Nordic Left	attach
Second Ensuite Bathroom (If Applicable)	Trbecca Bianca	Quartz Raven	attach
Ensuite 3	Alban Storm Grey Oak	Quartz Nordic Left	attach

Comment: Ensuite 4 Call: Weiland Classic White - Quartz Empire Blue / Ensuite 5 Call: Alban Storm Grey Oak - Quartz French

2. Floor Tile	Selection
Entrance Vestibule	13x13 Costa White
Main Hall	n/a
Kitchen / Breakfast	see hardwood - 12x12 10.44 White
Laundry Room	13x13 Costa White
Powder Room	13x13 Costa White
Mud Room	13x13 Costa White
Master Ensuite Bathroom	12x24 Eterna Imperial Grey polished
Second Ensuite Bathroom (If Applicable)	12x24 Revo Nub
Lower Landing (If Applicable)	13x13 Costa White (basement foyer)
Ensuite 3	13x13 Costa White

Comment: Ensuite 4: 13x13 Classic White / Ensuite 5: 13x13 Key Floor / Master Ensuite Shower Floor: Eterna Imperial Grey Homogeneous 12x24 shower floor, 2x2 standard white

3. Wall Tile	Selection	Listed/Unlisted	Describe
Ensuite 4	8x10 Weave White	☐ Yes ☒ No	
Master Ensuite Bathroom			
Tub Deck		☐ Yes ☒ No	
Shower Stall	12x24 Eterna Imperial Grey pol	☐ Yes ☒ No	
Bathroom Walls		☐ Yes ☒ No	
Second Ensuite Bathroom (If Applicable)	8x10 Weave White	☐ Yes ☒ No	
Ensuite 3	8x10 Weave White	☐ Yes ☒ No	
Kitchen Backsplash	☒ Yes ☐ No		Backsplash Behind Fridge

Comment: Ensuite 4: 8x10 Weave Tenor Grey

GOLDPARK WORTH NOTE		INTERIOR COLOUR SCHEME	
*** NOTE: This is not an approved document. Document must be locked ***			
Purchasers: NARINDER, KAUR DULAY & GURMEL, SINGH		Scheduled Closing Date: Thursday, August 26, 2021	
Telephone (Res. / Bus): /		Property: 27 of Plan -	
Decor Advisor: Angela Pham		Project: Pine Valley/Forevergreen - Phase 1	
		Model and Elevation: 42.03 A FORESTCREST	
4. Plumbing Fixtures			
Master Ensuite Bathroom	☐	Second Ensuite	☐
	☐	Other Room - Specify	☐
Powder Room	☐		☐
Other Washroom	☐		☐
Comment: Please attached plumbing upgrades			
5. Hardwood Flooring			
Main Hall	☐	Upper Landing	☐
Kitchen / Breakfast	☐	Upper Hall	☐
Living Room	☐	Master Bedroom	☐
Dining Room	☐	Bedroom #2	☐
Family Room	☐	Bedroom #3	☐
Den/Library	☐	Bedroom #4	☐
Entrance Vestibule	☐	Bedroom #5	☐
Lower Landing (If Applicable)	☐	Other Room - Specify	☐
Comment: 15x3/4" White Oak Sculpted Apollo thru-out standard area			
6. Carpeting			
Ground Floor	☐	Description	☐
Second Floor	☐		☐
Upgrade Underpad			
	☐	Type	Area
Carpet on Stairs	☐	Carpeted	Runner - Upgrade
Comment:			
7. Fireplace			
Living Room	☐	Family Room	☐
Other Room - Specify	☐	Great Room	☐
Fireplace Type	☐	Standard Gas	☐
Mantle Type	☐	Mediterranean	☐
Colour / Stain	☐	Arctic White	☐
Surround	☐	r/h	☐
Hearth	☐	t/h	☐
Comment:			

ARK
WORTH HOLE

GOLDPARK *** NOTE: This is not an approved document. Document must be locked ***
 INTERIOR COLOUR SCHEME
 WORTH NOTE
 Scheduled Closing Date: Thursday, August 28, 2021
 Purchasers: **NARINDER, KAUR DULAY & GURMEL, SINGH** Property: 27 of Plan -
 Telephone Res./Bus: /
 Decor Advisor: **Angela Pihm**
 Project: Pine Valley Forevergroen - Phase 1
 Model and Elevation: 42.03A FORESTCREST

Scheduled Closing Date: Thursday, August 26, 2021

Scheduled Closing Date: Thursday, August 26, 2021

Purchasers: NARINDER KAUR DULAY & GURMEL SINGH Property: 27 of Plan -

Project: Pine Valley Forevergreen - Phase 1

Decor Advisor: Angela Phim

r-12. Electrical-

Hood Fan ☐ White ☐ Stainless ☒ N/A

Above Kitchen Cabinet Light ☐ Yes ☒ No

Below Kitchen Cabinet Light ☐ Yes ☒ No

Standard Appliances ☐

Over The Range Microwave ☐

Chimney Style Fan ☒

Comment

13. Heating and Air Conditioning

Air Conditioning ☐ no

Gas Provisions Stay

Gas Provisions Dryer	no
----------------------	----

Gas Provisions Barbo

Comment

-14. Additional Comments

15. Disclaimers and Notes

- 1) Colours of all materials are as close as possible to builder's selection, but not necessarily identical due to variances in manufacturing.
- 2) Any extras listed above are null and void unless accompanied by a separate invoice/commitment. Said invoice must be paid in full.
- 3) The Purchaser acknowledges that after Interior Color Selection form is signed and dated, no further changes will be permitted other than re-selection due to unavailability. _____ Purchaser's Initials
- 4) The Purchaser acknowledges reading and accepting the "Gold Park Homes Decor Centre Disclaimers" form. This document contains other miscellaneous disclaimers.

This Interior Colour Selection is final and approved by:


Signature: _____

Date:

Printed 4/21/2021 14:31:20

Page 4 of 4

PV-27 ~~attached~~
May 4, 2021

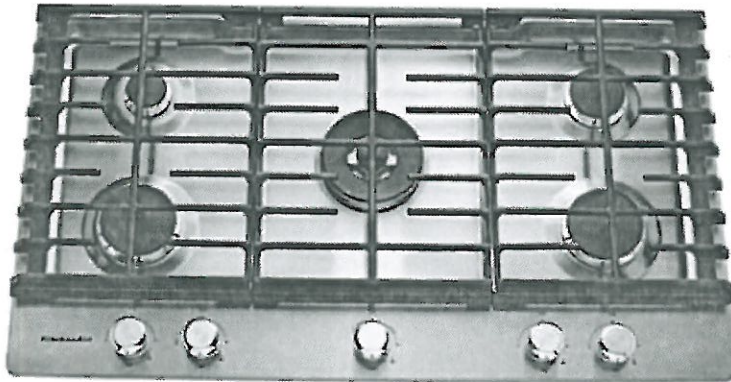

KITCHENAID 36" 5- BURNER GAS COOKTOP – STAINLESS STEEL

\$ 1,649.00

SKU: KCGS556ES

VSN: KCGS556ESS

Dimensions

Width: 36" (91.4 cm) Height: 3.62" (9.2 cm) Depth: 21" (53.3 cm)

Experience the convenient technology this cooktop from KitchenAid offers. Even-Heat™ technology uses a diffuser plate to allow for more control of the cooktop, making it ideal for melting chocolate or simmering sauce. With a professional dual-ring burner and electronic ignition, this cooktop makes it simple to whip up countless masterpieces. What's more, its CookShield finish helps protect against spills and stains while making the cooktop easy to wipe clean without the use of harsh chemicals.

KitchenAid


Key Features:

- Even-Heat Technology
- Professional Dual-Ring Burner
- CookShield Finish
- Electronic Ignition

PV-27 attached
 May 4, 2021


Product Dimensions

KCGS550ESS and KCGS950ESS Models

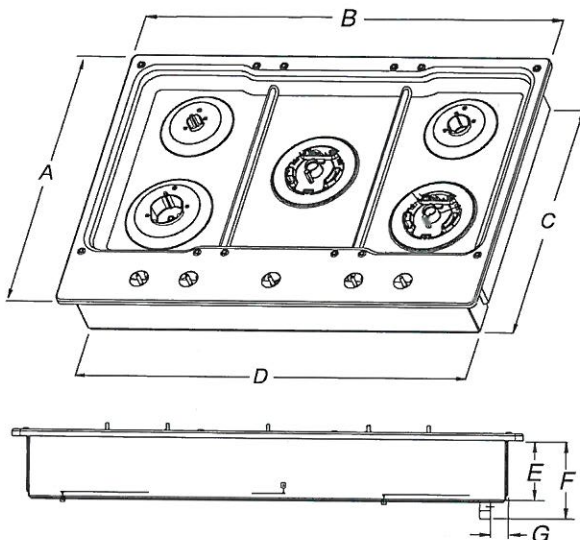


- | | |
|---|---|
| A. 21" (53.3 cm) | E. 3 ⁵ / ₈ " (9.2 cm) |
| B. 30" (76.2 cm) | F. 4 ⁹ / ₁₆ " (11.6 cm) |
| C. 19 ³ / ₈ " (49.2 cm) | G. 1 ³ / ₈ " (3.4 cm) |
| D. 28 ³ / ₈ " (72.1 cm) | |

KCGS556ESS and KCGS956ESS Models

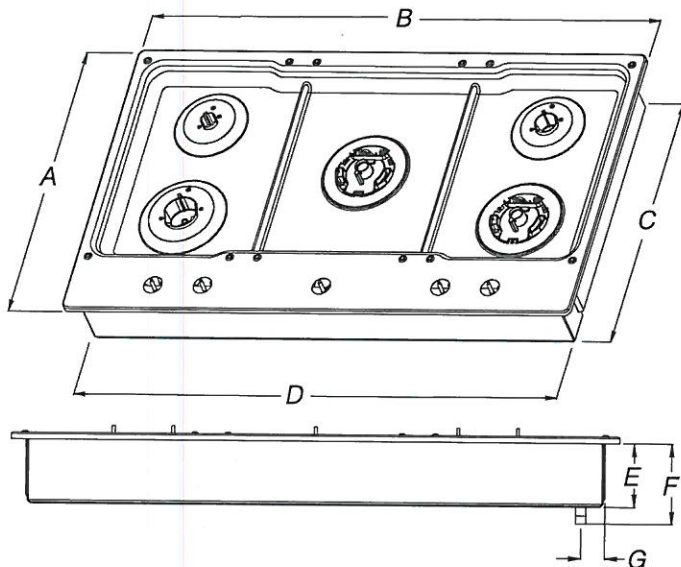


- | | |
|---|---|
| A. 21" (53.3 cm) | E. 3 ⁵ / ₈ " (9.2 cm) |
| B. 36 ¹ / ₄ " (92.0 cm) | F. 4 ⁹ / ₁₆ " (11.6 cm) |
| C. 19 ³ / ₈ " (49.2 cm) | G. 1 ⁷ / ₁₆ " (3.6 cm) |
| D. 34 ³ / ₈ " (88.1 cm) | |

All Other 30" (76.2 cm) Models

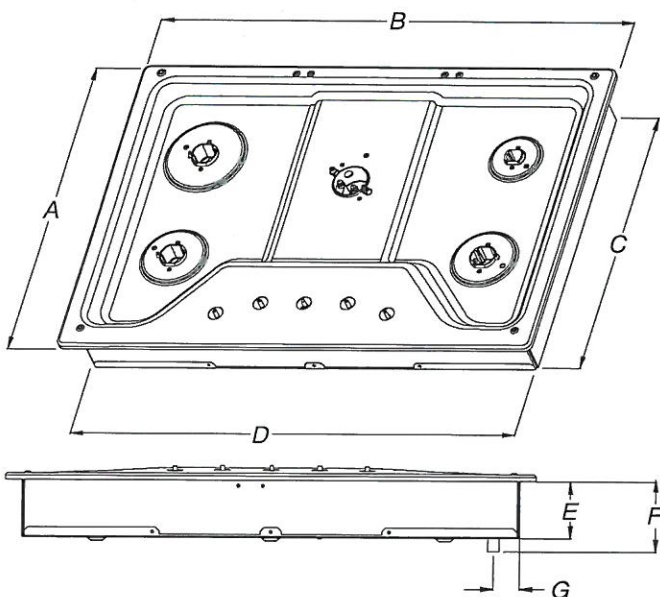

- | | |
|---|--|
| A. 21" (53.3 cm) | E. 3 ³ / ₈ " (8.6 cm) |
| B. 30" (76.2 cm) | F. 4 ¹ / ₈ " (10.5 cm) |
| C. 18 ⁷ / ₈ " (48.0 cm) | G. 1 ¹ / ₂ " (3.8 cm) |
| D. 28 ³ / ₈ " (72.1 cm) | |


All Other 36" (91.4 cm) Models

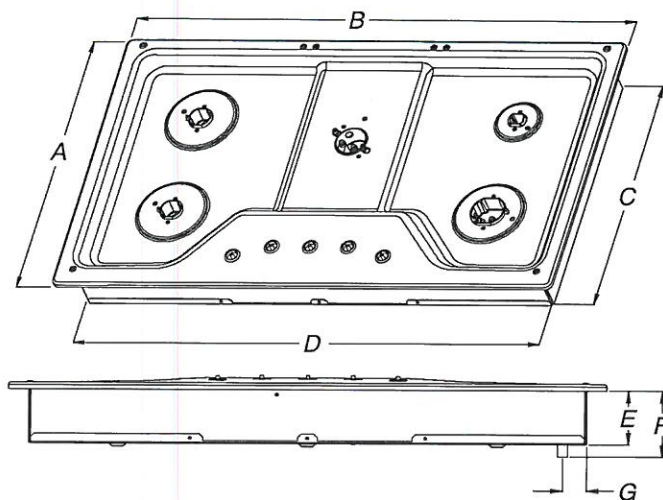

- | | |
|---|--|
| A. 21" (53.3 cm) | E. 3 ³ / ₈ " (8.6 cm) |
| B. 36" (91.4 cm) | F. 4 ¹ / ₈ " (10.5 cm) |
| C. 18 ⁷ / ₈ " (48.0 cm) | G. 1 ¹ / ₂ " (3.8 cm) |
| D. 33 ³ / ₄ " (85.7 cm) | |

PV-27 **attached**
May 4, 2021

Cutout Dimensions - Top View

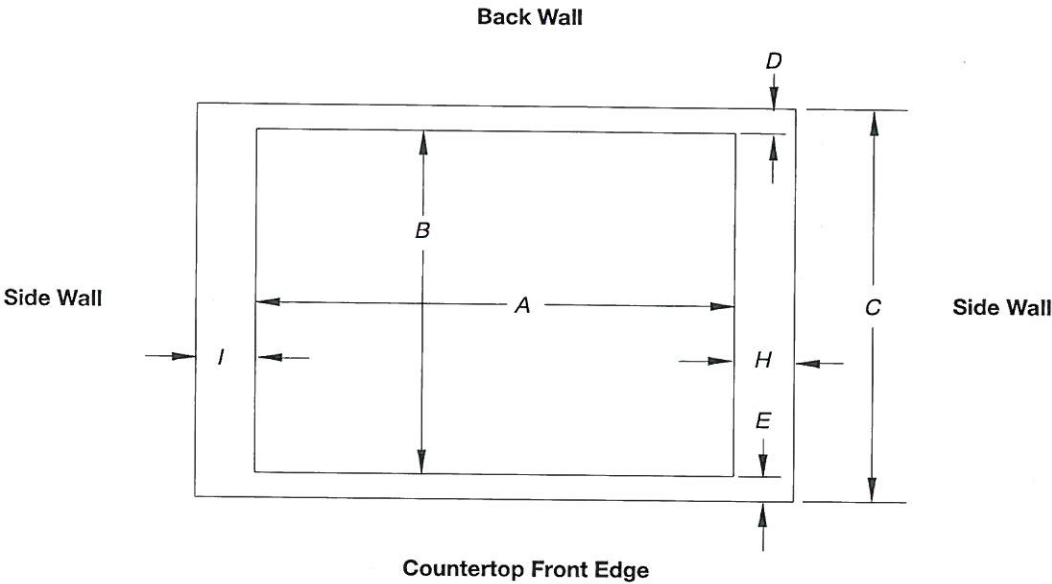

Cutout (Product Opening) Dimensions						
30" (76.2 cm) Models						
Models	A			B		
	Min	Recommended	Max	Min	Recommended	Max
KCGS550 and KCGS950 All Other 30" (76.2 cm) Models	28½" (72.4 cm) 28½" (72.4 cm)	28¾" (73.4 cm) 28¾" (73.4 cm)	29⅝" (74.3 cm) 29⅝" (74.3 cm)	19½" (49.5 cm) 19" (48.3 cm)	19⅜" (50.2 cm) 19½" (49.5 cm)	20" (50.8 cm) 20" (50.8 cm)
36" (91.4 cm) Models						
KCGS556 and KCGS956 All Other 36" (91.4 cm) Models	34⅞" (88.4 cm) 33⅞" (86.0 cm)	35⅞" (89.4 cm) 34⅞" (87.0 cm)	35⅝" (90.3 cm) 35¼" (89.5 cm)	19½" (49.5 cm) 19" (48.3 cm)	19⅜" (50.2 cm) 19½" (49.5 cm)	20" (50.8 cm) 20" (50.8 cm)

Side Walls (Combustible Surfaces)	
Models	H and I
KCGS5 and KCGS9	H and I added together must be at least 48" (122.0 cm), with each side individually being at least 8" (20.3 cm).
KCGS350, KCGS356, MGC9536, WCG97US0, WCG97US6	H and I added together must be at least 48" (122.0 cm), with each side individually being at least 12" (30.5 cm).
All Other Models	Both have to be 8" (20.3 cm) or more.

Back Wall and Countertop Front Dimensions			
Models	C	D	E
KCGS550 and KCGS950	25" (63.5 cm)	2⅞" (7.3 cm)	2¾" (6.9 cm)
All Other Models			3⅞" (7.9 cm)

NOTES: After making the countertop cutout, some installations may require notching down the base cabinet side walls to clear the cooktop base. To avoid this modification, use a base cabinet with sidewalls wider than the cutout.

If cabinet has a drawer, a 4" (10.2 cm) depth clearance from the countertop to the top of the drawer (or other obstruction) in base cabinet is required. The drawer depth may need to be shortened to avoid interfering with the regulator.


IMPORTANT: If a built-in wall oven is to be installed below this cooktop, the grounded outlet and gas supply piping must be located in an adjacent cabinet. If installing a range hood or microwave hood combination above the cooking surface, follow the range hood or microwave hood combination installation instructions for dimensional clearances above the cooktop surface.

This cooktop and its gas and electrical supply sources must be installed before the undercounter built-in wall oven is installed.


PV-27 ~~attached~~
May 4, 2021

Cabinet Clearances

Side View

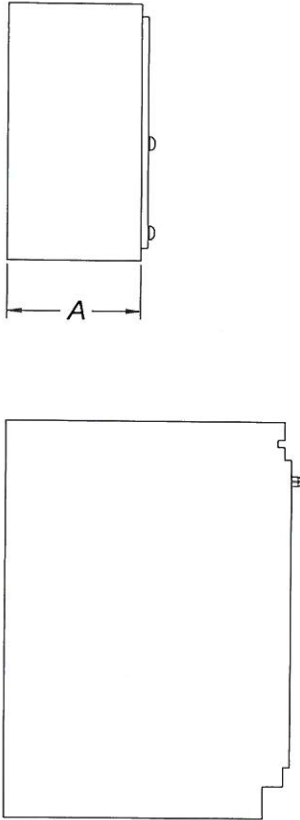

Front View

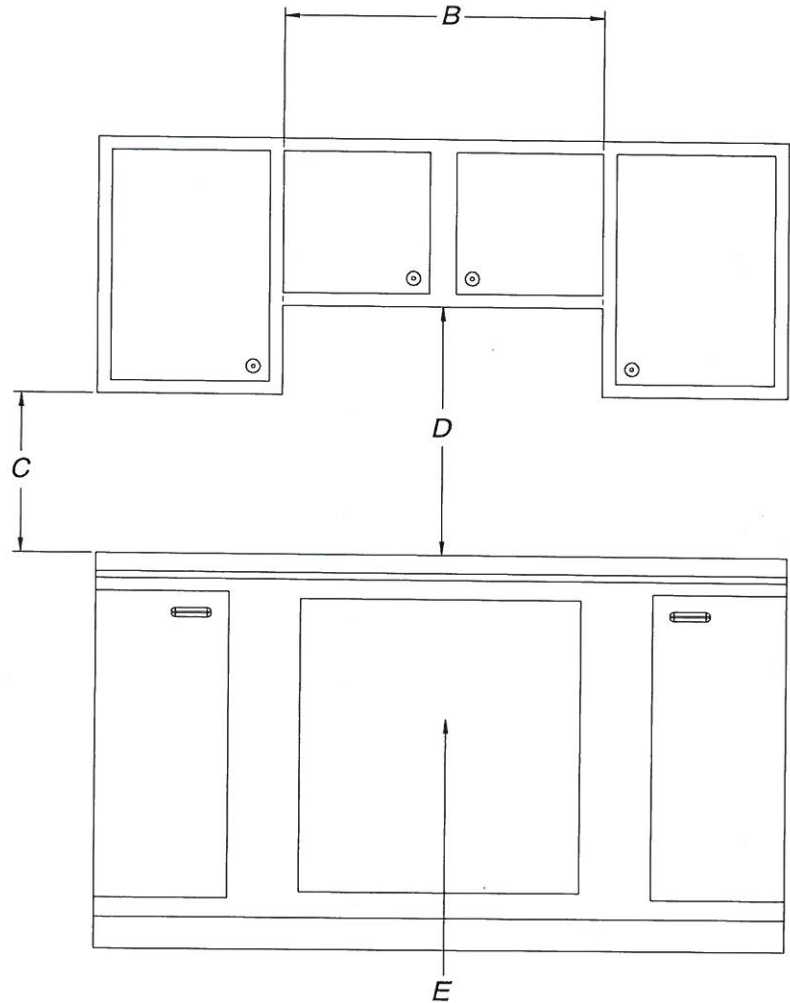

- A. 13" (33.0 cm) recommended upper cabinet depth.
- B. 30" (76.2 cm) for 30" models; 36" (91.4 cm) for 36" models.
- C. 18" (45.7 cm) minimum clearance from upper cabinet to countertop within minimum horizontal clearances to cooktop.
- D. 30" (76.2 cm) minimum clearance between top of cooktop platform and bottom of uncovered wood or metal cabinet.
24" [61 cm] minimum clearance if bottom of wood or metal cabinet is covered by not less than 1/4" [0.6 cm] flame retardant millboard covered with not less than No. 28 MSG sheet steel, 0.015" [0.04 cm] stainless steel, or 0.024" [0.06 cm] aluminum or 0.020" [0.05 cm] copper.
- E. Gas line opening - Wall: anywhere 5" (12.7 cm) below underside of countertop. Cabinet floor: anywhere within 6" (15.2 cm) of rear wall is recommended.


PV-27 **attached**
May 4, 2021

- Electrical supply junction box should be located 3" (7.6 cm) maximum below the support surface when the oven is installed in a wall cabinet. A 1" (2.5 cm) minimum diameter hole should have been drilled in the left rear corner of the support surface to pass the appliance cable through to the junction box.
- Oven support surface must be solid, level and flush with bottom of cabinet cutout. Floor must be able to support a total weight (microwave and built-in oven) of 208 lbs (95 kg) for 27" (68.6 cm) models or 249 lbs (113 kg) for 30" (76.2 cm) models.

IMPORTANT: To avoid damage to your cabinets, check with your builder or cabinet supplier to make sure that the materials used will not discolor, delaminate or sustain other damage. This oven has been designed in accordance with the requirements of UL and CSA International and complies with the maximum allowable wood cabinet temperatures of 194°F (90°C).

Product Dimensions

27" and 30" (68.6 cm and 76.2 cm) Ovens

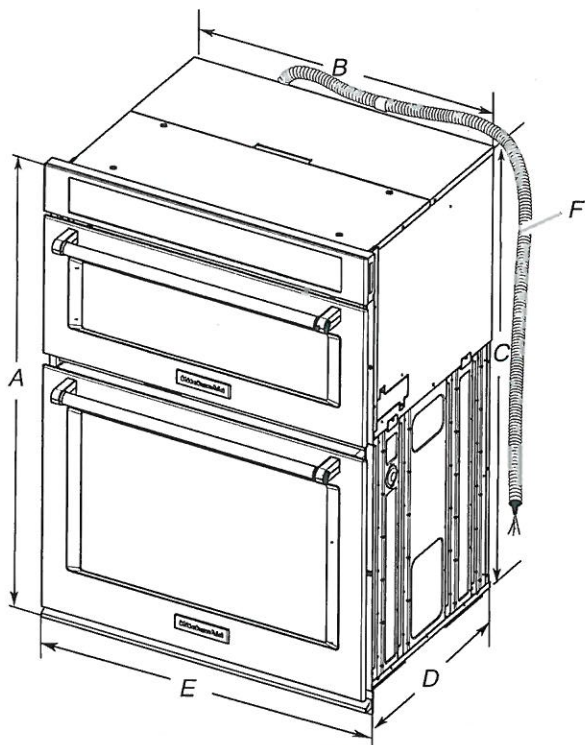

27" (68.6 cm) models


- A. 42 $\frac{5}{16}$ " (108.0 cm) overall height
- B. 25 $\frac{7}{16}$ " (64.6 cm) recessed width
- C. 41" (104.1 cm) recessed height
- D. 23 $\frac{1}{4}$ " (59.1 cm) max. recessed depth
- E. 27" (68.6 cm) overall width
- F. 48" (121.9 cm) flexible conduit length measured from the conduit clamp located at the rear of the oven. Do not remove the conduit clamp.

30" (76.2 cm) models

- A. 42 $\frac{5}{16}$ " (108.0 cm) overall height
- B. 28 $\frac{7}{16}$ " (72.2 cm) recessed width
- C. 41" (104.1 cm) recessed height
- D. 23 $\frac{1}{4}$ " (59.1 cm) max. recessed depth
- E. 30" (76.2 cm) overall width
- F. 48" (121.9 cm) flexible conduit length measured from the conduit clamp located at the rear of the oven. Do not remove the conduit clamp.

Cabinet Dimensions

27" and 30" (68.6 cm and 76.2 cm) Ovens

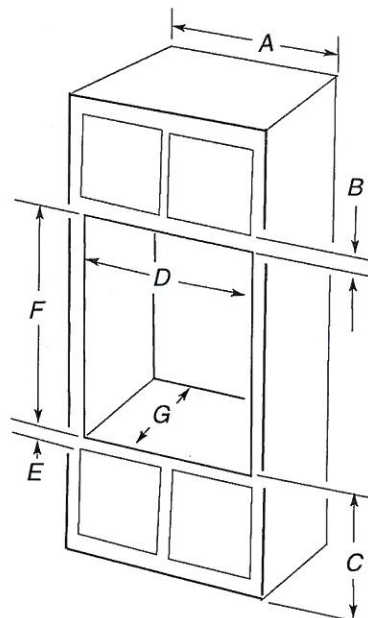

27" (68.6 cm) models

- A. 27" (68.6 cm) min. cabinet width
- B. 1" (2.5 cm) top of cutout to bottom of upper cabinet door
- C. 19 $\frac{1}{4}$ " (48.9 cm) bottom of cutout to floor is recommended. 4"-19 $\frac{1}{4}$ " (10.2-48.9 cm) bottom of cutout to floor is acceptable.
- D. 25 $\frac{1}{2}$ " (64.8 cm) cutout width
- E. 1 $\frac{1}{2}$ " (3.8 cm) min. bottom of cutout to top of cabinet door
- F. 41 $\frac{5}{16}$ " (105 cm)* recommended cutout height
- G. 24" (60.7 cm) cutout depth

30" (76.2 cm) models

- A. 30" (76.2 cm) min. cabinet width
- B. 1" (2.5 cm) top of cutout to bottom of upper cabinet door
- C. 19 $\frac{1}{4}$ " (48.9 cm) bottom of cutout to floor is recommended. 4"-19 $\frac{1}{4}$ " (10.2-48.9 cm) bottom of cutout to floor is acceptable.
- D. 28 $\frac{1}{2}$ " (72.4 cm) cutout width
- E. 1 $\frac{1}{2}$ " (3.8 cm) min. bottom of cutout to top of cabinet door
- F. 41 $\frac{5}{16}$ " (105 cm)* recommended cutout height
- G. 24" (60.7 cm) cutout depth

***NOTE:** The cutout height can be between 41" and 41 $\frac{1}{2}$ " (104.1 cm and 105.6 cm) for microwave/oven combination.

Electrical Requirements

If codes permit and a separate ground wire is used, it is recommended that a qualified electrical installer determine that the ground path and wire gauge are in accordance with local codes.

Check with a qualified electrical installer if you are not sure the oven is properly grounded.

This oven must be connected to a grounded metal, permanent wiring system.


Be sure that the electrical connection and wire size are adequate and in conformance with the National Electrical Code, ANSI/NFPA 70-latest edition or CSA Standards C22.1-94, Canadian Electrical Code, Part 1 and C22.2 No. O-M91-latest edition, and all local codes and ordinances.

A copy of the above code standards can be obtained from:

National Fire Protection Association
1 Batterymarch Park
Quincy, MA 02169-7471

CSA International
8501 East Pleasant Valley Road
Cleveland, OH 44131-5575

PV-27  
May 4, 2021

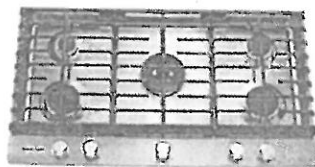

KITCHENAID 36" 5- BURNER GAS COOKTOP – STAINLESS STEEL

\$ 1,649.00

SKU: KCG556T5

VSN: KCG556T5

Dimensions

Width: 36" (91.4 cm) Height: 3.62" (9.2 cm) Depth: 21" (53.3 cm)

Experience the convenient technology this cooktop from KitchenAid offers. Even-Heat™ technology uses a diffuser plate to allow for more control of the cooktop, making it ideal for melting chocolate or simmering sauce. With a professional dual-ring burner and electronic ignition, this cooktop makes it simple to whip up countless masterpieces. What's more, the CookShield finish helps protect against spills and stains while making the cooktop easy to wipe clean without the use of harsh chemicals.

KitchenAid

Key Features:

- Even Heat Technology
- Professional Dual-Ring Burner
- CookShield Finish
- Electronic Ignition


Kitchenaid: 36" 5-Burner Gas Cooktop

PP-27 ~~(X)~~ (S)
May 4, 2011

Width: 36" (91.4 cm) Height: 3.62" (9.2 cm) Depth: 21" (53.3 cm)


Product Dimensions

KCGS550ESS and KCGS950ESS Models

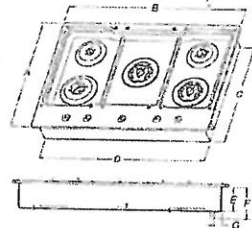

- | | |
|----------------------|---------------------|
| A. 21" (53.3 cm) | E. 3 1/2" (8.9 cm) |
| B. 30" (76.2 cm) | F. 4 1/2" (11.5 cm) |
| C. 19 1/2" (49.5 cm) | G. 2 1/2" (6.4 cm) |
| D. 28 1/2" (72.7 cm) | |


KCGS550ESS and KCGS950ESS Models

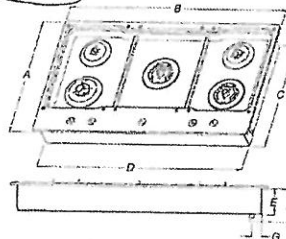

- | | |
|----------------------|---------------------|
| A. 21" (53.3 cm) | F. 3 1/2" (8.9 cm) |
| B. 36" (91.4 cm) | G. 4 1/2" (11.5 cm) |
| C. 19 1/2" (49.5 cm) | |
| D. 28 1/2" (72.7 cm) | |


* ← This one is correct

All Other 30" (76.2 cm) Models

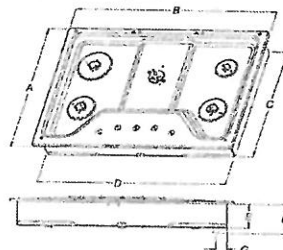


- | | |
|----------------------|---------------------|
| A. 21" (53.3 cm) | F. 3 1/2" (8.9 cm) |
| B. 30" (76.2 cm) | G. 4 1/2" (11.5 cm) |
| C. 19 1/2" (49.5 cm) | |
| D. 28 1/2" (72.7 cm) | |

All Other 36" (91.4 cm) Models

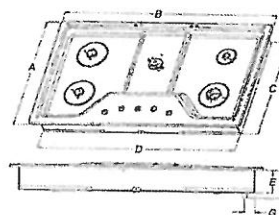


- | | |
|----------------------|---------------------|
| A. 21" (53.3 cm) | F. 3 1/2" (8.9 cm) |
| B. 36" (91.4 cm) | G. 4 1/2" (11.5 cm) |
| C. 19 1/2" (49.5 cm) | |
| D. 28 1/2" (72.7 cm) | |

Kitchenaid: 36" 5-Burner Gas COOKTOP
 PV-1+  Width 36" (91.4 cm) Height: 3.62" (9.2 cm) Depth: 21" (53.3 cm)
 May 4, 2011

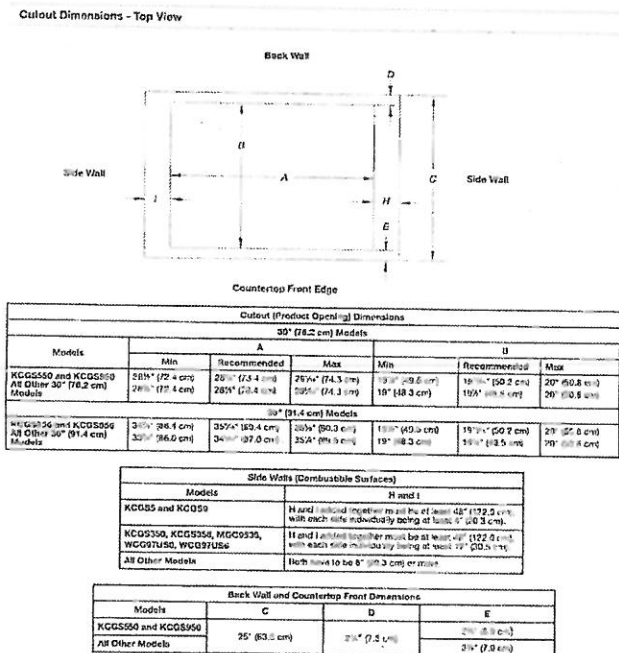

NOTES: After making the countertop cutout, some installations may require notching down the base cabinet side walls to clear the cooktop base. To avoid this modification, use a base cabinet with side walls wider than the cutout.
 If cabinet has a drawer, a 4" (10.2 cm) depth clearance from the countertop to the top of the drawer for other obstruction in base cabinet is required. The drawer depth may need to be shortened to avoid interfering with the regulator.
 IMPORTANT: If a built-in wall oven is to be installed below the cooktop, the grounded outlet and gas supply piping must be located in an adjacent cabinet. If installing a range hood or microwave hood combination above the cooking surface, follow the range hood or microwave hood combination manufacturer's instructions for dimensional clearances above the cooktop surface.
 The cooktop and its gas and electrical supply sources must be installed before the undercounter built-in wall oven is installed.

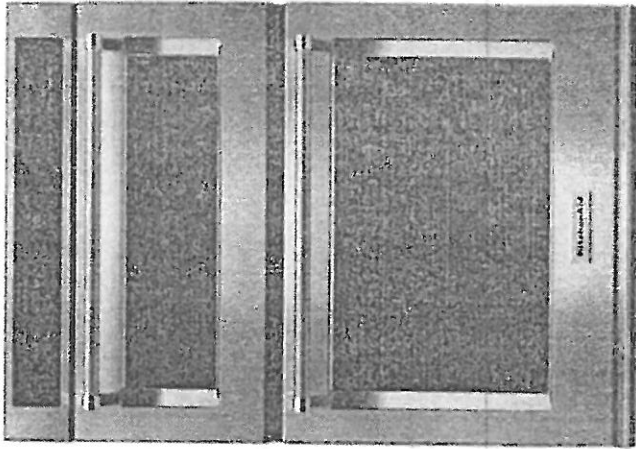

**KITCHENAID 30" COMBINATION WALL
OVEN WITH EVEN-HEAT™ TRUE
CONVECTION - KOCE500ESS**

\$ 4,899.00

SKU: KOCE500S

VSN: KOCE500ESS

Dimensions

Width: 30" (76.2 cm) Height: 42.5" (108.0 cm) Depth: 26.88" (68.3 cm)

Serve chef-quality meals to your family and friends thanks to this KitchenAid 30" combination wall oven.

With an extra-large conventional oven and microwave, you'll have all the room you need to create a true feast. The Even-Heat™ true convection system ensures your oven is heated to, and remains at, the perfect temperature. Use the EasyConvect™ conversion feature to be certain your food is heated through just right


PV-27
May 4, 1971

KitchenAid 30" Combination Wall Oven
SKU : KOCE 500S
USN : KOCE 500ES
Width: 30"(76.2cm) Height: 42.5"(108cm) Depth: 26.88"(68.3cm)

Cabinet Clearances

Side View

Front View

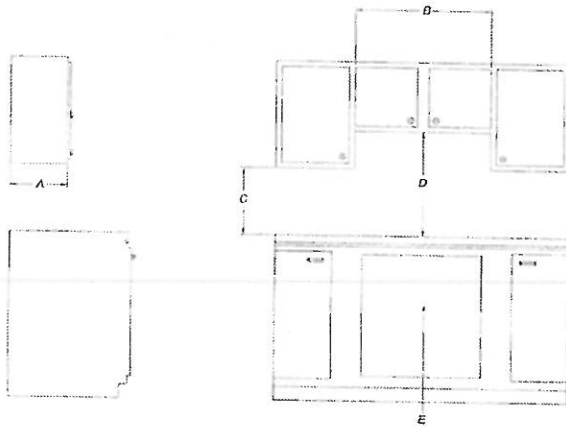

- A 17" (43.0 cm) maximum depth
- B 26" (66.0 cm) for all heights; 30" (76.2 cm) for 30" models
- C 18" (45.7 cm) maximum clearance from upper cabinet to back of oven with minimum horizontal clearance to backstop
- D 30" (76.2 cm) minimum clearance between top of countertop and bottom of uncovered wall or metal cabinet
- E 24" (61.0 cm) minimum clearance if bottom of wall or metal cabinet is covered by not less than 1/2" (12.7 mm) layer of material

PV-27 ④ ⑤
Way 4, 2011


Kitchenaid 30" Combination wall oven
SKU: KOCE500S
VSN: KOCE500ESS

width: 30" (76.2 cm) Height: 42.5" (108.0 cm) Depth: 26.88" (68.3 cm)

- Electrical supply junction box should be located 3" (7.6 cm) maximum below the cabinet floor when the oven is installed in a wall cabinet. A 1/2" (1.3 cm) diameter hole should have been drilled in the left rear corner of the support surface to pass the appliance cable through in the junction box.
 - Oven support surface must be solid, level and flush with bottom of cabinet cutout. Floor must be able to support a total weight (microwave and built-in oven) of 163 lbs (73 kg) for 27" (68.6 cm) models, or 219 lbs (99 kg) for 30" (76.2 cm) models.
- IMPORTANT:** To avoid damage to your cabinets, check with your builder or cabinet maker to make sure that the materials used will not discolor, flange or stain from damage. This oven has been designed in accordance with the requirements of UL and CSA International and complies with the maximum allowable wood cabinet temperature of 155°F (68°C).

Product Dimensions


27" and 30" (68.6 cm and 76.2 cm) Ovens

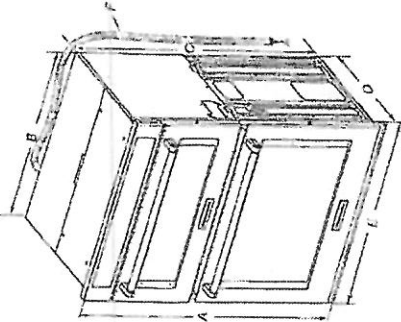

- 27" (68.6 cm) models: A 42 1/2" (108.0 cm) overall height, B 25 1/2" (64.8 cm) recessed height, C 41" (104.1 cm) max recessed height, D 23 1/2" (59.1 cm) max recessed depth, E 24" (61.0 cm) max width, F 24" (61.0 cm) max depth, G 24" (61.0 cm) cutout depth.
- 30" (76.2 cm) models: A 47 1/2" (120.7 cm) overall height, B 28 1/2" (72.9 cm) recessed height, C 46" (116.8 cm) max recessed height, D 27 1/2" (70.1 cm) max recessed depth, E 24" (61.0 cm) max width, F 24" (61.0 cm) max depth, G 24" (61.0 cm) cutout depth.

Cabinet Dimensions

27" and 30" (68.6 cm and 76.2 cm) Ovens

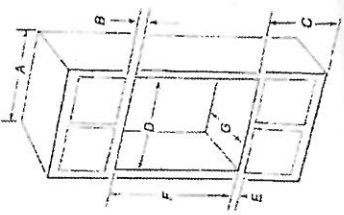

- 27" (68.6 cm) models: A 27" (68.6 cm) min cabinet width, B 5 1/2" (14.0 cm) min cabinet depth, C 19 1/2" (49.5 cm) min cabinet depth to floor, D 1" (2.5 cm) top of cutout to bottom of cabinet door, E 1 1/2" (3.8 cm) min bottom of cutout to top of cabinet door, F 1 1/2" (3.8 cm) min bottom of cutout to top of cabinet door, G 24" (61.0 cm) cutout depth.
- 30" (76.2 cm) models: A 30" (76.2 cm) min cabinet width, B 5 1/2" (14.0 cm) min cabinet depth, C 19 1/2" (49.5 cm) min cabinet depth to floor, D 1" (2.5 cm) top of cutout to bottom of cabinet door, E 1 1/2" (3.8 cm) min bottom of cutout to top of cabinet door, F 1 1/2" (3.8 cm) min bottom of cutout to top of cabinet door, G 24" (61.0 cm) cutout depth.

Electrical Requirements

If codes permit and a separate ground wire is used, it is recommended that a qualified electrical installer determine that the ground path and wire gauge are in accordance with local codes. Check with a qualified electrical installer if you are not sure the oven is properly grounded. This oven must be connected to a grounded metal, permanent wiring system. Be sure that the electrical connection and wire size are adequate and in accordance with the National Electrical Code, ANSI/NFPA 70-1997, Canadian Electrical Code, Part I, and CEC 2002 No. 0-4691, latest edition, and all local codes and ordinances. A copy of the above code standards can be obtained from: National Fire Protection Association, 1 Batterymarch Park, Quincy, MA 02269-7471, CSA International, 2601 East Pleasant Valley Road, Cleveland, OH 44131-5575.

PV - 27 Cabinetry Schedule

ROOM	DESCRIPTION	PRICE	QTY	TOTAL
KITCHEN	ADD POTS AND PANS DRAWER BELOW COOKTOP		1	
	CONVERT STANDARD CABINETRY TO TALL DEEP BUILT IN OVEN UNIT WITH DRAWER BELOW		1	
	RELOCATE STD BANK OF 4 DRAWERS TO ISLAND (N/C)		1	
	ADJUST CABINETRY FOR 36" COOKTOP (N/C)		1	
	LEAVE 42" SPACE IN UPPER CABINETS ABOVE COOKTOP (N/C)		1	
CABINETRY TOTAL:				

HANDLE PLACEMENT: AT INSTALLERS DISCRETION

LOT #:
27

DATE:
April 21 2021

SIGNATURE:


SIGNATURE:



Yolande Somerville

From: Narinder Dulay <ndulay21@yahoo.com>
Sent: June 3, 2021 6:29 PM
To: Yolande Somerville
Subject: Re: PV-27 Ensuite 5 Floor Tile - Urgent Response Required

Taupe looks fine.



Aloua 'storm Grey Oak'

OPEN +
drawers below.

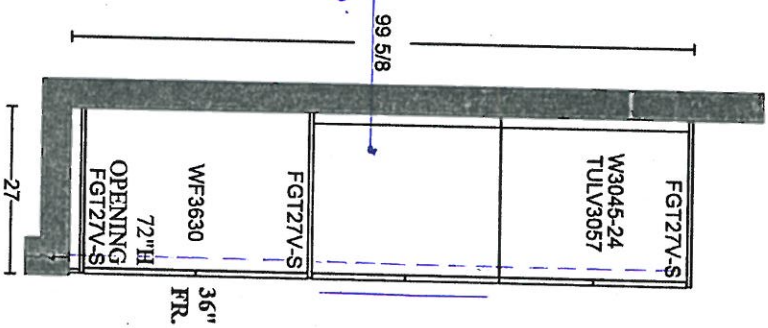

GOLDPARK HOMES
PINE VALLEY
VAUGHAN, ONTARIO
MODEL: (4203) FORESTCREST

SITE STANDARD: WHITE 3/4" EXTENSION
SOFT-CLOSE DRAWERS & SOFT-CLOSE
HINGES TO KITCHEN AREA
10" CEILING - 12" H COFFERED CEILING -
M.H. = 102" + 3/4" H CONTEMPORARY
MOLDING + 5 1/4" H FURRING RAIL
+ LARGE CORNICE MOLDING TO
UNDERSIDE OF BOX

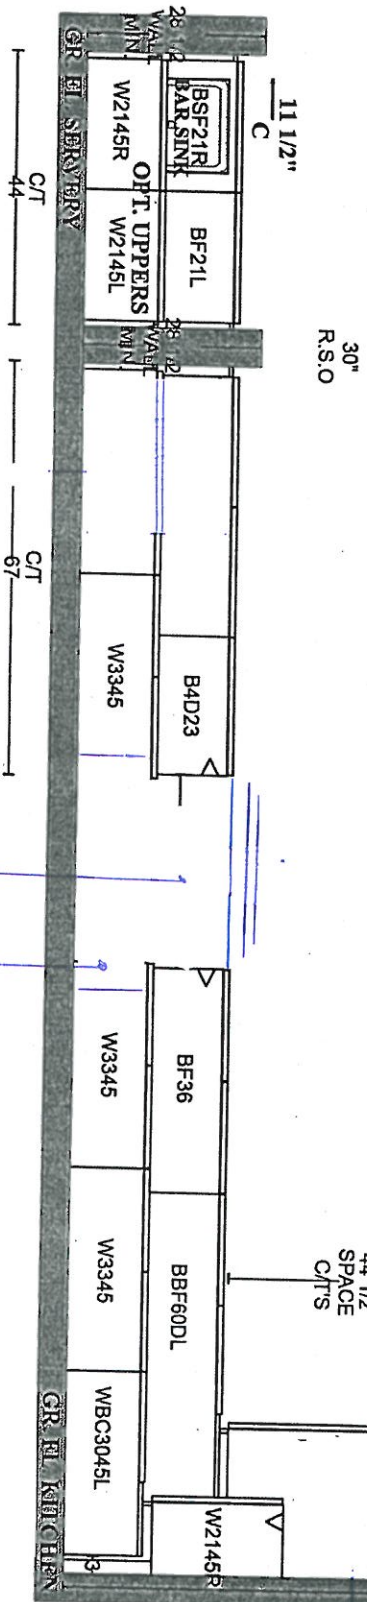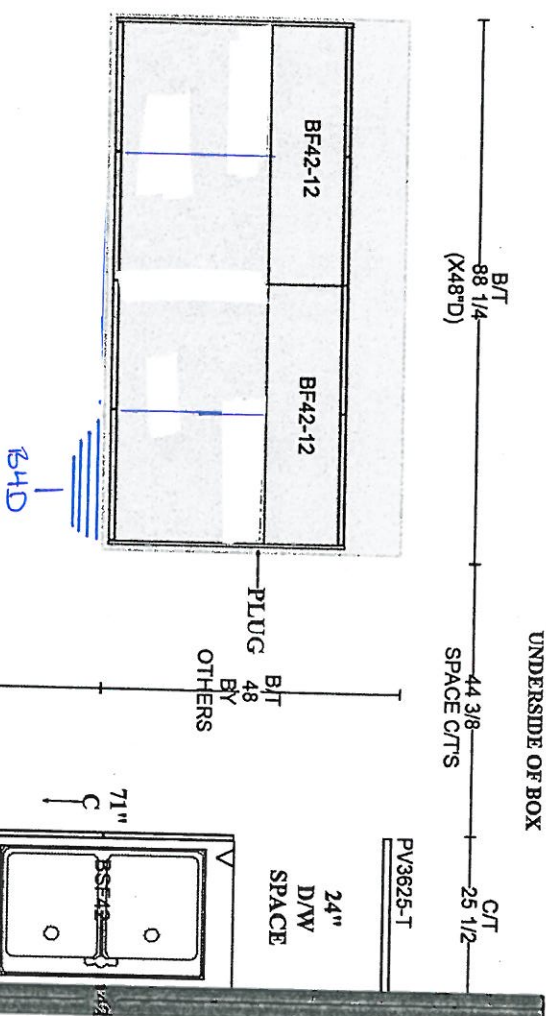

PV-27
April 21, 2021

Handwritten initials and a red circle.

PLAN VIEW




PV-27
April 21, 2021

AB

GOLDPARK HOMES
PINE VALLEY
VAUGHAN, ONTARIO
MODEL: (4203 OPT.) FORESTCREST

SITE STANDARD: WHITE 3/4" EXTENSION
SOFT-CLOSE DRAWERS & STANDARD SLAM DOOR HINGES
TO VANITIES

ONE TOP DRAWER WHERE POSSIBLE THROUGHOUT EACH
VANITY, ONE BANK OF DRAWERS WHERE POSSIBLE
THROUGHOUT EACH MASTER ENSUITE

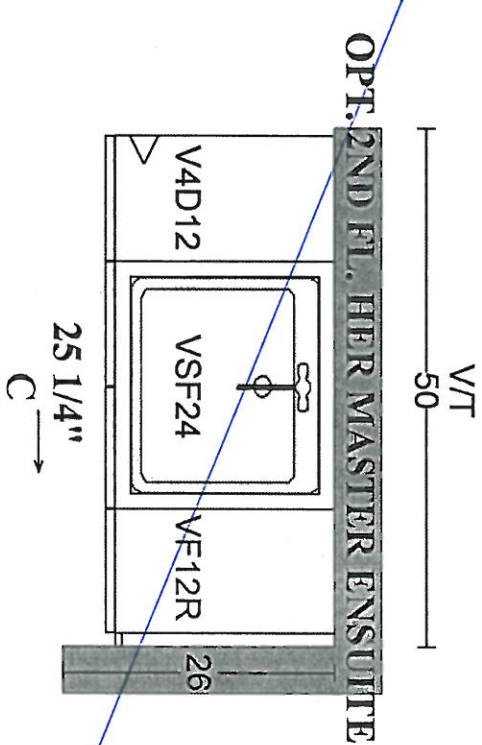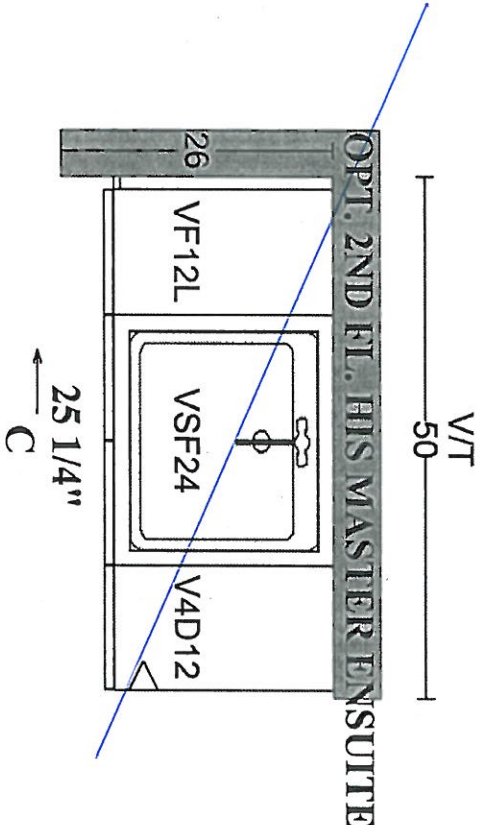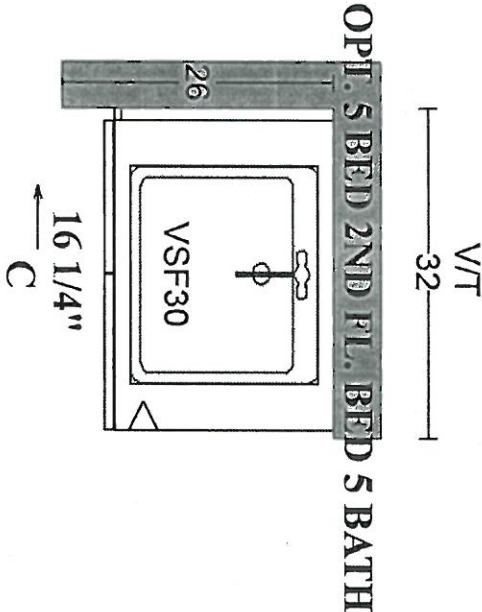

PLAN VIEW



SCHEDULE 'F'

PV-27 ~~attached~~

March 16, 2021

PV-27

March 23, 2021

The Forestcrest 42' SERIES

→ Elevation A • 3,800 sq.ft.
Elevation B • 3,785 sq.ft.
Elevation C • 3,800 sq.ft.

~~A~~

PV-27

April 21, 2021


~~g~~

COFFER

APPROX
64" A.F.F.

NO!

GAS +
ELECT

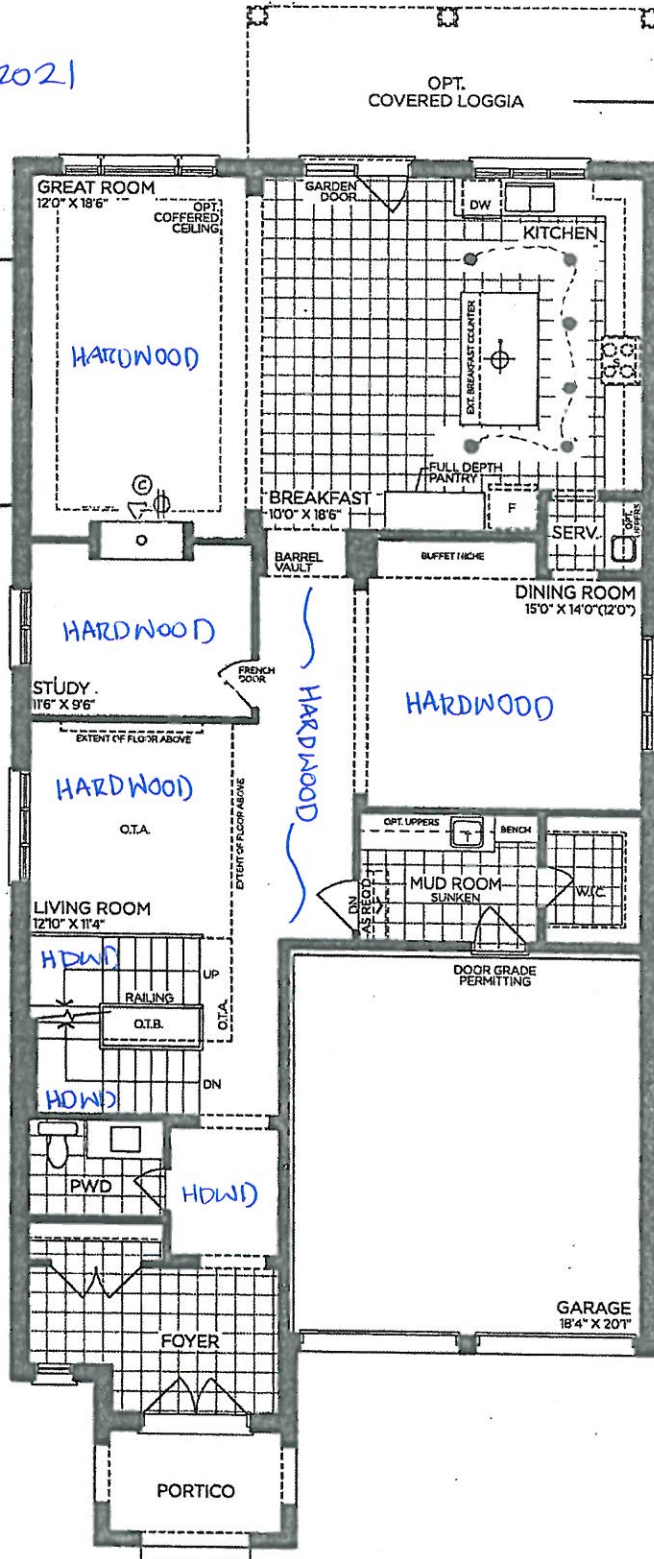

GROUND FLOOR | ELEV. A

VENDOR

PURCHASER

PURCHASER

GOLDPARK

WORTH MORE™

Prices, figures, illustrations, sizes, features and finishes are subject to change without notice. Areas and dimensions are approximate and actual usable floor space may vary from the stated area. Layout may be reverse of the unit purchased. E. & O.E. 4203



SCHEDULE 'F'

PV-27 ~~attached~~
March 16, 2021


PV-27 ○ ○
March 23, 2021

PV-27
April 21, 2021

The Forestcrest

42' SERIES

→ Elevation A • 3,800 sq.ft.
Elevation B • 3,785 sq.ft.
Elevation C • 3,800 sq.ft.

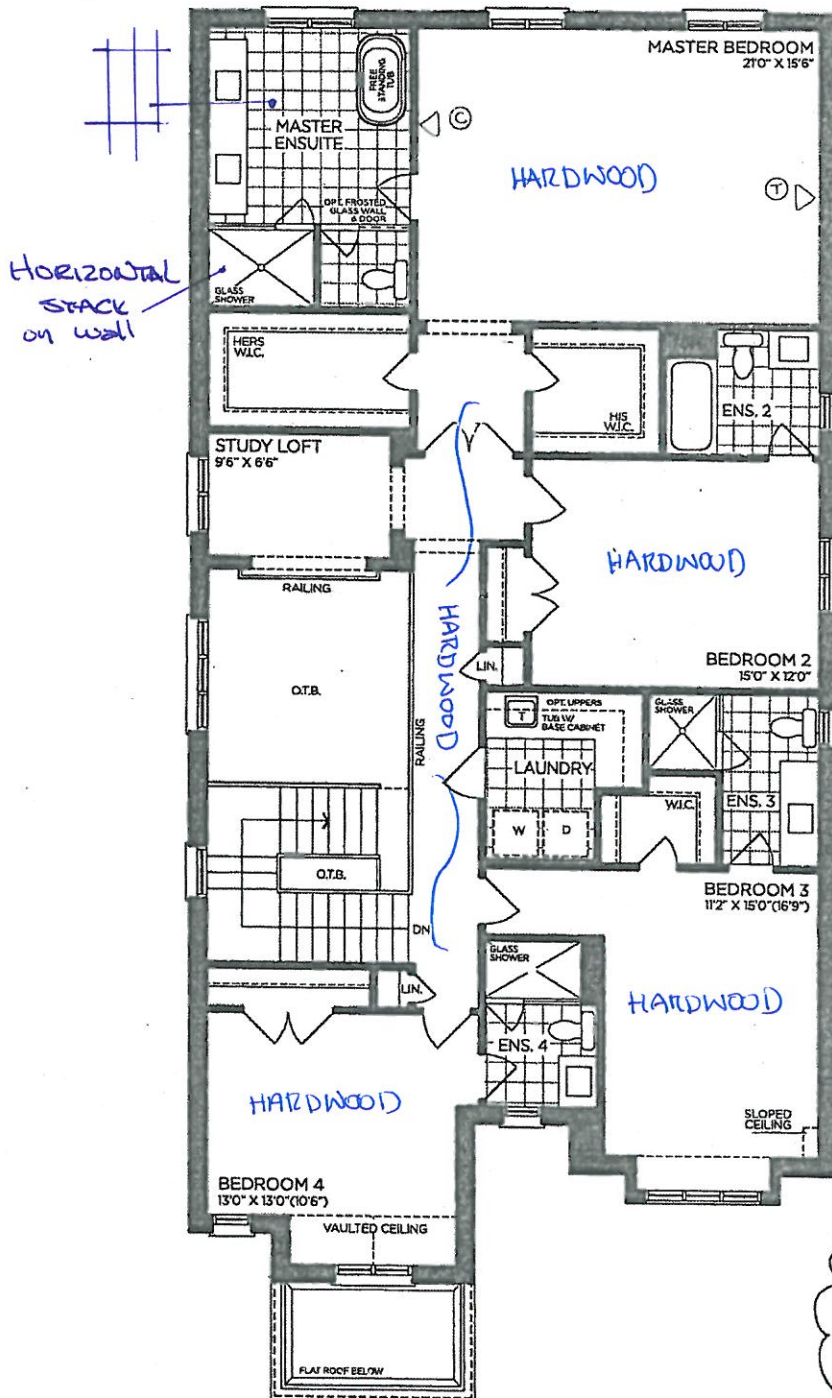

SECOND FLOOR | ELEV. A

SEE 5 BDRM
option to
Ensuite

NO PHONES IN
BEDROOM 2, 3, 4, 5

VENDOR

PURCHASER

PURCHASER

GOLDPARK

WORTH MORE™

Prices, figures, illustrations, sizes, features and finishes are subject to change without notice. Areas and dimensions are approximate and actual usable floor space may vary from the stated area. Layout may be reverse of the unit purchased. E. & O.E. 4203

SCHEDULE 'F'



PV-27  

March 16, 2021

PV-27  

March 23, 2021

PV-27  


April 21, 2021

The Forestcrest

42' SERIES

➤ Elevation A • 3,800 sq.ft.
Elevation B • 3,785 sq.ft.
Elevation C • 3,800 sq.ft.

9' BASEMENT

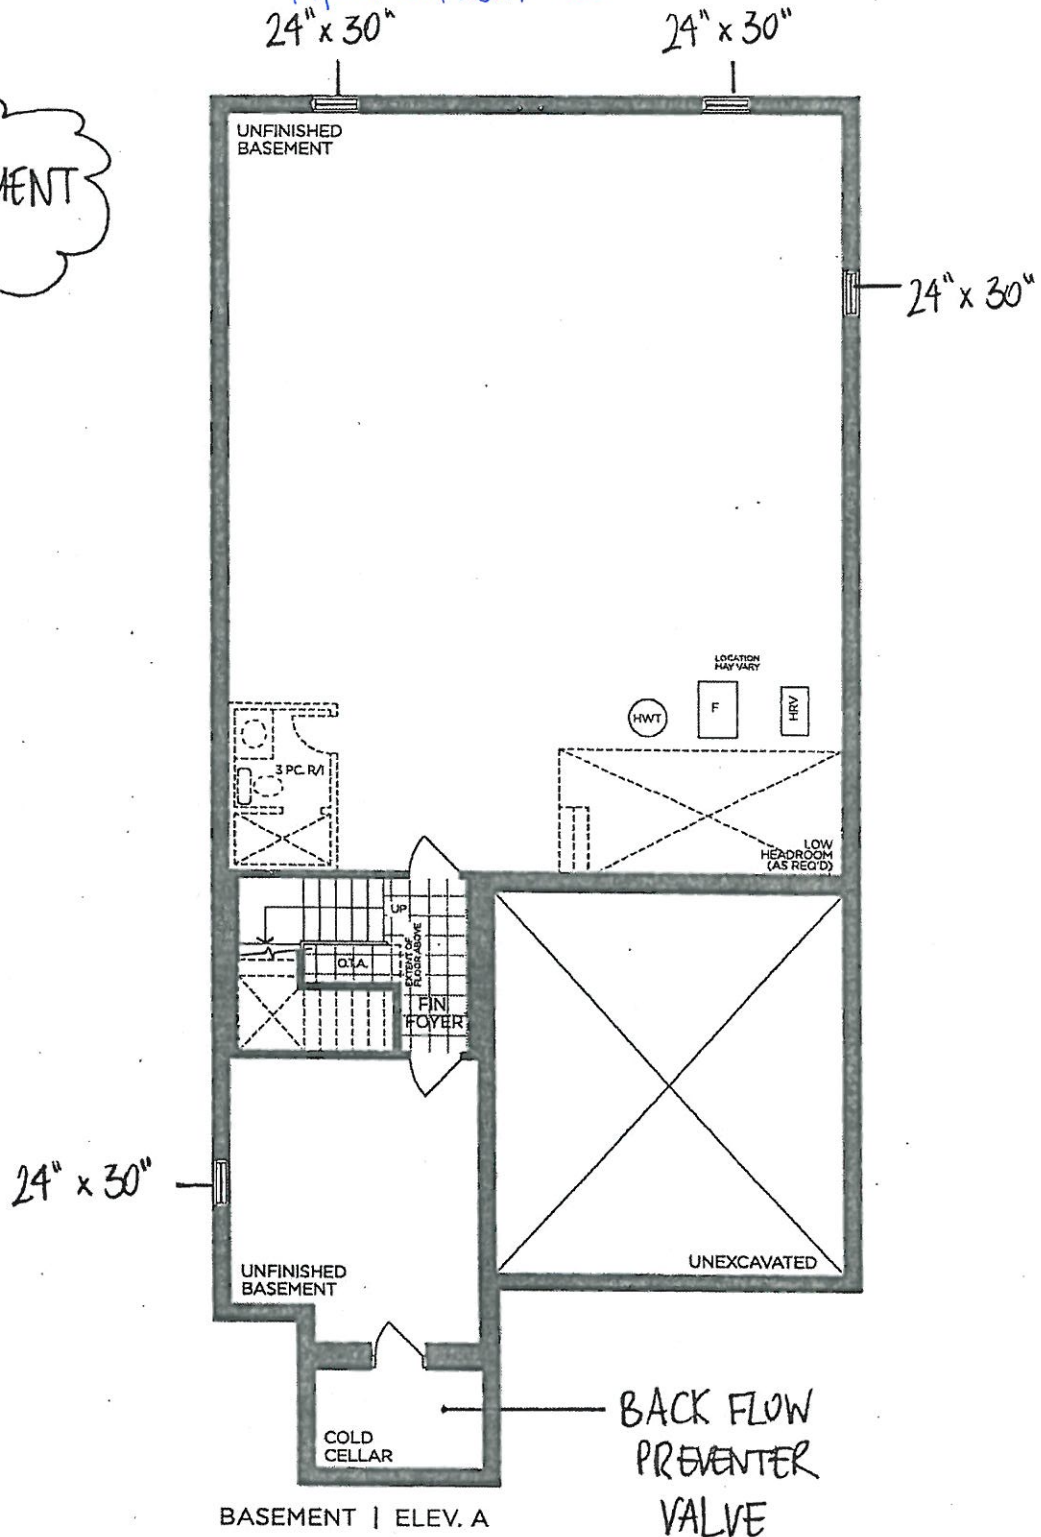

VENDOR

PURCHASER

PURCHASER

GOLDPARK
WORTH MORE™

Prices, figures, illustrations, sizes, features and finishes are subject to change without notice. Areas and dimensions are approximate and actual usable floor space may vary from the stated area. Layout may be reverse of the unit purchased. E. & O.E. 4203




SCHEDULE 'F'
PV-27 *attached*
March 16, 2021
PV-27 *00*
March 23, 2021

The Forestcrest 42' SERIES

Elevation A • 3,800 sq.ft.
Elevation B • 3,785 sq.ft.
Elevation C • 3,800 sq.ft.


NO PHONES IN
BEDROOM 2,3,4,5

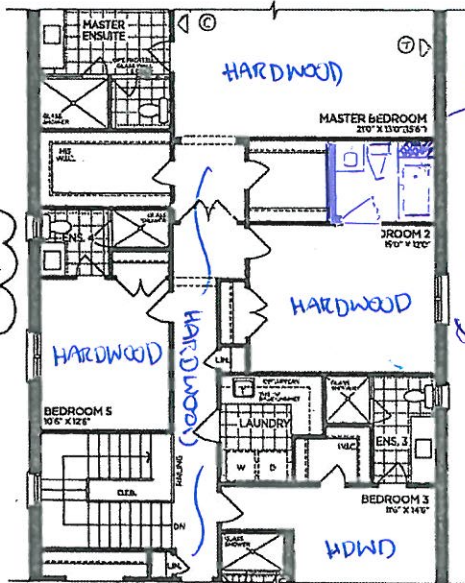


OPT. PART. SECOND FLOOR | ELEV. A
5 BEDROOM

PV-27 *00*
April 21, 2021


ADD
ENSUITE
TO TUB.

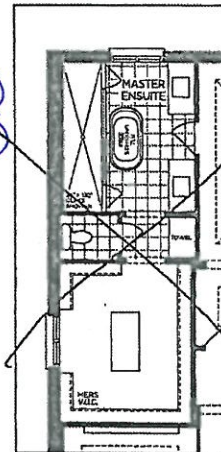


OPT. PART. SECOND FLOOR
MASTER ENSUITE

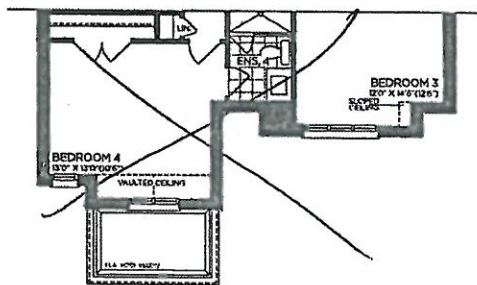


PART. SECOND FLOOR | ELEV. B

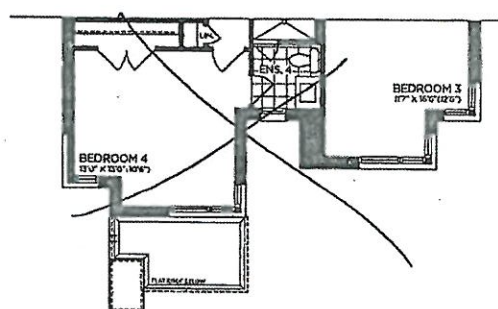


PART. SECOND FLOOR | ELEV. C

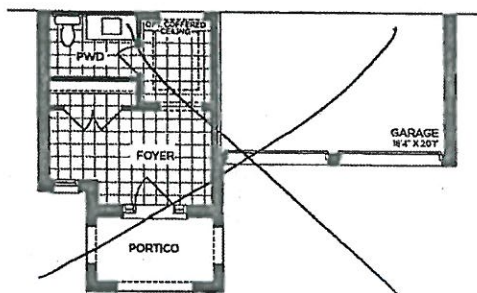


PART. GROUND FLOOR | ELEV. B

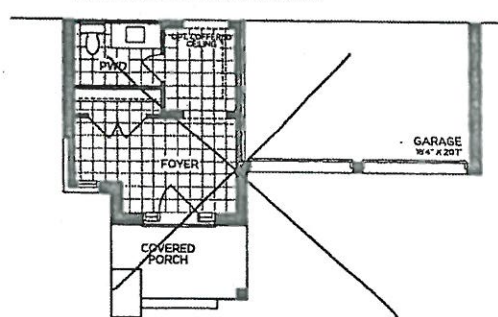

PART. GROUND FLOOR | ELEV. C

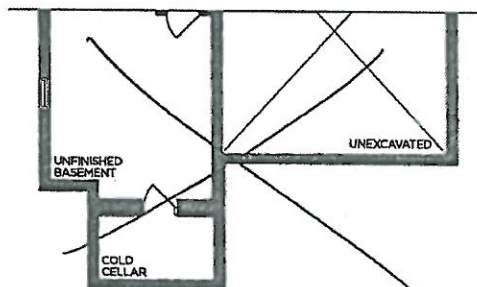

PART. BASEMENT | ELEV. B


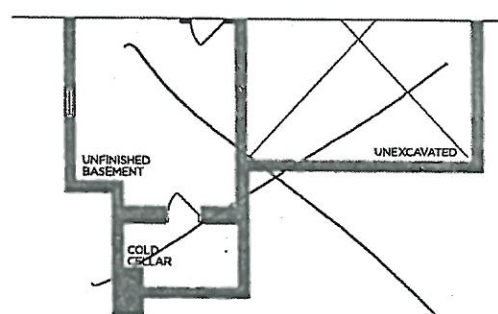


PART. BASEMENT | ELEV. C

VENDOR
PURCHASER
PURCHASER






GOLDPARK
WORTH MORE™

Prices, figures, illustrations, sizes, features and finishes are subject to change without notice. Areas and dimensions are approximate and actual usable floor space may vary from the stated area. Layout may be reverse of the unit purchased. E. & O.E. 4203

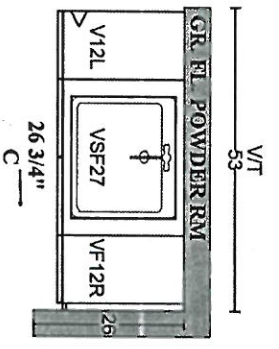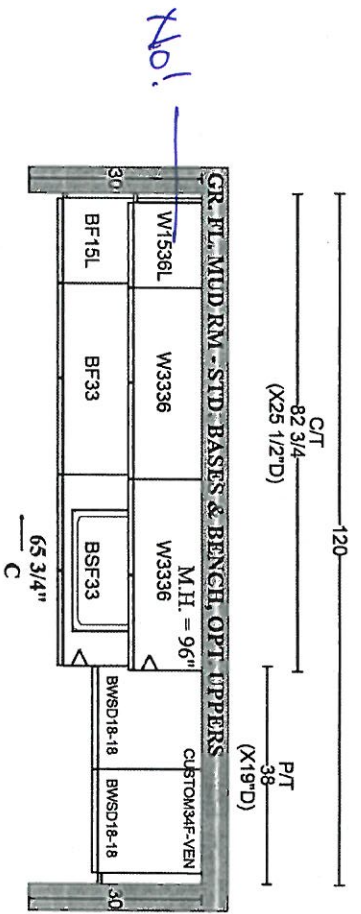

PV-27
April 21, 2021

GOLDPARK HOMES
PINE VALLEY
VAUGHAN, ONTARIO
MODEL: (4203) FORESTCREST
SITE STANDARD: WHITE 3/4" EXTENSION
SOFT-CLOSE DRAWERS & STANDARD SLAM DOOR HINGES TO VANITIES
ONE TOP DRAWER WHERE POSSIBLE THROUGHOUT EACH VANITY, ONE BANK OF DRAWERS WHERE POSSIBLE THROUGHOUT EACH MASTER ENSUITE VANITY

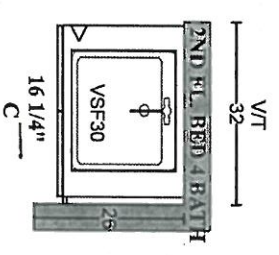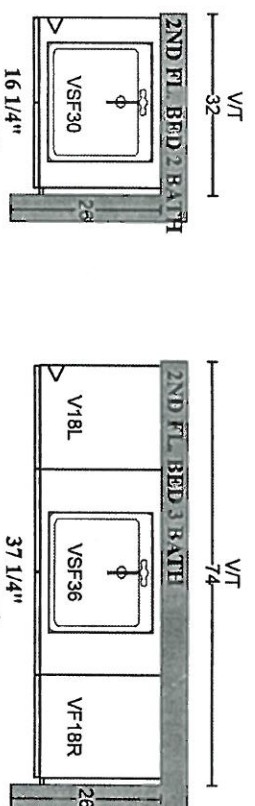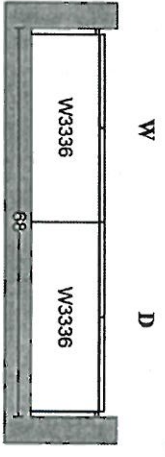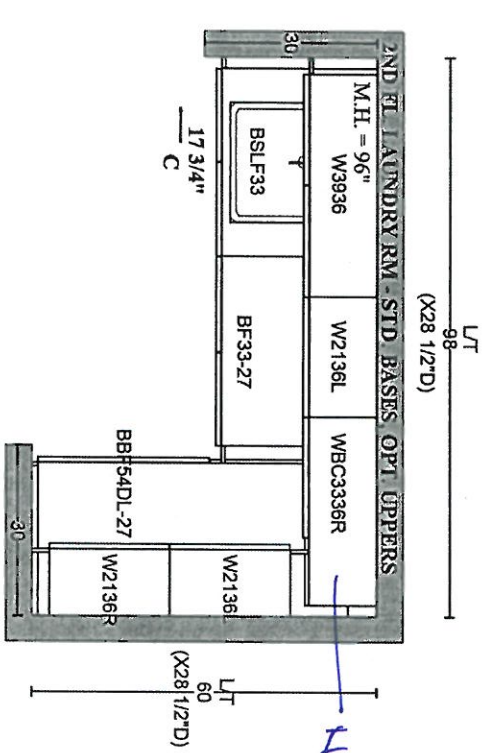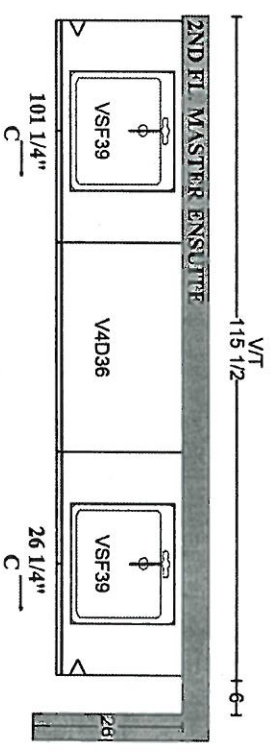




PINE VALLEY

FOREVERGREEN

UPGRADE SHOWER HARDWARE

MT6X6

Shower Door Handle

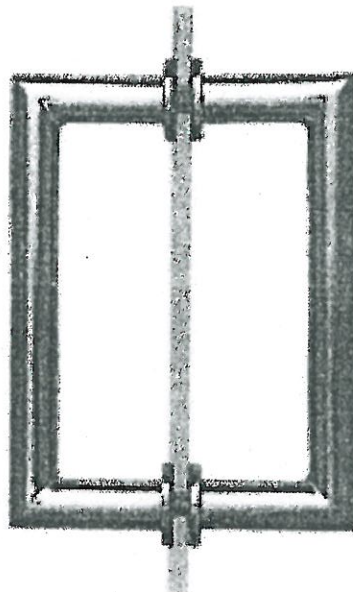

MT6X6
Shower Door Handle

6" x 6" back-to-back
3/4" dia. tube
Cut and mitred corners with
washers
(Also available single sided)



CHROME



MATTE BLACK



BRUSHED GOLD

Lot#

27

Date:

APRIL 21 2021

Room:

MASTER / ENS 3 / 4 / 5.

Signature:

Signature:

GOLDPARK
WORTH MORE



PINE VALLEY
FOREVERGREEN

STONE COUNTERTOP EDGE PROFILES



STANDARD 2CM EASED EDGE


LOCATION:

TRU OUT




UPGRADE 3CM EASED EDGE


LOCATION:

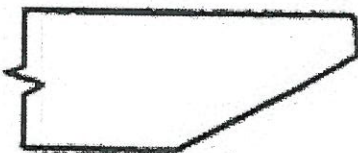

UPGRADE 4CM MITRED EDGE

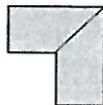

LOCATION:

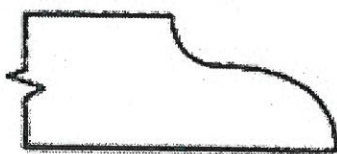

UPGRADE 2CM OGEE EDGE

LOCATION:

LOT #:

27

DATE:

April 21, 2021

SIGNATURE:

SIGNATURE:

STANDARD HARDWARE / HANDLES



☐ H001-02



☐ H001-03



☐ H001-04



☐ H009-03



☐ H009-09




☐ H011-03



☐ H011-05



☐ H011-06

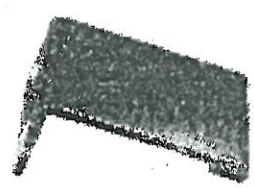

☐ H033-01



☒ H039-03
THRU OUT

☐ *NO HARDWARE

LOT # *27*

DATE: *April 21, 2021*

SIGNATURE: *[Signature]*

SIGNATURE: *[Signature]*



Project:

Lot:

Purchaser(s): Narinder and Gurnel Dula

Standard Hood Fan Deletion

We acknowledge that the builder's standard hood fan will not be installed.
Do not supply, install and/or credit. We will install our own hood fan after closing.

Signature: [Signature]

Signature: [Signature]

Date: April 21, 2021