



CONSTRUCTION SUMMARY

Lot: 35  
Model: 40.02 A VALLEYVIEW  
Project/Phase: Pine Valley Forevergreen / 1

BASEMENT WINDOWS

Invoice	Qty.	Description
2838 72,351 26Jul21	4	BASEMENT WINDOWS - UPGRADE BASEMENT WINDOW SIZE TO 30 " X 24" - 8" FRAME

DRYWALL

Invoice	Qty.	Description
2838 72,351 26Jul21 **	4	BASEMENT WINDOWS - UPGRADE BASEMENT WINDOW SIZE TO 30 " X 24" - 8" FRAME
2838  26Jul21 NoCat	1	THRU OUT 2ND FLOOR: INCREASE HEIGHT OF DOOR TO 8FT SECOND FLOOR - PER DOOR

ELECTRICAL

Invoice	Qty.	Description
2838 72,351 26Jul21 **	4	BASEMENT WINDOWS - UPGRADE BASEMENT WINDOW SIZE TO 30 " X 24" - 8" FRAME
2838 72,280 26Jul21	1	POWDER ROOM: INSTALL A CAPPED CEILING LIGHT FIXTURE WITH SEPARATE SWITCH - APPROX. CENTRE ON CEILING
2838 72,268 26Jul21	2	GARAGE: INTERIOR WALL OUTLET: 110V WALL INTERIOR RECEPTACLE ON EXISTING CIRCUIT FOR FUTURE GARAGE DOOR OPENER - INSTALL APPROX. 114" A.F.F. - SEE PLAN
2838 72,281 26Jul21	1	GREAT ROOM: INTERIOR WALL OUTLET: ADDITIONAL 110V WALL INTERIOR RECEPTACLE ON EXISTING CIRCUIT FOR WALL MOUNTED TV - ABOVE FIREPLACE, APPROX. 66" A.F.F.
2838 72,307 26Jul21	1	KITCHEN: FIXTURE - RELOCATE STANDARD CEILING MOUNT FIXTURE TO APPROX. CENTRE ON CEILING ABOVE ISLAND
2838 72,280 26Jul21	1	KITCHEN: INSTALL A CAPPED CEILING LIGHT FIXTURE ON EXISTING SWITCH - APPROX. CENTRE ON CEILING ABOVE ISLAND
2838 72,298 26Jul21	1	MASTER ENSUITE: BATHROOM FAN DELAY - ONE UNIT - SEE PLAN FOR APPROX. LOCATION
2838 72,307 26Jul21	1	UPPER HALL: FIXTURE: RELOCATE STANDARD CEILING MOUNT FIXTURE TO APPROX. CENTRE ON CEILING AT OTB
2838 72,281 26Jul21	1	MASTER BEDROOM: INTERIOR WALL OUTLET: ADDITIONAL 110V WALL INTERIOR RECEPTACLE ON EXISTING CIRCUIT FOR WALL MOUNTED TV - APPROX. 60" A.F.F.



CONSTRUCTION SUMMARY

Lot: 35  
Model: 40.02 A VALLEYVIEW  
Project/Phase: Pine Valley Forevergreen / 1

ELECTRICAL

Invoice	Qty.	Description
2838 72,289 26Jul21	2	MAIN HALL: 4" E/S LED INTERIOR POT LIGHT - GROUND FLOOR - EACH - INCLUDES ONE SWITCH  INCLUDED IN APS - DELETE STANDARD CEILING LIGHT FIXTURES, SWITCH TO REMAIN FOR POT LIGHTS
2838 72,289 26Jul21	4	DINING ROOM: 4" E/S LED INTERIOR POT LIGHT - GROUND FLOOR - EACH
2838 72,278 26Jul21	1	DINING ROOM: ADDITIONAL INTERIOR SWITCH FOR POT LIGHTS

FRAMING

Invoice	Qty.	Description
2838  26Jul21 NoCat	1	THRU OUT 2ND FLOOR: INCREASE HEIGHT OF DOOR TO 8FT SECOND FLOOR - PER DOOR

INTERIOR TRIM AND DOORS

Invoice	Qty.	Description
2838 72,644 26Jul21	17	THRU OUT 2ND FLOOR: INCREASE HEIGHT OF DOOR TO 8FT SECOND FLOOR - PER DOOR

PAINT

Invoice	Qty.	Description
2838  26Jul21 NoCat	1	THRU OUT 2ND FLOOR: INCREASE HEIGHT OF DOOR TO 8FT SECOND FLOOR - PER DOOR




SCHEDULE 'F'  
PV-35  
July 8, 2021

attached

# The Valleyview

## 40' SERIES

Elevation A • 3,145 sq.ft.  
Elevation B • 3,170 sq.ft.

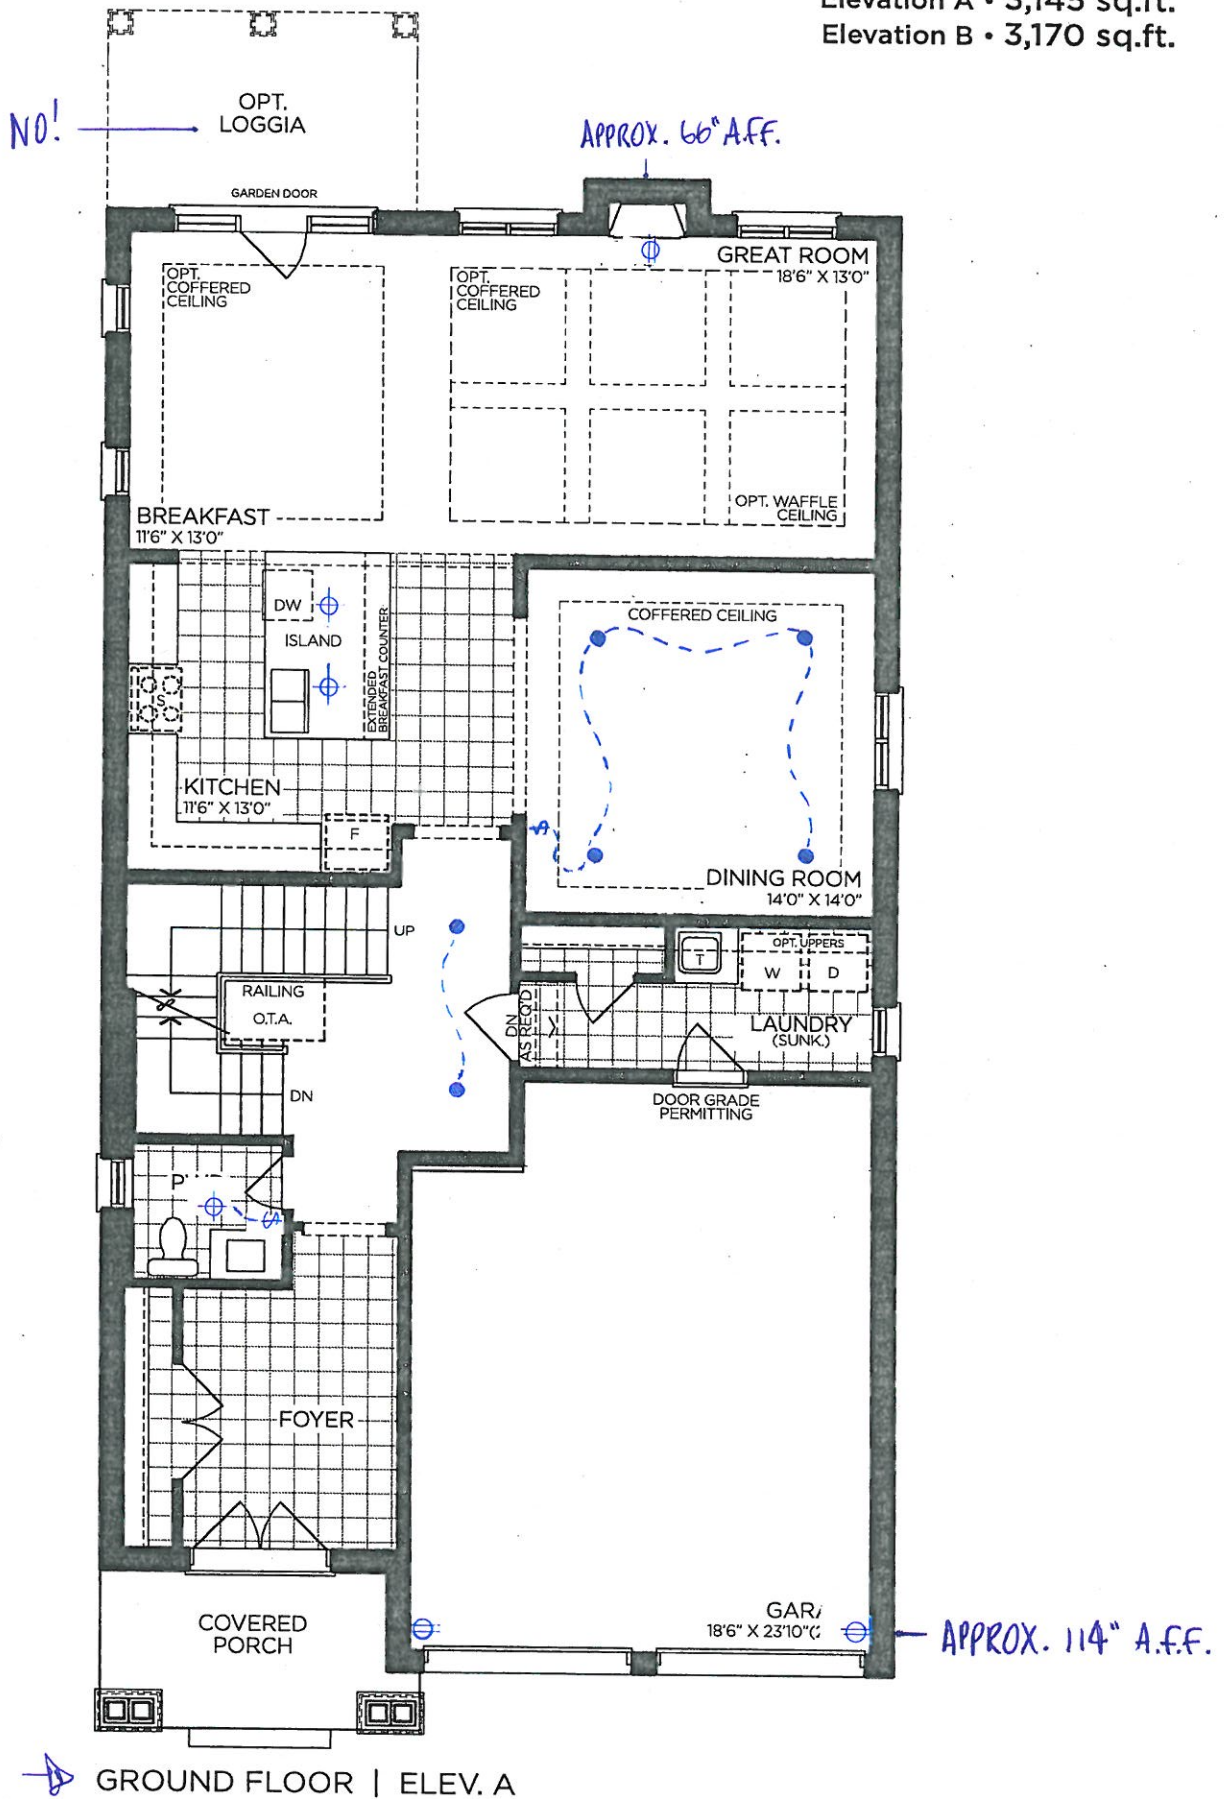


VENDOR

PURCHASER

PURCHASER

**GOLDPARK**  
WORTH MORE™

Prices, figures, illustrations, sizes, features and finishes are subject to change without notice. Areas and dimensions are approximate and actual usable floor space may vary from the stated area. Layout may be reverse of the unit purchased. E. & O.E. 4002



PINE VALLEY  
FOREVERGREEN

PV-35  
July 8, 2021

8' DOORS  
THRU OUT

SCHEDULE 'F'


The

Valleyview

40' SERIES

Elevation A • 3,145 sq.ft.

Elevation B • 3,170 sq.ft.

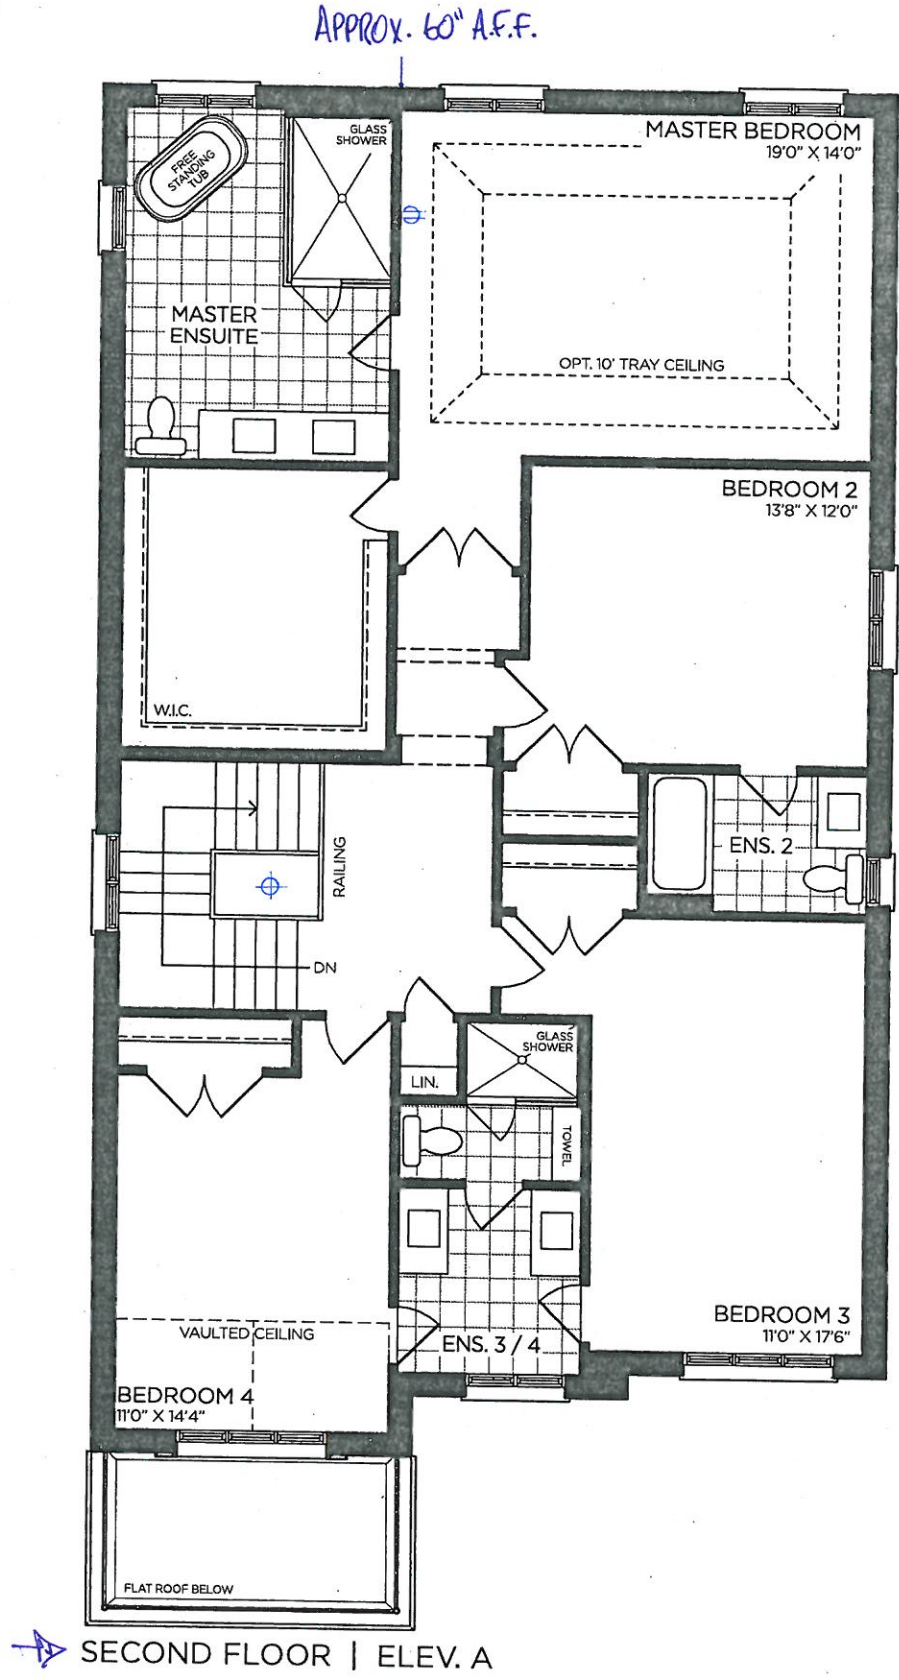

VENDOR

PURCHASER

PURCHASER

GOLDPARK

WORTH MORE™

Prices, figures, illustrations, sizes, features and finishes are subject to change without notice. Areas and dimensions are approximate and actual usable floor space may vary from the stated area. Layout may be reverse of the unit purchased. E. & O.E. 4002





SCHEDULE 'F'


PV-35  
July 8, 2021 *attached*

# The Valleyview

## 40' SERIES

Elevation A • 3,145 sq.ft.

Elevation B • 3,170 sq.ft.

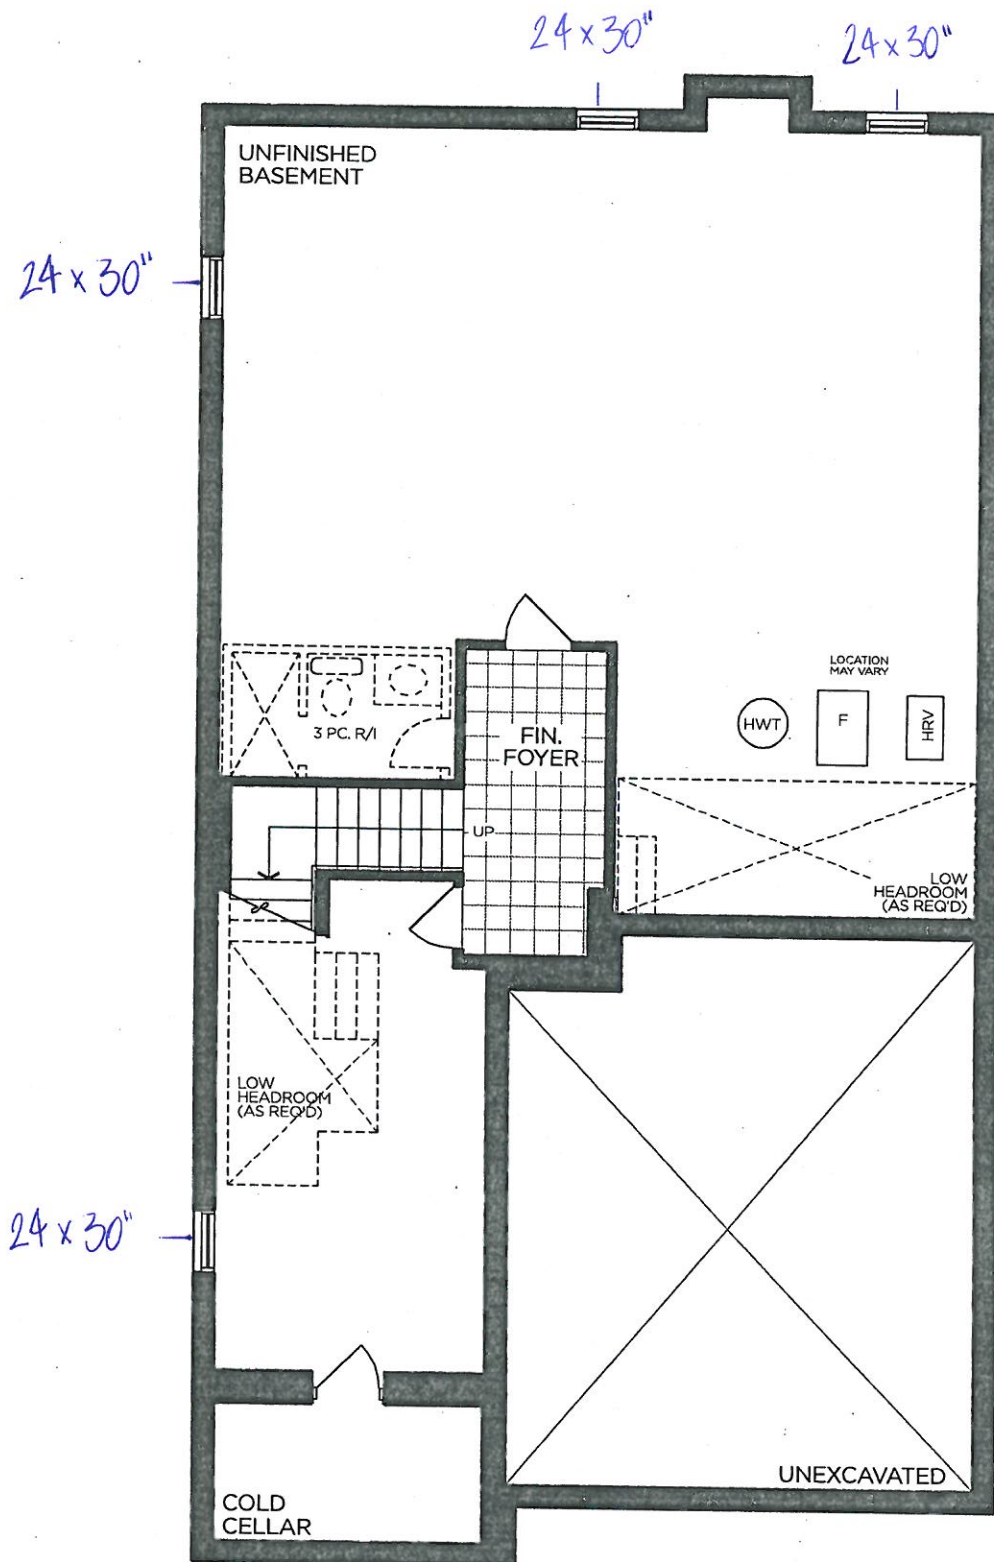

➡ BASEMENT | ELEV. A

VENDOR	<input type="text"/>
PURCHASER	<input type="text"/>
PURCHASER	<input type="text"/>

# GOLDPARK

WORTH MORE™


Prices, figures, illustrations, sizes, features and finishes are subject to change without notice. Areas and dimensions are approximate and actual usable floor space may vary from the stated area. Layout may be reverse of the unit purchased. E. & O.E. 4002



SCHEDULE 'F'  
PV-35  
July 8, 2021

# The Valleyview 40' SERIES

Elevation A • 3,145 sq.ft.  
Elevation B • 3,170 sq.ft.

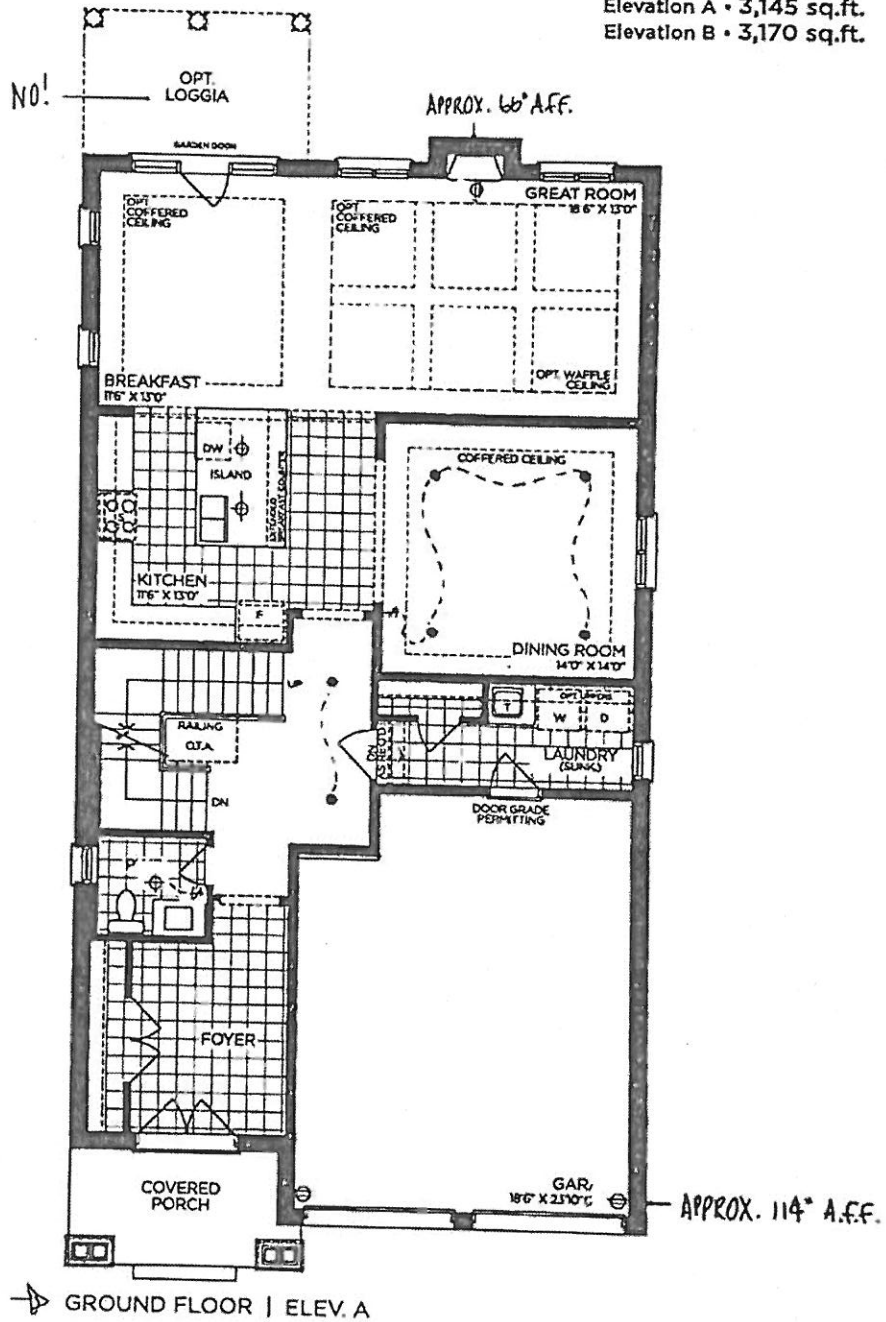


VENDOR

PURCHASER

PURCHASER

**GOLDPARK**  
WORTH MORE

Prices, figures, illustrations, sizes, features and finishes are subject to change without notice. Areas and dimensions are approximate and actual usable floor space may vary from the stated area. Layout may be reverse of the unit purchased. E & O.E. 4002

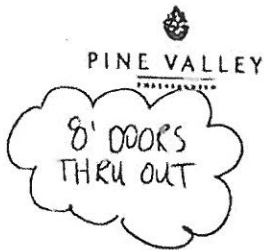


SCHEDULE 'F'

PV-35  
July 8, 2021

The  
Valleyview  
40' SERIES  
Elevation A • 3,145 sq.ft.  
Elevation B • 3,170 sq.ft.

APPROX. 60' A.F.F.

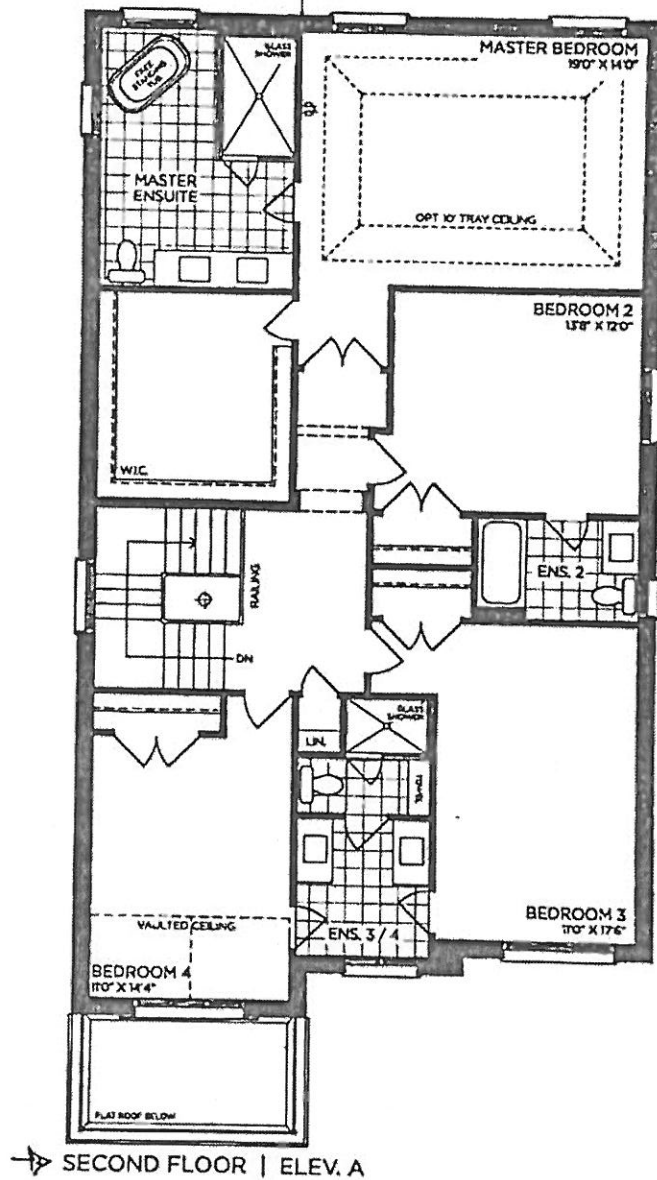

→ SECOND FLOOR | ELEV. A

VENDOR

PURCHASER

PURCHASER

GOLDPARK  
WORTH MORE™


Prices, figures, illustrations, sizes, features and finishes are subject to change without notice. Areas and dimensions are approximate and actual usable floor space may vary from the stated area. Layout may be reverse of the unit purchased. E. & O.E. 4002



SCHEDULE 'F'

PV-35  
July 8, 2021

The  
Valleyview  
40' SERIES  
Elevation A • 3,145 sq.ft.  
Elevation B • 3,170 sq.ft.

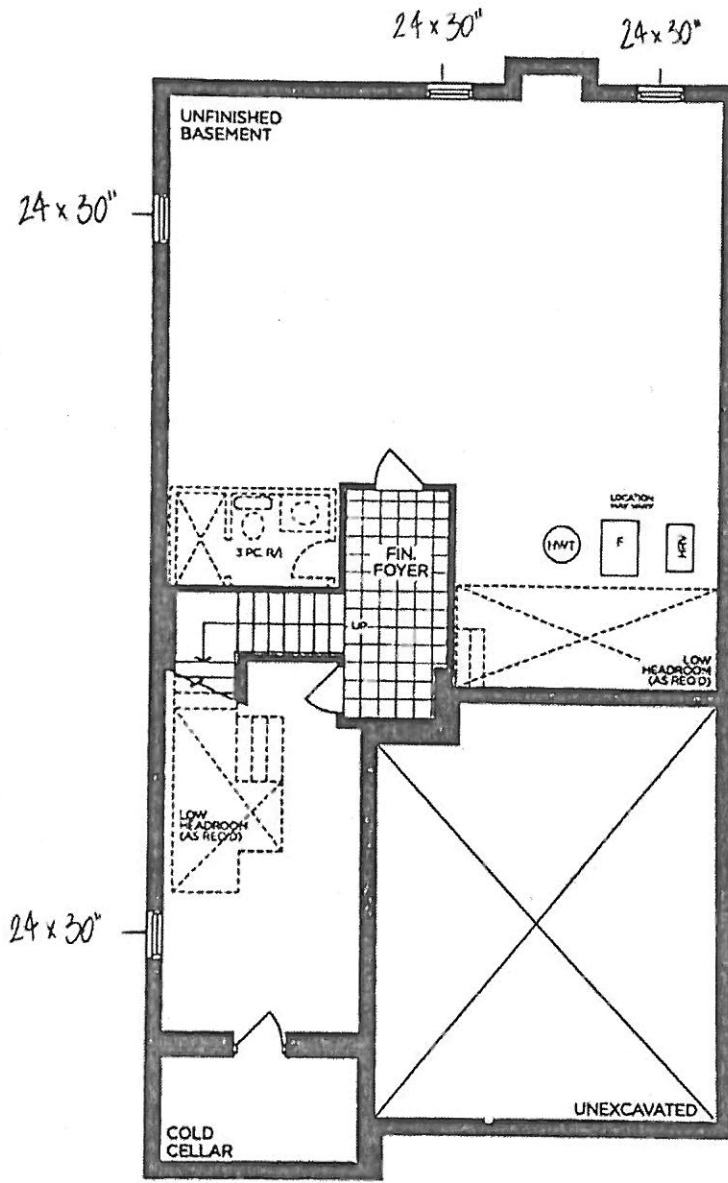

→ BASEMENT | ELEV. A

VENDOR	
PURCHASER	
PURCHASER	

GOLDPARK  
WORTH MORE

Prices, figures, illustrations, sizes, features and finishes are subject to change without notice. Areas and dimensions are approximate and actual usable floor space may vary from the stated area. Layout may be reverse of the unit purchased. E & O.E. 4002