



CONSTRUCTION SUMMARY

Lot: BLOCK 160
Model: 38-6 Elev.B SCARLATTI OPT- GFA1
Project/Phase: Brampton Encore / 2

CERAMIC

Invoice	Qty.	Description
2622 11Mar21 NoCat	1	FOYER / POWDER / GROUND FLOOR FOYER: UPGRADE 4 FLOOR TILE - 12X24" LAID IN STRAIGHT, STACKED PATTERN. SEE PLAN FOR TILE DIRECTION
2622 11Mar21 NoCat	1	MASTER ENSUITE: UPGRADE 4 FLOOR + SHOWER WALL TILE - 12X24" LAID IN STRAIGHT, STACKED PATTERN - HORIZONTAL ON WALLS
2622 11Mar21 NoCat	1	MASTER ENSUITE: UPGRADE TO FREE STANDING TUB - MIROLIN 'BROOKE' FLOOR TILE REQUIRED WALL TO WALL

CONCRETE AND DRAIN

Invoice	Qty.	Description
2549 28,894 27Jan21 **	1	ROUGH-IN - 3PC BASEMENT ROUGH-IN INCLUDED IN APS
2549 27Jan21 NoCat	1	.ROUGH-IN - 3PC BASEMENT ROUGH-IN INCLUDED IN APS

DRYWALL

Invoice	Qty.	Description
2549 27Jan21 NoCat	1	.SIDE DOOR- HOME TO EXTERIOR- AS PER PLAN AND GRADE PERMITTING Included in APS
2549 27Jan21 NoCat	1	.MANDOOR - GARAGE TO HOUSE- AS PER PLAN AND GRADE PERMITING INCLUDED IN APS
2549 27Jan21 NoCat	3	.MAIN FLOOR: EXTENDED HEIGHT ARCHWAY (PRICE PER DOORWAY) - 96"
2549 27Jan21 NoCat	4	.MAIN FLOOR: STANDARD DOOR EXTENDED HEIGHT 96" (PRICE PER DOOR) MAIN FLOOR 3 STOREY MODELS
2622 11Mar21 NoCat	1	FYI - MASTER ENSUITE: UPGRADE TO FREE STANDING TUB - MIROLIN 'BROOKE'
2791 03Jun21 NoCat	1	***DELETE*** STANDARD DOOR EXTENDED HEIGHT 96" IN BROOM CLOSET (PRICE PER DOOR) MAIN FLOOR 3 STOREY MODELS - INCLUDE FRAMING NOTE DELETE FROM ORDER PE.2549 - NOT AVAILABLE DUE TO SITE CONDITION (broom closet)



CONSTRUCTION SUMMARY

Lot: BLOCK 160
Model: 38-6 Elev.B SCARLATTI OPT- GFA1
Project/Phase: Brampton Encore / 2

ELECTRICAL

Invoice	Qty.	Description
2549 27Jan21 NoCat	1	KITCHEN: SINGLE POLE SWITCH FOR PENINSULA LIGHT
2549 28,822 27Jan21	1	KITCHEN: ROUGH - IN CEILING OUTLET ON SAME SWITCH - DOES NOT INCLUDE FIXTURE - LOCATE APPROX CENTERED ABOVE PENINSULA
2549 28,811 27Jan21	1	200 AMP ELECTRICAL SERVICE
2549 28,810 27Jan21	1	KITCHEN: 220V WALL RECEPTICAL ON DEDICATED CIRCUIT- FOR 4 WIRE BUILT-IN WALL OVEN - SEE PLAN FOR LOCATION
2549 28,808 27Jan21	1	KITCHEN: 110V WALL RECEPTACLE ON DEDICATED CIRCUIT - GAS FIRED APPLIANCE - FOR AUX. EQUIPMENT - NOT A STOVE PLUG

EXTERIOR COLOURS

Invoice	Qty.	Description
2549 27Jan21 NoCat	1	COLOUR PACKAGE #4

FORMING

Invoice	Qty.	Description
2549 28,841 27Jan21	1	SIDE DOOR- HOME TO EXTERIOR- AS PER PLAN AND GRADE PERMITTING INCLUDED IN APS
2549 28,842 27Jan21 **	1	MANDOOR - GARAGE TO HOUSE- AS PER PLAN AND GRADE PERMITTING INCLUDED IN APS
2549 28,916 27Jan21 **	4	BASEMENT WINDOWS - UPGRADE EXISTING BASEMENT WINDOW TO 30 INCH X 24 INCH - MAY REQUIRE INSTALLATION OF WINDOW WELL
2549 27Jan21 NoCat	1	.MANDOOR - GARAGE TO HOUSE- AS PER PLAN AND GRADE PERMITTING INCLUDED IN APS
2549 27Jan21 NoCat	4	.BASEMENT WINDOWS - UPGRADE EXISTING BASEMENT WINDOW TO 30 INCH X 24 INCH - MAY REQUIRE INSTALLATION OF WINDOW WELL



CONSTRUCTION SUMMARY

Lot: BLOCK 160
Model: 38-6 Elev.B SCARLATTI OPT- GFA1
Project/Phase: Brampton Encore / 2

FRAMING

Invoice	Qty.	Description
2549 28,842 27Jan21	1	MANDOOR - GARAGE TO HOUSE- AS PER PLAN AND GRADE PERMITTING INCLUDED IN APS
2549 27Jan21 NoCat	1	.SIDE DOOR- HOME TO EXTERIOR- AS PER PLAN AND GRADE PERMITTING INCLUDED IN APS
2549 27Jan21 NoCat	4	.BASEMENT WINDOWS - UPGRADE EXISTING BASEMENT WINDOW TO 30 INCH X 24 INCH - MAY REQUIRE INSTALLATION OF WINDOW WELL
2549 27Jan21 NoCat	3	.MAIN FLOOR: EXTENDED HEIGHT ARCHWAY (PRICE PER DOORWAY) - 96"
2549 27Jan21 NoCat	4	.MAIN FLOOR: STANDARD DOOR EXTENDED HEIGHT 96" (PRICE PER DOOR) MAIN FLOOR 3 STOREY MODELS
2622 11Mar21 NoCat	1	FYI - MASTER ENSUITE: UPGRADE TO FREE STANDING TUB - MIROLIN 'BROOKE'
2791 03Jun21 NoCat	1	***DELETE*** STANDARD DOOR EXTENDED HEIGHT 96" IN BROOM CLOSET (PRICE PER DOOR) MAIN FLOOR 3 STOREY MODELS - INCLUDE FRAMING NOTE DELETE FROM ORDER PE.2549 - NOT AVAILABLE DUE TO SITE CONDITION (broom closet)

GRANITE MARBLE QUARTZ

Invoice	Qty.	Description
2622 11Mar21 NoCat	1	KITCHEN: UPGRADE 3 QUARTZ COUNTER TOP
2622 11Mar21 NoCat	1	KITCHEN: FLUSH BREAKFAST BAR
2622 11Mar21 NoCat	1	KITCHEN: FULL HEIGHT SLAB BACKSPLASH - LEVEL 3 QUARTZ
2622 11Mar21 NoCat	1	KITCHEN: COOKTOP CUT OUT



CONSTRUCTION SUMMARY

Lot: BLOCK 160

Model: 38-6 Elev.B SCARLATTI OPT- GFA1

Project/Phase: Brampton Encore / 2

HARDWOOD

Invoice	Qty.	Description
2622	1	FAMILY / LIVING/ DINING/ MAIN HALL / LANDNGS / UPPER HALL / KITCHEN: UPGRADE 3 HARDWOOD - 3/4X5" VINTAGE WHITE OAK WIRE BRUSHED
11Mar21 NoCat		HARDWOOD FLOORS WILL NOT MATCH STAIRS IN COLOUR/TEXTURE/SPECIES
2622	1	FYI - KITCHEN: RAISE CABINETRY 3/4" FOR HARDWOOD FLOOR INSTALL
11Mar21 NoCat		

HVAC

Invoice	Qty.	Description
2549 28,872 27Jan21	1	KITCHEN: GAS LINE ROUGH - 2ND FLOOR- (3-STOREY MODELS) FOR GAS COOKTOP OR RANGE TOP
2867 27Jul21 NoCat	1	A/C 4.0 TON INCLUDED IN APS



CONSTRUCTION SUMMARY

Lot: BLOCK 160

Model: 38-6 Elev.B SCARLATTI OPT- GFA1

Project/Phase: Brampton Encore / 2

INTERIOR TRIM AND DOORS

Invoice	Qty.	Description
2549 28,841 27Jan21 **	1	SIDE DOOR- HOME TO EXTERIOR- AS PER PLAN AND GRADE PERMITTING INCLUDED IN APS
2549 28,885 27Jan21	3	MAIN FLOOR: EXTENDED HEIGHT ARCHWAY (PRICE PER DOORWAY) - 96"
2549 28,884 27Jan21	4	MAIN FLOOR: STANDARD DOOR EXTENDED HEIGHT 96" (PRICE PER DOOR) MAIN FLOOR 3 STOREY MODELS
2549 27Jan21 NoCat	1	.SIDE DOOR- HOME TO EXTERIOR- AS PER PLAN AND GRADE PERMITTING Included in APS
2549 27Jan21 NoCat	1	.MANDOOR - GARAGE TO HOUSE- AS PER PLAN AND GRADE PERMITING INCLUDED IN APS
2549 27Jan21 NoCat	4	.BASEMENT WINDOWS - UPGRADE EXISTING BASEMENT WINDOW TO 30 INCH X 24 INCH - MAY REQUIRE INSTALLATION OF WINDOW WELL
2622 11Mar21 NoCat	1	MASTER ENSUITE: UPGRADE TO FREE STANDING TUB - MIROLIN 'BROOKE'
2791 28,884 03Jun21	-1	***DELETE*** STANDARD DOOR EXTENDED HEIGHT 96" IN BROOM CLOSET (PRICE PER DOOR) MAIN FLOOR 3 STOREY MODELS - INCLUDE FRAMING NOTE DELETE FROM ORDER PE.2549 - NOT AVAILABLE DUE TO SITE CONDITION (broom closet)
2791 03Jun21 NoCat	1	***DELETE*** STANDARD DOOR EXTENDED HEIGHT 96" (PRICE PER DOOR) MAIN FLOOR 3 STOREY MODELS



CONSTRUCTION SUMMARY

Lot: BLOCK 160

Model: 38-6 Elev.B SCARLATTI OPT- GFA1

Project/Phase: Brampton Encore / 2

KITCHEN AND BATH CABINETRY

Invoice	Qty.	Description
2622 11Mar21 NoCat	1	KITCHEN: UPGRADE 2 CABINETRY PROFILE + SPRAY STAIN
2622 11Mar21 NoCat	1	KITCHEN: DOUBLE APPLIANCE CABINET WITH POT DRAWER BELOW OVENS
2622 11Mar21 NoCat	3	KITCHEN: POTS AND PANS DRAWERS BELOW COOKTOP - 1 SHALLOW TOP DRAWER (dummy at cooktop) + 2 DEEP DRAWERS BELOW
2622 11Mar21 NoCat	1	KITCHEN: FINISHED GABLE AT OVENS
2622 11Mar21 NoCat	1	KITCHEN: L-SHAPED CANOPY - INCLUDES 600CFM FAN
2622 11Mar21 NoCat	1	KITCHEN: UPGRADE HARDWARE
2622 11Mar21 NoCat	1	KITCHEN: RAISE CABINETRY 3/4" FOR HARDWOOD FLOOR INSTALL
2622 11Mar21 NoCat	1	FYI - KITCHEN: FULL HEIGHT SLAB BACKSPLASH - LEVEL 3 QUARTZ



CONSTRUCTION SUMMARY

Lot: BLOCK 160
Model: 38-6 Elev.B SCARLATTI OPT- GFA1
Project/Phase: Brampton Encore / 2

PAINT

Invoice	Qty.	Description
2549 28,842 27Jan21 **	1	MANDOOR - GARAGE TO HOUSE- AS PER PLAN AND GRADE PERMITING INCLUDED IN APS
2549 27Jan21 NoCat	1	.SIDE DOOR- HOME TO EXTERIOR- AS PER PLAN AND GRADE PERMITTING Included in APS
2549 27Jan21 NoCat	1	.MANDOOR - GARAGE TO HOUSE- AS PER PLAN AND GRADE PERMITING INCLUDED IN APS
2549 27Jan21 NoCat	3	.MAIN FLOOR: EXTENDED HEIGHT ARCHWAY (PRICE PER DOORWAY) - 96"
2549 27Jan21 NoCat	4	.MAIN FLOOR: STANDARD DOOR EXTENDED HEIGHT 96" (PRICE PER DOOR) MAIN FLOOR 3 STOREY MODELS
2622 11Mar21 NoCat	1	MAIN STAIRS: STAIN STAIRS
2622 11Mar21 NoCat	1	MASTER ENSUITE: UPGRADE TO FREE STANDING TUB - MIROLIN 'BROOKE'
2622 11Mar21 NoCat	1	FYI - MAIN STAIRS: EUROLINE 0 PICKETS + SQUARE NEWELL POSTS + STANDARD HAND RAIL
2791 03Jun21 NoCat	1	***DELETE*** STANDARD DOOR EXTENDED HEIGHT 96" IN BROOM CLOSET (PRICE PER DOOR) MAIN FLOOR 3 STOREY MODELS - INCLUDE FRAMING NOTE DELETE FROM ORDER PE.2549 - NOT AVAILABLE DUE TO SITE CONDITION (broom closet)

PLUMBING

Invoice	Qty.	Description
2549 28,894 27Jan21	1	ROUGH-IN - 3PC BASEMENT ROUGH-IN INCLUDED IN APS
2622 11Mar21 NoCat	1	KITCHEN: UPGRADE SINK TO BLANCO QATRUS R15 U SUPER SINGLE
2622 28,898 11Mar21	1	MASTER ENSUITE: UPGRADE TO FREE STANDING TUB - MIROLIN 'BROOKE'



CONSTRUCTION SUMMARY

Lot: BLOCK 160
Model: 38-6 Elev.B SCARLATTI OPT- GFA1
Project/Phase: Brampton Encore / 2

STAIRS AND RAILINGS

Invoice	Qty.	Description
2622	1	MAIN STAIRS: EUROLINE 0 PICKETS + SQUARE NEWELL POSTS + STANDARD HAND RAIL
11Mar21 NoCat		

WINDOWS - BASEMENT

Invoice	Qty.	Description
2549 28,916 27Jan21	4	BASEMENT WINDOWS - UPGRADE EXISTING BASEMENT WINDOW TO 30 INCH X 24 INCH - MAY REQUIRE INSTALLATION OF WINDOW WELL

WINDOWS AND DOORS

Invoice	Qty.	Description
2549 28,841 27Jan21 **	1	SIDE DOOR- HOME TO EXTERIOR- AS PER PLAN AND GRADE PERMITTING INCLUDED IN APS
2549 28,842 27Jan21 **	1	MANDOOR - GARAGE TO HOUSE- AS PER PLAN AND GRADE PERMITTING INCLUDED IN APS
2549 27Jan21 NoCat	1	.SIDE DOOR- HOME TO EXTERIOR- AS PER PLAN AND GRADE PERMITTING Included in APS

Scheduled Closing Date:

Purchaser: Inventory Lot_BLOCK 160

Property: BLOCK 160

Telephone Res. / Bus: (905) 760-9595

Project: Brampton Encore - Phase 2

Decor Advisor: Yolande Somerville

Model and Elevation: 38-6 Elev.B SCARLATTI OPT- GFA1

Layout Changes: ☐ Yes ☒ No Sketch Attached: ☒ Yes ☐ No Exterior Colour Scheme:

1. Cabinetry

	Style and Colour	Counter	Hardware
Kitchen / Breakfast	*Florentine oak 'Slate'	*Quartz: Misty Carrara	*CH-45
Laundry Room	n/a	n/a	n/a
Powder Room	n/a	n/a	n/a
Ground Floor Bath	Varese pvc 'White Crystal'	P-Lam #6698-46	cs1-23
Master Ensuite Bathroom	Siena oak 'Greystone'	P-Lam #4971-52	cs1-24
Second Ensuite Bathroom (If Applicable)	Siena oak 'Slate'	P-Lam #6698-46	cs1-23
Shared Ensuite	Siena oak 'Slate'	P-Lam #6698-46	cs1-23

Comment

2. Floor Tile

	Selection
Entrance Vestibule	*12x24" Eterna polished 'Imperial Grey'
Main Hall	
Kitchen / Breakfast	see hardwood
Laundry Room	13x13" New Reeds 'Taupe'
Powder Room	*12x24" Eterna polished 'Imperial Grey'
Ground Floor Bath	13x13" Costa matte 'White'
Master Ensuite Bathroom	*12x24" Eterna polished 'Imperial Grey'
Second Ensuite Bathroom (If Applicable)	13x13" Costa matte 'White'
Lower Landing (If Applicable)	*12x24" Eterna polished 'Imperial Grey'
Shared Bath	13x13" New Reeds 'Taupe'

Comment

3. Wall Tile

	Selection	Listello/Inserts	Describe
Ground Floor Bath	8x10" Weave 'White'	☐ Yes ☒ No	
Master Ensuite Bathroom			
Tub Deck		☐ Yes ☒ No	
Shower Stall	*12x24" Eterna pol 'Imperial Grey'	☐ Yes ☒ No	
Bathroom Walls		☐ Yes ☒ No	
Second Ensuite Bathroom (If Applicable)	8x10" Weave 'White'	☐ Yes ☒ No	
Shared Bath	8x10" Weave 'Tender Grey'	☐ Yes ☒ No	
Kitchen Backsplash	☒ Yes ☐ No	Backsplash Behind Fridge	

Comment

Scheduled Closing Date:

Purchaser: Inventory Lot_BLOCK 160

Property: BLOCK 160

Telephone Res. / Bus: (905) 760-9595

Project: Brampton Encore - Phase 2

Decor Advisor: Yolande Somerville

Model and Elevation: 38-6 Elev.B SCARLATTI OPT- GFA1

4. Plumbing Fixtures

	Second Ensuite		Powder Room	
Master Ensuite Bathroom	Other Room - Specify		Other Washroom	

Comment

See extras

5. Hardwood Flooring

	Type and Stain		Type and Stain
Main Hall		Upper Landing	
Kitchen / Breakfast	*3/4x5" wht oak wirebrush 'Atlantis'	Upper Hall	*3/4x5" wht oak wirebrush 'Atlantis'
Living Room		Master Bedroom	
Dining Room		Bedroom #2	
Family Room		Bedroom #3	
Den/Library		Bedroom #4	
Entrance Vestibule		Bedroom #5	
Lower Landing (If Applicable)		Other Room - Specify	
		Thru out standard areas	*3/4x5" wht oak wirebrush 'Atlantis'

Comment

6. Carpeting

	Upgrade	Description
Ground Floor	☐	Std: 4002-20 with std u/pad
Second Floor	☐	Std: 4002-20 with std u/pad
	☐	

Upgrade Underpad	Type	Area
Carpet on Stairs	Capped	Runner - *Upgrade

Comment

7. Fireplace

	Living Room			Family Room			Other Room - Specify		
	Purchased	As Per Plan	N/A	Purchased	As Per Plan	N/A	Purchased	As Per Plan	N/A
Fireplace Type	☐	☐	☒	☐	☒	☐	☐	☐	☒
Mantle Type				Standard Gas					
Colour / Stain				NF-23					
Surround				White					
Hearth				Nero Marquina					
				none					

Comment

Scheduled Closing Date:

Purchaser: Inventory Lot_BLOCK 160

Property: BLOCK 160

Telephone Res. / Bus: (905) 760-9595

Project: Brampton Encore - Phase 2

Decor Advisor: Yolande Somerville

Model and Elevation: 38-6 Elev.B SCARLATTI OPT- GFA1

8. Trim Carpentry

Interior Doors Front Door Glass Inserts Door Handles
 Interior Trim

Comment

9. Plaster Mouldings and Medallions

Standard Throughout ☐ Yes ☐ No ☒ N/A

Entrance Vestibule			Kitchen/Breakfast		
Main Hall			Den/Library		
Living Room			Lower Landing		
Dining Room			Other Room - Specify		
Family Room					

Comment

10. Railings and Spindles

Railing Package
 Railing Colour Spindle Colour
 Stringer / Riser Treads
 Oak Stairs ☒ Yes ☐ No ☐ N/A

Comment

11. Wall Paint / Ceilings

Throughout Finished Areas

Trim Paint

Smooth Ceilings

Ground Floor ☐

Second Floor ☐

Note

Comment

Scheduled Closing Date:

Purchaser: Inventory Lot_BLOCK 160

Property: BLOCK 160

Telephone Res. / Bus: (905) 760-9595

Project: Brampton Encore - Phase 2

Decor Advisor: Yolande Somerville

Model and Elevation: 38-6 Elev.B SCARLATTI OPT- GFA1

12. Electrical

Hood Fan ☐ White ☐ Stainless ☐ N/A

Above Kitchen Cabinet Light ☐ Yes ☒ No

Below Kitchen Cabinet Light ☐ Yes ☒ No

Standard Appliances ☐

Over The Range Microwave ☐

Chimney Style Fan ☐

Comment

13. Heating and Air Conditioning

Air Conditioning

Gas Provisions Stove

Gas Provisions Dryer

Gas Provisions Barbecue

Comment


14. Additional Comments

15. Disclaimers and Notes

- 1) Colours of all materials are as close as possible to builder's selection, but not necessarily identical due to variances in manufacturing.
- 2) Any extras listed above are null and void unless accompanied by a separate invoice/amendment. Said invoice must be paid in full.
- 3) The Purchaser acknowledges that after Interior Colour Selection form is signed and dated, no further changes will be permitted other than re-selection due to unavailability. _____ Purchaser's Initials
- 4) The Purchaser acknowledges reading and accepting the "Gold Park Homes Decor Centre Disclaimers" form. This document contains other miscellaneous disclaimers.

This Interior Colour Selection is final and approved by:

Signature: _____ Date: _____

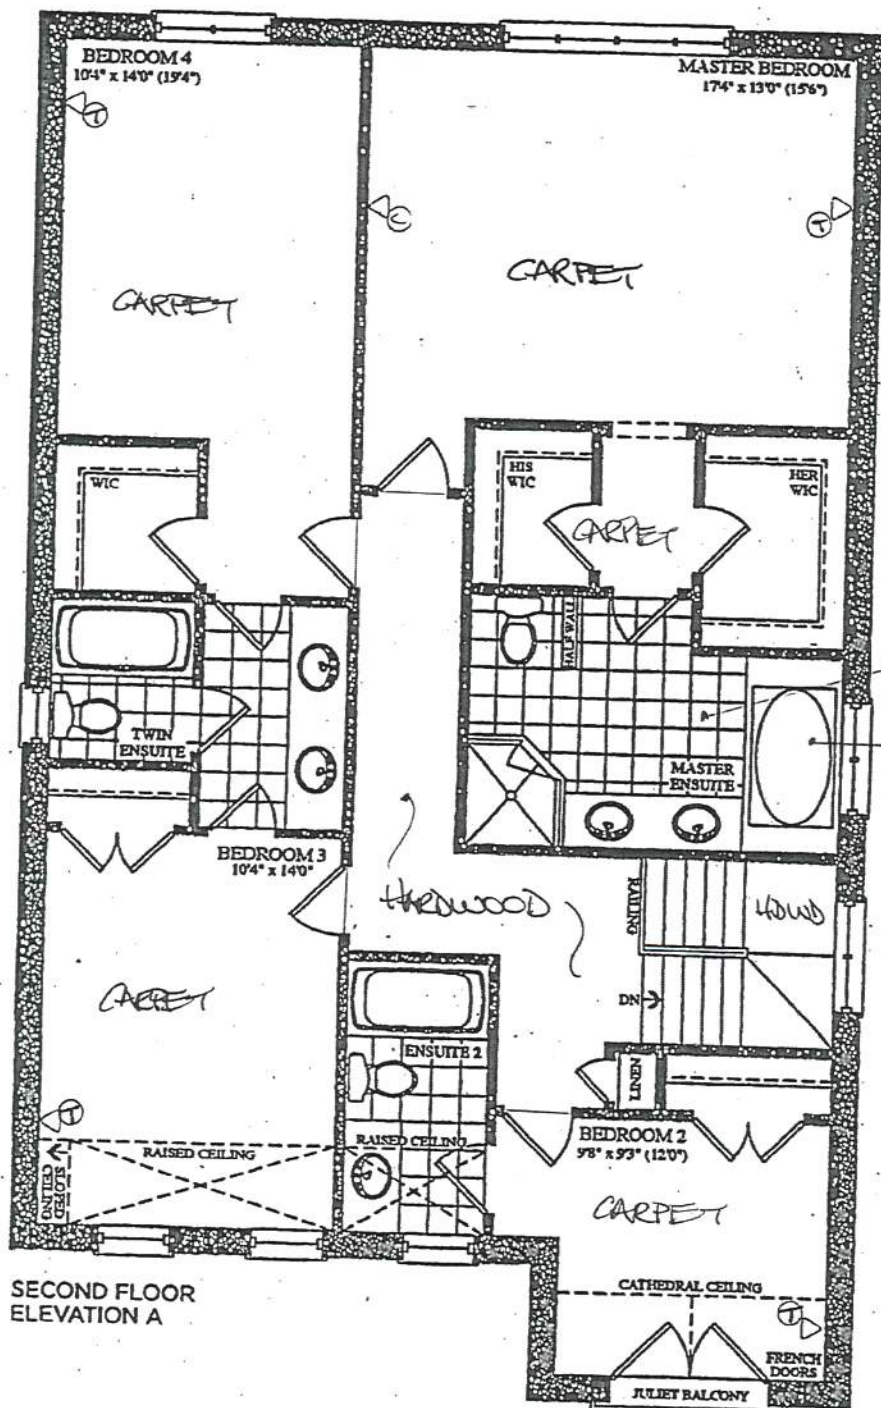

SECOND FLOOR
ELEVATION A

BEZ-160
JAN 8 2021

REVISED:
MAR 10 2021



FREE-STANDING
TUB

The Scarlatti

Elevation A • 3,591 sq.ft. Elevation B • 3,578 sq.ft.

Prices, figures, illustrations, sizes, features and finishes are subject to change without notice. E.A.O.E. Areas and dimensions are approximate and actual usable floor space may vary from the stated area. Layout may be reverse of the unit purchased. E. & O.E.

BE2-160
JAN 8 2021

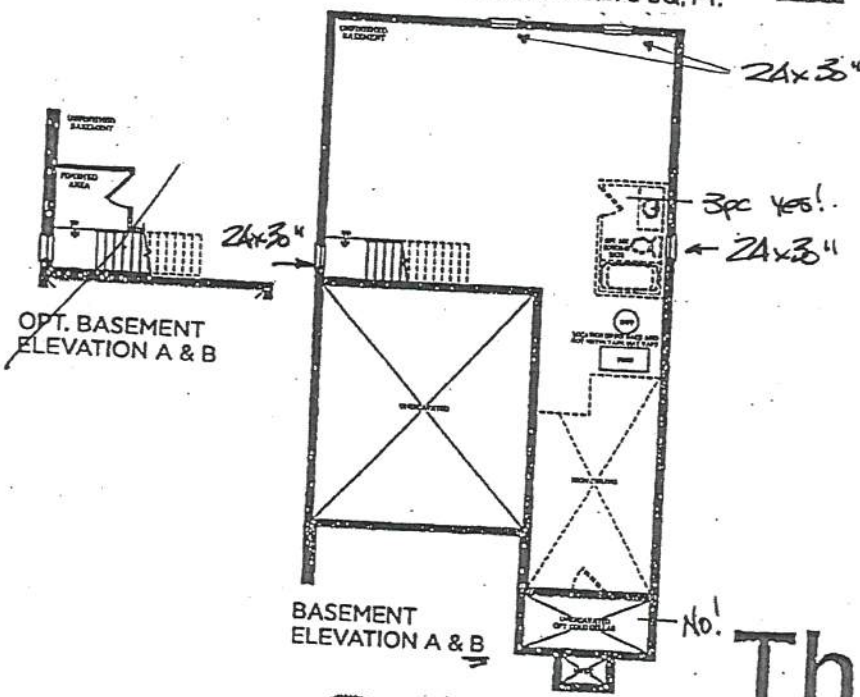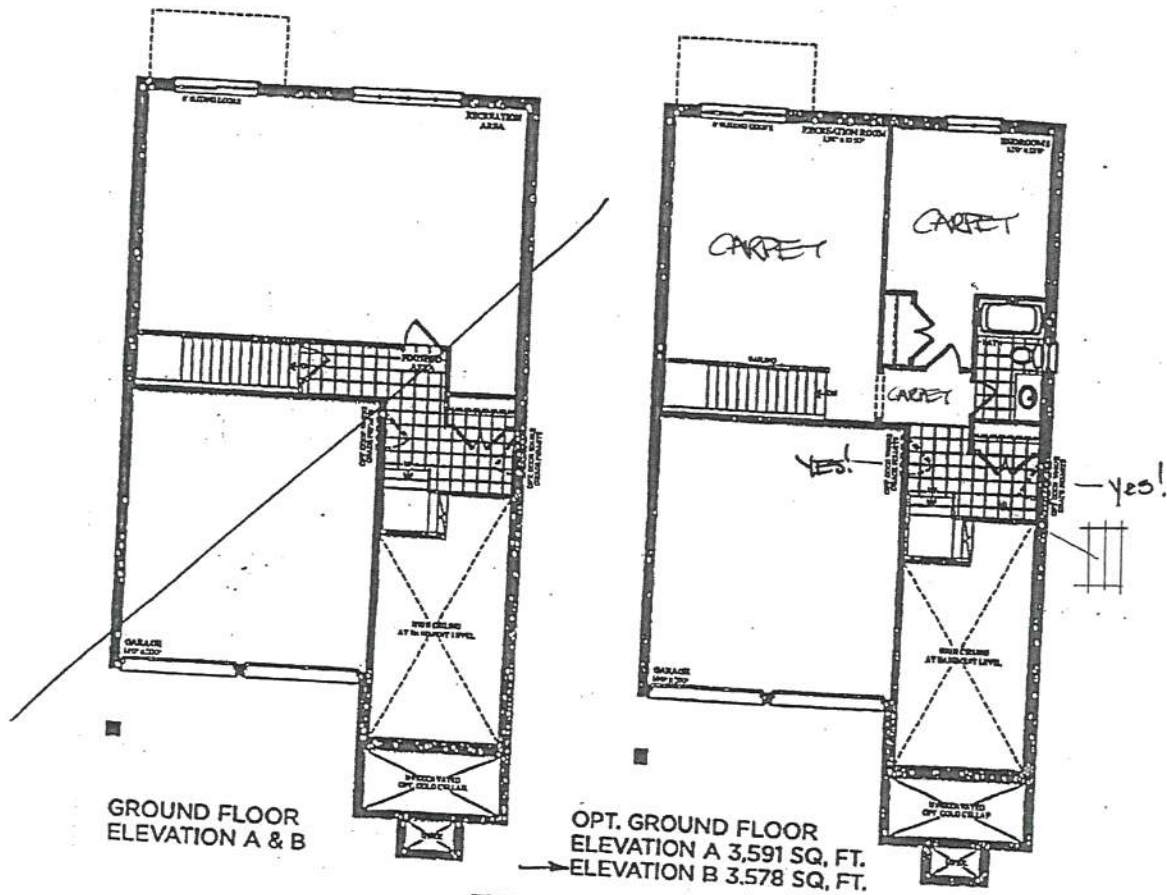


The Scarlatti

Elevation A • 3,591 sq.ft. Elevation B • 3,578 sq.ft.

Prices, figures, illustrations, sizes, features and finishes are subject to change without notice. E&O.E. Areas and dimensions are approximate and actual usable floor space may vary from the stated area. Layout may be reverse of the unit purchased. E. & O.E.

This layout has been explained to the purchaser by Cortina Kitchens Inc. and is understood by the purchaser.

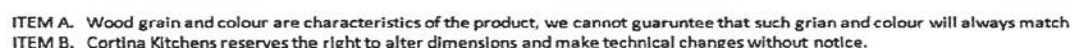

BE2-1160

March 10, 2021




20mm 1 3/4" Profiles


Kitchen



30mm 1 3/4" Profiles

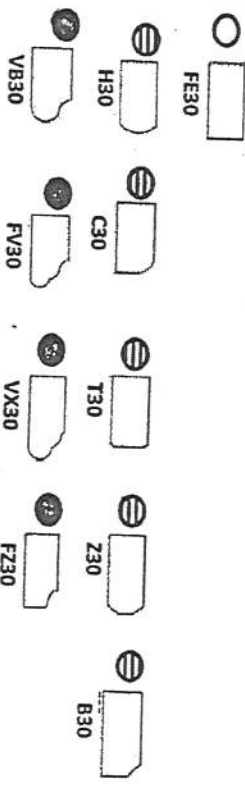

40mm 1 3/4" Profiles

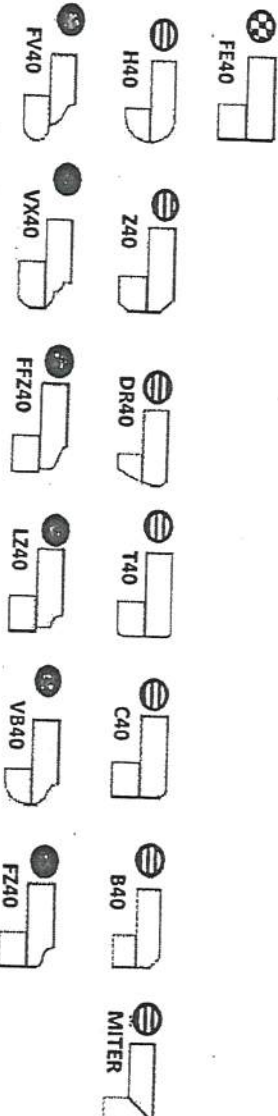

Note: All colours may not be available in 30mm at time ordered. Vendor reserves the right to use 40 mm edges (by lamination process).

*Mitre edge is available in Upgrade 1 for an overall thickness of 2". All other Mitre edge options will be an Upgrade 2 Edge.

ARTINA STANDARD HARDWARE

B62-160
March 10, 2021

MODIFIED: 19/05/18

STANDARD HARDWARE



CSI-6




CSI-10




CSI-14



CSI-16

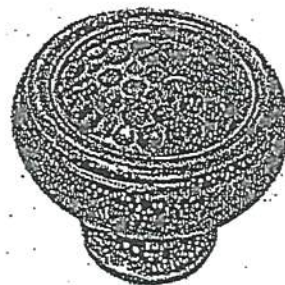

CSI-18

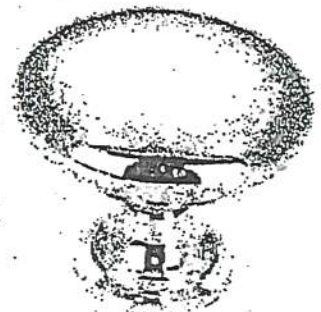

CSI-19



CSI-20

1. Ground Floor Bath
2. Ensuite 2
3. Shared Ensuite




CSI-21



CSI-22




CSI-23

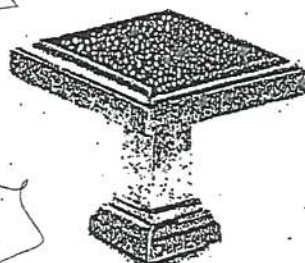

CSI-24

Master Ensuite

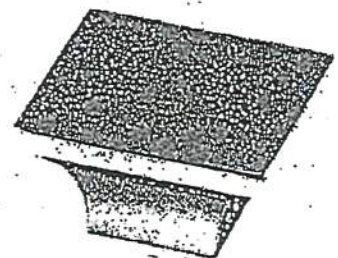

CSI-25

*NOTES:


- IMAGES ARE FOR QUICK REFERENCE PURPOSES ONLY
- ACTUAL SIZES AND FINISHES AS PER HARDWARE SAMPLE BOARD PROVIDED TO DECOR CENTRE




CH-32




CH-38

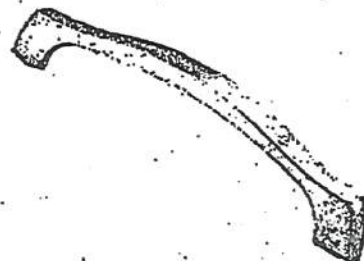


CH-44

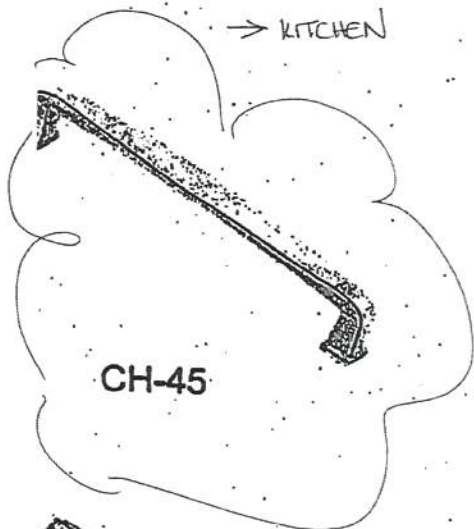


CH-45

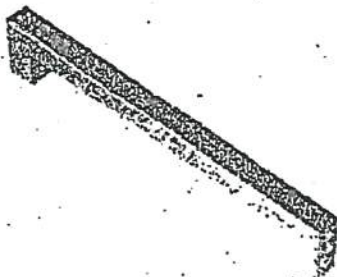

CH-46

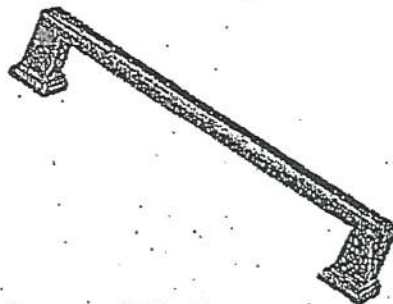


CH-47

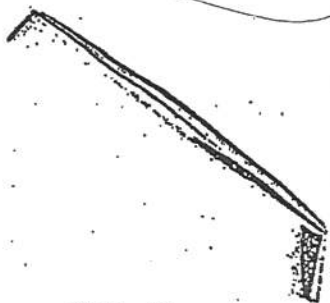


CH-48




CH-49

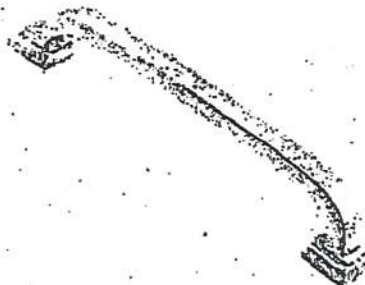


CH-50

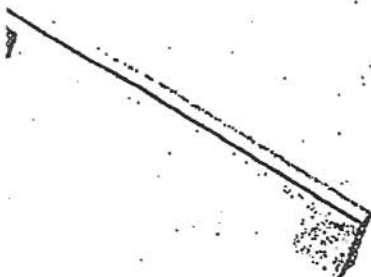

CH-51

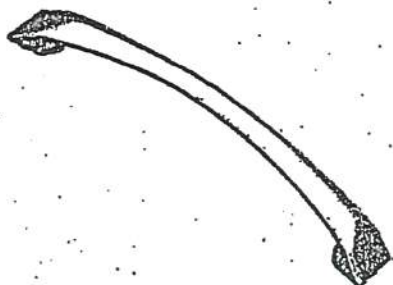

CH-52

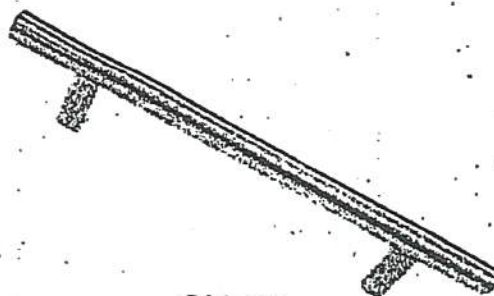

CH-53

NOTES:



IMAGES ARE FOR QUICK REFERENCE PURPOSES ONLY
ACTUAL SIZES AND FINISHES AS PER HARDWARE
SAMPLE BOARD PROVIDED TO DECOR CENTRE

UPGRADE KITCHEN SINK



BLANCO - QUATRUS R15 U SUPER SINGLE

Stainless Steel - Undermount
32" x 18" x 9"

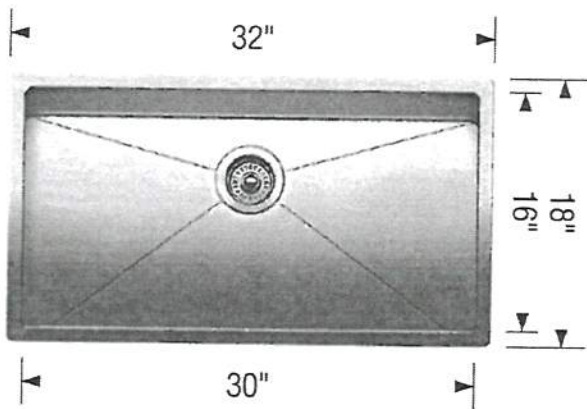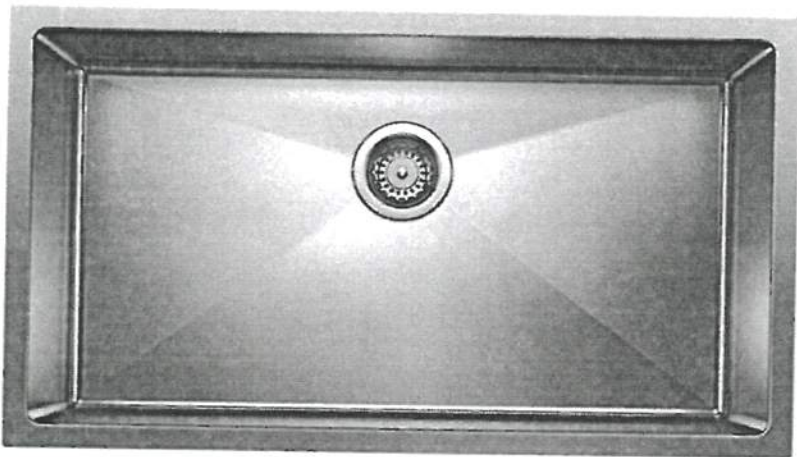

Stainless Steel

MODEL 401518 Stainless Steel

Lot# 160	Date: March 10, 2021	Room: Kitchen
Signature:		
Signature:		

UPGRADE TUB



MIROLIN - BROOKE
Freestanding Tub
68" x 36"
CF2002



Lot#

160

Date:

March 10, 2021

Room:

Master Ensuite

Signature:

Signature:



BATHROOM ACCESSORIES

PROJECT: ENCORE 2

LOT: 160

INSTALL STANDARD BATHROOM ACCESSORIES
THRU OUT (TOWEL BAR, SOAP DISH, TISSUE
HOLDER) **location as per vendors discretion



DO *NOT* INSTALL STANDARD BATHROOM
ACCESSORIES THRU OUT (TOWEL BAR, SOAP
DISH, TISSUE HOLDER)



SIGNATURE: _____

SIGNATURE: _____

DATE: March 10, 2021