



CONSTRUCTION SUMMARY

Lot: 112  
Model: 50.01 A HILLSBOROUGH  
Project/Phase: Pine Valley Forevergreen / 1

BASEMENT WINDOWS

Invoice	Qty.	Description
2388 72,675 25Aug20	1	**REVISED QTY** AUG 25 2020 : **.BASEMENT WINDOWS - UPGRADE BASEMENT WINDOW SIZE TO 30 " X 24" - 10" FRAME ( PINEVALLEY 50 FOOT LOTS ONLY) **REAR IS LOB**

CERAMIC

Invoice	Qty.	Description
2264  25Aug20 NoCat	2	.MASTER ENSUITE: SHOWER NICHE [SHAMPOO SHELF] - COMPLETE WITH MATCHING MARBLE JAMBS ON 4 SIDES, STANDARD TILE, APPROX. 12 X 18 INSTALLED VERTICALLY
2898  23Sep21 NoCat	1	FOYER\; NON-STD AREA, VINTAGE SERIES, 6-1/2" X 3/4" WHITE OAK, NSS ENG. HWD, SCULPTED TEXTURE, UVF FINISH - FOYER - LEVEL 6  DO NOT SUPPLY / INSTALL CERAMIC - CREDIT
2898  23Sep21 NoCat	1	KITCHEN/BREAKFAST\; NON-STD AREA, VINTAGE SERIES, 6-1/2" X 3/4" WHITE OAK, NSS ENG. HWD, SCULPTED TEXTURE, UVF FINISH - KITCHEN / BREAKFAST - LEVEL 6  DO NOT SUPPLY / INSTALL CERAMIC - CREDIT

CONCRETE AND DRAIN

Invoice	Qty.	Description
2264  25Aug20 NoCat	1	.BACK-FLOW PREVENTER VALVE

CROWN MOULDING

Invoice	Qty.	Description
2264  25Aug20 NoCat	1	**GREAT ROOM: OPT COFFERED CEILING AS PER PLAN
2264  25Aug20 NoCat	1	**GREAT ROOM: OPTIONAL WAFFLE CEILING (4 BOX) AS PER PLAN CTR-B07
2264  25Aug20 NoCat	1	.MASTER BEDROOM - OPT. 10 FOOT TRAY CEILING - AS PER PLAN



CONSTRUCTION SUMMARY

Lot: 112  
Model: 50.01 A HILLSBOROUGH  
Project/Phase: Pine Valley Forevergreen / 1

DRYWALL

Invoice	Qty.	Description
2264  25Aug20 NoCat	1	.**GREAT ROOM: OPT COFFERED CEILING AS PER PLAN
2264  25Aug20 NoCat	1	.**GREAT ROOM: OPTIONAL WAFFLE CEILING (4 BOX) AS PER PLAN CTR-B07
2264  25Aug20 NoCat	1	.MASTER BEDROOM - OPT. 10 FOOT TRAY CEILING - AS PER PLAN
2264  25Aug20 NoCat	19	.2ND FLOOR: INCREASE HEIGHT OF DOOR TO 8FT SECOND FLOOR - PER DOOR



CONSTRUCTION SUMMARY

Lot: 112  
Model: 50.01 A HILLSBOROUGH  
Project/Phase: Pine Valley Forevergreen / 1

ELECTRICAL

Invoice	Qty.	Description
2264 72,281 25Aug20	1	.GREAT ROOM: INTERIOR WALL OUTLET: ADDITIONAL 110V WALL INTERIOR RECEPTACLE ON EXISTING CIRCUIT FOR WALL MOUNTED TV - APPROX. 66" A.F.F. ABOVE FIREPLACE
2264 72,289 25Aug20	7	.MAIN HALL: 4" E/S LED INTERIOR POT LIGHT - GROUND FLOOR - EACH  IN LIEU OF STANDARD CEILING LIGHTS - USE STD SWITCH
2264 72,289 25Aug20	2	.HALL AT POWDER ROOM: 4" E/S LED INTERIOR POT LIGHT - GROUND FLOOR - EACH  IN LIEU OF STD CEILING LIGHTS - USE STD SWITCH INCLUDED IN APS
2264 72,289 25Aug20	4	.DINING ROOM: 4" E/S LED INTERIOR POT LIGHT - GROUND FLOOR - EACH
2264 72,278 25Aug20	1	.DINING ROOM: ADDITIONAL INTERIOR SWITCH  FOR POTLIGHTS
2264 72,309 25Aug20	1	.GREAT ROOM: UPGRADE STANDARD CEILING MOUNT FIXTURE TO (1) LED POT LIGHT - GROUND FLOOR - SEE PLAN FOR LOCATION
2264 72,289 25Aug20	7	.GREAT ROOM: 4" E/S LED INTERIOR POT LIGHT - GROUND FLOOR - EACH  USE SAME SWITCH AS STANDARD
2264 72,289 25Aug20	4	.BREAKFAST ROOM: 4" E/S LED INTERIOR POT LIGHT - GROUND FLOOR - EACH - INCLUDES 1 SWITCH  INCLUDED IN APS
2264 72,307 25Aug20	1	.KITCHEN: FIXTURE: RELOCATE STANDARD CEILING MOUNT FIXTURE - ABOVE ISLAND
2264 72,280 25Aug20	1	.KITCHEN: CEILING OUTLET: ADDITIONAL REINFORCED CEILING OUTLET - LOCATE ABOVE ISLAND, USE SAME SWITCH AS STANDARD
2264 72,303 25Aug20	1	.KITCHEN: FIXTURE: UNDER CABINET FLUORESCENT LIGHT FIXTURES - DOES NOT INCLUDE (AND REQUIRES) LIGHT VALANCE
2264 72,289 25Aug20	7	.KITCHEN: 4" E/S LED INTERIOR POT LIGHT - GROUND FLOOR - EACH
2264 72,278 25Aug20	1	.KITCHEN: ADDITIONAL INTERIOR SWITCH  FOR POTLIGHTS



CONSTRUCTION SUMMARY

Lot: 112  
Model: 50.01 A HILLSBOROUGH  
Project/Phase: Pine Valley Forevergreen / 1

ELECTRICAL

Invoice	Qty.	Description
2264 72,273 25Aug20	1	.KITCHEN: 110V WALL RECEPTACLE ON SEPARATE CIRCUIT - GAS FIRED APPLIANCE - FOR AUX. EQUIPMENT - NOT A STOVE PLUG
2264 72,310 25Aug20	2	.UPPER HALL: UPGRADE STANDARD CEILING MOUNT FIXTURE TO (1) LED POT LIGHT - SECOND FLOOR - SEE PLAN FOR LOCATION
2264 72,290 25Aug20	4	.UPPER HALL: 4" E/S LED INTERIOR POT LIGHT (INSULATED CEILING) - SECOND FLOOR - EACH
2264 72,279 25Aug20	1	.MASTER ENSUITE: SHOWER POT LIGHT: 6" RECESSED SHOWER POT LIGHT - USE SAME SWITCH AS STANDARD

EXTERIOR COLOURS

Invoice	Qty.	Description
2264  25Aug20 NoCat	1	EXTERIOR COLOUR PKG: BR# 4

FIREPLACE

Invoice	Qty.	Description
2898  23Sep21 NoCat	1	GREAT ROOM: UPGRADE MANTLE TO 'CAPRI'

FORMING

Invoice	Qty.	Description
2264  25Aug20 NoCat	1	**REVISED QTY** AUG 25 2020 : **.BASEMENT WINDOWS - UPGRADE BASEMENT WINDOW SIZE TO 30 " X 24" - 10" FRAME ( PINEVALLEY 50 FOOT LOTS ONLY) - **REAR IS LOB**
2264  25Aug20 NoCat	1	.BREAKFAST ROOM: UPGRADE EXTERIOR GARDEN DOOR ASSEMBLY TO 96" TALL



CONSTRUCTION SUMMARY

Lot: 112  
Model: 50.01 A HILLSBOROUGH  
Project/Phase: Pine Valley Forevergreen / 1

FRAMING

Invoice	Qty.	Description
2264 72,675 25Aug20	1	**REVISED QTY** AUG 25 2020 : **.BASEMENT WINDOWS - UPGRADE BASEMENT WINDOW SIZE TO 30 " X 24" - 10" FRAME ( PINEVALLEY 50 FOOT LOTS ONLY) - **REAR IS LOB**
2264  25Aug20 NoCat	1	**GREAT ROOM: OPT COFFERED CEILING AS PER PLAN
2264  25Aug20 NoCat	1	**GREAT ROOM: OPTIONAL WAFFLE CEILING (4 BOX) AS PER PLAN CTR-B07
2264  25Aug20 NoCat	1	.BREAKFAST ROOM: UPGRADE EXTERIOR GARDEN DOOR ASSEMBLY TO 96" TALL
2264 72,523 25Aug20	1	.MASTER BEDROOM - OPT. 10 FOOT TRAY CEILING - AS PER PLAN
2264 72,631 25Aug20	2	.MASTER ENSUITE: SHOWER NICHE [SHAMPOO SHELF] - COMPLETE WITH MATCHING MARBLE JAMBS ON 4 SIDES, STANDARD TILE, APPROX. 12 X 18 INSTALLED VERTICALLY
2264 72,644 25Aug20	19	.2ND FLOOR: INCREASE HEIGHT OF DOOR TO 8FT SECOND FLOOR - PER DOOR

GLASS AND MIRROR

Invoice	Qty.	Description
2898  23Sep21 NoCat	2	MASTER ENSUITE + SHARED ENSUITE: UPGRADE SHOWER DOOR HANDLE - CHROME

HARDWOOD

Invoice	Qty.	Description
2898 83 23Sep21	1	FOYER\; NON-STD AREA, VINTAGE SERIES, 6-1/2" X 3/4" WHITE OAK, NSS ENG. HWD, SCULPTED TEXTURE, UVF FINISH - FOYER - LEVEL 6
2898 83 23Sep21	1	KITCHEN/BREAKFAST\; NON-STD AREA, VINTAGE SERIES, 6-1/2" X 3/4" WHITE OAK, NSS ENG. HWD, SCULPTED TEXTURE, UVF FINISH - KITCHEN / BREAKFAST - LEVEL 6
2898  23Sep21 NoCat	1	THRU-OUT STANDARD AREAS: SITTING ROOM, MAIN HALL, DINING ROOM, GREAT ROOM, UPPER HALL, MASTER BEDROOM, BEDROOM 2, 3, 4 - VINTAGE SERIES, 6-1/2" WHITE OAK, NSS ENGINEERED HARDWOOD, 3/4" THK, SCULPTED TEXTURE, UVF FINISH - LEVEL 6



CONSTRUCTION SUMMARY

Lot: 112  
Model: 50.01 A HILLSBOROUGH  
Project/Phase: Pine Valley Forevergreen / 1

HVAC

Invoice	Qty.	Description
2264 72,224 25Aug20	1	.KITCHEN: GAS LINE ROUGH-IN - MAIN FLOOR FOR APPLIANCE - SEE PLAN

INTERIOR TRIM AND DOORS

Invoice	Qty.	Description
2264  25Aug20 NoCat	1	.**GREAT ROOM: OPT COFFERED CEILING AS PER PLAN
2264  25Aug20 NoCat	1	.**GREAT ROOM: OPTIONAL WAFFLE CEILING (4 BOX) AS PER PLAN CTR-B07
2264  25Aug20 NoCat	1	.MASTER BEDROOM - OPT. 10 FOOT TRAY CEILING - AS PER PLAN
2264  25Aug20 NoCat	19	.2ND FLOOR: INCREASE HEIGHT OF DOOR TO 8FT SECOND FLOOR - PER DOOR

KITCHEN AND BATH CABINETRY

Invoice	Qty.	Description
2264  25Aug20 NoCat	1	KITCHEN: ROUGH-IN FOR KITCHEN POT FILLER (FIXTURE NOT INCLUDED)
2898  23Sep21 NoCat	1	THRU-OUT: SEE ATTACHED CABINETRY SCHEDULE

NETWORK AND WIRING

Invoice	Qty.	Description
2264 72,259 25Aug20	1	.GREAT ROOM: CONDUIT PIPE - FOR WALL MOUNT TV - LOCATE APPROX 66" A.F.F. ABOVE FIREPLACE, THRU BASEMENT TERMINATING AT CABLE LOCATION



CONSTRUCTION SUMMARY

Lot: 112  
Model: 50.01 A HILLSBOROUGH  
Project/Phase: Pine Valley Forevergreen / 1

PAINT

Invoice	Qty.	Description
2264  25Aug20 NoCat	1	.**GREAT ROOM: OPT COFFERED CEILING AS PER PLAN
2264  25Aug20 NoCat	1	.**GREAT ROOM: OPTIONAL WAFFLE CEILING (4 BOX) AS PER PLAN CTR-B07
2264  25Aug20 NoCat	1	.MASTER BEDROOM - OPT. 10 FOOT TRAY CEILING - AS PER PLAN
2264  25Aug20 NoCat	19	.2ND FLOOR: INCREASE HEIGHT OF DOOR TO 8FT SECOND FLOOR - PER DOOR

PLUMBING

Invoice	Qty.	Description
2264 72,346 25Aug20	1	KITCHEN: ROUGH-IN FOR KITCHEN POT FILLER (FIXTURE NOT INCLUDED)
2264  25Aug20 NoCat	1	MASTER ENSUITE: MOEN 'ARRIS' POSI-TEMP 3-FUNCTION RAIN SHOWER (from ceiling) + HAND SHOWER + SLIDE BAR - CHROME #TS22002EP/3372/TS23005/62320/3887EP/A725
2264  25Aug20 NoCat	1	.BACK-FLOW PREVENTER VALVE
2898  23Sep21 NoCat	1	KITCHEN: POT FILLER TRIM - MOEN 'MODERN' MATTE BLACK  ROUGH-IN ON STRUCTURAL ORDER

STAIR AND RAILINGS

Invoice	Qty.	Description
2898 160,249 23Sep21	2	MAIN STAIRS: RAILING PACKAGE A-2
2898  23Sep21 NoCat	2	MAIN STAIRS 2ND FLOOR TO BASEMENT: STAIN STAIRS AND LANDINGS  WILL NOT MATCH HARDWOOD IN COLOUR, SPECIES OR TEXTURE



CONSTRUCTION SUMMARY

Lot: 112  
Model: 50.01 A HILLSBOROUGH  
Project/Phase: Pine Valley Forevergreen / 1

WINDOWS AND DOORS

Invoice	Qty.	Description
2264	1	.BREAKFAST ROOM: UPGRADE EXTERIOR GARDEN DOOR ASSEMBLY TO 96" TALL
25Aug20 NoCat		



PV - 112 Cabinetry Schedule

ROOM	DESCRIPTION	PRICE	QTY	TOTAL
KITCHEN	DELETE UPPERS (See attached kitchen plan.)		1	\$
	LEAVE // SPACE FOR FUTURE HOODFAN		1	\$
	RETURN TRIP FOR HARDWOOD IN KITCHEN		1	\$
	ADJUST BASE CABINETY FOR 42" RANGE		1	\$
	RELOCATE STANDARD BANK OF DRAWERS TO ISLAND		1	\$
	ADD VALANCE FOR UNDERCABINET LIGHTING - FLAT/STRAIGHT PANEL		1	\$
	STANDARD STRAIGHT SHAKER CROWN		1	\$
	CABINETY TOTAL:			\$

LOT #:
PV-112

DATE:
Sept- 21, 2021

SIGNATURE:
PDM

SIGNATURE:
du

Scheduled Closing Date: December 17, 2020

Purchasers: PAUL DIMARTINO & LUCY DIMARTINO
Telephone Res. / Bus: /
Decor Advisor: Yolande Somerville
Property: 112 of Plan -
Project: Pine Valley Forevergreen - Phase 1
Model and Elevation: 50.01 A HILLSBOROUGH

Layout Changes: Yes No Sketch Attached: Yes No Exterior Colour Scheme:

1. Cabinetry

Table with 4 columns: Room, Style and Colour, Counter, Hardware. Rows include Kitchen / Breakfast, Laundry Room, Powder Room, Mud Room, Master Ensuite Bathroom, Second Ensuite Bathroom, and Shared Ensuite.

Comment

Kitchen Cab Perimeter: Bowery 'White' + Island: Tribecca 'Timber' / Ensuite 4 Cab: Tribecca 'Timber' + Counter: Quartz: 'Nordic Loft'

2. Floor Tile

Table with 2 columns: Room, Selection. Rows include Entrance Vestibule, Main Hall, Kitchen / Breakfast, Laundry Room, Powder Room, Mud Room, Master Ensuite Bathroom, Second Ensuite Bathroom, Lower Landing, and Shared Ensuite.

Comment

Ensuite 4 Floor: 13x13" Costa 'White' / Master Ensuite Shower Floor: 2x2" Standard 'White' / Shared Ensuite Shower Floor: 2x2" Standard 'White'

3. Wall Tile

Table with 4 columns: Room, Selection, Listello/Inserts, Describe. Rows include Ensuite 4, Master Ensuite Bathroom (Tub Deck, Shower Stall, Bathroom Walls), Second Ensuite Bathroom, Shared Ensuite, and Kitchen Backsplash.

Comment

Handwritten signatures and initials at the bottom of the page.

Scheduled Closing Date: December 17, 2020

Purchasers: PAUL DIMARTINO & LUCY DIMARTINO

Property: 112 of Plan -

Telephone Res. / Bus: /

Project: Pine Valley Forevergreen - Phase 1

Decor Advisor: Yolande Somerville

Model and Elevation: 50.01 A HILLSBOROUGH

4. Plumbing Fixtures

Master Ensuite Bathroom Second Ensuite Powder Room
Other Room - Specify Other Washroom

Comment

see extras.

5. Hardwood Flooring

Main Hall Kitchen / Breakfast Living Room Dining Room Family Room Den/Library Entrance Vestibule Lower Landing (If Applicable)
Type and Stain
Upper Landing Upper Hall Master Bedroom Bedroom #2 Bedroom #3 Bedroom #4 Bedroom #5
Other Room - Specify thru out standard areas

Comment

6. Carpeting

Ground Floor Second Floor
Upgrade Description

Upgrade Underpad Type Area
Carpet on Stairs Capped Runner - \*Upgrade

Comment

7. Fireplace

Living Room Family Room Other Room - Specify
Purchased As Per Plan N/A
Fireplace Type Mantle Type Colour / Stain Surround Hearth

Comment



Scheduled Closing Date: December 17, 2020

Purchasers: PAUL DIMARTINO &amp; LUCY DIMARTINO

Property: 112 of Plan -

Telephone Res. / Bus: /

Project: Pine Valley Forevergreen - Phase 1

Decor Advisor: Yolande Somerville

Model and Elevation: 50.01 A HILLSBOROUGH

## 8. Trim Carpentry

Interior Doors Carrara Front Door Glass Inserts Standard Door Handles Standard

Interior Trim Standard - 50'

Comment

## 9. Plaster Mouldings and Medallions

Standard Throughout ☐ Yes ☐ No ☐ N/A

Entrance Vestibule Kitchen/Breakfast

Main Hall Den/Library

Living Room Lower Landing

Dining Room Other Room - Specify

Family Room

Comment

## 10. Railings and Spindles

Railing Package \*Package A-2

Railing Colour \*Mirage 'Graphite' Spindle Colour \*Mirage 'Graphite'

Stringer / Riser \*Mirage 'Graphite' Treads \*Mirage 'Graphite'

Comment Oak Stairs ☒ Yes ☐ No ☐ N/A

## 11. Wall Paint / Ceilings

Throughout Finished Areas Warm Grey

Trim Paint White

Smooth Ceilings

Ground Floor ☒Second Floor ☒

Note

Comment

Scheduled Closing Date: December 17, 2020

Purchasers: PAUL DIMARTINO & LUCY DIMARTINO

Property: 112 of Plan -

Telephone Res. / Bus: /

Project: Pine Valley Forevergreen - Phase 1

Decor Advisor: Yolande Somerville

Model and Elevation: 50.01 A HILLSBOROUGH

12. Electrical

Hood Fan ☐ White ☐ Stainless ☒ N/A

Above Kitchen Cabinet Light ☐ Yes ☒ No

Below Kitchen Cabinet Light ☒ Yes ☐ No

Standard Appliances ☐

Over The Range Microwave ☐

Chimney Style Fan ☐

Comment

13. Heating and Air Conditioning

Air Conditioning

Gas Provisions Stove

Gas Provisions Dryer

Gas Provisions Barbecue

Comment

14. Additional Comments

15. Disclaimers and Notes


- 1) Colours of all materials are as close as possible to builder's selection, but not necessarily identical due to variances in manufacturing.
- 2) Any extras listed above are null and void unless accompanied by a separate invoice/amendment. Said invoice must be paid in full.
- 3) The Purchaser acknowledges that after Interior Colour Selection form is signed and dated, no further changes will be permitted other than re-selection due to unavailability. ☒ Purchaser's Initials
- 4) The Purchaser acknowledges reading and accepting the "Gold Park Homes Decor Centre Disclaimers" form. This document contains other miscellaneous disclaimers.

This Interior Colour Selection is final and approved by:

Signature:  Date: Sept. 21, 2021



PV-112  
Sept. 21, 2021  
POM  
JL

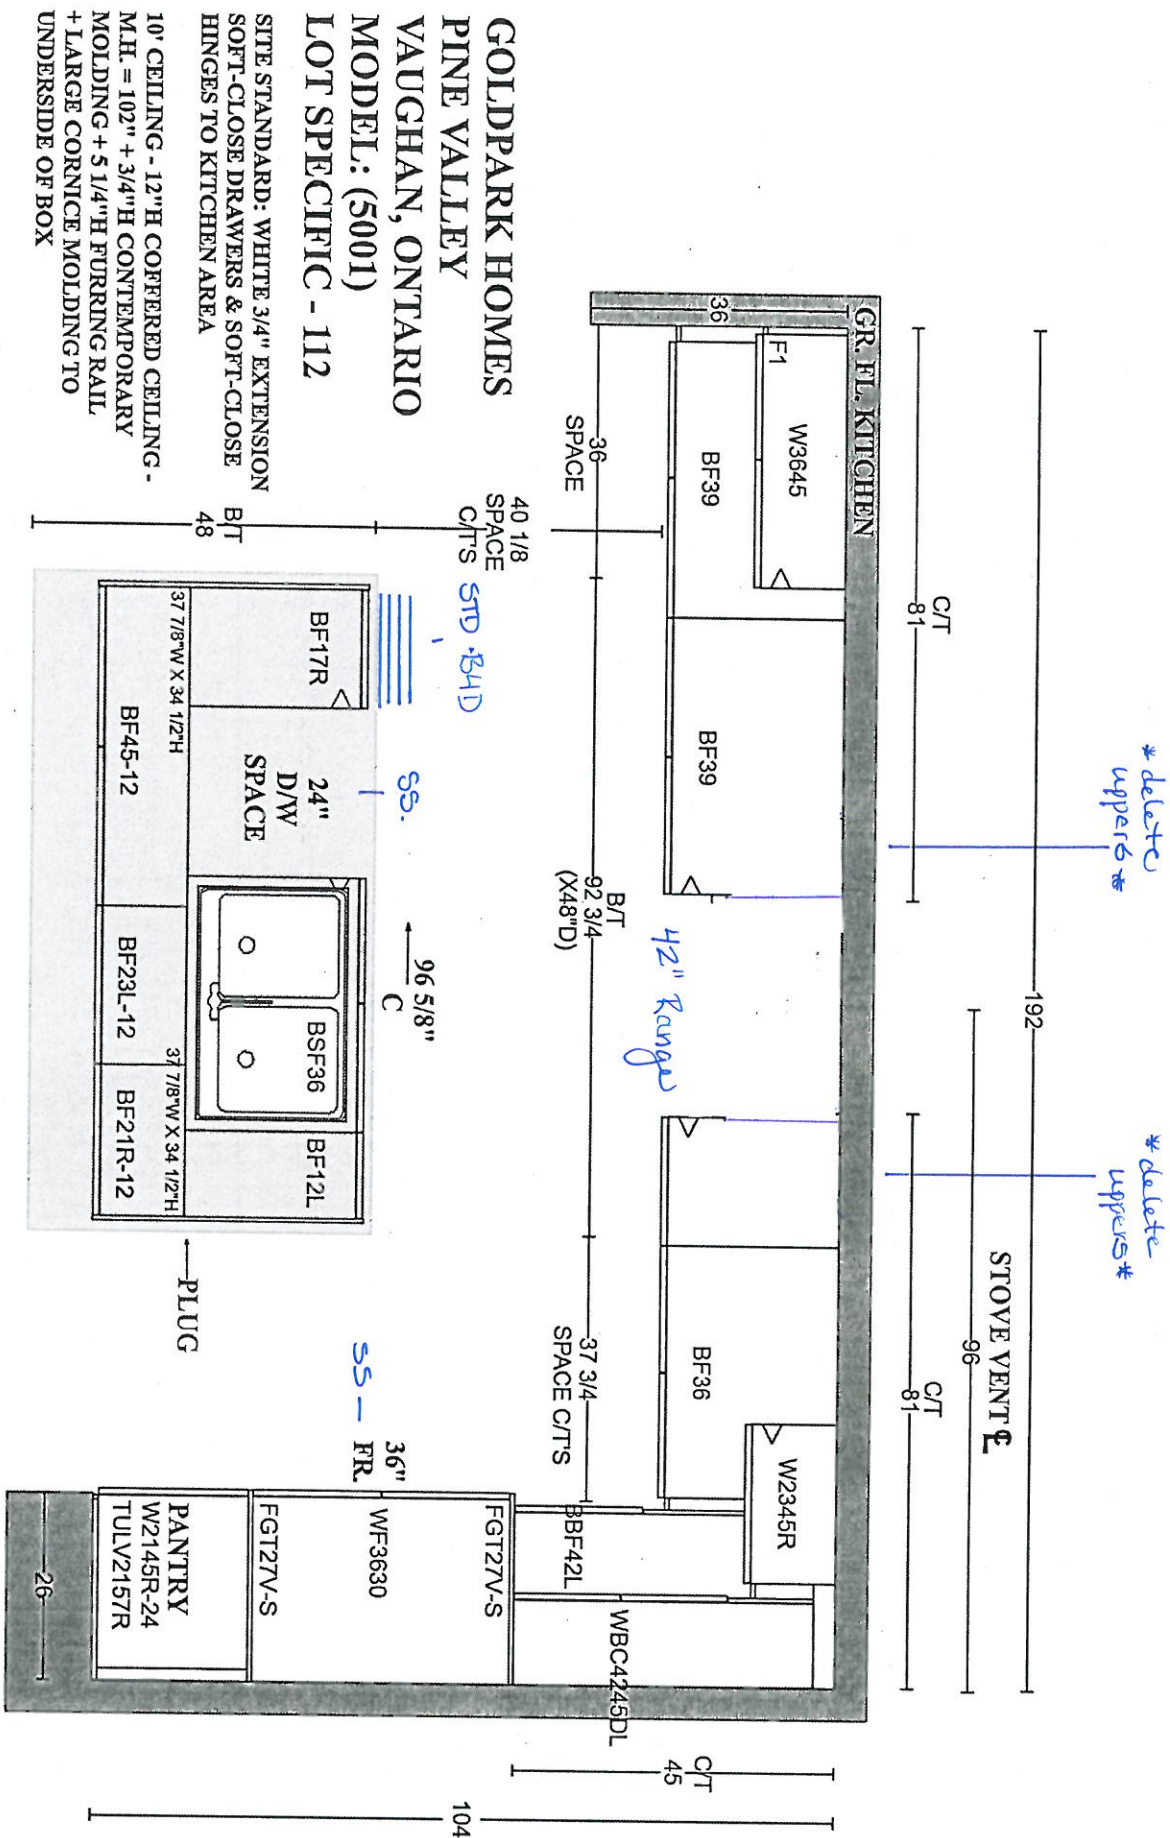

GOLDPARK HOMES  
PINE VALLEY  
VAUGHAN, ONTARIO  
MODEL: (5001)  
LOT SPECIFIC - 112

SITE STANDARD: WHITE 3/4" EXTENSION  
SOFT-CLOSE DRAWERS & SOFT-CLOSE  
HINGES TO KITCHEN AREA

10' CEILING - 12"H COFFERED CEILING -  
M.H. = 102" + 3/4"H CONTEMPORARY  
MOLDING + 5 1/4"H FURRING RAIL  
+ LARGE CORNICE MOLDING TO  
UNDERSIDE OF BOX








RV-112  
Sept. 21, 2021  
PDM  
[Signature]

GOLDPARK HOMES  
PINE VALLEY  
VAUGHAN, ONTARIO  
MODEL: (5001)  
LOT SPECIFIC - 112

SITE STANDARD: WHITE 3/4" EXTENSION  
SOFT-CLOSE DRAWERS & STANDARD SLAM DOOR HINGES  
TO VANITIES

ONE TOP DRAWER WHERE POSSIBLE THROUGHOUT EACH  
VANITY, ONE BANK OF DRAWERS WHERE POSSIBLE  
THROUGHOUT EACH MASTER ENSUITE VANITY

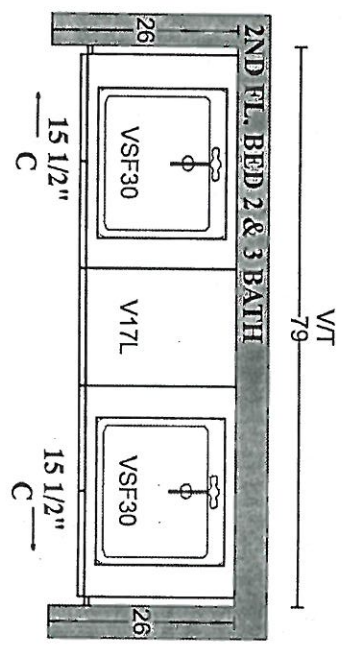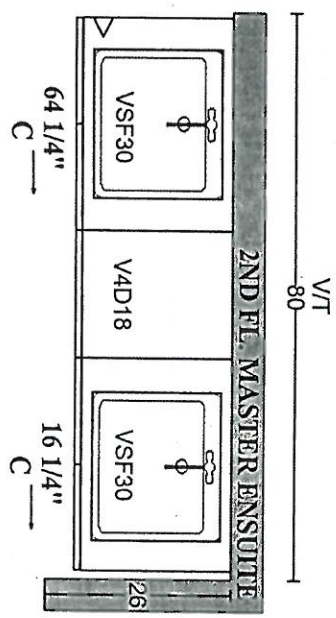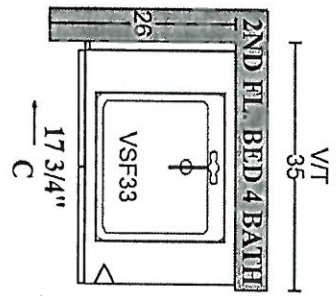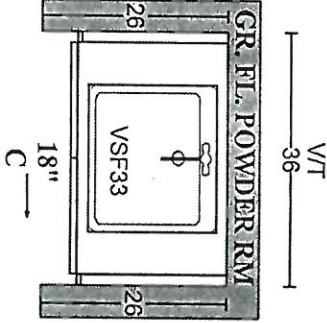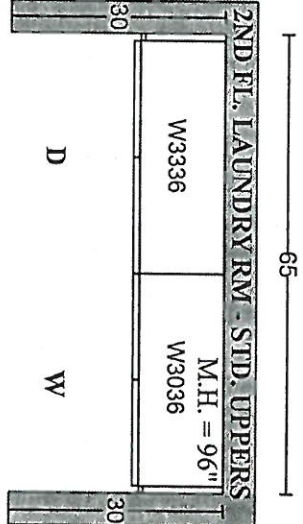


SCHEDULE 'F'



PV-112.  
JUNE 13 2020  
PV-112  
Sept. 21, 2021 ~~PDM~~ ~~del~~

Lot 112  
50' SERIES  
Elevation A • 3,225 sq.ft.

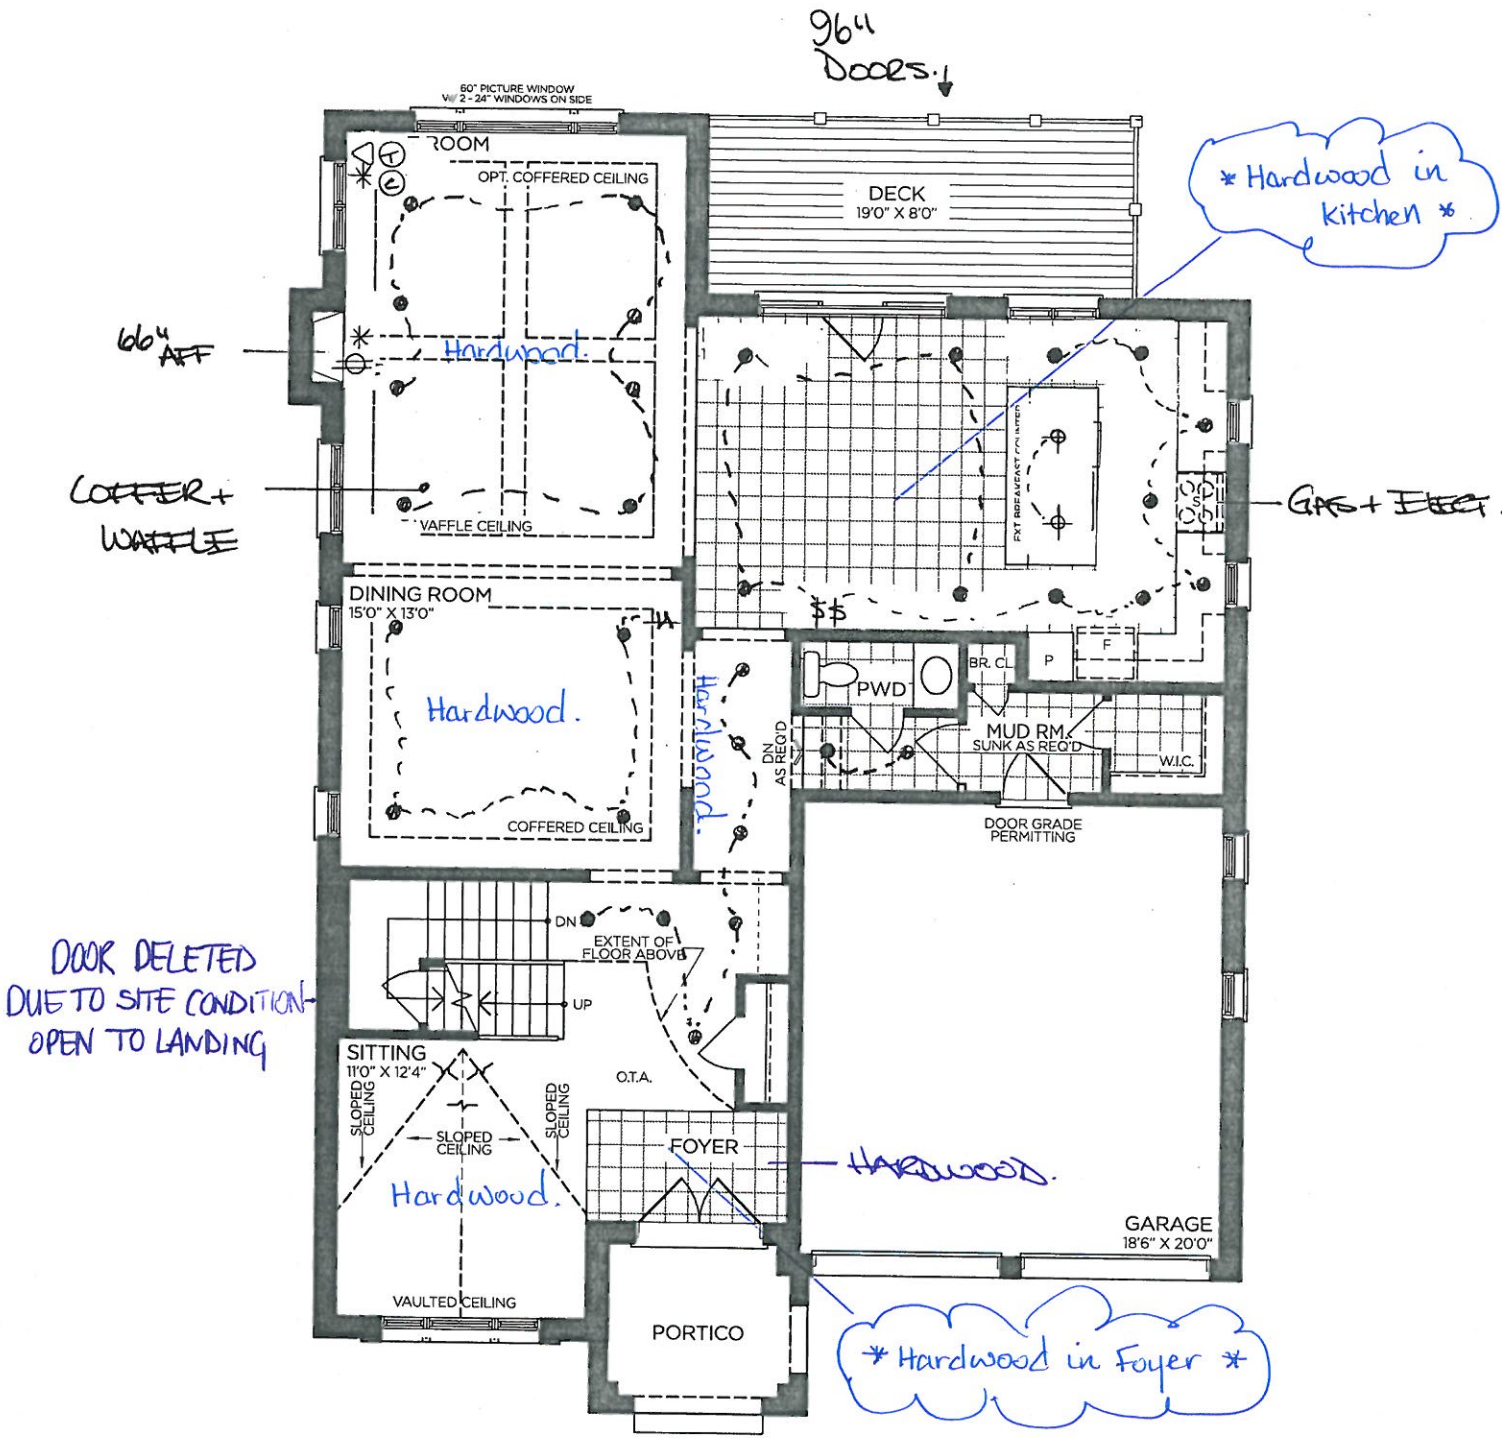

GROUND FLOOR | ELEV. A

VENDOR

PURCHASER

PURCHASER

GOLDPARK  
WORTH MORE™

Prices, figures, illustrations, sizes, features and finishes are subject to change without notice. Areas and dimensions are approximate and actual usable floor space may vary from the stated area. Layout may be reverse of the unit purchased. E. & O.E. 5001



SCHEDULE 'F'



PN-112.

JUNE 13 2020

PN-112

Sept. 21, 2021

~~PN-112~~


Lot 112

50' SERIES

Elevation A • 3,225 sq.ft.

8' doors  
on 2nd Floor

SQUARE  
TEXT  
CEILING!

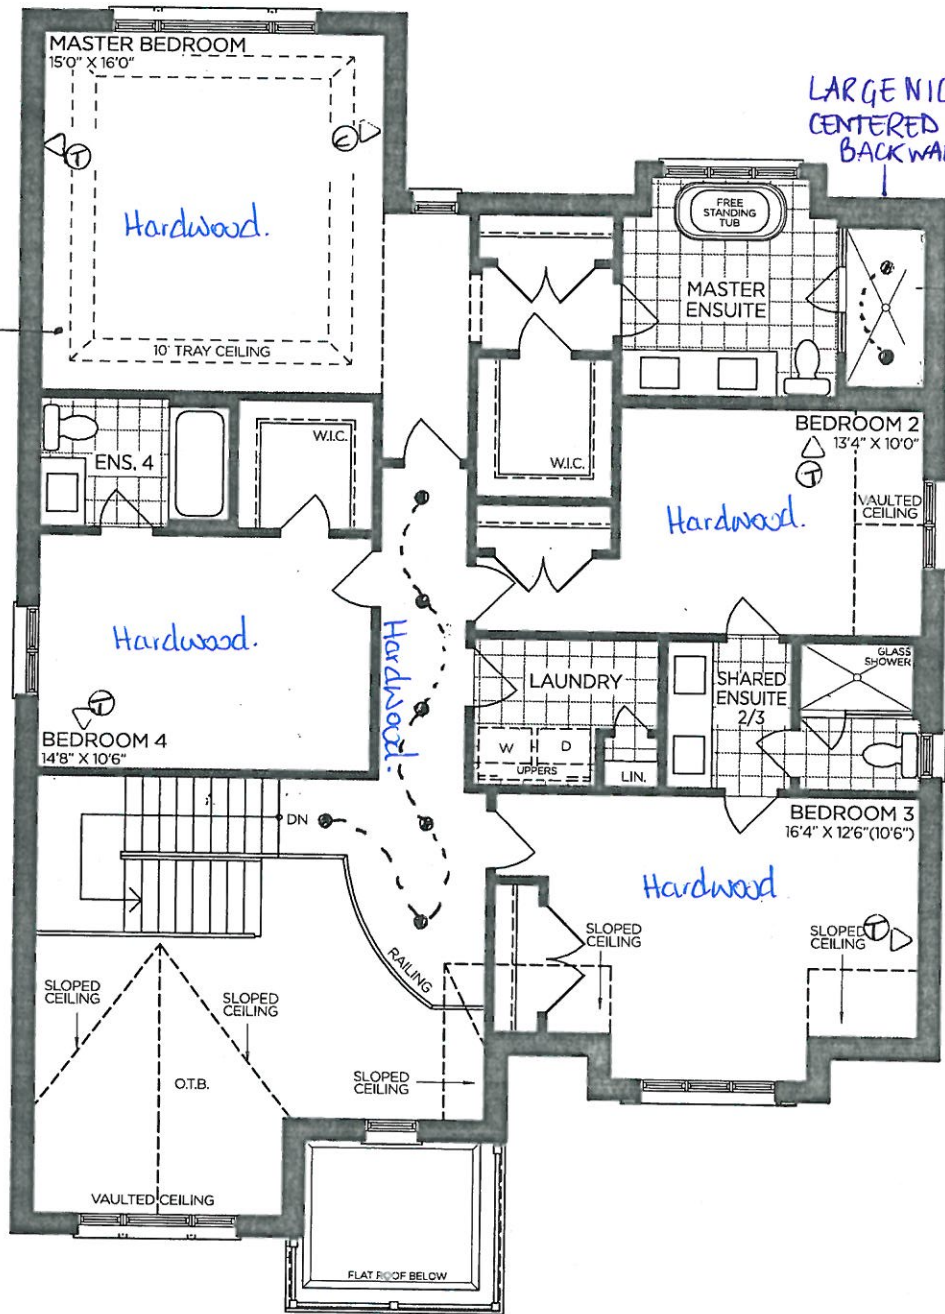

LARGE NICHE  
CENTERED ON  
BACK WALL

Rain shower.

SECOND FLOOR | ELEV. A

VENDOR

PURCHASER

PURCHASER

GOLDPARK  
WORTH MORE™

Prices, figures, illustrations, sizes, features and finishes are subject to change without notice. Areas and dimensions are approximate and actual usable floor space may vary from the stated area. Layout may be reverse of the unit purchased. E. & O.E. 5001

SCHEDULE 'F'




PV-112  
JUNE 13 2020

PV-112  
Sept. 21, 2021

~~PM~~

Lot 112  
50' SERIES

Elevation A • 3,225 sq.ft.

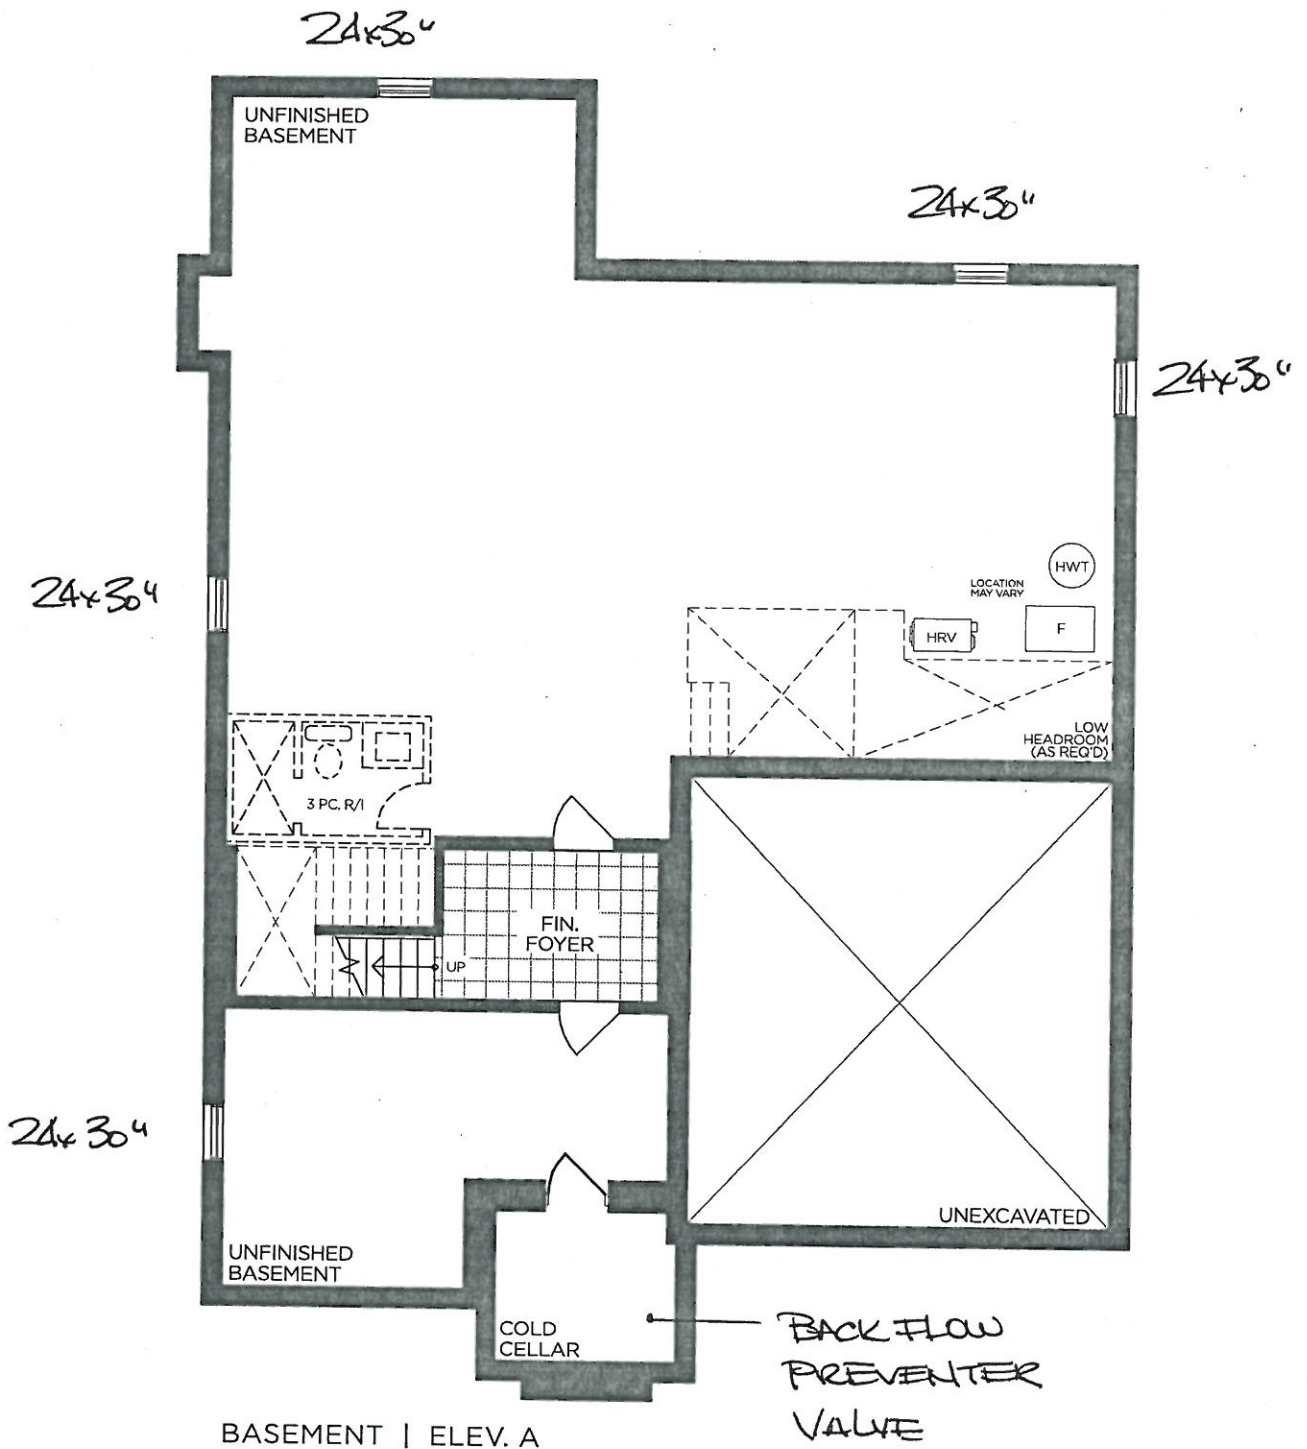

VENDOR

PURCHASER

PURCHASER

GOLDPARK  
WORTH MORE™

Prices, figures, illustrations, sizes, features and finishes are subject to change without notice. Areas and dimensions are approximate and actual usable floor space may vary from the stated area. Layout may be reverse of the unit purchased. E. & O.E. 5001

SCHEDULE 'F'



Lot 112  
50' SERIES

Elevation A • 3,225 sq.ft.



VENDOR

PURCHASER

PURCHASER

GOLDPARK  
WORTH MORE™


Prices, figures, illustrations, sizes, features and finishes are subject to change without notice. Areas and dimensions are approximate and actual usable floor space may vary from the stated area. Layout may be reverse of the unit purchased. E. & O.E. 5001

SCHEDULE 'F'



Lot 112  
50' SERIES

Elevation A • 3,225 sq.ft.

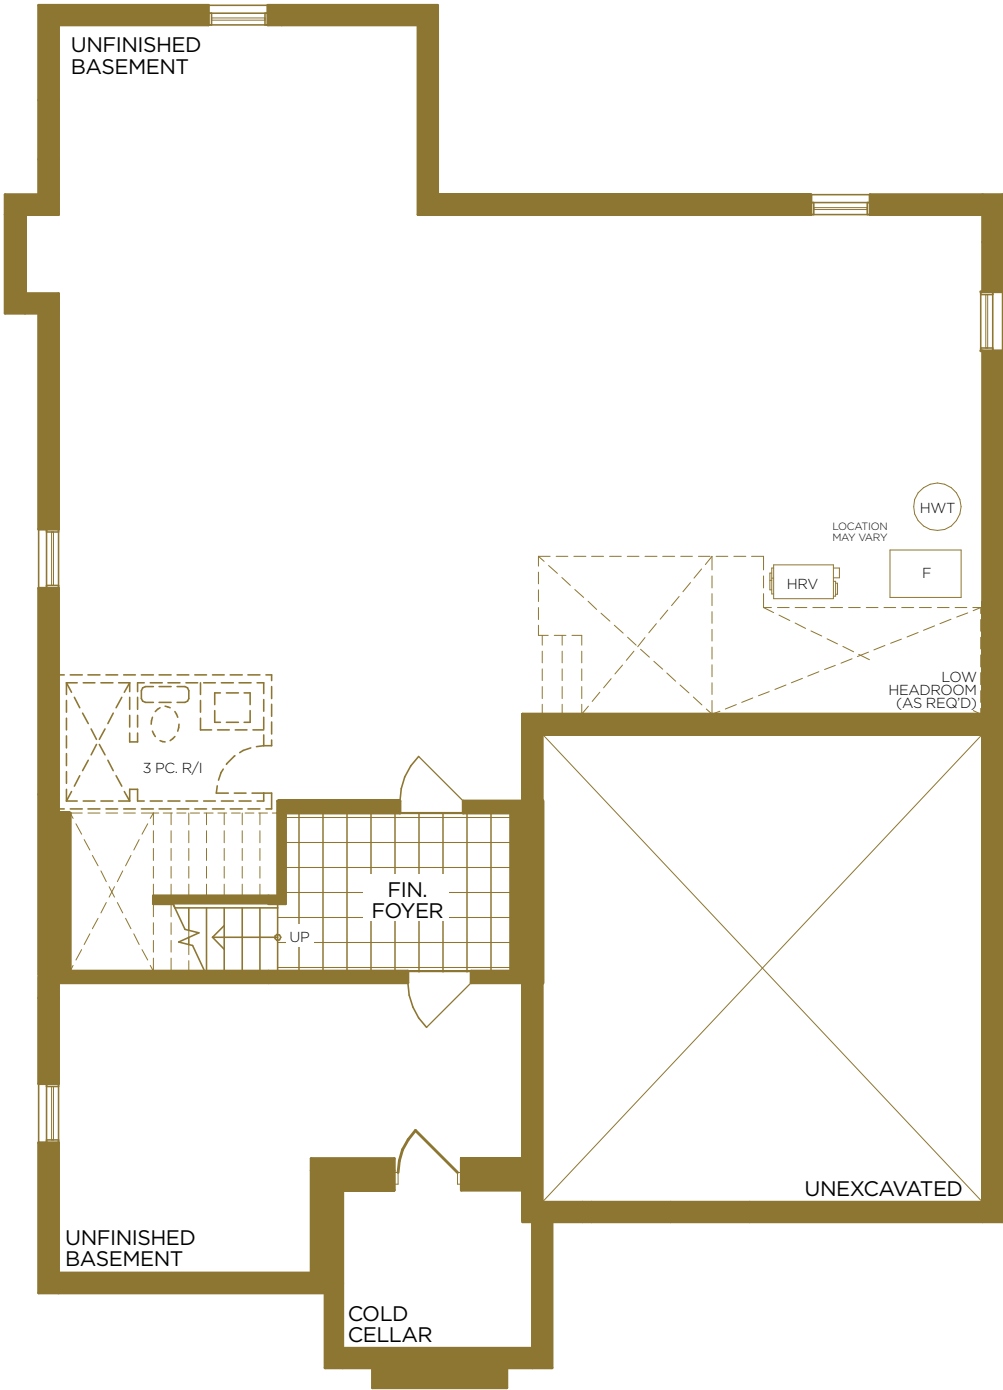

BASEMENT | ELEV. A

VENDOR

PURCHASER

PURCHASER



Prices, figures, illustrations, sizes, features and finishes are subject to change without notice. Areas and dimensions are approximate and actual usable floor space may vary from the stated area. Layout may be reverse of the unit purchased. E. & O.E. 5001

SCHEDULE 'F'




Lot 112  
50' SERIES

Elevation A • 3,225 sq.ft.

SEPT 8, 2021  
SEE CHANGES DUE TO SITE  
CONDITIONS NOTED BELOW

DUE TO SITE CONDITION:  
DOOR DELETED  
FULL OPENING TO  
LANDING

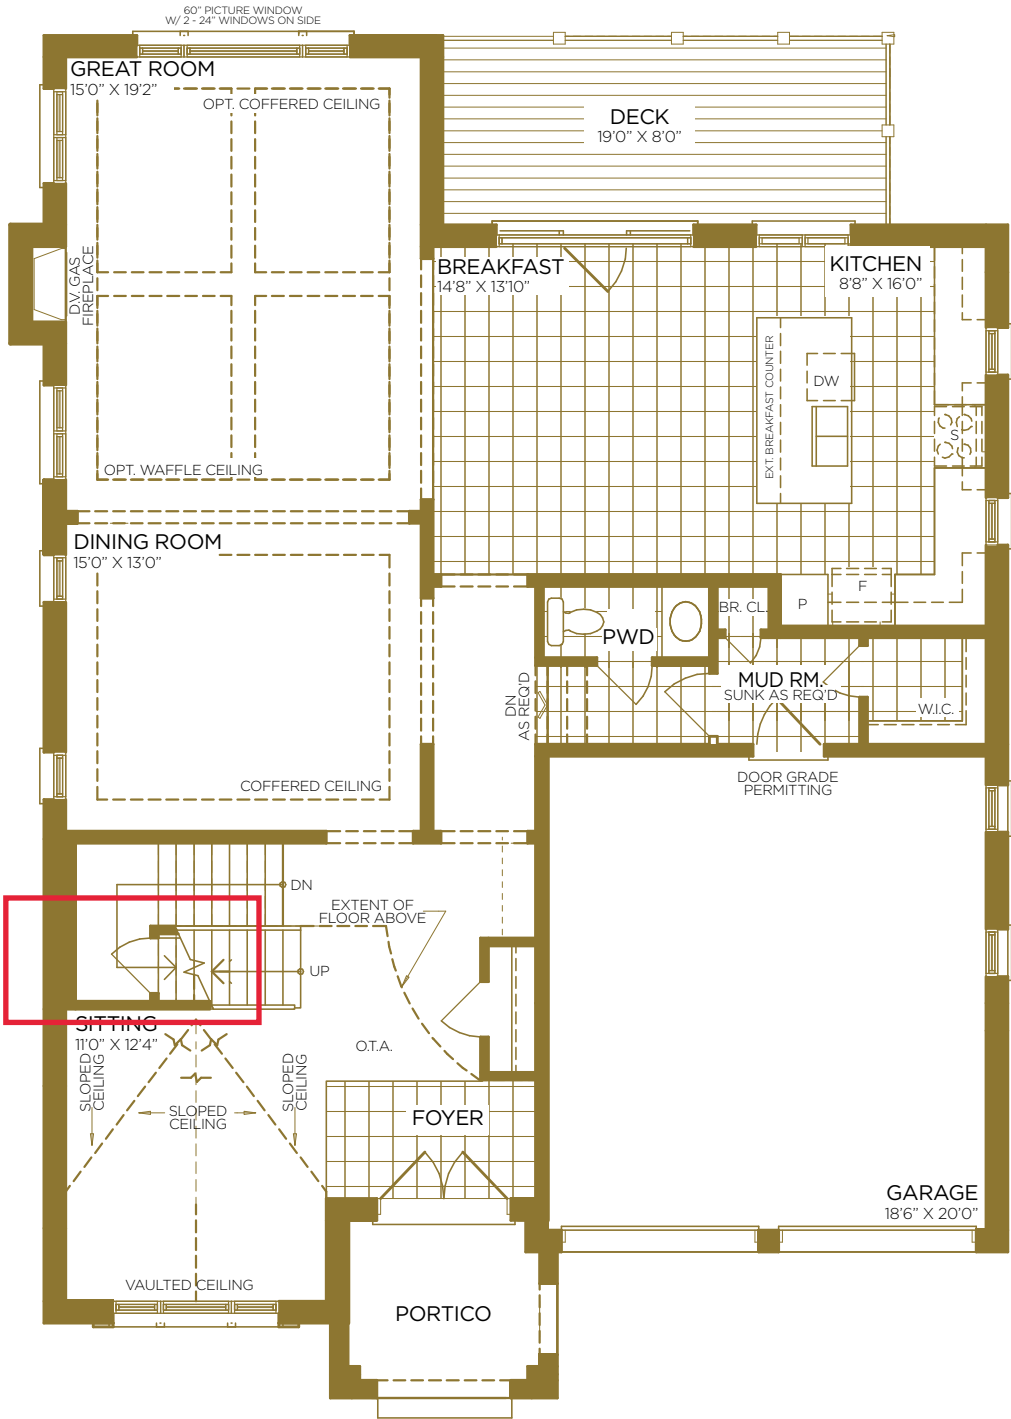

GROUND FLOOR | ELEV. A

VENDOR

PURCHASER

PURCHASER

GOLDPARK  
WORTH MORE™


Prices, figures, illustrations, sizes, features and finishes are subject to change without notice. Areas and dimensions are approximate and actual usable floor space may vary from the stated area. Layout may be reverse of the unit purchased. E. & O.E. 5001

SCHEDULE 'F'



Lot 112  
50' SERIES

Elevation A • 3,225 sq.ft.

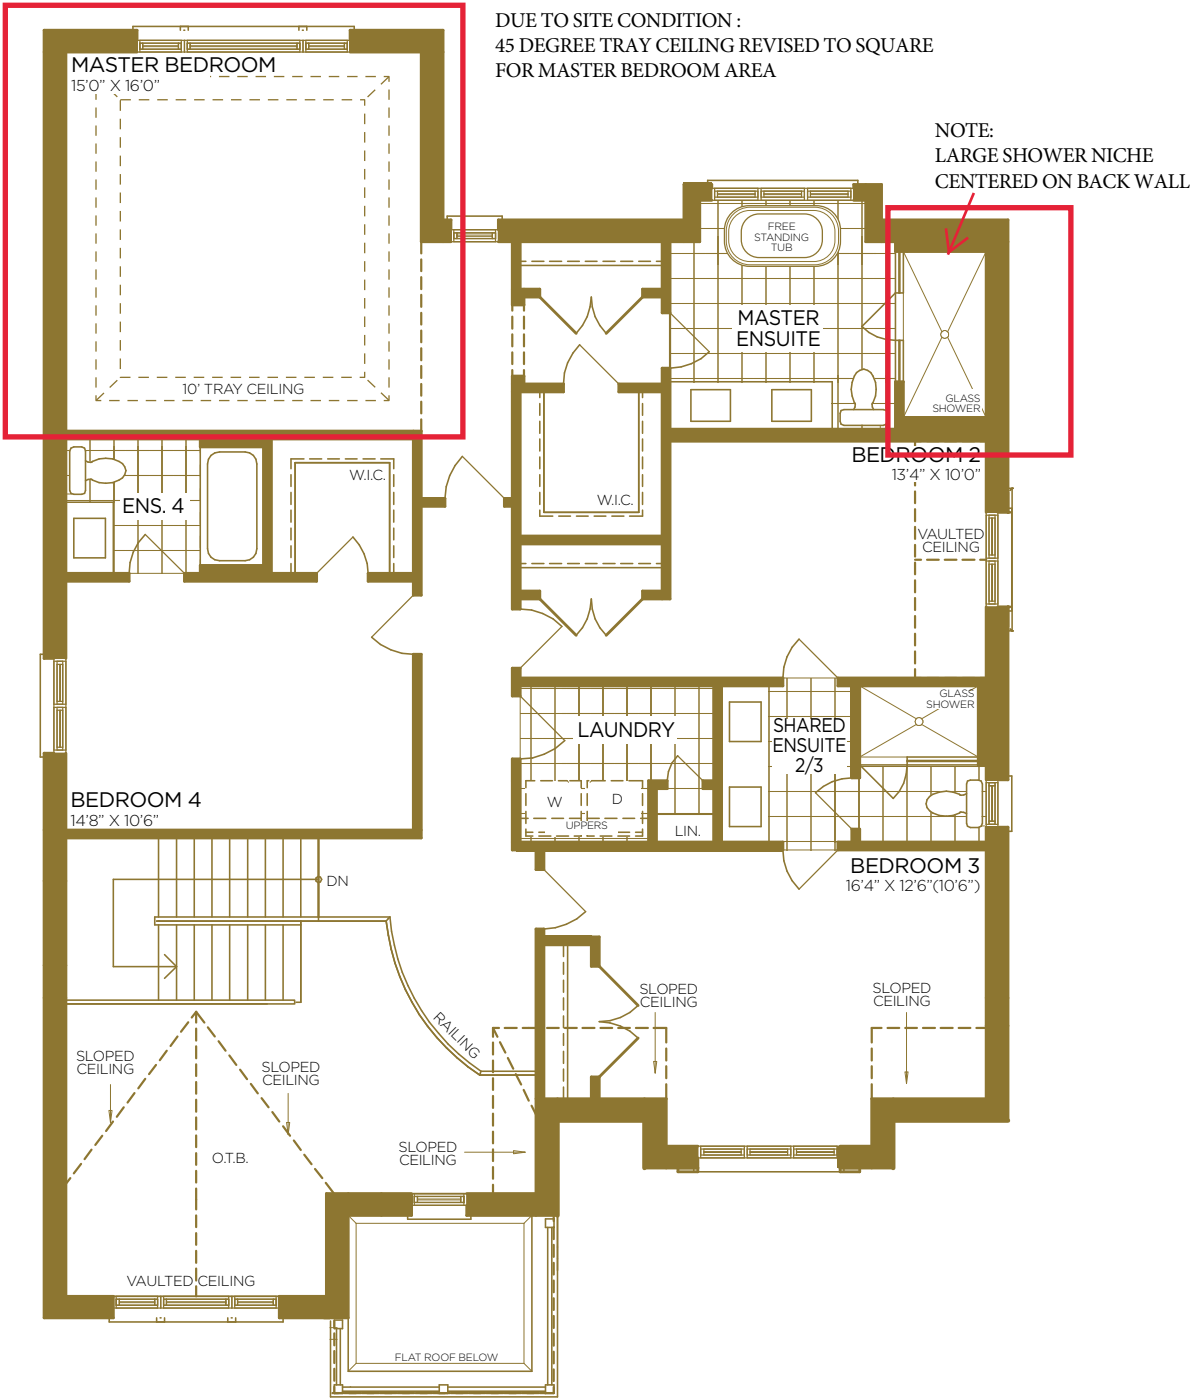

SECOND FLOOR | ELEV. A

VENDOR

PURCHASER

PURCHASER

GOLDPARK  
WORTH MORE™


Prices, figures, illustrations, sizes, features and finishes are subject to change without notice. Areas and dimensions are approximate and actual usable floor space may vary from the stated area. Layout may be reverse of the unit purchased. E. & O.E. 5001





PINE VALLEY  
FOREVERGREEN


STONE COUNTERTOP EDGE PROFILES

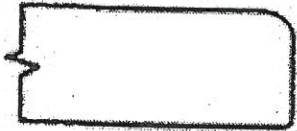

STANDARD 2CM EASED EDGE


LOCATION:

\* thru-out \*

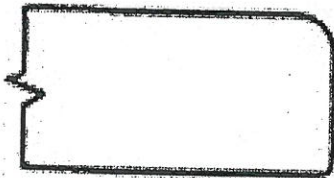


UPGRADE 3CM EASED EDGE


LOCATION:

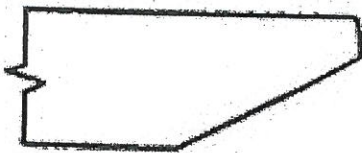

UPGRADE 4CM MITRED EDGE

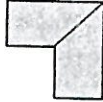

LOCATION:

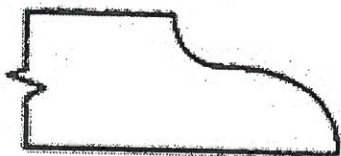

UPGRADE 2CM OGEE EDGE

LOCATION:

LOT #: PV-112

DATE: Sept. 21, 2021

SIGNATURE: PDM

SIGNATURE: [Signature]



PINE VALLEY  
FOREVERGREEN

## STANDARD HARDWARE / HANDLES

☐

H001-02

☐

H001-03

☐

H001-04

☐

H009-03

☐

H009-09

☐

TOUCH-LATCH

☐


H011-03

☐

H011-05

☐

H011-06

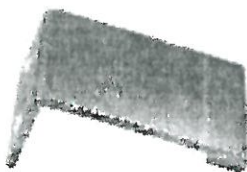☐

H033-01

☐

H039-03

☒

*\*NO HARDWARE  
\*thru-out\**

\*DISCLAIMER: NO HARDWARE OR HOLES THRU-OUT: HOMEOWNER IS RESPONSIBLE FOR THE INSTALLATION OF THEIR OWN HARDWARE AFTER CLOSING AT THEIR OWN EXPENSE AND WARRANTY.

LOT #

*PV-112*

DATE:

*Sept. 21, 2021*

SIGNATURE:

*PDM*

SIGNATURE:

*[Signature]*

GOLDPARK  
WORTH MORE





UPGRADE KITCHEN EXTRA

MOEN - MODERN

Pot Filler



- ☐ CHROME
- ☐ STAINLESS (SRS)
- ☐ BRUSHED GOLD (BG)
- ☒ MATTE BLACK (BL)

MODEL: S665 (SRS, BG, BL) Pot Filler

Lot# PR-112	Date: Sept. 21, 2021	Room: kitchen
Signature:		
Signature:		




PINE VALLEY  
FOREVERGREEN

## UPGRADE SHOWER HARDWARE

SQ6X6

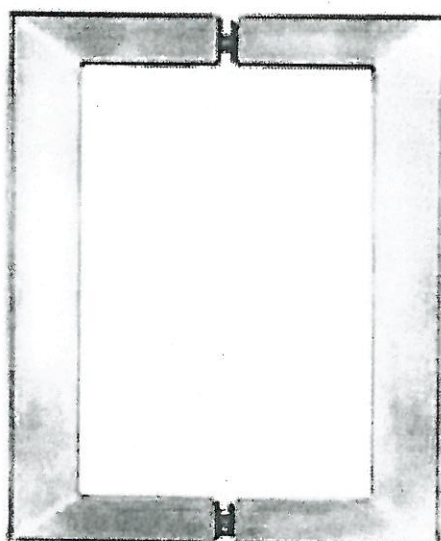

Shower Door Handle




SQ6X6  
Shower Door Handle

6" x 6" back-to-back  
3/4" square tube


☒ CHROME  
☐ MATTE BLACK

Lot# PV-112	Date: Sept. 21, 2021	Room: Master Ensuite + Shared Ensuite
Signature: 		
Signature: 		

## BATHROOM ACCESSORIES

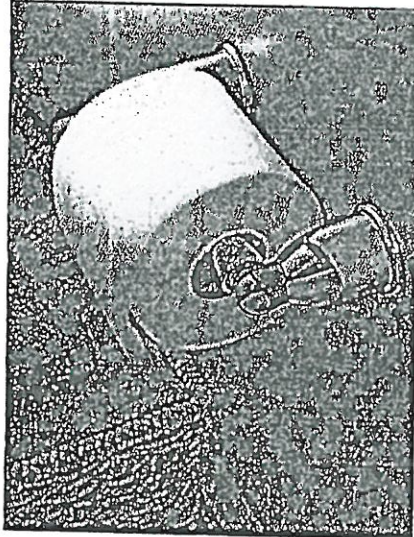

Tissue Holder  
Mason - Chrome

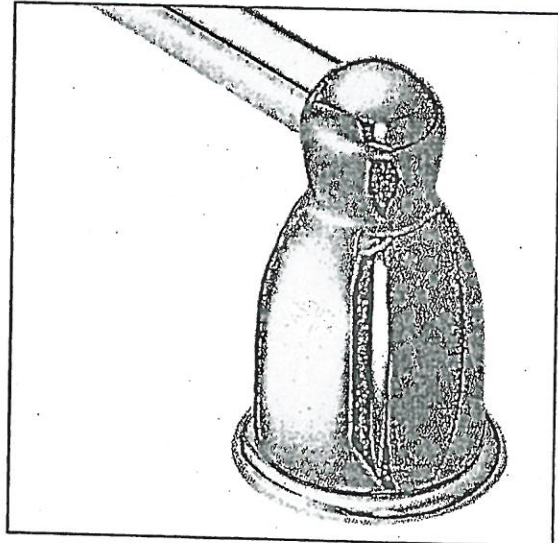

Towel Bar  
Mason - Chrome

Please select one of the following:

☒ INSTALL STANDARD BATHROOM ACCESSORIES THRU OUT  
(tissue holder + towel bar) *\*location as per vendors discretion\**

☐ **\*DO NOT\*** INSTALL STANDARD BATHROOM ACCESSORIES  
THRU OUT *\*tissue holder + towel bar will not be provided\**

LOT # PV-112

DATE: Sept. 21, 2021

SIGNATURE: Ppm

SIGNATURE: del






PINE VALLEY  
FOREVERGREEN

## FIREPLACE MANTLE UPGRADE


### CAPRI

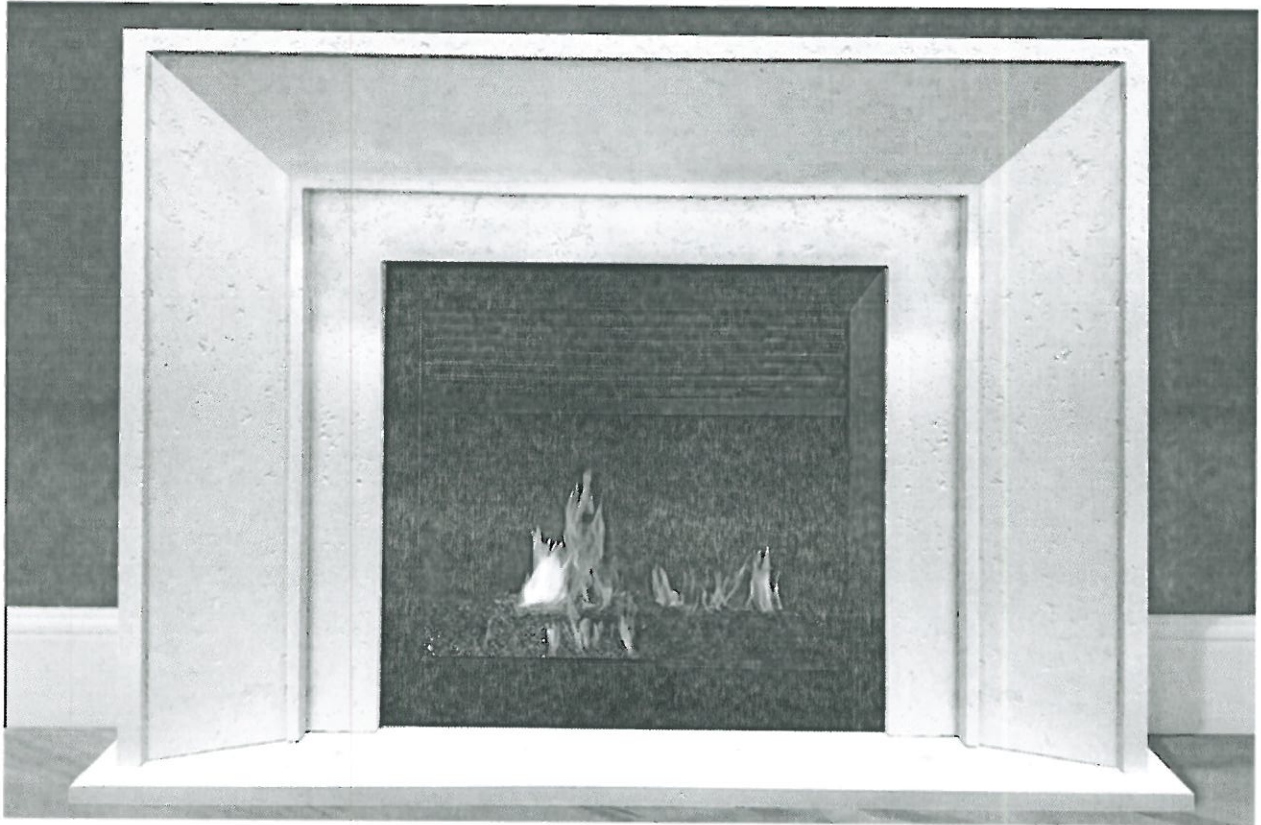

TOP VIEW



SIDE VIEW

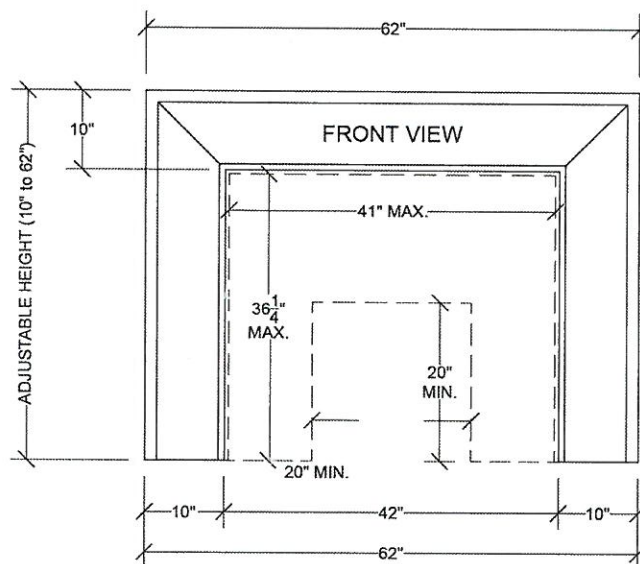

LOT #: PV-112

DATE: Sept. 21, 2021

LOCATION: Great Room

SIGNATURE:

PDM

SIGNATURE:

dy




Project: Pine Valley


Lot: 112

Purchaser(s): Paul Di martino & Silvia Di martino

Standard Hood Fan Deletion

We acknowledge that the builder's standard hood fan will not be installed.  
Do not supply, install and/or credit. We will install our own hood fan after closing.

Signature: 

Signature: 

Date: September 21, 2021

PLUMBING UPGRADES

POSI-TEMP SHOWER ONLY\* W/3 FUNCTION TRANSFER VALVE  
TRIM AND SLIDE BAR W/HAND SHOWER

MOEN - ARRIS



☒ CHROME

☐ BRUSHED NICKEL

☐ MATTE BLACK

☐ from WALL

☒ from CEILING

MODEL TS22002EP / 3372 / TS23005 / 62320 / 3887EP / A725

Lot#  
112

Room:  
MASTER ENSUITE

Signature:

Date:  
JUNE 13 2026

Signature: