



CONSTRUCTION SUMMARY

Lot: 156
Model: 40.01 B SUMMERDALE
Project/Phase: Pine Valley Forevergreen / 1

BASEMENT WINDOWS

Invoice	Qty.	Description
2492 72,351 01Dec20	2	BASEMENT WINDOWS - UPGRADE BASEMENT WINDOW SIZE TO 30 " X 24" - 8" FRAME

CERAMIC

Invoice	Qty.	Description
2599 39 23Feb21	1	FRONT FOYER: TILE, FLOOR , LEVEL 7 - 30X30" LAID IN STRAIGHT, STACKED PATTERN.
2599 37 23Feb21	1	POWDER ROOM: TILE, FLOOR , LEVEL 5 - 12X24" LAID IN STRAIGHT, STACKED PATTERN. SEE PLAN FOR TILE DIRECTION
2599 39 23Feb21	1	KITCHEN: TILE, FLOOR , LEVEL 7 - 30X30" LAID IN STRAIGHT, STACKED PATTERN.
2599 23Feb21 NoCat	1	MASTER ENSUITE: ADD TILE TO SHOWER CEILING (SAME AS WALL TILE - STD LEVEL)
2599 23Feb21 NoCat	1	ENSUITE 2: ADD TILE TO SHOWER CEILING (SAME AS WALL TILE - STD LEVEL)
2599 23Feb21 NoCat	1	MASTER ENSUITE: MOEN 'ALIGN' RAIN SHOWER (from ceiling) + HAND SHOWER/SLIDE BAR - CHROME

CONCRETE AND DRAIN

Invoice	Qty.	Description
2492 01Dec20 NoCat	1	BACK-FLOW PREVENTER VALVE

DRYWALL

Invoice	Qty.	Description
2492 72,351 01Dec20 **	2	BASEMENT WINDOWS - UPGRADE BASEMENT WINDOW SIZE TO 30 " X 24" - 8" FRAME
2492 72,324 01Dec20 **	2	GARAGE DOOR OPENER (CHAMBERLAIN BELT DRIVE) - WITH 1 REMOTE - PRICE IS PER DOOR
2492 01Dec20 ** NoCat	2	GARAGE DOOR OPENER (CHAMBERLAIN BELT DRIVE) - WITH 1 REMOTE - PRICE IS PER DOOR



CONSTRUCTION SUMMARY

Lot: 156
Model: 40.01 B SUMMERDALE
Project/Phase: Pine Valley Forevergreen / 1

ELECTRICAL

Invoice	Qty.	Description
2492 72,351 01Dec20 **	2	BASEMENT WINDOWS - UPGRADE BASEMENT WINDOW SIZE TO 30 " X 24" - 8" FRAME
2492 72,281 01Dec20	1	FAMILY ROOM: INTERIOR WALL OUTLET: ADDITIONAL 110V WALL INTERIOR RECEPTACLE ON EXISTING CIRCUIT FOR WALL MOUNTED TV - LOCATE APPROX 66" A.F.F. ABOVE FIREPLACE
2492 72,289 01Dec20	6	KITCHEN: 4" E/S LED INTERIOR POT LIGHT - GROUND FLOOR - EACH - INCLUDES 1 SWITCH INCLUDED IN APS
2492 72,289 01Dec20	4	BREAKFAST ROOM: 4" E/S LED INTERIOR POT LIGHT - GROUND FLOOR - EACH
2492 72,278 01Dec20	1	BREAKFAST: ADDITIONAL INTERIOR SWITCH FOR POTLIGHTS
2492 72,280 01Dec20	2	KITCHEN: CEILING OUTLET: ADDITIONAL REINFORCED CEILING OUTLET - LOCATE APPROX CENTERED ABOVE ISLAND, USE STANDARD SWITCH
2492 72,289 01Dec20	7	MAIN HALL: 4" E/S LED INTERIOR POT LIGHT - GROUND FLOOR - EACH IN LIEU OF STANDARD LIGHT, USE STANDARD SWITCHES
2492 72,289 01Dec20	6	STUDY: 4" E/S LED INTERIOR POT LIGHT - GROUND FLOOR - EACH IN ADDITION TO STD CEILING LIGHT
2492 72,278 01Dec20	1	STUDY: ADDITIONAL INTERIOR SWITCH FOR POTLIGHTS
2492 72,289 01Dec20	8	FAMILY ROOM: 4" E/S LED INTERIOR POT LIGHT - GROUND FLOOR - EACH IN ADDITION TO STANDARD CEILING LIGHT
2492 72,278 01Dec20	1	FAMILY ROOM: ADDITIONAL INTERIOR SWITCH FOR POTLIGHTS
2492 72,273 01Dec20	1	KITCHEN: 110V WALL RECEPTACLE ON SEPARATE CIRCUIT - GAS FIRED APPLIANCE - FOR AUX. EQUIPMENT - NOT A STOVE PLUG
2492 72,290 01Dec20	7	UPPER HALL+COMPUTER NICHE: 4" E/S LED INTERIOR POT LIGHT (INSULATED CEILING) - SECOND FLOOR - EACH IN LIEU OF STANDARD CEILING LIGHTS, USE STANDARD SWITCHES



CONSTRUCTION SUMMARY

Lot: 156
Model: 40.01 B SUMMERDALE
Project/Phase: Pine Valley Forevergreen / 1

ELECTRICAL

Invoice	Qty.	Description
2492 72,280 01Dec20	1	COMPUTER NICHE: CEILING OUTLET: ADDITIONAL REINFORCED CEILING OUTLET - SEE PLAN FOR APPROX LOCATION
2492 72,278 01Dec20	1	COMPUTER NICHE: ADDITIONAL INTERIOR SWITCH FOR LIGHT IN LOFT
2492 01Dec20 NoCat	1	BREAKFAST: UPGRADE EXTERIOR GARDEN DOOR ASSEMBLY TO 96"

FRAMING

Invoice	Qty.	Description
2492 01Dec20 NoCat	1	BREAKFAST: UPGRADE EXTERIOR GARDEN DOOR ASSEMBLY TO 96"
2599 23Feb21 NoCat	1	MASTER ENSUITE: MOEN 'ALIGN' RAIN SHOWER (from ceiling) + HAND SHOWER/SLIDE BAR - CHROME

GARAGE DOORS

Invoice	Qty.	Description
2492 72,324 01Dec20	2	GARAGE DOOR OPENER (CHAMBERLAIN BELT DRIVE) - WITH 1 REMOTE - PRICE IS PER DOOR
2492 72,323 01Dec20	1	GARAGE: WIRELESS KEYPAD GARAGE DOOR ENTRY 877LM
2492 01Dec20 ** NoCat	2	GARAGE DOOR OPENER (CHAMBERLAIN BELT DRIVE) - WITH 1 REMOTE - PRICE IS PER DOOR

GLASS AND MIRROR

Invoice	Qty.	Description
2599 23Feb21 NoCat	2	MASTER ENSUITE + ENSUITE 2: UPGRADE SHOWER DOOR HARDWARE - MT6X6 CHROME



CONSTRUCTION SUMMARY

Lot: 156
Model: 40.01 B SUMMERDALE
Project/Phase: Pine Valley Forevergreen / 1

GRANITE MARBLE QUARTZ

Invoice	Qty.	Description
2599	1	KITCHEN: FULL HEIGHT SLAB BACKSPLASH - STANDARD LEVEL GRANITE
23Feb21 NoCat		

HARDWOOD

Invoice	Qty.	Description
2599 7 23Feb21	1	THRU OUT STANDARD AREAS: MAIN HALL/ FAMILY/ STUDY/ DINING/ UPPER HALL/ COMPUTER NICHE/ MASTER BEDROOM/ BEDROOM 2/ BEDROOM 3/ BEDROOM 4: VINTAGE SERIES, 5" WHITE OAK, NSS ENGINEERED HARDWOOD, 3/4" THK, SCULPTED TEXTURE, UVF FINISH - LEVEL 4

HVAC

Invoice	Qty.	Description
2492 72,224 01Dec20	1	KITCHEN: GAS LINE ROUGH-IN - MAIN FLOOR FOR APPLIANCE - RANGE
2492 72,247 01Dec20	1	HUMIDIFER - LENNOX MODEL WB3-17 (2000 UP TO 3000 SQ.FT.)
2492 72,215 01Dec20	1	FURNACE - LENNOX 2 STAGE VARIABLE SPEED FURNACE (90,000 TO 110,000 BTU FOOT S) IN LIEU OF STANDARD OFFERING - (PINE VALLEY SITE ONLY - REFERENCE MODEL SPECIFIC FOR FURANCE UPGRADE EXTRA)
2492 72,238 01Dec20	1	3.5 TON AC - WITH LOW VOLTAGE WIRING & WALL BRACKETS (13ACX)
2492 01Dec20 ** NoCat	1	HUMIDIFER - LENNOX MODEL WB3-17 (2000 UP TO 3000 SQ.FT.)
2492 01Dec20 ** NoCat	1	FURNACE - LENNOX 2 STAGE VARIABLE SPEED FURNACE (90,000 TO 110,000 BTU FOOT S) IN LIEU OF STANDARD OFFERING - (PINE VALLEY SITE ONLY - REFERENCE MODEL SPECIFIC FOR FURANCE UPGRADE EXTRA)
2492 01Dec20 **	1	3.5 TON AC - WITH LOW VOLTAGE WIRING & WALL BRACKETS (13ACX)



CONSTRUCTION SUMMARY

Lot: 156
Model: 40.01 B SUMMERDALE
Project/Phase: Pine Valley Forevergreen / 1

MASONRY

Invoice	Qty.	Description
2492 01Dec20 NoCat	1	BREAKFAST: UPGRADE EXTERIOR GARDEN DOOR ASSEMBLY TO 96"

NETWORK AND WIRING

Invoice	Qty.	Description
2492 72,259 01Dec20	1	FAMILY ROOM: CONDUIT PIPE - FOR WALL MOUNT TV - LOCATE APPROX 66" A.F.F. ABOVE FIREPLACE, THRU BASEMENT, TERMINATING AT CABLE LOCATION. SEE PLAN FOR LOCATION
2492 72,258 01Dec20	2	FAMILY ROOM + COMPUTER STUDY: ADDITIONAL CAT6 ETHERNET OUTLET - EACH SEE PLAN FOR LOCATION
2492 72,264 01Dec20	1	LAUNDRY: ROUGH - IN FOR EXTRA SECURITY KEY PAD
2492 01Dec20 NoCat	1	GARAGE: WIRELESS KEYPAD GARAGE DOOR ENTRY 877LM

PAINT

Invoice	Qty.	Description
2599 23Feb21 NoCat	2	MAIN STAIRS: STAIN STAIRS AND LANDINGS STAIRS AND LANDINGS WILL NOT MATCH HARDWOOD IN COLOUR/TEXTURE/SPECIES

PAINTING

Invoice	Qty.	Description
2492 72,351 01Dec20 **	2	BASEMENT WINDOWS - UPGRADE BASEMENT WINDOW SIZE TO 30 " X 24" - 8" FRAME

GOLDPARK

WORTH MORE™

CONSTRUCTION SUMMARY

Lot: 156

Model: 40.01 B SUMMERDALE

Project/Phase: Pine Valley Forevergreen / 1

PLUMBING

Invoice	Qty.	Description
2492 72,332 01Dec20	1	KITCHEN: ROUGH-IN 1/4" COLD WATER LINE TO FRIDGE
2492 01Dec20 NoCat	1	BACK-FLOW PREVENTER VALVE
2599 23Feb21 NoCat	1	MASTER ENSUITE: MOEN 'ALIGN' RAIN SHOWER (from ceiling) + HAND SHOWER/SLIDE BAR - CHROME
2492 01Dec20 ** NoCat	1	HUMIDIFER - LENNOX MODEL WB3-17 (2000 UP TO 3000 SQ.FT.)

STAIR AND RAILINGS

Invoice	Qty.	Description
2599 93,778 23Feb21	2	MAIN STAIRS: 2ND FLOOR TO BASEMENT: UPGRADE - EURONLINE (ALL PLAIN) PICKET, 3" HALF-ROUND W/V-GROOVE HANDRAIL, 3 1/2" ALL SQUARE POST WITH PYRAMID TOP POST CAP - PACKAGE A-2
2599 23Feb21 NoCat	1	MAIN STAIRS: STAIN STAIRS AND LANDINGS STAIRS AND LANDINGS WILL NOT MATCH HARDWOOD IN COLOUR/TEXTURE/SPECIES

WINDOWS AND DOORS

Invoice	Qty.	Description
2492 01Dec20 NoCat	1	BREAKFAST: UPGRADE EXTERIOR GARDEN DOOR ASSEMBLY TO 96"

DisciplineMS.rpt 23feb21

Page 6 of 6
Printed and Sent: 30-Nov-21

Purchasers: Vay Dau Trong & My Phung Phan

Property: 156 of Plan -

Telephone Res. / Bus: / (416) 937-6590

Project: Pine Valley Forevergreen - Phase 1

Decor Advisor: Yolande Somerville

Model and Elevation: 40.01 B SUMMERDALE

Layout Changes: ☐ Yes ☒ No

Sketch Attached: ☒ Yes ☐ No

Exterior Colour Scheme:

1. Cabinetry

	Style and Colour	Counter	Hardware
Kitchen / Breakfast	Alban oak 'Storm Grey'	Granite: Arctic White	attached
Laundry Room	Alban oak 'Storm Grey'	P-Lam: Std White	attached
Powder Room	Alban oak 'Storm Grey'	Quartz: Ice Snow	attached
Master Ensuite Bathroom	Alban oak 'Storm Grey'	Quartz: Ice Snow	attached
Second Ensuite Bathroom (If Applicable)	Alban oak 'Storm Grey'	Quartz: Ice Snow	attached
Main Bath	Alban oak 'Storm Grey'	Quartz: Ice Snow	attached

Comment

2. Floor Tile

	Selection
Entrance Vestibule	*30x30" Marmorea matte 'Bianco Statuario'
Main Hall	n/a
Kitchen / Breakfast	*30x30" Marmorea matte 'Bianco Statuario'
Laundry Room	13x13" Costa 'White'
Powder Room	*12x24" Marmorea matte 'Bianco Statuario'
Master Ensuite Bathroom	13x13" New Byzantine 'Azzuro Blue'
Second Ensuite Bathroom (If Applicable)	13x13" New Byzantine 'Azzuro Blue'
Lower Landing (If Applicable)	13x13" Costa 'White' (basement)
Main Bath	13x13" New Byzantine 'Azzuro Blue'

Comment

3. Wall Tile

	Selection	Listello/Inserts	Describe
		☐ Yes ☒ No	
Master Ensuite Bathroom			
Tub Deck		☐ Yes ☒ No	
Shower Stall	8x10" Weave 'White'	☐ Yes ☒ No	
Bathroom Walls		☐ Yes ☒ No	
Second Ensuite Bathroom (If Applicable)	8x10" Weave 'White'	☐ Yes ☒ No	
Main Bath	8x10" Weave 'White'	☐ Yes ☒ No	
Kitchen Backsplash	☒ Yes ☐ No	Backsplash Behind Fridge	
	*Granite FHBS - same as counter		

Comment

[Signature]

Purchasers: Vay Dau Trong & My Phung Phan

Property: 156 of Plan -

Telephone Res. / Bus: / (416) 937-6590

Project: Pine Valley Forevergreen - Phase 1

Decor Advisor: Yolande Somerville

Model and Elevation: 40.01 B SUMMERDALE

4. Plumbing Fixtures

Master Ensuite Bathroom Second Ensuite Powder Room
Other Room - Specify Other Washroom

Comment

Standard except Master Ensuite Shower

5. Hardwood Flooring

Type and Stain	Type and Stain
Main Hall	Upper Landing
Kitchen / Breakfast	Upper Hall
Living Room	Master Bedroom
Dining Room	Bedroom #2
Family Room	Bedroom #3
Den/Library	Bedroom #4
Entrance Vestibule	Bedroom #5
Lower Landing (If Applicable)	Other Room - Specify
	Thru out standard areas

Comment

6. Carpeting

Upgrade	Description
Ground Floor ☐	
Second Floor ☐	
☐	

Type	Area
Upgrade Underpad	
Capped	Runner - *Upgrade
Carpet on Stairs	

Comment

7. Fireplace

	Living Room			Family Room			Other Room - Specify		
	Purchased	As Per Plan	N/A	Purchased	As Per Plan	N/A	Purchased	As Per Plan	N/A
Fireplace Type	☐	☐	☒	☐	☒	☐	☐	☐	☒
Mantle Type				Standard Gas					
Colour / Stain				Mediterranean					
Surround				Arctic White					
Hearth				n/a					
				none					

Comment

Scheduled Closing Date: Thursday, June 24, 2021

Purchasers: Vay Dau Trong & My Phung Phan

Property: 156 of Plan -

Telephone Res. / Bus: / (416) 937-6590

Project: Pine Valley Forevergreen - Phase 1

Decor Advisor: Yolande Somerville

Model and Elevation: 40.01 B SUMMERDALE

8. Trim Carpentry

Interior Doors Carrara Front Door Glass Inserts standard Door Handles standard

Interior Trim standard package

Comment

9. Plaster Mouldings and Medallions

Standard Throughout ☐ Yes ☐ No ☒ N/A

Entrance Vestibule

Main Hall

Living Room

Dining Room

Family Room

Comment

Kitchen/Breakfast

Den/Library

Lower Landing

Other Room - Specify

10. Railings and Spindles

Railing Package A-2 Euroline 0

Railing Colour *Hopscotch

Stringer / Riser *Hopscotch

Comment

Spindle Colour *Black

Treads *Hopscotch

Oak Stairs ☒ Yes ☐ No ☐ N/A

11. Wall Paint / Ceilings

Throughout Finished Areas Warm Grey

Trim Paint White

Smooth Ceilings

Ground Floor ☒Second Floor ☒

Note

Comment

Scheduled Closing Date: Thursday, June 24, 2021

Purchasers: Vay Dau Trong & My Phung Phan

Property: 156 of Plan -

Telephone Res. / Bus: / (416) 937-6590

Project: Pine Valley Forevergreen - Phase 1

Decor Advisor: Yolande Somerville

Model and Elevation: 40.01 B SUMMERDALE

12. Electrical

Hood Fan ☐ White ☒ Stainless ☐ N/A

Above Kitchen Cabinet Light ☐ Yes ☒ No

Below Kitchen Cabinet Light ☐ Yes ☒ No

Standard Appliances ☐

Over The Range Microwave ☐

Chimney Style Fan ☒

Comment

13. Heating and Air Conditioning

Air Conditioning

Gas Provisions Stove

Gas Provisions Dryer

Gas Provisions Barbecue

Comment

14. Additional Comments

15. Disclaimers and Notes

- 1) Colours of all materials are as close as possible to builder's selection, but not necessarily identical due to variances in manufacturing.
- 2) Any extras listed above are null and void unless accompanied by a separate invoice/amendment. Said invoice must be paid in full.
- 3) The Purchaser acknowledges that after Interior Colour Selection form is signed and dated, no further changes will be permitted other than re-selection due to unavailability. _____ Purchaser's Initials
- 4) The Purchaser acknowledges reading and accepting the "Gold Park Homes Decor Centre Disclaimers" form. This document contains other miscellaneous disclaimers.

This Interior Colour Selection is final and approved by:

Signature: _____ Date: _____


SCHEDULE 'F'



PV-156 **5th attach.**
Nov 23 2020
PV-156
Feb. 22, 2021

The Summerdale
40' SERIES

Elevation A • 2,895 sq.ft.
→ Elevation B • 2,880 sq.ft.

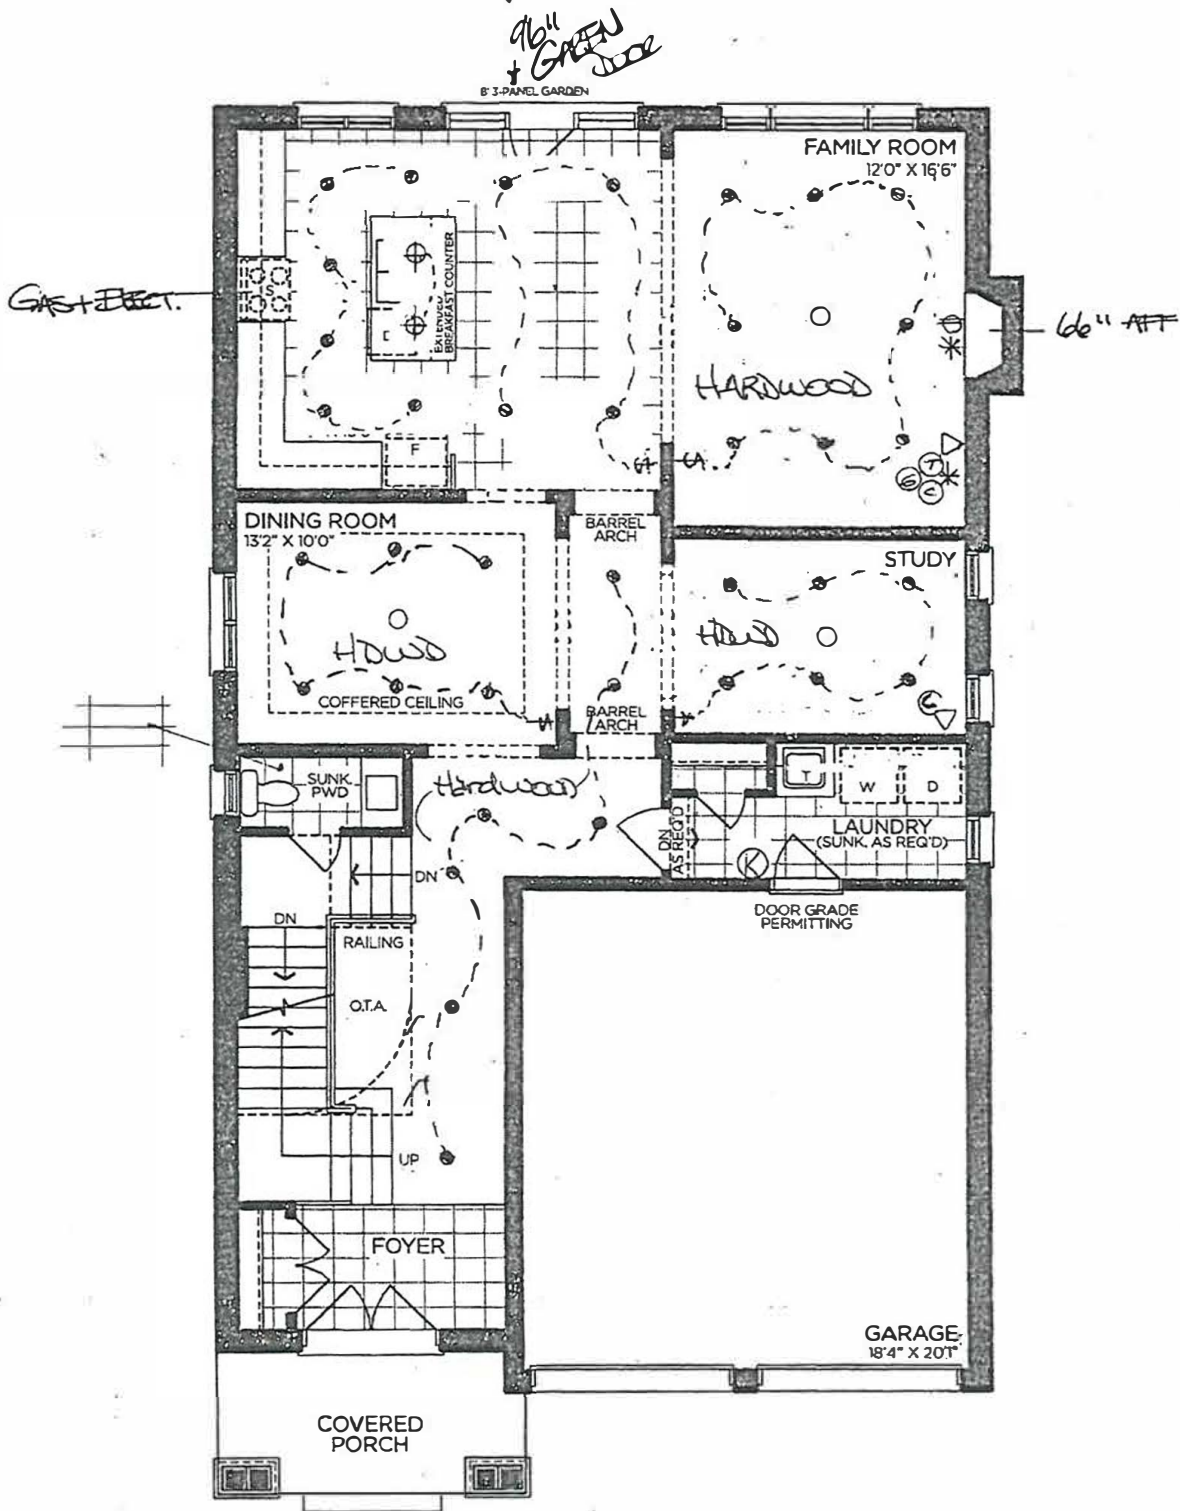

GROUND FLOOR | ELEV. A

VENDOR

PURCHASER

PURCHASER

GOLDPARK
WORTH MORE™

Prices, figures, illustrations, sizes, features and finishes are subject to change without notice. Areas and dimensions are approximate and actual usable floor space may vary from the stated area. Layout may be reverse of the unit purchased. E. & O.E. 4001


SCHEDULE 'F'



** See attach **
PV-156
Nov. 23, 2020
PV-156 *[Signature]*
Feb. 22, 2021

The
Summerdale
40' SERIES

Elevation A • 2,895 sq.ft.
Elevation B • 2,880 sq.ft.

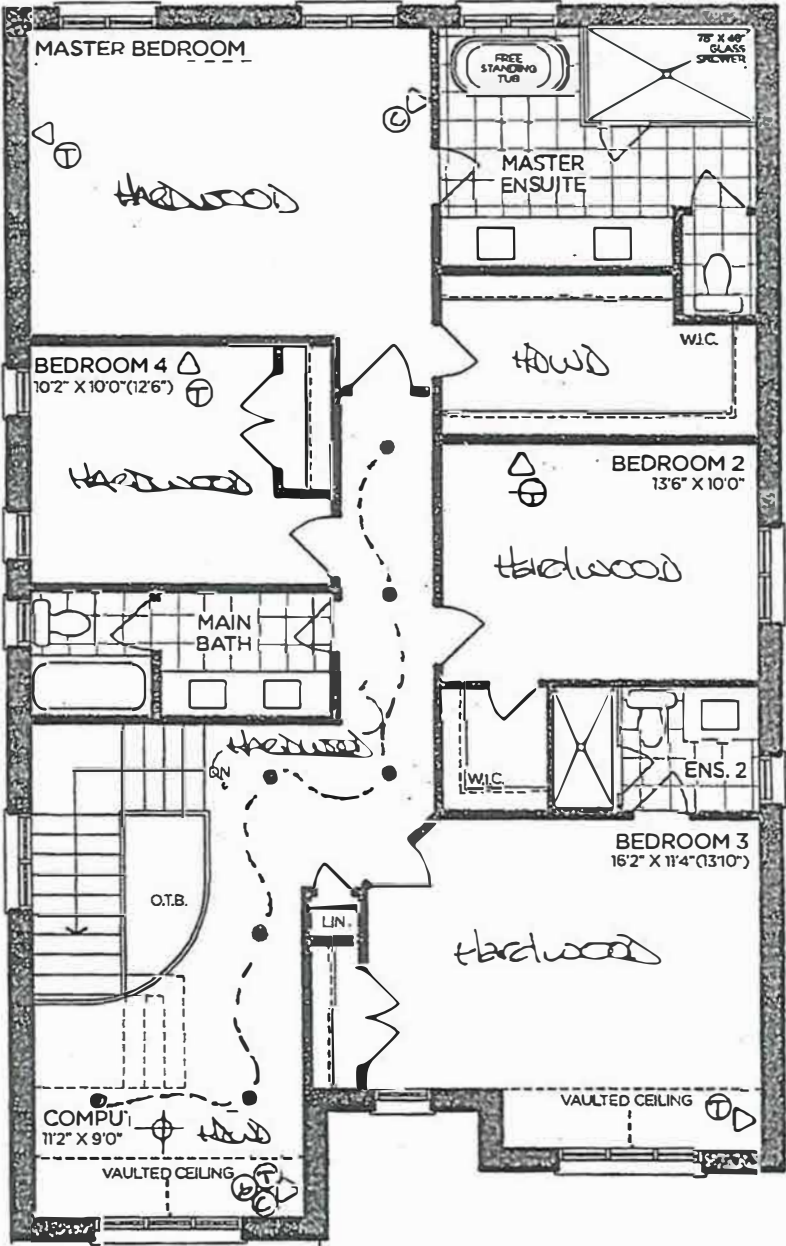

SECOND FLOOR | ELEV. A

VENDOR

PURCHASER

PURCHASER

GOLDPARK
WORTH MORE™


Prices, figures, illustrations, sizes, features and finishes are subject to change without notice. Areas and dimensions are approximate and actual usable floor space may vary from the stated area. Layout may be reverse of the unit purchased. E. & O.E. 4001

SCHEDULE 'F'



** See attach. **
PV-156
Nov 23 2020
PV-156
Feb. 22, 2021
24x30"

The
Summerdale
40' SERIES
Elevation A • 2,895 sq.ft.
Elevation B • 2,880 sq.ft.

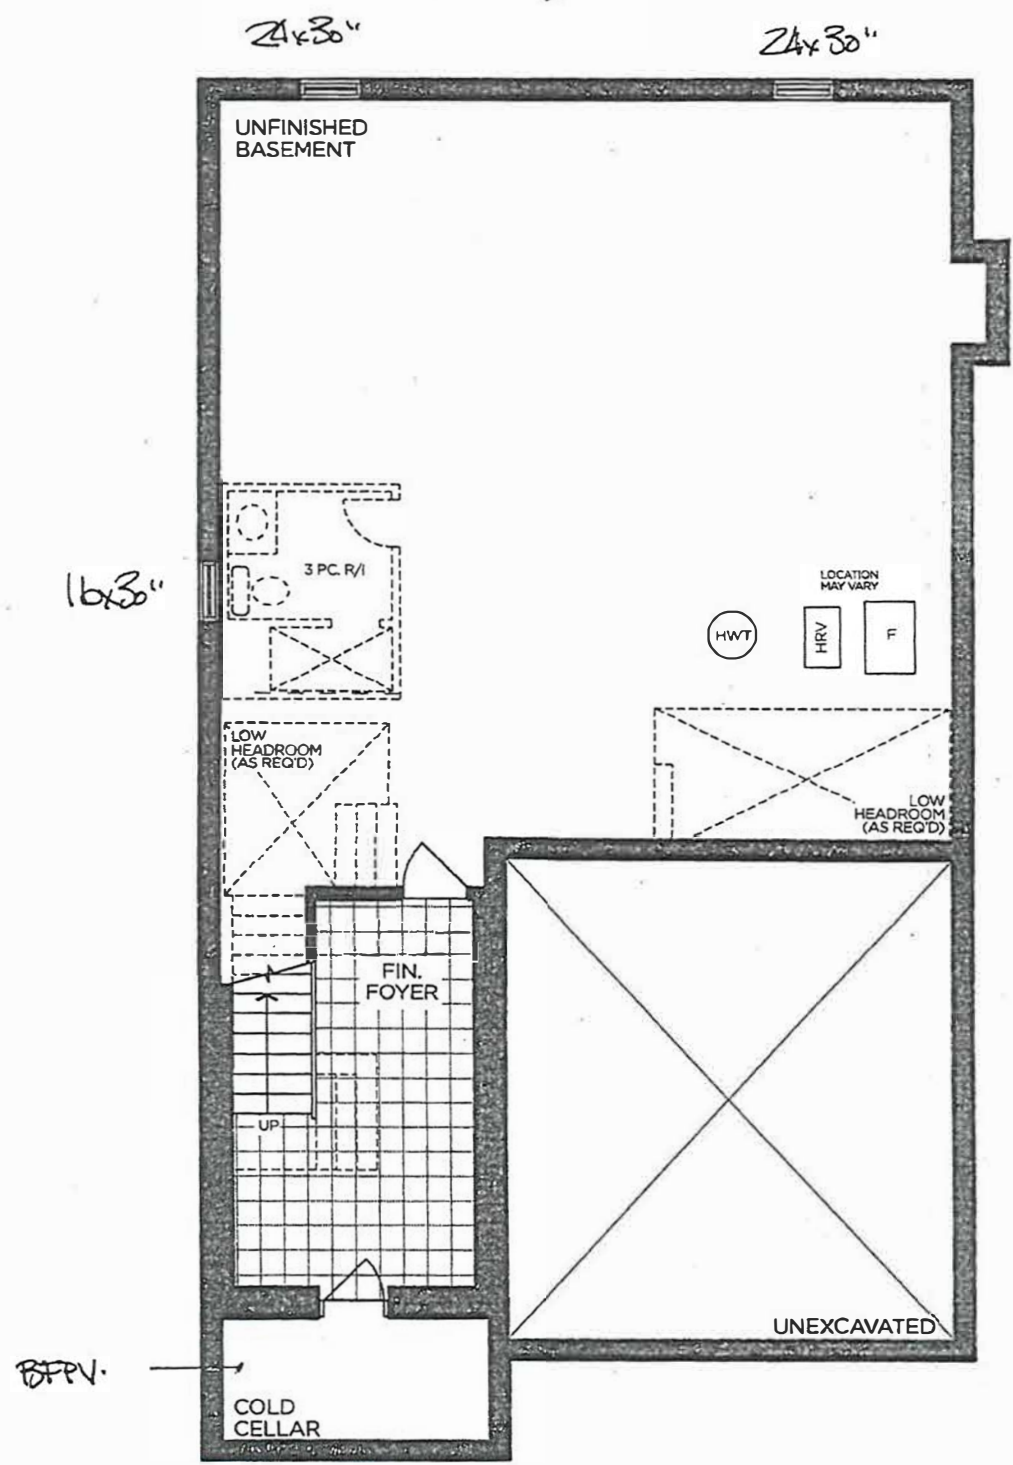

BASEMENT | ELEV. A

VENDOR

PURCHASER

PURCHASER

GOLDPARK
WORTH MORE™

Prices, figures, illustrations, sizes, features and finishes are subject to change without notice. Areas and dimensions are approximate and actual usable floor space may vary from the stated area. Layout may be reverse of the unit purchased. E. & O.E. 4001

SCHEDULE 'F'



PV-156

Nov 23 2020

PV-156


Feb. 22, 2021

*see attach. *


The
Summerdale
40' SERIES

Elevation A • 2,895 sq.ft.


→ Elevation B • 2,880 sq.ft.

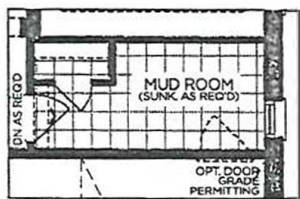


PART. GROUND FLOOR
MUDROOM FOR OPT.
SECOND FLOOR LAUNDRY

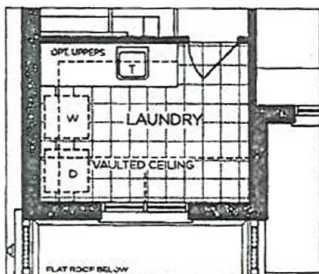


PART. SECOND FLOOR
W/ OPT. LAUNDRY
ELEV. B

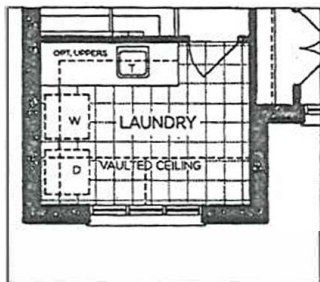


PART. SECOND FLOOR
W/ OPT. LAUNDRY
ELEV. A

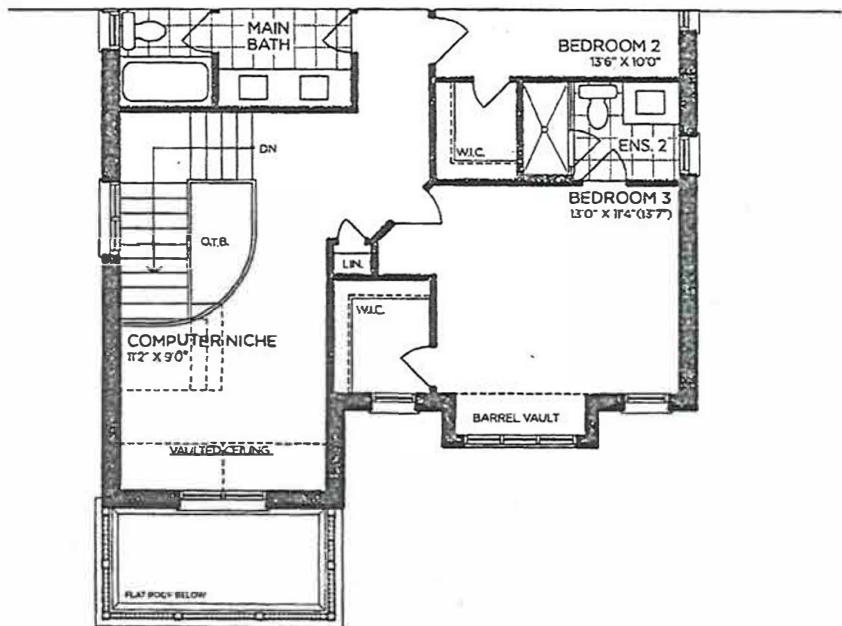

→ PART. SECOND FLOOR | ELEV. B

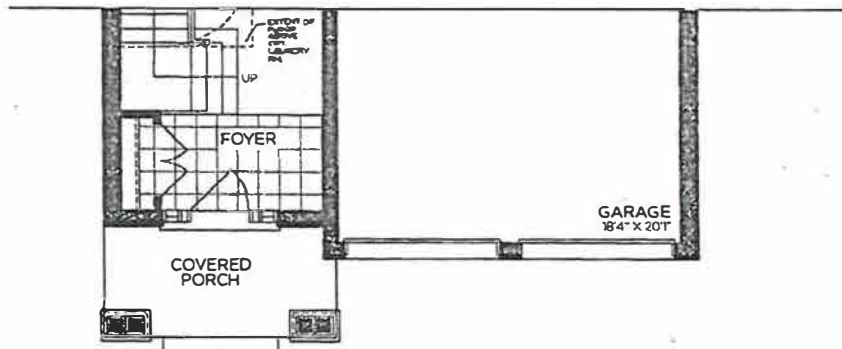

→ PART. GROUND FLOOR | ELEV. B

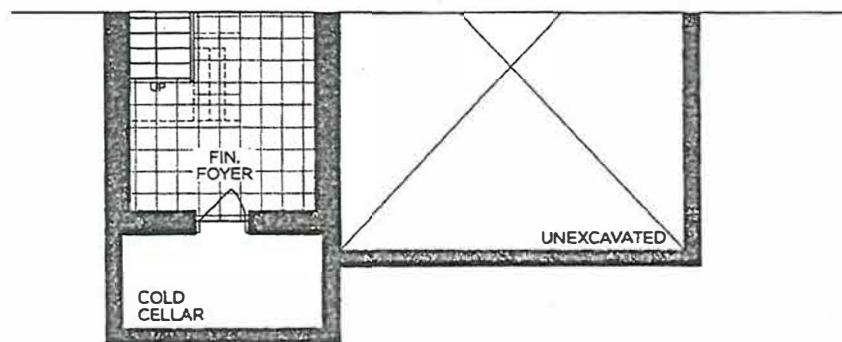

→ PART. BASEMENT | ELEV. B


VENDOR

PURCHASER

PURCHASER

GOLDPARK
WORTH MORE™

Prices, figures, illustrations, sizes, features and finishes are subject to change without notice. Areas and dimensions are approximate and actual usable floor space may vary from the stated area. Layout may be reverse of the unit purchased. E. & O.E. 4001

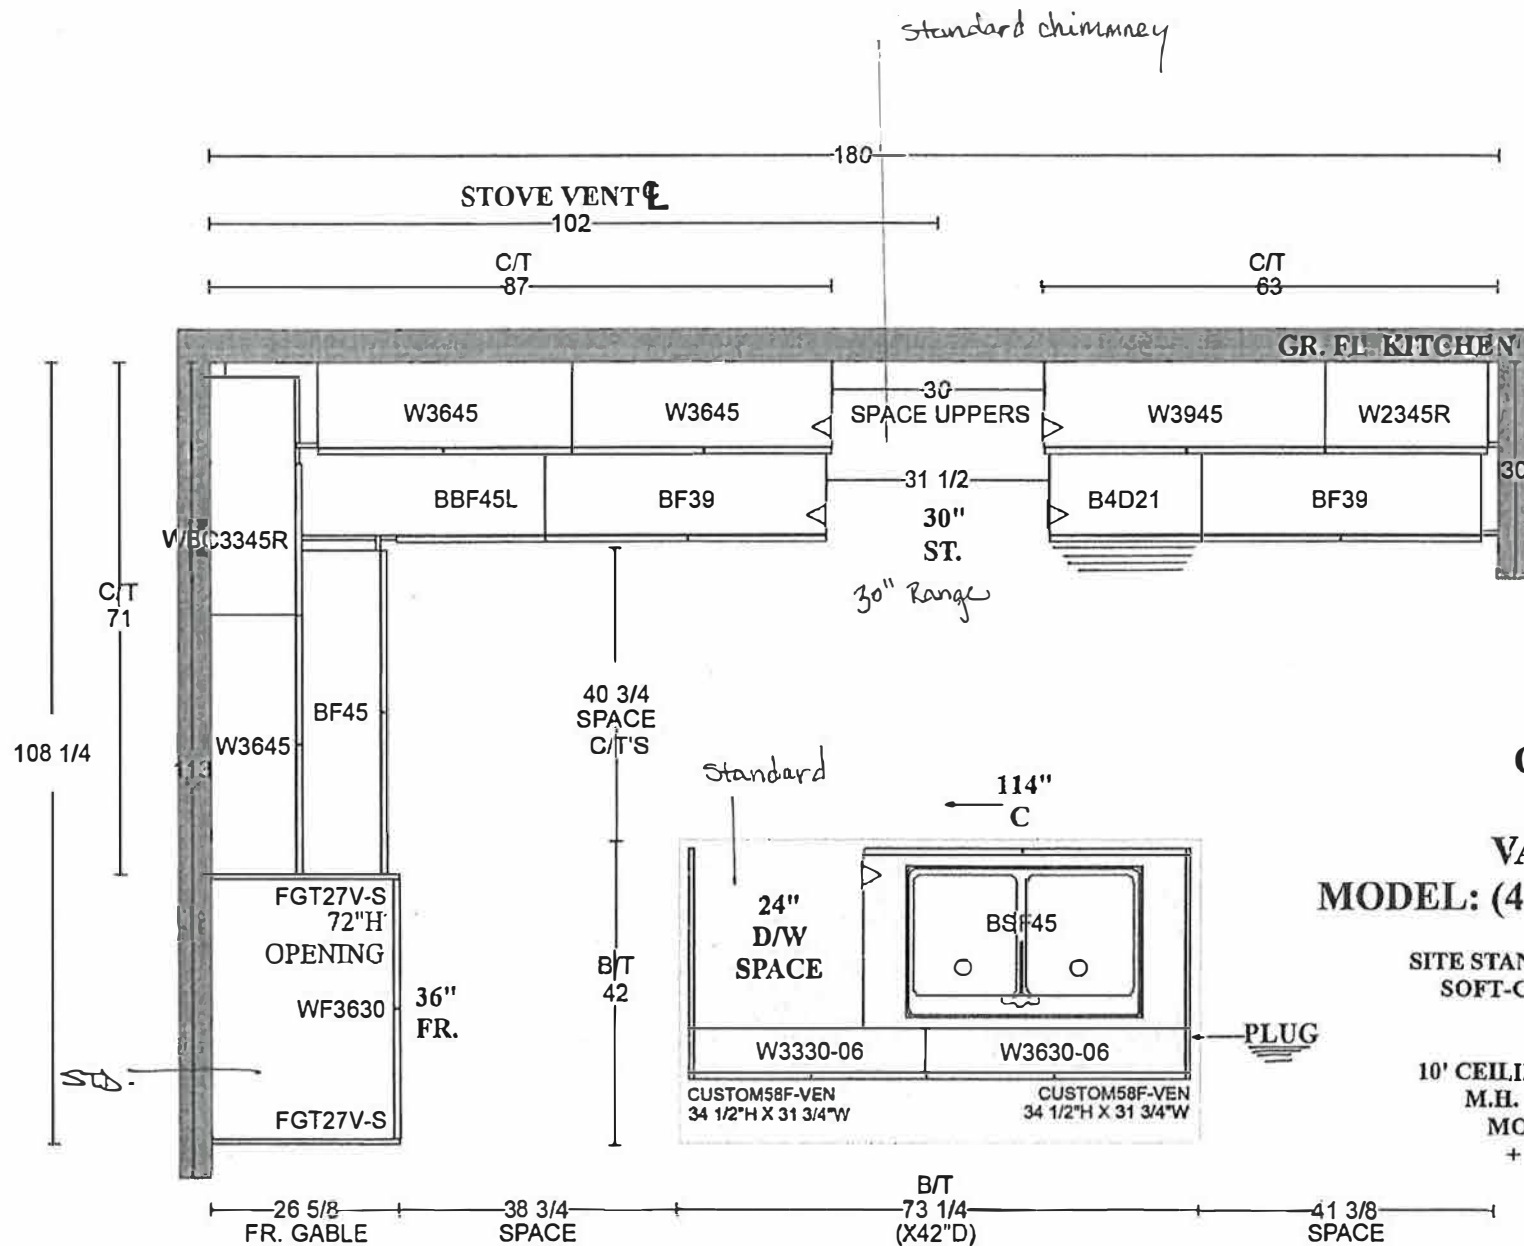

standard chimney

Alban Oak' Storm Grey Oak'

* standard appliance openings
 ≠ kitchen layout.

GOLDPARK HOMES
PINE VALLEY
VAUGHAN, ONTARIO
MODEL: (4001) SUMMERDALE

[Signature]
 PR-156
 Feb. 22, 2021

SITE STANDARD: WHITE 3/4" EXTENSION
 SOFT-CLOSE DRAWERS & SOFT-CLOSE
 HINGES TO KITCHEN AREA

10' CEILING - 12"H COFFERED CEILING -
 M.H. = 102" + 3/4"H CONTEMPORARY
 MOLDING + 5 1/4"H FURRING RAIL
 + LARGE CORNICE MOLDING TO
 UNDERSIDE OF BOX



PLAN VIEW

#: AKOWALTCHUK-0032-20 (V1.02)

Page# 5/22

PV-156 *[Signature]*
 Feb. 22, 2021






**GOLDPARK HOMES
 PINE VALLEY
 VAUGHAN, ONTARIO
 MODEL: (4001) SUMMERDALE**

SITE STANDARD: WHITE 3/4" EXTENSION
 SOFT-CLOSE DRAWERS & STANDARD SLAM DOOR HINGES
 TO VANITIES


ONE TOP DRAWER WHERE POSSIBLE THROUGHOUT EACH
 VANITY, ONE BANK OF DRAWERS WHERE POSSIBLE
 THROUGHOUT EACH MASTER ENSUITE VANITY

Alban 'Oak Storm Grey'

* Take out: *
 Alban 'Oak Storm Grey'

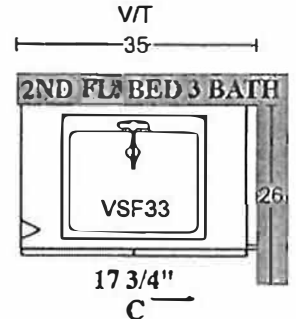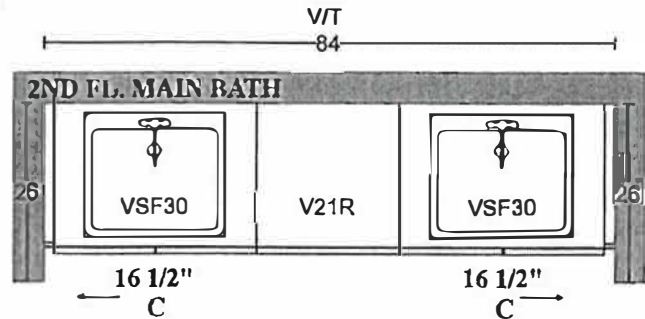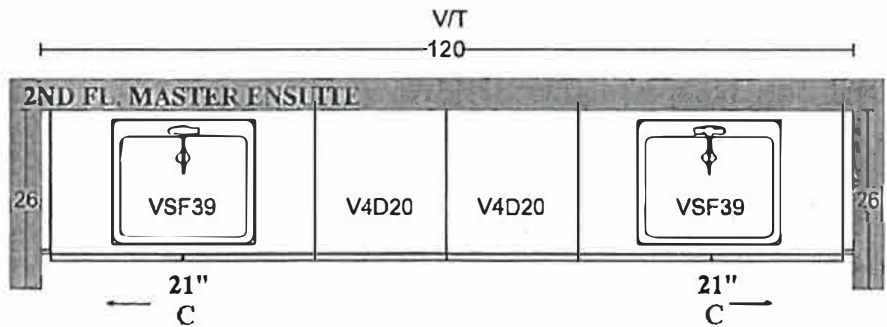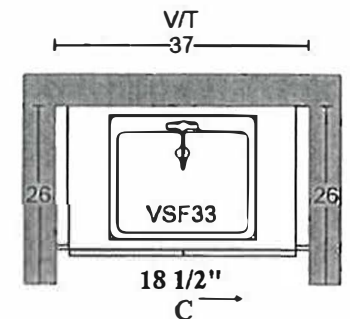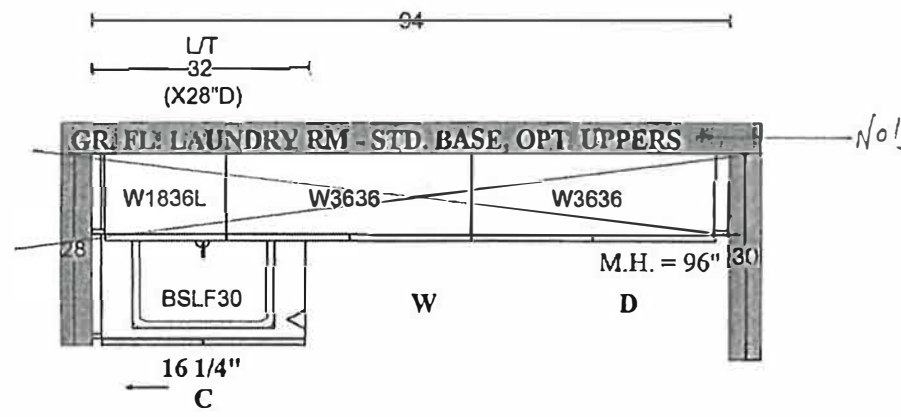

STONE COUNTERTOP EDGE PROFILES

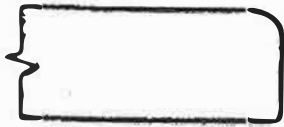

STANDARD 2CM EASED EDGE

LOCATION:

TURN OUT.



UPGRADE 3CM EASED EDGE


LOCATION:



UPGRADE 4CM MITRED EDGE



LOCATION:

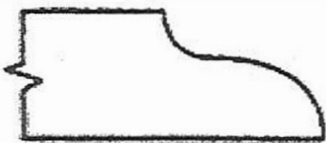

UPGRADE 2CM OGEE EDGE

LOCATION:


LOT #:

PV-156


DATE:

Feb. 22, 2021

SIGNATURE:

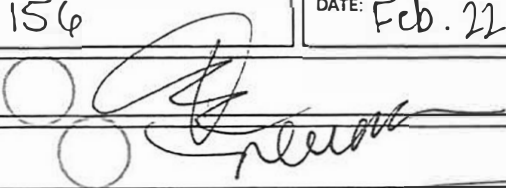

SIGNATURE:

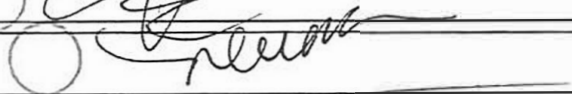



PINE VALLEY

FOREVER GREEN

STANDARD HARDWARE / HANDLES

☐

H001-02

☐

H001-03

☐

H001-04

☐

H009-03

☐

H009-09

☐

H011-03

☐

H011-05

☐

H011-06

☐

H033-01

☒

H039-03

Powder Room
Laundry
MASTER

INSZ
XAIN

☐

*NO HARDWARE

LOT # PV-156

DATE: Feb. 22, 2021

SIGNATURE:

SIGNATURE:

GOLDPARK
WORTH GOLD

STANDARD HARDWARE / KNOBS

☐

K002-02

☐

K002-03

☐

K002-04

☐

K002-06

☒

K002-05

KITCHEN

☐

K002-14

☐

K024-03

☐

*NO HARDWARE

LOT # PV-156

DATE: Feb. 22, 2021

SIGNATURE:

SIGNATURE:

GOLDPARK
WORKS SHOP

PLUMBING UPGRADES





MOEN - ALIGN

Posi-Temp SHOWER ONLY* with 3 Function Transfer Valve/Trim and Slide Bar with Handshower



*CHROME ONLY
*from CEILING

MODEL: T2192EP / U361CI / UT4191 / 62320 / 3887EP / A725 / 226651 / S1002

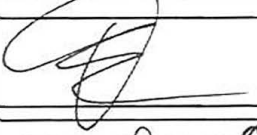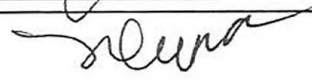
Lot# 156	Date: FEB 22 2021	Room: MASTER ENSUITE
Signature: 		
Signature: 		

UPGRADE SHOWER HARDWARE



MT6X6



Shower Door Handle

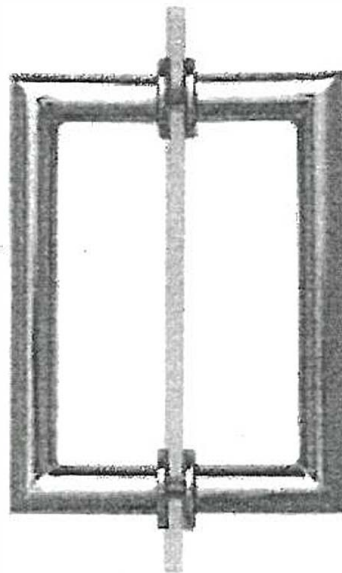


MT6X6
Shower Door Handle

6" x 6" back-to-back
3/4" dia. tube
Cut and mitred corners with
washers
(Also available single sided)


- ☒ CHROME
☐ MATTE BLACK
☐ BRUSHED GOLD

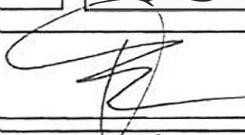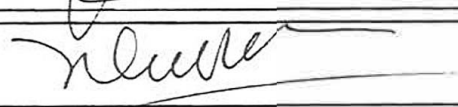Lot# 156	Date: FEB 22 2021	Room: MASTER + ENS 2
Signature: 		
Signature: 		

BATHROOM ACCESSORIES

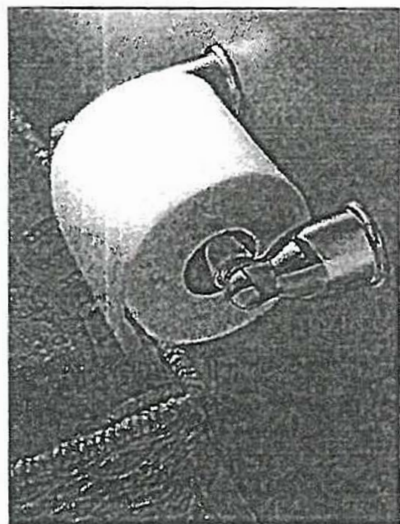

Tissue Holder
Mason - Chrome

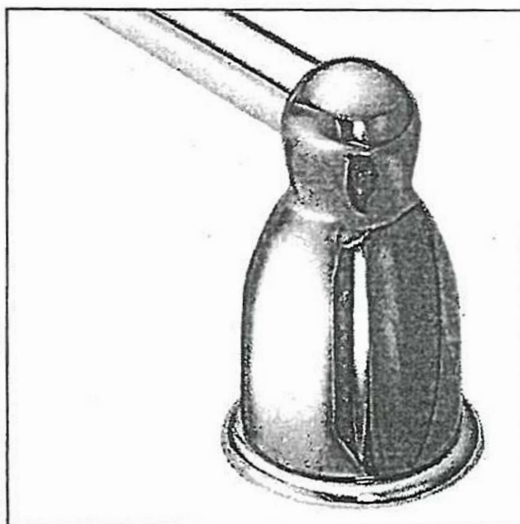

Towel Bar
Mason - Chrome

Please select one of the following:



INSTALL STANDARD BATHROOM ACCESSORIES THRU OUT
(tissue holder + towel bar) **location as per vendors discretion**



DO NOT INSTALL STANDARD BATHROOM ACCESSORIES
THRU OUT **tissue holder + towel bar will not be provided**

LOT # PV-156

DATE: Feb. 22, 2021

SIGNATURE:

SIGNATURE: