



CONSTRUCTION SUMMARY

Lot: 85
Model: 50.04 C BEAUMONT
Project/Phase: Pine Valley Forevergreen / 1

APPLIANCES

Invoice	Qty.	Description
2656 23Mar21 NoCat	1	APPLIANCE SPECIFICATIONS ATTACHED - SIGNED COPY
2691 15Apr21 NoCat	1	KITCHEN: UPGRADE TO 8" DUCT (EXTERIOR WALL) IN LIEU OF STANDARD OFFERING

BASEMENT WINDOWS

Invoice	Qty.	Description
2642 72,675 16Mar21	5	BASEMENT WINDOWS - UPGRADE BASEMENT WINDOW SIZE TO 30 " X 24" - 10" FRAME

CERAMIC

Invoice	Qty.	Description
2691 15Apr21 NoCat	1	MASTER ENSUITE: SHOWER BENCH COMPLETE WITH STANDARD TILE AND MATCHING MARBLE JAMB COLOUR SEAT TOP
2691 15Apr21 NoCat	1	**CUSTOM LAYOUT** MASTER ENSUITE: REVISE SIZE OF STANDARD VANITY TO ACCOMMODATE HIS AND HERS VANITIES - SEE PLAN
2691 15Apr21 NoCat	1	FYI - **CUSTOM LAYOUT** MASTER ENSUITE: DELETE STANDARD LINEN AS PER PLAN
2744 37 19May21	1	POWDER ROOM: TILE, FLOOR - LEVEL 5 - 12x24" LAID IN STRAIGHT STACKED PATTERN - SEE PLAN FOR DIRECTION
2744 37 19May21	1	MUD ROOM - TILE, FLOOR - LEVEL 5 - 12x24" LAID IN STRAIGHT STACKED PATTERN - SEE PLAN FOR DIRECTION
2744 39 19May21	1	FOYER: TILE, FLOOR - LEVEL 7 - 30x30" LAID IN STRAIGHT STACKED PATTERN
2744 39 19May21	1	MAIN HALL: TILE, FLOOR - LEVEL 7 - 30x30" LAID IN STRAIGHT STACKED PATTERN
2744 19 19May21	1	FOYER/MAIN HALL: TILE GROUT UPGRADE, FLOOR , UPG GROUT - FRONT FOYER/MAIN HALL - UPG GROUT
2744 19 19May21	1	POWDER ROOM: TILE GROUT UPGRADE, FLOOR , UPG GROUT



CONSTRUCTION SUMMARY

Lot: 85
Model: 50.04 C BEAUMONT
Project/Phase: Pine Valley Forevergreen / 1

CERAMIC

Invoice	Qty.	Description
2744 19 19May21	1	MUD ROOM: TILE GROUT UPGRADE, FLOOR , UPG GROUT
2744 39 19May21	1	MASTER ENSUITE: TILE, FLOOR , LEVEL 7 - 30X30" LAID IN STRAIGHT, STACKED PATTERN.
2744 43 19May21	1	MASTER ENSUITE: TILE, SHOWER FLOOR, LEVEL 2
2744 19 19May21	1	MASTER ENSUITE - FLOOR / WALL / SHOWER FLOOR: TILE GROUT UPGRADE
2744 53 19May21	1	MASTER ENSUITE: TILE, WALL, LEVEL 5 - 12X24" LAID IN HORIZONTAL STACKED PATTERN
2744 19May21 NoCat	1	THRU OUT *FULLY INSTALL TILE BELOW ALL CABINETRY PLEASE*
2744 19May21 NoCat	1	KITCHEN/BREAKFAST: VINTAGE SERIES, 5" WHITE OAK, NSS ENGINEERED HARDWOOD, 3/4" THK, WIREBRUSH TEXTURE, UV OIL FINISH - LEVEL 3

CONCRETE AND DRAIN

Invoice	Qty.	Description
2642 101,930 16Mar21	1	BACK FLOW PREVENTER VALVE



CONSTRUCTION SUMMARY

Lot: 85
Model: 50.04 C BEAUMONT
Project/Phase: Pine Valley Forevergreen / 1

DRYWALL

Invoice	Qty.	Description
2691 72,690 15Apr21 **	1	DELETE KITCHEN BULKHEAD, IF POSSIBLE, SITE APPROVAL REQUIRED
2691 15Apr21 NoCat	1	FRONT EXTERIOR: ADDITIONAL EXTERIOR COACH LIGHT ON SAME SWITCH (BUILDERS STANDARD FIXTURE)
2691 15Apr21 NoCat	1	LIBRARY: DELETE TWO STANDARD OPENINGS AS PER PLAN - INSTALL FULL HEIGHT WALLS
2691 15Apr21 NoCat	1	**CUSTOM LAYOUT** GARAGE: ADD MAN DOOR AT SIDE OF GARAGE - SEE PLAN
2691 15Apr21 NoCat	1	GREAT ROOM: UPGRADE MAIN FLOOR LINEAR 1 SIDED FIREPLACE - JADE SERIES 42" LINEAR DIRECT VENT GAS FIREPLACE IN LIEU OF STANDARD BOTTOM OF GLASS APPROX. 12" A.F.F. + ADD VENT GRILL APPROX. 6" FROM CEILING
2691 15Apr21 NoCat	1	DELETE KITCHEN BULKHEAD, IF POSSIBLE, SITE APPROVAL REQUIRED
2691 15Apr21 ** NoCat	1	DELETE KITCHEN BULKHEAD, IF POSSIBLE, SITE APPROVAL REQUIRED
2691 15Apr21 NoCat	1	MASTER ENSUITE: SHOWER BENCH COMPLETE WITH STANDARD TILE AND MATCHING MARBLE JAMB COLOUR SEAT TOP



CONSTRUCTION SUMMARY

Lot: 85
Model: 50.04 C BEAUMONT
Project/Phase: Pine Valley Forevergreen / 1

ELECTRICAL

Invoice	Qty.	Description
2691 72,292 15Apr21	1	FRONT EXTERIOR: ADDITIONAL EXTERIOR COACH LIGHT ON SAME SWITCH (BUILDERS STANDARD FIXTURE)
2691 72,291 15Apr21	3	FRONT EXTERIOR: EXTERIOR LED SOFFIT POT LIGHT - SEE ATTACHED ELEVATION FOR LOCATION
2691 72,278 15Apr21	1	FOYER: ADDITIONAL INTERIOR SWITCH FOR EXTERIOR POT LIGHTS
2691 72,307 15Apr21	1	FOYER: RELOCATE STANDARD CEILING MOUNT FIXTURE TO BE APPROX. CENTERED IN CIRCULAR AREA OF CEILING - SEE PLAN
2691 72,307 15Apr21	1	MAIN HALL AT POWDER ROOM: RELOCATE STANDARD CEILING MOUNT FIXTURE TO BE APPROX. CENTERED IN CIRCULAR AREA OF CEILING - SEE PLAN
2691 72,287 15Apr21	1	DINING ROOM: ROUGH-IN FOR WALL SCONCE - INCLUDED (1) CAPPED OUTLET AND (1) SWITCH - FIXTURE NOT INCLUDED - INSTALL APPROX. 78" A.F.F. - SEE PLAN
2691 72,288 15Apr21	1	DINING ROOM: ROUGH-IN FOR ADDITIONAL WALL SCONCE (1) CAPPED OUTLET ON EXISTING SWITCH - FIXTURE NOT INCLUDED - INSTALL APPROX. 78" A.F.F. - SEE PLAN
2691 72,281 15Apr21	1	GARAGE: INTERIOR WALL OUTLET: ADDITIONAL 110V WALL INTERIOR RECEPTACLE ON EXISTING CIRCUIT - SEE PLAN
2691 72,286 15Apr21	1	LOGGIA: ADDITIONAL EXTERIOR GFI RECEPTACLE WITH COVER - SEE PLAN
2691 72,287 15Apr21	1	MASTER BEDROOM: ROUGH-IN FOR WALL SCONCE - INCLUDED (1) CAPPED OUTLET AND (1) SWITCH - FIXTURE NOT INCLUDED - APPROX. 52" A.F.F. AND APPROX. 37" IN FROM WALL - ADD SWITCH BELOW, APPROX. 36" A.F.F.
2691 72,268 15Apr21	1	MASTER BEDROOM: ROUGH-IN FOR WALL SCONCE - INCLUDED (1) CAPPED OUTLET AND (1) SWITCH - FIXTURE NOT INCLUDED - APPROX. 52" A.F.F. AND APPROX. 37" IN FROM WALL - ADD SWITCH BELOW, APPROX. 36" A.F.F.
2691 72,281 15Apr21	1	MASTER BEDROOM: INTERIOR WALL OUTLET: ADDITIONAL 110V WALL INTERIOR RECEPTACLE ON EXISTING CIRCUIT FOR WALL MOUNTED TV - APPROX. 60"A.F.F. - SEE PLAN
2691 72,307 15Apr21	1	KITCHEN: RELOCATE STANDARD CEILING MOUNT FIXTURE TO APPROX. CENTRE OVER ISLAND



CONSTRUCTION SUMMARY

Lot: 85
Model: 50.04 C BEAUMONT
Project/Phase: Pine Valley Forevergreen / 1

ELECTRICAL

Invoice	Qty.	Description
2691 72,281 15Apr21	1	GREAT ROOM: INTERIOR WALL OUTLET: ADDITIONAL 110V WALL INTERIOR RECEPTACLE ON EXISTING CIRCUIT FOR WALL MOUNTED TV - APPROX. 64" A.F.F. ABOVE FIREPLACE
2691 72,307 15Apr21	1	UPPER HALL: RELOCATE STANDARD CEILING MOUNT FIXTURE TO APPROX. CENTRE ON CEILING AT OTB - SEE PLAN
2691 72,291 15Apr21	1	REAR EXTERIOR: EXTERIOR LED SOFFIT POT LIGHT - IN SOFFIT AT GREAT ROOM - ON EXISTING SWITCH W/ STD CEILING LIGHT AT LOGGIA - SEE PLAN
2691 72,288 15Apr21	1	UPPER HALL: ROUGH-IN FOR ADDITIONAL WALL SCONCE (1) CAPPED OUTLET ON EXISTING SWITCH - FIXTURE NOT INCLUDED - APPROX. 78" A.F.F. - APPROX CENTRE TO MAIN STAIRS - SEE PLAN
2691 72,288 15Apr21	1	STAIRS TO BASEMENT AT FIRST LANDING: ROUGH-IN FOR ADDITIONAL WALL SCONCE (1) CAPPED OUTLET ON EXISTING SWITCH - FIXTURE NOT INCLUDED - APPROX. 102" A.F.F.
2691 72,288 15Apr21	1	STAIRS AT LOWER BASEMENT LANDING: ROUGH-IN FOR ADDITIONAL WALL SCONCE (1) CAPPED OUTLET ON EXISTING SWITCH - FIXTURE NOT INCLUDED - APPROX. 78" A.F.F. - CONNECT TO 3-WAY SWITCH (SWITCH NOT INCLUDED)
2691 72,276 15Apr21	1	MAIN STAIRS: ADDITIONAL 3-WAY SWITCH (LIGHT OPERATED BY 2 DIFFERENT SWITCHES) - CONNECT TO ROUGH-IN WALL SCONCE AT LOWER LANDING TO BASEMENT
2691 72,276 15Apr21	1	MAIN STAIRS: ADDITIONAL 3-WAY SWITCH (LIGHT OPERATED BY 2 DIFFERENT SWITCHES) - CONNECT TO ROUGH-IN WALL SCONCE AT UPPER HALL
2691 72,307 15Apr21	1	UPPER HALL: RELOCATE STANDARD CEILING MOUNT FIXTURE TO CENTRE IN CIRCULAR AREA AT ENTRANCE TO MASTER BEDROOM
2691 72,289 15Apr21	6	MAIN HALL/FOYER: 4" E/S LED INTERIOR POT LIGHT - SEE PLAN - INCLUDES ONE SWITCH INCLUDED IN APS
2691 72,307 15Apr21	1	MASTER ENSUITE: RELOCATE STANDARD CEILING MOUNT FIXTURE TO APPROX. CENTRE ON CEILING OVER FREE STANDING TUB + ADDITIONAL SWITCH
2691 15Apr21 NoCat	1	DINING ROOM: ADD SPLIT SWITCH
2691 72,278 15Apr21	1	MAIN HALL AT MUD ROOM: ADDITIONAL INTERIOR SWITCH FOR POT LIGHTS IN TWO MAIN HALL NICHES



CONSTRUCTION SUMMARY

Lot: 85
Model: 50.04 C BEAUMONT
Project/Phase: Pine Valley Forevergreen / 1

ELECTRICAL

Invoice	Qty.	Description
2691 72,279 15Apr21	1	MASTER ENSUITE: SHOWER POT LIGHT: 6" RECESSED SHOWER POT LIGHT ON EXISTING SWITCH
2691 72,307 15Apr21	1	MASTER ENSUITE: RELOCATE STANDARD SHOWER POT LIGHT AS PER PLAN
2691 15Apr21 NoCat	1	LIBRARY: DELETE TWO STANDARD OPENINGS AS PER PLAN - INSTALL FULL HEIGHT WALLS
2691 15Apr21 NoCat	1	**CUSTOM LAYOUT** GARAGE: ADD MAN DOOR AT SIDE OF GARAGE - SEE PLAN
2691 15Apr21 NoCat	1	GREAT ROOM: UPGRADE MAIN FLOOR LINEAR 1 SIDED FIREPLACE - JADE SERIES 42" LINEAR DIRECT VENT GAS FIREPLACE IN LIEU OF STANDARD BOTTOM OF GLASS APPROX. 12" A.F.F. + ADD VENT GRILL APPROX. 6" FROM CEILING

FIREPLACE

Invoice	Qty.	Description
2691 72,620 15Apr21	1	GREAT ROOM: UPGRADE MAIN FLOOR LINEAR 1 SIDED FIREPLACE - JADE SERIES 42" LINEAR DIRECT VENT GAS FIREPLACE IN LIEU OF STANDARD BOTTOM OF GLASS APPROX. 12" A.F.F. + ADD VENT GRILL APPROX. 6" FROM CEILING

FORMING

Invoice	Qty.	Description
2642 72,560 16Mar21	1	MODEL OPTIONS 50.04 - KITCHEN REAR - OPT. COVERED LOGGIA AS PER PLAN
2642 101,930 16Mar21	1	OPTIONAL COLD CELLAR BELOW LOGGIA - SEE PLAN



CONSTRUCTION SUMMARY

Lot: 85
Model: 50.04 C BEAUMONT
Project/Phase: Pine Valley Forevergreen / 1

FRAMING

Invoice	Qty.	Description
2691 101,930 15Apr21	1	LIBRARY: DELETE TWO STANDARD OPENINGS AS PER PLAN - INSTALL FULL HEIGHT WALLS
2691 72,690 15Apr21	1	DELETE KITCHEN BULKHEAD, IF POSSIBLE, SITE APPROVAL REQUIRED
2691 72,671 15Apr21	1	MASTER ENSUITE: SHOWER BENCH COMPLETE WITH STANDARD TILE AND MATCHING MARBLE JAMB COLOUR SEAT TOP
2691 15Apr21 NoCat	1	FRONT EXTERIOR: ADDITIONAL EXTERIOR COACH LIGHT ON SAME SWITCH (BUILDERS STANDARD FIXTURE)
2691 15Apr21 NoCat	1	**CUSTOM LAYOUT** GARAGE: ADD MAN DOOR AT SIDE OF GARAGE - SEE PLAN
2691 15Apr21 NoCat	1	**CUSTOM LAYOUT** GARAGE: ADD MAN DOOR AT SIDE OF GARAGE - SEE PLAN
2691 15Apr21 NoCat	1	FRONT EXTERIOR: EXTERIOR LED SOFFIT POT LIGHT - SEE ATTACHED ELEVATION FOR LOCATION
2691 15Apr21 NoCat	1	GREAT ROOM: UPGRADE MAIN FLOOR LINEAR 1 SIDED FIREPLACE - JADE SERIES 42" LINEAR DIRECT VENT GAS FIREPLACE IN LIEU OF STANDARD BOTTOM OF GLASS APPROX. 12" A.F.F. + ADD VENT GRILL APPROX. 6" FROM CEILING
2691 15Apr21 NoCat	1	LOGGIA: ADDITIONAL EXTERIOR GFI RECEPTACLE WITH COVER - SEE PLAN
2691 15Apr21 ** NoCat	1	DELETE KITCHEN BULKHEAD, IF POSSIBLE, SITE APPROVAL REQUIRED
2691 15Apr21 ** NoCat	1	DELETE KITCHEN BULKHEAD, IF POSSIBLE, SITE APPROVAL REQUIRED
2691 15Apr21 NoCat	1	REAR EXTERIOR: EXTERIOR LED SOFFIT POT LIGHT - IN SOFFIT AT GREAT ROOM - ON EXISTING SWITCH W/ STD CEILING LIGHT AT LOGGIA - SEE PLAN



CONSTRUCTION SUMMARY

Lot: 85
Model: 50.04 C BEAUMONT
Project/Phase: Pine Valley Forevergreen / 1

GLASS AND MIRROR

Invoice	Qty.	Description
2744 19May21 NoCat	1	MASTER ENSUITE: SQ6X6 - BRUSHED GOLD + HINGES
2744 19May21 NoCat	1	THRU OUT: PLEASE DO NOT INSTALL MIRRORS
2744 19May21 NoCat	2	ENSUITE 2 + ENSUITE 4: UPGRADE SHOWER DOOR HARDWARE AND HINGES TO MATTE BLACK

GRANITE MARBLE QUARTZ

Invoice	Qty.	Description
2744 19May21 NoCat	1	POWDER ROOM: UPGRADE 1 QUARTZ COUNTER
2744 19May21 NoCat	1	MASTER ENSUITE: UPGRADE QUARTZ TO SHOWER BENCH *only* UPGRADE 1 VANITY COUNTER TOPS TO BE STANDARD
2957 11Jan22 NoCat	1	**REVISED SELECTION: DECEMBER 20 2021** MASTER ENSUITE: CHANGE *BOTH* COUNTER TOP SELECTION TO 3CM LEVEL 6 QUARTZ + WATERFALL LEGS ON BOTH SIDES OF VANITIES
2957 11Jan22 NoCat	1	**REVISION** JAN 10 2022 (modify previous selection # 24 pe.2744) MASTER ENSUITE: CHANGE SHOWER JAMB AND BENCH TO BLACK in addition to price, item 24 pe.2744

HARDWOOD

Invoice	Qty.	Description
2744 4 19May21	1	KITCHEN/BREAKFAST: VINTAGE SERIES, 5" WHITE OAK, NSS ENGINEERED HARDWOOD, 3/4" THK, WIREBRUSH TEXTURE, UV OIL FINISH - LEVEL 3
2744 4 19May21	1	THRU OUT STD AREAS: LIBRARY, DINING ROOM, GREAT ROOM, UPPER HALL, MASTER BEDROOM, BEDROOM 2, BEDROOM 3, BEDROOM 4 - VINTAGE SERIES, 5" WHITE OAK, NSS ENGINEERED HARDWOOD, 3/4" THK, WIREBRUSH TEXTURE, UV OIL FINISH - LEVEL 3 NOT MAIN HALL
2744 4 19May21	1	KITCHEN/BREAKFAST/SERVERY: HARDWOOD IN HERRINGBONE PATTERN 5X30" HERRINGBONE



CONSTRUCTION SUMMARY

Lot: 85
Model: 50.04 C BEAUMONT
Project/Phase: Pine Valley Forevergreen / 1

HVAC

Invoice	Qty.	Description
2691 101,930 15Apr21	1	LOGGIA: SEE PLAN FOR PREFERRED ROUGH-IN BBQ LOCATION
2691 72,217 15Apr21	1	KITCHEN: UPGRADE TO 8" DUCT (EXTERIOR WALL) IN LIEU OF STANDARD OFFERING
2691 72,690 15Apr21 **	1	DELETE KITCHEN BULKHEAD, IF POSSIBLE, SITE APPROVAL REQUIRED
2691 15Apr21 NoCat	1	GREAT ROOM: UPGRADE MAIN FLOOR LINEAR 1 SIDED FIREPLACE - JADE SERIES 42" LINEAR DIRECT VENT GAS FIREPLACE IN LIEU OF STANDARD BOTTOM OF GLASS APPROX. 12" A.F.F. + ADD VENT GRILL APPROX. 6" FROM CEILING
2691 15Apr21 ** NoCat	1	DELETE KITCHEN BULKHEAD, IF POSSIBLE, SITE APPROVAL REQUIRED
2691 15Apr21 ** NoCat	1	DELETE KITCHEN BULKHEAD, IF POSSIBLE, SITE APPROVAL REQUIRED



CONSTRUCTION SUMMARY

Lot: 85
Model: 50.04 C BEAUMONT
Project/Phase: Pine Valley Forevergreen / 1

INTERIOR TRIM AND DOORS

Invoice	Qty.	Description
2691 15Apr21 NoCat	1	LIBRARY: DELETE TWO STANDARD OPENINGS AS PER PLAN - INSTALL FULL HEIGHT WALLS
2691 15Apr21 NoCat	1	**CUSTOM LAYOUT** MASTER ENSUITE: REVISE SIZE OF STANDARD VANITY TO ACCOMMODATE HIS AND HERS VANITIES - SEE PLAN
2691 15Apr21 NoCat	1	FYI - **CUSTOM LAYOUT** MASTER ENSUITE: DELETE STANDARD LINEN AS PER PLAN
2744 155,410 19May21	1	THRU OUT: UPGRADE INTERIOR DOORS TO LINCOLN PARK, UPGRADE
2744 153,836 19May21	1	THRU OUT: HALIFAX LEVER, IRON BLACK INTERIOR DOOR HARDWARE UPGRADE
2744 155,917 19May21	1	THRU OUT: ADD FOR HINGES 3X3 SQUARE FLAT TIP THROUGHOUT UPGRADE
2744 153,551 19May21	1	THRU OUT: UPGRADE 3 1/4" STEP BEVEL BB CASING, 7 1/4" BASE BOARD UPGRADE



CONSTRUCTION SUMMARY

Lot: 85
Model: 50.04 C BEAUMONT
Project/Phase: Pine Valley Forevergreen / 1

KITCHEN AND BATH CABINETRY

Invoice	Qty.	Description
2691 72,690 15Apr21 **	1	DELETE KITCHEN BULKHEAD, IF POSSIBLE, SITE APPROVAL REQUIRED
2691 101,930 15Apr21	1	**CUSTOM LAYOUT** MASTER ENSUITE: REVISE SIZE OF STANDARD VANITY TO ACCOMMODATE HIS AND HERS VANITIES - SEE PLAN
2691 101,930 15Apr21	1	**CUSTOM LAYOUT** MASTER ENSUITE: DELETE STANDARD LINEN AS PER PLAN
2691 15Apr21 NoCat	1	FYI - KITCHEN: UPGRADE TO 8" DUCT (EXTERIOR WALL) IN LIEU OF STANDARD OFFERING
2691 15Apr21 ** NoCat	1	DELETE KITCHEN BULKHEAD, IF POSSIBLE, SITE APPROVAL REQUIRED
2691 15Apr21 ** NoCat	1	DELETE KITCHEN BULKHEAD, IF POSSIBLE, SITE APPROVAL REQUIRED
2744 156,625 19May21	1	THRU OUT: SEE ATTACHED CABINETRY SCHEDULE

MASONRY

Invoice	Qty.	Description
2691 15Apr21 NoCat	1	FRONT EXTERIOR: ADDITIONAL EXTERIOR COACH LIGHT ON SAME SWITCH (BUILDERS STANDARD FIXTURE)
2691 15Apr21 NoCat	1	**CUSTOM LAYOUT** GARAGE: ADD MAN DOOR AT SIDE OF GARAGE - SEE PLAN

MISC.

Invoice	Qty.	Description
2957 11Jan22 NoCat	1	ADMIN FEE TO RE-OPEN FILE



CONSTRUCTION SUMMARY

Lot: 85
Model: 50.04 C BEAUMONT
Project/Phase: Pine Valley Forevergreen / 1

NETWORK AND WIRING

Invoice	Qty.	Description
2691 72,259 15Apr21	1	GREAT ROOM: CONDUIT PIPE - FOR WALL MOUNT TV - APPROX. 64" A.F.F. ABOVE FIREPLACE, THRU BASEMENT, TERMINATE AT CABLE LOCATION
2691 72,260 15Apr21	1	CONDUIT PIPE - FROM ATTIC TO BASEMENT - BY ELECTRICAL PANEL IN BASEMENT TO APPROX. CENTRE IN ATTIC
2691 72,264 15Apr21	1	LAUNDRY ROOM: ROUGH - IN FOR EXTRA SECURITY KEY PAD
2691 72,264 15Apr21	1	MUD ROOM: ROUGH - IN FOR EXTRA SECURITY KEY PAD
2691 72,265 15Apr21	1	GREAT ROOM: ROUGH - IN WIRING FOR FIVE SPEAKERS
2691 72,265 15Apr21	1	MASTER ENSUITE: ROUGH - IN WIRING FOR ONE PAIR OF SPEAKERS - SEE PLAN FOR LOCATION
2691 72,265 15Apr21	1	KITCHEN: ROUGH - IN WIRING FOR ONE PAIR OF SPEAKERS - SEE PLAN FOR LOCATION
2691 72,265 15Apr21	1	LOGGIA: ROUGH - IN WIRING FOR ONE PAIR OF SPEAKERS - SEE PLAN FOR LOCATION
2691 72,258 15Apr21	5	EXTERIOR: ADDITIONAL CAT6 ETHERNET OUTLET - FOR FUTURE SECURITY CAMERAS - INSTALL IN THE UNDERSIDE OF SOFFIT OF FIRST FLOOR - APPROX. 10-12' ABOVE GRADE - SEE PLAN
2691 72,258 15Apr21	1	FRONT EXTERIOR: ADDITIONAL CAT6 ETHERNET OUTLET - FOR FUTURE SECURITY CAMERA - INSTALL IN THE UNDERSIDE OF SOFFIT AT GARAGE - SEE PLAN
2691 72,258 15Apr21	1	GREAT ROOM: ADDITIONAL CAT6 ETHERNET OUTLET - EACH - SEE PLAN
2691 72,258 15Apr21	1	LIBRARY: ADDITIONAL CAT6 ETHERNET OUTLET - EACH - SEE PLAN
2691 72,258 15Apr21	4	MASTER BEDROOM + BEDROOM 2 + BEDROOM 3 + BEDROOM 4: ADDITIONAL CAT6 ETHERNET OUTLET - EACH - SEE PLAN



CONSTRUCTION SUMMARY

Lot: 85
Model: 50.04 C BEAUMONT
Project/Phase: Pine Valley Forevergreen / 1

NETWORK AND WIRING

Invoice	Qty.	Description
2691 72,258 15Apr21	3	BEDROOM 2 + BEDROOM 3 + BEDROOM 4: ADDITIONAL RG6 - EACH - SEE PLAN

PAINT

Invoice	Qty.	Description
2691 15Apr21 NoCat	1	LIBRARY: DELETE TWO STANDARD OPENINGS AS PER PLAN - INSTALL FULL HEIGHT WALLS
2691 15Apr21 NoCat	1	**CUSTOM LAYOUT** GARAGE: ADD MAN DOOR AT SIDE OF GARAGE - SEE PLAN
2691 15Apr21 NoCat	1	**CUSTOM LAYOUT** MASTER ENSUITE: REVISE SIZE OF STANDARD VANITY TO ACCOMMODATE HIS AND HERS VANITIES - SEE PLAN
2691 15Apr21 NoCat	1	FYI -**CUSTOM LAYOUT** MASTER ENSUITE: DELETE STANDARD LINEN AS PER PLAN
2744 100,309 19May21	2	MAIN STAIRS: 2ND FLOOR TO BASEMENT - STAIN STAIRS AND LANDINGS WILL NOT MATCH HARDWOOD IN COLOUR, SPECIES OR TEXTURE

PAINTING

Invoice	Qty.	Description
2691 72,690 15Apr21 **	1	DELETE KITCHEN BULKHEAD, IF POSSIBLE, SITE APPROVAL REQUIRED
2691 15Apr21 ** NoCat	1	DELETE KITCHEN BULKHEAD, IF POSSIBLE, SITE APPROVAL REQUIRED
2691 15Apr21 ** NoCat	1	DELETE KITCHEN BULKHEAD, IF POSSIBLE, SITE APPROVAL REQUIRED
2957 11Jan22 NoCat	1	**REVISED SELECTION - DECEMBER 20 2021** MAIN STAIRS - CHANGE STAIR STAIN COLOUR IN LIEU OF PREVIOUS SELECTION



CONSTRUCTION SUMMARY

Lot: 85
Model: 50.04 C BEAUMONT
Project/Phase: Pine Valley Forevergreen / 1

PANL - FRAMING

Invoice	Qty.	Description
2691 72,690 15Apr21 **	1	DELETE KITCHEN BULKHEAD, IF POSSIBLE, SITE APPROVAL REQUIRED
2691 15Apr21 ** NoCat	1	DELETE KITCHEN BULKHEAD, IF POSSIBLE, SITE APPROVAL REQUIRED
2691 15Apr21 ** NoCat	1	DELETE KITCHEN BULKHEAD, IF POSSIBLE, SITE APPROVAL REQUIRED

PLUMBING

Invoice	Qty.	Description
2744 19May21 NoCat	1	POWDER ROOM: UPGRADE TO 'EMERY' BLACK RECTANGULAR UNDER MOUNT SINK

PLUMBING FIXTURE

Invoice	Qty.	Description
2691 75,857 15Apr21	1	MASTER ENSUITE: ADD MOEN ALIGN RAIN SHOWER FROM CEILING - CHROME - IN ADDITION TO STANDARD STANDARD SHOWER FAUCET TO REMAIN

STAIR AND RAILINGS

Invoice	Qty.	Description
2744 100,252 19May21	1	MAIN STAIRS: ADD FOR GLASS PANEL IN LIEU OF PICKETS - UPG - GLASS PANEL

WINDOWS AND DOORS

Invoice	Qty.	Description
2691 72,364 15Apr21	1	**CUSTOM LAYOUT** GARAGE: ADD MAN DOOR AT SIDE OF GARAGE - SEE PLAN GRADE PERMITTING

*** NOTE: This is not an approved document. Document must be locked ***

Scheduled Closing Date: Thursday, November 25, 2021

Purchasers: LAURA, GIUSEPPINA PELOSO & ANTHONY, AI Property: 85 of Plan -

Telephone Res. / Bus: (416) 669-8574 / (416) 669-8574

Project: Pine Valley Forevergreen - Phase 1

Decor Advisor: Amanda Ceresino

Model and Elevation: 50.04 C BEAUMONT

Layout Changes: ☐ Yes ☒ No Sketch Attached: ☒ Yes ☐ No Exterior Colour Scheme:

1. Cabinetry

	Style and Colour	Counter	Hardware
Kitchen / Breakfast	Chesapeake 'Classic White'	Granite: Arctic White	attached
Laundry Room	Bowery 'Capri'	P-Lam: White	attached
Powder Room	Bowery 'Capri'	*Quartz: Jet Black	attached
Mud Room	Tribeca 'Arris'	P-Lam: White	attached
Master Ensuite Bathroom	Bowery 'Capri'	Quartz: Ice Snow * ETERNAL NOISE + WATERFALL - 3CM.	attached
Second Ensuite Bathroom (If Applicable)	Bowery 'Capri'	Quartz: Ice Snow	attached
Ensuite 3	Tribeca 'Arris'	Quartz: Ice Snow	attached

Comment

Ensuite 4: Bowery 'Ello' + Ice Snow // MASTER ENSUITE SHOWER BENCH: *QUARTZ: JET BLACK

← MASTER ENSUITE SHOWER BENCH + JAMB "BLACK" JET BLACK JAN 20, 2022

REVISED: JAN 10 2022.

attached

2. Floor Tile

	Selection
Entrance Vestibule	*30x30" Marmorea 'Port Laurent' matte + see grout attached charcoal
Main Hall	*30x30" Marmorea 'Port Laurent' matte + see grout attached charcoal
Kitchen / Breakfast	see hwd
Laundry Room	13x13" Costa 'White'
Powder Room	*12x24" Marmorea 'Port Laurent' matte + see grout attached charcoal
Mud Room	*12x24" Marmorea 'Port Laurent' matte + see grout attached charcoal
Master Ensuite Bathroom	*30x30" Marmorea 'Port Laurent' matte + see grout attached charcoal
Second Ensuite Bathroom (If Applicable)	13x13" Costa 'White'
Lower Landing (If Applicable)	13x13" Costa 'White' (basement foyer)
Ensuite 3	13x13" Costa 'White'

Comment

Ensuite 4: 13x13" Cambridge 'White' // Shower Floor tile: std 2x2" white for ensuite 2/3/4 // Master Ensuite Shower floor: *2" Ont matte black

1x1" Basic Black matte hex + charcoal grout

3. Wall Tile

	Selection	Listello/Inserts	Describe
Ensuite 3	8x10: Weave 'White'	☐ Yes ☒ No	
Master Ensuite Bathroom			
Tub Deck		☐ Yes ☒ No	
Shower Stall	*12X24" Marmorea mt 'P.Laurent'	☐ Yes ☒ No	
Bathroom Walls		☐ Yes ☒ No	
Second Ensuite Bathroom (If Applicable)	8x10" Uniwall 'White'	☐ Yes ☒ No	
Ensuite 4	8x10" Uniwall 'White'	☐ Yes ☒ No	
Kitchen Backsplash	☐ Yes ☒ No	Backsplash Behind Fridge	

Comment

* REVISED - DEC 15 2021 AJ JP

REVISED MAY 5 2021

attached

Scheduled Closing Date: Thursday, November 25, 2021

Purchasers: LAURA, GIUSEPPINA PELOSO & ANTHONY, AI Property: 85 of Plan -

Telephone Res. / Bus: (416) 669-8574 / (416) 669-8574

Project: Pine Valley Forevergreen - Phase 1

Decor Advisor: Amanda Ceresino

Model and Elevation: 50.04 C BEAUMONT

4. Plumbing Fixtures

Master Ensuite Bathroom Second Ensuite Powder Room
Other Room - Specify Other Washroom

Comment

upgraded thru out - see extras

5. Hardwood Flooring

	Type and Stain		Type and Stain
Main Hall		Upper Landing	
Kitchen / Breakfast	3/4x5" wht oak wirebrush 'Atlantis'	Upper Hall	
Living Room		Master Bedroom	
Dining Room		Bedroom #2	
Family Room		Bedroom #3	
Den/Library		Bedroom #4	
Entrance Vestibule		Bedroom #5	
Lower Landing (If Applicable)		Other Room - Specify	
		thru out standard areas	3/4x5" wht oak wirebrush 'Atlantis'

Comment

5x30" HERRINGBONE IN KITCHEN/BREAKFAST/SERVERY

6. Carpeting

	Upgrade	Description
Ground Floor	☐	
Second Floor	☐	
	☐	

	Type	Area
Upgrade Underpad		
Carpet on Stairs	Capped	Runner - *Upgrade

Comment

7. Fireplace

	Living Room			Family Room			Other Room - Specify		
	Purchased	As Per Plan	N/A	Purchased	As Per Plan	N/A	Purchased	As Per Plan	N/A
Fireplace Type	☐	☐	☐	☐	☒	☐	☐	☐	☐
Mantle Type				Linear					
Colour / Stain				None					
Surround				N/A					
Hearth				N/A					
				None					

Comment

REVISED: Jan 10 2022 attached

attached

*** NOTE: This is not an approved document. Document must be locked ***

Scheduled Closing Date: Thursday, November 25, 2021

Purchasers: LAURA, GIUSEPPINA PELOSO & ANTHONY, AI Property: 85 of Plan -

Telephone Res. / Bus: (416) 669-8574 / (416) 669-8574

Project: Pine Valley Forevergreen - Phase 1

Decor Advisor: Amanda Ceresino

Model and Elevation: 50.04 C BEAUMONT

8. Trim Carpentry

Interior Doors Front Door Glass Inserts Door Handles Interior Trim

Comment

9. Plaster Mouldings and Medallions

Standard Throughout ☐ Yes ☐ No ☐ N/A

Entrance Vestibule			Kitchen/Breakfast		
Main Hall			Den/Library		
Living Room			Lower Landing		
Dining Room			Other Room - Specify		
Family Room					

Comment

10. Railings and Spindles

Railing Package Railing Colour Stringer / Riser Spindle Colour Treads Oak Stairs ☒ Yes ☐ No ☐ N/A

Comment

11. Wall Paint / Ceilings

Throughout Finished Areas Trim Paint

Smooth Ceilings

Ground Floor ☒Second Floor ☒Note

Comment

REUSED: Jan 10 2022 attached

attached

*** NOTE: This is not an approved document. Document must be locked ***

Scheduled Closing Date: Thursday, November 25, 2021

Purchasers: LAURA, GIUSEPPINA PELOSO & ANTHONY, AI Property: 85 of Plan -

Telephone Res. / Bus: (416) 669-8574 / (416) 669-8574

Project: Pine Valley Forevergreen - Phase 1

Decor Advisor: Amanda Ceresino

Model and Elevation: 50.04 C BEAUMONT

12. Electrical

Hood Fan ☐ White ☐ Stainless ☐ N/AAbove Kitchen Cabinet Light ☐ Yes ☒ NoBelow Kitchen Cabinet Light ☐ Yes ☒ NoStandard Appliances ☐Over The Range Microwave ☐Chimney Style Fan ☐

Comment

13. Heating and Air Conditioning

Air Conditioning

Gas Provisions Stove

Gas Provisions Dryer

Gas Provisions Barbecue

Comment

14. Additional Comments

15. Disclaimers and Notes

- 1) Colours of all materials are as close as possible to builder's selection, but not necessarily identical due to variances in manufacturing.
- 2) Any extras listed above are null and void unless accompanied by a separate invoice/amendment. Said invoice must be paid in full.
- 3) The Purchaser acknowledges that after Interior Colour Selection form is signed and dated, no further changes will be permitted other than re-selection due to unavailability. _____ Purchaser's Initials
- 4) The Purchaser acknowledges reading and accepting the "Gold Park Homes Decor Centre Disclaimers" form. This document contains other miscellaneous disclaimers.

This Interior Colour Selection is final and approved by:

Signature: attachedDate: attached

REVISED: JAN 10 2022

*** NOTE: This is not an approved document. Document must be locked ***

Scheduled Closing Date: Thursday, November 25, 2021

Purchasers: LAURA, GIUSEPPINA PELOSO & ANTHONY, AI Property: 85 of Plan -

Telephone Res. / Bus: (416) 669-8574 / (416) 669-8574

Project: Pine Valley Forevergreen - Phase 1

Decor Advisor: Amanda Ceresino

Model and Elevation: 50.04 C BEAUMONT

Layout Changes: ☐ Yes ☒ No

Sketch Attached: ☒ Yes ☐ No

Exterior Colour Scheme:

1. Cabinetry

	Style and Colour	Counter	Hardware
Kitchen / Breakfast	Chesapeake 'Classic White'	Granite: Arctic White	attachd
Laundry Room	Bowery 'Capri'	P-Lam: White	attachd
Powder Room	Bowery 'Capri'	*Quartz: Jet Black	attachd
Mud Room	Tribeca 'Arris'	P-Lam: White	attachd
Master Ensuite Bathroom	Bowery 'Capri'	Quartz: Ice Snow * F. EKNA NOISE + WATERFALL - 3CM	attachd
Second Ensuite Bathroom (If Applicable)	Bowery 'Capri'	Quartz: Ice Snow	attachd
Ensuite 3	Tribeca 'Arris'	Quartz: Ice Snow	attachd

Comment

Ensuite 4: Bowery 'Elio' + Ice Snow // MASTER ENSUITE SHOWER BENCH: *QUARTZ: JET BLACK

↳ MASTER ENSUITE SHOWER BENCH + JALUS "BLACK"

REVISED: JAN 10 2022

AA JP

2. Floor Tile

	Selection
Entrance Vestibule	*30x30" Marmorea 'Port Laurent' matte + see grout attached charcoal
Main Hall	*30x30" Marmorea 'Port Laurent' matte + see grout attached charcoal
Kitchen / Breakfast	see hdwd
Laundry Room	13x13" Costa 'White'
Powder Room	*12x24" Marmorea 'Port Laurent' matte + see grout attached charcoal
Mud Room	*12x24" Marmorea 'Port Laurent' matte + see grout attached charcoal
Master Ensuite Bathroom	*30x30" Marmorea 'Port Laurent' matte + see grout attached charcoal
Second Ensuite Bathroom (If Applicable)	13x13" Costa 'White'
Lower Landing (If Applicable)	13x13" Costa 'White' (basement foyer)
Ensuite 3	13x13" Costa 'White'

Comment

Ensuite 4: 13x13" Cambridge 'White' // Shower Floor tile: std 2x2" white for ensuite 2/3/4 // Master Ensuite Shower floor: *2" Ont matte black

1x1" Basic Black matte hex + charcoal grout

3. Wall Tile

	Selection	Listello/Inserts	Describe
Ensuite 3	8x10: Weave 'White'	☐ Yes ☒ No	
Master Ensuite Bathroom			
Tub Deck		☐ Yes ☒ No	
Shower Stall	*12X24" Marmorea mt 'P.Laurent'	☐ Yes ☒ No	
Bathroom Walls		☐ Yes ☒ No	
Second Ensuite Bathroom (If Applicable)	8x10" Uniwall 'White'	☐ Yes ☒ No	
Ensuite 4	8x10" Uniwall 'White'	☐ Yes ☒ No	
Kitchen Backsplash	☐ Yes ☒ No		Backsplash Behind Fridge

Comment

* REVISED - DEC 15 2021 AA JP

REVISED MAY 5 2021 attached

GOLDPARK
WORTH MORE

INTERIOR COLOUR SCHEME

*** NOTE: This is not an approved document. Document must be locked ***

Scheduled Closing Date: Thursday, November 25, 2021

Purchasers: LAURA, GIUSEPPINA PELOSO & ANTHONY, At Property: 85 of Plan -

Telephone Res. / Bus: (416) 669-8574 / (416) 669-8574

Project: Pine Valley Forevergreen - Phase 1

Decor Advisor: Amanda Ceresino

Model and Elevation: 50.04 C BEAUMONT

4. Plumbing Fixtures

Master Ensuite Bathroom ☐ Second Ensuite ☐ Powder Room ☐
Other Room - Specify ☐ Other Washroom ☐

Comment

upgraded thru out - see extras

5. Hardwood Flooring

	Type and Stain		Type and Stain
Main Hall		Upper Landing	
Kitchen / Breakfast	3/4x5" wht oak wirebrush 'Atlantis'	Upper Hall	
Living Room		Master Bedroom	
Dining Room		Bedroom #2	
Family Room		Bedroom #3	
Den/Library		Bedroom #4	
Entrance Vestibule		Bedroom #5	
Lower Landing (If Applicable)		Other Room - Specify	
		thru out standard areas	3/4x5" wht oak wirebrush 'Atlantis'

Comment

"5x30" HERRINGBONE IN KITCHEN/BREAKFAST/SERVERY"

6. Carpeting

	Upgrade	Description
Ground Floor	☐	
Second Floor	☐	

Upgrade Underpad

Type

Area

Carpet on Stairs

Capped

Runner - *Upgrade

Comment

7. Fireplace

	Living Room			Family Room			Other Room - Specify		
	Purchased	As Per Plan	N/A	Purchased	As Per Plan	N/A	Purchased	As Per Plan	N/A
Fireplace Type	☐	☐	☐	☐	☒	☐	☐	☐	☐
Mantle Type				Linear					
Colour / Stain				None					
Surround				N/A					
Hearth				N/A					

Comment

REVISED: JAN 10 2022

attached

GOLDPARK

WORTH MORE

INTERIOR COLOUR SCHEME

*** NOTE: This is not an approved document. Document must be locked ***

Scheduled Closing Date: Thursday, November 25, 2021

Purchasers: LAURA, GIUSEPPINA PELOSO & ANTHONY, AI Property: 85 of Plan -

Telephone Res. / Bus: (416) 669-8574 / (416) 669-8574

Project: Pine Valley Forevergreen - Phase 1

Decor Advisor: Amanda Ceresino

Model and Elevation: 50.04 C BEAUMONT

8. Trim Carpentry

Interior Doors Lincoln Park

Front Door Glass Inserts Standard

Door Handles: Halifax blk + hng

Interior Trim Board 6

Comment

9. Plaster Mouldings and Medallions

Standard Throughout ☐ Yes ☐ No ☐ N/A

Entrance Vestibule

Main Hall

Living Room

Dining Room

Family Room

Kitchen/Breakfast

Den/Library

Lower Landing

Other Room - Specify

Comment

10. Railings and Spindles

Railing Package Glass Railing

Railing Colour Vintage-Tahiti

Stringer / Riser Vintage-Tahiti

Spindle Colour Glass

Treads

Oak Stairs

Vintage-Tahiti

☒ Yes ☐ No ☐ N/A

Comment

11. Wall Paint / Ceilings

Throughout Finished Areas Cool White

Trim Paint White

Smooth Ceilings

Ground Floor

Second Floor

Note

Comment

Purchasers: LAURA, GIUSEPPINA PELOSO & ANTHONY, AI Property: 85 of Plan -

Telephone Res. / Bus: (416) 669-8574 / (416) 669-8574

Project: Pine Valley Forevergreen - Phase 1

Decor Advisor: Amanda Ceresino

Model and Elevation: 50.04 C BEAUMONT

12. Electrical

Hood Fan ☐ White ☐ Stainless ☐ N/A

Above Kitchen Cabinet Light ☐ Yes ☒ No

Standard Appliances ☐

Below Kitchen Cabinet Light ☐ Yes ☒ No

Over The Range Microwave ☐

Chimney Style Fan ☐

Comment

13. Heating and Air Conditioning

Air Conditioning

Gas Provisions Stove

Gas Provisions Dryer

Gas Provisions Barbecue

Comment

14. Additional Comments

15. Disclaimers and Notes

- 1) Colours of all materials are as close as possible to builder's selection, but not necessarily identical due to variances in manufacturing.
- 2) Any extras listed above are null and void unless accompanied by a separate invoice/amendment. Said invoice must be paid in full.
- 3) The Purchaser acknowledges that after Interior Colour Selection form is signed and dated, no further changes will be permitted other than re-selection due to unavailability. _____ Purchaser's Initials
- 4) The Purchaser acknowledges reading and accepting the "Gold Park Homes Decor Centre Disclaimers" form. This document contains other miscellaneous disclaimers.

This Interior Colour Selection is final and approved by:

Signature: attached Date: _____

RECEIVED: JAN 10 2022 JP

PV - 85 Cabinetry Schedule

ROOM	DESCRIPTION	PRICE	QTY	TOTAL
POWDER ROOM	CONVERT STANDARD VANITY TO FLOATING VANITY NOTE: NO PANEL PURCHASED TO COVER PLUMING, MAY HAVE PIPES EXPOSED NOTE: NO HARDWARE / NO HOLES		1	
KITCHEN	ADJUST CABINETRY FOR 36" RANGE (N/C) LEAVE 42" SPACE IN UPPER CABINETS ABOVE RANGE (N/C) NOTE: NO HARDWARE / NO HOLES NOTE: PURCHASERS HAVE REMOVED THE BULKHEAD AND HAVE NOT PURCHASED ANY ADDITIONAL CABINETRY, THERE WILL BE A GAP TO THE CEILING	- - - - -	1 1 1 1 1	
CABINETRY TOTAL:				

HANDLE PLACEMENT: AT INSTALLERS DISCRETION

LOT #: PV-85

DATE: May 4, 2021

SIGNATURE: 

SIGNATURE: Laura Peloso



LEGEND:

- ⑥ - EXTERIOR CAT6 LOCATE APPROX 10-12' ABOVE GRADE.
- ⑤ - SPEAKER WIRE
- Ⓢ - GFI

SCHEDULE 'F'

PV-85 ~~attached~~
March 15, 2021


PV-85 ~~attached~~
April 13, 2021

PV-85 ~~attached~~
May 3, 2021

The Beaumont

50' SERIES

Elevation A • 4,170 sq.ft.
4,315 sq.ft. Opt. Elevator
Elevation B • 4,165 sq.ft.
4,315 sq.ft. Opt. Elevator
Elevation C • 4,250 sq.ft.
4,400 sq.ft. Opt. Elevator

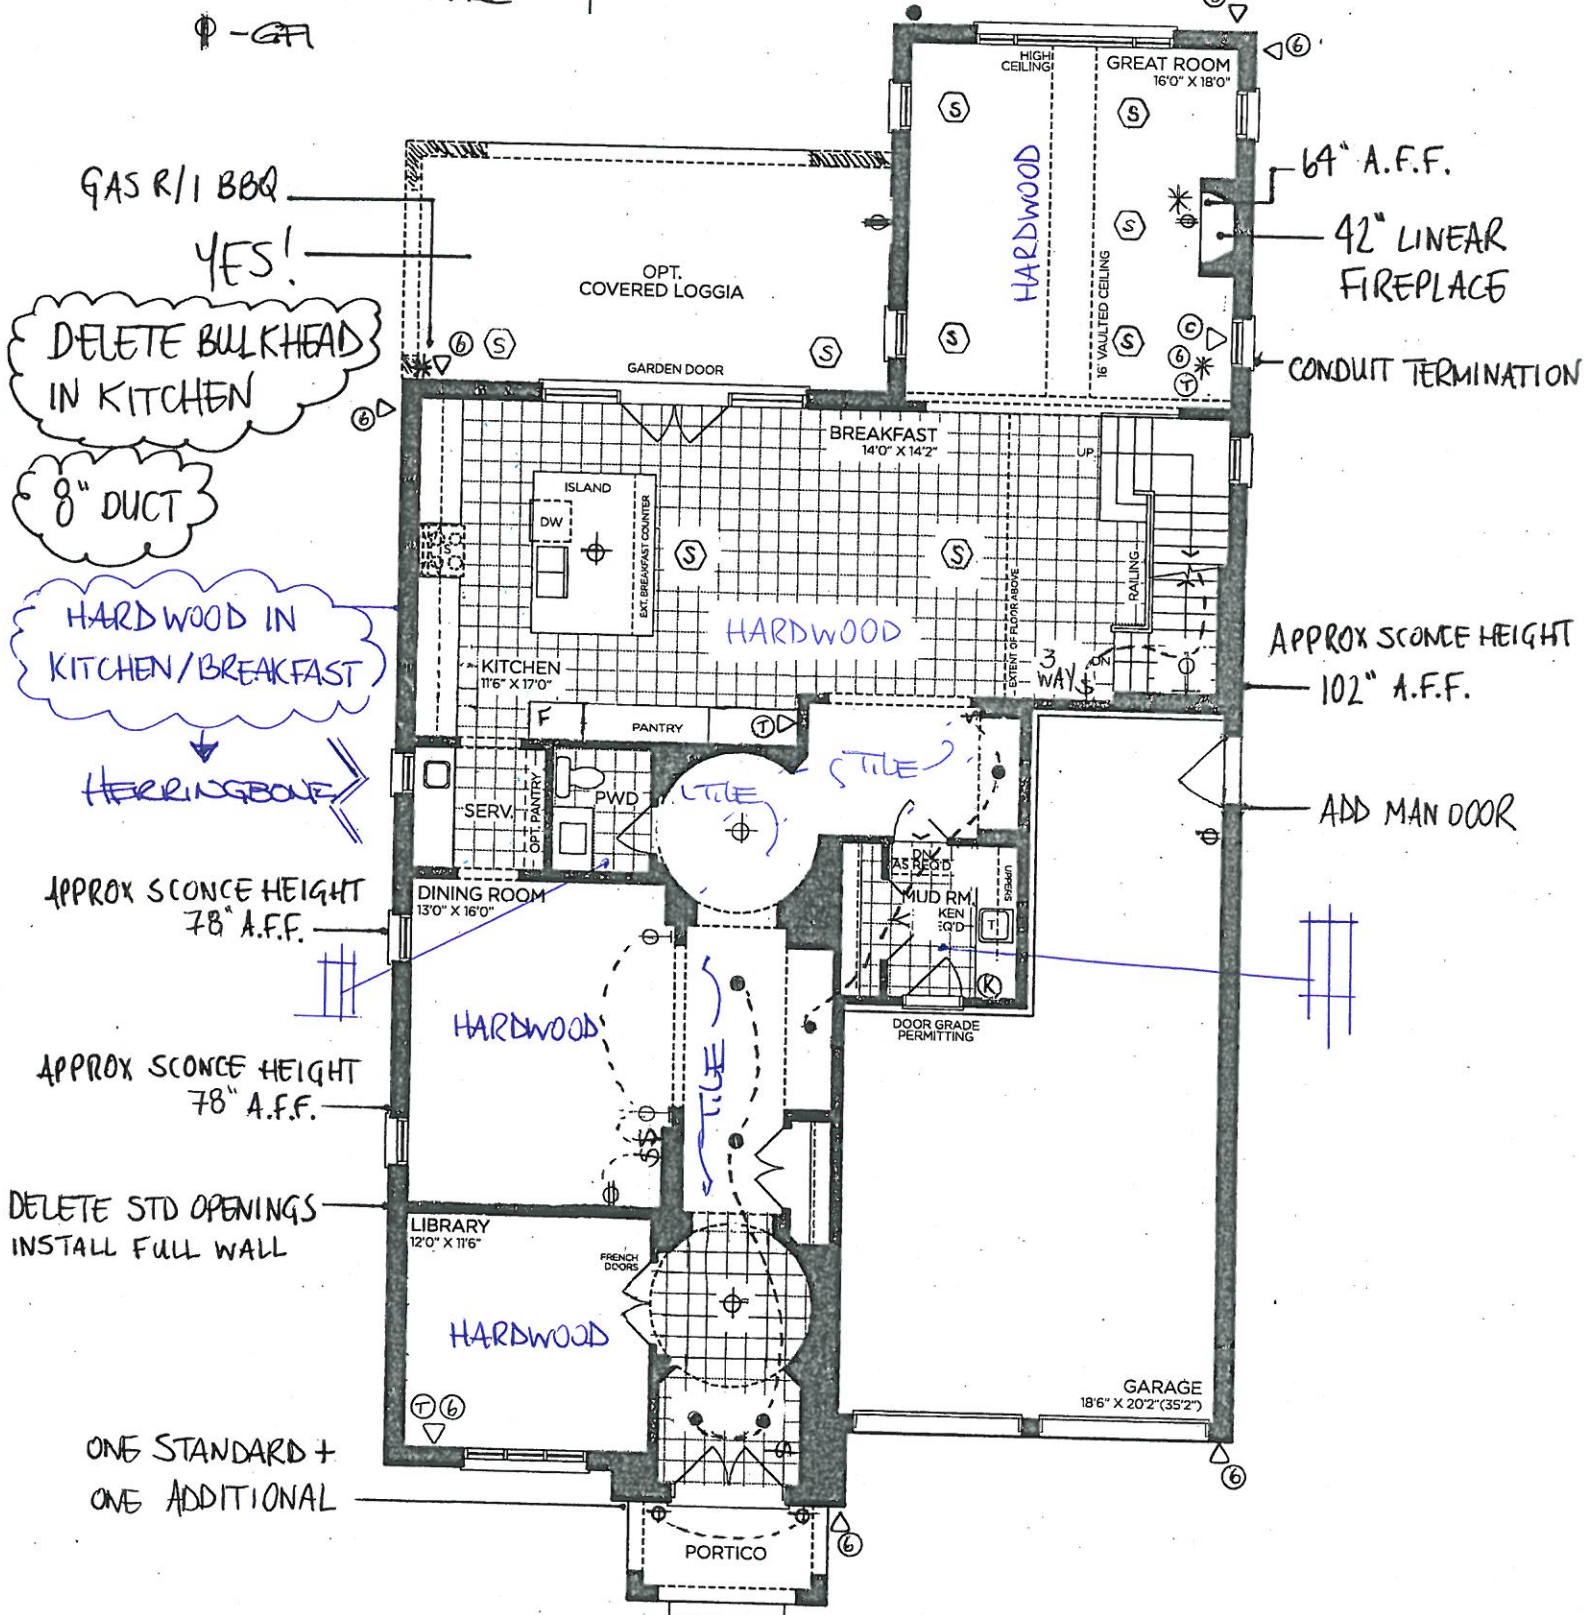

GROUND FLOOR | ELEV. A

VENDOR	
PURCHASER	
PURCHASER	

GOLDPARK
WORTH MORE™

Prices, figures, illustrations, sizes, features and finishes are subject to change without notice. Areas and dimensions are approximate and actual usable floor space may vary from the stated area. Layout may be reverse of the unit purchased. E. & O.E. 5004

SCHEDULE 'F'




PV-85 attached
March 15, 2021
PV-85 attached
April 13, 2021
PV-85 AP
May 3, 2021

The Beaumont

50' SERIES

Elevation A • 4,170 sq.ft.
4,315 sq.ft. Opt. Elevator
Elevation B • 4,165 sq.ft.
4,315 sq.ft. Opt. Elevator
Elevation C • 4,250 sq.ft.
4,400 sq.ft. Opt. Elevator

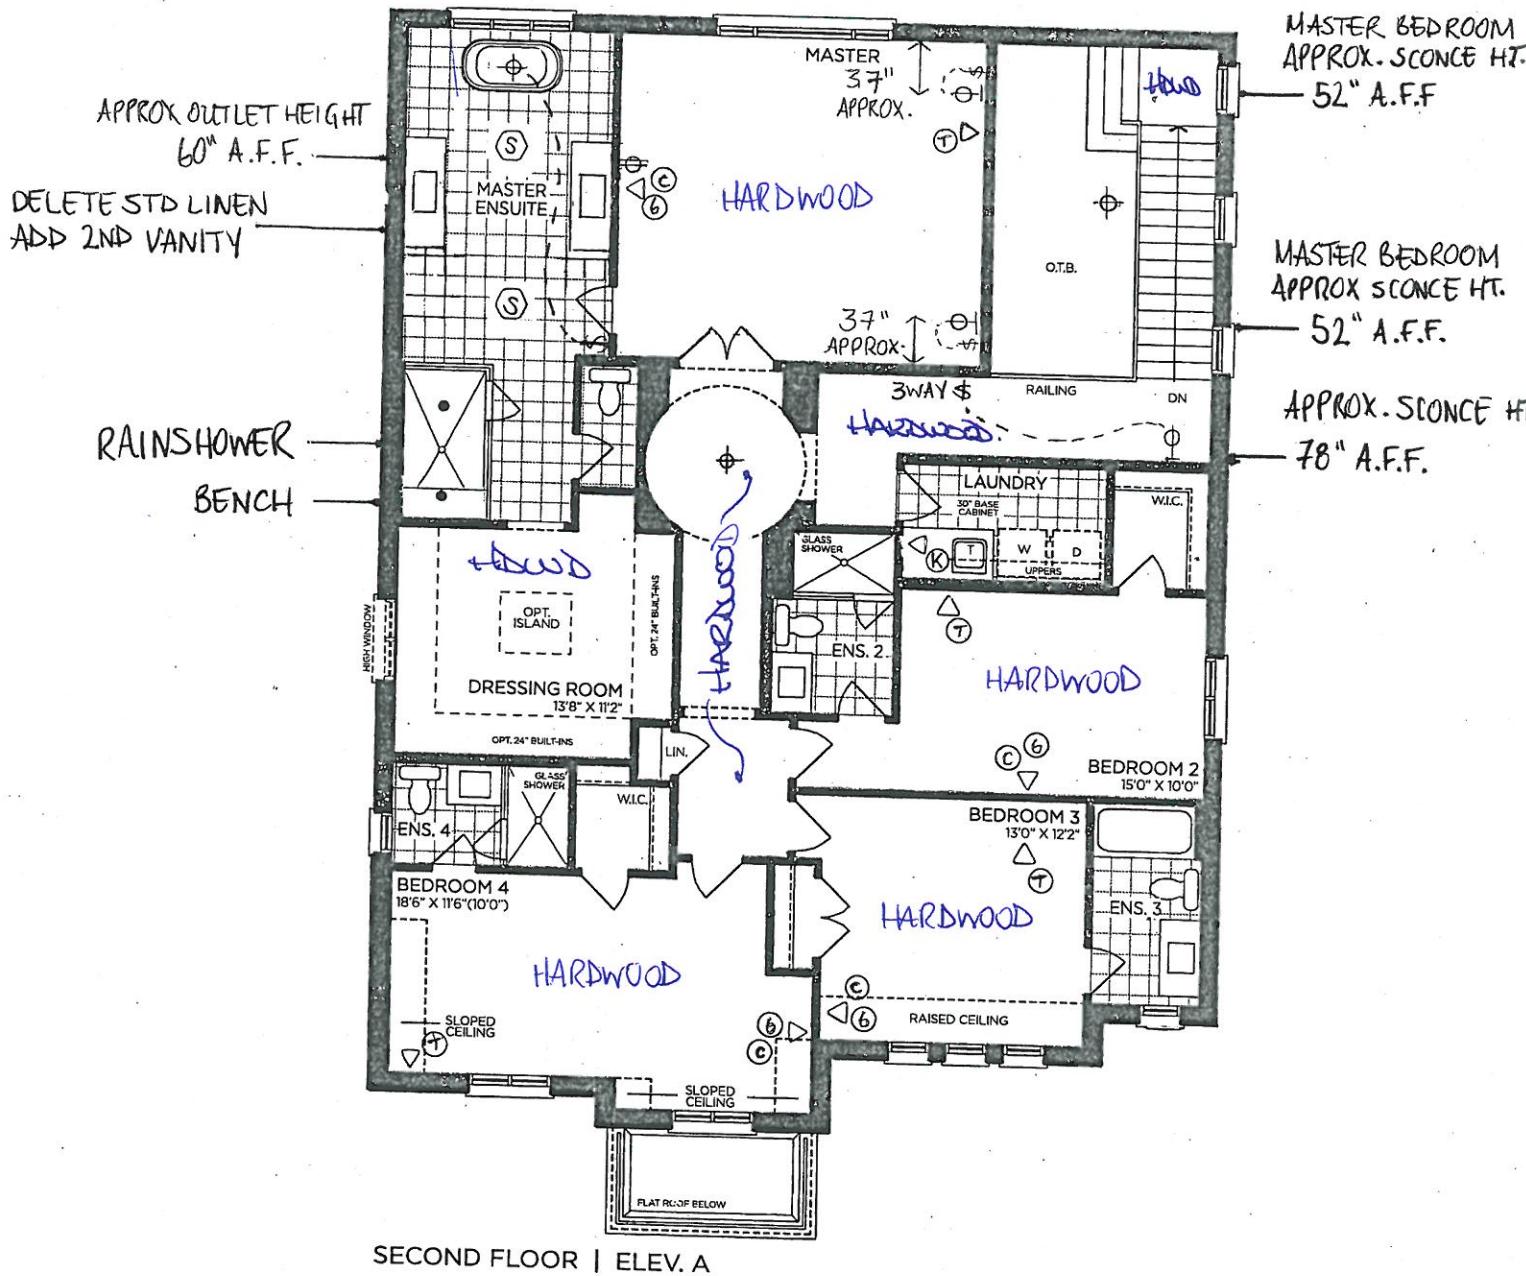

VENDOR

PURCHASER

PURCHASER

GOLDPARK
WORTH MORE™

Prices, figures, illustrations, sizes, features and finishes are subject to change without notice. Areas and dimensions are approximate and actual usable floor space may vary from the stated area. Layout may be reverse of the unit purchased. E. & O.E. 5004




SCHEDULE 'F'

PV-85 ~~attached~~
April 13, 2021
PV-85 ~~AP~~
May 3, 2021


The Beaumont

50' SERIES


Elevation A • 4,170 sq.ft.
4,315 sq.ft. Opt. Elevator
Elevation B • 4,165 sq.ft.
4,315 sq.ft. Opt. Elevator
Elevation C • 4,250 sq.ft.
4,400 sq.ft. Opt. Elevator

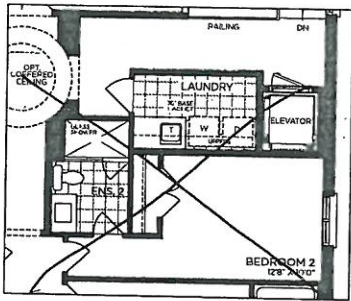


OPT. PART. SECOND FLOOR | ELEV. A
(ELEVATOR)

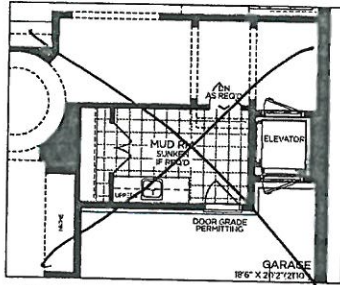


OPT. GROUND FLOOR | ELEV. A
(ELEVATOR)

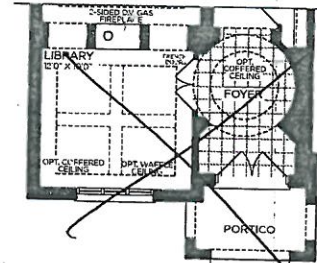


PART. OPT. LIBRARY GROUND FLOOR
ELEV. A, B & C

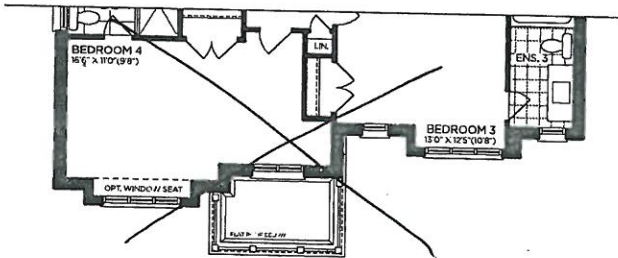


PART. OPT. SECOND FLOOR | ELEV. B
5 BEDROOM

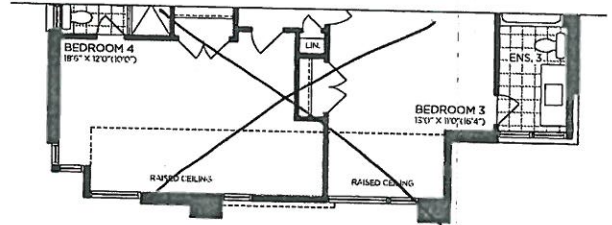


PART. OPT. SECOND FLOOR | ELEV. C
5 BEDROOM

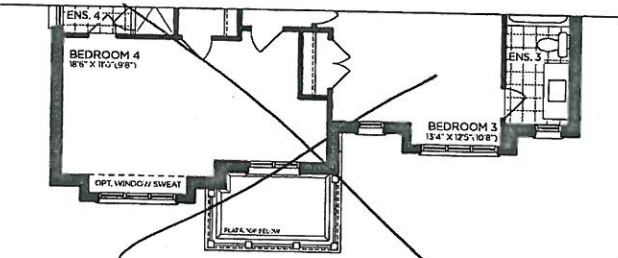


PART. SECOND FLOOR | ELEV. B

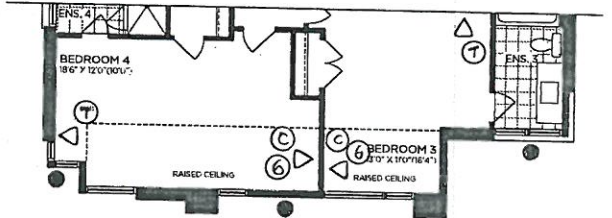


PART. SECOND FLOOR | ELEV. C

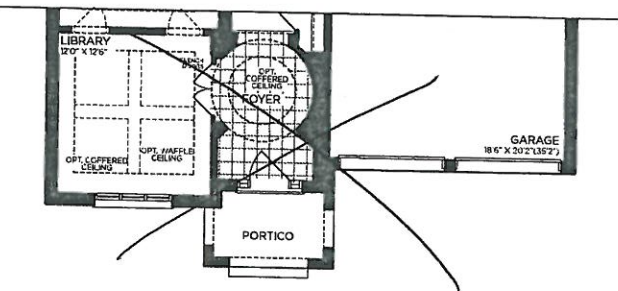


PART. GROUND FLOOR | ELEV. B

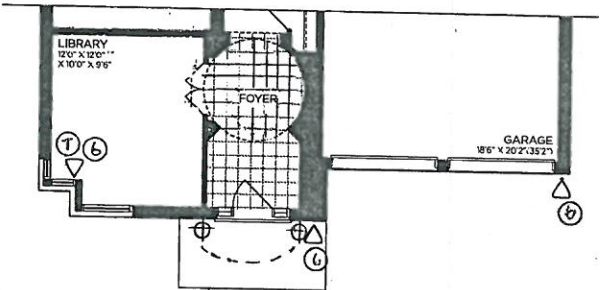


PART. GROUND FLOOR | ELEV. C

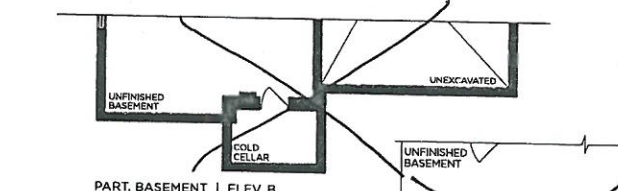

PART. BASEMENT | ELEV. B

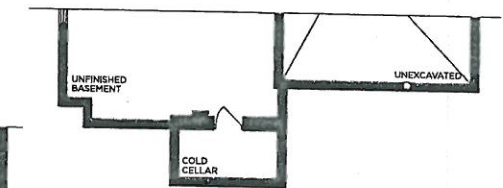

PART. BASEMENT | ELEV. C

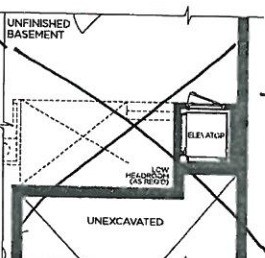

OPT. BASEMENT | ELEV. A
(ELEVATOR)

VENDOR
PURCHASER
PURCHASER

GOLDPARK
WORTH MORE™

Prices, figures, illustrations, sizes, features and finishes are subject to change without notice. Areas and dimensions are approximate and actual usable floor space may vary from the stated area. Layout may be reverse of the unit purchased. E. & O.E. 5004



SCHEDULE 'F'

PV-85 attached
March 15, 2021


PV-85 attached
April 13, 2021

PV-85 ~~NA~~ ~~PP~~
May 3, 2021

The Beaumont

50' SERIES

Elevation A • 4,170 sq.ft.
4,315 sq.ft. Opt. Elevator
Elevation B • 4,165 sq.ft.
4,315 sq.ft. Opt. Elevator
Elevation C • 4,250 sq.ft.
4,400 sq.ft. Opt. Elevator

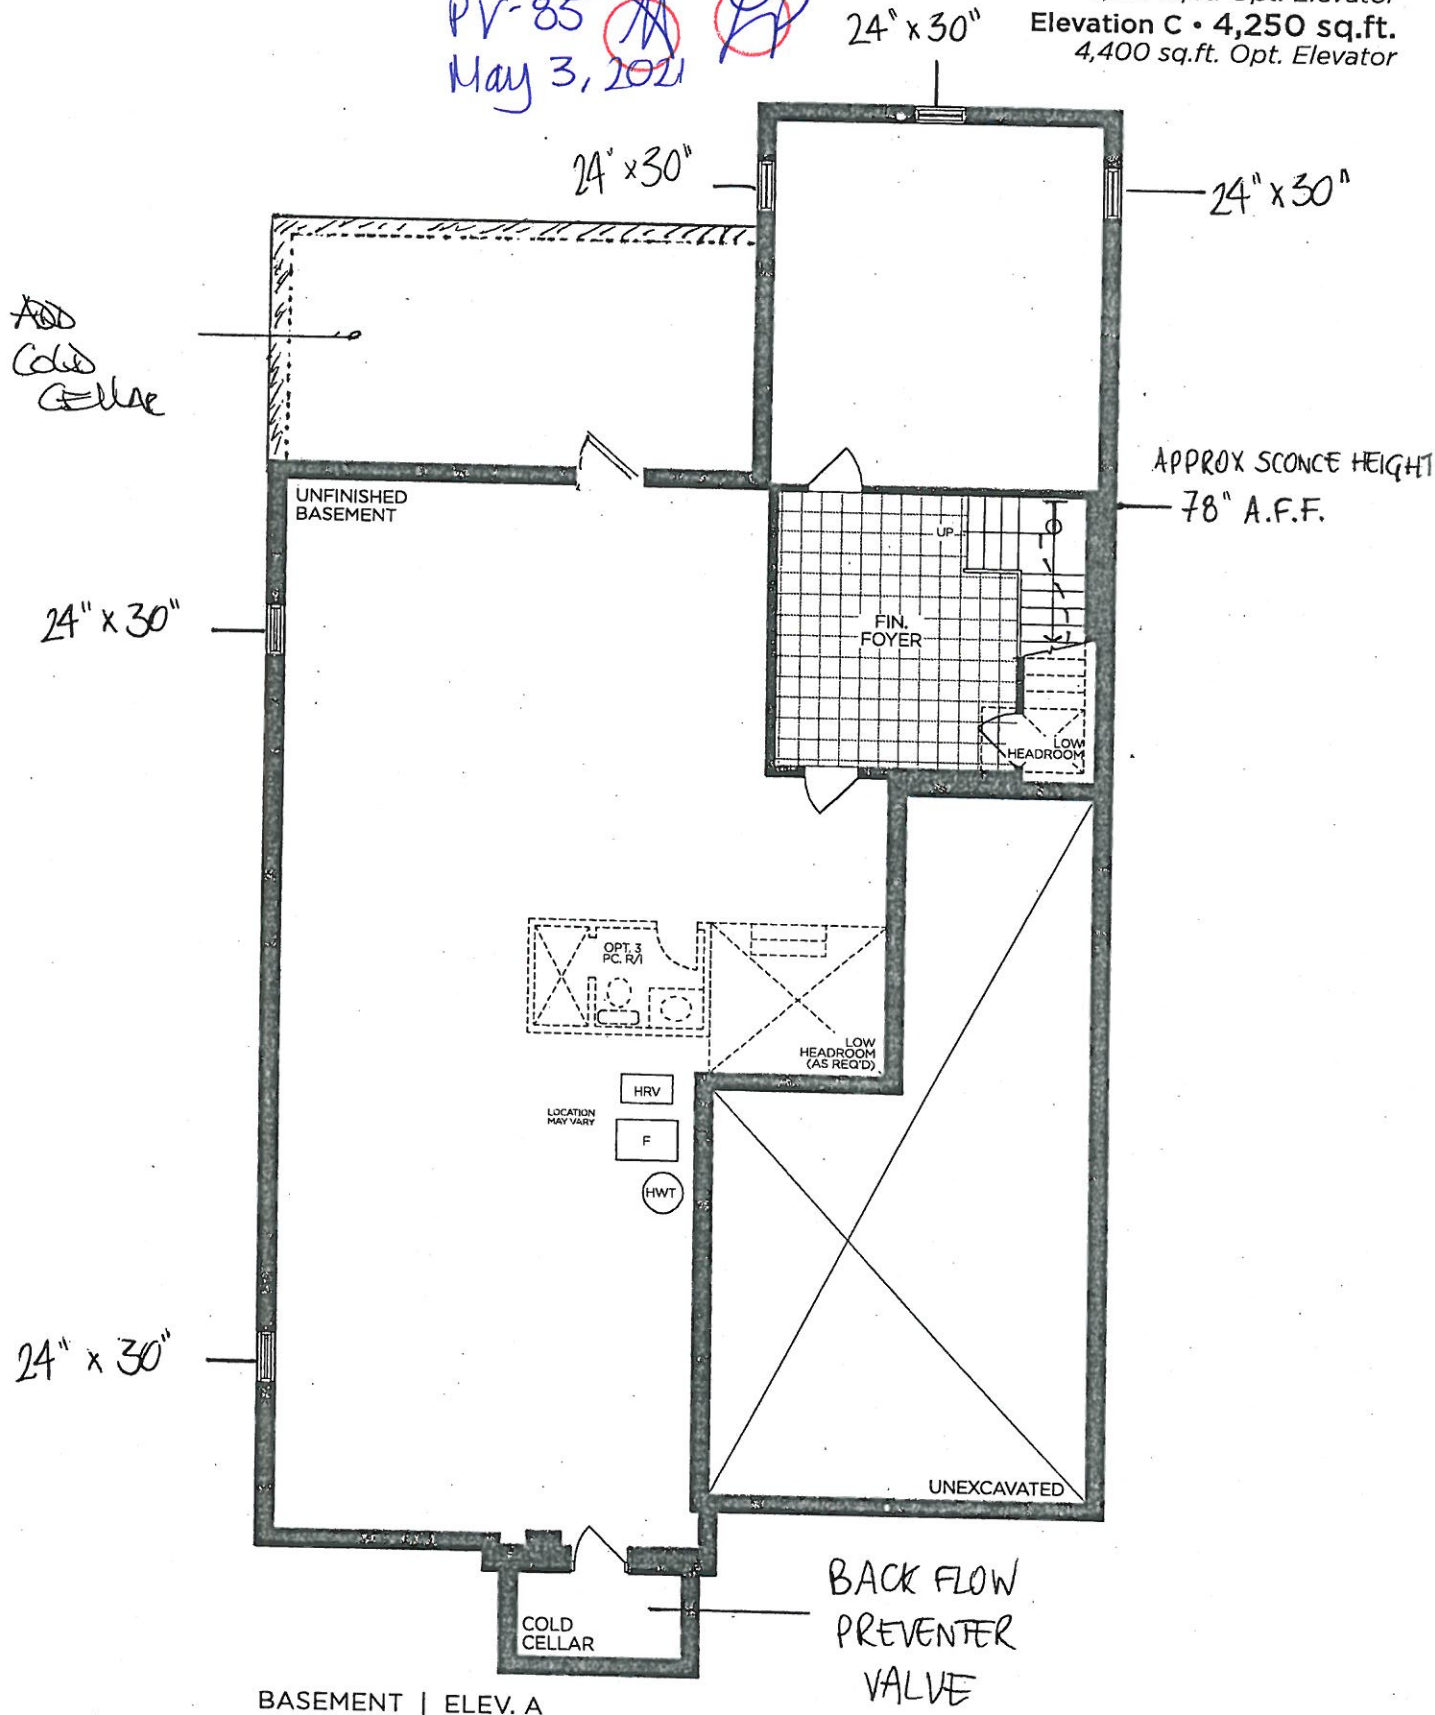

BASEMENT | ELEV. A

VENDOR
PURCHASER
PURCHASER

GOLDPARK
WORTH MORE™

Prices, figures, illustrations, sizes, features and finishes are subject to change without notice. Areas and dimensions are approximate and actual usable floor space may vary from the stated area. Layout may be reverse of the unit purchased. E. & O.E. 5004

May 3, 2021

10' CEILING - 12" H COFFERED CEILING -
M.H. = 102" + 3/4" H CONTEMPORARY
MOLDING + 5 1/4" H FURRING RAIL
+ LARGE CORNICE MOLDING TO
UNDERSIDE OF BOX










PV-95-~~10~~20

May 3, 2021

**GOLDPARK HOMES
PINE VALLEY
VAUGHAN, ONTARIO
MODEL: (5004) BEAUMONT**

SITE STANDARD: WHITE 3/4" EXTENSION
SOFT-CLOSE DRAWERS & STANDARD SLAM DOOR HINGES
TO VANITIES

ONE TOP DRAWER WHERE POSSIBLE THROUGHOUT EACH
VANITY, ONE BANK OF DRAWERS WHERE POSSIBLE
THROUGHOUT EACH MASTER ENSUITE VANITY

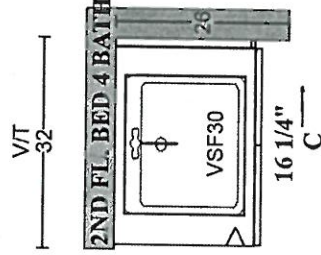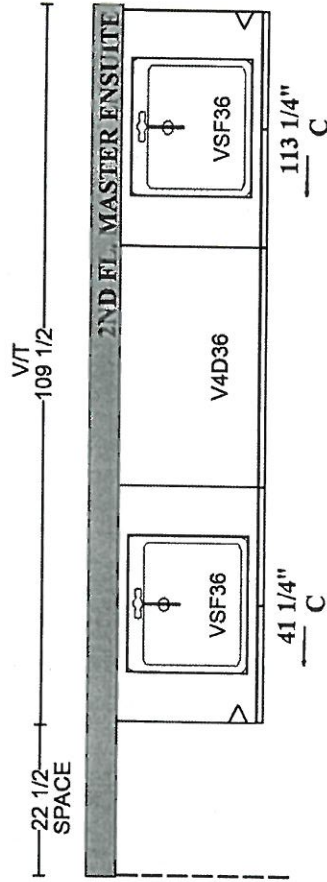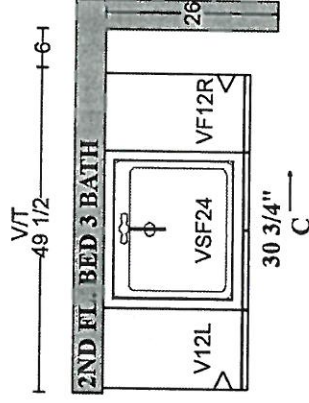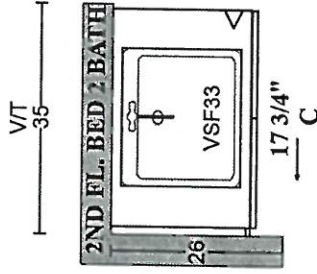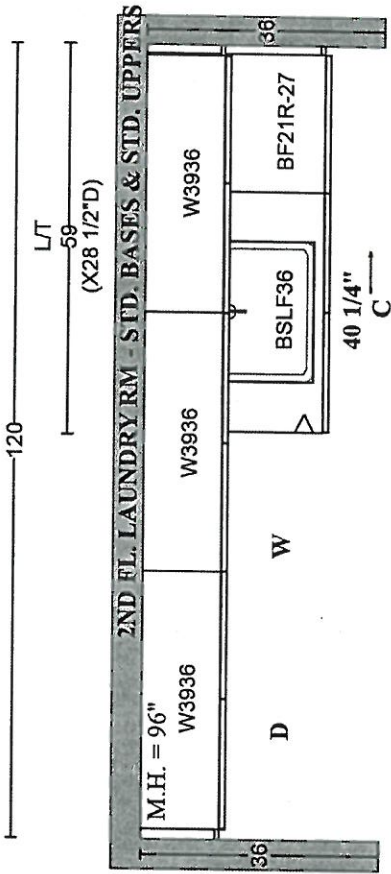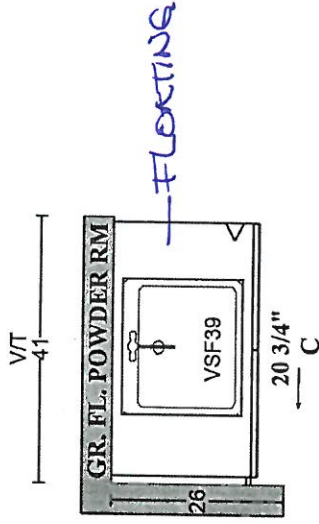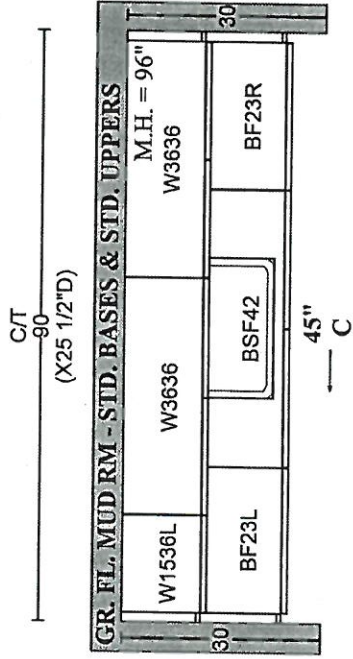


PLAN VIEW



PINE VALLEY

FOREVERGREEN

STONE COUNTERTOP EDGE PROFILES

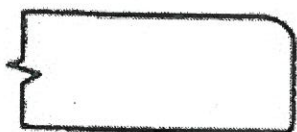

STANDARD 2CM EASED EDGE




LOCATION:

THRU OUT




UPGRADE 3CM EASED EDGE

LOCATION:

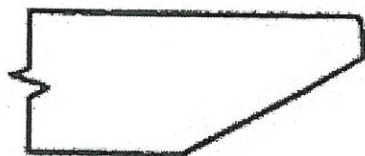

UPGRADE 4CM MITRED EDGE

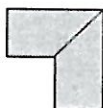

LOCATION:



UPGRADE 2CM OGEE EDGE

LOCATION:

LOT #: PV-85.

DATE: May 3, 2021

SIGNATURE:

SIGNATURE:

STANDARD HARDWARE / HANDLES



☐ H001-02



☐ H001-03



☐ H001-04



☐ H009-03



☐ H009-09




☐ H011-03



☐ H011-05



☐ H011-06

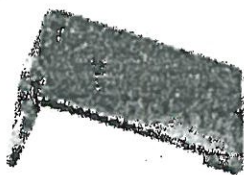

☐ H033-01



☒ H039-03
 → Laundry Room

☒ *NO HARDWARE
 → Kitchen
 → Powder Room

LOT # **PV-85**

DATE: **May 3, 2021**

SIGNATURE:

May 3

SIGNATURE:

Relaxo



PINE VALLEY

FOREVERGREEN

STANDARD HARDWARE / KNOBS

☐

K002-02

☐

K002-03

☐

K002-04

☐

K002-06

☒

K002-05

- Mud Room
- Master Ensuite
- Ensuite 2
- Ensuite 3
- Ensuite 4

☐

K008-14

☐

K024-03

☐

*NO HARDWARE

☐

*TOUCH-LATCH

LOT # PV-85

DATE: May 3, 2021

SIGNATURE:

[Signature]

SIGNATURE:

Laura Peloso



PINE VALLEY

FOREVERGREEN

EMERY

RECTANGULAR UNDERMOUNT SINK

- ☐ 4220CGY Undermount Sink, Soft White
☒ 4220CGY-077 Undermount Sink, Matte Black
☐ 4220CGY-088 Undermount Sink, Slate Grey

PRODUCT SPECS:

- Vitreous china
- Front overflow hole
- 8 1/4" Bowl depth
- Template and mounting hardware supplied

DIMENSIONS:

Outer:

545mm W x 355mm D x 210mm H
21 1/2" W x 14" D x 8 1/4" H

Inner:

495mm W x 305mm D x 160mm H
19 1/2" W x 12" D x 6 3/4" H


COMPLIANCE CERTIFICATIONS

Meets or exceeds the following:



- IAPMO cUPC
- ASME A112.19.2 / CSA B45.1

SHIPPING

Cube 1.85
GW 20 lbs

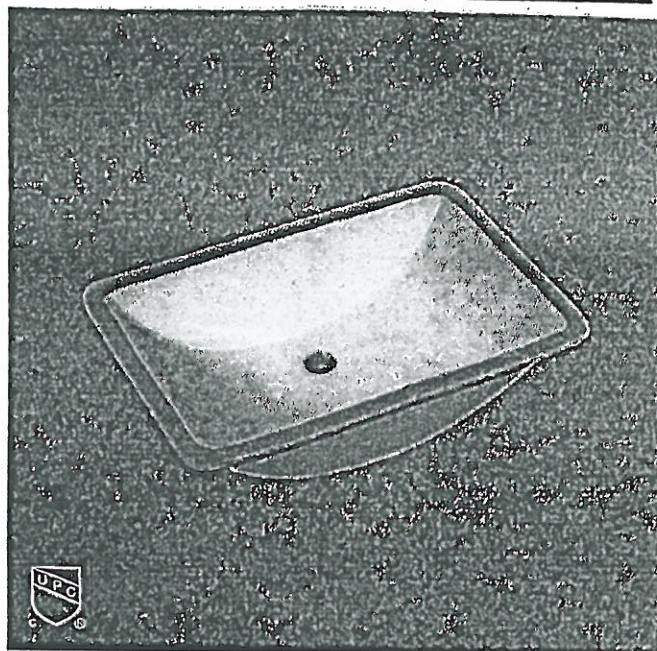

NOTES: Dimensions of fixtures are nominal and may vary within the range of tolerances established by ASME standard A112.19.2. These measurements are subject to change or cancellation. No responsibility is assumed for use of superseded or voided pages.

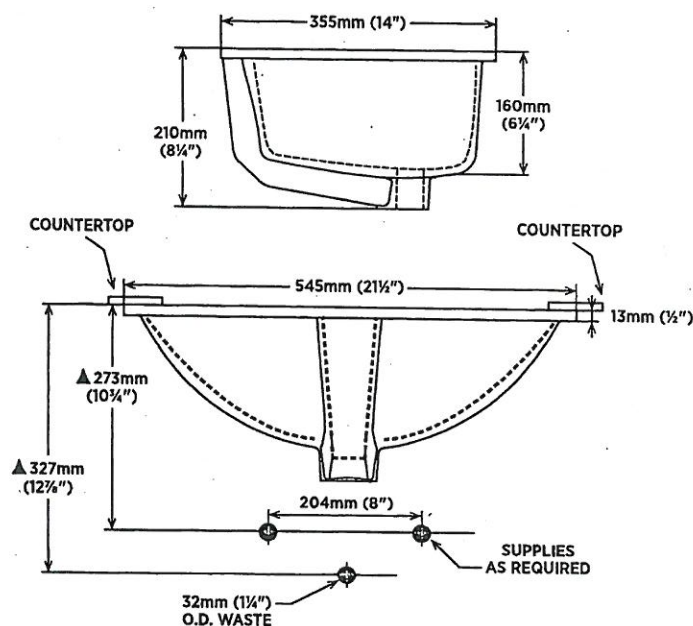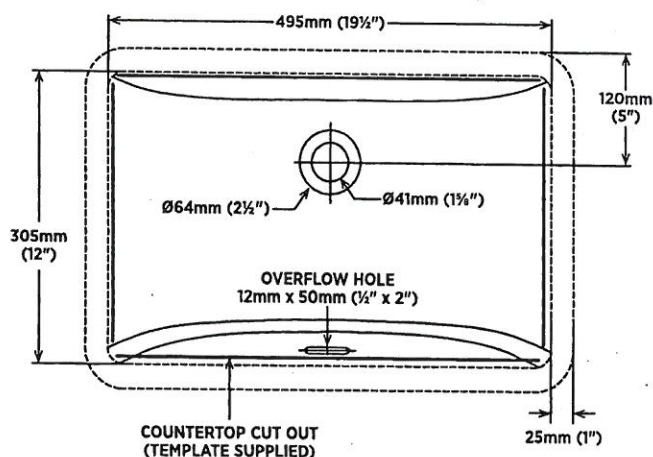

Lot# PV-85

Room: Powder Room

Date: May 4, 2021

Signature: [Signature]

Signature: Laura Peloso

GOLDPARK
WORTH MORE




PINE VALLEY
FOREVERGREEN

UPGRADE SHOWER HARDWARE

SQ6X6

Shower Door Handle + Hinges

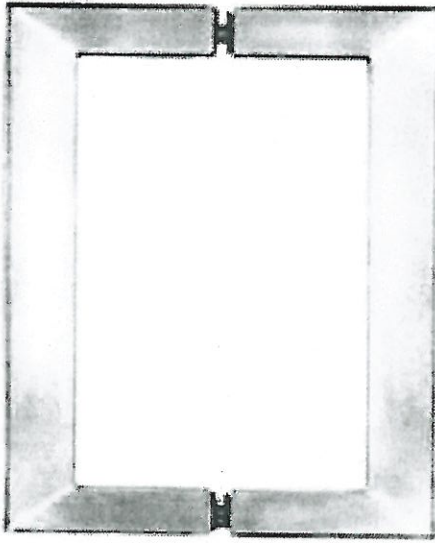

SQ6X6
Shower Door Handle

6" x 6" back-to-back
3/4" square tube
(Also available single sided)

☐ CHROME

☐ MATTE BLACK

☒ BRUSHED GOLD

Lot# PV-35

Date: May 4, 2021

Room: Master Ensuite

Signature:

Signature:




PINE VALLEY
FOREVERGREEN

UPGRADE SHOWER HARDWARE

SQ6X6

Shower Door Handle + Hinges

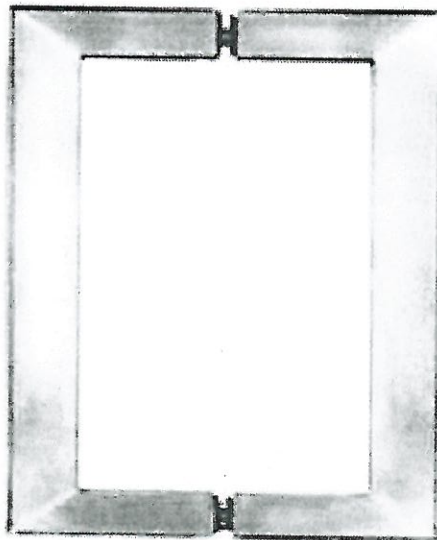

SQ6X6
Shower Door Handle

6" x 6" back-to-back
3/4" square tube
(Also available single sided)

☐ CHROME

☒ MATTE BLACK

Lot# PV-95


Date: May 4, 2021

Room: Ensuite 2, Ensuite 4


Signature:

Signature:

BATHROOM ACCESSORIES

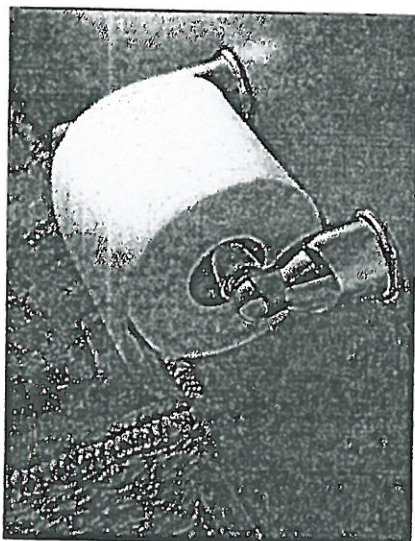

Tissue Holder
Mason - Chrome

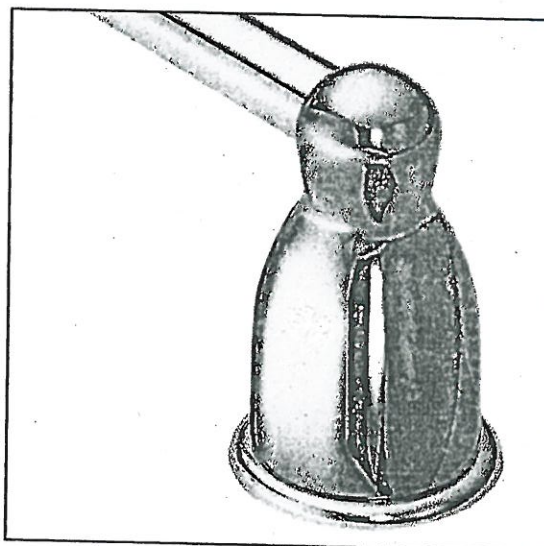

Towel Bar
Mason - Chrome


Please select one of the following:

- ☐ INSTALL STANDARD BATHROOM ACCESSORIES THRU OUT
(tissue holder + towel bar) **location as per vendors discretion**
- ☒ ***DO NOT*** INSTALL STANDARD BATHROOM ACCESSORIES
THRU OUT **tissue holder + towel bar will not be provided**


LOT # PV-85

DATE: May 3, 2021

SIGNATURE:

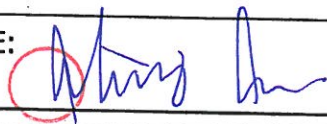

SIGNATURE:

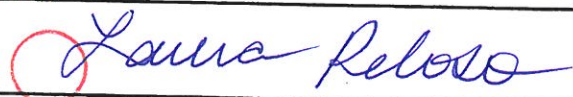




Project: Pine Valley

Lot: 85

Purchaser(s): Laura Peloso & Anthony Arci

Standard Hood Fan Deletion

We acknowledge that the builder's standard hood fan will not be installed.
Do not supply, install and/or credit. We will install our own hood fan after closing.

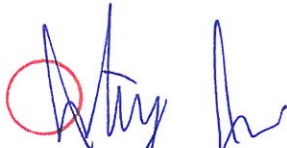Signature: 


Signature: 

Date: May 3, 2021

PLUMBING UPGRADES

MOEN - ALIGN

Posi-Temp SHOWER ONLY* with 3 Function Transfer Valve/Trim and Slide Bar with Handshower

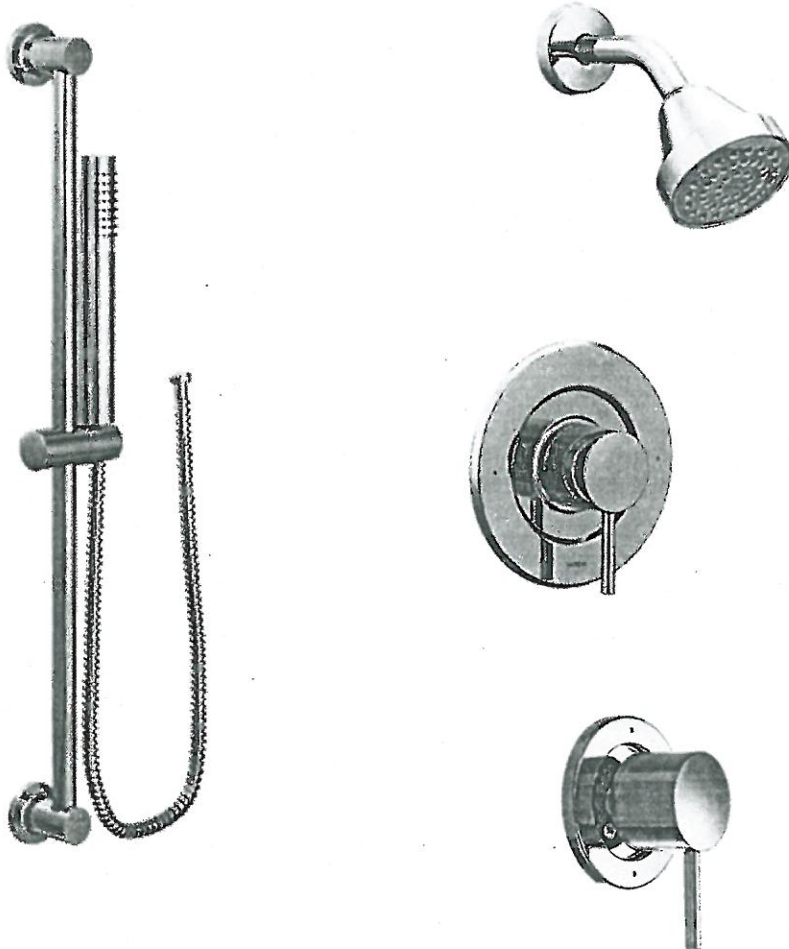

☒ CHROME

☐ BRUSHED NICKEL (BN)

☐ BRUSHED GOLD (BG)

☐ MATTE BLACK (BL)

*from CEILING

MODEL: T2192EP / U361CI / UT4191 / 62320 / 3887EP / A725 / 226651

Lot# PV-85

Date: April 13, 2021


Room: Master Ensuite

Signature: attached

Signature: attached

EXTERIOR LED SOFFIT POT LIGHTS

5004 BEAUMONT – ELEVATION C

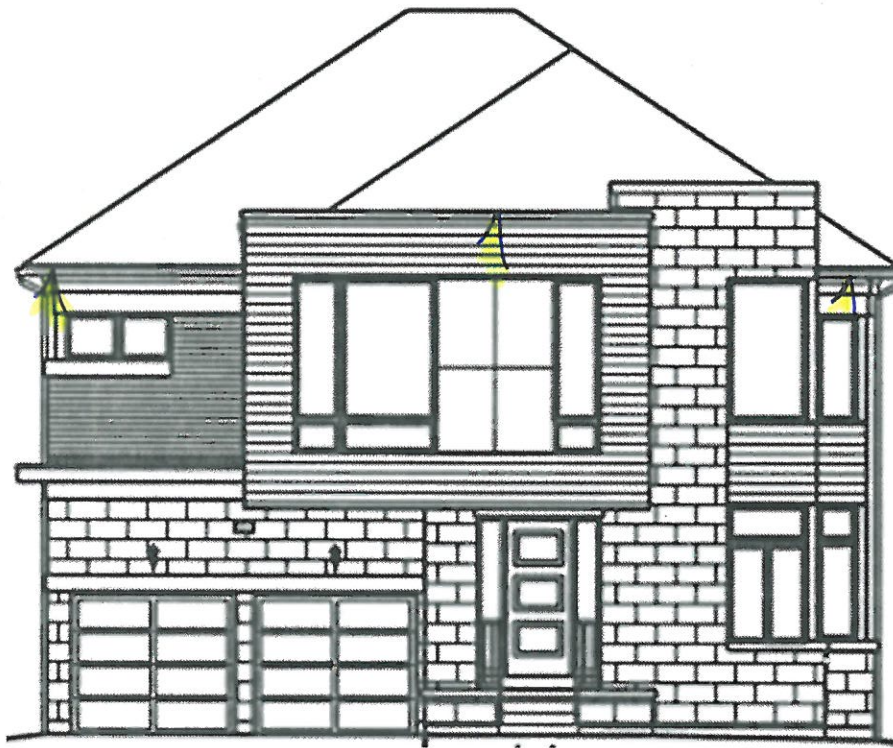

LOT #: PV-85

DATE: April 13, 2021

SIGNATURE: attached

SIGNATURE: attached

EXTERIOR LED SOFFIT POT LIGHTS

5004 BEAUMONT – ELEVATION C




LOT #: PV-85	DATE: April 13, 2021
SIGNATURE: <i>Gaura Patel</i>	
SIGNATURE: <i>Shirley D.</i>	

PLUMBING UPGRADES



MOEN - ALIGN

Posi-Temp SHOWER ONLY* with 3 Function Transfer Valve/Trim and Slide Bar with Handshower

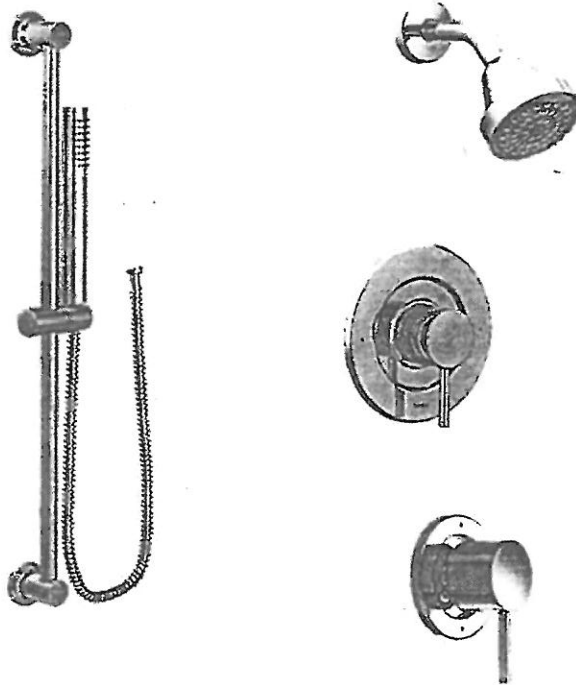

☒ CHROME

☐ BRUSHED NICKEL (BN)

☐ BRUSHED GOLD (BG)

☐ MATTE BLACK (BL)

*from CEILING

MODEL: T2192EP / U361CI / UT4191 / 62320 / 3887EP / A725 / 226651

Lot# PV-85	Date: April 13, 2021	Room: Master Ensuite
Signature: <i>Jason Peloso</i>		
Signature: <i>[Signature]</i>		

GOLDPARK
WORTH MORE

PV-85  
March 22, 2021

PRG366WH
36-INCH GAS PRO HARMONY® RANGE
PROFESSIONAL SERIES, STANDARD-DEPTH, PORCELAIN COOKTOP SURFACE

Thermador 



FEATURES & BENEFITS

- ★ - The Star® Burner delivers superior flame spread for more even heating
- ★ - ExtraLow® feature provides a wide range of temperature control, perfect for simmering delicate sauces
- ★ - 2 ExtraLow® burners for simmering, melting, or holding long durations
 - Raised pedestal burner and porcelain maintop for effortless cleaning
 - Convection Bake offers precise multi-level baking results

TECHNICAL DETAILS


Circuit Breaker	15 A
Volts	120 V, 60Hz
Energy Source	Gas
Plug Type USA	120V – 3 Prong
Power Cord Length	65" (1,651mm)
Gas Supply	3/4"

WARRANTY

Limited Warranty, Entire Appliance, Parts and Labor	2 Year
---	--------

SEE PAGE 2 FOR INCLUDED AND OPTIONAL ACCESSORIES

RANGETOP

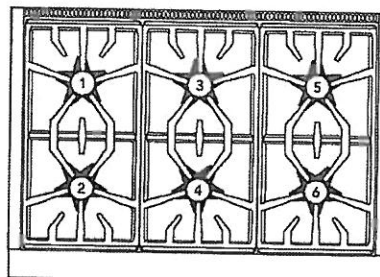

Total number of cooktop Burners	6
1 – Power of Back Left Burner BTU	15,000 and XLO
2 – Power of Front Left Burner BTU	18,000 and XLO
3 – Power of Back Center Burner BTU	15,000
4 – Power of Front Center Burner BTU	18,000
5 – Power of Back Right Burner BTU	15,000
6 – Power of Front Right Burner BTU	18,000


OVEN

Oven Capacity	5.1 cu. ft.
Cooking Modes	Bake, Convection Bake, Roast, Broil
Sabbath	Yes
Self Clean	No
Telescopic Rack(s)	3
Interior Lights	2
Bake Power	20,500 BTU
Broil Power	17,500 BTU
Home Connect™ (Wi-Fi Enabled)	Yes
Cavity Interior Dimensions (HxWxD)	16 3/8" x 29 1/8" x 18 5/8"
Cavity Usable Dimensions (HxWxD)	11 1/4" x 25 5/8" x 16 3/4"

DIMENSIONS & WEIGHT

Overall Appliance Dimensions (HxWxD)	35 3/4" – 36 3/4" x 35 15/16" x 24 5/8"
Required Cutout Size (HxWxD)	35 3/4" – 36 3/4" x 36" x 24"
Net Weight	415 lbs.


★ THERMADOR® EXCLUSIVE

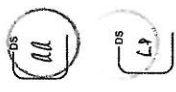PV-85 
March 22, 2021

PRG366WH
36-INCH GAS PRO HARMONY® RANGE
PROFESSIONAL SERIES, STANDARD-DEPTH, PORCELAIN COOKTOP SURFACE




36-INCH RANGE DIMENSIONS

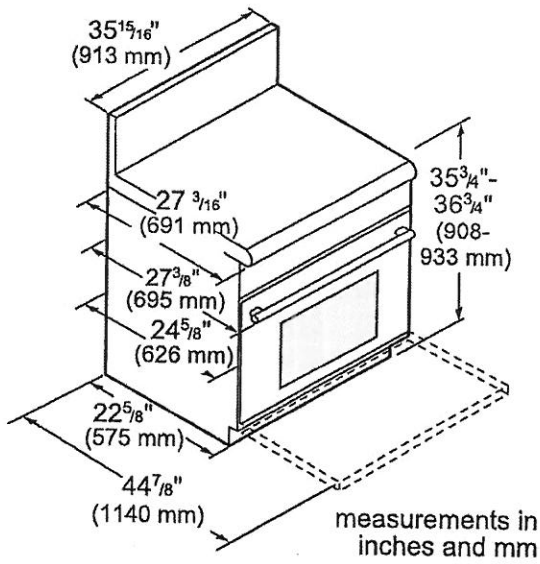

36-INCH RANGE CUTOUT DIMENSIONS

measurements in inches (mm)

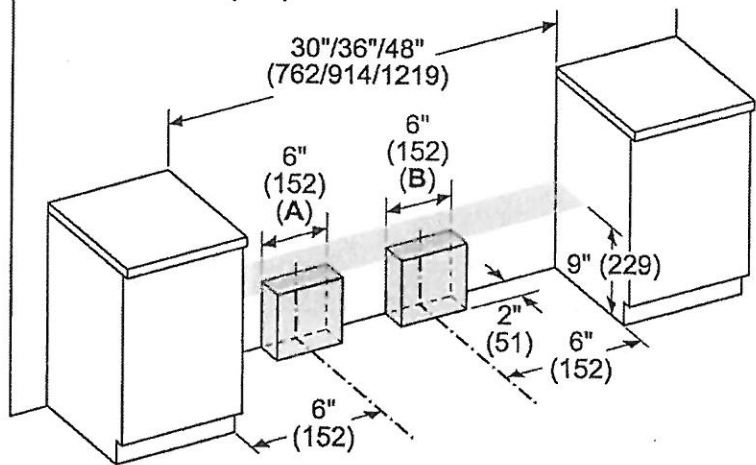

A: Gas zone
B: Electric zone


PV-85  
March 22, 2021

PRG366WH
36-INCH GAS PRO HARMONY® RANGE
PROFESSIONAL SERIES, STANDARD-DEPTH, PORCELAIN COOKTOP SURFACE



36-INCH RANGE DIMENSIONS AND CLEARANCE REQUIREMENTS WITH "LOW BACK"

NOTE: A 36-inch minimum clearance is required between the top of the cooking surface and the bottom of an unprotected cabinet. A 30-inch clearance can be used when the bottom of the wood or metal cabinet is protected by not less than 1/4 inch of a flame retardant material covered with not less than No. 28 MSG sheet steel, 0.015 inch (0.4 mm) thick stainless steel, 0.024 inch (0.6 mm) aluminum, or 0.020 inch (0.5 mm) thick copper.

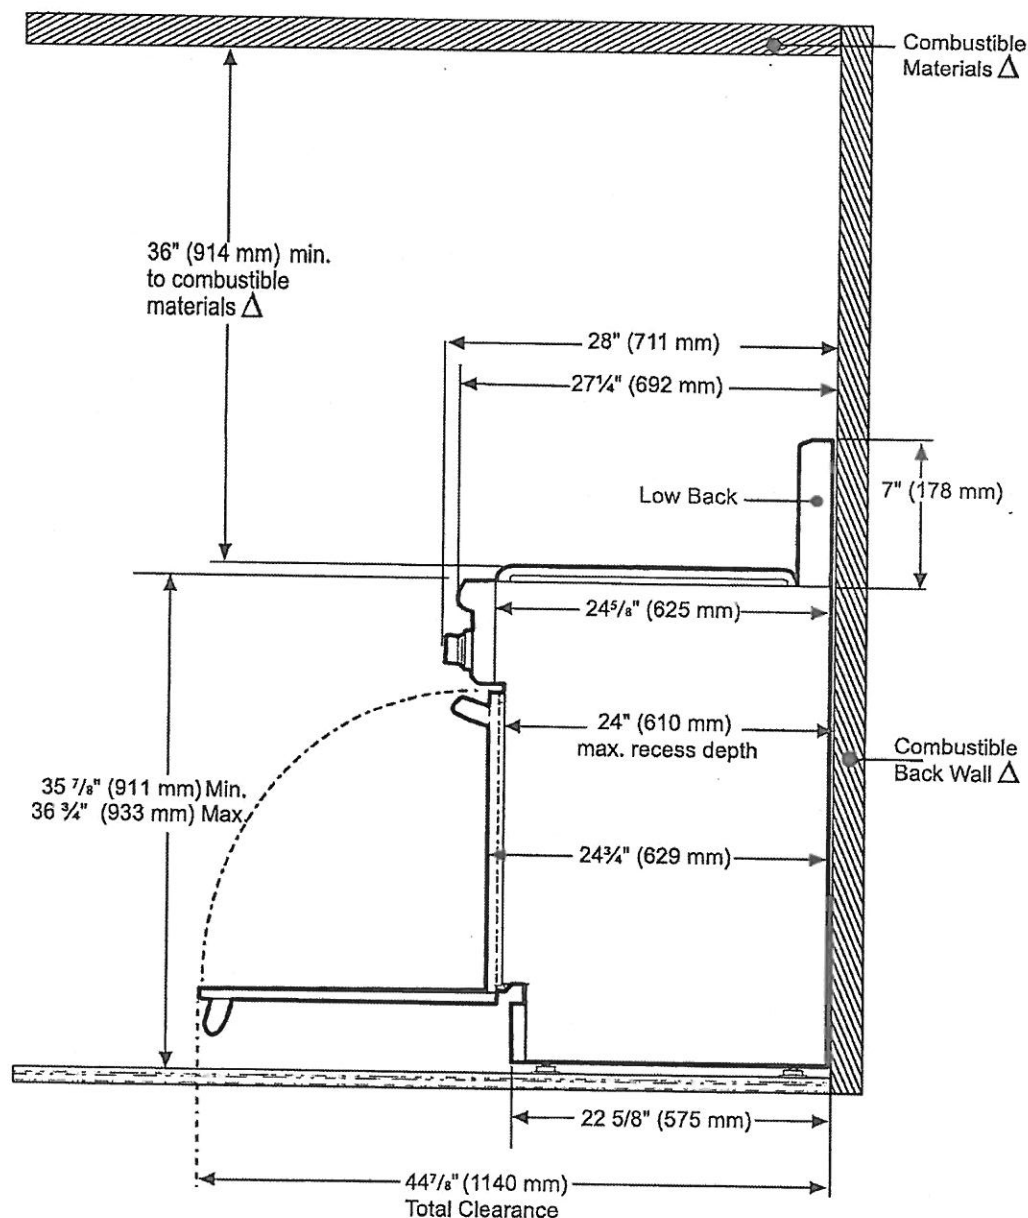


△ As defined in the "National Fuel Gas Code" (ANSI Z223.1, Current Edition). Clearances from non-combustible materials are not part of the ANSI Z21.1 scope and are not certified by CSA. Clearances of less than 6" (152 mm) must be approved by the local codes and/or by the local authority having jurisdiction.

PV-85  
March 22, 2021

PRG366WH
36-INCH GAS PRO HARMONY® RANGE
PROFESSIONAL SERIES, STANDARD-DEPTH, PORCELAIN COOKTOP SURFACE



36-INCH RANGE DIMENSIONS AND CLEARANCE REQUIREMENTS WITH "FLUSH ISLAND TRIM"

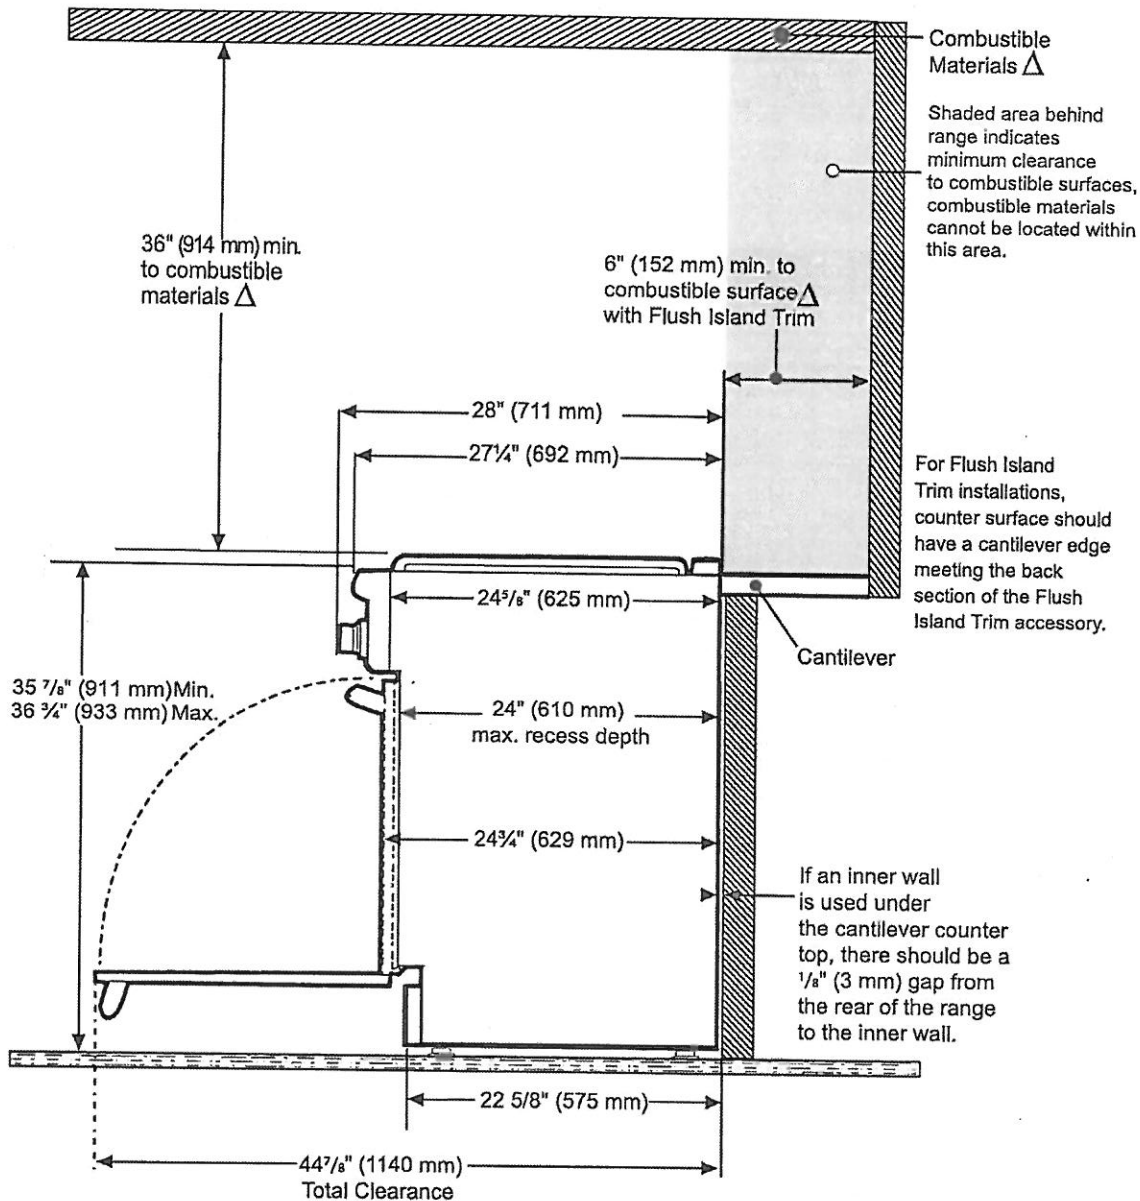

△ As defined in the "National Fuel Gas Code" (ANSI Z223.1, Current Edition). Clearances from non-combustible materials are not part of the ANSI Z21.1 scope and are not certified by CSA. Clearances of less than 6" (152 mm) must be approved by the local codes and/or by the local authority having jurisdiction.


These warranties give you specific legal rights and you may have other rights that vary from state to state. Limited warranty from date of purchase. For complete warranty details, refer to your Use & Care manual, or ask your dealer.

Specifications are for planning purposes only. Refer to installation instructions and consult your countertop supplier prior to making counter opening. Consult with a heating and ventilation engineer for your specific ventilation requirements. For the most detailed information, refer to installation instructions accompanying product or write to Thermador indicating the model number. Specifications are correct at time of printing. Thermador reserves the right to change product specifications or design without notice. Some models are certified for use in Canada. Thermador is not responsible for products that are transported from the U.S. for use in Canada.

1 800 735 4328 | USA THERMADOR.COM | CANADA THERMADOR.CA | ©2020 BSH HOME APPLIANCES CORPORATION. ALL RIGHTS RESERVED.

PV-85
March 22, 2021

DWHD650WFP
EMERALD® 6-PROGRAM DISHWASHER
PROFESSIONAL SERIES HANDLE

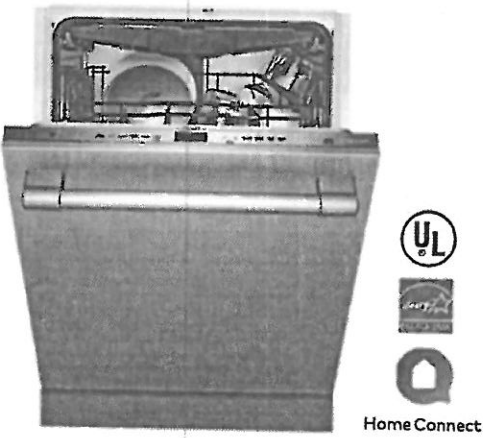

Also Available In:
DWHD650WFM – Flat Stainless Steel Panel with
Masterpiece® Series Handle
DWHD650WPR – Custom Panel

- FEATURES & BENEFITS**
- Chef's Tool Drawer (3rd Rack) is designed to make loading and unloading tools and hard to place items extraordinarily easier
 - Sens-A-Wash® measures water cleanliness and adjusts wash cycle
 - Three stage advanced filtration recirculates water for sparkling results
 - 3-Level adjustable upper rack is customizable for all of your needs, designed to be raised for extra large items placed on the bottom rack, or lowered to fit taller wine glasses on the upper rack
 - Extra Dry Option adds extra heat to the final rinse to enhance drying results
 - Impressively Quiet®—48 dBA for peaceful kitchen experience
 - Thermador Connected Experience by Home Connect brings exclusive dish features that keep you connected. Always.

ACCESSORIES (OPTIONAL)	
Dishwasher Supply and Drainage Hose Extension 76 3/4"	SGZ1010UC
Dishwasher Accessory Kit	SMZ5000
Fine Silverware Carafe	SMZ5002UC
Junction Box	SMZPCJB1UC



GENERAL PROPERTIES	
Number Of Wash Cycles	6
Number Of Options	5
dBA	48
Third Rack	Chef's Tool Drawer®
Rack Adjustability	Rackmatic 3-Stage
Tub Material	Stainless Steel
Control Type	Touch Control
Concealed Water Heating Element	Yes
Leak Protection System	24/7 AquaStop®
Water Softener	No
Five-Level Wash	Yes
Childlock	No
Home Connect (Wi-Fi Enabled)	Yes


EFFICIENCY	
Water Usage Per Cycle (g)	3.5 g
Energy Efficiency Class	Tier 1
ENERGY STAR® Certified	Yes
Total Annual Energy Consumption (kWh)	269 kWh
Total Annual Water Consumption (g)	624 g

CAPACITY	
Number Of Place Settings	16

TECHNICAL DETAILS	
Watts (W)	1,440 W
Current (A)	12 A
Volts (V)	120 V
Frequency (Hz)	60 Hz
Power Cord Length (in)	67"
Power Cord Install Length from Corner of Unit when Facing the Door (in)*	Left - 45" Right - 56"
Minimum Water Pressure (lb/sin)	14
Max. Temperature for Water Intake	140° F
Length Inlet Hose (in)	N/A
Length Outlet Hose (in)	79"

DIMENSIONS & WEIGHT	
Overall Appliance Dimensions (HxWxD) (in)	33 7/8" x 23 9/16" x 23 3/4"
Required Cutout Size (HxWxD) (in)	33 7/8" Min. x 23 5/8" Min. x 24"
Adjustable Feet	Yes
Net Weight (lbs)	93 lbs

*September 2020 running production change to remove adhesive routing clips for power cord. These clips and the edge protector are now included in the dishwasher accessory kit #SMZEPCC1UC.

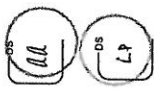
PV-85 
March 22, 2021

DWHD650WFP
EMERALD® 6-PROGRAM DISHWASHER
PROFESSIONAL SERIES HANDLE



WARRANTY	
Limited Warranty, Entire Appliance, Parts and Labor	2 Year
Limited Warranty for Microprocessor or Printed Circuit Board; Parts Only	3rd to 5th Year
Limited Warranty for Racks (Does Not Include Rack Components); Parts Only	3rd to 5th Year
Limited Warranty for Rust-through On Inner Tub Liner; Parts Only	Lifetime

DISHWASHER & CUTOUT DIMENSIONS

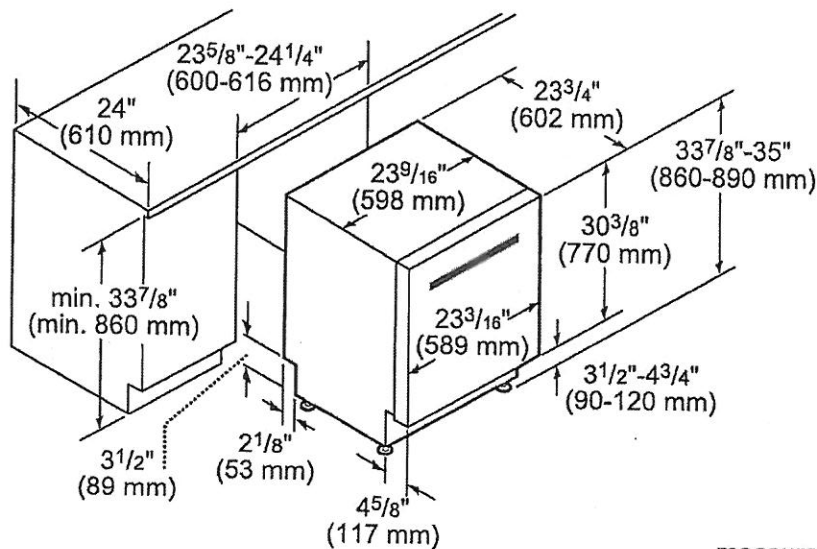


measurements in inches and mm

DocuSign Envelope ID: 6681413F-7A13-4D43-8FF4-319A43F4B349

These warranties give you specific legal rights and you may have other rights that vary from state to state. Full warranty and limited warranty from date of installation. For complete warranty details, refer to your Use & Care manual, or ask your dealer.


Specifications are for planning purposes only. Refer to installation instructions and consult your countertop supplier prior to making counter opening. Consult with a heating and ventilation engineer for your specific ventilation requirements. For the most detailed information, refer to installation instructions accompanying product or write to Thermador indicating the model number. Specifications are correct at time of printing. Thermador reserves the right to change product specifications or design without notice. Some models are certified for use in Canada. Thermador is not responsible for products that are transported from the U.S. for use in Canada.

1 800 735 4328 | USA THERMADOR.COM | CANADA THERMADOR.CA | ©2020 BSH HOME APPLIANCES CORPORATION. ALL RIGHTS RESERVED.

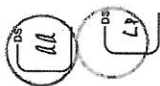PV- 85 
March 22, 2021

T30IF905SP
30-INCH BUILT-IN FREEZER COLUMN WITH
INTERNAL ICE MAKER
FREEDOM® COLLECTION, PANEL-READY

Thermador 

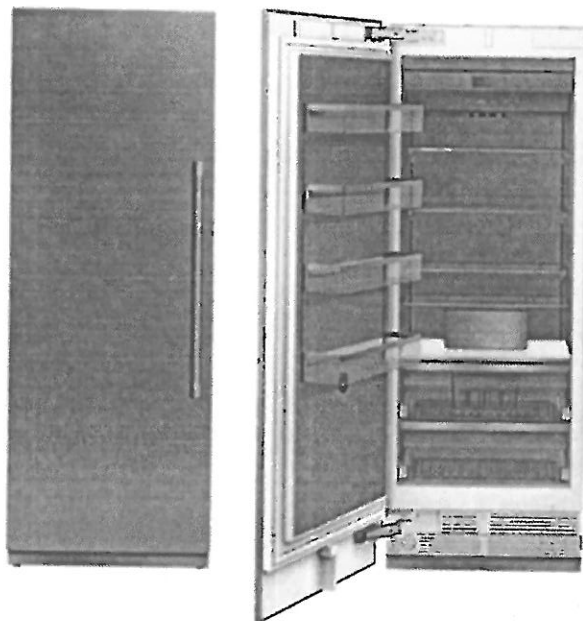

FEATURES & BENEFITS

- Full Stainless Steel Inner Liner
- Freedom® Hinge enables true flush design
- Auto Door Opening provides the opening of the door with just a slight push or pull
- SoftClose® Drawers for easy and controlled storage
- Sleek clean design for the perfect symmetry when paired with additional columns
- TFT control panel managing all your columns functions

TEMPERATURE RANGES

Freezer	-11°F (-24°C) to 7°F (-14°C)
SuperFreeze®	-22°F (-30°C) for approximately 52 hours
Energy Saving (Economy) Mode	3°F (-16°C)

GENERAL PROPERTIES

Home Connect™ (Wi-Fi Enabled)	Yes
Panel Ready	Yes
Reversible Door Swing	Yes
SoftClose® Door	Yes*
SoftClose® Drawers	Yes
Lighting	LED Sidewall and Theater Lighting
Freezer Shelves	4
Adjustable Shelves	3
Shelf Material	Glass w/Aluminum Profile
Full Extension Drawers @ 115° Door Opening Angle	Yes
General Use Drawer	2
Door Bins	4
External LED Proximity Sensor	No
Oversized Dispenser Opening	No
Chilled Water, Crushed and Cubed Ice	No
Rapid Water Replenishment System	No
Ice Maker with Diamond Ice System	Yes
Door Open Alarm	Yes
Open Door Assist	Yes
Special Modes	Sabbath, Economy, Vacation

CAPACITY

Total Capacity (cu. ft.)	15.8 cu. ft.
--------------------------	--------------

PERFORMANCE

Dedicated Evaporator & Compressor System	Yes
SuperFreeze®	Yes
Defrost Process	Frost-Free

TECHNICAL DETAILS

Watts (W)	350 W
Current (A)	15 A
Volts (V)	110-120 V
Frequency (Hz)	60 Hz
Power Cord Length (in.)	118
Plug Type	120V-3 Prong

DIMENSIONS & WEIGHT

Appliance Dimensions (H x W x D) (in.)	84"*** x 29 3/4" x 24"
Required Cutout Size (H x W x D) (in.)	84" x 30" x 25"
Net / Gross Weight (lbs)	362 / 398 lbs

EFFICIENCY

ENERGY STAR® Qualified	Yes
Annual Energy Consumption	479 kWh

*To verify, if you have a refrigeration unit with Soft-Close capability please contact our customer team by calling 1-800-735-4328.

**Height adjustable + / - 1/2" (+ / - 13 mm)

PV-85 
March 22, 2021

T30IF905SP
30-INCH BUILT-IN FREEZER COLUMN WITH
INTERNAL ICE MAKER
FREEDOM® COLLECTION, PANEL-READY


Thermador 

WARRANTY


Limited, Entire Appliance, Parts and Labor on Any Part of the Refrigerator that Fails Because of a Manufacturing Defect	2 Year
Limited Warranty for Sealed Refrigeration System*; Parts and Labor	3rd to 6th Year
Limited Warranty for Sealed Refrigeration System*; Parts Only	7th to 12th Year
Limited Warranty for Stainless Steel Rust-Through	Lifetime

*Sealed refrigeration system includes compressor, evaporator, condenser, dryer / strainer and connection tubing

CUTOUT DIMENSIONS

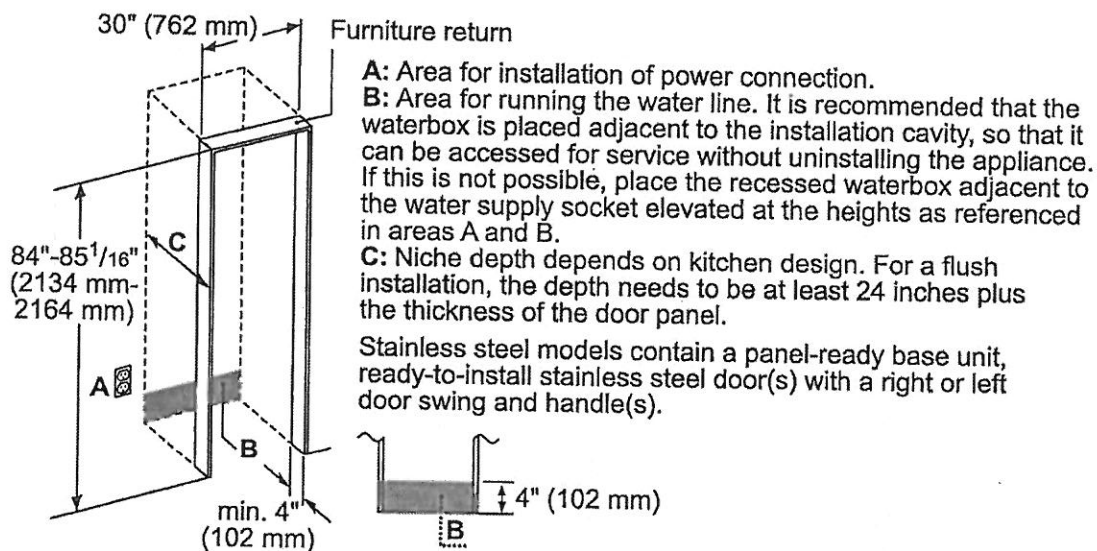


TOP VIEW CLEARANCE

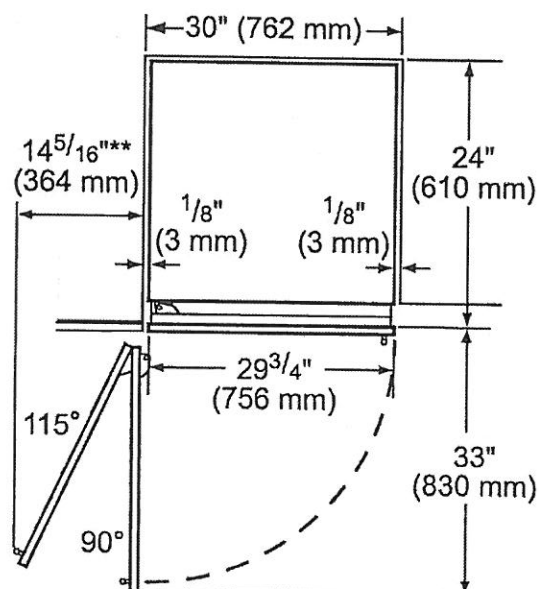

**** Door handle must be added to this dimension**

*** Depends on the thickness of the unit door.**
3/4" (19 mm) refers to the stainless steel door. (special accessory).

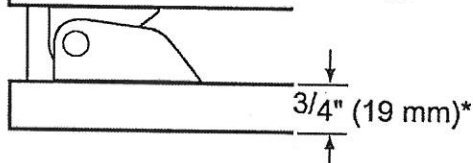


PV-85
March 22, 2021

T30IF905SP
30-INCH BUILT-IN FREEZER COLUMN WITH
INTERNAL ICE MAKER
FREEDOM® COLLECTION, PANEL-READY




PRODUCT AND PANEL DIMENSIONS

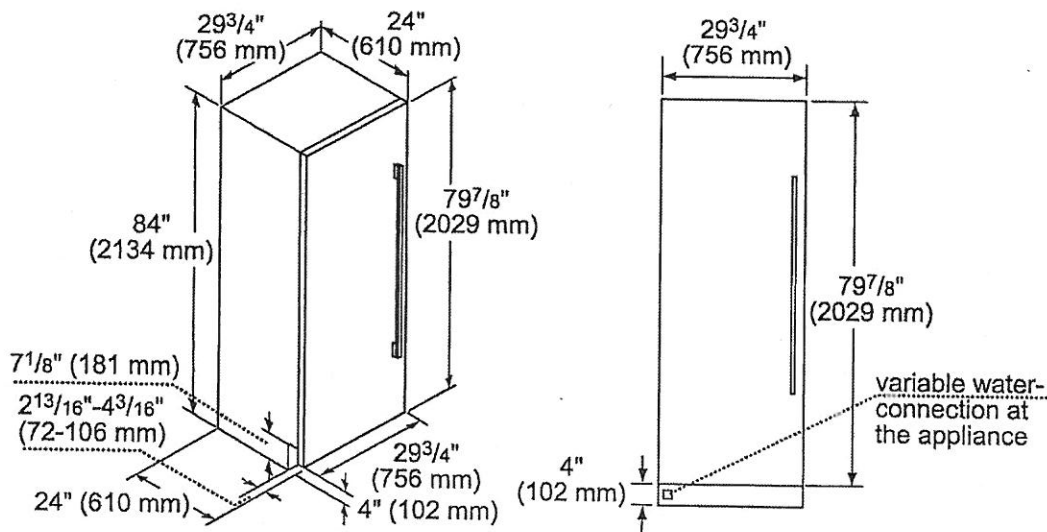

ACCESSORIES (OPTIONAL)

FLAT STAINLESS STEEL DOOR PANELS

30-Inch Flat Stainless Steel Door Panel Without Dispenser

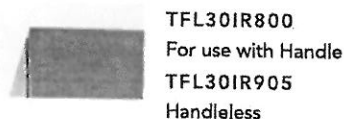


NOTE: Handleless Panels should not be installed on units without the Soft-Close capability. If you are uncertain if you have a refrigeration unit with Soft-Close capability please contact our customer team by calling 1-800-735-4328.

HANDLES

Choose between two options:



or

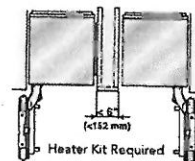

HEATRKIT20 - 13W @ 120V
Freedom® Heater Kit

When two appliances are installed side-by-side a sealing kit must be used. For combinations that involve a freezer column, this sealing kit is included. For all other (non-traditional, i.e. two wine columns, two bottom freezers, etc.) side-by-side combinations or instances where any appliances are installed less than 6-inches (152 mm) apart from one another but not connected side-by-side, purchase this kit. This kit is recommended for use with any installation in areas that are subject to humidity, or located next to an outside wall.

STORAGE




FRAMEKIT10

Freedom® Frame Kit

For any custom column installation in 24-inch deep cutouts. With two metal side trims whose placement between the interior cutout wall and the appliance helps overcome the challenge of unfinished cabinet returns.


FILTERS

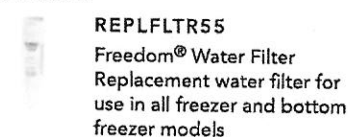

These warranties give you specific legal rights and you may have other rights that vary from state to state. Limited warranty from date of purchase. For complete warranty details, refer to your Use & Care manual, or ask your dealer.


Specifications are for planning purposes only. Refer to installation instructions and consult your countertop supplier prior to making counter opening. Consult with a heating and ventilation engineer for your specific ventilation requirements. For the most detailed information, refer to installation instructions accompanying product or write to Thermador indicating the model number. Specifications are correct at time of printing. Thermador reserves the right to change product specifications or design without notice. Some models are certified for use in Canada. Thermador is not responsible for products that are transported from the U.S. for use in Canada.

1 800 735 4328 | USA THERMADOR.COM | CANADA THERMADOR.CA | ©2020 BSH HOME APPLIANCES CORPORATION. ALL RIGHTS RESERVED.

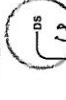PV-85  
March 22, 2021

T361R905SP
36-INCH BUILT-IN FRESH FOOD COLUMN
FREEDOM® COLLECTION, PANEL-READY

Thermador 

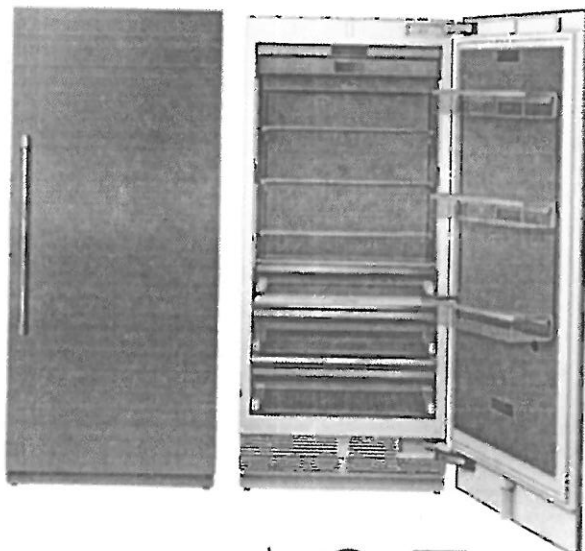

FEATURES & BENEFITS

- Full Stainless Steel Inner Liner
- Freedom® Hinge enables true flush design
- Auto Door Opening provides the opening of the door with just a slight push or pull
- ThermaFresh System, Humidity and Temperature controlled drawers
- SoftClose® Drawers for easy and controlled storage
- Sleek clean design for the perfect symmetry when paired with additional columns
- TFT control panel managing all your columns functions

TEMPERATURE RANGES

Refrigerator	36°F (2°C) to 46°F (8°C)
Temperature Controlled Drawer	30°F (-1°C) to 38°F (3°C)
SuperCool	36°F (2°C) for approximately 6 hours
Energy Saving (Economy) Mode	43°F (6°C)

GENERAL PROPERTIES

Home Connect™ (Wi-Fi Enabled)	Yes
Panel Ready	Yes
Reversible Door Swing	Yes
SoftClose® Door	Yes*
SoftClose® Drawers	Yes
Carbon Air Filter	Yes
Lighting	LED Sidewall and Theater Lighting
Refrigerator Shelves	4
Adjustable Shelves	3
Shelf Material	Glass w/Aluminum Profile
Full Extension Drawers @ 115° Door Opening Angle	Yes
Full Extension Drawers @ 90° Door Opening Angle	Yes
General Use Drawer	1
Humidity Managed Drawer	1
Temperature Controlled Drawer	1
Door Bins	3
Gallon Door Bins	1
Door Open Alarm	Yes
Open Door Assist	Yes
Special Modes	Sabbath, Economy, Vacation

CAPACITY

Total Capacity (cu. ft.)	20.6 cu. ft.
--------------------------	--------------

PERFORMANCE

Dedicated Evaporator & Compressor System	Yes
Freeflow® Cold Air System	Yes
SuperCool	Yes

TECHNICAL DETAILS

Watts (W)	350 W
Current (A)	15 A
Volts (V)	110-120 V
Frequency (Hz)	60 Hz
Power Cord Length (in.)	118
Plug Type	120V-3 Prong

DIMENSIONS & WEIGHT

Appliance Dimensions (H x W x D) (in.)	83 3/4"*** x 35 3/4" x 24"
Required Cutout Size (H x W x D) (in.)	84" x 36" x 25"
Net / Gross Weight (lbs)	406 / 449 lbs

EFFICIENCY

ENERGY STAR® Qualified	Yes
Annual Energy Consumption	312 kWh

*To verify if you have a refrigeration unit with Soft-Close capability please contact our customer team by calling 1-800-735-4328.

**Height adjustable + / - 1/2" (+ / - 13 mm)

PV-85
March 22, 2021


T361R905SP
36-INCH BUILT-IN FRESH FOOD COLUMN
FREEDOM® COLLECTION, PANEL-READY




WARRANTY	
Limited, Entire Appliance, Parts and Labor on Any Part of the Refrigerator that Fails Because of a Manufacturing Defect	2 Year
Limited Warranty for Sealed Refrigeration System*; Parts and Labor	3rd to 6th Year
Limited Warranty for Sealed Refrigeration System*; Parts Only	7th to 12th Year
Limited Warranty for Stainless Steel Rust-Through	Lifetime

*Sealed refrigeration system includes compressor, evaporator, condenser, dryer / strainer and connection tubing

CUTOUT DIMENSIONS

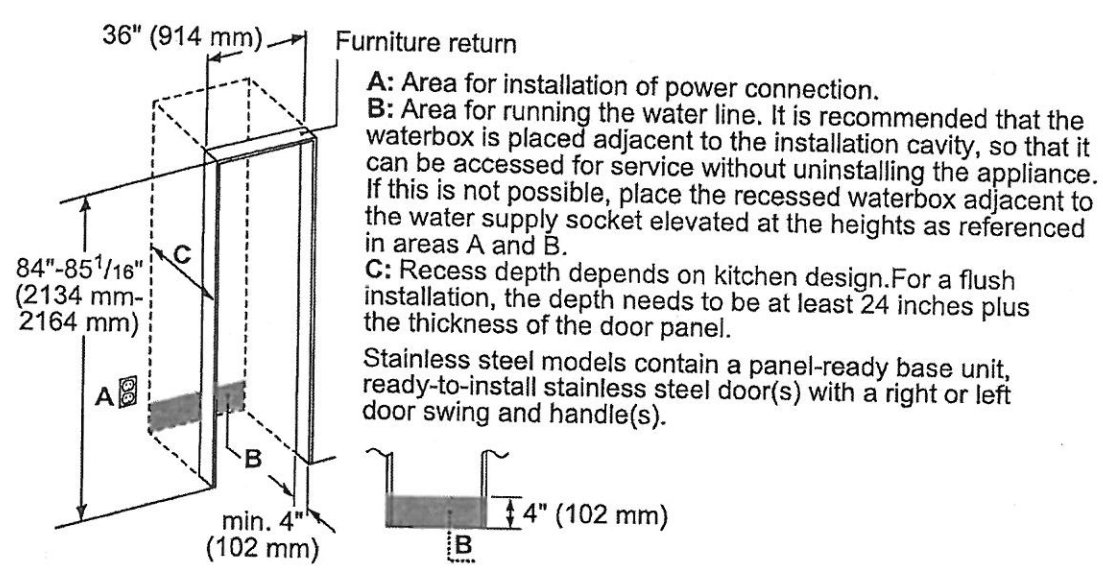

TOP VIEW CLEARANCE

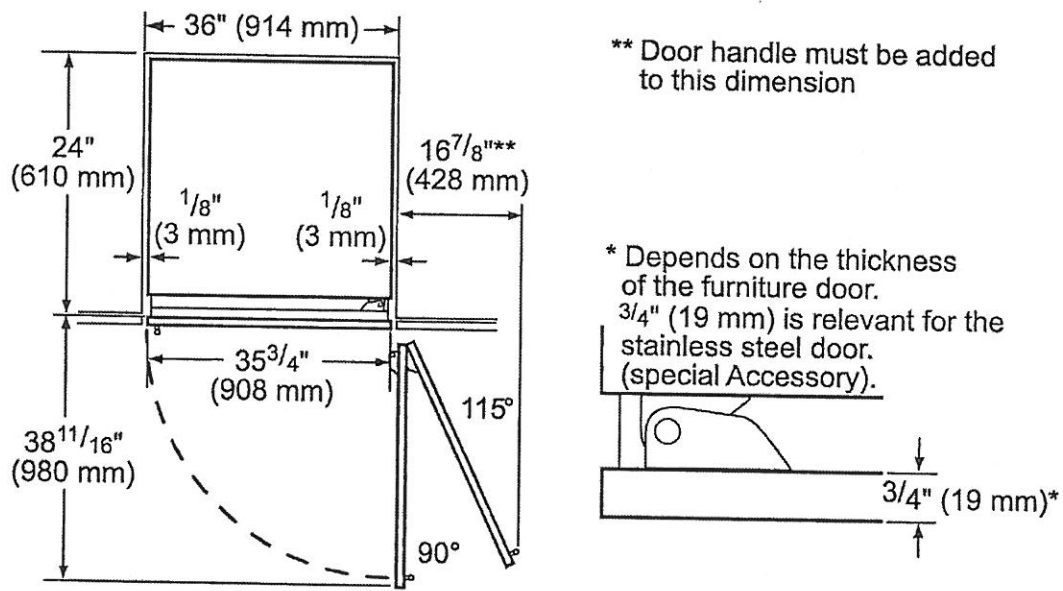

** Door handle must be added to this dimension


* Depends on the thickness of the furniture door. 3/4" (19 mm) is relevant for the stainless steel door. (special Accessory).

PV-85
March 22, 2021

T36IR905SP
36-INCH BUILT-IN FRESH FOOD COLUMN
FREEDOM® COLLECTION, PANEL-READY



PRODUCT AND PANEL DIMENSIONS

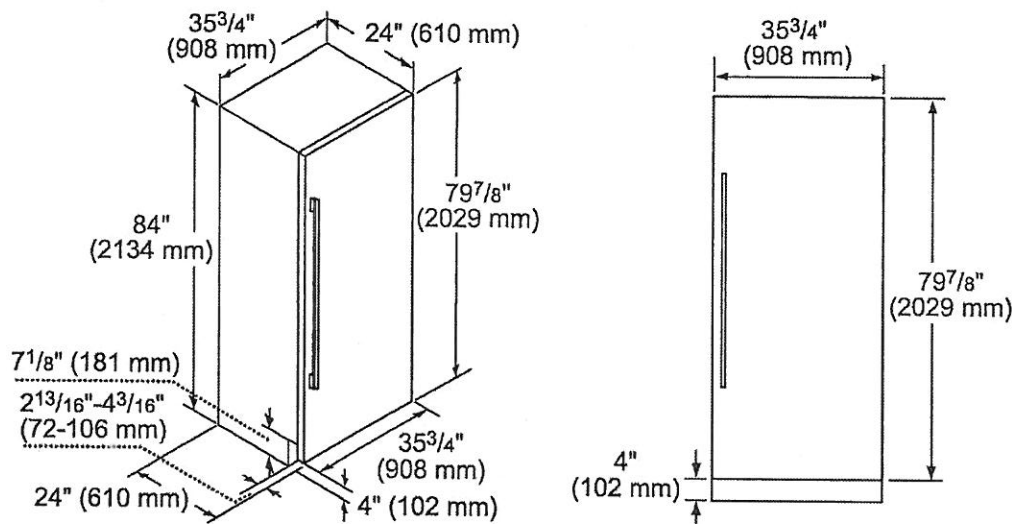

ACCESSORIES (OPTIONAL)

FLAT STAINLESS STEEL DOOR PANELS

30-Inch Flat Stainless Steel Door Panel



TFL36IR900
For use with Handle
TFL36IR905
Handleless

NOTE: Handleless Panels should not be installed on units without the Soft-Close capability. If you are uncertain if you have a refrigeration unit with Soft-Close capability please contact our customer team by calling 1-800-735-4328.

HANDLES

Choose between two options:



PR36HNDL20
36-Inch Professional Series Handle

or



MS36HNDL20
36-Inch Masterpiece® Series Handle

STORAGE



SPRODBIN10
Small Produce Bin



LPRODBIN10
Large Produce Bin




36PRODRAIL
36-Inch Produce Railing



36HFGALBIN
36-Inch Half Gallon Bin

FRAMEKIT10

Freedom® Frame Kit
For any custom column installation in 24-inch deep cutouts. With two metal side trims whose placement between the interior cutout wall and the appliance helps overcome the challenge of unfinished cabinet returns.

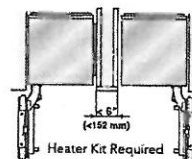

HEATRKIT20 – 13W @ 120V

Freedom® Heater Kit
When two appliances are installed side-by-side a sealing kit must be used. For combinations that involve a freezer column, this sealing kit is included. For all other (non-traditional, i.e. two wine columns, two bottom freezers, etc.) side-by-side combinations or instances where any appliances are installed less than 6-inches (152 mm) apart from one another but not connected side-by-side, purchase this kit. This kit is recommended for use with any installation in areas that are subject to humidity, or located next to an outside wall.

These warranties give you specific legal rights and you may have other rights that vary from state to state. Limited warranty from date of purchase. For complete warranty details, refer to your Use & Care manual, or ask your dealer.

Specifications are for planning purposes only. Refer to installation instructions and consult your countertop supplier prior to making counter opening. Consult with a heating and ventilation engineer for your specific ventilation requirements. For the most detailed information, refer to installation instructions accompanying product or write to Thermador indicating the model number. Specifications are correct at time of printing. Thermador reserves the right to change product specifications or design without notice. Some models are certified for use in Canada. Thermador is not responsible for products that are transported from the U.S. for use in Canada.

1 800 735 4328 | USA THERMADOR.COM | CANADA THERMADOR.CA | ©2020 BSH HOME APPLIANCES CORPORATION. ALL RIGHTS RESERVED.


PV-85
March 22, 2021

HOME APPLIANCES

LG LAUNDRY

WM3800HBA

5.2 cu.ft. Capacity Front Load Washer

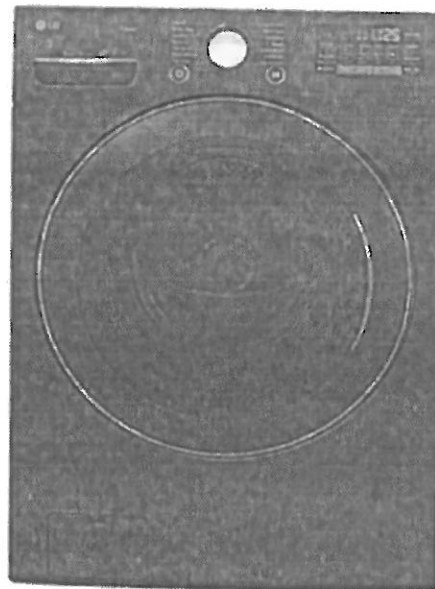

TurboWash™ Technology
Steam Technology
SmartThinQ® Technology (Wi-Fi Enabled)
6Motion™ Technology
2018 ENERGY STAR Most Efficient
Inverter BLDC Pump Motor
SmartDiagnosis™



Enjoy new ways to control your home with LG smart appliances

SmartThinQ®

CAPACITY	
Capacity	5.2 cu.ft.
APPEARANCE	
Design Look	Front Control
Intelligent Electronic Controls with Dual LED Display	-
Touch Buttons	-
Dial-A-Cycle™	-
ENERGY	
2018 Energy Star Most Efficient	-
CEE Tier	2
WASH PROGRAMS	
No. of Programs	14
Normal, Heavy Duty, Bedding, Sanitary, Allergiene™, Bright Whites™, Tub Clean, Deep Wash, Perm. Press, Delicates, Towels, Speed Wash, Sportswear, Downloaded	
No. of Options	12
Steam, Fresh Care, Pre Wash, Remote Start, Delay Wash, Wi-Fi, Add Garments, TurboWash™, Cold Wash, Extra Rinse, Rinse+Spin, Control Lock	
No. of Wash/Rinse Temps	5
Extra Hot, Hot, Warm, Cold, Tap Cold	
Spin Speeds	Extra High, High, Medium, Low, No Spin
No. of Water Levels	Automatically adjusts to the size of load
No. of Soil Levels	5
FABRIC CARE FEATURES	
ColdWash™ Option	-
SenseClean™ System	-
Steam Technology	-
Allergiene™ Cycle	-
Sanitary Cycle	-
CONVENIENCE FEATURES	
4 Tray Dispenser	Prewash, Main Wash (with liquid detergent cup), Bleach, Fabric Softener
TrueBalance™ Anti-Vibration System	-
SmartDiagnosis™	-
LoadSense	-
Status Indicator(s)	-
End of Cycle Signal	-
Child Lock	-
Auto Suds Removal	-
Forced Drain System	-
LoDecibel™ Quiet Operation	-
Easy Loading Tilt™	-
Wi-Fi Connectivity	-
Energy Monitoring	-

MOTOR AND AGITATOR

Motor Type	Direct Drive Motor
Motor Speed	Variable
Max RPM	1,300
Axis	Horizontal

MATERIALS AND FINISHES

NeveRust™ Stainless Steel Drum	-
Cabinet	PCM
Control Panel	Plastic
Top Plate	Painted Steel
Door/Rim	Glass / Chrome (with Dark Blue Tinted Round Cover)
Available Colours	Black Steel (B)

POWER SOURCE

Ratings	UL Listed
Electrical Requirements	120V, 10 Amps
Type	Electric

OPTIONS / ACCESSORIES

Pedestal	WDP4B
Pedestal Dimensions (WxHxD)	27" x 14 1/8" x 28 2/5"
SideKick™ Pedestal Washer	WD100CB
SideKick™ Pedestal Washer (WxHxD)	27" x 14 1/8" x 30 3/4" (50 9/16" with door open)
Stacking Kit	KSTK1
Hose Included	No

DIMENSIONS

Product (WxHxD)	27" x 39" x 30 1/4" (55"D with door open)
Carton (WxHxD)	29 1/2" x 43 5/16" x 31 5/16"
Weight (Product/Carton)	187.4 lbs / 209.4 lbs

LIMITED WARRANTY

1 Year Parts and Labour, 3 Years on Drum, 10 Years on Direct Drive Motor

UPC CODES

WM3800HBA Washer (Black Steel)	772454071720
DLEX3900B Electric Dryer (Black Steel)	772454071737
DLGX3901B Gas Dryer (Black Steel)	772454071744

© 2018 LG Electronics Canada, Inc. All rights reserved. "LG Life's Good" is a registered trademark of LG Corp. All other product and brand names are trademarks or registered trademarks of their respective owners. Design, features and specifications are subject to change without notice. Non-metric weights and measurements are approximate. Some features may require Internet access. Content and services may vary by product and are subject to change without notice. 05/01/2018
20 Norelco Drive, North York, Ontario M9L 2X6 Tel: 647-253-6300 | Customer Service & Parts 1-888-542-2623

LG.com

PV-88

March 22, 2021

Choosing the Proper Location

Install the washer on a solid floor that is strong and rigid enough to support the weight of the washer, even when fully loaded, without flexing or bouncing. If the floor has too much flex, you may need to reinforce it to make it more rigid. If the floor is not solid, it may cause severe vibration and noise.

NOTE

- Before installing the washer, make sure the floor is clean, dry and free of dust, dirt, water and oil so the washer feet cannot slide easily. Leveling feet that can move or slide on the floor can contribute to excess vibration and noise due to poor contact with the floor.
- If a drip pan must be used, take extra care to follow the instructions provided with the drip pan and make sure the leveling feet are adjusted for firm and even contact with the pan. Use of drip pans and failure to properly level the machine may result in increased vibration and noise during operation.
- Allow for sufficient space between the walls and the washer for installation.

Power Outlet

- The power outlet must be within 60 inches (1.5 m) of either side of the washer.
- The appliance and outlet must be positioned so that the plug is easily accessible.
- Do not overload the outlet with more than one appliance.
- The outlet must be grounded in accordance with current electrical wiring codes and regulations.
- Use a time-delay fuse or circuit breaker.

NOTE

- It is the personal responsibility and obligation of the product owner to have a proper outlet installed by qualified service personnel.


Flooring

- To minimize noise and vibration, the washer must be installed on a solidly constructed floor.
- Allowable slope under the entire washer is a maximum 1 inch (2.5 cm) difference from side to side or from front to back.
- Installing on carpeting and soft tile surfaces is not recommended.
- Never install the washer on a platform or weakly supported structure.

NOTE


- The washer must be installed on firm flooring to minimize vibration during the spin cycle. Concrete flooring is best, but a wood floor is sufficient, provided it is built to FHA standards.

Floor Installation

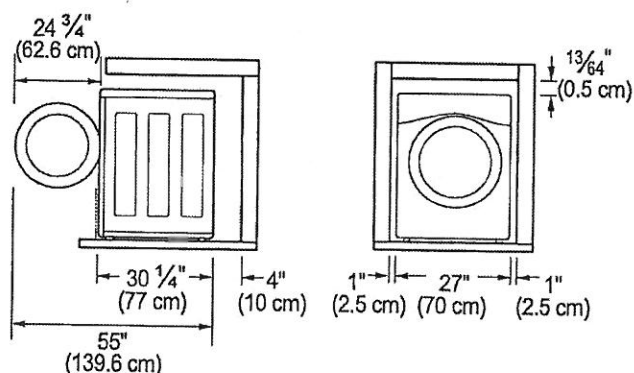

To ensure sufficient clearance for water lines, the drain line and airflow, allow minimum clearances of at least 1 inch (2.5 cm) at the sides and 4 inches (10 cm) behind the unit. Be sure to allow for wall, door, or floor moldings that may increase the required clearances.

Stacked or Pedestal Installation

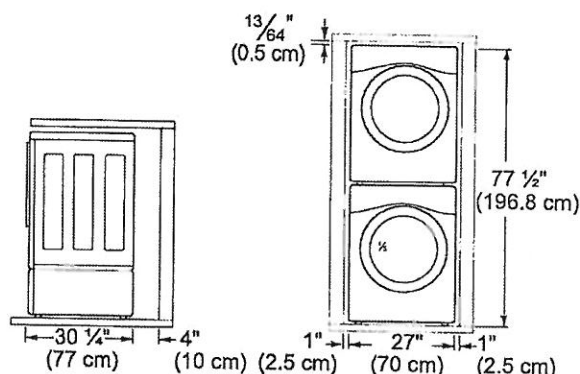

NOTE

- Refer to the instructions packaged with the optional pedestal kit before installing with a pedestal kit.
- Do not use a drip pan with a pedestal or pedestal washer installation as it can block the drawer. Using a drip pan may result in increased vibration and noise during operation.

PV-85



March 22, 2021

HOME APPLIANCES

LG LAUNDRY

DLEX3900_ / DLGX3901_

7.4 cu.ft. Front Load Dryer with TurboSteam™



KEY FEATURES

- 7.4 cu. ft. Capacity
- TurboSteam™ Technology
- LG SmartThinQ® Technology
- Sensor Dry System
- FlowSense™ Duct Clogging Indicator
- ENERGY STAR® Qualified
- Electronic Control Panel with Dual LED Display

AVAILABLE COLORS



WHITE



BLACK STEEL




SMART APPLIANCE



Enjoy new ways to control your home with LG smart appliances

- Start the laundry while you're out shopping
- Get alerts when the cycle is finished
- Works with the LG SmartThinQ® app

SmartThinQ®

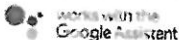

PRODUCT FEATURES


SUMMARY		FABRIC CARE FEATURES		POWER SOURCE	
Type	Front Load Dryer	Sensor Dry	Yes	Ratings	CSA Listed
Capacity	7.4 cu. ft.	Precise Temperature Control with Variable Heater	Yes	Electrical Requirements	Electric: 240V 30 Amps Gas: 120V, 15 Amps
Matching Washer	WM3900HWA / WM3900HBA	Steam	TurboSteam™	Type	Electric / Gas
Sensor Dry	Yes	CONVENIENCE FEATURES		BTU Rating	10,000 Feet
Colors	White (W) / Black Steel (B)	3 Minute Installation Check	Yes	OPTIONS	
APPEARANCE		LoDecibel™ Quiet Operation	Yes	LP Conversion Kit	383EEL3002D
Intelligent Electronic Controls with LED Display	Yes	End of Cycle Signal	Yes	Side Venting Kit	383EEL9001B
Dial-A-Cycle™	Yes	Drum Light	Yes	Pedestal	WDP4W / WDP4B
Touch Buttons	Yes	Reversible Door	Yes	Pedestal (WxHxD)	27 x 14 1/8 x 30 3/4 (50 1/2 D with door open)
ENERGY		FlowSense™ Duct Clogging Indicator	Yes	DIMENSIONS	
ENERGY STAR® Qualified	Yes	Wrinkle Care Option	Yes	Product (WxHxD)	27" x 38 11/16" x 30"
DRYER PROGRAMS		Child Lock	Yes	Depth with Door Open	51"
No. of Programs	14	Venting Option	Electric: 4 Way Venting Gas: 3 Way Venting	Carton (WxHxD)	29 19/32" x 43 3/8" x 31 3/8"
	Normal, Heavy Duty, Bedding, Small Load, Anti Bacterial, SteamSanitary™, SteamFresh™, Perm Press, Delicates, Sportswear, Towels, Speed Dry (Manual Dry), Air Dry (Manual Dry), Downloaded	4 Adjustable Legs	Yes	Weight (Product)	Electric: 123lbs Gas: 125.7lbs.
DRYER OPTIONS		Remaining Time Display/Status Indicator(s)	Yes	Weight Carton	Electric: 136.2lbs. Gas: 138.9lbs.
No. of Options	13	SmartThinQ® SMART FEATURES		LIMITED WARRANTY	
	More Time, Less Time, Damp Dry Signal, Wrinkle Care, Control Lock, Custom Program, PGM Save, Wi-Fi Connect, Energy Saver, TurboSteam™, Reduce Static, Smart Grid, Remote Start	SmartDiagnosis™	Yes	Parts & Labor	1 Year
DRYER DETAILS		Wi-Fi Connectivity	Yes	UPC CODES	
Temperature Settings	High, Medium High, Medium, Low, Ultra Low	Remote Control	Yes	DLEX3900W (Electric / White)	048231025195
Drying Levels	Very Dry, More Dry, Normal Dry, Less Dry, Damp Dry	Cycle Monitoring and Notification	Yes	DLEX3900B (Electric / Black Steel)	048231026437
Manual Dry Times	60 min., 50 min., 40 min., 30 min., 20 min., More Time/Less Time	Energy Monitoring	Yes	DLGX3901W (Gas / White)	048231025201
		MATERIALS AND FINISHES		DLGX3901B (Gas / Black Steel)	048231026444
		Aluminized Alloy Steel Drum	Yes		
		Tub Rear	Painted		
		Cabinet	Painted Steel		
		Door	Round w/ Chrome trim		

© 2019 LG Electronics USA, Inc. All rights reserved. "LG Life's Good" is a registered trademark of LG Corp. All other product and brand names are trademarks or registered trademarks of their respective owners. Design, features and specifications are subject to change without notice. Non-metric weights and measurements are approximate. Some features may require Internet access. Content and services may vary by product and are subject to change without notice. 2/7/19

PV-85  
March 22, 2021

PRODUCT OVERVIEW

Parts

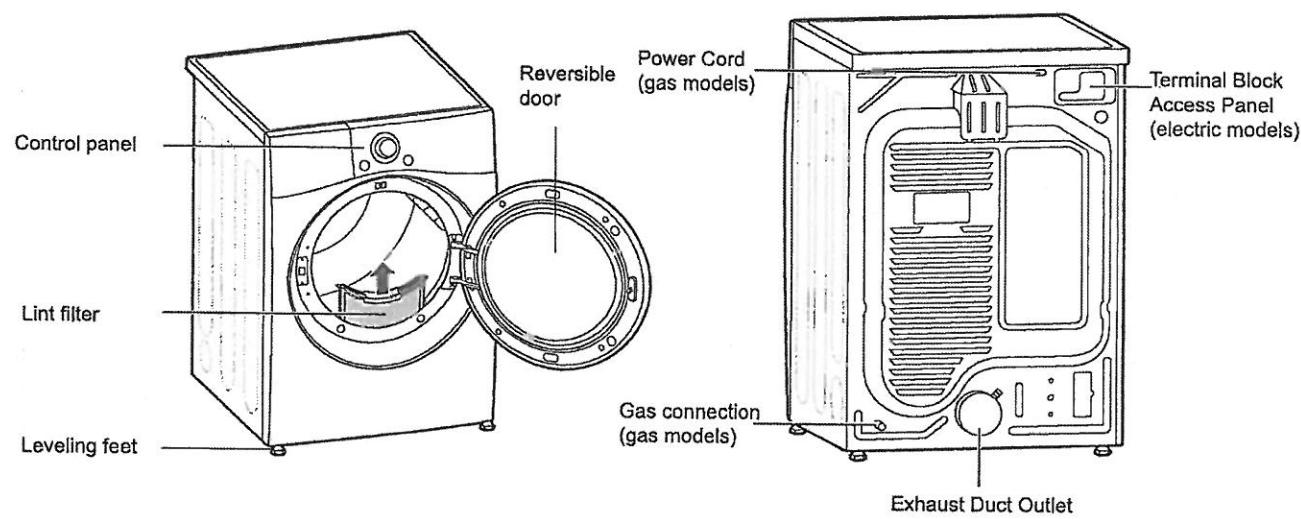

Product Specifications

The appearance and specifications listed in this manual may vary due to constant product improvements.

Dryer Models		DLE3500* / DLG3501*	DLEX3700* / DLGX3701*	DLEX3900* / DLGX3901*
Description		Non-steam Dryer	Steam Dryer	Steam Dryer
Electrical requirements		Please refer to the rating label for detailed information.		
Gas requirements		NG: 4 - 10.5-inch (10.2 - 26.7 cm) WC LP: 8 - 13-inch (20.4 - 33.1 cm) WC		
Dimensions		27" (W) X 30.2" (D) X 39" (H), 51.4" (D with door open) 68.6 cm (W) X 76.5 cm (D) X 99 cm (H), 130.5 cm (D with door open)		
Net weight		Gas : 123.02 lb (55.8kg) - 126.77 lb (57.5kg) Electric : 120.15 lb (54.5kg) - 123.46 lb (56kg)		
Drying capacity	Steam Cycle	-	IEC 7.4 cu.ft. (8 lb/3.6 kg)	
	Normal Cycle	IEC 7.4 cu.ft. (22.5 lb/10.2 kg)		


NOTE

Model numbers can be found on the cabinet inside the door.

PV-85 
March 22, 2021

12 INSTALLATION

Clearances

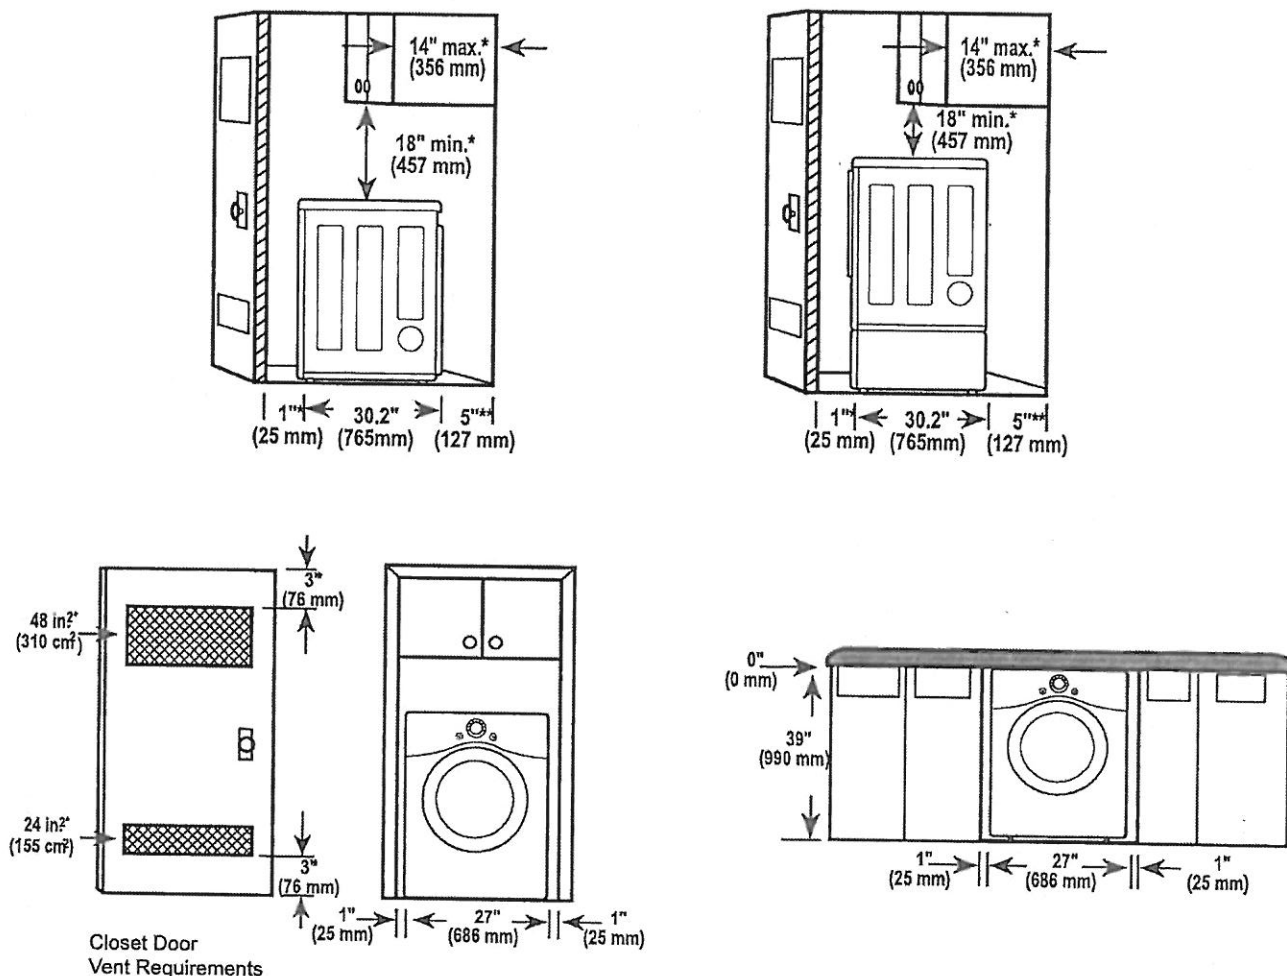

Installation Spacing for Recessed Area or Closet Installation

The following clearances are recommended for this dryer. This dryer has been tested for clearances of 1 inch (2.5 cm) on the sides and rear. Recommended clearances should be considered for the following reasons:

- Additional clearances should be considered for ease of installation and servicing.
- Additional clearances should be considered on all sides of the dryer to reduce noise transfer. For closet installation, with a door, minimum ventilation openings in the top and bottom of the door are required. Louvered doors with equivalent ventilation openings are acceptable.

Closet Ventilation Requirements


Closets with doors must have both an upper and lower vent to prevent heat and moisture buildup in the closet. One upper vent opening with a minimum opening of 48 sq. in. (310 cm²) must be installed no lower than 6 feet above the floor. One lower vent opening with a minimum opening of 24 sq. in. (155 cm²) must be installed no more than one foot above the floor. Install vent grills in the door or cut down the door at the top and bottom to form openings. Louvered doors with equivalent ventilation openings are also acceptable.

NOTE

- There should be at least a little space around the dryer (or any other appliance) to eliminate the transfer of vibration from one appliance to another. If there is enough vibration, it could cause appliances to make noise or come into contact, causing paint damage and further increasing noise.

PV-85
March 22, 2021

Installation Spacing for Recessed Area or Closet, with Stacked Washer and Dryer

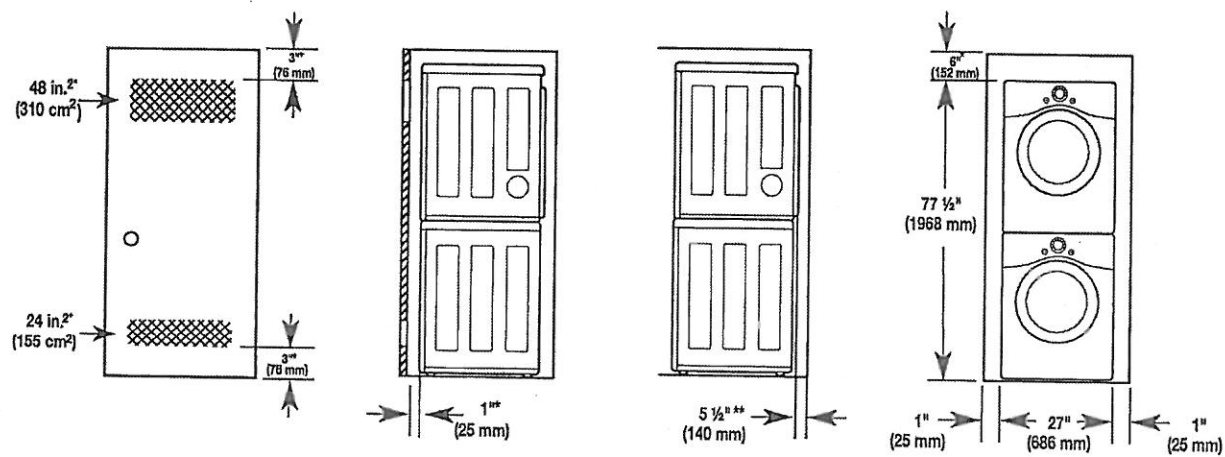


* Required spacing

** For side or bottom venting, 2-inch (5.1 cm) of spacing is allowed.

Installation Spacing for Cabinet

For cabinet installation with a door, minimum ventilation openings in the top of the cabinet are required.

* Required spacing

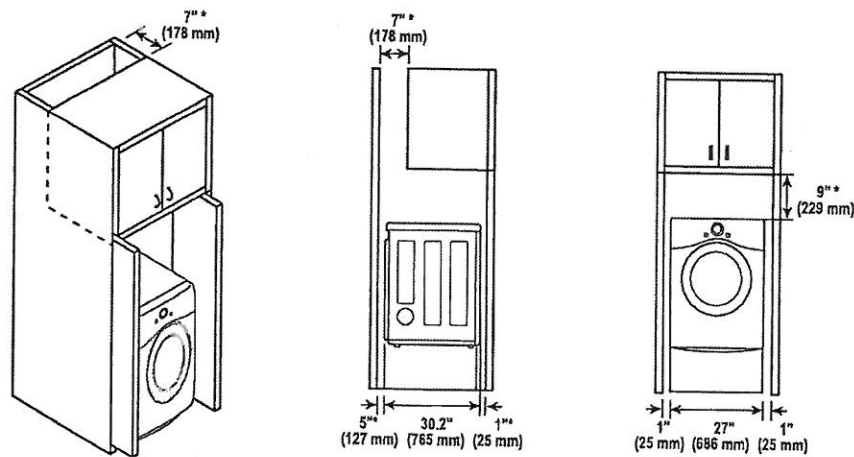

PV-85 
March 22, 2021

SAXONY

SPRBC056D1SS

Silhouette
PROFESSIONAL
www.silhouetteappliances.com

BENEFITS

Model #	SPRBC056D1SS
Capacity-Wine Compartment	Stores up 126 beverage cans and 6 bottles of wine
Volume	5.6 cu. ft.
Temperature Range	34F – 50F (1C-10C)
Noise	39 db
Door Frame	304 grade seamless stainless steel
Cabinet	Matte black textured steel
Interior Finish	Matte black
Door Style	Single door
Reversible Door Swing	Yes
Door Hinge	Hidden for flush fit installation
Door Glass	Low E, dual pane argon filled
Door Handle	Pro-style, 20% longer than previous model
Door Lock	Yes
Shelving Material	3 adjustable clear glass shelves
Lighting Option 1	On/Off with door opening
Lighting Option 2	On 100% illumination for 2 hours
Lighting Option 3	On 50% illumination for 2 hours
Light Colours	Choose between Arctic white or Azure blue
Controls	Digital seamless capacitive touch
Temperature Recall	Yes reverts to last set temperature after power outage
Alarm	Yes, temperature and door ajar
Sabbath Mode	Yes

PRODUCT SPECIFICATIONS

UPC 067638024273

Unit Dimensions

Width 23.8" in.
Min. Height 34" in.
Max. Height 34.7" in.
Depth 23.8" in.
(DOES NOT INCLUDE HANDLE)

Installation




Gross Weight: 136 lbs.
Built-in under counter or free standing
Refrigerator: R600
Size: Min 24" wide opening required

AC Power

115V, 60Hz at MAX 1.5A
Power cord length: 6.5 ft.


Platinum Warranty

2 year parts and labor coverage

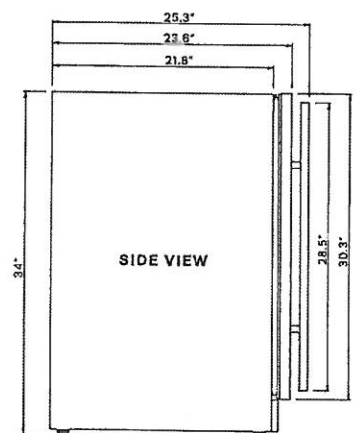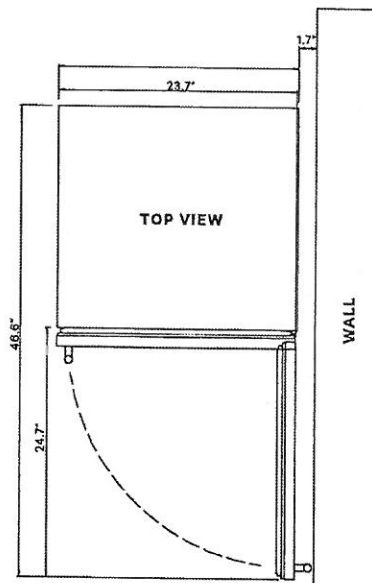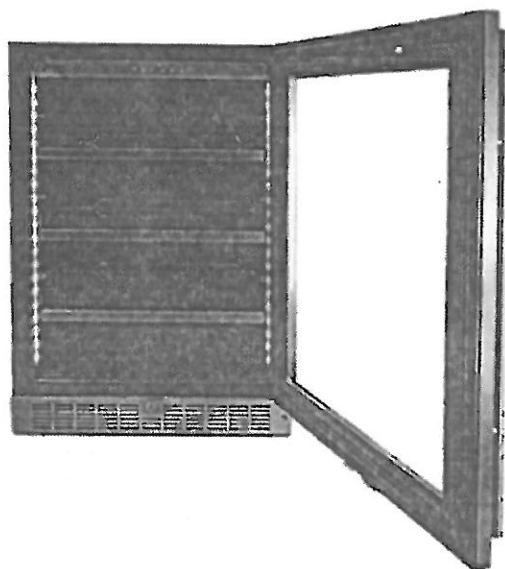

*based on standard 750ml bordeaux style bottle

Danby USA 1-866-649-3309 Danby Canada 1-800-461-4492
03.09.20-V4

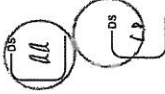PV-85 
March 22, 2021

INSTALLATION INSTRUCTIONS

PREPARING THE ENCLOSURE

Gloves and safety goggles should be worn during installation.

It is not recommended to install the appliance into a corner or directly beside a wall. The door will need to be opened more than 90° to allow full extension of the shelves. If it is necessary to place the unit next to a wall or in a corner, leave at least 2-4 inches (5-10 cm) of space between the wall and the appliance to allow for the door opening.



The cabinet opening must be at least 24 inches (61 cm) wide by 35 inches (88.9 cm) high by 25 inches (63.5 cm) deep.

Note: The listed depth requirement is assuming that the electrical outlet is located in the adjacent cabinetry or flush mounted in the rear wall, not surface mounted inside the enclosure.

If the electrical outlet is located inside adjacent cabinetry, cut a 1.5 inch (3.8 cm) diameter hole to admit the power cord. If the cabinet wall is metal, the hole edge must be covered with a bushing or grommet.

REQUIRED TOOLS

- Safety goggles
- Gloves
- Tape measure
- Carpenter square
- Level
- Flashlight
- Electric drill with hole bit

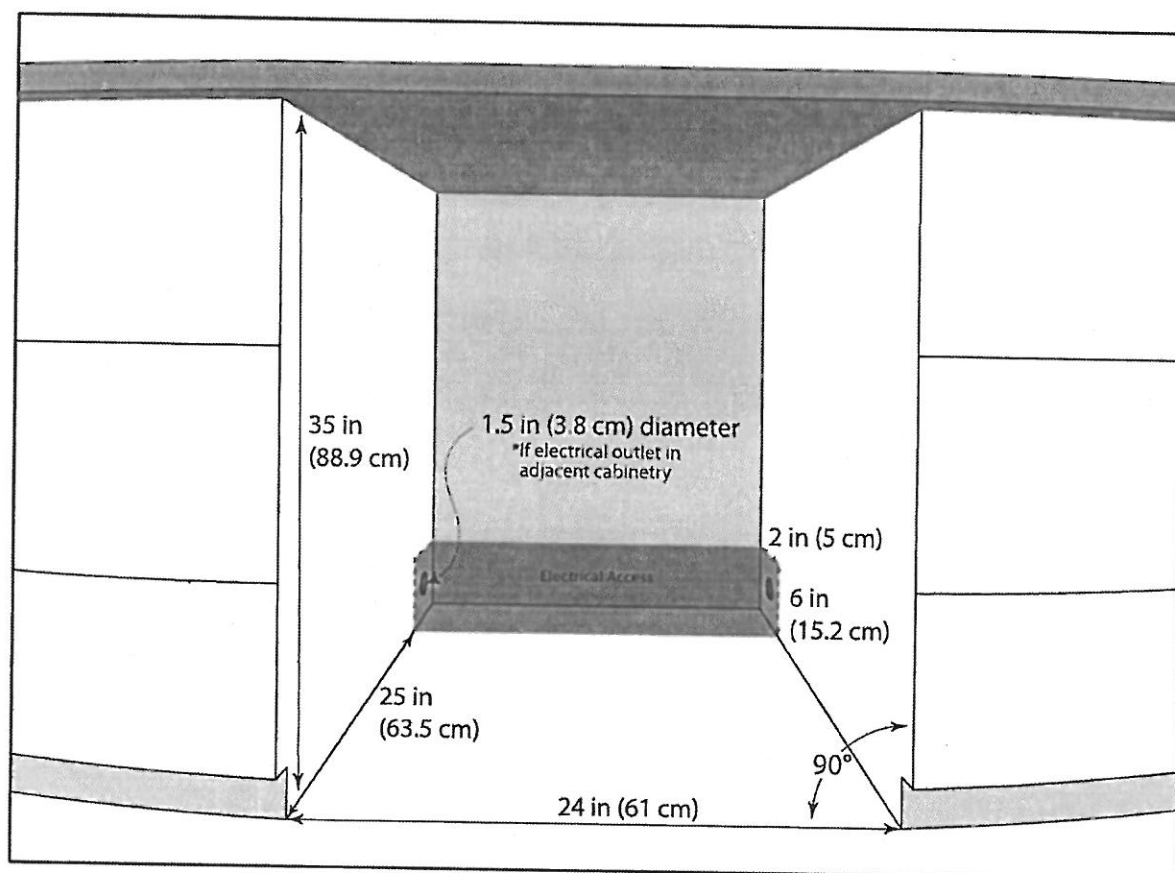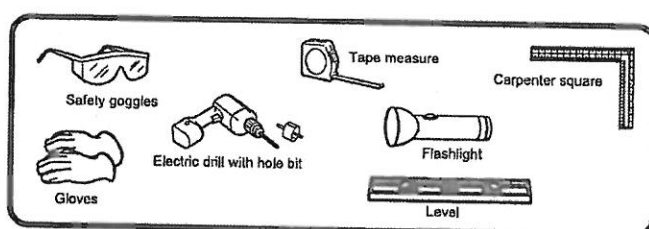

PV-85  
March 22, 2021



Microwave Ovens Countertop
Countertop NN-ST681SC

Model Number		NN-ST681SC
Type		Mid-size
Capacity		1.2 cu.ft.
Technology		Inverter®
Power	Microwave	1,200 W
	Grill	NA
	Grill Power Level	NA
	Convection	NA
Combination	Microwave + Grill	NA
	Power Level	NA
Design	Colour	Stainless Steel
	Dial / Button	-
	Door Release	Push Open
	Finish	Half Mirror
Control Panel	Panel Design	Touch pad
Display	Type	4 Digit
	Colour	Green
	Back Light	yes
Power Level + Other.	Power Level	10
	Delay Start	yes
	Clock	12 Hour
	Child Lock	yes
	Stage Cooking	3 Stage
Menu	Sensor	yes


PV-85  
 March 22, 2021

		Turbo Defrost	yes
		Popcorn	yes
		Keep Warm	yes (up to 30 minutes)
		Quick Min	yes (up to 10 minutes)
		Auto Reheat	Sensor Reheat
		# of Auto Cook Categories	12
Turntable Size			340 mm
Accessory			Glass Tray
Trim Kit			NNTK621S
Power Source			120 V / 60 Hz
Power Consumption	Microwave		1,480 W
	Grill		NA
	Combination		NA
Cooking Power	Microwave		1,200 W
	Grill		NA
Dimensions	Outside (W × D × H)		525 × 401 × 310 mm 20.7 × 15.8 x 12.3 inch
	Oven (W × D × H)		355 × 365 × 251 mm 13.9 x 14.4 x 9.9 inch
Weight	Net		11.5 kg
	Shipping		13.0 kg
NOTE		Specifications are subject to change without notice.	

PV-85
March 22, 2021

VCIN36GWS
36-INCH CUSTOM INSERT
PROFESSIONAL® SERIES

Thermador

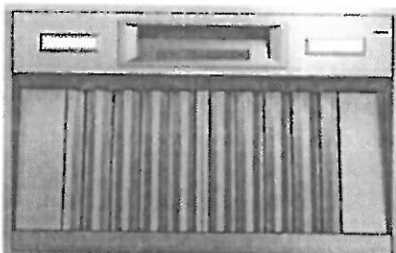

FEATURES & BENEFITS

- Revel in creative freedom with Professional® Series custom inserts that can blend in with cabinetry or make a bold statement
- ★ Equipped with the Thermador Connected Experience by Home Connect™
- Powerfully Quiet® system accepts integral, inline, and remote blowers
- Beautiful illumination with multi-level, vivid LED lights
- Features automatic mode, delay shut-off, and check filter light

ACCESSORIES (OPTIONAL)

25 ft. Blower Connector Cable - EXTNCB25W

For use with the following inline and remote blowers: VTR630W, VTR1030W, VTR1330W, VTI610W, VTI1010W

Roofplates

RFPLT600P - For use with 600 CFM remote blower VTR630W

RFPLT1000P - For use with 1000 CFM remote blower VTR1030W and 1300 CFM blower VTR1330W

VCIN Trim Notes

NOTE: VCIN_GWS series custom insert models include hood trim pieces to complete the installation.

Remote Control Panel

REMCPUW - Ability to vertically install on cabinetry or wall to control hood in a convenient location



GENERAL PROPERTIES

Features

Multi-Level LED Lights with Fading Transitions, Automatic Mode, Check Filter Reminder Light, Delay Shut-Off

Operating Mode	Ducted
Maximum CFM	Blower Sold Separately
Number of Speed Settings	4-Stage
Number of Lights	2
Bulb Type	LED
Light Lumens	100 – 150
Light Color (°K)	3500 – 4000
Total Power of the Lamps (W)	2.4 W
Damper Included	Yes
Grease Filter Material	Washable Stainless Steel
Grease Filter Type	Stainless-Steel Commercial Style Baffle Filter
Home Connect™ (Wi-Fi Enabled)	Yes

TECHNICAL DETAILS

Watts (W)	See Chart on Page 3
Current (A)	See Chart on Page 3
Volts (V)	120 V
Frequency (Hz)	60 Hz
Plug Type	Fixed Connection
Power Cord / Conduit Length (in)	Direct Wire at Junction Box

DIMENSIONS & WEIGHT

Overall Appliance Dimensions (Width of Canopy Included) (HxWxD) (in)	12 13/16" x 33 3/4" x 22"
Minimum Required Distance Above Gas / Electric Cooking Surface	30" Electric / 30" Gas
Diameter of Air Duct (in.) Top	10"
Net Weight (lbs)	54 lbs

ACCESSORIES (REQUIRED)

Blower (Sold Separately)

BLOWER OPTIONS

Remote Blowers (Mounted to Roof or External Wall)	VTR630W - 600 CFM
	VTR1030W - 1000 CFM
	VTR1330W - 1300 CFM
Inline Blowers (Mounted Between Kitchen and External Wall)	VTI610W - 600 CFM
	VTI1010W - 1000 CFM
Integrated Blower (Mounted in Hood)	VTN630W - 600 CFM
	VTN1090R - 1000 CFM

WARRANTY

Limited Warranty Parts and Labor	2 Year
----------------------------------	--------

★ THERMADOR® EXCLUSIVE


PV-85  
March 22, 2021

VCIN36GWS
36-INCH CUSTOM INSERT
PROFESSIONAL® SERIES



HOOD DIMENSIONS

NOTE: VCIN Custom Insert models include hood trim pieces.

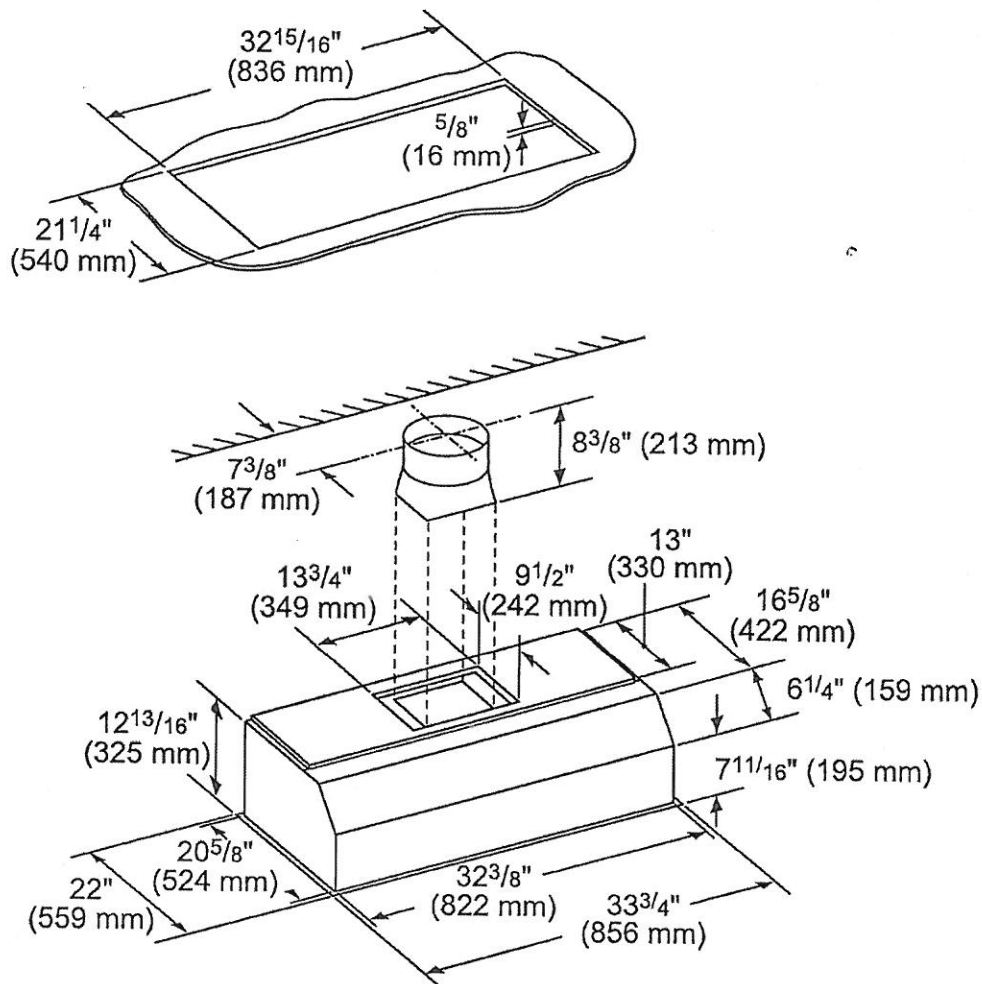

measurements in inches (mm)

PV-85  
 March 22, 2021


VCIN36GWS
 36-INCH CUSTOM INSERT
 PROFESSIONAL® SERIES




MODEL	DESCRIPTION		ELECTRIC LOAD					
			VTN630W	VTN1090R	VTI610W	VTI1010W	VTR630W	VTR1030W
VCIN36GWS	36" Custom Insert	Amps	4.0	7.4	5.9	7.8	5.9	7.8
		Watts	480	888	708	936	708	936
								11.3
								1,356

REMOTE BLOWERS (MOUNTED TO ROOF OR EXTERNAL WALL)


VTR630W-600 CFM

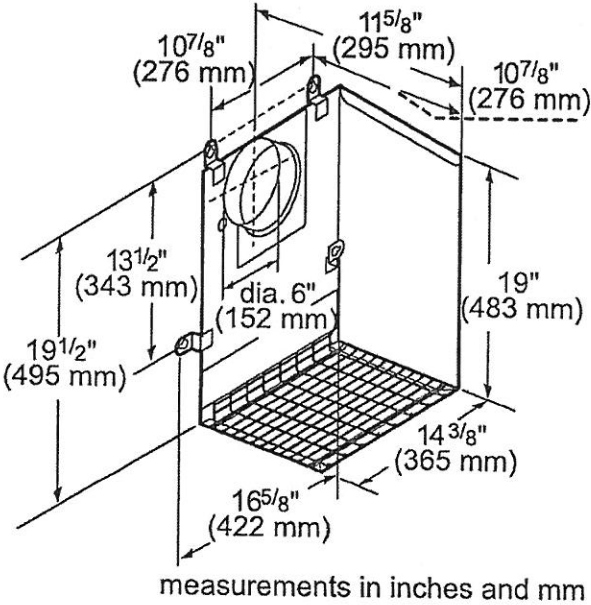

VTR1030W-1000 CFM

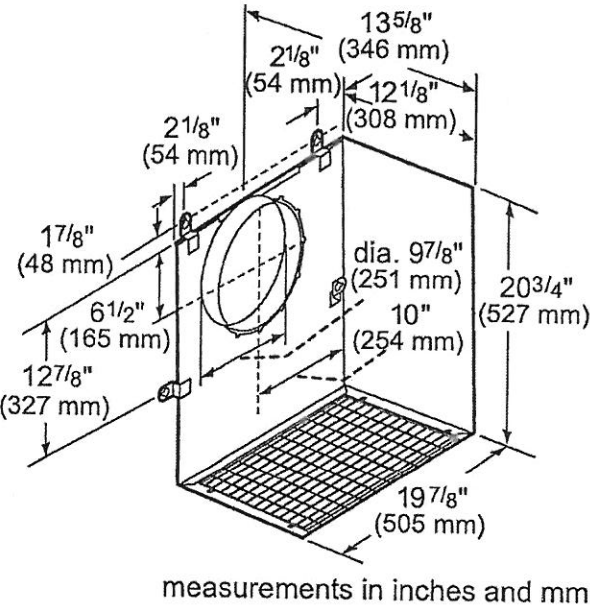

VTR1330W-1300 CFM

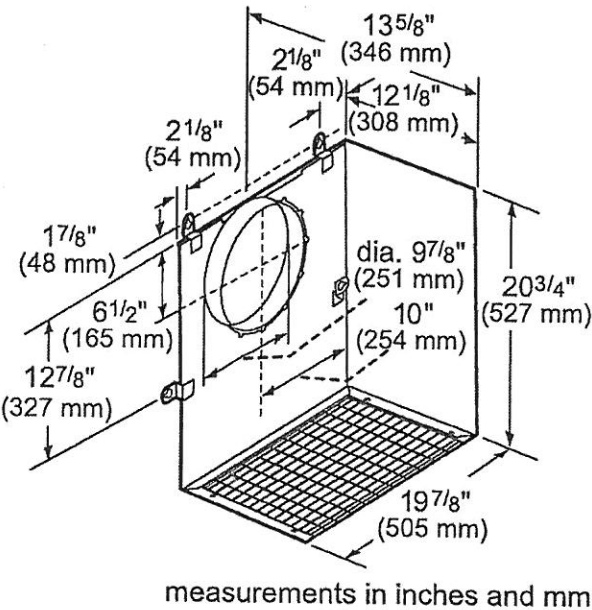


PV-85  
March 22, 2021

VCIN36GWS
36-INCH CUSTOM INSERT
PROFESSIONAL® SERIES




INLINE BLOWERS (MOUNTED BETWEEN KITCHEN AND EXTERNAL WALL)

VTI610W-600 CFM

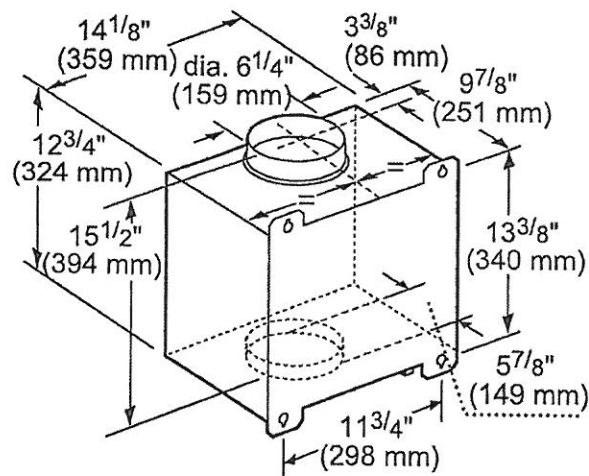

measurements in inches and mm


VTI1010W-1000 CFM

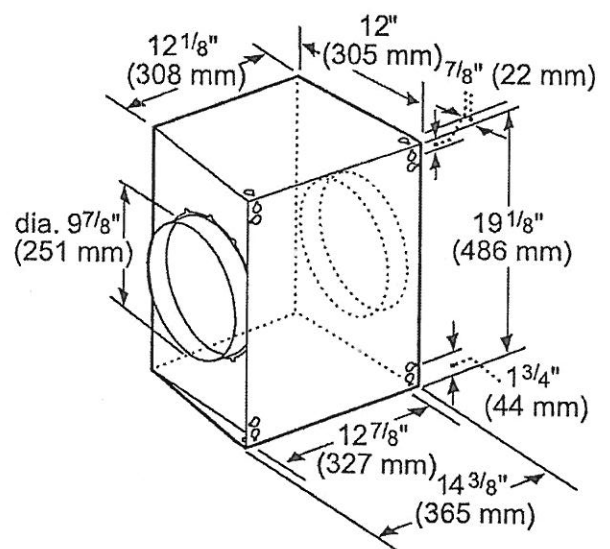

measurements in inches and mm


INTEGRATED BLOWERS (MOUNTED IN HOOD)

VTN630W-600 CFM

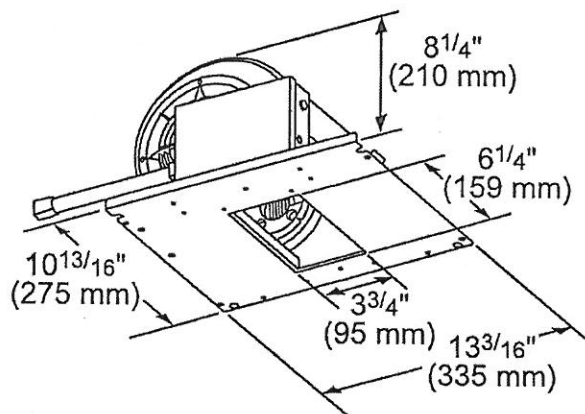

measurements in inches (mm)

VTN1090R-1000 CFM

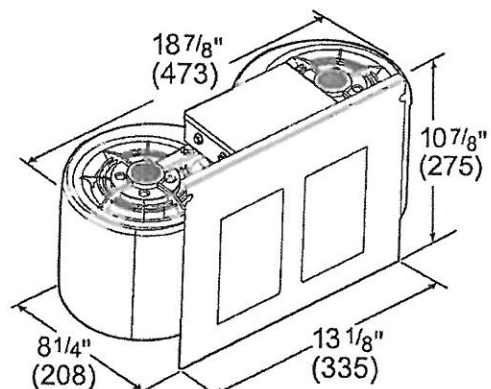

measurements in inches and mm


PV-85  
March 22, 2021

VCIN36GWS
36-INCH CUSTOM INSERT
PROFESSIONAL® SERIES




REMOTE BLOWER ACCESSORIES

ROOFPLATE-RFPLT600P

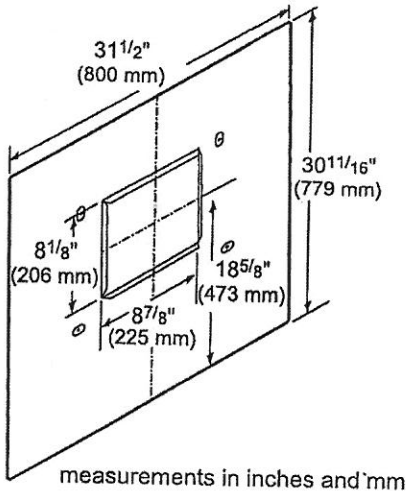

ROOFPLATE-RFPLT1000P

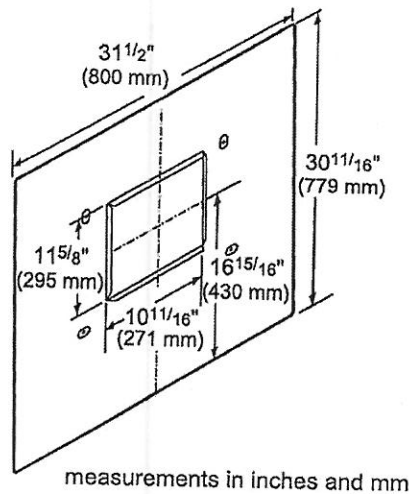

EXTNCB25W


For use with the following Inline and Remote Blowers: VTR630W, VTR1030W, VTR1330W, VT1610W, VT11010W

OPTIONAL ACCESSORIES

REMOTE CONTROL PANEL
REMC PW



Convenience at your fingertips: The remote control accessory offers the freedom to extend your hood controls to a more reachable spot

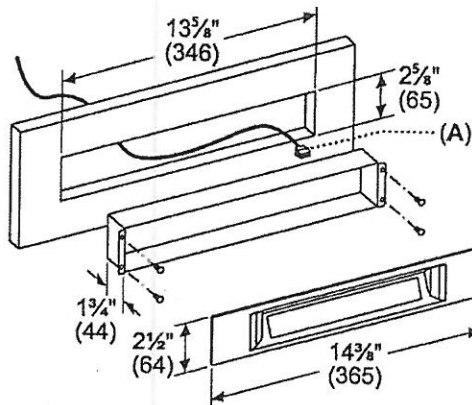


These warranties give you specific legal rights and you may have other rights that vary from state to state. Full warranty and limited warranty from date of installation. For complete warranty details, refer to your Use & Care manual, or ask your dealer.

Specifications are for planning purposes only. Refer to installation instructions and consult your countertop supplier prior to making counter opening. Consult with a heating and ventilation engineer for your specific ventilation requirements. For the most detailed information, refer to installation instructions accompanying product or write to Thermador indicating the model number. Specifications are correct at time of printing. Thermador reserves the right to change product specifications or design without notice. Some models are certified for use in Canada. Thermador is not responsible for products that are transported from the U.S. for use in Canada.

1 800 735 4328 | USA THERMADOR.COM | CANADA THERMADOR.CA | ©2020 BSH HOME APPLIANCES CORPORATION. ALL RIGHTS RESERVED.

PV-85
March 22, 2021

600 CFM Integral Blower

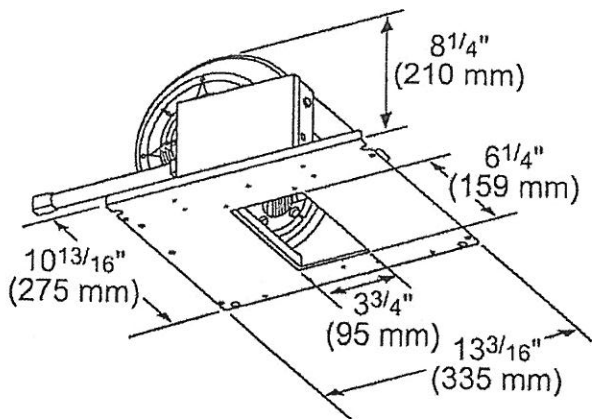

measurements in inches (mm)

Product Features

	Accessory
Brand	Thermador
SKU	VTN630W
Internal article number	VTN630W
EAN code	825225934738
Product packaging dimensions (HxWxD) (in)	12 1/8" x 13 3/8" x 19 7/8"
	11
	13
UPC code	825225934738
	MCSA02216228_I7490_1621980_VTN630W_PA

Technical Specification

Notes: Please refer to installation instructions. Installation instructions are available at www.thermador.com. Specifications are correct at the time of printing. Thermador reserves the right to change product specifications and design at any time, without notice.

1 800 735 4328 | WWW.THERMADOR.COM | 1901 Main Street, Suite 600 Irvine, CA 92614

©2020 BSH HOME APPLIANCES CORPORATION, ALL RIGHTS RESERVED LITHO DATE: 09/2020