




LOT NUMBER: 1
UNIT NAME: THE BEAUMONT
ELEVATION: A CORNER FRONT(REV)
UNIT NUMBER: 5004



LOT NUMBER: 1
UNIT NAME: THE BEAUMONT
ELEVATION: A CORNER FLANKAGE-LOGGIA(REV)
UNIT NUMBER: 5004

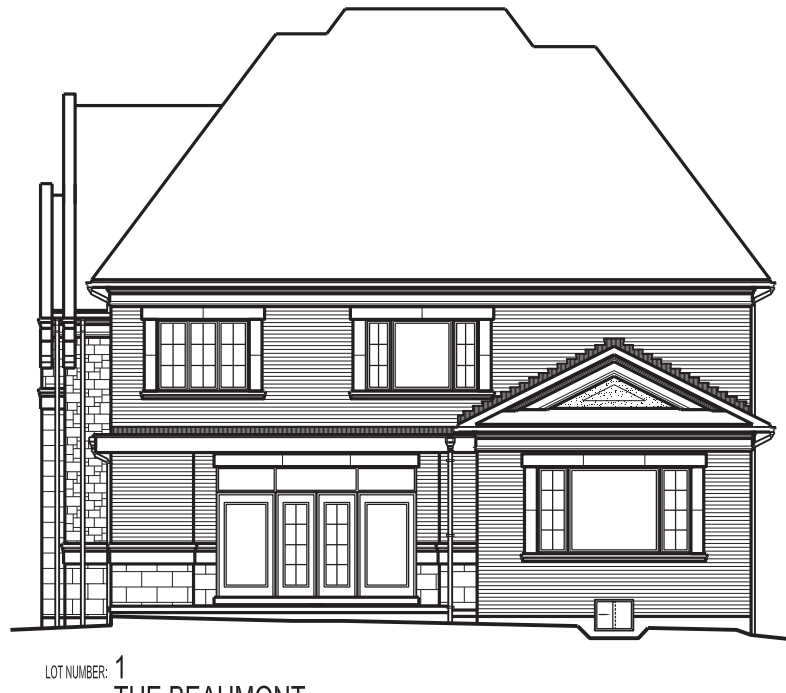

LOT NUMBER: 1
UNIT NAME: THE BEAUMONT
ELEVATION: A CORNER REAR-LOGGIA(REV)
UNIT NUMBER: 5004

LEGEND:

- 1

BRICK/ STONE VENEER ON SIDES OF STAIRS
(POURED OR "BRICK LEDGE" PRECAST)
- 2

DROP OR RAISE BANDING
BY AMOUNT INDICATED.
- 3

ADD BANDING AND/OR TRIM
AS INDICATED.
- 4

ADDED CAMBERED HEADERS
- 5

8'-0" X 8'-0" GARAGE DOORS.
- 6

DROPPED OR RAISED SOFFIT AS INDICATED.
- 7

ADJUSTED ROOF OVERHANG
AS INDICATED ON ROOF PLAN.
- 8


PROVIDE GUARD FER
CONSTRUCTION NOTE 11.
- 9

FOYER SUNKEN AS INDICATED
- 10

LIGHT FIXTURE RELOCATED
AS INDICATED.

LOT 1

JOHN G. WILLIAMS LTD., ARCHITECT
ARCHITECTURAL CONTROL REVIEW
AND APPROVAL

APPROVED BY: 
DATE: JAN 19, 2022

It is the builder's complete responsibility to ensure that all plans submitted for approval fully comply with the Architectural Guidelines and all applicable regulations and requirements including zoning provisions and any provisions in the subdivision agreement. The Control Architect is not responsible in any way for examining or approving site (lotting) plans or working drawings with respect to any zoning or building code or permit matter or that any house can be properly built or located on its lot.

This is to certify that these plans comply with the applicable Architectural Design Guidelines approved by the City of VAUGHAN.

This stamp certifies compliance with the applicable Design Guidelines only and bears no further professional responsibility.