



CONSTRUCTION SUMMARY

Lot: 48

Model: 50.03 A OAKGROVE OPT. 5 BEDROOM

Project/Phase: Pine Valley Forevergreen / 1

APPLIANCES

Invoice	Qty.	Description
2936 72,217 10Dec21 **	1	KITCHEN - UPGRADE TO 8" DUCT (EXTERIOR WALL) IN LIEU OF STANDARD OFFERING

CERAMIC

Invoice	Qty.	Description
2947 11Mar22 NoCat	1	FRONT FOYER: UPGRADE 7 FLOOR TILE - 30X30" LAID IN STRAIGHT, STACKED PATTERN.
2947 11Mar22 NoCat	1	FRONT FOYER: UPGRADE GROUT
2947 11Mar22 NoCat	1	POWDER ROOM: UPGRADE 5 HEX FLOOR TILE
2947 11Mar22 NoCat	1	POWDER ROOM: UPGRADE FLOOR GROUT
2947 11Mar22 NoCat	1	MUDROOM + OUTSIDE POWDER ROOM: UPGRADE 5 HEX FLOOR TILE
2947 11Mar22 NoCat	1	MUD ROOM: UPGRADE FLOOR GROUT
2947 11Mar22 NoCat	1	MASTER ENSUITE: UPGRADE 9 FLOOR TILE: 30X60" LAID IN STRAIGHT, STACKED PATTERN. SEE PLAN FOR TILE DIRECTION
2947 11Mar22 NoCat	1	MASTER ENSUITE: UPGRADE 9 WALL TILE - 30X60" LAID IN HORIZONTAL STACKED PATTERN.
2947 11Mar22 NoCat	1	MASTER ENSUITE SHOWER FLOOR: UPGRADE 7 MARBLE MOSAIC
2947 11Mar22 NoCat	1	MASTER ENSUITE - FLOOR + SHOWER WALL + SHOWER FLOOR: UPGRADE GROUT
2947 11Mar22 NoCat	1	SHARED ENSUITE 2/5: UPGRADE 3 FLOOR TILE - 12X24" LAID IN STRAIGHT, STACKED PATTERN. SEE PLAN FOR TILE DIRECTION



CONSTRUCTION SUMMARY

Lot: 48

Model: 50.03 A OAKGROVE OPT. 5 BEDROOM

Project/Phase: Pine Valley Forevergreen / 1

CERAMIC

Invoice	Qty.	Description
2947 11Mar22 NoCat	1	SHARED ENSUITE 2/5: UPGRADE 1 WALL TILE - 3X6"
2947 11Mar22 NoCat	1	SHARED ENSUITE 2/5: LAY WALL TILE IN HERRINGBONE PATTERN
2947 11Mar22 NoCat	1	SHARED ENSUITE 2/5: FLOOR + WALL TILE - UPGRADE GROUT
2947 11Mar22 NoCat	1	SHARED ENSUITE 3/4: UPGRADE 3 BATHROOM FLOOR TILE + SHOWER FLOOR TILE - HEX
2947 11Mar22 NoCat	1	SHARED ENSUITE 3/4: UPGRADE 4 WALL TILE - 2X10"
2947 11Mar22 NoCat	1	SHARED ENSUITE 3/4: LAY WALL TILE IN HORIZONTAL BRICK PATTERN.
2947 11Mar22 NoCat	1	SHARED ENSUITE 3/4: UPGRADE GROUT - FLOOR + SHOWER FLOOR + SHOWER WALL
2947 11Mar22 NoCat	1	LAUNDRY ROOM: UPGRADE 4 FLOOR TILE - 8X8" INSTALLED IN STRAIGHT STACKED 'RANDOM' PATTERN
2947 11Mar22 NoCat	1	LAUNDRY ROOM: UPGRADE GROUT ON FLOOR

CONCRETE AND DRAIN

Invoice	Qty.	Description
2799 08Jun21 NoCat	1	BACK-FLOW PREVENTER VALVE



CONSTRUCTION SUMMARY

Lot: 48

Model: 50.03 A OAKGROVE OPT. 5 BEDROOM

Project/Phase: Pine Valley Forevergreen / 1

CROWN MOULDING

Invoice	Qty.	Description
2947 11Mar22 NoCat	1	KITCHEN: CEILING DETAIL: ADD 3 BOX WAFFLE + BEAM DETAIL - SEE ATTACHED SKETCH
2947 11Mar22 NoCat	1	GREAT ROOM: CEILING DETAIL: ADD 3 BOX WAFFLE + BEAM DETAIL - SEE ATTACHED SKETCH

DRYWALL

Invoice	Qty.	Description
2799 08Jun21 NoCat	1	MASTER BEDROOM: MODEL OPTIONS 50.03. A - MASTER BEDROOM - OPT. SITTING AREA 10 FOOT TRAY CEILING - AS PER PLAN
2936 72,377 10Dec21	1	LIVING ROOM: ADD OPT. COFFERED CEILING AS PER PLAN
2936 72,377 10Dec21	1	GREAT ROOM: MODEL OPTIONS GREAT ROOM - OPT. COFFERED CEILING AS PER PLAN
2936 72,377 10Dec21	1	KITCHEN / BREAKFAST : ADD COFFERED CEILING AS PER PLAN
2936 72,324 10Dec21 **	2	GARAGE DOOR OPENER (CHAMBERLAIN BELT DRIVE) - WITH 1 REMOTE - PRICE IS PER DOOR
2936 10Dec21 NoCat	1	**CUSTOM LAYOUT** LIVING / DINING: DELETE OPENING, CREATE FULL WALL PARTITION BETWEEN LIVING/DINING



CONSTRUCTION SUMMARY

Lot: 48

Model: 50.03 A OAKGROVE OPT. 5 BEDROOM

Project/Phase: Pine Valley Forevergreen / 1

ELECTRICAL

Invoice	Qty.	Description
2936 72,281 10Dec21	1	GREAT ROOM: INTERIOR WALL OUTLET: ADDITIONAL 110V WALL INTERIOR RECEPTACLE ON EXISTING CIRCUIT FOR WALL MOUNTED TV - LOCATE APPROX 66" A.F.F. ABOVE FIREPLACE
2936 72,281 10Dec21	1	MASTER BEDROOM - SITTING ROOM: INTERIOR WALL OUTLET: ADDITIONAL 110V WALL INTERIOR RECEPTACLE ON EXISTING CIRCUIT FOR WALL MOUNTED TV - LOCATE APPROX 42" A.F.F. ABOVE FIREPLACE
2936 72,291 10Dec21	5	*EXTERIOR* EXTERIOR LED SOFFIT POT LIGHT - EACH - (TOTAL 5) 2 @ FRONT ELEVATION - SEE ATTACHED ELEVATION 3 @ REAR ELEVATION - CENTERED ACROSS REAR
2936 72,288 10Dec21	1	LIVING ROOM: ROUGH-IN FOR ADDITIONAL WALL SCONCE (1) CAPPED OUTLET + SINGLE POL SWITCH - FIXTURE NOT INCLUDED LOCATE APPROX 84" A.F.F. - SEE PLAN FOR LOCATION
2936 72,289 10Dec21	5	MAIN HALL: 4" E/S LED INTERIOR POT LIGHT - GROUND FLOOR - EACH IN LIEU OF CEILING LIGHTS - USE STANDARD SWITCHES
2936 72,289 10Dec21	6	KITCHEN: 4" E/S LED INTERIOR POT LIGHT - GROUND FLOOR - EACH, INCLUDES 1 SWITCH INCLUDED IN APS
2936 72,289 10Dec21	1	KITCHEN: 4" E/S LED INTERIOR POT LIGHT - GROUND FLOOR - EACH SAME SWITCH AS STANDARD POTLIGHTS
2936 72,307 10Dec21	1	KITCHEN: FIXTURE: RELOCATE STANDARD CEILING MOUNT FIXTURE - LOCATE APPROXD CENTER ABOVE ISLAND
2936 72,280 10Dec21	2	KITCHEN: CEILING OUTLET: ADDITIONAL REINFORCED CEILING OUTLET - LOCATE APPROX CENTERED ABOVE ISLAND, USE SAME SWITCH AS STANDARD
2936 72,288 10Dec21	2	BREAKFAST ROOM: ROUGH-IN FOR ADDITIONAL WALL SCONCE (1) CAPPED OUTLET - FIXTURE NOT INCLUDED LOCATE APPROX 80" A.F.F.
2936 72,278 10Dec21	1	BREAKFAST ROOM: ADDITIONAL INTERIOR SWITCH FOR WALL SCONCES
2936 72,307 10Dec21	1	GREAT ROOM: FIXTURE: RELOCATE STANDARD CEILING MOUNT FIXTURE - SEE PLAN FOR LOCATION
2936 72,280 10Dec21	1	GREAT ROOM: CEILING OUTLET: ADDITIONAL REINFORCED CEILING OUTLET - SEE PLAN FOR LOCATION SAME SWITCH AS STANDARD CEILING LIGHT



CONSTRUCTION SUMMARY

Lot: 48

Model: 50.03 A OAKGROVE OPT. 5 BEDROOM

Project/Phase: Pine Valley Forevergreen / 1

ELECTRICAL

Invoice	Qty.	Description
2936 72,289 10Dec21	8	GREAT ROOM: 4" E/S LED INTERIOR POT LIGHT - GROUND FLOOR - EACH SEE PLAN FOR LOCATION
2936 72,278 10Dec21	1	GREAT ROOM: ADDITIONAL INTERIOR SWITCH FOR POTLIGHTS
2936 72,303 10Dec21	1	KITCHEN: FIXTURE: UNDER CABINET LED LIGHT FIXTURES - CABINETRY LIGHT VALANCE INCLUDED
2936 72,273 10Dec21	1	KITCHEN: 110V WALL RECEPTACLE ON SEPARATE CIRCUIT - GAS FIRED APPLIANCE - FOR AUX. EQUIPMENT - NOT A STOVE PLUG
2936 72,665 10Dec21	1	KITCHEN: 240V WALL RECEPTACLE ON SEPARATE CIRCUIT FOR BUILT-IN WALL OVEN. - APPROX. LOCATION AS PER ATTACHED DRAWINGS
2936 72,272 10Dec21	1	KITCHEN: 110V WALL RECEPTACLE ON SEPARATE CIRCUIT - FOR FRIDGE - LOCATION TO BE APPROX- APPLIANCE NOT INCLUDED FINAL LOCATION MAY NEED TO BE ADJUSTED AFTER CLOSING BY LICENCED ELECTRICIAN
2936 72,272 10Dec21	1	SERVERY: 110V WALL RECEPTACLE ON SEPARATE CIRCUIT - FOR WINE FRIDGE, APPLIANCE NOT INCLUDED
2936 72,249 10Dec21 **	1	STEAM HUMIDIFER - APRILAIRE 800 WHOLE HOUSE STEAM HUMIDIFIER (UP TO 6,200 SQ.FT.) - COMPLETE WITH HI VOLTAGE WIRING, 240V DOUBLE BREAKER 20 AMP, SHUT OFF VALVE
2936 72,290 10Dec21	10	MASTER WIC: 4" E/S LED INTERIOR POT LIGHT (INSULATED CEILING) - SECOND FLOOR - EACH SEE PLAN FOR LOCATION
2936 72,278 10Dec21	1	WIC: ADDITIONAL INTERIOR SWITCH FOR POTLIGHTS
2936 72,280 10Dec21	1	MASTER ENSUITE: CEILING OUTLET: ADDITIONAL REINFORCED CEILING OUTLET - LOCATE APPROX CENTER ABOVE TUB
2936 72,278 10Dec21	1	MASTER ENSUITE: ADDITIONAL INTERIOR SWITCH FOR TUB LIGHT
2936 72,288 10Dec21	2	UPPER HALL: ADD ROUGH-IN FOR ADDITIONAL WALL SCONCE (1) CAPPED OUTLET ON EXISTING SWITCH - FIXTURE NOT INCLUDED LOCATE APPROX 80" A.F.F.



CONSTRUCTION SUMMARY

Lot: 48

Model: 50.03 A OAKGROVE OPT. 5 BEDROOM

Project/Phase: Pine Valley Forevergreen / 1

ELECTRICAL

Invoice	Qty.	Description
2936 72,276 10Dec21	1	UPPER HALL: ADDITIONAL 3 - WAY SWITCH (LIGHT OPERATED BY 2 DIFFERENT SWITCHES) FOR UPPER HALL SCONCES
2936 10Dec21 NoCat	1	**CUSTOM LAYOUT** BREAKFAST ROOM: DELETE DOOR TO DECK, INSTALL WINDOW INSTEAD
2936 10Dec21 NoCat	1	STEAM HUMIDIFER - APRILAIRE 800 WHOLE HOUSE STEAM HUMIDIFIER (UP TO 6,200 SQ.FT.) - COMPLETE WITH HI VOLTAGE WIRING, 240V DOUBLE BREAKER 20 AMP, SHUT OFF VALVE
2947 11Mar22 NoCat	1	SERVERY: ADD ELECTRICAL AND SWITCH FOR IN CABINET LIGHTING (cabinet lighting supplied + installed by AYA)
2947 72,669 11Mar22	1	ADD-ON EXTERIOR SOFFIT LIGHT TIMER - EACH
2947 72,291 11Mar22	8	**EXTERIOR - REVISED** EXTERIOR LED SOFFIT POT LIGHT - EACH REVISED LOCATIONS: 2@ FRONT ELEVATION 2@ SIDE ELEVATION 4@ REAR ELEVATION 5@ SIDE ELEVATION ADD 8 SOFFIT LIGHTS, *IN ADDITION TO* 5 PREVIOUSLY PURCHASED - TOTAL OF 13 SOFFIT LIGHTS
2947 72,275 11Mar22	1	KITCHEN: 240V WALL RECEPTACLE ON SEPARATE CIRCUIT FOR SPEED OVEN

EXTERIOR COLOURS

Invoice	Qty.	Description
2799 08Jun21 NoCat	1	EXTERIOR COLOUR PACKAGE BR4

FIREPLACE - MANTEL

Invoice	Qty.	Description
2947 11Mar22 NoCat	1	GREAT ROOM: UPGRADE FIREPLACE MANTLE TO 'CAPRI'



CONSTRUCTION SUMMARY

Lot: 48

Model: 50.03 A OAKGROVE OPT. 5 BEDROOM

Project/Phase: Pine Valley Forevergreen / 1

FRAMING

Invoice	Qty.	Description
2799 72,552 08Jun21	1	MASTER BEDROOM: MODEL OPTIONS 50.03. A - MASTER BEDROOM - OPT. SITTING AREA 10 FOOT TRAY CEILING - AS PER PLAN
2936 10Dec21 NoCat	1	**CUSTOM LAYOUT** LIVING / DINING: DELETE OPENING, CREATE FULL WALL PARTITION BETWEEN LIVING/DINING
2936 10Dec21 NoCat	1	**CUSTOM LAYOUT** BREAKFAST ROOM: DELETE DOOR TO DECK, INSTALL WINDOW INSTEAD
2936 10Dec21 NoCat	1	**CUSTOM LAYOUT** WIC - DELETE WALL/DOOR, CREATING 1 LARGE OPEN SPACE
2936 72,631 10Dec21	1	MASTER ENSUITE: SHOWER NICHE [SHAMPOO SHELF] - COMPLETE WITH MATCHING MARBLE JAMBS ON 4 SIDES, STANDARD TILE, APPROX. 12 X 18 INSTALLED VERTICALLY - SEE PLAN FOR PREFERRED LOCATION
2936 72,631 10Dec21	1	SHARED ENSUITE 3/4: SHOWER NICHE [SHAMPOO SHELF] - COMPLETE WITH MATCHING MARBLE JAMBS ON 4 SIDES, STANDARD TILE, APPROX. 12 X 18 INSTALLED VERTICALLY - SEE PLAN FOR PREFERRED LOCATION
2936 72,631 10Dec21	1	SHARED ENSUITE 2/5: SHOWER NICHE [SHAMPOO SHELF] - COMPLETE WITH MATCHING MARBLE JAMBS ON 4 SIDES, STANDARD TILE, APPROX. 12 X 18 INSTALLED VERTICALLY - LOCATE WALL OPPOSITE VALVE
2936 10Dec21 NoCat	1	LIVING ROOM: ADD OPT. COFFERED CEILING AS PER PLAN
2936 10Dec21 NoCat	1	KITCHEN / BREAKFAST : ADD COFFERED CEILING AS PER PLAN
2936 10Dec21 NoCat	1	GREAT ROOM: MODEL OPTIONS GREAT ROOM - OPT. COFFERED CEILING AS PER PLAN

GARAGE DOORS

Invoice	Qty.	Description
2936 72,324 10Dec21	2	GARAGE DOOR OPENER (CHAMBERLAIN BELT DRIVE) - WITH 1 REMOTE - PRICE IS PER DOOR
2936 72,323 10Dec21	1	GARAGE: WIRELESS KEYPAD GARAGE DOOR ENTRY 877LM SEE PLAN FOR LOCATION



CONSTRUCTION SUMMARY

Lot: 48

Model: 50.03 A OAKGROVE OPT. 5 BEDROOM

Project/Phase: Pine Valley Forevergreen / 1

GLASS AND MIRROR

Invoice	Qty.	Description
2936 10Dec21 NoCat	1	MASTER ENSUITE: UPGRADE TO FROSTED GLASS ENCLOSURE AT WATER CLOSET - DOOR + SHARED SHOWER WALL SHOWER DOOR AND OTHER GLASS WALLS TO BE CLEAR GLASS
2947 11Mar22 NoCat	2	MASTER ENSUITE SHOWER + WATER CLOSET: UPGRADE SHOWER DOOR HANDLE AND HINGES - BRUSHED GOLD
2947 11Mar22 NoCat	1	SHARED ENSUITE 3/4: UPGRADE SHOWER DOOR HANDLE AND HINGES - BRUSHED GOLD
2947 11Mar22 NoCat	1	THRU OUT: DO NOT SUPPLY/INSTALL MIRRORS



CONSTRUCTION SUMMARY

Lot: 48

Model: 50.03 A OAKGROVE OPT. 5 BEDROOM

Project/Phase: Pine Valley Forevergreen / 1

GRANITE MARBLE QUARTZ

Invoice	Qty.	Description
2947 11Mar22 NoCat	1	POWDER ROOM: UPGRADE 2 QUARTZ COUNTER
2947 11Mar22 NoCat	1	MUD ROOM: UPGRADE 2 QUARTZ COUNTER TOP
2947 11Mar22 NoCat	1	KITCHEN: UPGRADE COUNTER TOP - LEVEL 6 QUARTZ SEE REVISED ISLAND LAYOUT + EXTENDED PERIMETER OF KITCHEN (towards breakfast room)
2947 11Mar22 NoCat	1	KITCHEN: FULL HEIGHT SLAB BACKSPLASH - LEVEL 6 QUARTZ
2947 11Mar22 NoCat	1	SERVERY: UPGRADE 5 QUARTZ COUNTER TOP + FULL HEIGHT BACKSPLASH
2947 11Mar22 NoCat	1	MASTER ENSUITE: UPGRADE 2 QUARTZ COUNTER
2947 11Mar22 NoCat	1	SHARED ENSUITE 2/5: UPGRADE 2 QUARTZ COUNTER TOP
2947 11Mar22 NoCat	1	SHARED ENSUITE 3/4: UPGRADE 2 QUARTZ COUNTER
2947 11Mar22 NoCat	1	LAUNDRY ROOM: UPGRADE 2 QUARTZ COUNTER AT COUNTER + ABOVE MACHINES
2947 11Mar22 NoCat	1	KITCHEN: COOKTOP CUT OUT
2947 11Mar22 NoCat	1	KITCHEN: ADD MOEN SIP FAUCET - HOLE DRILLED AND INSTALLED, BUT NOT PLUMBED - PURCHASER TO FIT TO OWN WATER FILTRATION SYSTEM AFTER CLOSING LOCATE RIGHT OF KITCHEN FAUCET
2947 11Mar22 NoCat	1	SERVERY: UPGRADE SINK (Blanco Silgranit Anthracite) + FAUCET (Moen Align - Brushed Gold)



CONSTRUCTION SUMMARY

Lot: 48

Model: 50.03 A OAKGROVE OPT. 5 BEDROOM

Project/Phase: Pine Valley Forevergreen / 1

HARDWOOD

Invoice	Qty.	Description
2947 4 11Mar22	1	THRU OUT STD AREAS MAIN HALL/ LIVING/ DINING/ GREAT/ SERVERY/ UPPER HALL/ MASTER BEDRM + SITTING + WIC/ BEDRM 2/ BEDRM 3/ BEDRM 4/ BDRM 5: VINTAGE SERIES, 5" WHITE OAK, NSS ENGINEERED HARDWOOD, 3/4" THK, WIREBRUSH TEXTURE, UV OIL FINISH- LEVEL 3
2947 4 11Mar22	1	KITCHEN: VINTAGE SERIES, 5" WHITE OAK, NSS ENGINEERED HARDWOOD, 3/4" THK, WIREBRUSH TEXTURE, UV OIL FINISH - LEVEL 3

HVAC

Invoice	Qty.	Description
2936 72,217 10Dec21	1	KITCHEN - UPGRADE TO 8" DUCT (EXTERIOR WALL) IN LIEU OF STANDARD OFFERING
2936 72,224 10Dec21	1	KITCHEN: GAS LINE ROUGH-IN - MAIN FLOOR FOR GAS COOKTOP - LOCATE TO BE APPROXIMATE, FINAL POSITION MAY NEED TO BE ADJUSTED AFTER CLOSING BY LICENCED GAS FITTER.
2936 72,213 10Dec21	1	MASTER ENSUITE / ENSUITE 2/5 / ENSUITE 3/4/ LAUNDRY ROOM: HRV WITH 20 MINUTE LIGHT TIMER , INCLUDES MAIN WALL CONTROLLER UP TO 4 OUTLETS
2936 72,249 10Dec21	1	STEAM HUMIDIFER - APRILAIRE 800 WHOLE HOUSE STEAM HUMIDIFIER (UP TO 6,200 SQ.FT.) - COMPLETE WITH HI VOLTAGE WIRING, 240V DOUBLE BREAKER 20 AMP, SHUT OFF VALVE
2936 10Dec21 ** NoCat	1	STEAM HUMIDIFER - APRILAIRE 800 WHOLE HOUSE STEAM HUMIDIFIER (UP TO 6,200 SQ.FT.) - COMPLETE WITH HI VOLTAGE WIRING, 240V DOUBLE BREAKER 20 AMP, SHUT OFF VALVE

INTERIOR DOORS

Invoice	Qty.	Description
2947 11Mar22 NoCat	1	THRU OUT: UPGRADE INTERIOR DOOR HARDWARE - HALIFAX MATTE BLACK
2947 11Mar22 NoCat	1	THRU OUT: UPGRADE INTERIOR DOOR HINGES TO SQUARE FLAT TIP HINGE - MATTE BLACK

INTERIOR DOORS AND TRIM

Invoice	Qty.	Description
2936 72,640 10Dec21	2	MASTER BEDROOM + MASTER ENSUITE (AT WIC): ADD SINGLE POCKET DOOR 800 SERIES COMPLETE WITH BUILDERS STANDARD OFFERINGS
2936 72,645 10Dec21	18	THRU OUT: ADDITIONAL FOR SAFE & SOUND (SOLID CORE) INTERIOR DOORS NOT INCLUDING CLOSET DOORS



CONSTRUCTION SUMMARY

Lot: 48
Model: 50.03 A OAKGROVE OPT. 5 BEDROOM
Project/Phase: Pine Valley Forevergreen / 1

INTERIOR TRIM AND DOORS

Invoice	Qty.	Description
2947 11Mar22 NoCat	1	THRU OUT: UPGRADE INTERIOR DOOR PROFILE TO 'LIVINGSTON'
2947 11Mar22 NoCat	1	THRU OUT - ALL CLOSETS DO NOT INSTALL CLOSET FITTINGS, LEAVE EMPTY FOR PURCHASER TO INSTALL OWN CUSTOM CLOSET ORGANIZERS AFTER CLOSING

KITCHEN AND BATH CABINETRY

Invoice	Qty.	Description
2936 72,217 10Dec21 **	1	KITCHEN - UPGRADE TO 8" DUCT (EXTERIOR WALL) IN LIEU OF STANDARD OFFERING
2947 11Mar22 NoCat	1	THRU OUT: SEE ATTACHED CABINETRY SCHEDULE

NETWORK AND WIRING

Invoice	Qty.	Description
2936 72,260 10Dec21	1	BASEMENT/ATTIC: CONDUIT PIPE - FROM APPROX CENTER OF ATTIC TO BASEMENT NEAR ELECTRICAL PANEL
2936 72,265 10Dec21	3	DINING ROOM / GREAT ROOM / KITCHEN: ROUGH - IN WIRING FOR ONE PAIR OF SPEAKERS - SEE PLAN FOR LOCATION
2936 72,258 10Dec21	1	FRONT FOYER: ADDITIONAL CAT6 ETHERNET OUTLET - EACH FOR FUTURE 'RING-TYPE' DOOR BELL
2936 72,259 10Dec21	1	GREAT ROOM: CONDUIT PIPE - FOR WALL MOUNT TV - LOCATE ABOVE FIREPLACE, APPROX 66" A.F.F., THRU BASEMENT, TERMINATE AT CABLE LOCATION - SEE PLAN FOR LOCATION
2936 72,259 10Dec21	1	MASTER BEDROOM - SITTING ROOM: CONDUIT PIPE - FOR WALL MOUNT TV - LOCATE ABOVE FIREPLACE, APPROX 42" A.F.F., TERMINATE AT CABLE LOCATION - SEE PLAN FOR LOCATION
2936 72,258 10Dec21	1	LIVING ROOM: ADDITIONAL CAT6 ETHERNET OUTLET - EACH - SEE PLAN FOR LOCATION
2936 10Dec21 NoCat	1	NO STANDARD PHONES ON 2ND FLOOR, PLEASE



CONSTRUCTION SUMMARY

Lot: 48

Model: 50.03 A OAKGROVE OPT. 5 BEDROOM

Project/Phase: Pine Valley Forevergreen / 1

PAINT

Invoice	Qty.	Description
2799 08Jun21 NoCat	1	MASTER BEDROOM: MODEL OPTIONS 50.03. A - MASTER BEDROOM - OPT. SITTING AREA 10 FOOT TRAY CEILING - AS PER PLAN
2936 10Dec21 NoCat	1	LIVING ROOM: ADD OPT. COFFERED CEILING AS PER PLAN
2936 10Dec21 NoCat	1	KITCHEN / BREAKFAST : ADD COFFERED CEILING AS PER PLAN
2936 10Dec21 NoCat	1	GREAT ROOM: MODEL OPTIONS GREAT ROOM - OPT. COFFERED CEILING AS PER PLAN
2947 11Mar22 NoCat	2	MAIN STAIRS: STAIN STAIRS AND LANDINGS STAIN WILL NOT MATCH HARDWOOD IN COLOUR/TEXTURE/SPECIES

PAINTING

Invoice	Qty.	Description
2947 11Mar22 NoCat	1	KITCHEN: CEILING DETAIL: ADD 3 BOX WAFFLE + BEAM DETAIL - SEE ATTACHED SKETCH
2947 11Mar22 NoCat	1	GREAT ROOM: CEILING DETAIL: ADD 3 BOX WAFFLE + BEAM DETAIL - SEE ATTACHED SKETCH

PANL - FRAMING

Invoice	Qty.	Description
2936 72,324 10Dec21 **	2	GARAGE DOOR OPENER (CHAMBERLAIN BELT DRIVE) - WITH 1 REMOTE - PRICE IS PER DOOR



CONSTRUCTION SUMMARY

Lot: 48

Model: 50.03 A OAKGROVE OPT. 5 BEDROOM

Project/Phase: Pine Valley Forevergreen / 1

PLUMBING

Invoice	Qty.	Description
2936 72,346 10Dec21	1	KITCHEN: ADD POT FILLER - MOEN MODERN 'BRUSHED GOLD' INCLUDES ROUGH-IN
2936 72,335 10Dec21	1	GARAGE: UPGRADE TO HOT AND COLD WATER SUPPLY LINES IN GARAGE IN LIEU OF STANDARD OFFERING SEE PLAN FOR *PREFERRED LOCATION* OF HOSE BIB
2936 72,249 10Dec21 **	1	STEAM HUMIDIFER - APRILAIRE 800 WHOLE HOUSE STEAM HUMIDIFIER (UP TO 6,200 SQ.FT.) - COMPLETE WITH HI VOLTAGE WIRING, 240V DOUBLE BREAKER 20 AMP, SHUT OFF VALVE
2936 10Dec21 NoCat	1	MASTER ENSUITE: UPGRADE PLUMBING *SHOWER TO 3-FUNCTION SHOWER COMPLETE WITH RAIN SHOWER FROM CEILING AND HAND SHOWER *TUB FAUCET - FLOOR MOUNT * LAV FAUCET x2 MOEN ALIGN BRUSHED GOLD
2936 10Dec21 NoCat	1	SHARED ENSUITE 3/4: UPGRADE FAUCETS SHOWER FAUCET LAV FAUCET x2 MATTE BLACK
2936 10Dec21 NoCat	1	SHARED ENSUITE 2/5: UPGRADE FAUCETS TUB/SHOWER FAUCET LAV FAUCET MATTE BLACK
2936 10Dec21 ** NoCat	1	STEAM HUMIDIFER - APRILAIRE 800 WHOLE HOUSE STEAM HUMIDIFIER (UP TO 6,200 SQ.FT.) - COMPLETE WITH HI VOLTAGE WIRING, 240V DOUBLE BREAKER 20 AMP, SHUT OFF VALVE
2947 11Mar22 NoCat	1	POWDER ROOM: UPGRADE FAUCET TO MOEN 'ALIGN' WIDESPREAD - BRUSHED GOLD
2947 11Mar22 NoCat	1	MUD ROOM: UPGRADE SINK (Blanco Silgranit - White) + FAUCET (Moen Align - Brushed Gold)
2947 11Mar22 NoCat	1	KITCHEN: UPGRADE SINK (Blanco Silgranit - white) + FAUCET (Moen Align - brushed gold)
2947 11Mar22 NoCat	1	KITCHEN: ADD MOEN SIP FAUCET - HOLE DRILLED AND INSTALLED, BUT NOT PLUMBED - PURCHASER TO FIT TO OWN WATER FILTRATION SYSTEM AFTER CLOSING LOCATE RIGHT OF KITCHEN FAUCET
2947 11Mar22 NoCat	1	SERVERY: UPGRADE SINK (Blanco Silgranit Anthracite) + FAUCET (Moen Align - Brushed Gold)
2947 11Mar22 NoCat	4	THRU OUT: POWDER ROOM/ MASTER ENSUITE/ SHARED ENSUITE 2/5/ SHARED ENSUITE 3/4: UPGRADE TOILET TO CONTRAC 'CILA' WHITE



CONSTRUCTION SUMMARY

Lot: 48

Model: 50.03 A OAKGROVE OPT. 5 BEDROOM

Project/Phase: Pine Valley Forevergreen / 1

PLUMBING

Invoice	Qty.	Description
2947	1	LAUNDRY ROOM: UPGRADE SINK (Blanco Silgranit - 'Anthracite') + FAUCET (Moen Align 'Matte Black')
11Mar22 NoCat		
2947	1	**REVISED SELECTION - FEB 23 2022** SHARED ENSUITE 2/5 + SHARED ENSUITE 3/4: INSTALL MOEN 'ALIGN' SHOWER SYSTEM and LAV FAUCET ^IN LIEU OF PREVIOUS SELECTION (rizon)^
11Mar22 NoCat		This is difference in price from previous selection

STAIRS AND RAILINGS

Invoice	Qty.	Description
2947	1	MAIN STAIRS: UPGRADE RAILING TO A2 - BLACK METAL PACKAGE
11Mar22 NoCat		

TRIM AND DOORS

Invoice	Qty.	Description
2947	1	THRU OUT: ADD WINDOW STOOLS AND APRONS
11Mar22 NoCat		

WINDOWS AND DOORS

Invoice	Qty.	Description
2799 72,675 08Jun21	4	BASEMENT WINDOWS - UPGRADE BASEMENT WINDOW SIZE TO 30 " X 24" - 10" FRAME (PINEVALLEY 50 FOOT LOTS ONLY)
2936	1	**CUSTOM LAYOUT** BREAKFAST ROOM: DELETE DOOR TO DECK, INSTALL WINDOW INSTEAD
10Dec21 NoCat		

Scheduled Closing Date:

Purchaser: KARAN PAL SINGH

Property: 48 of Plan -

Telephone Res. / Bus: (905) 850-8067

Project: Pine Valley Forevergreen - Phase 1

Decor Advisor: Yolande Somerville

Model and Elevation: 50.03 A OAKGROVE OPT. 5 BEDROOM

Layout Changes: ☒ Yes ☐ No Sketch Attached: ☒ Yes ☐ No Exterior Colour Scheme:

1. Cabinetry

	Style and Colour	Counter	Hardware
Kitchen / Breakfast	*2-tone	*2-tone	attached
Laundry Room	Modena 'White'	*Quartz: Organic White	attached
Powder Room	*Willis 'Oyster'	*Quartz: Organic White	attached
Mud Room	Modena 'white'	*Quartz: Organic White	attached
Master Ensuite Bathroom	*Winsette 'Anthracite'	*Quartz: Organic White	attached
Second Ensuite Bathroom (If Applicable)	*Winsette 'Oyster' (ens2/5)	*Quartz: Organic White	attached
Shared 3/4	*Winsette 'Oyster'	*Quartz: Organic White	attached

Comment

Kitchen: 'Willis Oyster + Calacatta Gold + FHBS / Servery: Willis Pitch Black + Empira Black + FHBS

2. Floor Tile

	Selection
Entrance Vestibule	*30x30" Marmorea matte 'Port Laurent' + Charcoal grout
Main Hall	
Kitchen / Breakfast	hardwood
Laundry Room	*8x8" Maku decor 'Light Mix' + Bone Grout
Powder Room	*Merino Hex 'Ivory' + Bone Grout
Mud Room	*Merino Hex 'Ivory' + Bone Grout
Master Ensuite Bathroom	*30x60" Marmorea polished 'Breccia White' + Bone Grout
Second Ensuite Bathroom (If Applicable)	*12x24" Timeless matte 'white (ens 2/5) + Bone Grout
Lower Landing (If Applicable)	13x13" Capri 'White'
Shared 3/4	*Mosaic Quebec Hex 'Arctic white' + Bone Grout

Comment

Master Shower Floor: Marble mosaic herringbone 'Oriental White' + bone grout / Shared Ensuite 3/4: Mosaic Quebec hex 'white' + bone grout

3. Wall Tile

	Selection	Listello/Inserts	Describe
		☐ Yes ☒ No	
Master Ensuite Bathroom			
Tub Deck		☐ Yes ☒ No	
Shower Stall	*30x60" Marmorea pol Breccia wht	☐ Yes ☒ No	
Bathroom Walls		☐ Yes ☒ No	
Second Ensuite Bathroom (If Applicable)	*3x6" Soho bevel 'White' gloss (2/5)	☐ Yes ☒ No	
Ensuite 3/4	*2x10" London 'White' + Bone grout	☐ Yes ☒ No	
Kitchen Backsplash	☒ Yes ☐ No	Backsplash Behind Fridge	
Comment	see below		

Kitchen: Calacatta Gold FHBS / Servery: Empira Black FHBS



Scheduled Closing Date:

Purchaser: KARAN PAL SINGH
Telephone Res. / Bus: (905) 850-8067
Decor Advisor: Yolande Somerville

Property: 48 of Plan -
Project: Pine Valley Forevergreen - Phase 1
Model and Elevation: 50.03 A OAKGROVE OPT. 5 BEDROOM

4. Plumbing Fixtures

	Second Ensuite		Powder Room	
Master Ensuite Bathroom		Other Room - Specify		Other Washroom

Comment

See extras

5. Hardwood Flooring

	Type and Stain		Type and Stain
Main Hall		Upper Landing	
Kitchen / Breakfast	*3/4x5" wht oak wire brsh 'Atlantis'	Upper Hall	
Living Room		Master Bedroom	
Dining Room		Bedroom #2	
Family Room		Bedroom #3	
Den/Library		Bedroom #4	
Entrance Vestibule		Bedroom #5	
Lower Landing (If Applicable)		Other Room - Specify	
		Thru out standard areas	*3/4x5" wht oak wire brsh 'Atlantis'

Comment

6. Carpeting

	Upgrade	Description
Ground Floor	☐	
Second Floor	☐	
	☐	

Upgrade Underpad	Type	Area
Carpet on Stairs	Capped	Runner - *Upgrade

Comment

7. Fireplace

	Living Room			Family Room			Other Room - Specify		
	Purchased	As Per Plan	N/A	Purchased	As Per Plan	N/A	Purchased	As Per Plan	N/A
Fireplace Type	☐	☐	☒	☐	☒	☐	☐	☐	☒
Mantle Type				Standard Gas					
Colour / Stain				*Capri					
Surround				Arctic White					
Hearth				n/a					
				none					

Comment

KS

Scheduled Closing Date:

Purchaser: KARAN PAL SINGH

Property: 48 of Plan -

Telephone Res. / Bus: (905) 850-8067

Project: Pine Valley Forevergreen - Phase 1

Decor Advisor: Yolande Somerville

Model and Elevation: 50.03 A OAKGROVE OPT. 5 BEDROOM

8. Trim Carpentry

Interior Doors Front Door Glass Inserts Door Handles
 Interior Trim
 Comment

9. Plaster Mouldings and Medallions

Standard Throughout ☐ Yes ☐ No ☐ N/A

Entrance Vestibule			Kitchen/Breakfast	CTRB05A/615	
Main Hall			Den/Library		
Living Room			Lower Landing		
Dining Room			Other Room - Specify		
Family Room	CTRB05A/615				

Comment

10. Railings and Spindles

Railing Package
 Railing Colour Spindle Colour
 Stringer / Riser Treads
 Oak Stairs ☒ Yes ☐ No ☐ N/A
 Comment

11. Wall Paint / Ceilings

Throughout Finished Areas

 Trim Paint
 Smooth Ceilings
 Ground Floor ☒
 Second Floor ☒
 Note

Comment

KS

Scheduled Closing Date:

Purchaser: KARAN PAL SINGH

Property: 48 of Plan -

Telephone Res. / Bus: (905) 850-8067

Project: Pine Valley Forevergreen - Phase 1

Decor Advisor: Yolande Somerville

Model and Elevation: 50.03 A OAKGROVE OPT. 5 BEDROOM

12. Electrical

Hood Fan ☐ White ☐ Stainless ☒ N/A

Above Kitchen Cabinet Light ☐ Yes ☒ No

Below Kitchen Cabinet Light ☒ Yes ☐ No

Standard Appliances ☐

Over The Range Microwave ☐

Chimney Style Fan ☐

Comment

13. Heating and Air Conditioning

Air Conditioning

Gas Provisions Stove

Gas Provisions Dryer

Gas Provisions Barbecue

Comment

14. Additional Comments

15. Disclaimers and Notes

- 1) Colours of all materials are as close as possible to builder's selection, but not necessarily identical due to variances in manufacturing.
- 2) Any extras listed above are null and void unless accompanied by a separate invoice/amendment. Said invoice must be paid in full.
- 3) The Purchaser acknowledges that after Interior Colour Selection form is signed and dated, no further changes will be permitted other than re-selection due to unavailability. _____ Purchaser's Initials
- 4) The Purchaser acknowledges reading and accepting the "Gold Park Homes Decor Centre Disclaimers" form. This document contains other miscellaneous disclaimers.

This Interior Colour Selection is final and approved by:

Signature:  Date: _____

SCHEDULE 'F'



PV-48
NOV. 22, 2021

PV-48
DEC 8 2021 (KS)


Lot 48
50' SERIES

Elevation A • 4,936 sq.ft.

LEGEND

(S) = SPEAKER R11

PV-48
MARCH 1 2022 (KS) CHANGE from door to window

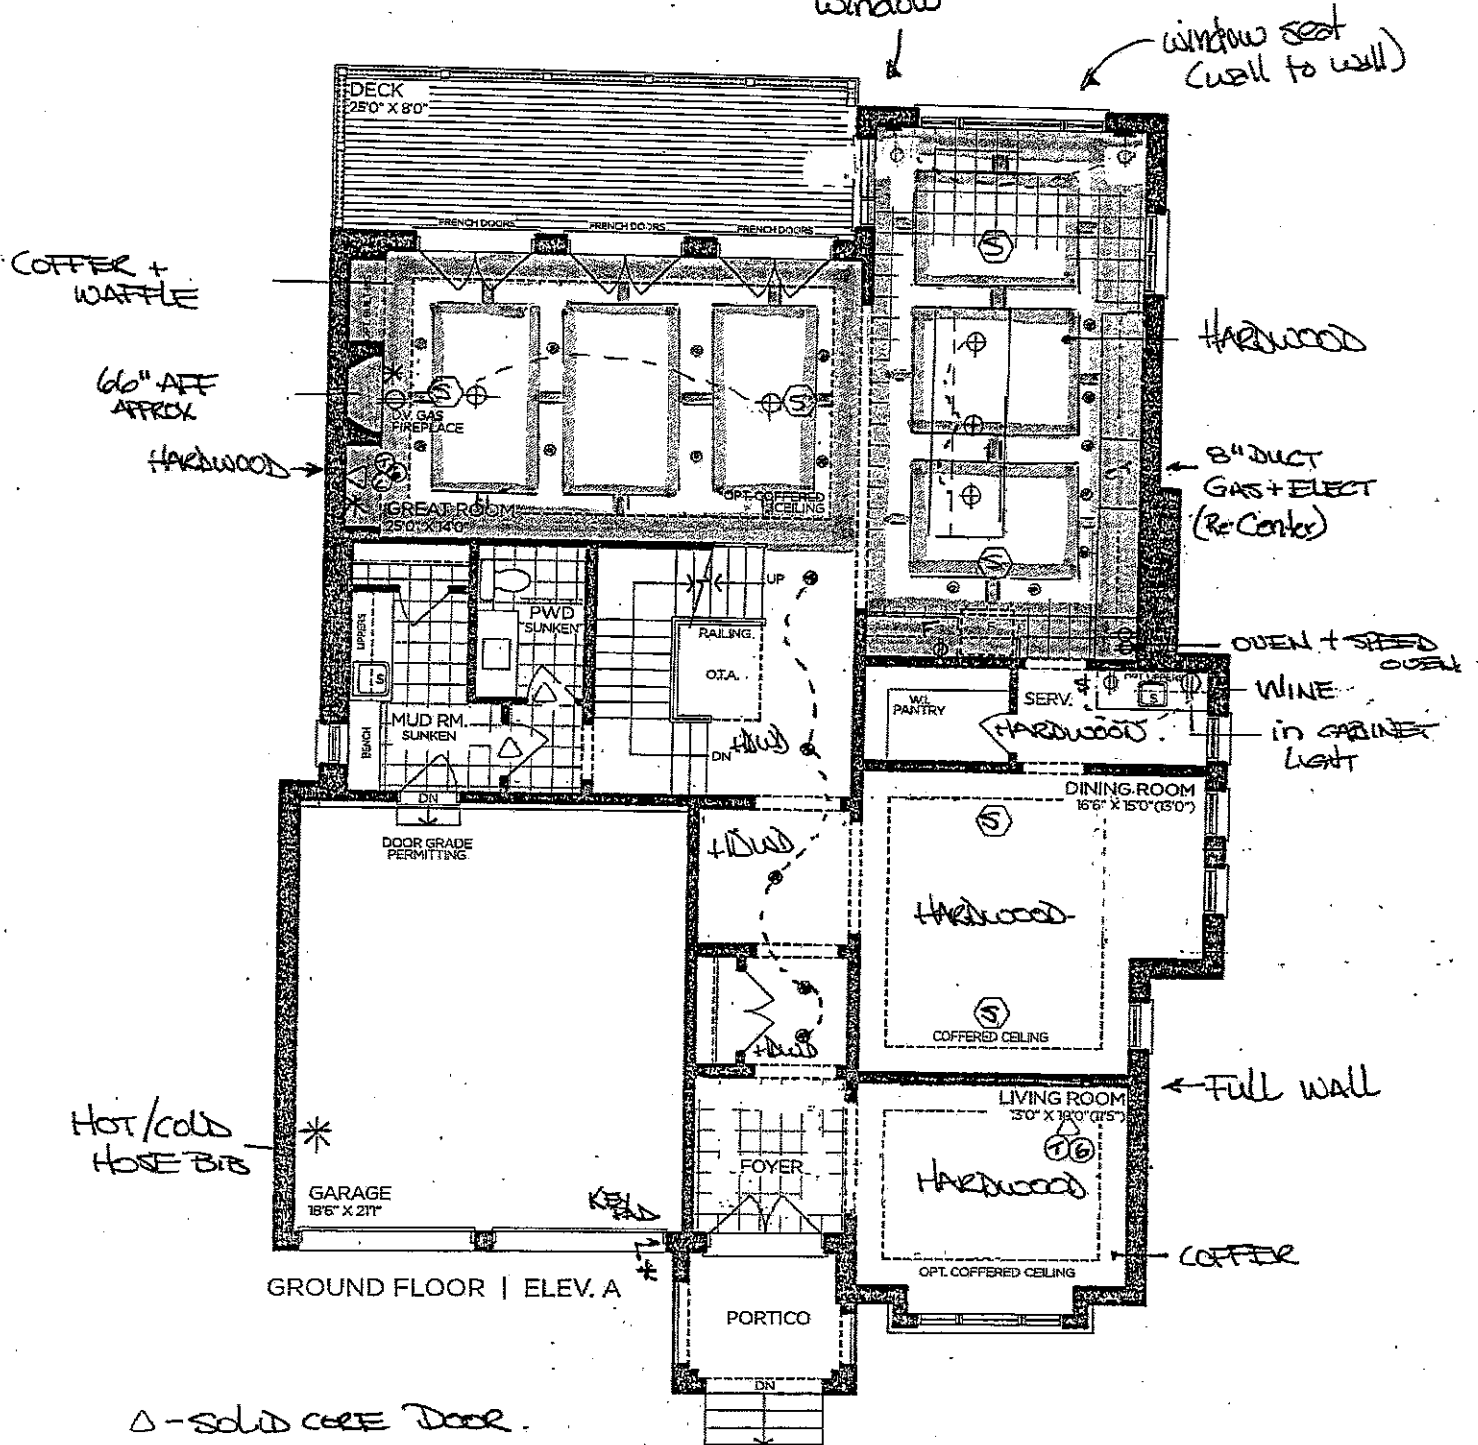

VENDOR

PURCHASER

PURCHASER

GOLDPARK
WORTH MORE™


Prices, figures, illustrations, sizes, features and finishes are subject to change without notice. Areas and dimensions are approximate and actual usable floor space may vary from the stated area. Layout may be reverse of the unit purchased. E. & O.E. 5003

SCHEDULE 'F'



PV-48
NOV. 22, 2021
PV-48
DEC 8 2021 (KS)
PV-48
MARCH 1 2022 (KS)

Lot 48
50' SERIES
Elevation A • 4,936 sq.ft.

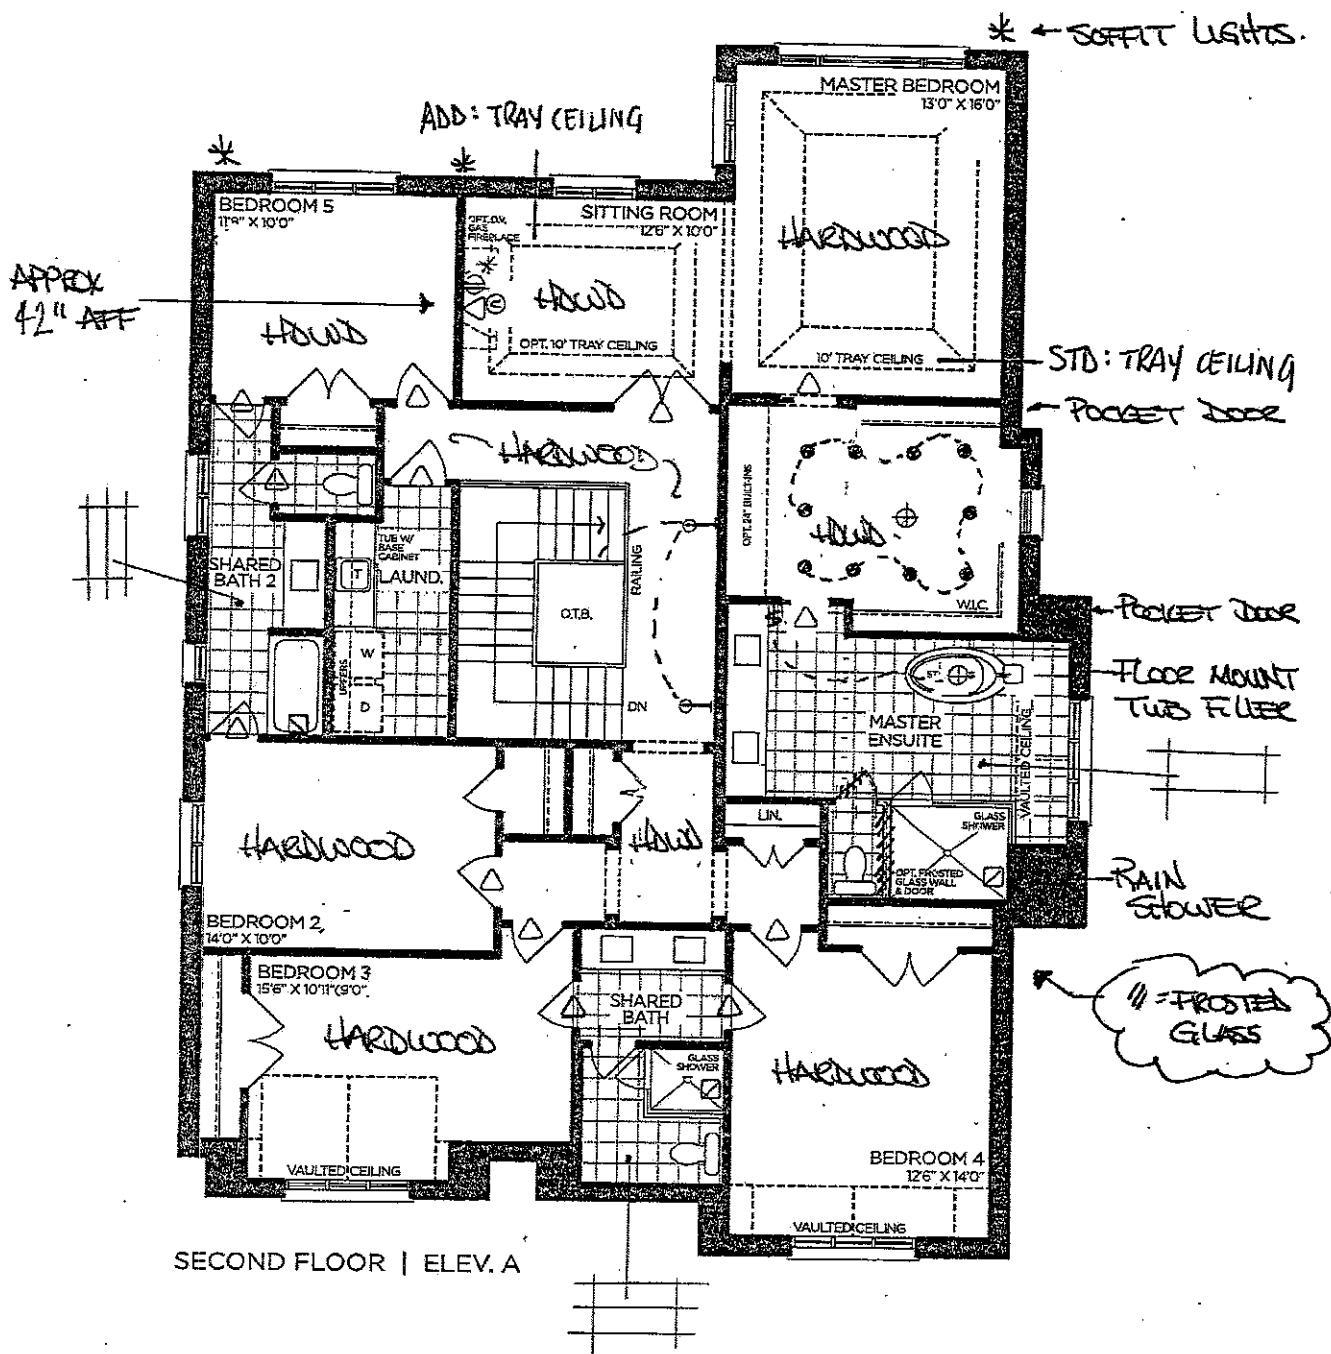

VENDOR

PURCHASER

PURCHASER

GOLDPARK
WORTH MORE™

Prices, figures, illustrations, sizes, features and finishes are subject to change without notice. Areas and dimensions are approximate and actual usable floor space may vary from the stated area. Layout may be reverse of the unit purchased. E. & O.E. 5003

SCHEDULE 'F'



PV-48

NOV 22, 2021

PV-48

DEC 8 2021 (KS)


PV-48

MARCH 1 2022 (KS)

Lot 48

50' SERIES

Elevation A • 4,936 sq.ft.

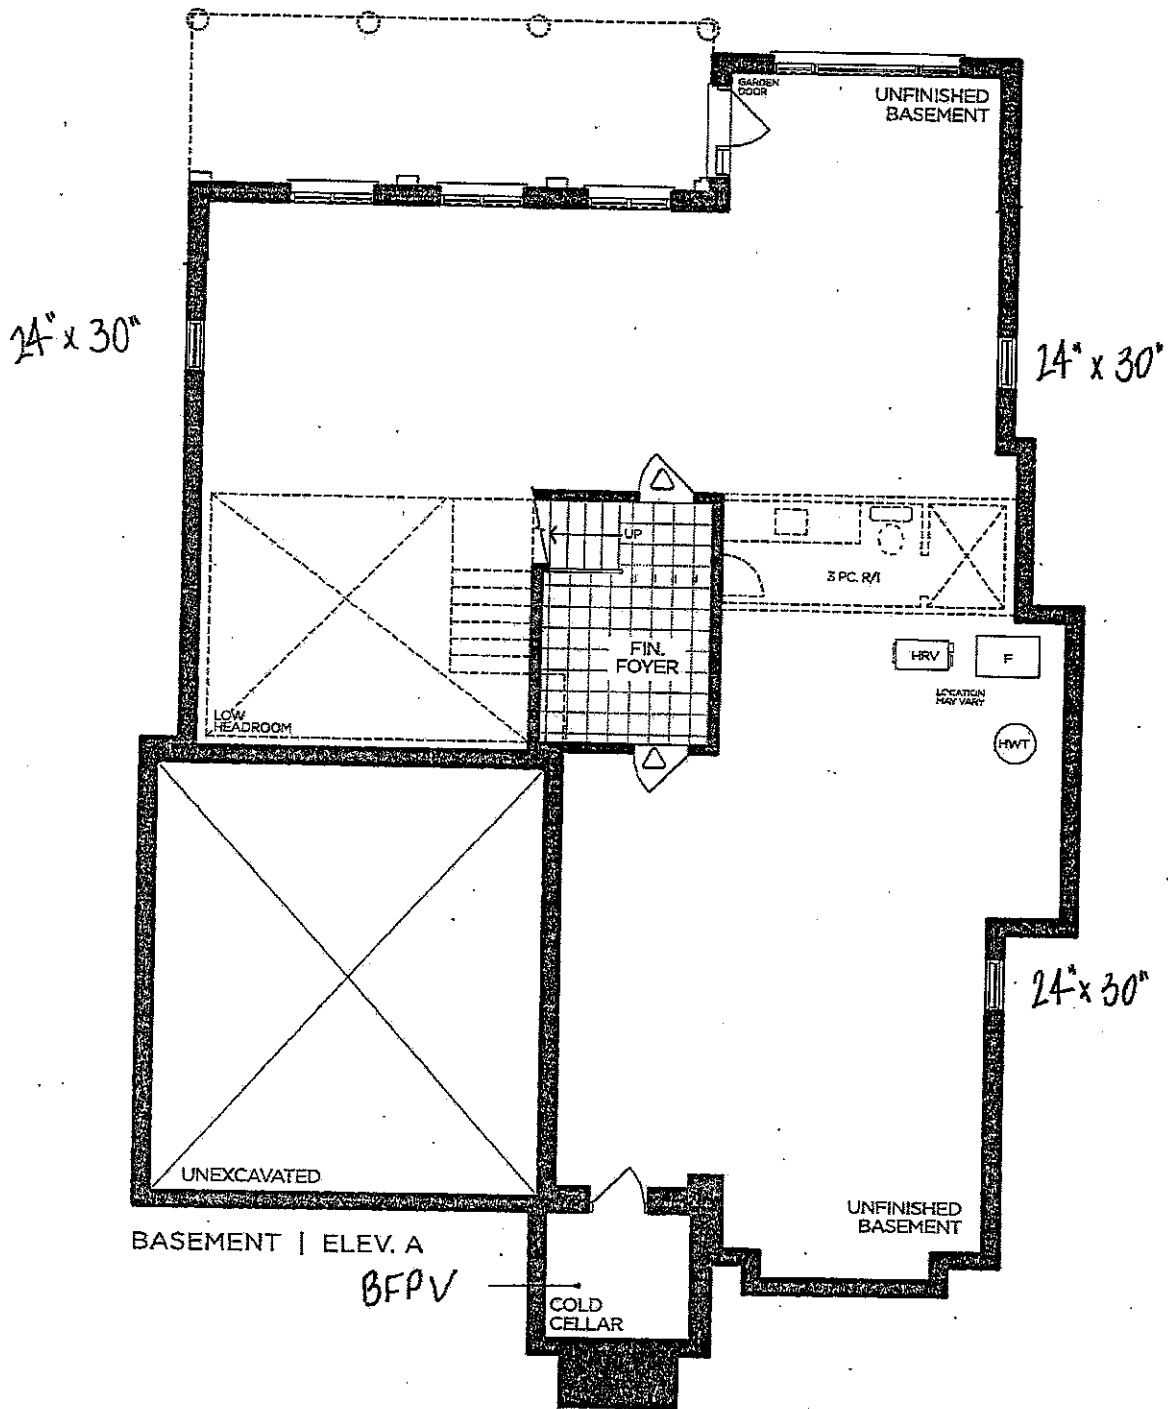

VENDOR

PURCHASER

PURCHASER

GOLDPARK
WORTH MORE™

Prices, figures, illustrations, sizes, features and finishes are subject to change without notice. Areas and dimensions are approximate and actual usable floor space may vary from the stated area. Layout may be reverse of the unit purchased. E. & O.E. 5003



KITCHEN
ISLAND

Wanda's SEAT!
Willis oyster
Gidd hardware

SECRET

~~Base:~~ willis Pencil Block
upper: Ric Alum Block.

Page 1/2


- Ric Aluminum
- Back/class - car
- fin int
- 1/2 cut
- LED lights inside

**GOLDPARK HOMES
PINE VALLEY
VAUGHAN, ONTARIO
MODEL: (5003) OAKGROVE
LOT SPECIFIC 48**

**SITE STANDARD: WHITE 3/4" EXTENSION
SOFT-CLOSE DRAWERS WITH STANDARD
SLAM DOOR HINGES**

10" CELLING - 12"H COFFERED CELL.
M.H. = 102" + 3/4"H CONTEMPORARY
MOLDING + 5 1/4"H FURRING RAIL
+ LARGE CORNICE MOLDING TO
UNDERSIDE OF BOX

FLP 685

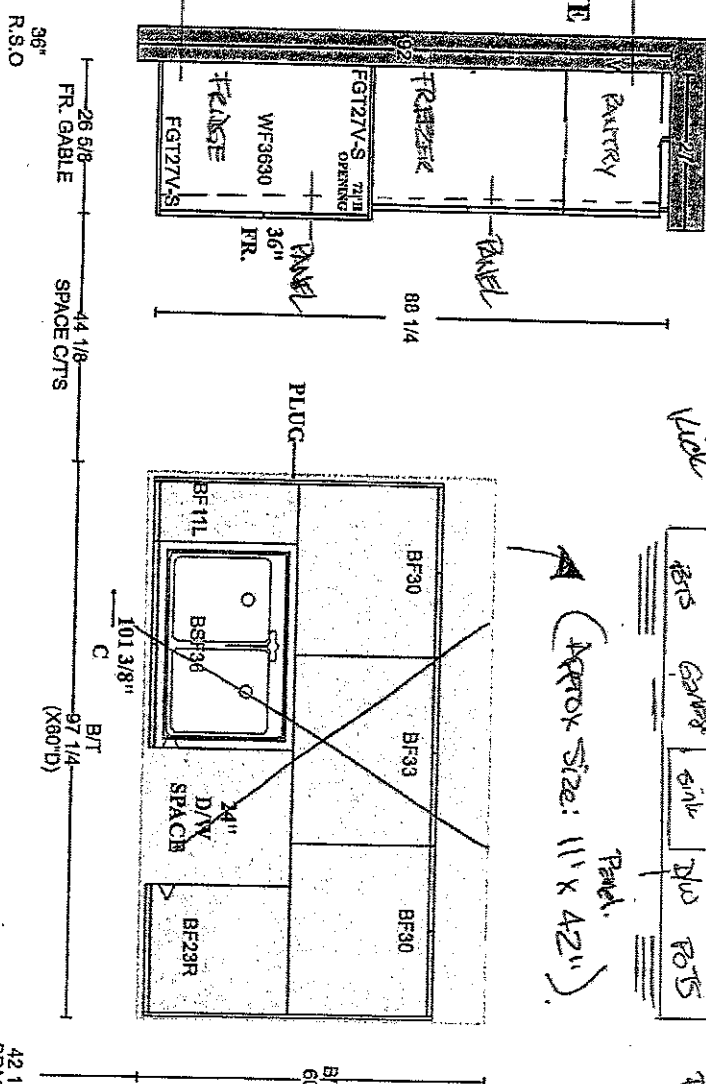

Dr. Patel
+ Rick
Kick


(Approx Size: 11' x 42")

15. Shallow CANIBETERS + TURCH
 16. rest Canibers girl you POIS


Dec
Panel +
Packed
luck

used to
used

T/LATCH
DRAUGHTS
FINISHED TOP
FURN KICK

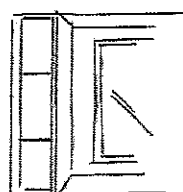

Minibus 8471

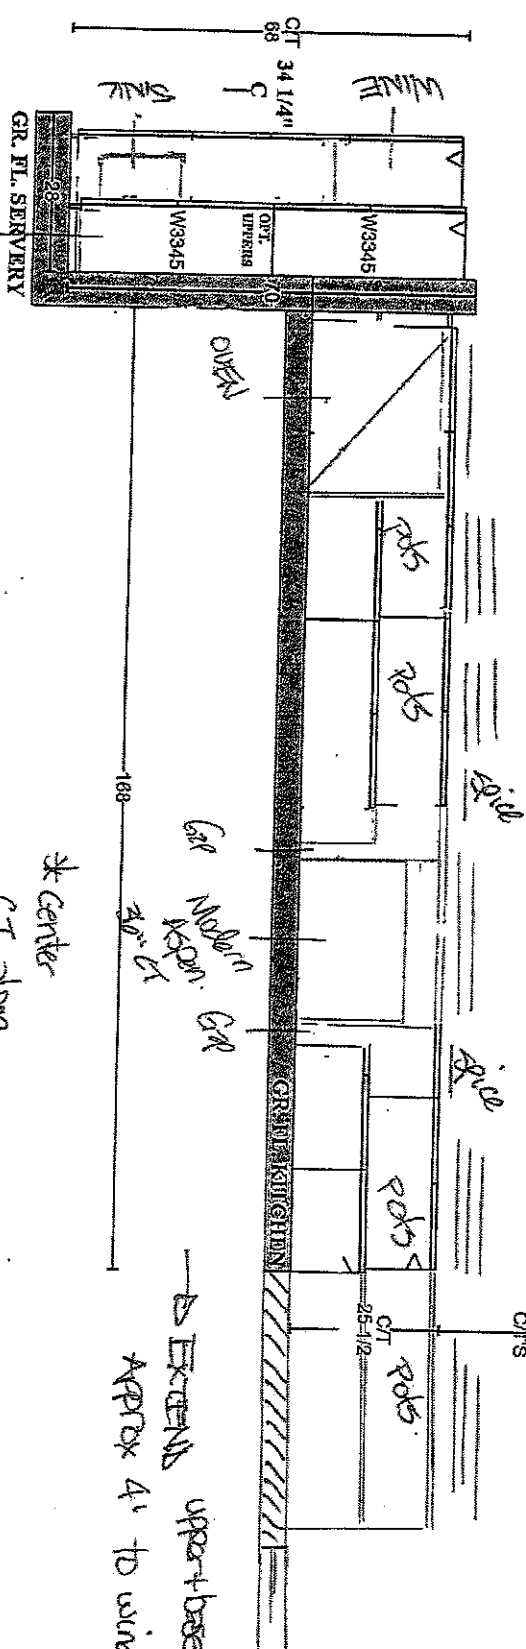

* Center
CT along
New car
Run



→ EXCISES upper + base.

PU-48
March 1 2022 (S)


GOLDPARK HOMES
PINE VALLEY
VAUGHAN, ONTARIO
MODEL: (5003) OAKGROVE
LOT SPECIFIC 48

SITE STANDARD: WHITE 3/4" EXTENSION
SOFT-CLOSE DRAWERS WITH STANDARD
SLAM DOOR HINGES

Gold handles
w/inselle oyster

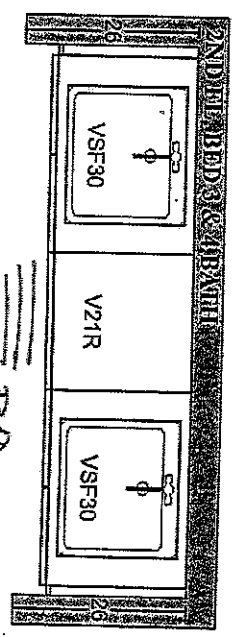
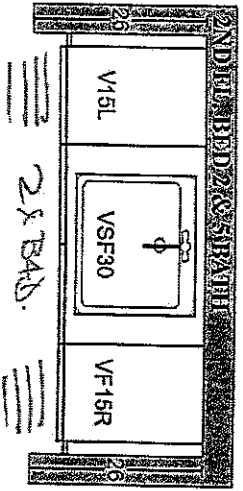


Gold handles
w/inselle oyster
Black handles.

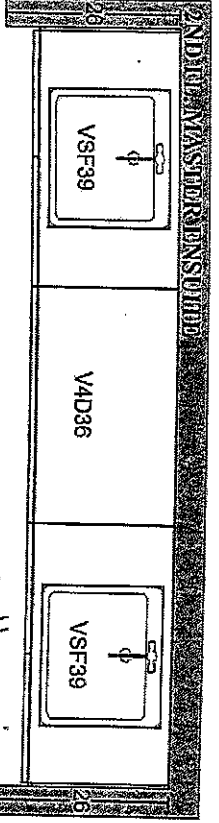


inselle anthracite
gold handles.
comfort height
flooding
Kiel pushed in

Modena white + Gold hardware.

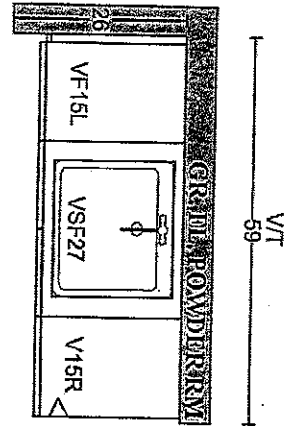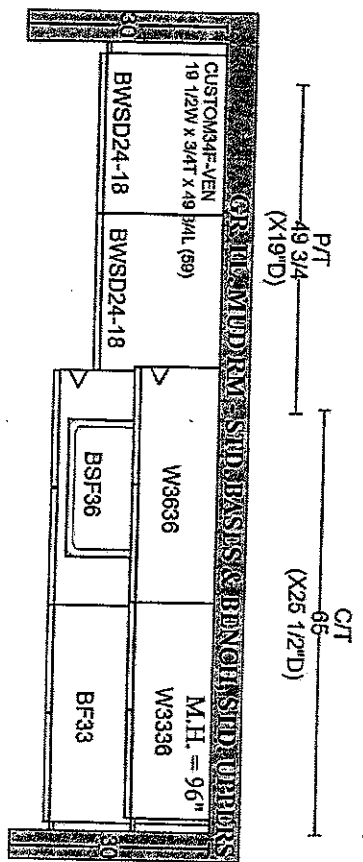

willis oyster
Gold hardware
Black material feet

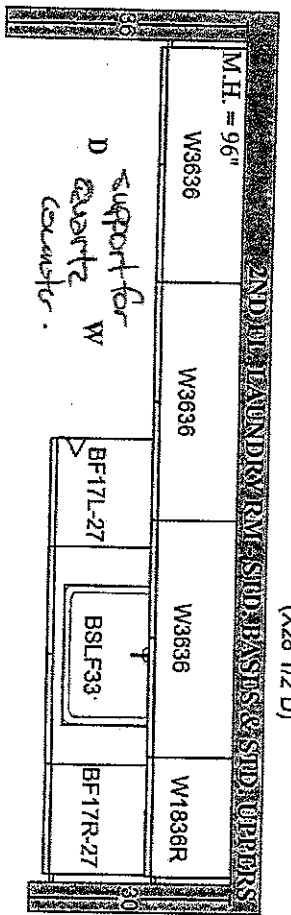

Modena - white
Black handles

PLAN VIEW

UPGRADE HARDWARE



BAH-053-09

Appliance Pull - 'Brushed Gold'



LOCATION:

KITCHEN

LOT # 48	DATE: FEB 25 2022
-------------	----------------------

SIGNATURE: 


SIGNATURE:

UPGRADE HARDWARE



BH-052-09

'Brushed Gold'

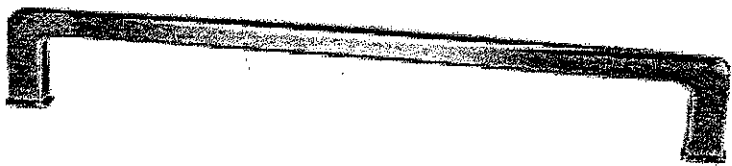

LOCATION:

KITCHEN
ISLAND
SERVING

LOT #
48

DATE:
FEB 25 2022


SIGNATURE: KS

SIGNATURE:

UPGRADE HARDWARE



BH-081-03

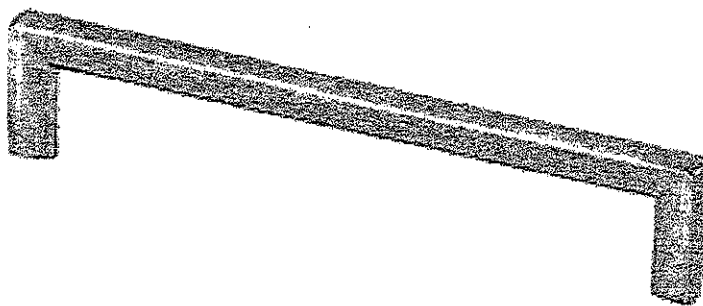

☐ BRUSHED NICKEL

☒ MATTE BLACK - LAUNDRY

☒ MODERN BRONZE - POWDER

- MUD

- MASTER

- SHAVED 2/5 + SHAVED 3/4.

LOCATION:

LOT #

48

DATE:

FEB 25 2022

SIGNATURE:

KS

SIGNATURE:




UPGRADE DECORATIVE HOOD CABINET

PINE VALLEY
FOREVERGREEN

ASPEN MODERN HOOD

(Insert fan not included)

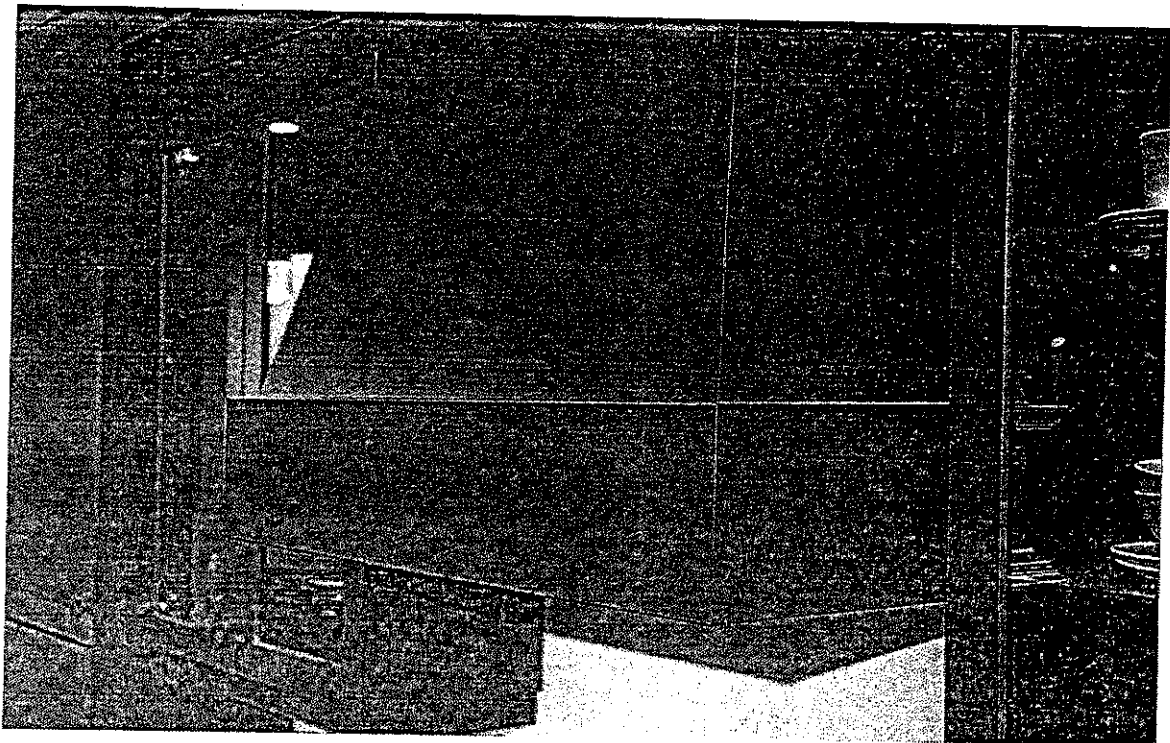

Lot# 48	Date: FEB 25 2022	Room: KITCHEN
Signature: (KS)		
Signature:		



PINE VALLEY


FOREVERGREEN

UPGRADE KITCHEN SINK


BLANCO - PRECIS U SUPER SINGLE

Silgranit - Undermount Sink


32" x 19"

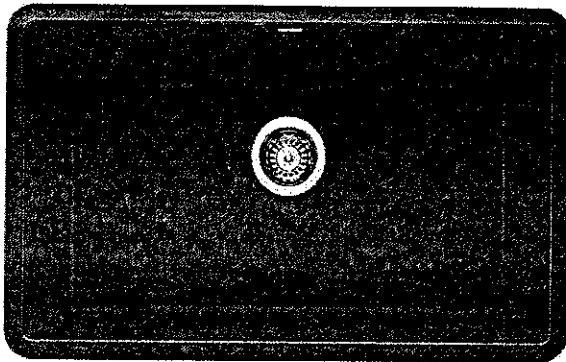


Anthracite

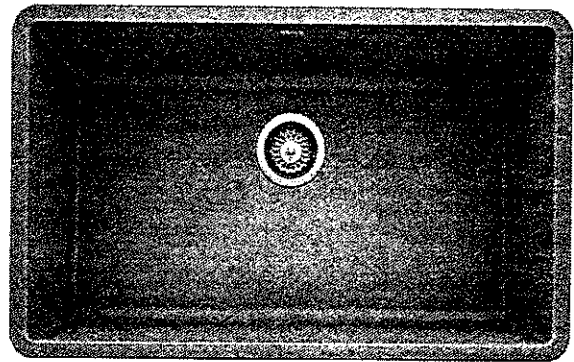

Concrete Grey

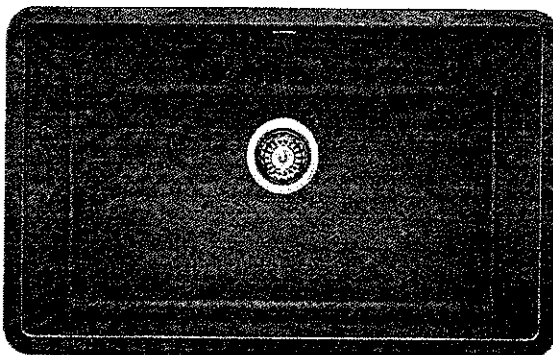

Metallic Grey

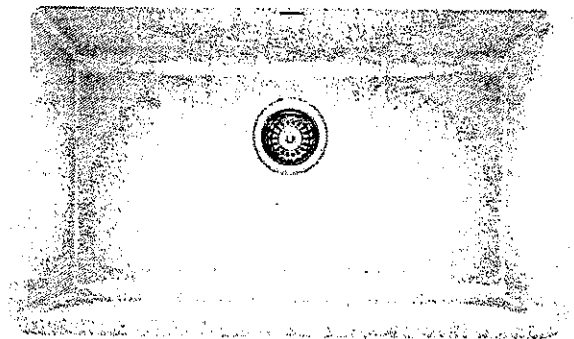

White

☒ ANTHRACITE - ~~KITCHEN~~

☐ CONCRETE GREY

☐ METALLIC GREY

☒ WHITE - KITCHEN

MODEL 400890 Anthracite / 402266 Concrete Grey / 401683 Metallic Grey / 401820 White

Lot#
48

Room:
KITCHEN + ~~SERVICERY~~

Signature:
(KS)

Date:
FEB 25 2022

Signature:


GOLDPARK
WORTH MORE

UPGRADE KITCHEN FAUCET



MOEN - ALIGN

One-Handle Pulldown Kitchen Faucet

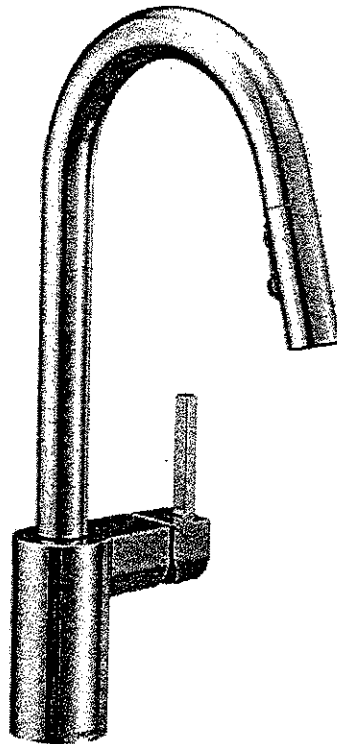

☐ CHROME* - STANDARD

☐ STAINLESS (SRS)

☒ MATTE BLACK (BL) LAUNDRY ROOM

☒ BRUSHED GOLD (BG) KITCHEN + SERVERY + MUD ROOM

MODEL: 7565 Chrome / 7565SRS Stainless / 7565BL Matte Black / 7565BG Brushed Gold


Lot# 48	Date: FEB 25 2022	Room: KITCHEN + SERVERY + MUD ROOM + LAUNDRY
Signatures: (KS)		
Signature:		

UPGRADE FAUCET



MOEN - SIP MODERN

Single Handle Beverage Faucet

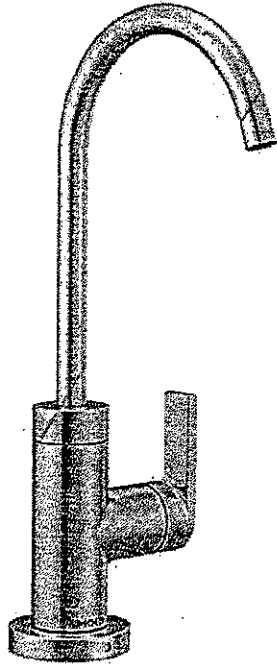

- ☒ GOLD (BG)
- ☐ CHROME (C)
- ☐ STAINLESS (SRS)
- ☐ MATTE BLACK (BL)
- ☐ BLACK STAINLESS (BLS)


MODEL: S5530 / S5500

LOCATE Right of faucet
DO NOT PLUMB, purchaser to
finish plumbing to own water
filtration system after closing


Lot# 48	Date: March 1 2022	Room: Kitchen
Signature: 		
Signature: 		

UPGRADE LAUNDRY SINK


BLANCO - LIVEN
Silgranit - ~~UNDERMOUNT~~
25" x 22" x 12"

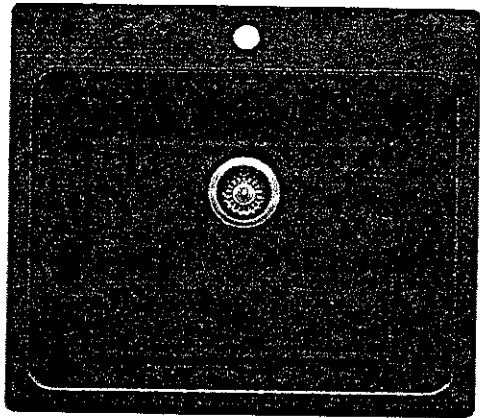


Anthracite

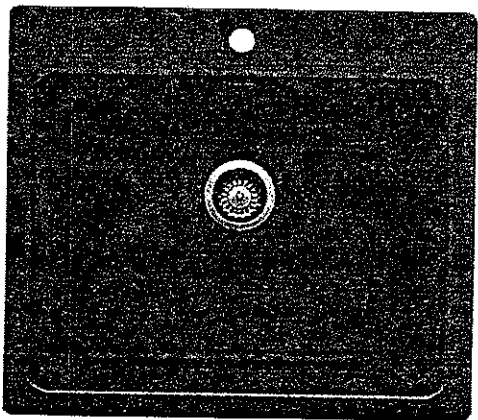

Concrete Grey

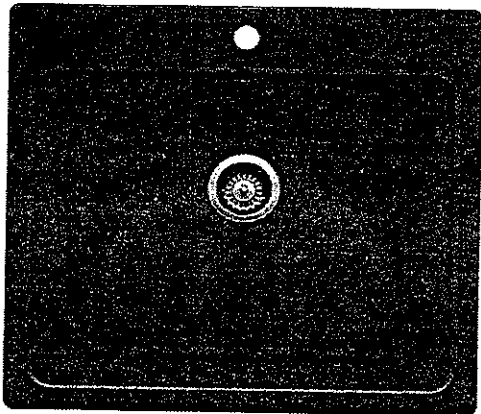

Metallic Grey

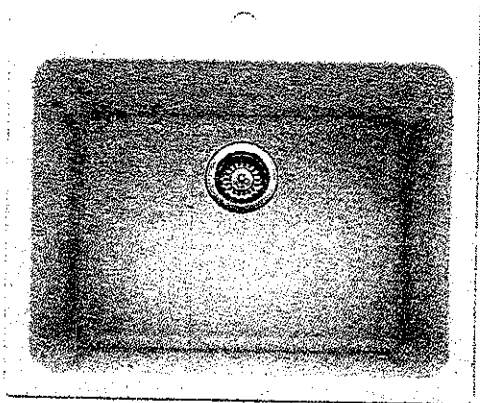

White

- ☒ ANTHRACITE - Laundry Room
- ☐ CONCRETE GREY
- ☐ METALLIC GREY
- ☒ WHITE - Mud Room


MODEL 401902 Anthracite / 402297 Concrete Grey / 401906 Metallic Grey / 401908 White /

Lot# 48	
Room: Mud Room + Laundry	Signature: KS
Date: FEB 25 2022	Signature:



PINE VALLEY
FOREVERGREEN


STONE COUNTERTOP EDGE PROFILES

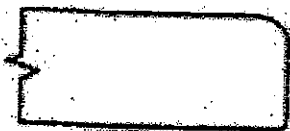

STANDARD 2CM EASED EDGE


LOCATION:

THRU OUT

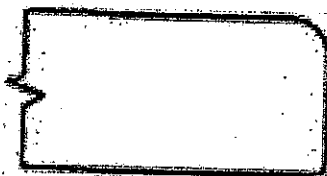

UPGRADE 3CM EASED EDGE

LOCATION:

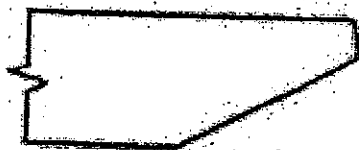

UPGRADE 4CM MITRED EDGE



LOCATION:




UPGRADE 2CM OGEE EDGE

LOCATION:

LOT # 48	DATE: FEB 25 2022
SIGNATURE: KS	
SIGNATURE:	

UPGRADE INTERIOR DOOR

LIVINGSTON DOOR

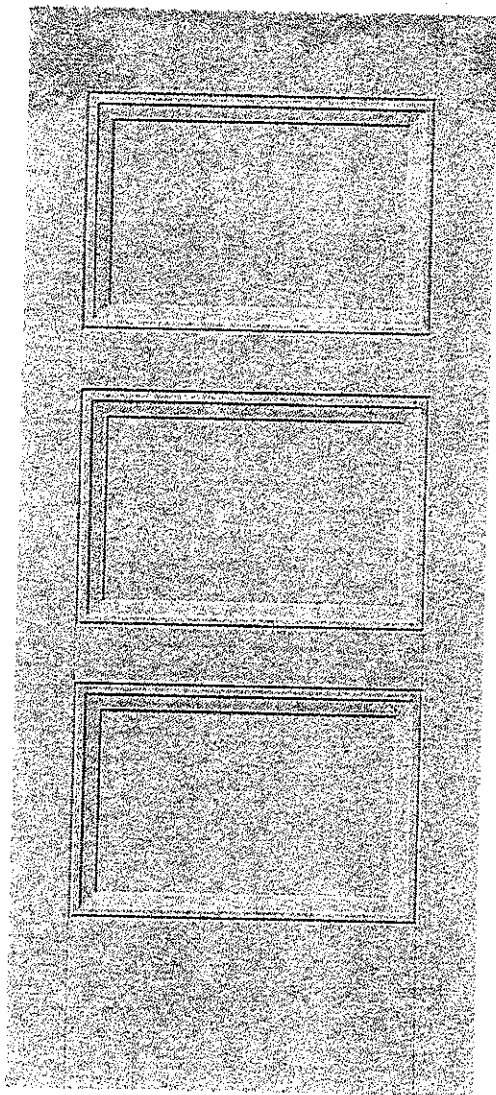

LOCATION:


THRU OUT

LOT # 48	DATE: FEB 25 2022
SIGNATURE: KS	
SIGNATURE:	

UPGRADE TOILET

CILA

Contrac
Soft White
1 Piece Elongated Bowl w/ Concealed Skirted Trap-Way

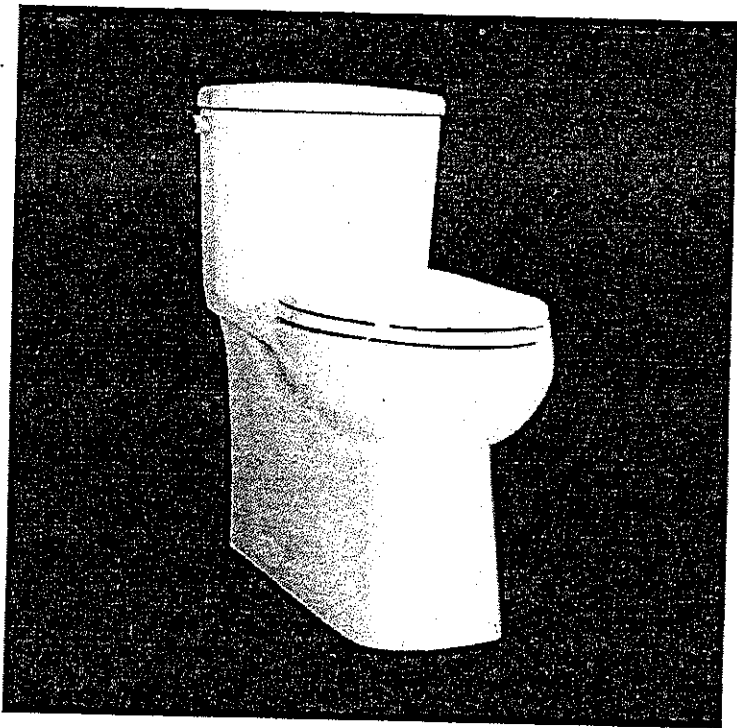

DESCRIPTION: Soft White, 17" plus height for greater comfort, Soft white tank lever

DIMENSIONS: 15 3/8" W x 28 1/2" D x 30 1/8" H


MODEL: 4710BOXU

Lot# 48	Date: FEB 25 2022	Room: THRU OUT
Signature: 		
Signature:		

UPGRADE SHOWER HARDWARE

RM6X6

Shower Door Handle

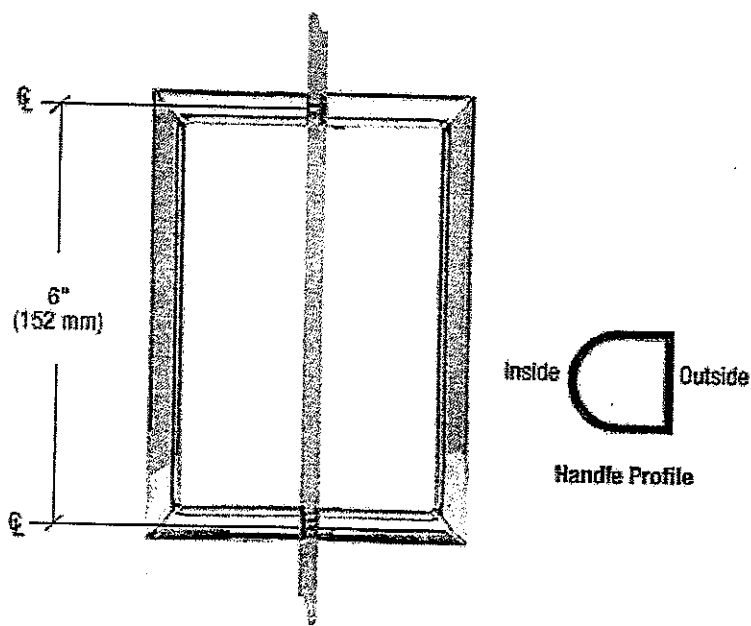



RM6X6
Shower Door Handle

6" RM Series Flat Outside Surface
/ Round Tubing Inside Back-to-
Back Pull Handle

- ☐ CHROME (CH)
☒ BRASS (BR)
☐ BRUSHED NICKEL (BN)

Lot# 48	Date: FEB 25 2022	Room: MASTER ENSUITE + ENSUITE 3/4
Signature: 		
Signature:		

WINDOW STOOLS & APRONS

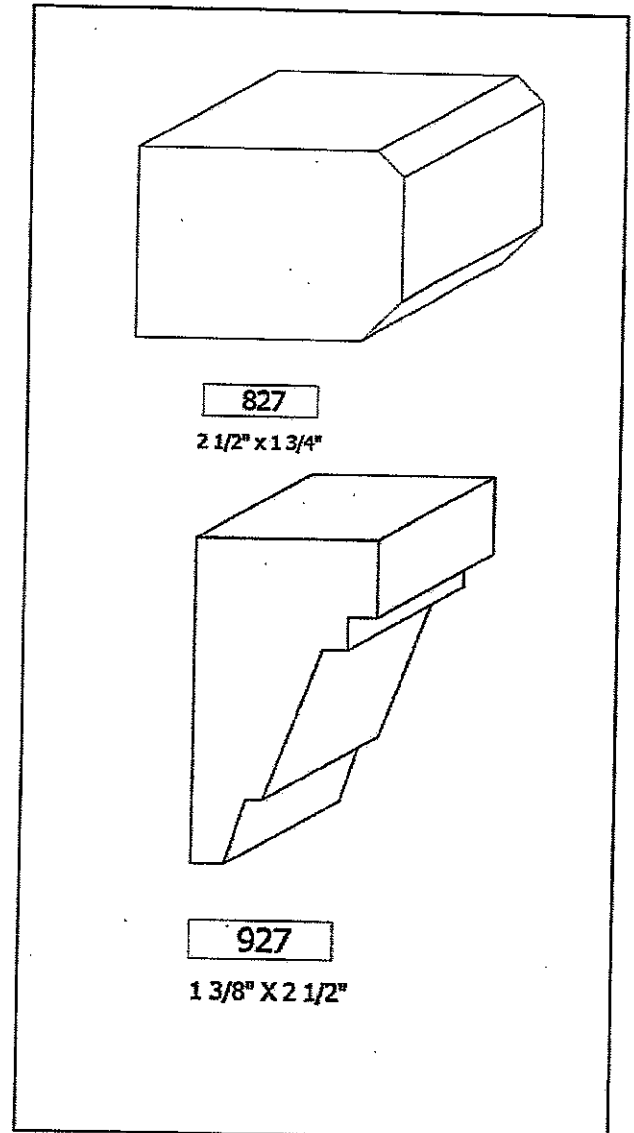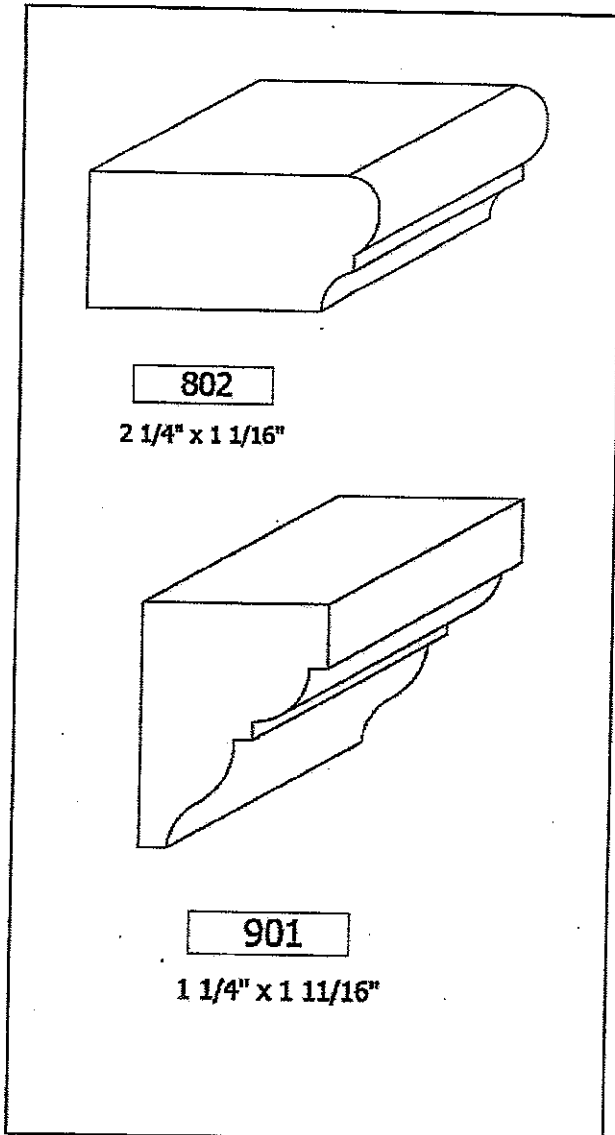


☒ 802 + 901 PACKAGE

☐ 827 + 927 PACKAGE


Lot# 48	Date: FEB 25 2022	Room: THRU OUT
Signature: KS		
Signature:		




CAPRI

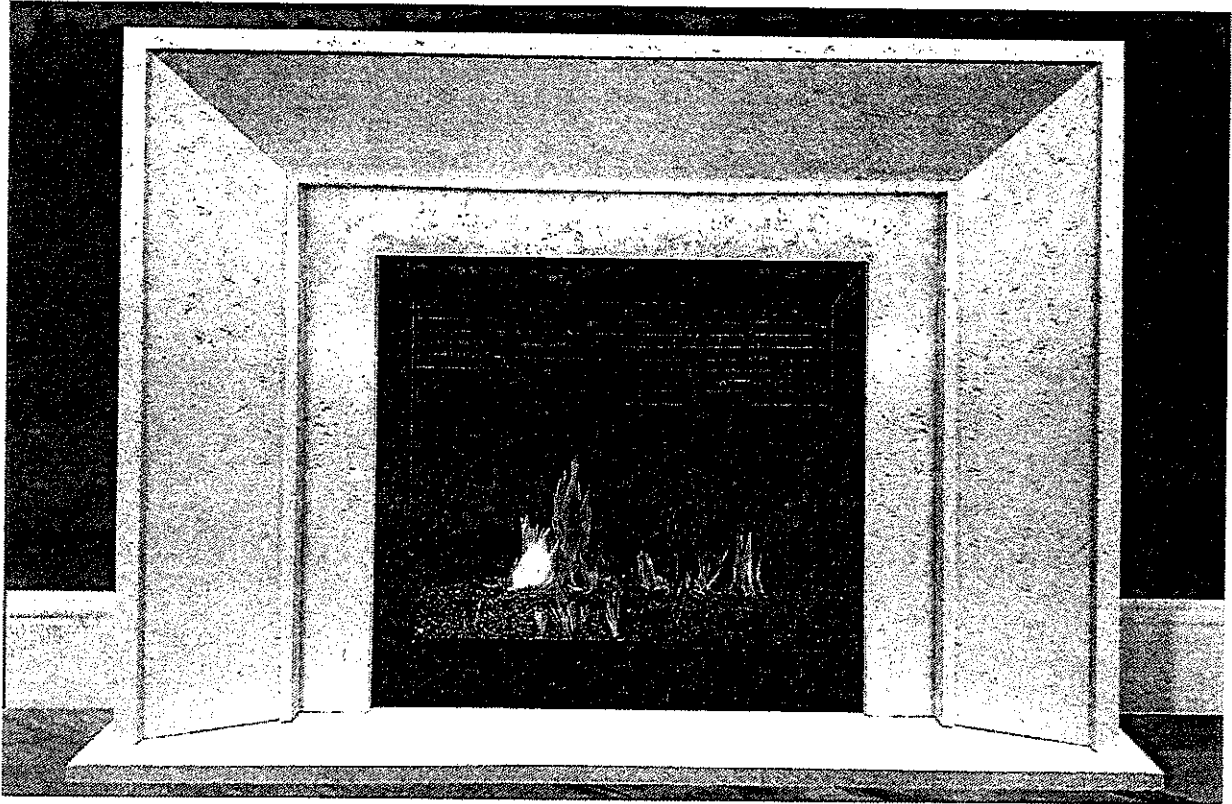

TOP VIEW

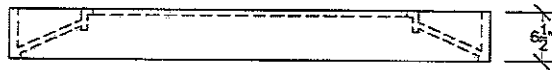


SIDE VIEW

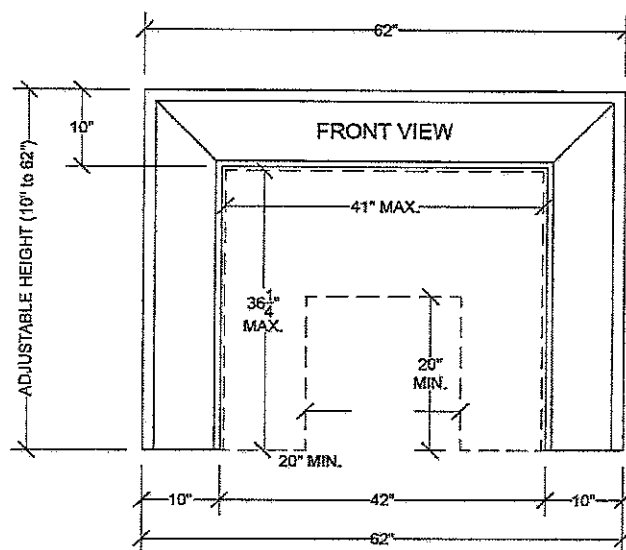[illegible]

LOT #: 48	DATE: FEB 25 2022	LOCATION: GREAT ROOM
SIGNATURE: KS		
SIGNATURE:		

MOEN - ALIGN

Single-Handle Lav Faucet with Rod Drain

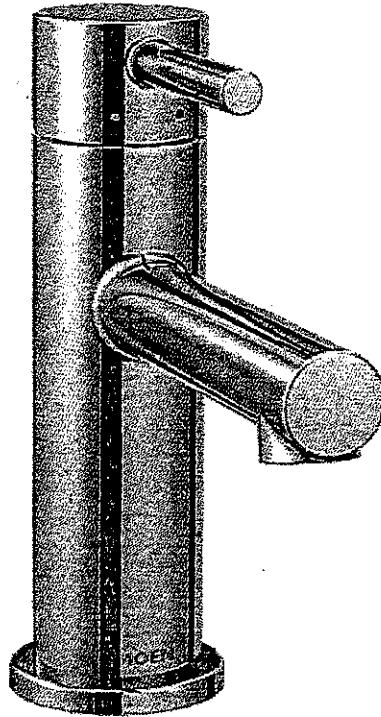

- ☐ CHROME
- ☐ BRUSHED NICKEL (BN)
- ☒ BRUSHED GOLD (BG)
- ☐ MATTE BLACK (BL)

THIS IS A REVERSED SELECTION

MODEL: 6190

Lot# 48	Date: MARCH 1 2022	Room: SHARED 2/5 + 3/4
Signature: 		
Signature:		






PINE VALLEY
FOREVERGREEN

PLUMBING UPGRADES

MOEN - ALIGN

Eco-Performance Posi-Temp Tub/Shower Faucet

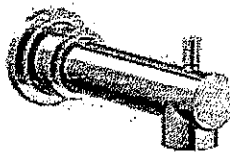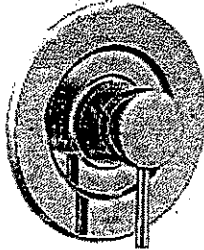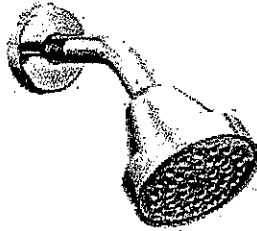

- ☐ CHROME
- ☐ BRUSHED NICKEL (BN)
- ☒ BRUSHED GOLD (BG)
- ☐ MATTE BLACK (BL)

THIS IS A REVISED SELECTION

MODEL: T2193EP / 62320 / 226651

Lot# 48	Date: MARCH 1 2022	Room: SHARED: 2/5.
Signature: KS		
Signature:		

GOLDPARK
WORTH MORE





PINE VALLEY
FOREVERGREEN

PLUMBING UPGRADES

MOEN - ALIGN .

Eco-Performance Posi-Temp SHOWER ONLY* Faucet

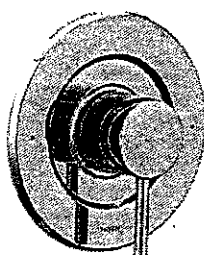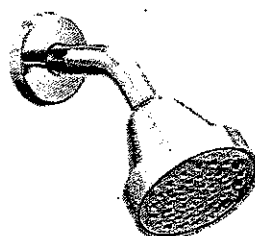

- ☐ CHROME (EP)
- ☒ BRUSHED GOLD (BG)
- ☐ MATTE BLACK (BL)


THIS IS A REVISED SELECTION

MODEL: T2192EP / 62320 / 226651


Lot# 48	Date: March 1 2022	Room: SHARED 3/4
Signature: KS		
Signature:		

GOLDPARK
WORTH MORE

BATHROOM ACCESSORIES

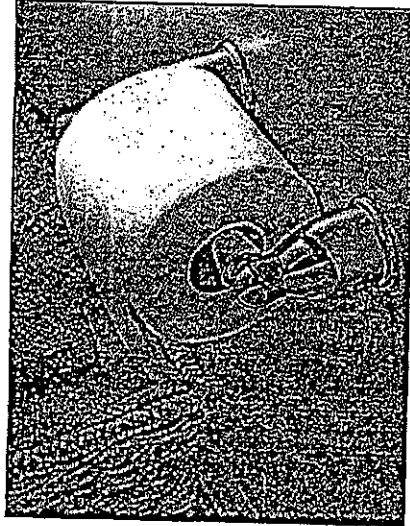

Tissue Holder
Mason - Chrome

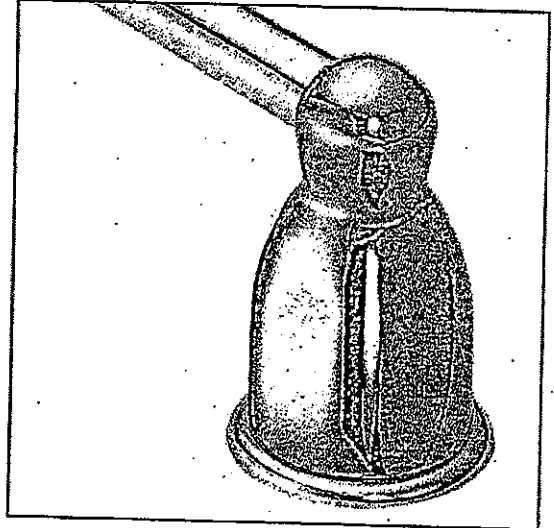

Towel Bar
Mason - Chrome

Please select one of the following:

☐ INSTALL STANDARD BATHROOM ACCESSORIES THRU OUT
(tissue holder + towel bar) **location as per vendors discretion**

☒ ***DO NOT*** INSTALL STANDARD BATHROOM ACCESSORIES
THRU OUT **tissue holder + towel bar will not be provided**

LOT #

48

DATE:

~~FEB~~ 25 2022

SIGNATURE:

KS

SIGNATURE:



Project: PINE VALLEY

Lot: 48

Purchaser(s): KARAN PAL SINGH

Standard Hood Fan Deletion

We acknowledge that the builder's standard hood fan will not be installed.
Do not supply, install and/or credit. We will install our own hood fan after closing.

Signature: (KS)

Signature: _____

Date: FEB 25 2022




PINE VALLEY
FOREVERGREEN

PLUMBING UPGRADES

MOEN - RIZON

Eco-Performance Posi-Temp Tub/Shower Faucet

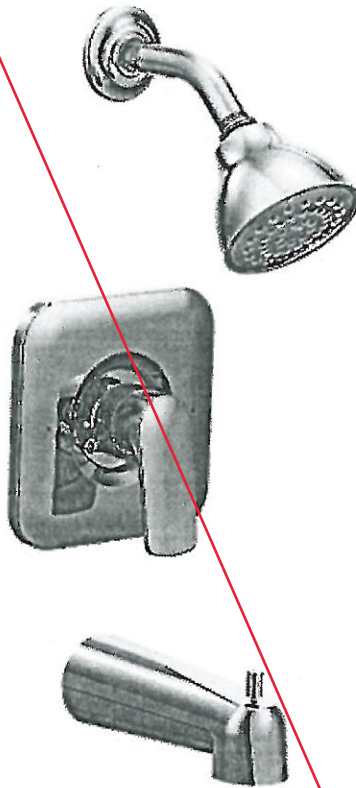

Please see
revised
selection
dated March
1/22

- ☐ CHROME
- ☐ BRUSHED NICKEL (BN)
- ☒ MATTE BLACK (BL)

MODEL: T2813EP / 62320

Lot#

48

Date:

Dec 8 2021

Room:

SHARED 2/5

Signature:

[Handwritten signature]

Signature:


GOLDPARK
WORTH MORE™

ALIGN MASTER ENSUITE PACKAGE

*Brushed Gold

MOEN

Lav Faucets, 8" Rainshower, Handshower, Free-Standing Tub Filler

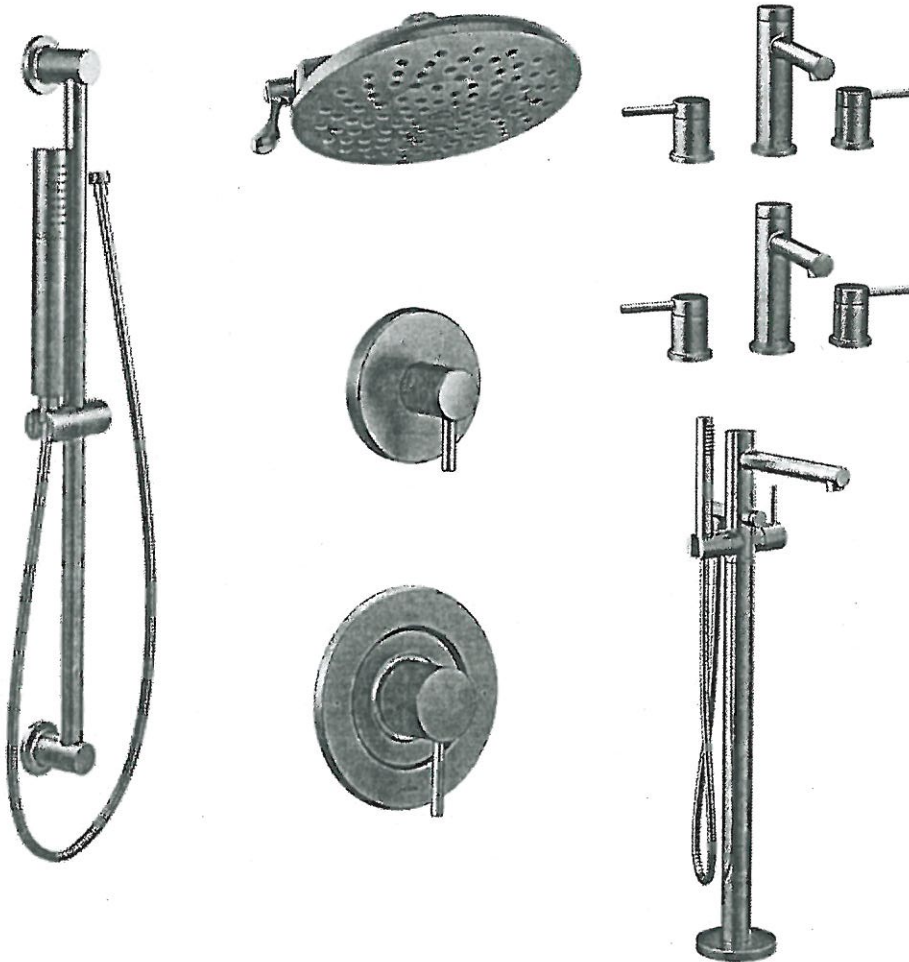

☐ WALL
☒ CEILING

MODEL: S6320 Shower Head + 226651 Shower Arm + T6193/69000 Lav Facuets(x2) + 395/TS50100 Tub Filler + T2192 Shower + U361CI Transfer Valve + UT4191 Transfer + 62320 Temp Valve + 3887 Handshower + A725 Drop El

Lot# 48	Date: DEC 8 2021	Room: MASTER ENSUITE
Signature: [Signature]		
Signature:		

MOEN - ALIGN

Single Freestanding Tub Filler



- ☐ CHROME (EP)
- ☐ BRUSHED NICKEL (BN)
- ☐ MATTE BLACK (BL)
- ☒ BRUSHED GOLD (BG)


MODEL: 395 / TS50100

Lot# 48	Date: Dec 8 2021	Room: MASTER ENSUITE
Signature: 		
Signature:		

PLUMBING UPGRADES

MOEN - RIZON

Eco-Performance Posi-Temp SHOWER-ONLY*

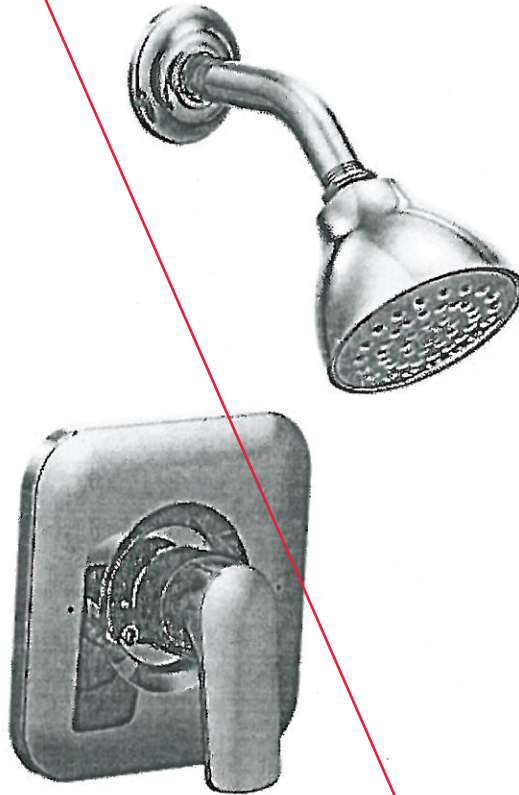

Please see
revised
selection
dated March
1/22

☐ CHROME - STANDARD

☐ BRUSHED NICKEL (BN)

☒ MATTE BLACK (BL)

MODEL: T2812EP / 62320

Lot# 48	Date: DEC 8 2021	Room: SHADE ENSUITE 3/4.
Signature: 		
Signature:		