
QUALIFICATION INFORMATION
Allan Whiting

HUNT DESIGN ASSOCIATES INC.

23177

19695

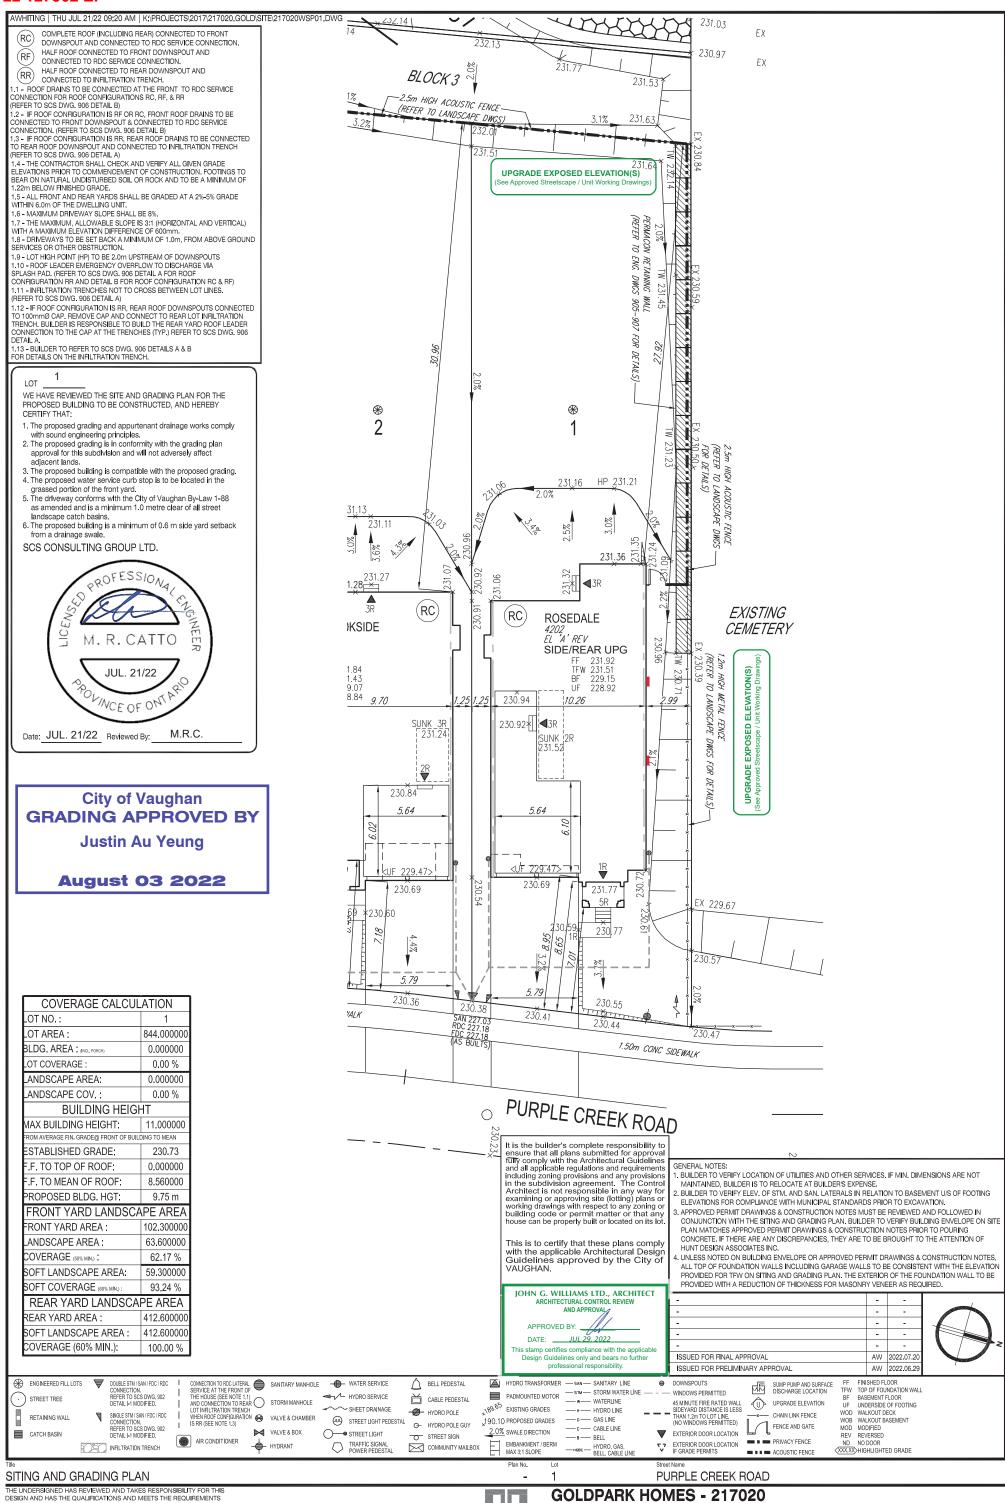

AW

Drawn By

JR

DESIGN ASSOCIATES INC.

PINE VALLEY, VAUGHAN ONT.

1:250

217020WSP01

Lot / Page Numbe