



△/△
LOT NUMBER: 33
UNIT NAME: KNIGHTSWOOD
ELEVATION: A
UNIT NUMBER: 5005-OPT.


△/△
LOT NUMBER: 32
UNIT NAME: KNIGHTSWOOD
ELEVATION: B (REV.)
UNIT NUMBER: 5005-OPT.



△/△
LOT NUMBER: 31
UNIT NAME: WILLOWCREEK
ELEVATION: B
UNIT NUMBER: 5012



△/△
LOT NUMBER: 30
UNIT NAME: TIMBERLAND
ELEVATION: A (REV.)
UNIT NUMBER: 5011

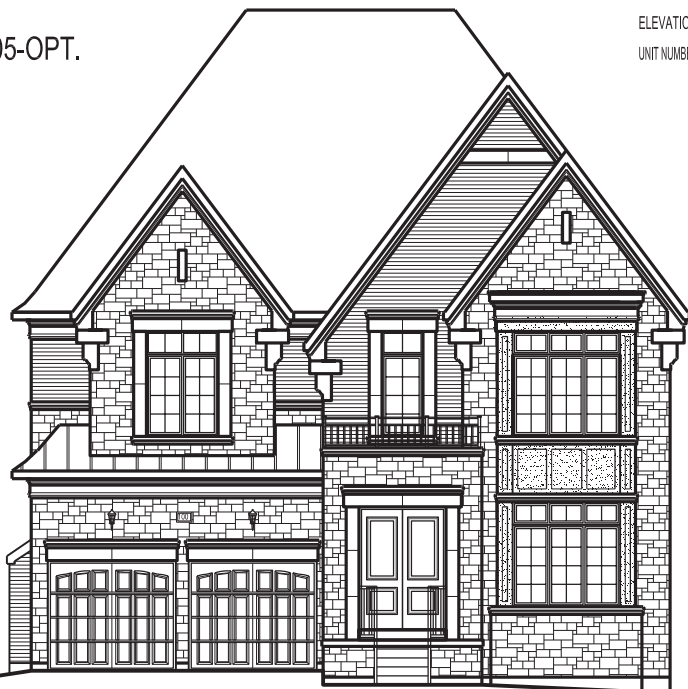


△/△
LOT NUMBER: 29
UNIT NAME: WILLOWCREEK
ELEVATION: A (REV.)
UNIT NUMBER: 5012



△/△
LOT NUMBER: 28
UNIT NAME: RIVERVIEW
ELEVATION: C
UNIT NUMBER: 5013



△/△
LOT NUMBER: 27
UNIT NAME: BROOKSIDE
ELEVATION: B (REV.)
UNIT NUMBER: 4003

JOHN G. WILLIAMS LTD., ARCHITECT
PRELIMINARY
ARCHITECTURAL CONTROL REVIEW
APPROVED BY:  DATE: Aug. 19, 2022
This stamp certifies urban review has been conducted only and bears no further professional responsibility.

It is the builder's complete responsibility to ensure that all plans submitted for approval fully comply with the Architectural Guidelines and all applicable regulations and requirements including zoning provisions and any provisions in the subdivision agreement. The Control Architect is not responsible in any way for examining or approving site (lotting) plans or working drawings with respect to any zoning or building code or permit matter or that any house can be properly built or located on its lot.

This is to certify that these plans comply with the applicable Architectural Design Guidelines approved by the City of VAUGHAN.

LEGEND:

- | | | | | |
|--|---|---|-----------------------------|--|
| 1 BRICK/ STONE VENEER ON SIDES OF STAIRS (POURED OR "BRICK LEDGE" PRECAST) | 2 DROP OR RAISE BANDING BY AMOUNT INDICATED. | 3 ADD BANDING AND/OR TRIM AS INDICATED. | 4 ADDED CAMBERED HEADERS | 5 8'-0" X 8'-0" GARAGE DOORS. |
| 6 DROPPED OR RAISED SOFFIT AS INDICATED. | 7 ADJUSTED ROOF OVERHANG AS INDICATED ON ROOF PLAN. | 8 PROVIDE GUARD PER CONSTRUCTION NOTE 11. | 9 FOYER SUNKEN AS INDICATED | 10 LIGHT FIXTURE RELOCATED AS INDICATED. |

HUNT 
DESIGN ASSOCIATES INC.
www.huntdesign.ca

GOLDPARK HOMES - 221081
PINE VALLEY PH2, VAUGHAN ON
8966 Woodbine Ave, Markham, ON L3R 0J7 ■ T 905.737.5133 ■ F 905.737.7326 ■ 2020/10/15 ■ NEA ■

STREETSCAPES - LOTS 27-31
PAGE 07
221081WSS01

All drawings specifications, related documents and design are the copyright property of Hunt Design Associates (H.D.A.). Reproduction of this property in whole or in part is strictly prohibited without H.D.A.'s written permission.