

## LEGEND:

BRICK/ STONE VENEER ON SIDES OF STAIRS (POURED OR 'BRICK LEDGE' PRECAST)

DROP OR RAISE BANDING BY AMOUNT INDICATED.

ADD BANDING AND/OR TRIM AS INDICATED.

4 ADDED CAMBERED HEADERS

5 8'-0" X 8'-0" GARAGE DOORS.





STREETSCAPES - LOTS 42-49

217020WSS01

PINE VALLEY, VAUGHAN ONT. 8966 Woodbine Ave, Markham, ON L3R 0J7 ■ T905.737.5133 ■ F905.737.7326 ■ 2021/03/15 ■ NEA ■


6 DROPPED OR RAISED SOFFIT AS INDICATED.

ADJUSTED ROOF OVERHANG
AS INDICATED ON ROOF PLAN.

PROVIDE GUARD PER CONSTRUCTION NOTE 11.

9 FOYER SUNKEN AS INDICATED

LIGHT FIXTURE RELOCATED AS INDICATED.

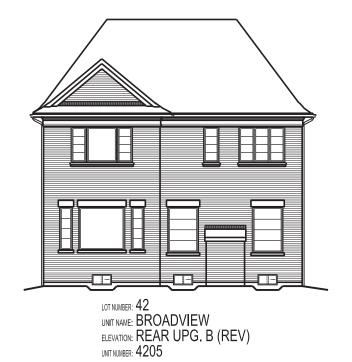







LOT NUMBER: 45

UNIT NAME: BROADVIEW
ELEVATION: REAR UPG. C
UNIT NUMBER: 4205

LOT NUMBER: 46
UNIT NAME: FORESTVIEW
ELEVATION: REAR UPG. B(REV)
UNIT NUMBER: 4206

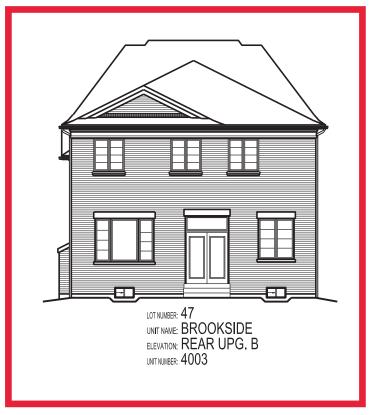

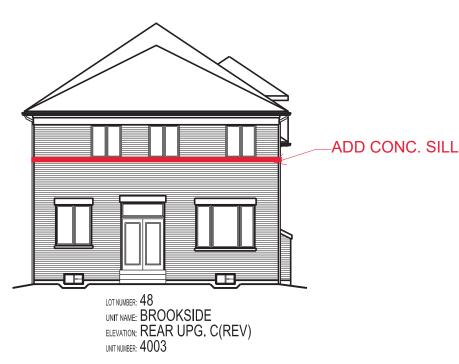

It is the builder's complete responsibility to ensure that all plans submitted for approval fully comply with the Architectural Guidelines and all applicable regulations and requirements including zoning provisions and any provisions in the subdivision agreement. The Control Architect is not responsible in any way for examining or approving site (lotting) plans or working drawings with respect to any zoning or building code or permit matter or that any house can be properly built or located on its lot.

JOHN G. WILLIAMS LTD., ARCHITECT
ARCHITECTURAL CONTROL REVIEW
AND APPROVED BY:

DATE: JAN 19, 2022

This is to certify that these plans comply with the applicable Architectural Design Guidelines approved by the City of VAUGHAN.

his stamp certifies compliance with the applicable Design Guidelines only and bears no further professional responsibility.

## LEGEND:

BRICK/ STONE VENEER ON SIDES OF STAIRS (POURED OR 'BRICK LEDGE' PRECAST)

6 DROPPED OR RAISED SOFFIT AS INDICATED.

DROP OR RAISE BANDING BY AMOUNT INDICATED.

ADJUSTED ROOF OVERHANG AS INDICATED ON ROOF PLAN.

DING 3 A

PROVIDE GUARD PER CONSTRUCTION NOTE 11.

ADD BANDING AND/OR TRIM AS INDICATED. 4 ADDED CAMBERED HEADERS

9 FOYER SUNKEN AS INDICATED

5 8'-0" X 8'-0" GARAGE DOORS.

LIGHT FIXTURE RELOCATED AS INDICATED.

