



EMAIL TRANSMITTAL

TO: Shahin Ramim	DATE: April 19, 2022
FIRM: Hunt Design	RE: Colours, Gold Park, Pine Valley
EMAIL: sramin@huntdesign.ca	FILE #: W-1559'B'

Total number of pages sent 2 , including this cover page. If you did not receive all the pages please call (905) 780-0500 or (905) 780-9534.

The following exterior colour package selection(s) and/or revision(s) **only** for Gold Park Homes, Pine Valley have been reviewed and approved **as noted** attached:

Approved – Condo Selections

Condo Blocks: #1 - #17

NOTE: Any revisions to the attached TH selections are required to be submitted for our review and approval.

Please submit the colour selections for each lot as they are chosen by the purchaser to avoid issues with repetition.

If you have any questions please do not hesitate to contact our office.

Thank you,

Carolyn

Approved By:  Avi Shwartz Boyd Montgomery


Processed By: Carolyn Donaldson

Pine Heights Gold Park - Condos

McQuinn

Color Selects

ARCHITECTURAL REVIEW & APPROVAL
APR 19 2022
John G. Williams, Licensed Architect

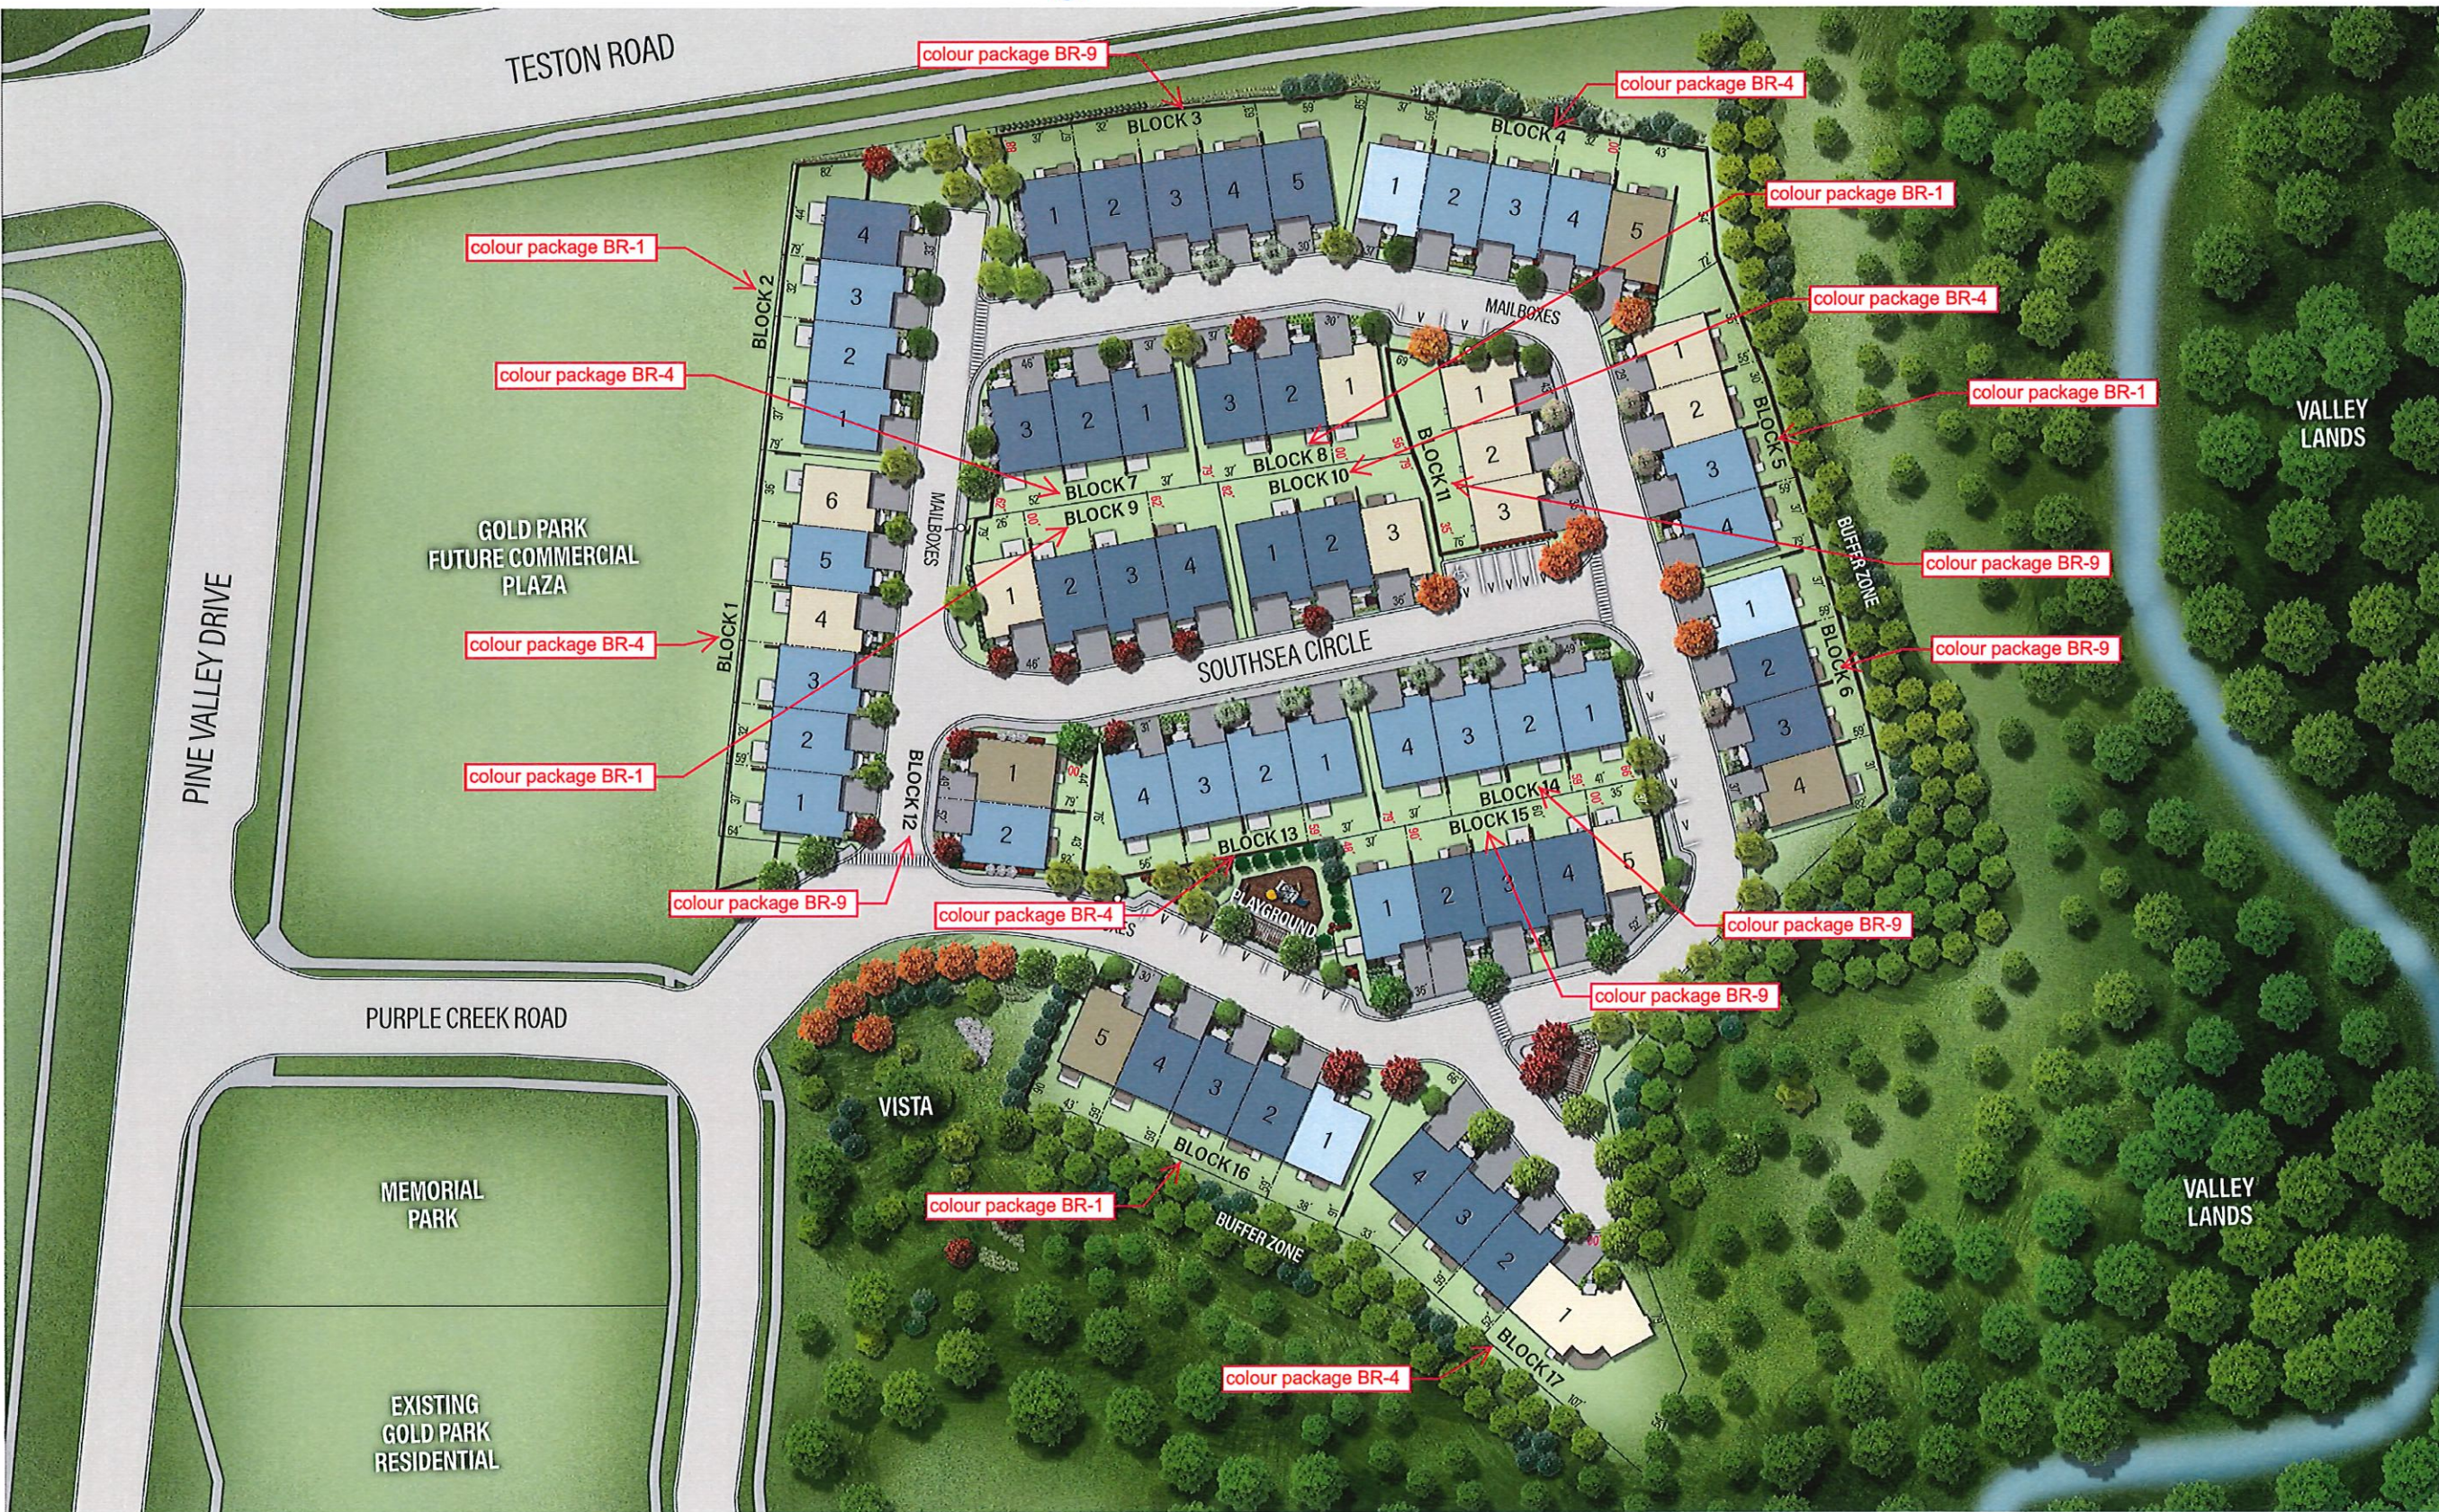

3101
3102
3103
3104
3105
3106