
City of Vaughan **GRADING APPROVED BY Jason Pham**

May 25 2022



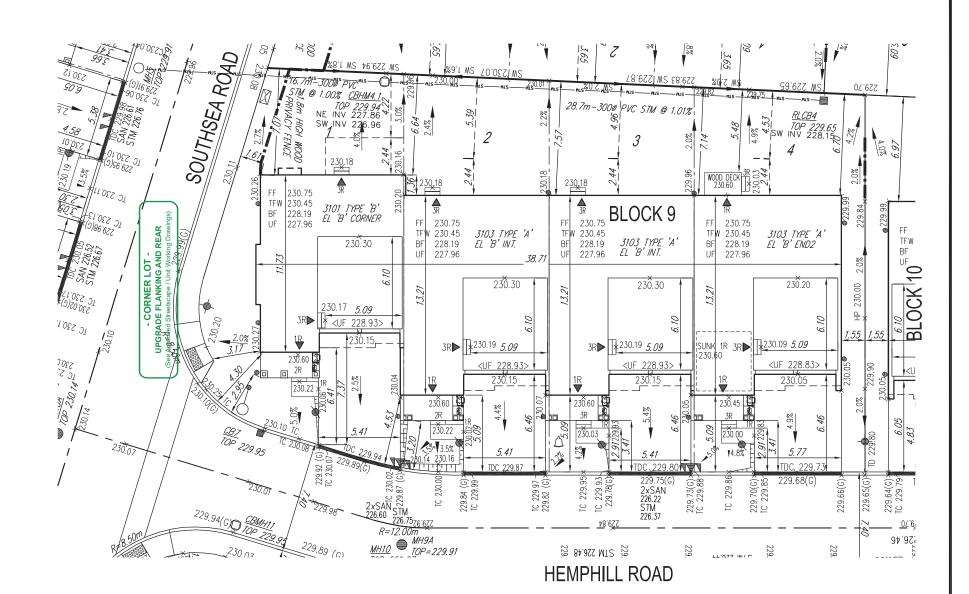

BUILDING HEIGHT		COVERAGE CALCULATION		COVERAGE CALCULATION		COVERAGE CALCULATION		COVERAGE CALCULATION		
MAX BUILDING HEIGHT:	12.00 m	LOT NO.:	BLK 9-1	LOT NO.:	BLK 9-2	LOT NO.:	BLK 9-3	LOT NO.:	BLK 9-4	
FROM AVERAGE FIN. GRADE TO MEAN		LOT AREA:	291.85 m2	LOT AREA:	250.16 m2	LOT AREA:	246.30 m2	LOT AREA:	284.10 m2	
ESTABLISHED GRADE:	230.13	BLDG. AREA :	124.30 m2	BLDG. AREA:	135.45 m2	BLDG. AREA :	135.45 m2	BLDG. AREA:	136.94 m2	
F.F. TO TOP OF ROOF:	11.33 m	LOT COVERAGE (%):	42.59 %	LOT COVERAGE (%):	54.15 %	LOT COVERAGE (%):	54.99 %	LOT COVERAGE (%):	48.20 %	
F.F. TO MEAN OF ROOF:	8.59 m	FRONTAGE @ 6.4M		FRONTAGE @ 6.4M		FRONTAGE @ 6.4M		FRONTAGE @ 6.4M		
PROPOSED BLDG. HGT.	9,21 m	FRONTAGE:	13,39 m	FRONTAGE:	9.60 m	FRONTAGE:	9.60 m	FRONTAGE:	11,28 m	
		FRONT LANDSCAPE STATS		FRONT LANDSCAPE STATS		FRONT LANDSCAPE STATS		FRONT LANDSCAPE STATS		
		FRONT YARD AREA:	53.32 m2	FRONT YARD AREA:	32.44 m2	FRONT YARD AREA:	32.73 m2	FRONT YARD AREA:	38.46 m2	
		LANDSCAPE AREA:	23.76 m2	LANDSCAPE AREA:	13.99 m2	LANDSCAPE AREA:	14.29 m2	LANDSCAPE AREA:	18.79 m2	
		COVERAGE (%): (50% MIN)	44.56 %	COVERAGE (%):	43.13 %	COVERAGE (%):	43.66 %	COVERAGE (%):	48.86 %	
	_	SOFT LANDSCAPE AREA:	21.73 m2	SOFT LANDSCAPE AREA:	11.57 m2	SOFT LANDSCAPE AREA:	11.61 m2	SOFT LANDSCAPE AREA:	16.12 m2	
uilder's complete responsibility to		COVERAGE (%): (60% MIN)	91.46 %	COVERAGE (%):	82.70 %	COVERAGE (%):	81.25 %	COVERAGE (%):	85.79 %	

It is the builder's complete responsibility to ensure that all plans submitted for approval fully comply with the Architectural Guidelines and all applicable regulations and requirements including zoning provisions and any provisions in the subdivision agreement. The Control Architect is not responsible in any way for examining or approving site (lotting) plans or working drawings with respect to any zoning or building code or permit matter or that any house can be properly built or located on Its lot.

This is to certify that these plans comply with the applicable Architectural Design Guidelines approved by the City of VAUGHAN.

JOHN G. WILLIAMS LTD., ARCHITECT AND APPROVAL APPROVED BY: DATE: MAY 12, 2022 This stamp certifies compliance with the applicable Design Guidelines only and bears no further professional responsibility.

NOTE: SANITARY LATERAL INFORMATION IS BASED ON AS-BUILT SHEET PROVIDED ON OCTOBER 19, 2020

9 LOT REVIEWED FOR:

1. GRADING AS BEING IN CONFORMANCE WITH THE DRAINAGE CONCEPTS SHOWN ON THE APPROVED LOT GRADING PLANS PREPARED BY SCS CONSULTING GROUP LTD.

Date: MAY 04/22 Reviewed By:

SCS CONSULTING GROUP LTD.

GENERAL NOTES:

ATION OF UTILITIES AND OTHER SERVICES, IF MIN, DIMENSIONS ARE NOT MAINTAINED, BUILDER IS TO BELOCATE AT BUILDER'S EXPENSE.

2. BUILDER TO VERIFY ELEV. OF STM. AND SAN. LATERALS IN RELATION TO BASEMENT US OF FOOTING ELEVATIONS FOR COMPLIANCE WITH MUNICIPAL STANDARDS PRIOR TO EXCAVATION.

. APPROVED PERMIT DRAWINGS & CONSTRUCTION NOTES MUST BE REVIEWED AND FOLLOWED IN CONJUNCTION WITH THE STING AND GRADING PLAN, BUILDER TO VERIFY BUILDING ENVELOPE ON SITE PLAN MATCHES APPROVED PERMIT DRAWINGS & CONSTRUCTION NOTES PRIOR TO POURING CONCRETE. IF THERE ARE ANY DISCREPANCIES, THEY ARE TO BE BROUGHT TO THE ATTENTION OF HUNT DESIGN ASSOCIATES INC.

I. UNLESS NOTED ON BUILDING ENVELOPE OR APPROVED PERMIT DRAWINGS & CONSTRUCTION NOTES, ALL TOP OF FOUNDATION WALLS INCLUDING GARAGE WALLS TO BE CONSISTENT WITH THE ELEVATION PROVIDED FOR TFW ON SITING AND GRADING PLAN. THE EXTERIOR OF THE FOUNDATION WALL TO BE PROVIDED WITH A REDUCTION OF THICKNESS FOR MASONRY VENEER AS REQUIRED.


	-	-	-	ISSUED FOR PERMIT	AW	2022.02.22	
	-	-	-	ISSUED FOR ENG. GRADING REVIEW	AW	2021/11/03	
	-	-	-	ISSUED FOR SITE PLAN APPROVAL	OF	2019/11/26	`
	-	-	-	REVISED TO MATCH NEW GRADING AND FENCE DETAILS	OF	2019/09/18	(
			-	REVISED AS PER CITY COMMENTS	OF	2019/08/07	'
			-	ISSUED FOR SITE PLAN APPROVAL	OF	2019/01/29	
	REVISED PER CITY GRADING COMMENTS	AW	2022.04.20	ISSUED FOR SITE PLAN APPROVAL	OF	2018/03/16	
ARY MANHOLE	→ WATER SERVICE	ANSFORM	MER — SAN—	- SANITARY LINE DOWNSPOUTS	PUMP AN	ID SURFACE	FF






19695



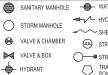





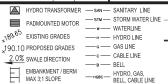

WINDOWS PERMITTED 45 MINUTE FIRE RATED WALL SIDEYARD DISTANCE IS LESS EXTERIOR DOOR LOCATION EXTERIOR DOOR LOCATION IF GRADE PERMITS

DISCHARGE LOCATION UPGRADE ELEVATION CHAIN LINK FENCE FENCE AND GATE PRIVACY FENCE ACOUSTIC FENCE

FINISHED FLOOR
TOP OF FOUNDATION WAI
BASEMENT FLOOR
UNDERSIDE OF FOOTING
WALKOUT DECK WALKOUT BASEMENT MODIFIED REV REVERSED

SITING AND GRADING PLAN

HUNT DESIGN ASSOCIATES INC.

THE UNDERSIGNED HAS REVIEWED AND TAKES RESPONSIBILITY FOR THIS DESIGN AND HAS THE QUALIFICATIONS AND MEETS THE REQUIREMENTS SET OUT IN THE ONTARIO BUILDING CODE TO BE A DESIGNER. QUALIFICATION INFORMATION

(M) Allan Whiting 23177 NAME REGISTRATION INFORMATION



BLOCK 9 HEMPHILL ROAD GOLDPARK HOMES - 217014 PINE VALLEY DRIVE, VAUGHAN, ONTARIO

Drawn By Checked By Scale File Number OF OF 1:250 217014-SPA3 8966 Woodbine Ave, Markham, ON L3R 0J7 T 905.737.5133 F 905.737.7326 **BLOCK 9**