

CONSTRUCTION SUMMARY

Lot: 5-1

Model: 31-01 B END1 Avebury Manor **Project/Phase: The Manors at Pine Valley / 4**

CROWN MOULDING

Invoice	Qty.	Description
3035	1	GREAT ROOM: ADD 6 BOX WAFFLE CEILING - CTR-B59+B60 MODERN STYLE
28Sep23 NoCat		

No. Decorption	ELECT	ELECTRICAL				
164,749 IN LIEU OF STANDARD CEILING LIGHTS, USE STANDARD SWITCHES. SEE PLAN FROM LOCATION 3035 164,749 IN LIEU OF STANDARD CEILING LIGHTS, USE STANDARD SWITCH. SEE PLAN FOR LOCATION 3035 164,739 IN LIEU OF STANDARD CEILING LIGHTS, USE STANDARD SWITCH. SEE PLAN FOR LOCATION 3035 164,739 IN LIEU OF STANDARD CEILING LIGHTS, USE STANDARD SWITCH. SEE PLAN FOR LOCATION 3035 164,739 IN LIEU OF STANDARD CEILING LIGHTS, USE STANDARD SWITCH. SEE PLAN FOR LOCATION 3035 164,739 IN LIEU OF STANDARD CEILING LIGHTS, USE STANDARD SWITCH. SEE PLAN FOR LOCATION 3035 105 105 105 105 105 105 105 105 105 10	Invoice	Qty.	Description			
28Sep23 IN LIEU OF STANDARD CEILING LIGHTS, USE STANDARD SWITCHES, SEE PLAN FROM LOCATION 3035 164,749 IN LIEU OF STANDARD CEILING LIGHTS, USE STANDARD SWITCH. SEE PLAN FOR LOCATION 3035 164,749 IN LIEU OF STANDARD CEILING LIGHTS, USE STANDARD SWITCH. SEE PLAN FOR LOCATION 3035 164,749 IN LIEU OF STANDARD CEILING LIGHTS, USE STANDARD SWITCH. SEE PLAN FOR LOCATION 3035 17 KITCHEN: SIA ADDITIONAL INTERIOR SWITCIL SINGLE POLE 4 KITCHEN: SIA ADDITIONAL REINFORCED CEILING MOUNT FIXTURE 4 LOCATE APPROX CENTERED ABOVE ISLAND, SEE PLAN FOR LOCATION 3035 10 KITCHEN: SIA ADDITIONAL REINFORCED CEILING OUTLET. SUPPORTS UP TO APPROX. 40 LBS. 4 LOCATE APPROX CENTERED ABOVE ISLAND, ON SAME SWITCH AS STANDARD. SEE PLAN FOR LOCATION 3035 10 KITCHEN: SIA ADDITIONAL REINFORCED CEILING OUTLET. SUPPORTS UP TO APPROX. 40 LBS. 4 LOCATE APPROX CENTERED ABOVE ISLAND, ON SAME SWITCH AS STANDARD. SEE PLAN FOR LOCATION 3035 10 KITCHEN: SIA ADDITIONAL REINFORCED CEILING OUTLET. SUPPORTS UP TO APPROX. 40 LBS. 4 KITCHEN: SIA ADDITIONAL REINFORCED CEILING OUTLET. SUPPORTS UP TO APPROX. 40 LBS. 4 KITCHEN: SIA ADDITIONAL REINFORCED CEILING OUTLET. SUPPORTS UP TO APPROX. 40 LBS. 4 KITCHEN: SIA ADDITIONAL REINFORCED CEILING OUTLET. SUPPORTS UP TO APPROX. 40 LBS. 4 KITCHEN: SIA ADDITIONAL REINFORCED CEILING OUTLET. SUPPORTS UP TO APPROX. 40 LBS. 4 KITCHEN: SIA ADDITIONAL REINFORCED CEILING OUTLET. SUPPORTS UP TO APPROX. 40 LBS. 4 KITCHEN: SIA ADDITIONAL REINFORCED CEILING OUTLET. SUPPORTS UP TO APPROX. 40 LBS. 4 KITCHEN: SIA ADDITIONAL REINFORCED CEILING OUTLET. SUPPORTS UP TO APPROX. 40 LBS. 4 KITCHEN: SIA ADDITIONAL REINFORCED CEILING OUTLET. SUPPORTS UP TO APPROX. 40 LBS. 5 KITCHEN: SIA ADDITIONAL REINFORCED CEILING OUTLET. SUPPORTS UP TO APPROX. 40 LBS. 5 KITCHEN: SIA ADDITIONAL REINFORCED CEILING OUTLET. SUPPORTS UP TO APPROX. 40 LBS. 5 KITCHEN: SIA ADDITI		8	BASEMENT: S/I 4" E/S LED INTERIOR POT LIGHT - GROUND FLOOR - EACH. WHITE			
164,749 28Sep23 IN LIEU OF STANDARD CEILING LIGHTS, USE STANDARD SWITCH. SEE PLAN FOR LOCATION 3035 164,749 28Sep23 IN LIEU OF STANDARD CEILING LIGHT - GROUND FLOOR - EACH. WHITE INCLUDED IN APS. IN LIEU OF STANDARD CEILING OF STANDARD CEILING OF STANDARD SWITCH. SEE PLAN FOR LOCATION 3035 14 KITCHEN: S1 ADDITIONAL INTERIOR SWITCH. SINGLE POLE 4 KITCHEN: S1 ADDITIONAL REINFORCED CEILING MOUNT FIXTURE 5 LOCATE APPROX CENTERED ABOVE ISLAND, ON SAME SWITCH AS STANDARD, SEE PLAN FOR LOCATION 3035 10 KITCHEN: S1 240V (50 AMP) RECEPTACLE ON A SEPARATE CIRCUIT 5 POR FUTURE WALL OVEN, SEE PLAN FOR LOCATION 3035 164,749 1 NICHIEN: S1 4* E'S LED INTERIOR POT LIGHT - GROUND FLOOR - EACH. WHITE 164,749 1 NICHIEN SI 4** E'S LED INTERIOR POT LIGHT - GROUND FLOOR - EACH. WHITE 164,749 1 NICHIED IN APS. 3035 1 MAIN HALL: S1 4** E'S LED INTERIOR POT LIGHT - GROUND FLOOR - EACH. WHITE 164,749 28Sep23 2 SEP PLAN FOR LOCATION 3035 5 UPPER HALL: S1 4** E'S LED INTERIOR POT LIGHT - GROUND FLOOR - EACH. WHITE 3035 5 SEP PLAN FOR LOCATION 3035 5 UPPER HALL: S1 4** E'S LED INTERIOR POT LIGHT - GROUND FLOOR - EACH. WHITE	•		IN LIEU OF STANDARD CEILING LIGHTS, USE STANDARD SWITCHES. SEE PLAN FROM LOCATION			
28Sep23 IN LIEU OF STANDARD CEILING LIGHTS, USE STANDARD SWITCH. SEE PLAN FOR LOCATION SEEPLAN FOR LOCATION KITCHEN: S14" ES LED INTERIOR POT LIGHT - GROUND FLOOR - EACH. WHITE IN LIEU OF STANDARD CEILING LIGHTS, USE STANDARD SWITCH. SEE PLAN FOR LOCATION KITCHEN: S1 ADDITIONAL INTERIOR SWITCH. SINGLE POLE SEEPLAN FOR LOCATE STANDARD CEILING MOUNT FIXTURE LOCATE APPROX CENTERED ABOVE ISLAND, SEE PLAN FOR LOCATION LOCATE APPROX CENTERED ABOVE ISLAND, ON SAME SWITCH AS STANDARD. SEE PLAN FOR LOCATION LOCATE APPROX CENTERED ABOVE ISLAND, ON SAME SWITCH AS STANDARD. SEE PLAN FOR LOCATION LOCATE APPROX CENTERED ABOVE ISLAND, ON SAME SWITCH AS STANDARD. SEE PLAN FOR LOCATION SO335 FOR FUTURE WALL OVEN, SEE PLAN FOR LOCATION CONTROL OF STANDARD CEILING OUTLIFT. SUPPORTS UP TO APPROX. 40 LBS. SO355 FOR FUTURE WALL OVEN, SEE PLAN FOR LOCATION CONTROL OF STANDARD CEILING OUTLIFT. SUPPORTS UP TO APPROX. 40 LBS. CONTROL OF STANDARD SEE PLAN FOR LOCATION CONTROL OF STANDARD SWITCH AS STANDARD. SEE PLAN FOR LOCATION CONTROL OF STANDARD CEILING LIGHT - GROUND FLOOR - EACH. WHITE LOCATION CONTROL OF STANDARD CEILING LIGHTS, USE STANDARD SWITCH. SEE PLAN FOR LOCATION MAIN HALL: S14" ES LED INTERIOR POT LIGHT - GROUND FLOOR - EACH. WHITE LOCATION MAIN HALL: S14" ES LED INTERIOR POT LIGHT - GROUND FLOOR - EACH. WHITE SEE PLAN FOR LOCATION MAIN HALL: S14" ES LED INTERIOR POT LIGHT - GROUND FLOOR - EACH. WHITE SEE PLAN FOR LOCATION MAIN HALL: S14" ES LED INTERIOR POT LIGHT - GROUND FLOOR - EACH. WHITE SEE PLAN FOR LOCATION MAIN HALL: S14" ES LED INTERIOR POT LIGHT - GROUND FLOOR - EACH. WHITE SEE PLAN FOR LOCATION CONTROL OF STANDARD CEILING LIGHT - GROUND FLOOR - EACH. WHITE SEE PLAN FOR LOCATION CONTROL OF STANDARD CEILING CONTROL OF SEACH. WHITE SEE PLAN FOR LOCATION		3	BASEMENT HALL: S/I 4" E/S LED INTERIOR POT LIGHT - GROUND FLOOR - EACH. WHITE			
164,749 28Sep23 IN LIEU OF STANDARD CEILING LIGHTS, USE STANDARD SWITCH. SEE PLAN FOR LOCATION 3035 164,752 28Sep23 IN LIEU OF STANDARD CEILING MOUNT FIXTURE 164,741 1 LOCATE APPROX CENTERED ABOVE ISLAND, SEE PLAN FOR LOCATION 3035 164,753 1 LOCATE APPROX CENTERED ABOVE ISLAND, SEE PLAN FOR LOCATION 3035 164,753 1 LOCATE APPROX CENTERED ABOVE ISLAND, ON SAME SWITCH AS STANDARD. SEE PLAN FOR LOCATION 3035 164,747 1 KITCHEN: \$1,240V (50 AMP) RECEPTACLE ON A SEPARATE CIRCUIT 160 FUTURE WALL OVEN, SEE PLAN FOR LOCATION 3035 164,749 1 INCLUDED IN APS. IN LIEU OF STANDARD CEILING LIGHT - GROUND FLOOR - EACH. WHITE 3035 164,749 1 INCLUDED IN APS. IN LIEU OF STANDARD CEILING LIGHTS, USE STANDARD SWITCH. SEE PLAN FOR LOCATION 3035 164,749 1 INCLUDED IN APS. 3035 164,749 1 INCLUDED IN APS. 3035 164,749 1 INCLUDED IN APS. 3035 164,749 28Sep23 1 SEE PLAN FOR LOCATION 3035 164,749 1 INCLUDED IN APS. 3035 164,749 1 INCLUDED IN APS. 3035 164,749 1 INCLUDED IN APS. 3035 164,749 28Sep23 1 INCLUDED IN APS. 3035 164,749 1 INCLUDED IN APS. 3035 164,749 28Sep23 1 INCLUDED IN APS.			IN LIEU OF STANDARD CEILING LIGHTS, USE STANDARD SWITCH. SEE PLAN FOR LOCATION			
288ep23		5	KITCHEN: S/I 4" E/S LED INTERIOR POT LIGHT - GROUND FLOOR - EACH. WHITE			
164,752 28Sep23			IN LIEU OF STANDARD CEILING LIGHTS, USE STANDARD SWITCH. SEE PLAN FOR LOCATION			
164,741 28Sep23 LOCATE APPROX CENTERED ABOVE ISLAND, SEE PLAN FOR LOCATION 3035 164,753 28Sep23 LOCATE APPROX CENTERED ABOVE ISLAND, ON SAME SWITCH AS STANDARD. SEE PLAN FOR LOCATION 3035 164,747 28Sep23 1 KITCHEN: S/I 240V (50 AMP) RECEPTACLE ON A SEPARATE CIRCUIT FOR FUTURE WALL OVEN, SEE PLAN FOR LOCATION 3035 164,749 28Sep23 1 INCLUDED IN APS. IN LIEU OF STANDARD CEILING LIGHTS, USE STANDARD SWITCH. SEE PLAN FOR LOCATION 3035 164,749 28Sep23 2 MAIN HALL: S/I 4" E/S LED INTERIOR POT LIGHT - GROUND FLOOR - EACH. WHITE 164,749 28Sep23 3035 1 MAIN HALL: S/I 4" E/S LED INTERIOR POT LIGHT - GROUND FLOOR - EACH. WHITE 164,749 28Sep23 3035 1 MAIN HALL: S/I 4" E/S LED INTERIOR POT LIGHT - GROUND FLOOR - EACH. WHITE 3035 164,749 28Sep23 3035 5 UPPER HALL: S/I 4" E/S LED INTERIOR POT LIGHT - GROUND FLOOR - EACH. WHITE 3035 3035 3035 5 UPPER HALL: S/I 4" E/S LED INTERIOR POT LIGHT - EACH. WHITE	164,752	1	KITCHEN: S/I ADDITIONAL INTERIOR SWITCH. SINGLE POLE			
28Sep23 LOCATE APPROX CENTERED ABOVE ISLAND, SEE PLAN FOR LOCATION 1 KITCHEN: S/I ADDITIONAL REINFORCED CEILING OUTLET. SUPPORTS UP TO APPROX. 40 LBS. 1 LOCATE APPROX CENTERED ABOVE ISLAND, ON SAME SWITCH AS STANDARD. SEE PLAN FOR LOCATION 3035 LOCATION 1 KITCHEN: S/I 240V (50 AMP) RECEPTACLE ON A SEPARATE CIRCUIT FOR FUTURE WALL OVEN, SEE PLAN FOR LOCATION 3035 LOCATION 3035 LOCATION 4 GREAT ROOM: S/I 4" E/S LED INTERIOR POT LIGHT - GROUND FLOOR - EACH. WHITE LOCATION 3035 LOCATION 3035 LOCATION 3035 LOCATION 3035 LOCATION 3035 LOCATION 3035 LOCATION 4 MAIN HALL: S/I 4" E/S LED INTERIOR POT LIGHT - GROUND FLOOR - EACH. WHITE LOCATION 3035 LOCATION 3035 LOCATION 3035 LOCATION 5 WAIN HALL: S/I 4" E/S LED INTERIOR POT LIGHT - GROUND FLOOR - EACH. WHITE LOCATION 3035 LOCATION 3035 LOCATION 5 UPPER HALL: S/I 4" E/S LED INTERIOR POT LIGHT - GROUND FLOOR - EACH. WHITE LOCATION 3035 LOCATION 3035 LOCATION 3035 LOCATION 5 UPPER HALL: S/I 4" E/S LED INTERIOR POT LIGHT - EACH. WHITE LOCATION 3035 LOCATION 3035 LOCATION 3035 LOCATION 3035 LOCATION 3035 LOCATION 3035 LOCATION 4 WITCH AS STANDARD CEILING LIGHT - EACH. WHITE LOCATION 3035 LOCATION 3035 LOCATION 4 WITCH AS STANDARD SWITCH. SEE PLAN FOR LOCATION 3035 LOCATION 4 WITCH AS STANDARD SWITCH. SEE PLAN FOR LOCATION 3035 LOCATION 4 WITCH AS STANDARD SWITCH. SEE PLAN FOR LOCATION 4 WITCH AS STANDARD SWITCH AS STANDARD SWITCH. SEE PLAN FOR LOCATION 4 WITCH AS STANDARD SWITCH AS STANDARD SW		1	KITCHEN: RELOCATE STANDARD CEILING MOUNT FIXTURE			
164,753 28Sep23 LOCATE APPROX CENTERED ABOVE ISLAND, ON SAME SWITCH AS STANDARD. SEE PLAN FOR LOCATION 3035 164,747 28Sep23 1 KITCHEN: S/I 240V (50 AMP) RECEPTACLE ON A SEPARATE CIRCUIT FOR FUTURE WALL OVEN, SEE PLAN FOR LOCATION 3035 164,749 28Sep23 1 INCLUDED IN APS. IN LIEU OF STANDARD CEILING LIGHTS, USE STANDARD SWITCH. SEE PLAN FOR LOCATION 3035 164,749 28Sep23 2 MAIN HALL: S/I 4" E/S LED INTERIOR POT LIGHT - GROUND FLOOR - EACH. WHITE 1NCLUDED IN APS 3035 164,749 28Sep23 3035 1 MAIN HALL: S/I 4" E/S LED INTERIOR POT LIGHT - GROUND FLOOR - EACH. WHITE 3035 164,749 28Sep23 5 UPPER HALL: S/I 4" E/S LED INTERIOR POT LIGHT - EACH. WHITE			LOCATE APPROX CENTERED ABOVE ISLAND, SEE PLAN FOR LOCATION			
LOCATE APPROX CENTERED ABOVE ISLAND, ON SAME SWITCH AS STANDARD. SEE PLAN FOR LOCATION 3035 164,747 28Sep23 1 KITCHEN: \$/1 240V (50 AMP) RECEPTACLE ON A SEPARATE CIRCUIT FOR FUTURE WALL OVEN, SEE PLAN FOR LOCATION 3035 164,749 28Sep23 1 INCLUDED IN APS. IN LIEU OF STANDARD CEILING LIGHTS, USE STANDARD SWITCH. SEE PLAN FOR LOCATION 3035 164,749 28Sep23 2 MAIN HALL: \$/14" E/S LED INTERIOR POT LIGHT - GROUND FLOOR - EACH. WHITE 1NCLUDED IN APS 1NCLUDED IN APS 1NCLUDED IN APS 1NCLUDED IN APS 3035 164,749 28Sep23 3035 164,749 28Sep23 3035 104,749 28Sep23 3035 3035 3035 104,749 4 E/S LED INTERIOR POT LIGHT - GROUND FLOOR - EACH. WHITE 3035 3035 3035 3035 3035 3035 3035 303		1	KITCHEN: S/I ADDITIONAL REINFORCED CEILING OUTLET. SUPPORTS UP TO APPROX. 40 LBS.			
164,747 28Sep23 FOR FUTURE WALL OVEN, SEE PLAN FOR LOCATION 3035 164,749 28Sep23 INCLUDED IN APS. IN LIEU OF STANDARD CEILING LIGHTS, USE STANDARD SWITCH. SEE PLAN FOR LOCATION 3035 164,749 28Sep23 INCLUDED IN APS 4 MAIN HALL: S/14" E/S LED INTERIOR POT LIGHT - GROUND FLOOR - EACH. WHITE INCLUDED IN APS 3035 164,749 28Sep23 SEE PLAN FOR LOCATION 3035 164,749 28Sep23 UPPER HALL: S/14" E/S LED INTERIOR POT LIGHT - EACH. WHITE						
28Sep23 FOR FUTURE WALL OVEN, SEE PLAN FOR LOCATION 3035 164,749 28Sep23 INCLUDED IN APS. IN LIEU OF STANDARD CEILING LIGHTS, USE STANDARD SWITCH. SEE PLAN FOR LOCATION 3035 164,749 28Sep23 INCLUDED IN APS 3035 164,749 28Sep23 SEE PLAN FOR LOCATION 3035 164,749 28Sep23 SEE PLAN FOR LOCATION 3035 164,749 28Sep23 SEE PLAN FOR LOCATION 3035 5 UPPER HALL: S/I 4" E/S LED INTERIOR POT LIGHT - GROUND FLOOR - EACH. WHITE 3035 164,749 SEE PLAN FOR LOCATION		1	KITCHEN: S/I 240V (50 AMP) RECEPTACLE ON A SEPARATE CIRCUIT			
164,749 28Sep23 INCLUDED IN APS. IN LIEU OF STANDARD CEILING LIGHTS, USE STANDARD SWITCH. SEE PLAN FOR LOCATION 3035 164,749 28Sep23 INCLUDED IN APS 1 MAIN HALL: S/I 4" E/S LED INTERIOR POT LIGHT - GROUND FLOOR - EACH. WHITE INCLUDED IN APS 3035 164,749 28Sep23 SEE PLAN FOR LOCATION 3035 5 UPPER HALL: S/I 4" E/S LED INTERIOR POT LIGHT - EACH. WHITE			FOR FUTURE WALL OVEN, SEE PLAN FOR LOCATION			
28Sep23 INCLUDED IN APS. IN LIEU OF STANDARD CEILING LIGHTS, USE STANDARD SWITCH. SEE PLAN FOR LOCATION 3035 164,749 28Sep23 INCLUDED IN APS 1000 MAIN HALL: S/I 4" E/S LED INTERIOR POT LIGHT - GROUND FLOOR - EACH. WHITE INCLUDED IN APS 1000 MAIN HALL: S/I 4" E/S LED INTERIOR POT LIGHT - GROUND FLOOR - EACH. WHITE SEE PLAN FOR LOCATION 3035 164,749 SEE PLAN FOR LOCATION 3035 164,749 5 UPPER HALL: S/I 4" E/S LED INTERIOR POT LIGHT - EACH. WHITE		6	GREAT ROOM: S/I 4" E/S LED INTERIOR POT LIGHT - GROUND FLOOR - EACH. WHITE			
164,749 28Sep23 INCLUDED IN APS 3035 164,749 28Sep23 SEE PLAN FOR LOCATION 3035 164,749 5 UPPER HALL: S/I 4" E/S LED INTERIOR POT LIGHT - EACH. WHITE						
28Sep23 INCLUDED IN APS 1 MAIN HALL: S/I 4" E/S LED INTERIOR POT LIGHT - GROUND FLOOR - EACH. WHITE 28Sep23 SEE PLAN FOR LOCATION 3035 164,749 5 UPPER HALL: S/I 4" E/S LED INTERIOR POT LIGHT - EACH. WHITE		2	MAIN HALL: S/I 4" E/S LED INTERIOR POT LIGHT - GROUND FLOOR - EACH. WHITE			
164,749 28Sep23 SEE PLAN FOR LOCATION 3035 164,749 5 UPPER HALL: S/I 4" E/S LED INTERIOR POT LIGHT - EACH. WHITE	•		INCLUDED IN APS			
28Sep23 SEE PLAN FOR LOCATION 3035 164,749 5 UPPER HALL: S/I 4" E/S LED INTERIOR POT LIGHT - EACH. WHITE		1	MAIN HALL: S/I 4" E/S LED INTERIOR POT LIGHT - GROUND FLOOR - EACH. WHITE			
164,749	•		SEE PLAN FOR LOCATION			
		5	UPPER HALL: S/I 4" E/S LED INTERIOR POT LIGHT - EACH. WHITE			
			IN LIEU OF STANDARD CEILING LIGHTS, USE STANDARD SWITCH. SEE PLAN FOR LOCATION			

DisciplineMS.rpt 23feb21 Page 1 of 3

Printed and Sent: 29-Sep-23



CONSTRUCTION SUMMARY

Lot: 5-1

Model: 31-01 B END1 Avebury Manor Project/Phase: The Manors at Pine Valley / 4

ELECTRICAL

Invoice	Qty.	Description
3035 164,752	1	PRINCIPAL BEDROOM: S/I ADDITIONAL INTERIOR SWITCH. SINGLE POLE
28Sep23		FOR POTLIGHTS
3035 164,749	4	PRINCIPAL BEDROOM: S/I 4" E/S LED INTERIOR POT LIGHT - EACH. WHITE
28Sep23		IN ADDITION TO STANDARD CEILING LIGHTS. SEE PLAN FOR LOCATION
3035 164,749	4	PRINCIPAL BEDROOM WIC - S/I 4" E/S LED INTERIOR POT LIGHT - GROUND FLOOR - EACH. WHITE
28Sep23		IN LIEU OF STANDARD CEILING LIGHTS, USE STANDARD SWITCH. SEE PLAN FOR LOCATION
3035 164,747	1	GARAGE: S/I 240V (50 AMP) RECEPTACLE ON A SEPARATE CIRCUIT
28Sep23		FOR FUTURE CAR CHARGER

FRAMING

Invoice	Qty.	Description
3035 164,770 28Sep23	1	KITCHEN: DELETE KITCHEN BULKHEAD, IF POSSIBLE, SITE APPROVAL REQUIRED AND IF MECHANICAL LAYOUTS ALLOW. GAP ABOVE UPPER KITCHEN CABINETS WILL BE PRESENT UNLESS ADDITIONAL CABINETRY IS PURCHASED.
3035 164,775 28Sep23	1	KITCHEN: S/I TALLER UPPER, FURRING PANEL WITH CROWN MOULDING TO CEILING. OPTION ONLY AVAILBLE WITH DELETED BULKHEAD.
3035 164,774 28Sep23	1	S/I RECESSED SHOWER NICHE [SHAMPOO SHELF] - COMPLETE WITH MATCHING STONE ON 4 SIDES, STANDARD TILE, APPROX. 12 X 42 INSTALLED VERTICALLY WITH STONE SHELF DIVIDERS. BASED ON STANDARD FINISHES.

HVAC

пулс			
Invoice	Qty.	Description	
3035 164,780 28Sep23	1	KITCHEN: GAS LINE ROUGH-IN - MAIN FLOOR FOR COOKTOP	

INTERIOR DOORS AND TRIM

Invoice	Qty.	Description	
3035 164,784 28Sep23		2ND FLOOR: S/I 8FT HIGH DOOR THROUGHOUT SECOND FLOOR IN LIEU OF STANDARD HEIGHT DOOR. PRICE IS PER DOOR	

DisciplineMS.rpt 23feb21 Page 2 of 3

Printed and Sent: 29-Sep-23



CONSTRUCTION SUMMARY

Lot: 5-1

Model: 31-01 B END1 Avebury Manor Project/Phase: The Manors at Pine Valley / 4

NETWORK AND WIRING

Qty.	Description
-	GREAT ROOM: S/I CONDUIT PIPE FOR WALL MOUNT TV LOCATED APPROX. 66" A.F.F. ABOVE FIREPLACE TO CABLE LOCATION. SEE PLAN FOR LOCATION.
1	EXTERIOR: S/I SECURITY PACKAGE - ROUGH - IN WIRING FOR: 1 RING DOOR BELL + 2 CAMERAS - 1 AT FRONT AND 1 AT REAR. COMPONENTS NOT INCLUDED. (CAT6)
-	GREAT ROOM: S/I ADDITIONAL CAT6 ETHERNET OUTLET SEE PLAN FOR LOCATION
	1

PLUMBING

Invoice	Qty.	Description
3035 164,798 28Sep23	1	KITCHEN: S/I ROUGH-IN 1/4" COLD WATER LINE TO FRIDGE
3035	1	PRINCIPAL ENSUITE: UPGRADE TO MOEN 'ALIGN' SUITE INCLUDING RAIN SHOWER + TUB FILLER + LAV FAUCETS x2
28Sep23 NoCat		

DisciplineMS.rpt 23feb21 Page 3 of 3

Printed and Sent: 29-Sep-23



The Avebury Manor

3 BEDROOMS | 3.5 BATHROOMS

ELEV. A 2330 SQ.FT.
INCLUDES 466 SQ.FT. OF FINISHED BASEMENT

ELEV. B 2327 sq.ft.
INCLUDES 466 SQ.FT. OF FINISHED BASEMENT


END 1 A 2366 sq.ft. INCLUDES 469 SQ.FT. OF FINISHED BASEMEN


END 1 B 2362 sq.ft.
INCLUDES 468 SQ.FT. OF FINISHED BASEMENT

END 2 A 2357 sq.ft.
INCLUDES 471 SQ.FT. OF FINISHED BASEMENT

END 2 B 2353 sq.ft.

TM-5-1 SEPT 26, 2023

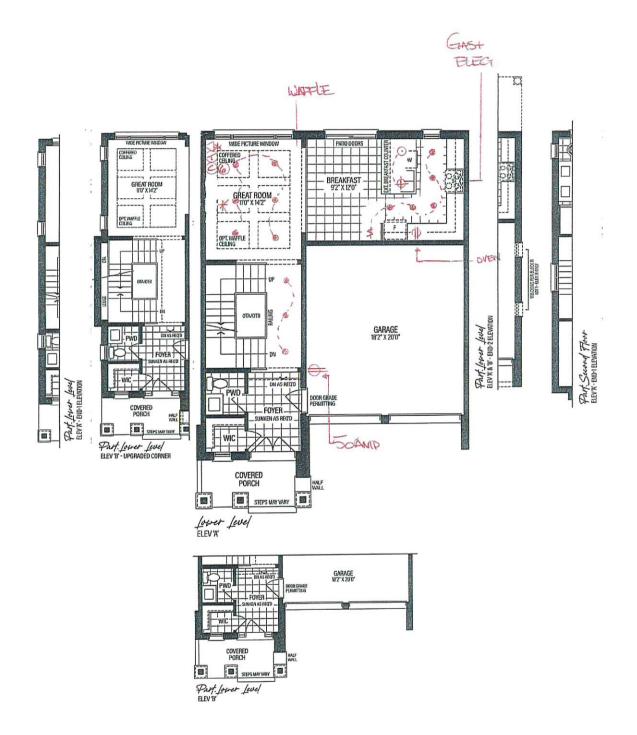

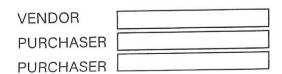





The Avebury Manor

3 BEDROOMS | 3.5 BATHROOMS

ELEV. A 2330 sq.FT.

ELEV. B 2327 sq.FT.

INCLUDES 466 SQ.FT. OF FINISHED BASEMENT


TM-5-1 SEPT 26, 2023 END 1 A 2366 sq.ft. INCLUDES 469 SQ.FT. OF FINISHED BASEMENT

END 1 B 2362 sq.FT. INCLUDES 468 SQ.FT. OF FINISHED BASEMENT

END 2 A 2357 sq.ft. INCLUDES 471 SQ.FT. OF FINISHED BASEMENT

END 2 B 2353 sq.FT. INCLUDES 471 SQ.FT. OF FINISHED BASEMENT



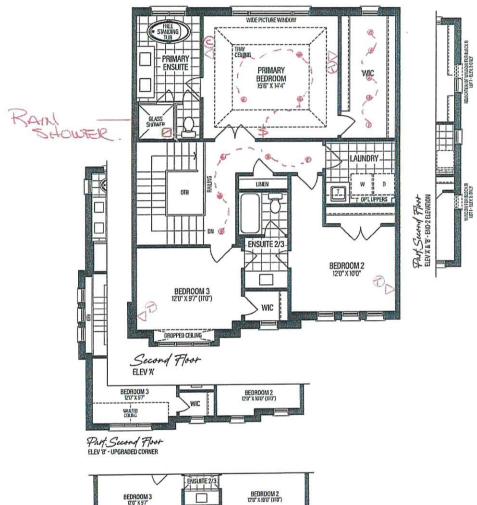

VENDOR PURCHASER PURCHASER GOLD PARK WORTH MORE

SCHEDULE 'F'

RENDERINGS ARE ARTIST'S CONCEPT. FIGURES, ILLUSTRATIONS, SIZES, FEATURES AND FINISHES ARE SUBJECT TO CHANGE WITHOUT NOTICE. AREAS AND DIMENSIONS ARE APPROXIMATE AND ACTUAL USABLE FLOOR SPACE MAY VARY FROM THE STATED AREA. LAYOUT MAY BE REVERSE OF THE UNIT PURCHASED. E. & O.E. 3101



The Avebury Manor

3 BEDROOMS | 3.5 BATHROOMS

ELEV. A 2330 sq.FT. INCLUDES 466 SQ.FT. OF FINISHED BASEMENT

ELEV. B 2327 sq.FT.


INCLUDES 466 SQ.FT. OF FINISHED BASEMENT


TM-5-1 SEPT 26, 2023

END 1 A 2366 sq.FT. INCLUDES 469 SQ.FT. OF FINISHED BASEMENT

END 1 B 2362 sq. FT. INCLUDES 468 SQ.FT. OF FINISHED BASEMENT END 2 A 2357 sq.ft. INCLUDES 471 SQ.FT. OF FINISHED BASEMENT

END 2 B 2353 sq.FT. INCLUDES 471 SQ.FT. OF FINISHED BASEMENT

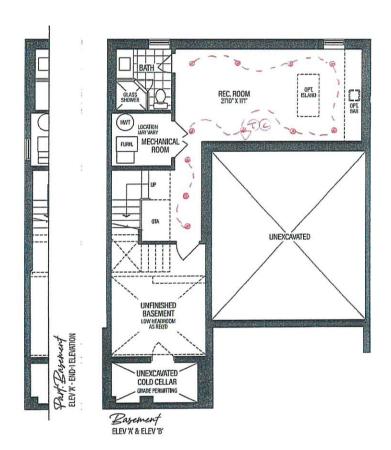

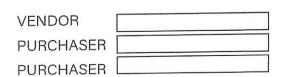



PLUMBING UPGRADES

ALIGN

Ceiling Mount: 226651 (12" Arm)		
	Developed Cold	\square
	Brushed Gold Brushed Nickel	
	Chrome	
	Matte Black	
	matto Diaon	
Date: September 20, 2023	Lot: TM-85-1	
Location: Principal Ensuite		
	0:	
Signature:	Signature:	

Shower with 3-Function Transfer Valve/Trim and Slide Bar with Hand Shower + 7" Rain Showerhead From Ceiling on 12" Arm (includes plumbing provision for ceiling mount showerhead) Model T2192EP/UT4191/3887EP/226651/S176/U361CI/

62320/A725





ALIGN



	Brushed Gold Brushed Nickel Chrome Matte Black	□ × 2 □ □
Date: September 20, 2023	Lot: TM- 85 - 1	
Location: Principal Ensuite		
Signature:	Signature:	





ALIGN



*includes Tub Drain Half Kit

	Brushed Gold Brushed Nickel Chrome Matte Black	
Date: September 20, 2023	Lot: TM-85-1	
Location: Principal Ensuite		
Signature:	Signature:	

